


**GENERAL SHEET NOTES**

- A. REFER TO ELECTRICAL DEMOLITION DRAWING FOR ADDITIONAL DEMOLITION REQUIREMENTS OUTSIDE OF MECHANICAL SCOPES.
- B. REFER TO ELECTRICAL DEMOLITION DRAWING FOR ADDITIONAL DEMOLITION REQUIREMENTS OUTSIDE OF MECHANICAL SCOPES.
- C. DEMOLITION SCOPE OF WORK INCLUDES:
  - REMOVAL OF ALL DUCTWORK, HANGERS, RISERS AND ACCESSORIES SERVING THE THIRD FLOOR.
  - REMOVAL OF ALL HYDRONIC PIPING, REHEAT COILS, HANGERS, RISERS, AND ISOLATION VALVES SERVING THE 3RD FLOOR.
  - REMOVAL OF ALL DUCT AND HYDRONIC RISERS SERVING THE 2ND FLOOR.
  - REMOVAL OF ALL THERMOSTATS AND ASSOCIATED WRING.
- D. (E) HYDRONIC PIPING FOR REMAIN IN PLACE UNLESS OTHERWISE NOTED, VERIFY & LABEL FOR REMAIN.

**DEMOLITION SHEET KEYNOTES**

- 1 REMOVE (E) DUCT RISERS SERVING THE 2ND FLOOR.
- 2 REMOVE ALL EXISTING TRANSFER AIR DUCT AND GRILLE. (TYPICAL)
- 3 REMOVE ALL EXISTING THERMOSTAT AND ASSOCIATED (E)CONTROL WIRING AND DELIVER TO BUILDINGS & GROUNDS.
- 4 REMOVE ALL (E) HYDRONIC PIPING, (E) REHEAT COILS AND ALL ASSOCIATED PIPE HANGERS SERVING THE SS3 LOWER LEVEL. (TYPICAL)
- 5 REMOVE ALL (E) DUCT RISERS SERVING THE SS3 LOWER LEVEL.
- 6 REMOVE (E) HYDRONIC RISERS AND ALL (E) ISOLATION VALVES.
- 7 REMOVE ALL (E) DUCTWORK AND ALL ASSOCIATED DUCT HANGERS SERVING THE SS3 LOWER LEVEL. (TYPICAL)
- 8 REMOVE (E) HYDRONIC RISERS SERVING THE 2ND FLOOR.
- 9 CAP AND ABANDON (E) HYDRONIC PIPING IN PLACE.

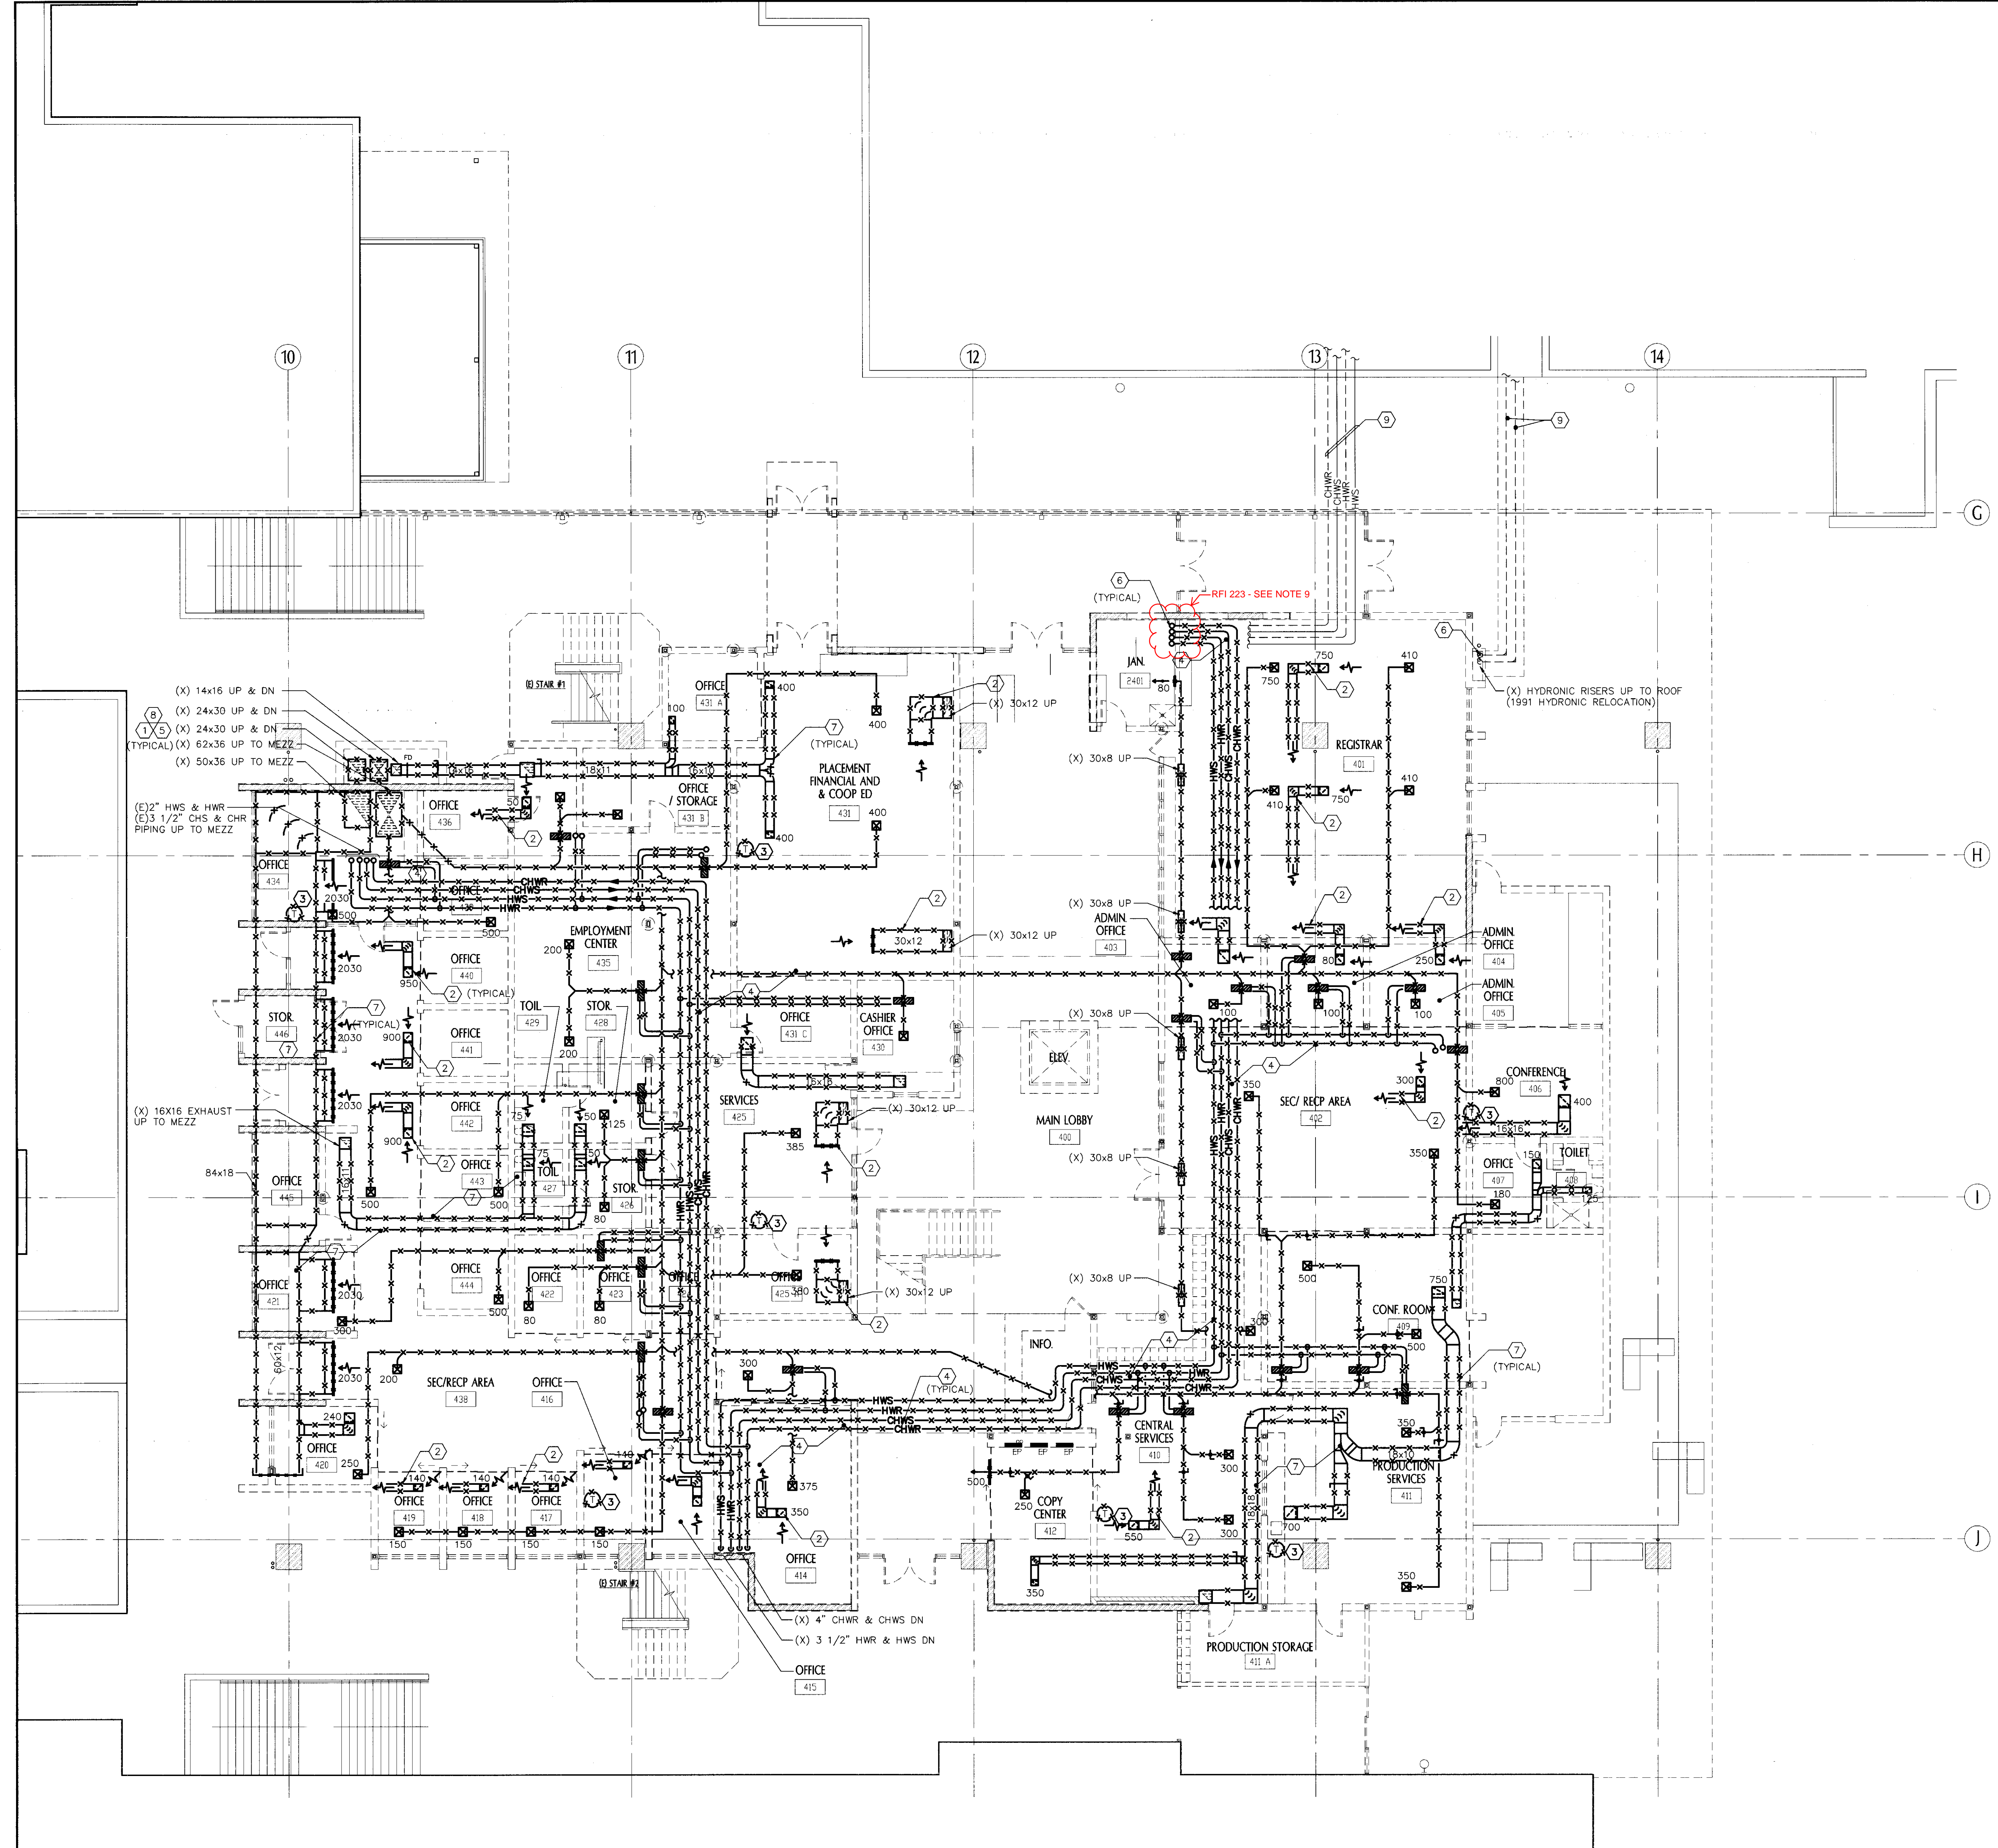

**1 SS3 LOWER LEVEL DEMO PLAN - MECHANICAL**  
 SCALE: 1/8"=1'-0"

**tBP**  
 architecture  
 planning  
 interiors  
 management

1000 Burnett Avenue Suite 140  
 Concord, CA 94520  
 ph: 925.246.6419 fx: 925.246.6495

**INTERFACE**  
 ENGINEERING

PROJECT: 2006-0108  
 CONTRACT: Sherrill Wilson

714 Market Street  
 San Francisco, CA 94103  
 Tel: 415.489.7288  
 Fax: 415.489.7288  
 www.interfaceeng.com

**RE #/CI**

DATE: JUL 31 2012

name  
 address  
 city, state, zip  
 ph: \_\_\_\_\_  
 fx: \_\_\_\_\_  
 agency

**L-612 STUDENT SERVICES CENTER REMODEL COLLEGE COMPLEX**  
 BID DOCUMENTS

LOS MEDANOS COLLEGE  
 2700 EAST LELAND DRIVE  
 PITTSBURG, CA 94565

tBP project number : 200610.00  
 file name : 0106MID.dwg  
 drawn by : GE checked by : BC  
 date : JULY 31, 2012

Rev	date	description

THIS DRAWING AND THE DESIGN, SPECIFICATIONS, DEANS AND OTHER INFORMATION CONTAINED HEREIN CONSTITUTE UNPUBLISHED WORKS OF ARCHITECTURE AND SHALL REMAIN THE PROPERTY OF tBP ARCHITECTURE. NO PART THEREOF SHALL BE REPRODUCED, DISCLOSED, DISTRIBUTED, SOLD, PUBLISHED OR OTHERWISE USED IN ANY MANNER WITHOUT THE EXPRESS WRITTEN CONSENT OF tBP ARCHITECTURE.

drawing title:  
**SS3 LOWER LEVEL DEMO PLAN - MECHANICAL**


drawing no:  
**MD-11**  
 drawing of

**GENERAL SHEET NOTES**

- A. REFER TO ELECTRICAL DEMOLITION DRAWING FOR ADDITIONAL DEMOLITION REQUIREMENTS OUTSIDE OF MECHANICAL SCOPES.
- B. ALL EXISTING SHALL REMAIN UNLESS OTHERWISE NOTED FOR DEMOLITION.
- C. DEMOLITION SCOPE OF WORK INCLUDES:
  - REMOVAL OF ALL DUCTWORK, HANGERS, RISERS AND ACCESSORIES SERVING THE THIRD FLOOR.
  - REMOVAL OF ALL HYDRONIC PIPING, REHEAT COILS, HANGERS, RISERS, AND ISOLATION VALVES SERVING THE 3RD FLOOR.
  - REMOVAL OF ALL DUCT AND HYDRONIC RISERS SERVING THE 2ND FLOOR.
  - REMOVAL OF ALL THERMOSTATS AND ASSOCIATED WIRING.
- D. ALL EXISTING MECH EQUIPMENT TO BE DEMOLISHED SHALL BE SALVAGED AND OFFER TO RETURN TO COLLEGE. IF THE DISTRICT REJECTS THE EXISTING EQUIPMENT, CONTRACTOR SHALL DEMOLISH & REMOVE EXISTING.
- E. ALL EXISTING MECH EQUIPMENT WILL BE REVIEWED AND TAGGED AT PRE-CONSTRUCTION SITE WALK WITH COLLEGE FACILITIES PERSONNEL. IF THE DISTRICT REJECTS THE EXISTING EQUIPMENT, CONTRACTOR SHALL DEMOLISH & REMOVE EXISTING.
- F. UNLESS OTHERWISE NOTED FOR DEMOLITION, SALVAGE ALL EXISTING.

**SHEET KEYNOTES**

- 1. DEMOLISH (E) DUCT RISERS.
- 2. DEMOLISH ALL EXISTING EXHAUST HOOD CONNECTION AND ALL ASSOCIATED DUCT WORK ACCESSORIES. REFER TO STRUCTURAL FOR CONCRETE INFILL AT EXISTING ROOF OPENING.
- 3. DEMOLISH ALL EXISTING THERMOSTAT AND ASSOCIATED (E) CONTROL WIRING. VERIFY LOCATIONS AND REMOVE ALL.
- 4. DEMOLISH ALL (E) HYDRONIC PIPING, (E) REHEAT COILS AND ALL ASSOCIATED PIPE HANGERS.
- 5. DEMOLISH (E) HYDRONIC RISERS AND ALL (E) ISOLATION VALVES, EXCEPT FOR THOSE SERVING THE 2ND FLOOR.
- 6. DEMOLISH ALL (E) DUCTWORK AND ALL ASSOCIATED DUCT HANGERS SERVING THE SS4 UPPER LEVEL.
- 7. SALVAGE (E) OUTDOOR CONDENSER AND (E) INDOOR FAN COILS AND OFFER TO THE DISTRICT FOR REUSE. DEMOLISH ALL REFRIGERANT PIPING AND ALL ASSOCIATED COMPONENTS.

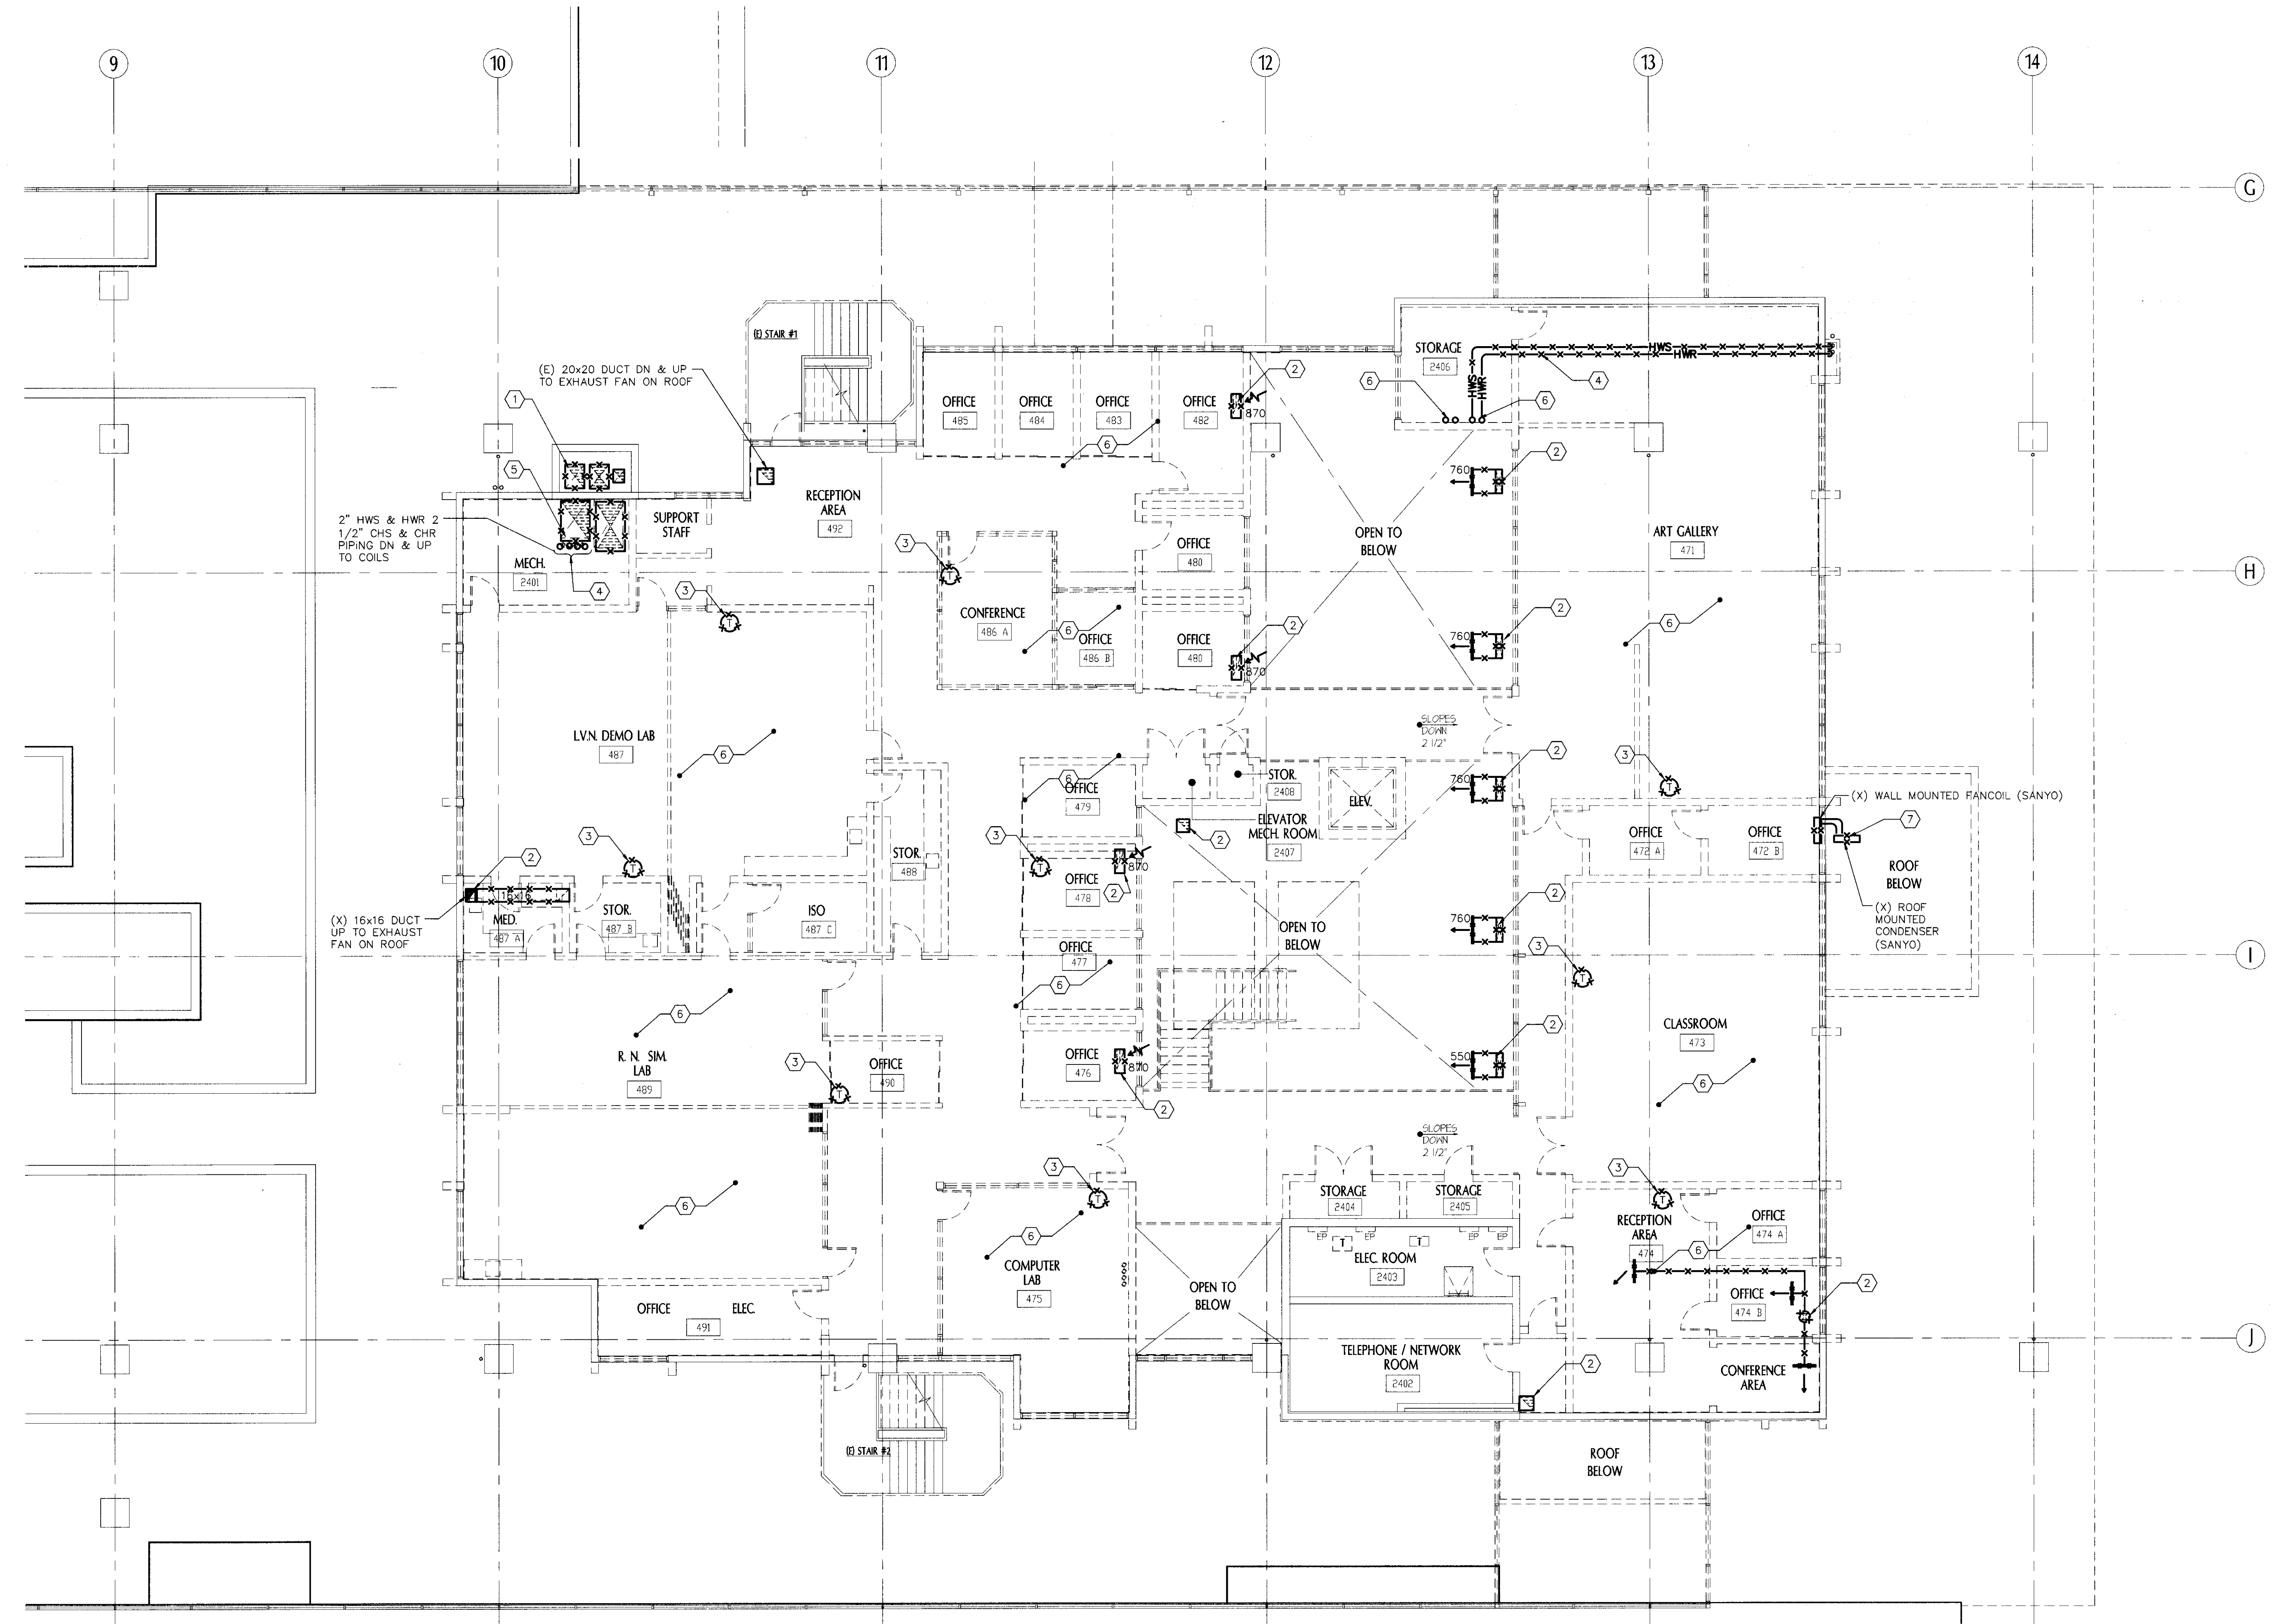

**1 SS4 UPPER LEVEL DEMO PLAN - MECHANICAL**  
 SCALE: 1/8"=1'-0"

**tBP**  
 architecture  
 planning  
 interiors  
 management

1887/Architecture  
 1000 Burnett Avenue Suite 140  
 Concord, CA 94520  
 ph: 925.246.6419 fx: 925.246.6495

architect

**INTERFACE**  
 ENGINEERING

PROJECT: 2008-0108  
 CONTRACT: Shawn Wilson

717 Market Street  
 San Francisco, CA 94103  
 TEL: 415.488.7240  
 FAX: 415.488.7240  
 WWW: www.interfaceengineering.com

consultant

**RE #/CI**  
 EXAMINATION STAMP  
 OFFICE OF REGULATION SERVICES

APPL 01-11277  
 JUL 31 2012

name \_\_\_\_\_  
 address \_\_\_\_\_  
 city, state, zip \_\_\_\_\_  
 ph \_\_\_\_\_  
 agency \_\_\_\_\_

**L-612 STUDENT SERVICES CENTER REMODEL COLLEGE COMPLEX**  
**BID DOCUMENTS**


owner  
**LOS MEDANOS COLLEGE**  
 2700 EAST LELAND DRIVE  
 PITTSBURG, CA 94565

tBP project number : 20671000  
 file name: 0106M12D.dwg  
 drawn by: CR checked by: BC  
 date: **JULY 31, 2012**  
 Rev. date: description:

drawing title:  
**SS4 UPPER LEVEL DEMO PLAN - MECHANICAL**

drawing no:  
**MD-12**  
 drawing of

THIS DRAWING AND THE DESIGN, SPECIFICATIONS, IDEAS AND OTHER INFORMATION CONTAINED HEREIN CONSTITUTE UNPUBLISHED WORK OF tBP/ARCHITECTURE AND SHALL REMAIN THE PROPERTY OF tBP/ARCHITECTURE. NO PART OF THIS DRAWING SHALL BE REPRODUCED, DISCLOSED, DISTRIBUTED, SOLD, PUBLISHED OR OTHERWISE USED IN ANY MANNER WITHOUT THE EXPRESS WRITTEN CONSENT OF tBP/ARCHITECTURE.

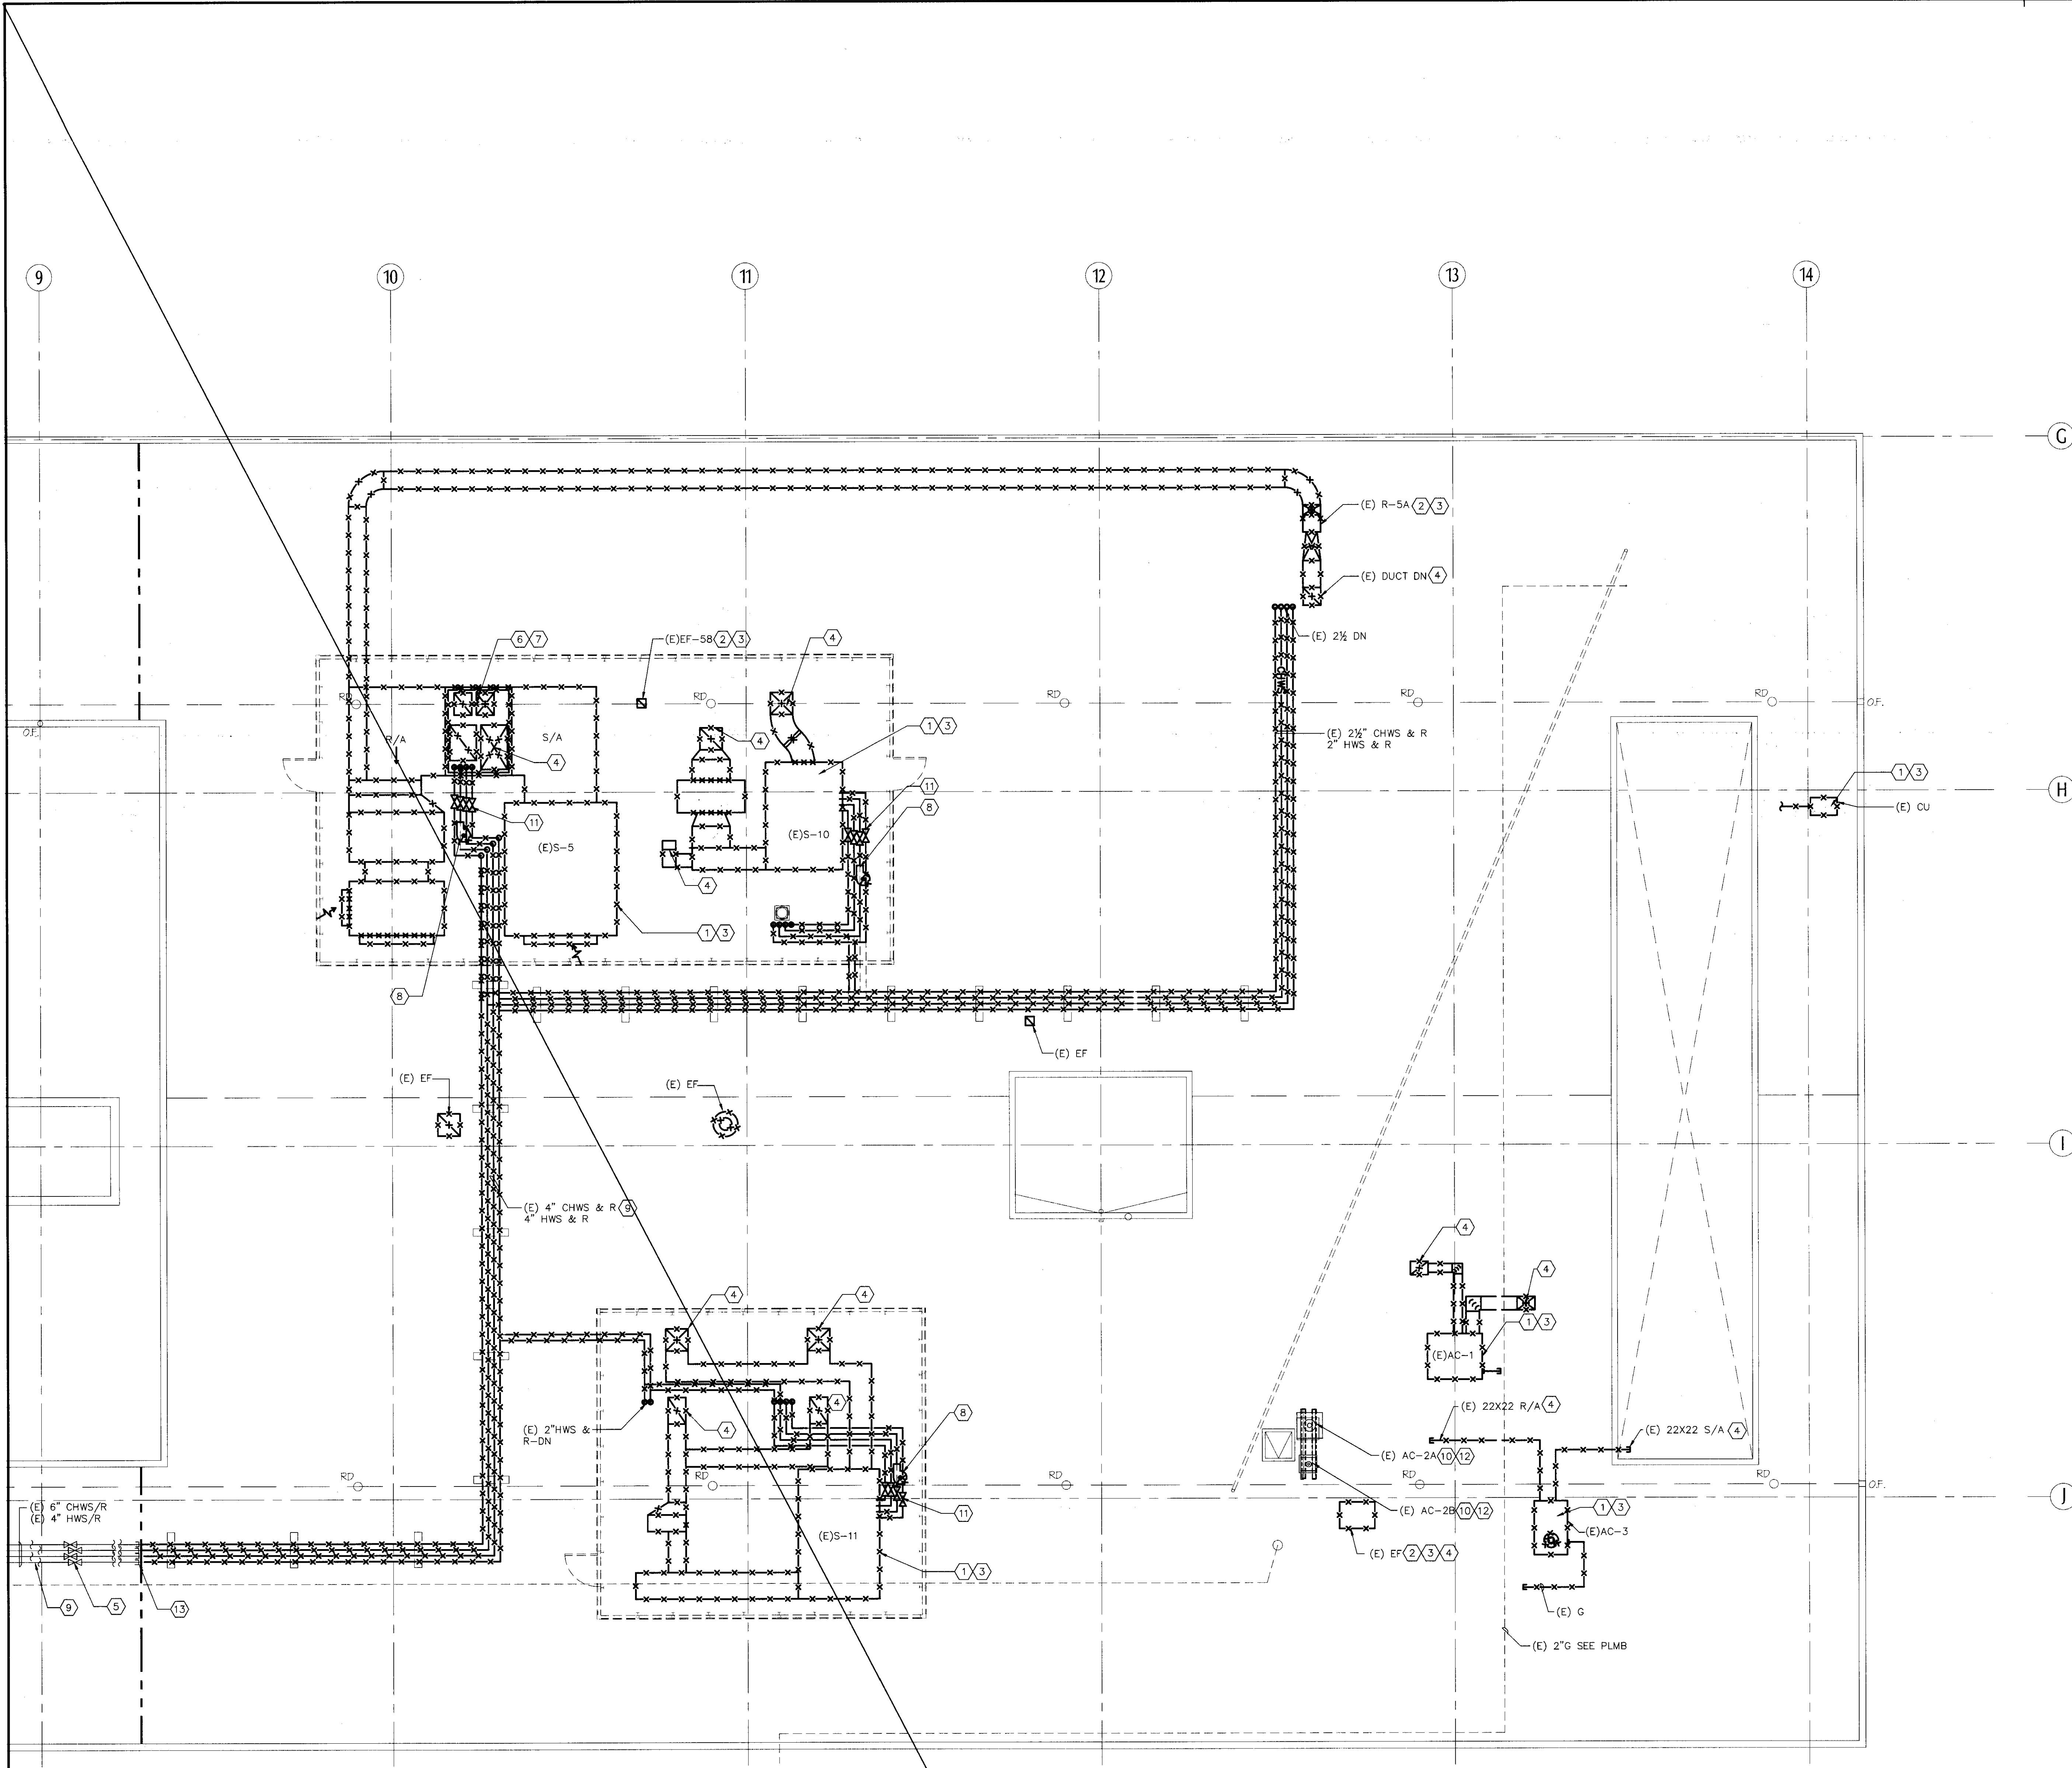

**GENERAL SHEET NOTES**

- A. REFER TO ELECTRICAL DEMOLITION DRAWING FOR ADDITIONAL DEMOLITION REQUIREMENTS OUTSIDE OF MECHANICAL SCOPES.
- B. ALL EXISTING SHALL REMAIN UNLESS OTHERWISE NOTED FOR DEMOLITION.
- C. CONTRACTOR SHALL COORDINATE PHASE I DEMOLITION SEQUENCE WITH THE FACILITY IN ORDER TO MINIMIZE IMPACT TO THE OPERATION OF THE FACILITY.
- D. ALL OTHER DEMOLITION WORK SHOWN ON THIS DRAWING SHALL BE PHASE II.
- E. ALL EXISTING MECH EQUIPMENT TO BE DEMOLISHED SHALL BE SALVAGED AND OFFERED TO COLLEGE FOR RE-USE ON CAMPUS. ALL ROOFTOP MECH EQUIPMENT WILL BE REVIEWED AND TAGGED AT PRE-CONSTRUCTION SITE WALK WITH COLLEGE FACILITIES PERSONNEL. IF THE DISTRICT REJECTS THE EXISTING EQUIPMENT, CONTRACTOR SHALL DEMOLISH & REMOVE EXISTING.

**SHEET KEYNOTES**

- 1 DEMOLISH EXISTING HVAC EQUIPMENT AND ALL ASSOCIATED COMPONENTS. SALVAGE & DELIVER ENTIRE UNIT UNDAMAGED. NOTE: DURING DEMOLITION, CONTRACT SHALL TAKE PRECAUTION NOT TO DAMAGE OR DESTROY ANY PARTS OR COMPONENTS OF THE HVAC EQUIPMENT.
- 2 DEMOLISH EXISTING ROOF MOUNTED EXHAUST FAN, ROOF CURB AND ALL ASSOCIATED DUCT WORK ACCESSORIES.
- 3 ELECTRICAL POWER TO HVAC EQUIPMENT IS TO BE DEMOLISHED AND PULLED BACK TO THE MAIN CIRCUIT BREAKER. SEE ELECTRICAL DRAWING FOR DEMOLITION REQUIREMENT.
- 4 REFER TO STRUCTURAL FOR CONCRETE INFILL AND PATCHING AT EXISTING ROOF OPENING.
- 5 (PHASE I) PROVIDE NEW ISOLATION VALVES FOR ISOLATION OF (E) BUILDING HYDRONIC LOOP. REFER TO M-2.3 FOR NEW ISOLATION VALVES LOCATION.
- 6 DEMOLISH (E) DUCT RISERS DOWN TO 2ND FLOOR.
- 7 DEMOLISH (E) DUCT RISERS SERVING 3RD FLOOR.
- 8 DEMOLISH EXISTING BOOSTER PUMPS. SALVAGE AND OFFER PUMPS TO COLLEGE FOR RE-USE ON CAMPUS.
- 9 EXISTING HYDRONIC PIPING TO REMAIN. REFER TO ARCH DEMO DRAWING FOR REROOFING AREA SCOPE OF WORK.
- 10 EXISTING AC UNITS SERVING THE MAIN CAMPUS TELECOM ROOM SHALL REMAIN OPERATIONAL DURING CONSTRUCTION.
- 11 CLOSE ALL ISOLATION VALVES AND PROVIDE CAP-OUTS PRIOR TO DEMOLITION WORK. REFER TO FACILITY MANAGER FOR LOCATION OF EXISTING MAIN HYDRONIC ISOLATION VALVES SERVING THE BUILDING.
- 12 PROVIDE TEMPORARY PRE-FAB SLEEPERS FOR (E)AC-2A & (E)AC-2B TO ACCOMMODATE RE-ROOFING.
- 13 LINE OF RE-ROOFING WHERE (E) HYDRONICS ARE TO BE REMOVED OR REMAINED

**1 ROOF DEMOLITION PLAN - MECHANICAL**  
 SCALE: 1/8"=1'-0"

**tBP**  
 architecture  
 planning  
 interiors  
 management

1000 Burnett Avenue Suite 140  
 Concord, CA 94520  
 ph: 925.246.6495  
 fx: 925.246.6495

architect

**INTERFACE**  
 ENGINEERING  
 CONSULTANTS

2020-0106  
 Project: Student Services  
 777 Market Street  
 Suite 200  
 San Francisco, CA 94103  
 Tel: 415.488.2200  
 Fax: 415.488.2208  
 www.interfaceengineering.com

consultant

**RE 7/C**  
 IDENTIFICATION SHEET  
 OFFICE OF REGULATION SERVICES

APPL 01/12/27  
 AC 7/15/12  
 DATE JUL 31 2012

name \_\_\_\_\_  
 address \_\_\_\_\_  
 city, state, zip \_\_\_\_\_  
 ph. \_\_\_\_\_  
 agency \_\_\_\_\_

**L-612 STUDENT SERVICES  
 CENTER REMODEL  
 COLLEGE COMPLEX**  
 BID DOCUMENTS

LOS MEDANOS COLLEGE  
 2700 EAST LELAND DRIVE  
 PITTSBURG, CA 94565

owner

tBP project number: 20610.00  
 file name: 0106M3D.dwg  
 drawn by: GE checked by: EC  
 date: JULY 31, 2012  
 Rev. date: description:

THIS DRAWING AND THE DESIGN, SPECIFICATIONS, DETAILS AND OTHER INFORMATION CONTAINED HEREIN CONSTITUTE UNPUBLISHED WORK OF ARCHITECTURE AND SHALL REMAIN THE PROPERTY OF ARCHITECTURE IN PERPETUITY. NO PART HEREOF SHALL BE REPRODUCED, TRANSMITTED, COPIED, STORED, SOLD, RENTED OR OTHERWISE USED IN ANY MANNER WITHOUT THE EXPRESS WRITTEN CONSENT OF ARCHITECTURE.









drawing title:  
**ROOF DEMOLITION  
 PLAN MECHANICAL**

drawing no:  
**MD-13**  
 drawing of

**MECHANICAL SYMBOL LIST**

NOTE: This is a standard symbol list and not all items listed may be used.

Abbreviations		Equipment	
(E)	EXISTING		RECTANGULAR MAIN WITH RECTANGULAR BRANCH
(N)	NEW		RECTANGULAR MAIN WITH ROUND BRANCH
(X)	DEMOLISH		RECTANGULAR OFFSET LESS THAN 15°
(RL)	RELOCATE		RECTANGULAR OFFSET MORE THAN 15°
A/C	AIR CONDITION(ED)		ROUND DUCT DROP
AD	ACCESS DOOR		ROUND DUCT RISER
AFF	ABOVE FINISHED FLOOR		ROUND DUCT WITH ROUND BRANCH
AHU	AIR HANDLING UNIT		ROUND WYE
B	BOILER		SYMMETRICAL WYE
BDD	BACKDRAFT DAMPER		DUCT ROOF SUPPORT
BFF	BELOW FINISHED FLOOR		AIR TERMINAL UNIT / VAV BOX
BFP	BACKFLOW PREVENTER		AIR HANDLING UNIT
BHP	BRAKE HORSEPOWER		CHILLED / HEATING WATER PUMP
CD	CEILING DIFFUSER		DIFFUSER OR GRILLE IDENTIFICATION
CD	CONDENSATE DRAIN		OUTSIDE AIR
CF	CUBIC FOOT		RETURN OR EXHAUST AIR
CFM	CUBIC FEET PER MINUTE		SUPPLY AIR
CH	CHILLER		General
CL	CENTERLINE		AUTOMATIC AIR VENT
CONT.	CONTINUATION		BACKFLOW PREVENTER
COP	COEFFICIENT OF PERFORMANCE		CAP
CT	COOLING TOWER		CONCENTRIC REDUCER
CU	CONDENSING UNIT		UNIT HEATER
CV	CHECK VALVE		CONTINUATION
CV	VALVE FLOW COEFFICIENT		ECCENTRIC REDUCER
CW	COLD WATER		EXPANSION JOINT
D	DROP		EXPANSION LOOP
DB	DECIBEL		EXPANSION TANK
DB	DRY BULB		FLOW DIRECTION
DG	DOOR GRILLE		FLOW SWITCH
DIA	DIAMETER		HOSE BIBB
DEF	DISHWASHER EXHAUST FAN		MANUAL AIR VENT
DX	DIRECT EXPANSION		PIPE BELOW GRADE
EAT	ENTERING AIR TEMPERATURE		PIPE DROP
EDH	ELECTRIC DUCT HEATER		PIPE REMOVED IN DEMOLITION
EER	ENERGY EFFICIENCY RATING		PIPE RISE
EF	EXHAUST FAN		PIPE TO DRAIN
EFF	EFFICIENT		PRESSURE GAUGE WITH COCK
EL	ELEVATION		PRESSURE RELIEF VALVE
ELECT	ELECTRICAL		PRESSURE SENSOR
EWT	ENTERING WATER TEMPERATURE		SHOCK ABSORBER
EXH	EXHAUST		T&P RELIEF VALVE WITH PIPE TO DRAIN
F	FAHRENHEIT		TEE DOWN ON PIPE
FA	FACE AREA		TEE UP ON PIPE
FC	FAN COIL		TEMPERATURE SENSOR
FC	FLEXIBLE CONNECTOR		TEST PORT (PETE'S PLUG OR EQUAL)
FD	FIRE DAMPER		THERMOMETER
FF	FOULING FACTOR		UNION
FLA	FULL LOAD AMPS		VENT TO ATMOSPHERE
FM	FLOW METER		
FPI	FINS PER INCH		
FPM	FEET PER MINUTE		
FPS	FEET PER SECOND		
FS	FLOW SWITCH		
FT	FEET		
FVEL	FACE VELOCITY		
GAL	GALLONS		
GPH	GALLONS PER HOUR		
GPW	GALLONS PER MINUTE		
HD	HEAD		
HP	HEAT PUMP		
HP	HORSEPOWER		
HTG	HEATING		
HTR	HEATER		
HWC	HOT WATER COIL		
ID	INSIDE DIAMETER		
IE	INVERT ELEVATION		
IN	INCHES		
KEF	KITCHEN HOOD EXHAUST FAN		
KW	KILOWATT		
LBS.	POUNDS		
LH	LATENT HEAT		
LWT	LEAVING WATER TEMPERATURE		
MA	MIXED AIR		
MAX	MAXIMUM		
MBH	THOUSAND BTU'S PER HOUR		
MD	MOTORIZED DAMPER		

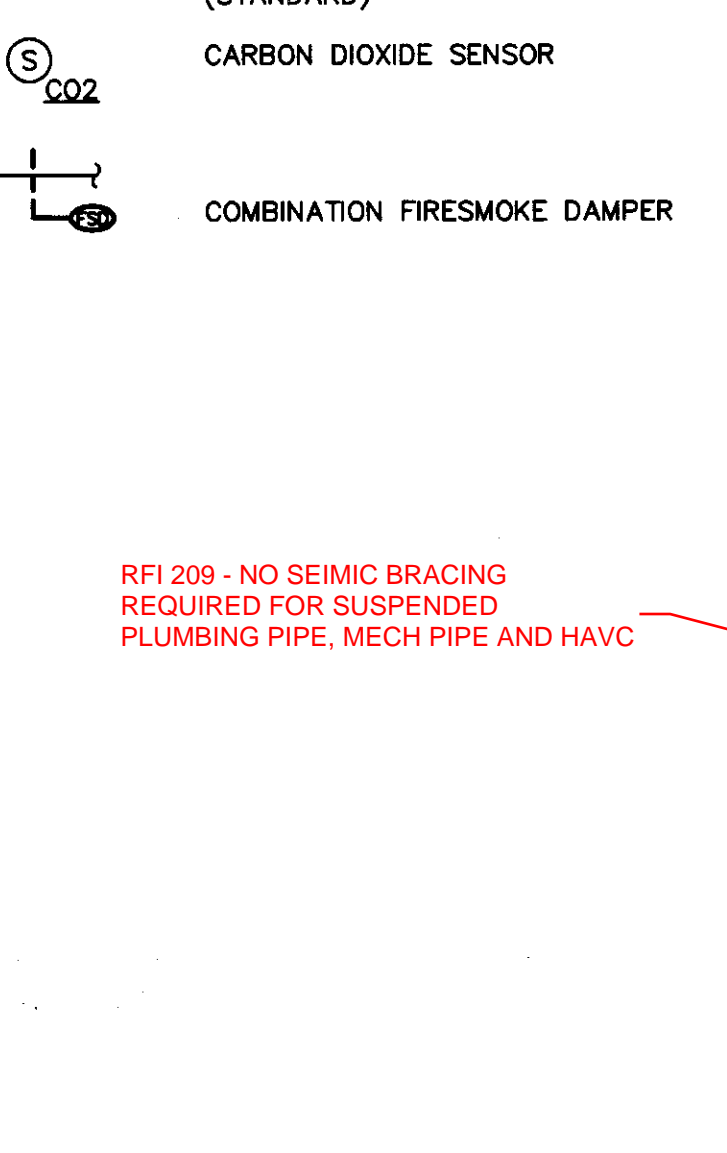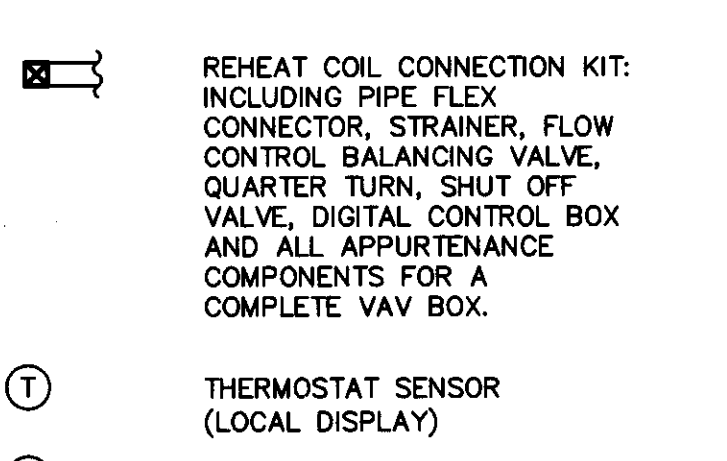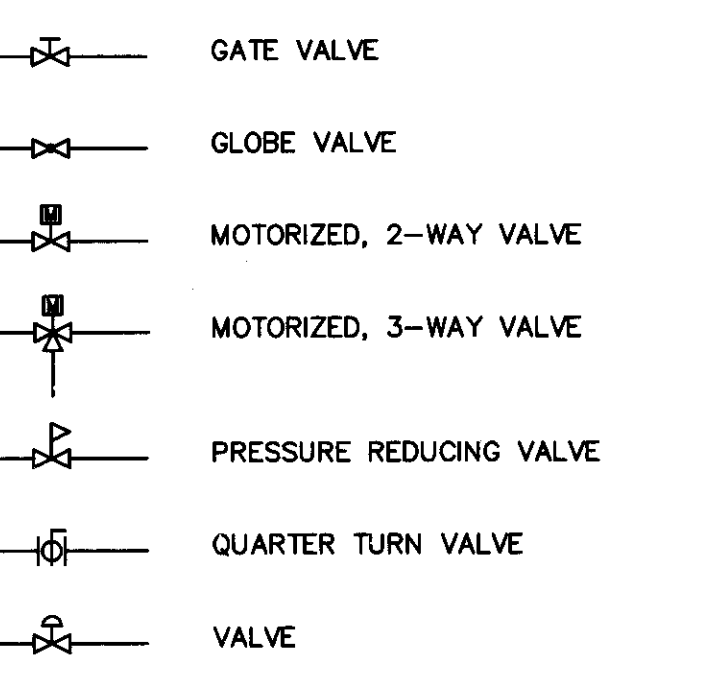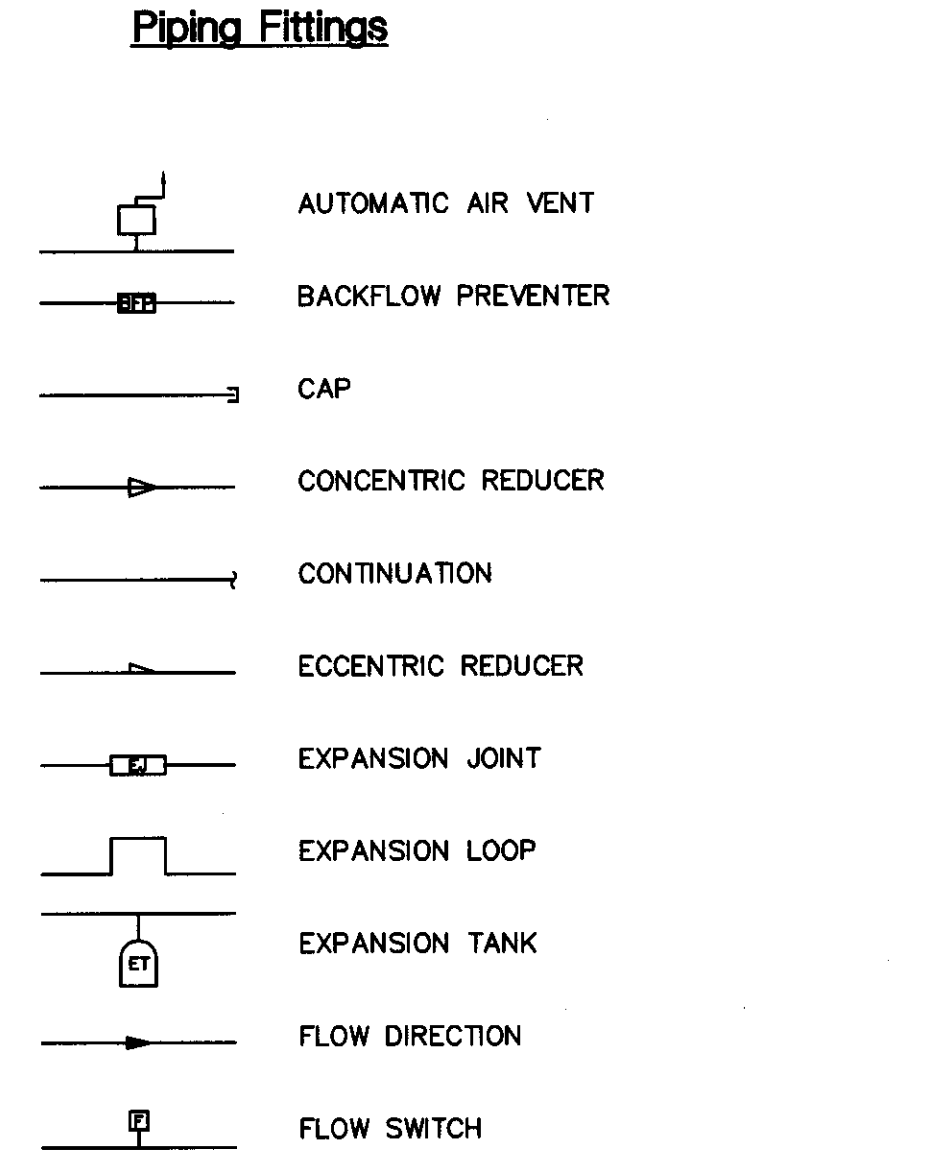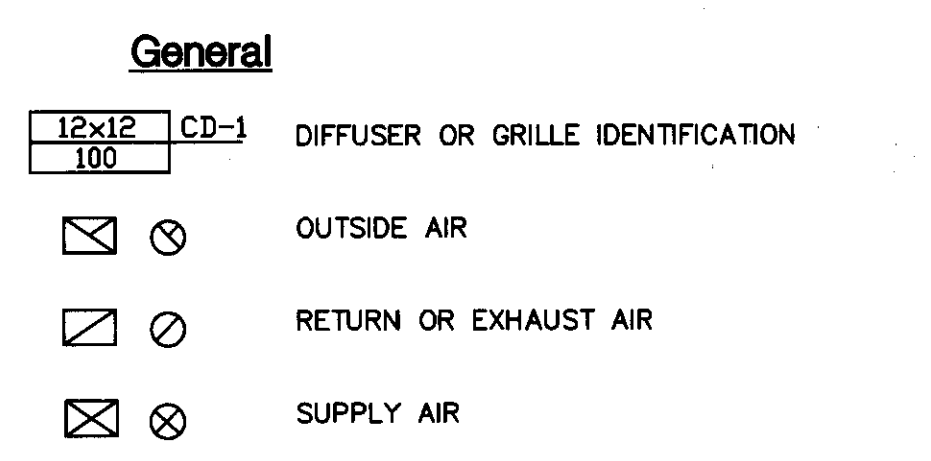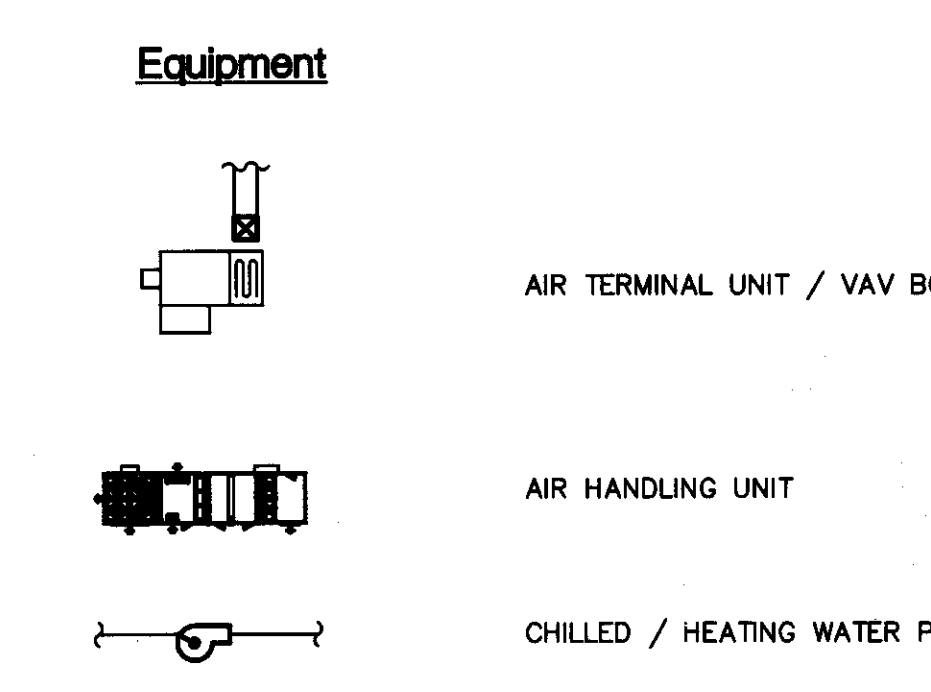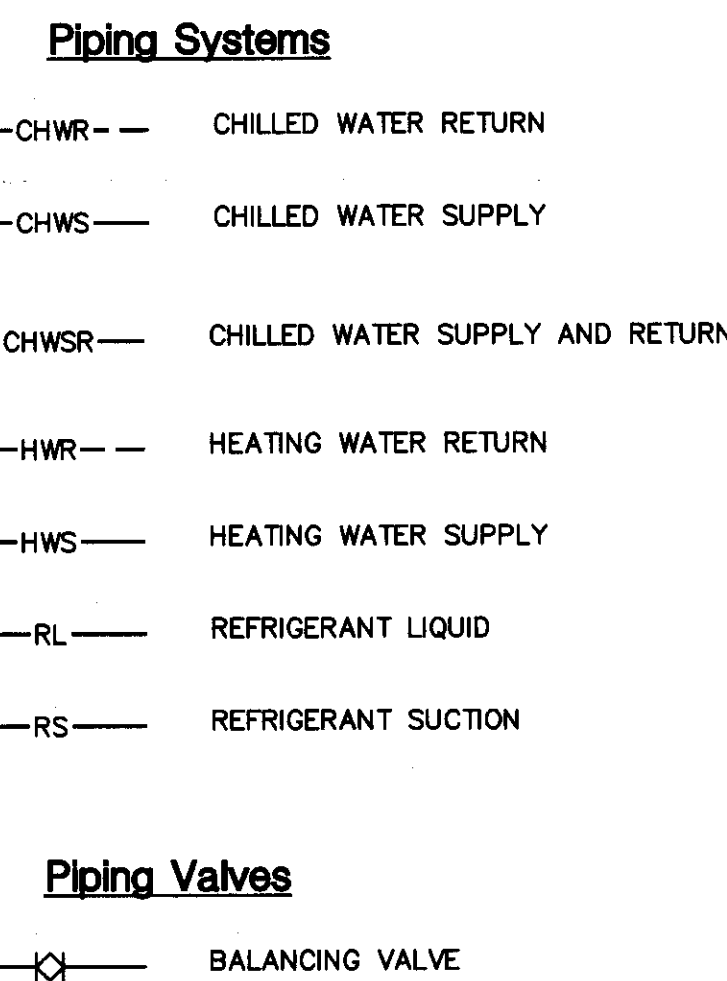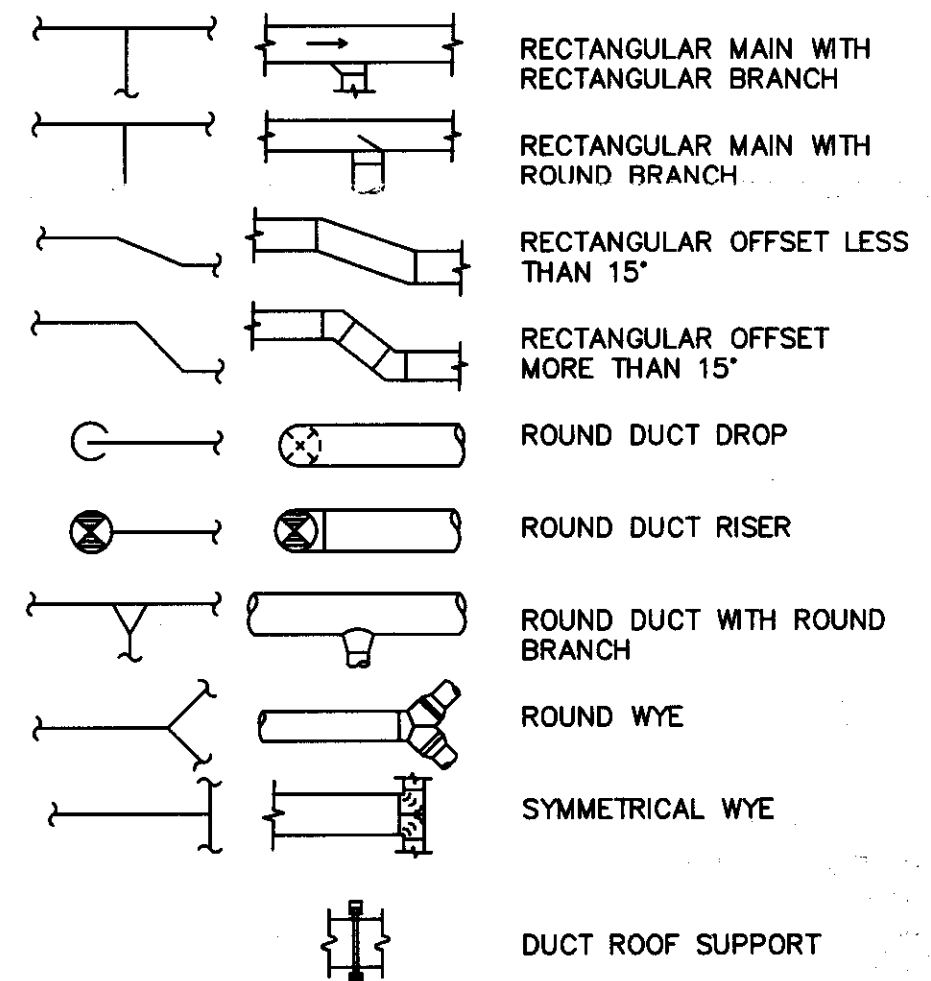

RFI 208 - NO SEISMIC BRACING REQUIRED FOR SUSPENDED PLUMBING PIPE, MECH PIPE AND HVAC

**GENERAL DEMOLITION NOTES**

- COORDINATE DEMOLITION AND CUTTING PATCHING WITH GENERAL CONTRACTOR, REVIEW AS-BUILT DRAWINGS AND SURVEY EXISTING FIELD CONDITIONS PRIOR TO SUBMITTING CONSTRUCTION CONTRACT BIDS. SEE SPECIFICATIONS GENERAL PROVISIONS, NOT ALL DUCT AND PIPING ARE ILLUSTRATED.
- REFER TO ARCHITECTURAL, STRUCTURAL, PLUMBING AND ELECTRICAL DRAWINGS FOR SPACE ALLOTMENT, BEAM LOCATION AND COORDINATION PURPOSES. CONFLICTS REGARDING SPACE REQUIREMENTS, CLEARANCES, INTERFERENCE WITH STRUCTURE OR OTHER WORK, ETC., SHALL BE DIRECTED TO THE ARCHITECT FOR RESOLUTION PRIOR TO INSTALLATION OF WORK.
- CUTTING, PATCHING AND PAINTING OF EXISTING WALLS, CEILING AND FLOOR TO ACCOMMODATE WORK AS SHOWN OR SPECIFIED HEREIN, SHALL BE INCLUDED IN THE WORK FOR EACH TRADE.
- VERIFY AND COORDINATE ALL CHILLED AND HEATING WATER PIPING CONNECTION BETWEEN EXISTING AND NEW. CONTRACTOR SHALL REMOVE/REPIPE EXISTING PIPING TO REMAIN AS REQUIRED TO MAINTAIN SERVICE.
- EXISTING DUCTS AND PIPING SERVING THE SECOND FLOOR SPACES ARE TO REMAIN.
- ALL BIDDERS ARE REQUIRED TO COLLECT ALL AS BUILTS INFORMATION, ATTEND THE PRE-BID SITE WALK TO UNDERSTAND THE SCOPE, OR THEY MAY SUBMIT PRE-BID RFI PRIOR TO BIDDING. UNFORSEEN CONDITION MAY ARISE DURING DEMOLITION. IN THE EVENT WHERE CONFLICTS ARISE, CONTRACTOR SHALL SUBMIT RFI FOR CLARIFICATION. FAILURE TO DO SO WILL RESULT NO ADDITIONAL COST TO THE OWNER.
- PROVIDE TEMPORARY HEATING & COOLING SERVING THE CHILDCARE CENTER FOR THE DURATION OF THE CONSTRUCTION & RELOCATING OF THE HYDRONIC HEATING & CHILLED WATER PIPING.

**GENERAL SEISMIC BRACING**

- ANCHORAGE OF ALL EQUIPMENT TO BE INSTALLED, AS A PART OF THIS PROJECT SHALL BE DETAILED ON THESE PLANS, EXCEPT FOR THE FOLLOWING:
  - EQUIPMENT WEIGHING LESS THAN 400 POUNDS SUPPORTED DIRECTLY ON THE FLOOR PLAN.
  - EQUIPMENT WEIGHING LESS THAN 20 POUNDS SUPPORTED BY VIBRATION ISOLATOR.
  - EQUIPMENT WEIGHING THAN 20 POUNDS SUSPENDED FROM A ROOF OR FLOOR OR HUNG FROM A WALL.
- REFERENCE: PERMANENT EQUIPMENT IN ITEMS 1, 2 AND 3 MUST BE SUPPORTED AND ANCHORED TO RESIST THE FORCES PRESCRIBED BY CHAPTER 13 OF ASCE 7-05 AS MODIFIED BY THE CBC 2010 SECTION 1613A / 1614A AND THE ANCHORAGE SHALL BE APPROVED BY THE APPROPRIATE DESIGN PROFESSIONAL OF RECORD AS A PART OF FIELD REVIEWS / OBSERVATIONS. THE INSPECTOR OF RECORD SHALL ASSURE THAT THE ABOVE REQUIREMENTS ARE ENFORCED.
- REFERENCE: CBC 2010 TITLE 24 PART 1 SECTION 7-125(C)(2)(L), 7-125(C)(3)(C), 7-125(C)(4)(M) AND 7-125(C)(5)(L)
- REFER TO STRUCTURAL DRAWINGS FOR CONCRETE ANCHOR TYPE AND INSTALLATION REQUIREMENTS.
- ALL PIPING AND CONDUIT CROSSING BUILDING SEISMIC SEPARATIONS SHALL BE PROVIDED WITH APPROVED FLEXIBLE CONNECTORS.
- A COPY OF THE BRACING SYSTEMS INSTALLATION MANUAL SHALL BE ON THE JOB SITE PRIOR TO STARTING THE INSTALLATION OF THE HANGERS AND/OR BRACES. SUBMIT APPLICABLE DETAILS FOR REVIEW AND APPROVAL.
- LATERAL SUPPORT FOR PIPES AND DUCTS SHALL COMPLY WITH THE REQUIREMENTS OF THE LATEST ADDITION OF THE "GUIDELINES FOR SEISMIC RESTRAINTS OF MECHANICAL SYSTEMS AND PLUMBING SYSTEMS" BY SMACNA.
- UNLESS THE STRUCTURAL DRAWINGS HAVE AN ENGINEERED SYSTEM, PIPING SHALL BE SUPPORTED AND BRACED WITH ONE OF THE FOLLOWING PRE-APPROVED SYSTEMS.
  - OPA - 0300 TOLCO SEISMIC RESTRAINT SYSTEM.
  - OPA-0349, MASON SEISMIC RESTRAINT GUIDELINES FOR MECHANICAL SYSTEMS AND PLUMBING SYSTEMS. OPA-0114, B-LINE SEISMIC RESTRAINT SYSTEM.
  - OPA-0125, NUSIG SEISMIC SUPPORT DEVICES.
- SEISMIC BRACING POINTS SHALL BE SUBMITTED ON CONTRACTOR'S COORDINATED SHOP DRAWINGS.
- ALL PRE-APPROVED MUST BE SATISFIED. IF DEVIATED FROM PRE-APPROVAL SCOPE, THE PRE-APPROVAL STATUS BECOMES INVALID FOR APPLICATION. DSA/IOB MAY CHOOSE TO COMMENT OR ACCEPT THE MODIFIED PORTIONS.
- CONTRACTOR TO SUBMIT WRITTEN CERTIFICATION, BY A STRUCTURAL OR CIVIL ENGINEER REGISTERED IN THE STATE OF CALIFORNIA THAT THE PIPING AND DUCTWORK IS INSTALLED IN COMPLIANCE WITH THE REQUIREMENTS OF THE 2010 CALIFORNIA BUILDING CODE.
- LAYOUT DRAWINGS, SHOWING THE BRACING/SUPPORT LOCATIONS AND REFERENCES TO DETAILS FROM THE RELEVANT DSA PRE-APPROVALS FOR PIPING/DUCTS/CONDUITS EXCEPT FIRE SPRINKLERS, NEED TO BE SUBMITTED FOR USE BY THE IOB FIELD STAFF. THE LAYOUT DRAWINGS, PREPARED PER SECTION 13.6, ASCE 7-05 AS AMENDED BY SECTION 1615A1.14, CBC 2010, NEED TO BE REVIEWED AND ACCEPTED BY THE IOB AND EOR (SE AND/OR ME/EE) PRIOR TO STARTING INSTALLATION OF THE BRACING/SUPPORT. IOB SHALL ENSURE THE ABOVE REQUIREMENTS ARE SATISFIED.
- A COPY OF THE CHOSEN BRACING SYSTEM(S) INSTALLATION GUIDE/MANUAL SHALL BE ON THE JOBSITE PRIOR TO STARTING THE INSTALLATION OF THE COMPONENT, EQUIPMENT, HANGERS AND/OR BRACES.

**GENERAL MECHANICAL NOTES**

- ALL NEW CONSTRUCTION SHALL CONFORM TO CURRENT CITY, STATE, AND NATIONAL CODES, STANDARDS, AND REQUIREMENTS.
- ALL MATERIALS AND WORKMANSHIP ARE SUBJECT TO APPROVAL BY OWNER. ANY DEFECTIVE WORK SHALL BE REPLACED BY THE CONTRACTOR AS PART OF THIS CONTRACT AT NO ADDITIONAL COST TO THE OWNER.
- ANY NEW OR EXISTING DUCT OR PIPING OFFSETS REQUIRED AS RESULT OF JOB CONDITIONS OR LACK OF COORDINATION WITH OTHER TRADES SHALL BE PROVIDED AT NO ADDITIONAL COST TO THE OWNER.
- CONTRACTOR SHALL PROVIDE DUCTWORK AND TRANSITION EQUAL TO DUCT FREE AREA OF DUCTWORK AS SHOWN ON DRAWINGS, TO PREVENT A CONFLICT WITH EXISTING CONDITIONS OR TO RESOLVE DUCTWORK CONFLICTS.
- PROVIDE MANUAL VOLUME DAMPERS TO FACILITATE PROPER BALANCE OF THE AIR DISTRIBUTION SYSTEM. VOLUME DAMPER AT DIFFUSERS AND REGISTERS SHALL NOT BE USED FOR AIR BALANCING.
- SEAL ALL OPENINGS AROUND PIPING AND DUCTWORK PENETRATING FIRE RESISTIVE RATED WALLS TO MAINTAIN RATING INTEGRITY.
- COORDINATE EXACT LOCATION OF CEILING, WALL OR FLOOR ACCESS PANELS FOR FIRE, SMOKE OR COMBINATION FIRE SMOKE DAMPERS AND VOLUME DAMPERS WITH ARCHITECT.
- COORDINATE EXACT LOCATION OF CORE DRILLING, CUTTING OF FLOOR SLAB, OR WALLS OF THE BUILDING WITH THE ARCHITECTURAL AND STRUCTURAL DRAWINGS.
- PROVIDE ACCESS DOOR FOR ALL EQUIPMENT, VALVES AND CLEANOUTS WHICH REQUIRE ACCESS FOR ADJUSTMENT OR SERVICING, AND WHICH ARE LOCATED IN OTHERWISE INACCESSIBLE LOCATIONS. OPENINGS SHALL BE LARGE ENOUGH TO PERMIT MAINTENANCE AND ADJUSTMENT OF THE DEVICE.
- DUCTS STORED ON THE CONSTRUCTION SITE SHALL BE PROTECTED AND ISOLATED FROM DUST CONTAMINATION.
- PITCH PIPELINES AS REQUIRED FOR PROPER DRAINAGE AND ELIMINATION OF AIR.
- PROVIDE CONDENSATE DRAIN PIPING WITH DRAINAGE AND CLEANOUT FITTINGS FOR ALL COOLING COILS AND ROUTE TO A NEAREST APPROVED RECEPTOR.
- THE PROJECT DESIGN SHOWN ON THE DRAWINGS AND SPECIFIC ITEMS REFERENCED IN THE SPECIFICATIONS IS IN COMPLIANCE WITH THE CODES AND ORDINANCES LISTED IN DIVISION 23 SPECIFICATIONS.
- COORDINATE SEISMIC ANCHORAGE AND BRACING FOR MECHANICAL EQUIPMENT, PIPING AND DUCTWORK. SEE "GENERAL SEISMIC NOTES" FOR DETAIL REQUIREMENTS.
- COORDINATE WITH DIVISION 26 CONTRACTOR FOR LOCATION OF POWER AND LOCAL DISCONNECTS FOR MECHANICAL EQUIPMENT DEVICES.
- INSTALL ALL EQUIPMENT AND MATERIALS IN ACCORDANCE WITH MANUFACTURER RECOMMENDATIONS UNLESS SPECIFICALLY INDICATED OTHERWISE OR WHERE THE LOCAL CODES OR REGULATIONS TAKE PRECEDENCE.
- DRAWINGS ARE DIAGRAMMATIC IN NATURE AND EXISTING CONDITIONS SHALL BE FIELD VERIFIED FOR EXACT LOCATION AND SIZES OF EXISTING UTILITIES. THE PROPOSED POINT OF CONNECTIONS TO EXISTING SYSTEMS, AND NEW ROUTINGS, THE CONTRACTOR IS RESPONSIBLE TO THOROUGHLY VERIFY ALL EXISTING CONDITIONS BEFORE SUBMITTING BID.
- KEEP CUTTING TO THE MINIMUM REQUIRED FOR PROPER EXECUTION OF WORK. BE RESPONSIBLE FOR ALL CUTTING AND PATCHING NECESSARY FOR THE COMPLETION OF WORK. NO CUTTING SHALL BE PERFORMED WITHOUT THE APPROVAL OF THE ARCHITECT.
- PROVIDE OFFSETS, ELBOWS AND TRANSITIONS IN DUCTWORK AND PIPING AS REQUIRED AT NO ADDITIONAL COST TO THE OWNER.
- VERIFY ALL CONNECTIONS WITH MANUFACTURER'S CERTIFIED DRAWINGS. PROVIDE TRANSITIONS FOR FINAL CONNECTION TO EQUIPMENT. FIELD VERIFY ALL DIMENSIONS PRIOR TO FABRICATION OF WORK.
- VERIFY DIFFUSERS, GRILLES, AND REGISTER MOUNTING FRAME TYPES WITH CEILING TYPE AND CONFIGURATION.
- PROVIDE DUCT ACCESS DOORS FOR ALL DUCTS AS REQUIRED BY DISTRICT STANDARDS.
- PROVIDE HANGER, SUPPORT AND SWAY BRACES FOR ALL DUCTWORK AND EQUIPMENT AS REQUIRED BY THE LATEST EDITION OF THE SMACNA GUIDELINES.
- DUCT SYSTEMS SHALL BE BALANCED TO CFM ON DRAWINGS. FANS SHALL BE FIELD TESTED TO ENSURE COMPLIANCE WITH SCHEDULED FAN PERFORMANCE, AIR FLOW AT DESIGN STATIC PRESSURE.
- ALL WORK AND MATERIALS SHALL BE IN COMPLIANCE WITH THE SPECIFICATIONS IN THE EVENT OF A CONFLICT BETWEEN THE CONTRACT DRAWINGS AND THE SPECIFICATIONS, THE MOST STRINGENT SHALL GOVERN.
- INSTALL ALL PIPING AND DUCTWORK TO BEST SUIT FIELD CONDITIONS AND COORDINATE WITH OTHER TRADES. THE DRAWINGS ARE DIAGRAMMATIC, AND SHALL NOT BE SCALED TO DETERMINE THE EXACT LOCATIONS OF THE PIPING OR DUCTWORK.
- CONTRACTOR SHALL FIELD-VERIFY EXISTING CONDITIONS AND SHALL REPORT ANY DISCREPANCIES AND/OR INCONSISTENCIES BETWEEN THE DRAWINGS AND EXISTING CONDITIONS TO THE ENGINEER BEFORE COMMENCEMENT OF WORK.
- CONTRACTOR SHALL BE RESPONSIBLE FOR SECURING ALL TRADE PERMITS AND INSPECTIONS.
- CONTRACTOR SHALL PROVIDE ALL MATERIALS, LABOR, AND EQUIPMENT TO COMPLETE WORK AS SET FORTH IN THESE PLANS UNLESS OTHERWISE NOTED. THE SUBMISSION OF A BID OR PROPOSAL SHALL BE CONSIDERED AS CONCLUSIVE EVIDENCE THAT THE CONTRACTOR IS THOROUGHLY FAMILIAR WITH THE INTENT OF THE CONTRACT DOCUMENTS, AND NO CHANGE ORDER WILL BE ISSUED FOR ANY ADDITIONAL LABOR OR MATERIAL REQUIRED TO RECTIFY ANY DISCREPANCY DISCOVERED OR REPORTED TO THE ENGINEER AFTER THE EXECUTION OF CONTRACT.
- "PROVIDE ACOUSTICAL INTERNAL DUCT LINING WHERE SHOWN ON PLANS OR INDICATED IN SPECIFICATIONS."
- MINIMUM ALLOWABLE FOR END RUNS HYDRONIC PIPING ARE GENERALLY SIZED AT 2" FOR VAV TERMINAL.
- COORDINATION DOCUMENTS FOR ALL DIVISION 15 AND 16 TRADES SHALL BE SUBMITTED AND SIGNED OFF BY ALL TRADES. NO SHOP DRAWINGS SHALL BE REVIEWED BY AOR AND ENGINEERS UNLESS COORDINATION DOCUMENTS ARE SIGNED OFF.

CONTRACTOR TO REVIEW REQUIREMENTS FOR COORDINATION DRAWINGS IN DIVISION 1, 15, AND 16 SECTIONS. PROVIDE ADEQUATE TIME IN SCHEDULE TO ASSESS SITE CONDITIONS IN FIELD, ATTEND MEETINGS, CREATE COORDINATION DOCUMENTATION AS SPECIFIED, AND ALLOW FOR FOUR WEEKS OF REVIEW PERIOD AFTER SUBMISSION OF FINAL COORDINATION DOCUMENTS. INSTALLATION OF SYSTEMS AND EQUIPMENT WILL NOT BE ALLOWED UNTIL COORDINATION DOCUMENTS ARE REVIEWED BY ARCHITECT.

**DSA STRUCTURAL ANCHORAGE COORDINATION SHEET**

EQUIPMENT TAG	EQUIPMENT DESCRIPTION	INTERFACE PLAN DRAWING	INTERFACE SCHEDULE DRAWING	INTERFACE DETAIL DRAWING	STRUCTURAL DETAIL (SUPPORT)	ARCHITECTURAL DETAIL (SUPPORT)	REMARKS
AHU-1 THRU AHU-7	AIR HANDLING UNITS	M-2.3	---	---	---	---	
CHWP-1 & HWP-1	CHILLED & HEATING WATER PUMP	M-2.3	---	---	---	---	
AC-1	WALL MOUNTED DUCTLESS SPLIT SYSTEM	M-2.1A	---	---	---	---	
CU-1	ROOF MOUNTED CONDENSING UNIT	M-2.3	---	---	---	---	
EF-1, EF-2, EF-3, EF-4	ROOF MOUNTED EXHAUST FAN	M-2.2	---	---	---	---	
VAV-2-xx TO VAV-7-xx	CEILING HUNG VAV TERMINAL UNITS	M-2.1B, M-2.2B	---	---	---	---	

NOTES:  
PROVIDE SEISMIC CALCULATIONS AND DETAILS, SIGNED AND SEALED BY CALIFORNIA REGISTERED STRUCTURAL ENGINEER.  
NO CUTTING OR DAMAGING OF EXISTING CONCRETE WAFFLE.

**SHEET INDEX**

M-0.1	MECHANICAL SYMBOL LIST & GENERAL NOTES
M-0.2	TITLE 24 - ENERGY COMPLIANCE FORMS
M-0.3	TITLE 24 - ENERGY COMPLIANCE FORMS
M-0.4	TITLE 24 - ENERGY COMPLIANCE FORMS
M-0.5	TITLE 24 - ENERGY COMPLIANCE FORMS
MD-1.1	SS3 LOWER LEVEL DEMO PLAN - MECHANICAL
MD-1.2	SS4 UPPER LEVEL DEMO PLAN - MECHANICAL
MD-1.3	ROOF DEMOLITION PLAN - MECHANICAL
M-2.1A	SS3 LOWER LEVEL FLOOR PLAN - HVAC DUCTWORK
M-2.1B	SS3 LOWER LVL. FLR PLAN - HVAC REHEAT PIPING
M-2.2A	SS4 UPPER LEVEL FLOOR PLAN - HVAC DUCTWORK
M-2.2B	SS4 UPPER LVL. FLR PLAN - HVAC REHEAT PIPING
M-2.3	ROOF PLAN - MECHANICAL
M-3.1	MECHANICAL DETAILS
M-3.2	MECHANICAL DETAILS
M-3.3	MECHANICAL DETAILS
M-4.1	MECHANICAL SCHEDULES
M-4.2	MECHANICAL SCHEDULES
M-5.1	HYDRONIC PIPING DIAGRAM
M-5.2	AIR FLOW DIAGRAM
M-6.1	MECHANICAL CONTROL DIAGRAM
M-6.2	MECHANICAL CONTROL DIAGRAM
M-6.3	MECHANICAL CONTROL DIAGRAM

**tBP**  
architecture  
planning  
interiors  
management

1887 Architecture  
1000 Burnett Avenue Suite 140  
Concord, CA 94520  
ph: 925.246.6495  
fx: 925.246.6495

architect

**INTERFACE ENGINEERING**

PROJECT: 2008.0108  
CONTRACT: Shannon Wilson

777 Market Street  
Suite 300  
San Francisco, CA 94103  
Tel: 415.489.7242  
Fax: 415.489.7258  
www.interfaceengineering.com

consultant

**RE-FCI**  
REGISTERED CIVIL ENGINEER  
DIVISION OF THE STATE ARCHITECTS  
OFFICE OF REGULATION SERVICES

APPL 01-17277  
DATE JUL 31 2012

name  
address  
city, state, zip  
ph.  
agency

**L-612 STUDENT SERVICES CENTER REMODEL COLLEGE COMPLEX**  
BID DOCUMENTS

LOS MEDANOS COLLEGE  
2700 EAST LELAND DRIVE  
PITTSBURG, CA 94565

owner

tBP project number: 20810100

file name: 0106M01.dwg

drawn by: GE checked by: BC

date: JULY 31, 2012

Rev. date: description:

drawing title:  
**MECHANICAL SYMBOL LIST & GENERAL NOTES**

drawing no:  
**M-01**  
drawing of

THIS DRAWING AND THE ORIGINAL, REVISIONS, IDEAS AND OTHER INFORMATION CONTAINED HEREIN CONSTITUTE UNPUBLISHED WORKS OF BBP/ARCHITECTURE AND SHALL REMAIN THE PROPERTY OF BBP/ARCHITECTURE AND BE REPRODUCED, COPIED, DISTRIBUTED, SOLD, RENTED OR OTHERWISE USED IN ANY WAY WITHOUT THE ADVANCED EXPRESS WRITTEN CONSENT OF BBP/ARCHITECTURE.

ENVELOPE MANDATORY MEASURES: NONRESIDENTIAL ENV-MM

Project Name: LMCC L-612 Student Services Center Remodel Date: 09/30/2011

DESCRIPTION

- 5118(a): Installed insulating material shall have been certified by the manufacturer to comply with the California Quality Standards for Insulating Material, Title 20 Chapter 4, Article 3.
5118(b): All resulting Materials shall be installed in compliance with the flame spread rating and smoke density requirements of Sections 2002 and 707 of Title 24, Part 2.
5117(a): The opaque portions of framed demising walls in nonresidential buildings shall have insulation with an installed R-value of no less than R-13 between framing members.
5117(a): All exterior joints and openings in the building that are observable sources of air leakage shall be caulked, gasketed, weatherstripped or otherwise sealed.
5116(a): Manufactured fenestration products and exterior doors shall have air infiltration rates not exceeding 0.3 cfm/ft^2 of window area, 0.3 cfm/ft^2 of door area for residential doors, 0.3 cfm/ft^2 of door area for nonresidential single doors (swing-in and swing-out), and 1.0 cfm/ft^2 for nonresidential double doors (swing-in).

5116(a) 2: Fenestration U-factor shall be rated in accordance with NFRC 100, or the applicable default U-factor.
5116(a) 3: Fenestration SHGC shall be rated in accordance with NFRC 200, or NFRC 100 for site-built fenestration, or the applicable default SHGC.
5116(b): Site Constructed Doors, Windows and Skylights shall be caulked between the unit and the building, and shall be weatherstripped (except for unframed glass doors and fire doors).

Run Infiltration Time: 30-Sep-2011 @ 11:27:23 AM Run Code: 1317407310

PERFORMANCE CERTIFICATE OF COMPLIANCE (Part 2 of 3) PERF-1

Project Name: LMCC L-612 Student Services Center Remodel Date: 30-Sep-2011

ANNUAL TDV ENERGY USE SUMMARY (per ASHRAE 90.1)

Table with columns: ENERGY COMPONENT, Standard Design, Proposed Design, Compliance Margin. Rows include Space Heating, Space Cooling, Indoor Fans, Heat Rejection, Pumps, Domestic Hot Water, Lighting, Receptacle, Process, Exterior Usage.

BUILDING CLIMATES

Table with columns: Building Orientation, Number of Stories, Number of Systems, Number of Zones, Conditioned, Unconditioned, Plenum.

Table with columns: Orientation, Gross Area, Glazing Area, Glazing Ratio. Rows include Front Elevation, Left Elevation, Rear Elevation, Right Elevation, Total, Roof.

Run Infiltration Time: 30-Sep-2011 @ 11:27:23 AM Run Code: 1317407310

ENVELOPE COMPLIANCE SUMMARY Performance (part 1 of 2) ENV-1C

Project Name: LMCC L-612 Student Services Center Remodel Date: 30-Sep-2011

OPAQUE SURFACES

Table with columns: #, Surface Type, Appendix J(A) Reference, Area, U-Factor, A1, T8, Status, Location (Space). Lists various opaque surfaces like roof, above grade walls, and below grade walls.

Run Infiltration Time: 30-Sep-2011 @ 11:27:23 AM Run Code: 1317407310

ENVELOPE COMPLIANCE SUMMARY Performance (part 1 of 2) ENV-1C

Project Name: LMCC L-612 Student Services Center Remodel Date: 30-Sep-2011

VERTICAL FENESTRATION SURFACES WITH NFRC U-FACTORS

Table with columns: #, Fenestration Type, Area (ft^2), U-Factor, Astm, SHGC, Glazing Type, Location (Space). Lists vertical fenestration surfaces with NFRC ratings.

VERTICAL FENESTRATION EXTERIOR SHADING

Table with columns: Fen #, Exterior Space, Window, Overhang, Left Fin, Right Fin. Lists exterior shading details for various fenestration types.

Run Infiltration Time: 30-Sep-2011 @ 11:27:23 AM Run Code: 1317407310

PERFORMANCE CERTIFICATE OF COMPLIANCE (Part 1 of 3) PERF-1

Project Name: LMCC L-612 Student Services Center Remodel Date: 30-Sep-2011

Project Address: 2700 East Leland Dr. Pittsburg, CA 94565

GENERAL INFORMATION

Form with fields for Building Type (Nonresidential), Phase of Construction (Alteration), and other project details.

STATEMENT OF COMPLIANCE

This Certificate of Compliance with the building features and performance specifications needed to comply with Title 24, Part 1 and 8 of the State Building Code. This certificate applies only to the building under the performance compliance approach.

ENV. LTD. MEAS.

1. I hereby affirm that I am eligible under the provisions of Division 3 of the Business and Professions Code to sign this document as the person responsible for its preparation and that I am licensed in the State of California as a civil engineer, mechanical engineer or architect.

ENVELOPE COMPLIANCE

Indicate location on plans of Note Block for Mandatory Measures: Required Forms: ENV-1C, ENV-3C. Signatures: [Signature]

LIGHTING COMPLIANCE

Indicate location on plans of Note Block for Mandatory Measures: Required Forms: LTC-1C, LTC-2C. Signatures: [Signature]

MECHANICAL COMPLIANCE

Indicate location on plans of Note Block for Mandatory Measures: Required Forms: MECH-1C, MECH-2C, MECH-3C, MECH-5C. Signatures: [Signature]

Run Infiltration Time: 30-Sep-2011 @ 11:27:23 AM Run Code: 1317407310

ENVELOPE COMPLIANCE SUMMARY Performance (part 1 of 2) ENV-1C

Project Name: LMCC L-612 Student Services Center Remodel Date: 30-Sep-2011

OPAQUE SURFACES

Table with columns: #, Surface Type, Appendix J(A) Reference, Area, U-Factor, A1, T8, Status, Location (Space). Lists opaque surfaces for this project.

Run Infiltration Time: 30-Sep-2011 @ 11:27:23 AM Run Code: 1317407310

ENVELOPE COMPLIANCE SUMMARY Performance (part 1 of 2) ENV-1C

Project Name: LMCC L-612 Student Services Center Remodel Date: 30-Sep-2011

OPAQUE SURFACES

Table with columns: #, Surface Type, Appendix J(A) Reference, Area, U-Factor, A1, T8, Status, Location (Space). Lists opaque surfaces for this project.

VERTICAL FENESTRATION SURFACES WITH NFRC U-FACTORS

Table with columns: #, Fenestration Type, Area (ft^2), U-Factor, Astm, SHGC, Glazing Type, Location (Space). Lists vertical fenestration surfaces with NFRC ratings.

Run Infiltration Time: 30-Sep-2011 @ 11:27:23 AM Run Code: 1317407310


ENVELOPE COMPLIANCE SUMMARY Performance (part 1 of 2) ENV-1C

Project Name: LMCC L-612 Student Services Center Remodel Date: 30-Sep-2011


VERTICAL FENESTRATION EXTERIOR SHADING

Table with columns: Fen #, Exterior Space, Window, Overhang, Left Fin, Right Fin. Lists exterior shading details for various fenestration types.

Run Infiltration Time: 30-Sep-2011 @ 11:27:23 AM Run Code: 1317407310

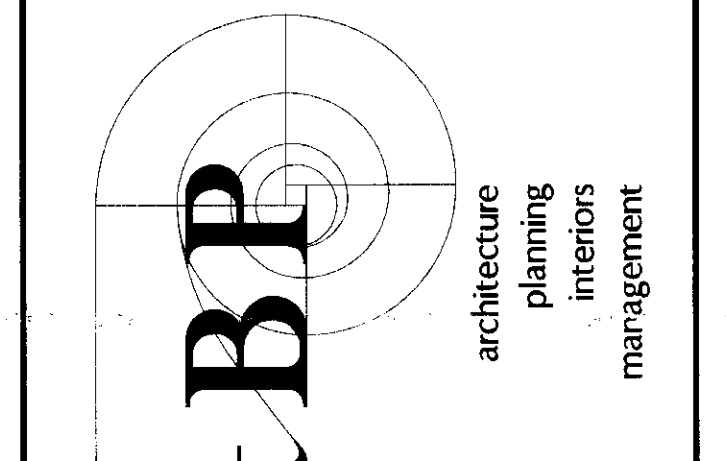

architecture
planning
interiors
management
1000 Burnett Avenue Suite 140
Concord, CA 94520
ph: 925.246.6495
fax: 925.246.6495

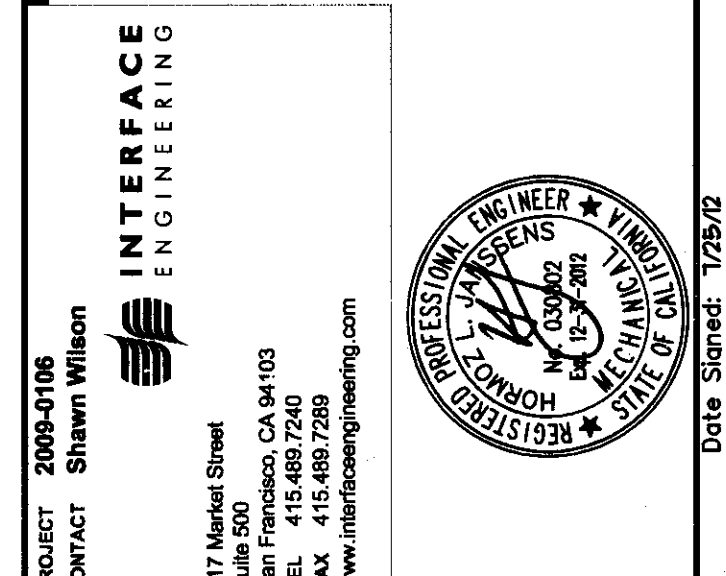

INTERFACE
ENGINEERING
777 Market Street
San Francisco, CA 94103
APPL 01/17/27
DATE: JUL 3 2012

PROJECT CONTACT: Shawn Wilson
CONSULTANT: name, address, city, state, zip, ph, agency

L-612 STUDENT SERVICES CENTER REMODEL COLLEGE COMPLEX
LOS MEDANOS COLLEGE
2700 EAST LELAND DRIVE
PITTSBURG, CA 94565

tBP project number: 2061020
file name: C:\06M02.dwg
drawn by: HP checked by: BC
date: JULY 31, 2012
Rev. date: description:

THIS DRAWING AND THE DESIGN, CALCULATIONS, SEALS AND OTHER INFORMATION CONTAINED HEREIN CONSTITUTE UNPUBLISHED WORK OF INTERFERING ENGINEERS AND SHALL REMAIN THE PROPERTY OF INTERFERING ENGINEERS. IF REPRODUCED IN ANY MANNER WITHOUT THE WRITTEN CONSENT OF INTERFERING ENGINEERS, THE REPRODUCER SHALL BE RESPONSIBLE FOR ALL DAMAGES AND LOSSES INCURRED BY THE REPRODUCER.

drawing title: TITLE 24 - ENERGY COMPLIANCE FORMS
drawing no: M-02

**ENVELOPE COMPLIANCE SUMMARY Performance (part 1 of 2) ENV-1C**

Project Name: LMCC L-612 Student Service Center Remodel Date: 30-Sep-2011

**OVERHEAD FENESTRATION SURFACES WITH NFRC U-FACTORS**

#	Fenestration Type	Area (ft²)	U-Factor	Ashmun	SHGC	Coating Type	Location (Space)
1	Mfg Skylt, MB w/ Bk	160	0.400	180	0.38	NFRC Progs. 6 Spc. w/Trt	F27
2	Mfg Skylt, MB w/ Bk	160	0.400	180	0.38	NFRC Progs. 6 Spc. w/Trt	F28
3	Mfg Skylt, MB w/ Bk	96	0.400	180	0.38	NFRC Progs. 6 Spc. w/Trt	M10
4	Mfg Skylt, MB w/ Bk	96	0.400	180	0.38	NFRC Progs. 6 Spc. w/Trt	M10
5	Mfg Skylt, MB w/ Bk	96	0.400	180	0.38	NFRC Progs. 6 Spc. w/Trt	M23
6	Mfg Skylt, MB w/ Bk	96	0.400	180	0.38	NFRC Progs. 6 Spc. w/Trt	M23
7	Mfg Skylt, MB w/ Bk	192	0.400	0	0.38	NFRC Progs. 6 Spc. w/Trt	M29
8	Mfg Skylt, MB w/ Bk	192	0.390	90	0.37	NFRC Progs. 6 Spc. w/Trt	M29

**OVERHEAD FENESTRATION EXTERIOR SHADING**

Fan #	Exterior Shade Type	Window			Overhang			Left Fin			Right Fin					
		Height	Width	Depth	Width	LEXT	REXT	Depth	Height	TEXT	REXT	Depth	Height	TEXT	REXT	
1	T24 Default	8.0	8.0	-	-	-	-	-	-	-	-	-	-	-	-	-
2	T24 Default	8.0	4.8	-	-	-	-	-	-	-	-	-	-	-	-	-
3	T24 Default	8.0	4.0	-	-	-	-	-	-	-	-	-	-	-	-	-
4	T24 Default	8.0	7.2	-	-	-	-	-	-	-	-	-	-	-	-	-
5	T24 Default	8.0	7.2	-	-	-	-	-	-	-	-	-	-	-	-	-
6	T24 Default	8.0	11.0	-	-	-	-	-	-	-	-	-	-	-	-	-
7	T24 Default	8.0	4.0	-	-	-	-	-	-	-	-	-	-	-	-	-
8	T24 Default	8.0	11.0	-	-	-	-	-	-	-	-	-	-	-	-	-
9	T24 Default	8.0	11.0	-	-	-	-	-	-	-	-	-	-	-	-	-
10	T24 Default	8.0	11.0	-	-	-	-	-	-	-	-	-	-	-	-	-
11	T24 Default	8.0	4.8	-	-	-	-	-	-	-	-	-	-	-	-	-
12	T24 Default	7.0	8.0	-	-	-	-	-	-	-	-	-	-	-	-	-
13	T24 Default	9.5	28.0	-	-	-	-	-	-	-	-	-	-	-	-	-
14	T24 Default	8.5	11.0	-	-	-	-	-	-	-	-	-	-	-	-	-
15	T24 Default	8.0	8.0	-	-	-	-	-	-	-	-	-	-	-	-	-
16	T24 Default	8.0	4.0	-	-	-	-	-	-	-	-	-	-	-	-	-
17	T24 Default	8.5	8.4	-	-	-	-	-	-	-	-	-	-	-	-	-
18	T24 Default	8.0	21.0	-	-	-	-	-	-	-	-	-	-	-	-	-
19	Fixed Interior	18.0	10.0	-	-	-	-	-	-	-	-	-	-	-	-	-
20	Fixed Interior	16.0	10.0	-	-	-	-	-	-	-	-	-	-	-	-	-
21	T24 Default	8.0	8.0	-	-	-	-	-	-	-	-	-	-	-	-	-
22	T24 Default	8.0	4.0	-	-	-	-	-	-	-	-	-	-	-	-	-
23	T24 Default	8.0	7.0	-	-	-	-	-	-	-	-	-	-	-	-	-
24	T24 Default	8.0	3.0	-	-	-	-	-	-	-	-	-	-	-	-	-
25	T24 Default	8.0	20.0	-	-	-	-	-	-	-	-	-	-	-	-	-
26	T24 Default	8.0	23.5	8.4	23.5	0.0	0.0	-	-	-	-	-	-	-	-	-
27	T24 Default	8.5	22.0	-	-	-	-	-	-	-	-	-	-	-	-	-
28	T24 Default	8.5	8.2	-	-	-	-	-	-	-	-	-	-	-	-	-
29	T24 Default	8.5	22.0	-	-	-	-	-	-	-	-	-	-	-	-	-
30	T24 Default	8.5	9.0	-	-	-	-	-	-	-	-	-	-	-	-	-
31	T24 Default	8.5	9.0	-	-	-	-	-	-	-	-	-	-	-	-	-
32	T24 Default	8.5	9.0	-	-	-	-	-	-	-	-	-	-	-	-	-
33	T24 Default	8.5	9.0	-	-	-	-	-	-	-	-	-	-	-	-	-
34	Fixed Interior	8.0	12.0	-	-	-	-	-	-	-	-	-	-	-	-	-

Run Initiation Time: 30-Sep-2011 @ 11:27:23 AM Run Code: 1317407310  
 eQUEST 3.84 using DOEComp3.84 / DOE 2.2-7-78 Page 14 of 40

**ENVELOPE COMPLIANCE SUMMARY Performance (part 2 of 2) ENV-1C**

Project Name: LMCC L-612 Student Service Center Remodel Date: 30-Sep-2011

**Required Acceptance Tests:**  
**Designer:**  
 This form is to be used by the designer and attached to the plans. Listed below is the acceptance test for Envelope Fenestrations system. The designer is required to check the acceptance tests and list all the fenestration products that require an acceptance test. If the site-built fenestration of a certain type requires a test, list the different fenestration products and the number of systems. The NA# Section in the Appendix of the Nonresidential Reference Appendices Manual describes the test. Since this form will be part of the plans, completion of this section will allow the responsible party to budget for the scope of work appropriately.

**Enforcement Agency:**  
 Systems Acceptance: Before Occupancy Permit is granted for a newly constructed building or space or when ever new fenestration is installed in the building or space shall be certified as meeting the Acceptance Requirements. The ENV-2A form is not considered a complete form and is not to be accepted by the enforcement agency unless the boxes are checked and/or filled and signed. In addition, a Certificate of Acceptance forms shall be submitted to the enforcement agency that certifies plans, specifications, installation certificates, and operating and maintenance information meet the requirements of §10-120(b) of Title 24 Part 6. The field inspector must receive the properly filled out and signed forms before the building can receive final occupancy. A copy of the ENV-2A for each different fenestration product line must be provided to the owner of the building for their records.

**FENESTRATION ACCEPTANCE TABLE**

Test Description	ENV-2A	Test Performed By
Fenestration Products Name or ID Requiring Testing or Verification	Number of Line Products Building Envelope Acceptance Test	

Run Initiation Time: 30-Sep-2011 @ 11:27:23 AM Run Code: 1317407310  
 eQUEST 3.84 using DOEComp3.84 / DOE 2.2-7-78 Page 15 of 40

**ENVELOPE COMPLIANCE SUMMARY Performance (part 1 of 2) ENV-1C**

Project Name: LMCC L-612 Student Service Center Remodel Date: 30-Sep-2011

**OVERHEAD FENESTRATION EXTERIOR SHADING**

Fan #	Exterior Shade Type	Window			Overhang			Left Fin			Right Fin					
		Height	Width	Depth	Width	LEXT	REXT	Depth	Height	TEXT	REXT	Depth	Height	TEXT	REXT	
35	Fixed Interior	8.0	12.0	-	-	-	-	-	-	-	-	-	-	-	-	-
36	T24 Default	6.5	8.0	-	-	-	-	-	-	-	-	-	-	-	-	-
37	T24 Default	6.5	9.0	-	-	-	-	-	-	-	-	-	-	-	-	-
38	T24 Default	6.5	9.0	-	-	-	-	-	-	-	-	-	-	-	-	-
39	T24 Default	6.5	9.0	-	-	-	-	-	-	-	-	-	-	-	-	-
40	T24 Default	12.5	8.5	-	-	-	-	-	-	-	-	-	-	-	-	-
41	T24 Default	12.5	7.8	-	-	-	-	-	-	-	-	-	-	-	-	-
42	T24 Default	12.5	9.3	-	-	-	-	-	-	-	-	-	-	-	-	-
43	T24 Default	12.5	5.8	-	-	-	-	-	-	-	-	-	-	-	-	-
44	T24 Default	12.5	3.3	-	-	-	-	-	-	-	-	-	-	-	-	-
45	T24 Default	6.5	7.3	-	-	-	-	-	-	-	-	-	-	-	-	-
46	T24 Default	6.5	9.3	-	-	-	-	-	-	-	-	-	-	-	-	-
47	T24 Default	6.5	9.0	-	-	-	-	-	-	-	-	-	-	-	-	-
48	T24 Default	6.5	7.3	-	-	-	-	-	-	-	-	-	-	-	-	-
49	T24 Default	7.0	13.0	-	-	-	-	-	-	-	-	-	-	-	-	-
50	T24 Default	6.5	4.8	-	-	-	-	-	-	-	-	-	-	-	-	-
51	T24 Default	7.0	17.0	-	-	-	-	-	-	-	-	-	-	-	-	-
52	Fixed Interior	8.0	12.0	-	-	-	-	-	-	-	-	-	-	-	-	-
53	Fixed Interior	8.0	12.0	-	-	-	-	-	-	-	-	-	-	-	-	-
54	T24 Default	6.5	3.0	-	-	-	-	-	-	-	-	-	-	-	-	-
55	T24 Default	6.5	7.0	-	-	-	-	-	-	-	-	-	-	-	-	-
56	T24 Default	7.0	9.2	-	-	-	-	-	-	-	-	-	-	-	-	-
57	Fixed Interior	12.0	16.0	-	-	-	-	-	-	-	-	-	-	-	-	-
58	Fixed Interior	16.0	12.0	-	-	-	-	-	-	-	-	-	-	-	-	-
59	T24 Default	10.0	28.0	-	-	-	-	-	-	-	-	-	-	-	-	-
60	T24 Default	9.0	4.0	-	-	-	-	-	-	-	-	-	-	-	-	-
61	T24 Default	9.0	11.0	-	-	-	-	-	-	-	-	-	-	-	-	-
62	T24 Default	9.0	17.8	-	-	-	-	-	-	-	-	-	-	-	-	-
63	T24 Default	12.0	20.0	-	-	-	-	-	-	-	-	-	-	-	-	-

Run Initiation Time: 30-Sep-2011 @ 11:27:23 AM Run Code: 1317407310  
 eQUEST 3.84 using DOEComp3.84 / DOE 2.2-7-78 Page 15 of 40

**MECHANICAL MANDATORY MEASURES: NONRESIDENTIAL MECH-MM**

Project Name: LMCC L-612 Student Services Center Remodel Date: 09/30/2011

**Equipment and System Efficiencies**  
 §111: Any appliance for which there is a California standard established in the Appliance Efficiency Regulations will comply with the applicable standard.  
 §115(a): Fan type central furnaces shall not have a pilot light.  
 §123: Piping, except that conveying fluids at temperatures between 80 and 100 degrees Fahrenheit, or within HVAC equipment, shall be insulated in accordance with Standards Section 123.  
 §124: Air handling duct systems shall be installed and insulated in compliance with Sections 601, 602, 603, 604, and 605 of the CMC Standards.

**Controls**  
 §122(a): Each space conditioning system shall be installed with one of the following:  
 1A. Each space conditioning system serving building types such as offices and manufacturing facilities (and all others not explicitly exempt from the requirements of Section 112 (d)) shall be installed with an automatic time switch with an accessible manual override that allows operation of the system during off-hours for up to 4 hours. The time switch shall be capable of programming different schedules for weekdays and weekends and have program backup capabilities that prevent the loss of the device's program and time setting for at least 10 hours if power is interrupted; or  
 1B. An occupancy sensor to control the operating period of the system; or  
 1C. A 4-hour timer that can be manually operated to control the operating period of the system.  
 2. Each space conditioning system shall be installed with controls that temporarily restrict and temporarily operate the system as required to maintain a setback heating and/or a setback cooling thermostat setpoint.  
 Each space conditioning system serving multiple zones with a combined conditioned floor area more than 25,000 square feet shall be provided with isolation zones. Each zone shall not exceed 25,000 square feet, shall be provided with isolation devices, such as valves or dampers that allow the supply of heating or cooling to be setback or shut off independently of other isolation areas, and shall be controlled by a time control device as described above.

§122(b): Thermostats shall have numeric setpoints in degrees Fahrenheit (F) and adjustable setpoint stops accessible only to authorized personnel.  
 §122(b): Heat pumps shall be installed with controls to prevent electric resistance supplementary heater operation when the heating load can be met by the heat pump alone.  
 §122(b): Each space conditioning system shall be controlled by an individual thermostat that responds to temperature within the zone. Where used to control heating, the control shall be adjustable down to 55 degrees F or lower. For cooling, the control shall be adjustable up to 85 degrees F or higher. Where used for both heating and cooling, the control shall be capable of providing a deadband of at least 5 degrees F within which the supply of heating and cooling is shut off or reduced to a minimum.

**Ventilation**  
 §121(a): Controls shall be provided to allow outside air dampers or devices to be operated at the ventilation rates as specified on these plans.  
 §122(i): All gravity ventilating systems shall be provided with automatic or readily accessible manually operated dampers in all openings to the outside, except for combustion air openings.  
 §121(i): Ventilation System Acceptance: Before an occupancy permit is granted for a newly constructed building or space, or a new ventilating system serving a building or space is operated for normal use, all ventilation systems serving the building or space shall be certified as meeting the Acceptance Requirements for Code Compliance.

**Service Water Heating Systems**  
 §113(c) Installation  
 3. Temperature controls for public lavatories. The controls shall limit the outlet temperature to 110°F.  
 2. Circulating service water-heating systems shall have a control capable of automatically turning off the circulating pump when hot water is not required.

Run Initiation Time: 30-Sep-2011 @ 11:27:23 AM Run Code: 1317407310  
 eQUEST 3.84 using DOEComp3.84 / DOE 2.2-7-78 Page 3 of 3

**PERFORMANCE CERTIFICATE OF COMPLIANCE (Part 2 of 3) PERF-1**

Project Name: LMCC L-612 Student Service Center Remodel Date: 30-Sep-2011

**ANNUAL TDV ENERGY USE SUMMARY (REV-4/8/09)**

ENERGY COMPONENT	Standard Energy	Proposed Energy	Compliance Margin
Space Heating	10.18	9.84	0.34
Space Cooling	71.53	63.00	8.52
Indoor Fans	108.79	56.95	49.94
Heat Rejection	0.00	3.91	-3.91
Pumps	1.84	14.79	-12.95
Domestic Hot Water	8.73	8.13	0.59
Lighting	67.87	41.20	26.67
Receptacle	68.74	68.74	0.00
Process	0.00	0.00	0.00
Exterior Usage	0.00	0.00	0.00
TOTALS:	338.66	265.46	69.21

**BUILDING COMPLIES**

Building Orientation	Conditioned Floor Area	Unconditioned Floor Area
North	37,124	402
South		
East		
West		

Number of Stories: 2  
 Number of Systems: 10  
 Number of Zones: 76 (Conditioned), 10 (Unconditioned), 0 (Plenum)

Orientation	Gross Area	Gazing Area	Gazing Ratio
Front Elevation	4,256	1,450	0.341
Left Elevation	3,042	1,259	0.414
Right Elevation	4,217	537	0.127
Rear Elevation	2,854	883	0.309
Total	14,369	3,919	0.273
Roof	19,500	1,088	0.056

Run Initiation Time: 30-Sep-2011 @ 11:27:23 AM Run Code: 1317407310  
 eQUEST 3.84 using DOEComp3.84 / DOE 2.2-7-78 Page 2 of 4

**ENVELOPE COMPLIANCE SUMMARY Performance (part 2 of 2) ENV-1C**

Project Name: LMCC L-612 Student Service Center Remodel Date: 30-Sep-2011

**OVERHEAD FENESTRATION EXTERIOR SHADING**

Fan #	Exterior Shade Type	Window			Overhang			Left Fin			Right Fin					
		Height	Width	Depth	Width	LEXT	REXT	Depth	Height	TEXT	REXT	Depth	Height	TEXT	REXT	
59	Fixed Interior	8.0	12.0	-	-	-	-	-	-	-	-	-	-	-	-	-
60	T24 Default	6.5	8.0	-	-	-	-	-	-	-	-	-	-	-	-	-
61	T24 Default	6.5	9.0	-	-	-	-	-	-	-	-	-	-	-	-	-
62	T24 Default	6.5	9.0	-	-	-	-	-	-	-	-	-	-	-	-	-
63	T24 Default	6.5	9.0	-	-	-										

**MECHANICAL COMPLIANCE SUMMARY Performance MECH-1C**

Project Name: LMCC L-612 Student Service Center Remodel Date: 30-Sep-2011

**CENTRAL HEATING & COOLING SYSTEM ACCEPTANCE (Part 2)**

Test Description	MECH-6A	MECH-11A	MECH-12A	MECH-13A	MECH-14A	Test Performed By
Equipment Requiring Testing	# of Units	Valve Leakage Test	Automatic Demand Flow Control	Full Flow Diagnostic for Air & Zone	Disturbance Energy Storage (DES) Systems	
AC-1	1	<input type="checkbox"/>	<input type="checkbox"/>	<input type="checkbox"/>	<input type="checkbox"/>	
AC-3	1	<input type="checkbox"/>	<input type="checkbox"/>	<input type="checkbox"/>	<input type="checkbox"/>	
AC-2	1	<input type="checkbox"/>	<input type="checkbox"/>	<input type="checkbox"/>	<input type="checkbox"/>	
AC-4	1	<input type="checkbox"/>	<input type="checkbox"/>	<input type="checkbox"/>	<input type="checkbox"/>	

**CHILLED WATER, HEATING HOT WATER & CONDENSER WATER CIRCULATION SYSTEMS ACCEPTANCE**

Test Description	MECH-6A	MECH-6A	MECH-11A	MECH-11A	MECH-12A	Test Performed By
Equipment Requiring Testing	# of Units	Valve Leakage Test	Supply Water Temperature Reset	Hydronic System Variable Flow Control	Automatic Demand Flow Control	
Chilled Water Loop	1	<input type="checkbox"/>	<input type="checkbox"/>	<input type="checkbox"/>	<input type="checkbox"/>	
Hot Water Loop	1	<input type="checkbox"/>	<input type="checkbox"/>	<input type="checkbox"/>	<input type="checkbox"/>	
DHW Plant (Loop 1)	1	<input type="checkbox"/>	<input type="checkbox"/>	<input type="checkbox"/>	<input type="checkbox"/>	
Condenser Loop	1	<input type="checkbox"/>	<input type="checkbox"/>	<input type="checkbox"/>	<input type="checkbox"/>	

**PUMP ACCEPTANCE**

Test Description	MECH-10A	MECH-11A	MECH-11A	Test Performed By
Equipment Requiring Testing	# of Units	Hydronic Variable Flow Control	Automatic Demand Flow Control	
Chilled Water Pump	1	<input type="checkbox"/>	<input type="checkbox"/>	
Hot Water Pump	1	<input type="checkbox"/>	<input type="checkbox"/>	
Pump 3	1	<input type="checkbox"/>	<input type="checkbox"/>	

**CHILLER ACCEPTANCE**

Test Description	MECH-6A	MECH-6A	MECH-10A	MECH-11A	MECH-11A	Test Performed By
Equipment Requiring Testing	# of Units	Valve Leakage Test	Supply Water Temperature Reset	Hydronic System Variable Flow Control	Automatic Demand Flow Control	
Chiller 1	1	<input type="checkbox"/>	<input type="checkbox"/>	<input type="checkbox"/>	<input type="checkbox"/>	

**BOILER ACCEPTANCE**

Test Description	MECH-6A	MECH-6A	MECH-10A	MECH-11A	MECH-11A	Test Performed By
Equipment Requiring Testing	# of Units	Valve Leakage Test	Supply Water Temperature Reset	Hydronic System Variable Flow Control	Automatic Demand Flow Control	
Boiler 1	1	<input type="checkbox"/>	<input type="checkbox"/>	<input type="checkbox"/>	<input type="checkbox"/>	

Run Infiltration Time: 30-Sep-2011 @ 11:27:23 AM Run Code: 1317407310  
QUEST 3.64 using DDCComp3.64 / DOE 2.2-7/02 Page 28 of 40

**MECHANICAL COMPLIANCE SUMMARY Performance MECH-2C**

Project Name: LMCC L-612 Student Service Center Remodel Date: 30-Sep-2011

**SYSTEM FEATURES**

System Name	AHU-2	AHU-3	AHU-4	Note to Field
Time Control	S	S	S	
Setback Control	S	S	S	
Isolation Zones	B	B	B	
Heat Pump Thermostat?	Y	Y	Y	
Electric Heat?	N	N	N	
Fan Control	Any Fan w/ VSD	Any Fan w/ VSD	Any Fan w/ VSD	
VAV Minimum Position Control?	Yes	Yes	Yes	
Simultaneous Heat/Cool?	Y	Y	Y	
Heating Supply Reset?	Yes	Yes	Yes	
Cooling Supply Reset?	Yes	Yes	Yes	
Ventilation	Air Balance	Air Balance	Air Balance	
Outdoor Damper Control?	A	A	A	
Economizer Type	OA Temperature	OA Temperature	OA Temperature	
Design O.A. CFM (Mech-3C, Column H)	1,477,855	1,477,855	1,477,855	
Heating Equipment Type	Hot Water	Hot Water	Hot Water	
Heating Equipment Efficiency	N/A	N/A	N/A	
Cooling Equipment Type	Ch W/ Clg	Ch W/ Clg	Ch W/ Clg	
Cooling Equipment Efficiency	N/A	N/A	N/A	
Make and Model Number	N/A	N/A	N/A	
Heating Duct Location	On Roof	On Roof	On Roof	
Heating Duct R-Value	7.000	7.000	7.000	
Cooling Duct Location	On Roof	On Roof	On Roof	
Cooling Duct R-Value	7.000	7.000	7.000	
Duct Type Allowed?	0	0	0	
Flue Type (Supply, Return, Etc.)	-	-	-	
Flue Insulation R-Value	-	-	-	

CODE TABLES: Enter code from table below into column above.

Heat Pump Thermostat?	Isolation Zones	Fan Control
Y: Yes N: No	S: Prog Switch C: Occupancy Sensor M: Manual Timer	H: Heating C: Cooling B: Both
Y: Yes N: No	H: Heating C: Cooling B: Both	E: Fan number of Isolation Zones V: VFD O: Other C: Curve
Y: Yes N: No	B: Air Balance C: Outside Air Cert. M: Out. Air Measure D: Demand Control N: Natural	A: Air W: Water N: Not Required
Y: Yes N: No	V: Ventilation O: Outdoor Damper E: Economizer D: Design O.A. CFM	E: Enter Design Outdoor Air CFM N: Note: This shall be no less than Column H on MECH-3C.

Run Infiltration Time: 30-Sep-2011 @ 11:27:23 AM Run Code: 1317407310  
QUEST 3.64 using DDCComp3.64 / DOE 2.2-7/02 Page 30 of 40

**MECHANICAL COMPLIANCE SUMMARY Performance MECH-2C**

Project Name: LMCC L-612 Student Service Center Remodel Date: 30-Sep-2011

**SYSTEM FEATURES**

System Name	AC-1	AC-3	AC-2	Note to Field
Time Control	S	S	S	
Setback Control	S	S	S	
Isolation Zones	B	B	B	
Heat Pump Thermostat?	Y	Y	Y	
Electric Heat?	N	N	N	
Fan Control	Constant Volume	Constant Volume	Constant Volume	
VAV Minimum Position Control?	No	No	No	
Simultaneous Heat/Cool?	N	N	N	
Heating Supply Reset?	No	No	No	
Cooling Supply Reset?	No	No	No	
Ventilation	Air Balance	Air Balance	Air Balance	
Outdoor Damper Control?	A	A	A	
Economizer Type	Fixed Fraction	Fixed Fraction	Fixed Fraction	
Design O.A. CFM (Mech-3C, Column H)	18,900	28,795	17,895	
Heating Equipment Type	Split H Pump	Split H Pump	Split H Pump	
Heating Equipment Efficiency	7.700 HSPF	7.700 HSPF	7.700 HSPF	
Cooling Equipment Type	Pkg DX Clg	Pkg DX Clg	Pkg DX Clg	
Cooling Equipment Efficiency	18.00 SEER	18.00 SEER	18.00 SEER	
Make and Model Number	MITSUBISHI AD-424AA	MITSUBISHI SY-424NA	MITSUBISHI SY-424NA	
Heating Duct Location	On Roof	On Roof	On Roof	
Heating Duct R-Value	7.000	7.000	7.000	
Cooling Duct Location	On Roof	On Roof	On Roof	
Cooling Duct R-Value	7.000	7.000	7.000	
Duct Type Allowed?	0	0	0	
Flue Type (Supply, Return, Etc.)	-	-	-	
Flue Insulation R-Value	-	-	-	

CODE TABLES: Enter code from table below into column above.

Heat Pump Thermostat?	Isolation Zones	Fan Control
Y: Yes N: No	S: Prog Switch C: Occupancy Sensor M: Manual Timer	H: Heating C: Cooling B: Both
Y: Yes N: No	H: Heating C: Cooling B: Both	E: Fan number of Isolation Zones V: VFD O: Other C: Curve
Y: Yes N: No	B: Air Balance C: Outside Air Cert. M: Out. Air Measure D: Demand Control N: Natural	A: Air W: Water N: Not Required
Y: Yes N: No	V: Ventilation O: Outdoor Damper E: Economizer D: Design O.A. CFM	E: Enter Design Outdoor Air CFM N: Note: This shall be no less than Column H on MECH-3C.

Run Infiltration Time: 30-Sep-2011 @ 11:27:23 AM Run Code: 1317407310  
QUEST 3.64 using DDCComp3.64 / DOE 2.2-7/02 Page 30 of 40

**MECHANICAL VENTILATION Performance MECH-3C**

Project Name: LMCC L-612 Student Service Center Remodel Date: 30-Sep-2011

**MECHANICAL VENTILATION**

Zone Name	AREA BASIS			OCCUPANCY BASIS			Reg'd O.A. (Max. of D or G)	Design Outdoor Air CFM	VAV Min. CFM	Transfer Air CFM
	Cond. Area (sq. ft.)	CFM (ft²)	Min. (ft²)	No. People	CFM (ft²)	Min. (ft²)				
ZF15	170	0.38	68	4	15.0	67	68	68	382.50	0
ZF17	486	0.15	65	2	15.0	35	65	65	319.85	0
ZF19	1,076	0.38	409	27	15.0	404	409	409	1,131.86	0
ZF21	183	0.15	27	1	15.0	14	27	27	159.82	0
ZF23	488	0.15	66	2	15.0	33	66	66	327.27	0
ZF24	428	0.15	64	2	15.0	32	64	64	333.04	0
ZF25	560	0.38	213	14	15.0	210	213	213	664.97	0
ZM99	273	0.15	41	1	15.0	20	41	41	182.29	0
ZM10	951	0.15	143	5	15.0	71	143	143	1,129.85	0
ZM11	588	0.15	73	3	15.0	38	73	73	1,488.85	0
ZM13	118	0.15	18	1	15.0	3	18	18	296.79	0
ZM14	557	0.15	84	3	15.0	42	84	84	214.89	0
ZM15	137	0.15	21	1	15.0	10	21	21	128.81	0
ZM16	423	0.15	63	2	15.0	32	63	63	328.48	0
ZM18	136	0.15	20	1	15.0	10	20	20	77.52	0
ZM21	344	0.15	52	2	15.0	28	52	52	389.31	0
ZM22	1,298	0.15	209	7	15.0	100	204	204	523.81	0
ZF26	276	0.15	40	1	15.0	20	40	40	181.83	0
ZF31	157	0.15	24	1	15.0	12	24	24	79.29	0
ZF32	418	0.15	63	2	15.0	31	63	63	194.10	0
ZF33	278	0.30	139	8	15.0	142	140	139	257.13	1
ZF39	251	0.50	125	8	15.0	126	126	126	309.23	0
ZM23	894	0.15	80	3	15.0	40	80	80	442.47	0
ZM25	537	0.15	105	4	15.0	67	105	105	1,045.32	0
ZM24	243	0.15	37	1	15.0	18	37	37	87.83	0
ZM25	196	0.15	29	1	15.0	15	29	29	46.43	0
ZM26	376	0.15	58	2	15.0	28	58	58	158.71	0
ZM27	306	0.15	46	2	15.0	23	46	46	189.22	0
ZM28	352	0.30	166	11	15.0	167	163	163	511.65	1
ZM44	900	0.15	136	5	15.0	68	136	135	411.23	0
ZM45	489	0.15	70	2	15.0	35	70	70	134.77	0
ZM46	440	0.15	69	2	15.0	34	69	69	358.83	0
ZF24	210	0.50	106	7	15.0	106	106	106	1,112.14	1
ZF26	441	0.50	220	15	15.0	221	221	220	549.99	1
ZF28	176	0.15	26	1	15.0	13	26	26	281.46	0
ZF29	373	0.15	57	2	15.0	28	57	57	328.03	0
ZF10	242	0.15	36	1	15.0	18	36	36	322.58	0
ZF11	446	0.15	66	2	15.0	33	66	66	160.78	0

Minimum ventilation rate per Section 121, Table 121-A.

Base on expected number of occupants or at least 50% of CBC occupant density for egress purposes.

Must be greater than or equal to H, or use Transfer Air. Design outdoor air includes ventilation from supply air system & exhaust fans which operate at design conditions.

Must be greater than or equal to H-1, and, for VAV, greater than or equal to (H-2).

Run Infiltration Time: 30-Sep-2011 @ 11:27:23 AM Run Code: 1317407310  
QUEST 3.64 using DDCComp3.64 / DOE 2.2-7/02 Page 34 of 40

**MECHANICAL COMPLIANCE SUMMARY Performance MECH-1C**

Project Name: LMCC L-612 Student Service Center Remodel Date: 30-Sep-2011

**COOLING TOWER & FLUID COOLER ACCEPTANCE**

Test Description	MECH-6A	MECH-6A	MECH-10A	MECH-11A	Test Performed By
Equipment Requiring Testing	# of Units	Valve Leakage Test	Supply Water Temperature Reset	Hydronic System Variable Flow Control	
CT	1	<input type="checkbox"/>	<input type="checkbox"/>	<input type="checkbox"/>	

Run Infiltration Time: 30-Sep-2011 @ 11:27:23 AM Run Code: 1317407310  
QUEST 3.64 using DDCComp3.64 / DOE 2.2-7/02 Page 29 of 40

**MECHANICAL COMPLIANCE SUMMARY Performance MECH-2C**

Project Name: LMCC L-612 Student Service Center Remodel Date: 30-Sep-2011

**SYSTEM FEATURES**

System Name	AHU-5	AHU-6	AHU-7	Note to Field
Time Control	S	S	S	
Setback Control	S	S	S	
Isolation Zones	B	B	B	
Heat Pump Thermostat?	Y	Y	Y	
Electric Heat?	N	N	N	
Fan Control	Any Fan w/ VSD	Any Fan w/ VSD	Any Fan w/ VSD	
VAV Minimum Position Control?	Yes	Yes	Yes	
Simultaneous Heat/Cool?	Y	Y	Y	
Heating Supply Reset?	Yes	Yes	Yes	
Cooling Supply Reset?	Yes	Yes	Yes	
Ventilation	Air Balance	Air Balance	Air Balance	
Outdoor Damper Control?	A	A	A	
Economizer Type	OA Temperature	OA Temperature	OA Temperature	
Design O.A. CFM (Mech-3C, Column H)	1,263,788	1,263,788	1,263,788	
Heating Equipment Type	Hot Water	Hot Water	Hot Water	
Heating Equipment Efficiency	N/A	N/A	N/A	
Cooling Equipment Type	Ch W/ Clg	Ch W/ Clg	Ch W/ Clg	
Cooling Equipment Efficiency	N/A	N/A	N/A	
Make and Model Number	N/A	N/A	N/A	
Heating Duct Location	On Roof	On Roof	On Roof	
Heating Duct R-Value	7.000	7.000	7.000	

**MECHANICAL VENTILATION Performance MECH-3C**

Project Name: LMCC L-612 Student Service Center Remodel Date: 30-Sep-2011

**MECHANICAL VENTILATION**

Zone Name	Cond Area (sq ft)	Min. CFM (Per Person)	Max. CFM (Per Person)	Occupancy	Design Outdoor Air (cfm/person)	VAV Min. CFM	Transfer Air CFM
ZM00	153	0.15	124	15.0	19	n/a	0

- C** Minimum ventilation rate per Section 121, Table 121-A.
- E** Base on expected number of occupants or at least 80% of CBC occupant density for spaces purposes.
- I** Must be greater than or equal to H, or use Transfer Air. Design outdoor air includes ventilation from supply air system & exhaust fans which operate at design conditions.
- K** Must be greater than or equal to 34-I, and, for VAV, greater than or equal to (H+J).

Run Initiation Time: 30-Sep-2011 @ 11:27:23 AM Run Code: 1317407310  
 eQUEST 3.64 using DDCControl3.64 / DOE-2.2.47b2 Page 36 of 40

**MECHANICAL EQUIPMENT DETAILS Performance (Part 1 of 2) MECH-5C**

Project Name: LMCC L-612 Student Service Center Remodel Date: 30-Sep-2011

**CENTRAL FAN SUMMARY**

Station Name	Description	SUPPLY FAN				RETURN FAN						
		Qty	CFM	BHP	Motor Eff	Qty	CFM	BHP	Motor Eff			
AHJ-2	Any Fan w/ VSD	1	5,800	6.04	0.90	1.00	0.30	Hot Water Loop	30.0			
AHJ-3	Any Fan w/ VSD	2	6,800	1.81	0.90	1.00	Any Fan w/ VSD	1	4,092	2.52	0.90	1.00
AHJ-4	Any Fan w/ VSD	2	6,200	1.74	0.92	1.00	Any Fan w/ VSD	1	3,245	2.58	0.90	1.00
AHJ-5	Any Fan w/ VSD	2	4,400	1.88	0.92	1.00	Any Fan w/ VSD	1	2,728	2.32	0.90	1.00
AHJ-6	Any Fan w/ VSD	1	4,800	6.10	0.90	1.00	Any Fan w/ VSD	1	2,852	1.72	0.87	1.00
AHJ-7	Any Fan w/ VSD	1	6,100	6.10	0.90	1.00	Any Fan w/ VSD	1	3,168	1.72	0.87	1.00
AC-1	Constant Volume	1	871	0.18	0.92	1.00	n/a					
AC-3	Constant Volume	1	568	0.18	0.82	1.00	n/a					
AC-2	Constant Volume	1	568	0.18	0.80	1.00	n/a					
AC-4	Constant Volume	1	568	0.18	0.90	1.00	n/a					

Run Initiation Time: 30-Sep-2011 @ 11:27:23 AM Run Code: 1317407310  
 eQUEST 3.64 using DDCControl3.64 / DOE-2.2.47b2 Page 38 of 40

**MECHANICAL EQUIPMENT DETAILS Performance (Part 2 of 2) MECH-5C**

Project Name: LMCC L-612 Student Service Center Remodel Date: 30-Sep-2011

**VAV SUMMARY**

Zone Name	System Type	Qty	VAV		Reheat Type	Reheat Delta, T
			Min. CFM	Ratio		
ZM41	Variable Air Volume	1	0.30	Hot Water Loop	30.0	
ZM42	Variable Air Volume	1	0.30	Hot Water Loop	30.0	
**EXHAUST FAN SUMMARY**

Zone Name	Description	Qty	EXHAUST FAN			
			CFM	BHP	Motor Eff	Drive Eff
ZM44	Cycling	1	1,050.0	0.15	0.82	1.00
ZF34	Cycling	1	1,050.0	0.15	0.82	1.00
ZM00	Cycling	1	568.0	0.15	0.82	1.00

Run Initiation Time: 30-Sep-2011 @ 11:27:23 AM Run Code: 1317407310  
 eQUEST 3.64 using DDCControl3.64 / DOE-2.2.47b2 Page 40 of 40

**MECHANICAL EQUIPMENT DETAILS Performance (Part 1 of 2) MECH-5C**

Project Name: LMCC L-612 Student Service Center Remodel Date: 30-Sep-2011

**CIRCULATION LOOP SUMMARY**

Name	Description	Qty	CIRCULATION LOOP PUMPS				Pump Control
			GPM	BHP	Motor Eff	Drive Eff	
Chilled Water Loop	Chilled Water	1	222	3.8	1.00	var spd	
Hot Water Loop	Hot Water	1	138	2.2	0.86	1.00	var spd
DHW Plan..._oop (1)	Domestic DHW Loop	0	n/a	0.0	n/a	n/a	n/a
Condenser Loop	Condenser Water	1	326	7.3	0.92	1.00	var spd

**CHILLER SUMMARY**

Name	Circulation Loop	Description	Qty	Eff. (%)	Total Tons	CHILLER PUMPS				Pump Control
						GPM	BHP	Motor Eff	Drive Eff	
Chiller 1	Chilled Water Loop	Serve	1	4.46	111	0	n/a	n/a	n/a	n/a

**COOLING TOWER SUMMARY**

Name	Circulation Loop	Description	Qty	Eff. (%)	Total Tons	COOLING TOWER PUMPS				Pump Control
						GPM	BHP	Motor Eff	Drive Eff	
CT	Condenser Loop	Open Tower	1	0.916	135	0	n/a	n/a	n/a	n/a

**BOILER SUMMARY**

Name	Circulation Loop	Description	Qty	Efficiency	Total Input (MMBtu/yr)	BOILER PUMPS				Pump Control
						GPM	BHP	Motor Eff	Drive Eff	
Boiler 1	Hot Water Loop	HW Boiler	1	0.90	1390	0	n/a	n/a	n/a	n/a

**DOMESTIC WATER HEATER SUMMARY**

Name	Circulation Loop	Description	Qty	Rel Input (MMBtu/yr)	Volume (Gal/yr)	E.F. (%)	Btu per Gallon	Tank Installation	
								Int. R-Val	Exc. R-Val
DHW Plan..._Hz (1)	DHW Plan..._oop (1)	Indirect Fired	1	102	30.0	0.80%	0.00%	0.00	12.00

**CENTRAL SYSTEM RATINGS**

System Name	Circulation Loop	Description	Qty	HEATING			COOLING			Economizer Type	
				Output (MMBtu/yr)	Aux. MW	Efficiency	Output (MMBtu/yr)	SEER	SEER		
AHJ-2	CHW & HW Loops	Variable Air Volume	1	149	-	n/a	175	n/a	n/a	CA Te. Sure	
AHJ-3	CHW & HW Loops	Variable Air Volume	1	185	-	n/a	192	n/a	n/a	CA Te. Sure	
AHJ-4	CHW & HW Loops	Variable Air Volume	1	184	-	n/a	212	n/a	n/a	CA Te. Sure	
AHJ-5	CHW & HW Loops	Variable Air Volume	1	210	-	n/a	225	n/a	n/a	CA Te. Sure	
AHJ-6	CHW & HW Loops	Variable Air Volume	1	121	-	n/a	172	n/a	n/a	CA Te. Sure	
AHJ-7	CHW & HW Loops	Variable Air Volume	1	121	-	n/a	172	n/a	n/a	CA Te. Sure	
AC-1	-none-	Plug Single Zone	1	0	-	7.70	HSPFF	24	n/a	16.00	Fixed..._cbn
AC-3	-none-	Plug Single Zone	1	1	-	7.70	HSPFF	22	n/a	16.00	Fixed..._cbn
AC-2	-none-	Plug Single Zone	1	1	-	7.70	HSPFF	22	n/a	16.00	Fixed..._cbn
AC-4	-none-	Plug Single Zone	1	15	-	7.70	HSPFF	22	n/a	16.00	Fixed..._cbn

Run Initiation Time: 30-Sep-2011 @ 11:27:23 AM Run Code: 1317407310  
 eQUEST 3.64 using DDCControl3.64 / DOE-2.2.47b2 Page 37 of 40


**MECHANICAL EQUIPMENT DETAILS Performance (Part 2 of 2) MECH-5C**

Project Name: LMCC L-612 Student Service Center Remodel Date: 30-Sep-2011

**VAV SUMMARY**

Zone Name	System Type	Qty	VAV		Reheat Type	Reheat Delta, T
			Min. CFM	Ratio		
ZF15	Variable Air Volume	1	0.30	Hot Water Loop	30.0	
ZF17	Variable Air Volume	1	0.30	Hot Water Loop	30.0	
Run Initiation Time: 30-Sep-2011 @ 11:27:23 AM Run Code: 1317407310  
 eQUEST 3.64 using DDCControl3.64 / DOE-2.2.47b2 Page 39 of 40

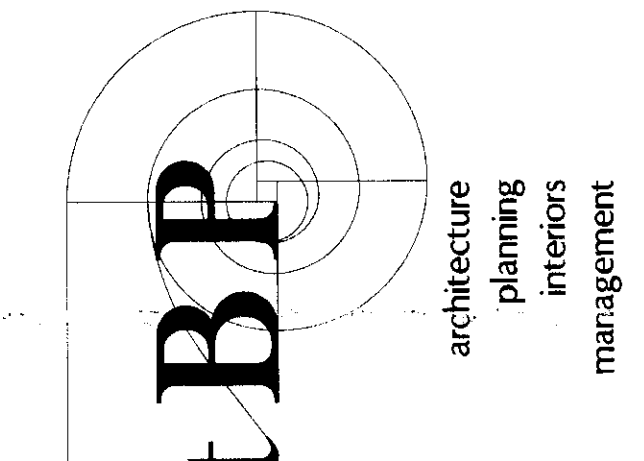

architecture  
planning  
interiors  
management

1877 Architecture  
1000 Burnett Avenue Suite 140  
Concord, CA 94520  
ph: 925.246.6419 fx: 925.246.6495

INTERFACE  
ENGINEERING

PROJECT: 2008-0108  
CONTRACT: Shawn Wilson

777 Market Street  
Suite 100  
Oakland, CA 94612  
TEL: 415.469.7243  
FAX: 415.469.7299  
www.interface-engineering.com

CONSULTANT

RE #/CI  
DIVISION STAMP  
DIV OF THE STATE ARCHITECT  
OFFICE OF RESOLUTION SERVICES  
APPL 01-112072  
DATE: JUL 31 2012

name  
address  
city, state, zip  
ph.  
agency

L-612 STUDENT SERVICES  
CENTER REMODEL  
COLLEGE COMPLEX  
BID DOCUMENTS

LOS MEDANOS COLLEGE  
2700 EAST LELAND DRIVE  
PITTSBURG, CA 94565

owner

tBP project number: 20610.00  
 file name: 0106M05.dwg  
 drawn by: HP checked by: BC  
 date: JULY 31, 2012  
 Rev. date: description:


THIS DRAWING AND THE DESIGN, SPECIFICATIONS, DETAILS AND OTHER INFORMATION CONTAINED HEREIN CONSTITUTE UNPUBLISHED WORKS OF ARCHITECTURE AND SHALL REMAIN THE PROPERTY OF ARCHITECTS/ENGINEERS IN PROFESSIONAL LIABILITY. NO PART HEREOF SHALL BE REPRODUCED, DISCLOSED, DISTRIBUTED, SOLD, PUBLISHED OR OTHERWISE USED IN ANY MANNER WITHOUT THE ADVANCED EXPRESS WRITTEN CONSENT OF ARCHITECTS/ENGINEERS.

drawing title:  
**TITLE 24 - ENERGY COMPLIANCE FORMS**

drawing no:  
**M-05**  
drawing of

FILE: 0106M05.DWG - MOS | EDIT: 7/24/2012 11:43 AM BY: ALLEN | PLOT: 7/25/2012 10:08 PM BY: RAI PHAN



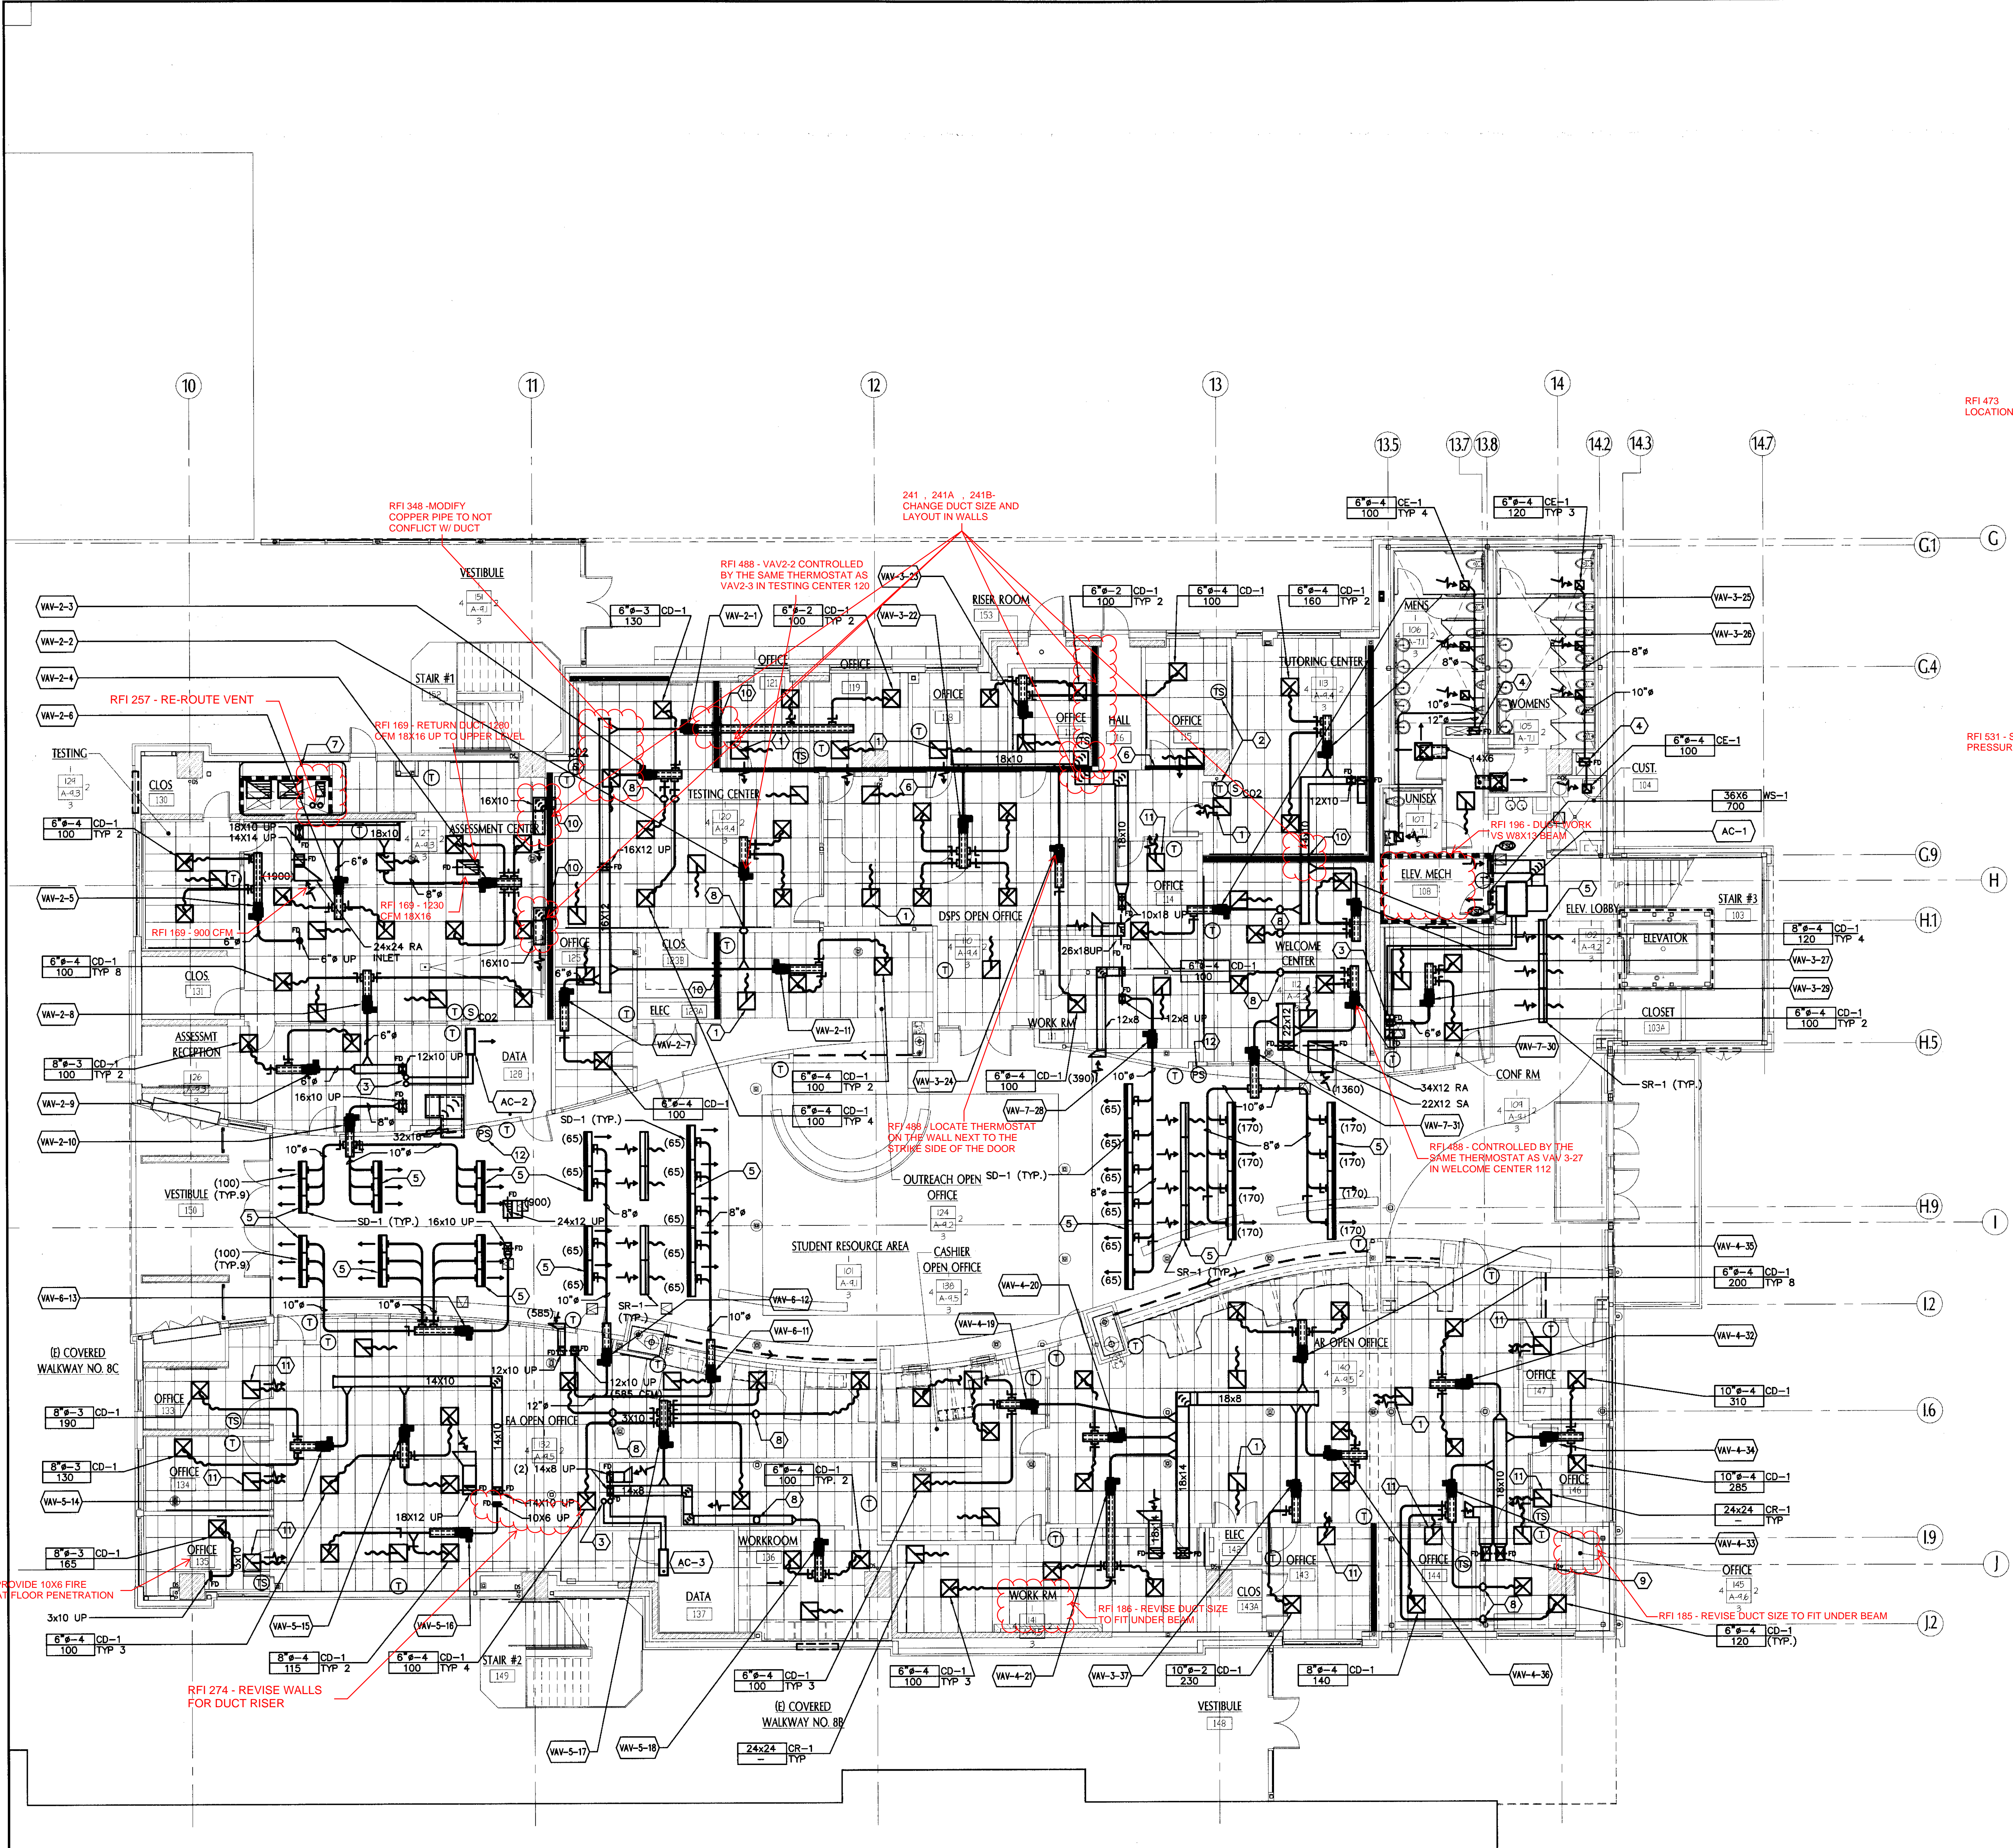

**GENERAL SHEET NOTES**


- A. SEE ARCHITECTURAL INTERIOR ELEVATION PLAN FOR EXACT LOCATIONS OF ALL THERMOSTAT.
- B. LOCATE ALL VAV BOXES SUCH THAT THEY CAN BE ACCESSIBLE FROM DROP-IN CEILING TO VAV'S CONTROLLER AND VALVES.
- C. LOCATE ALL VAV BOXES AWAY FROM RECESSED LIGHTING FIXTURES & T-BAR HANGERS.
- D. COORDINATION DOCUMENTS FOR ALL DIVISION 15 AND 16 TRADES SHALL BE SUBMITTED AND SIGNED OFF BY ALL TRADES. NO SHOP DRAWINGS SHALL BE REVIEWED BY AOR AND ENGINEERS UNLESS COORDINATION DOCUMENTS ARE SIGNED OFF.
- E. REFER TO VAV CONTROL DIAGRAM ON SHEET M-6.2 FOR VAV ZONES ADDRESSES FOR THERMOSTAT.
- F. REFER TO VAV SCHEDULE ON SHEET M-4.2 FOR VAV DUCT INLET SIZES.

**SHEET KEYNOTES**


- 1. CEILING RETURN GRILLE WITH MINIMUM 5' OF ACOUSTICAL FLEX DUCT IN RETURN PLENUM. (TYPICAL)
- 2. REFER TO ARCH INTERIOR ELEVATION FOR EXACT THERMOSTAT LOCATION. (TYPICAL ALL)
- 3. REFRIGERANT PIPE RISERS UP TO CONDENSER ON ROOF.
- 4. 14X10 EXHAUST DUCT UP. REFER TO PLUMBING DRAWINGS FOR HVAC CONDENSATE LINES.
- 5. DIFFUSER LENGTHS ARE TO MATCH SLOT LIGHT LENGTHS AS SHOWN. REFER TO SHEET M-4.1 FOR DIFFUSER SCHEDULE. (TYPICAL)
- 6. PROVIDE 3" HIGH CONTINUOUS SLOT OPENING IN FULL HEIGHT WALL ABOVE CEILING FOR RETURN AIR. SEE ARCHITECTURAL RCP DRAWING FOR ADDITIONAL INFORMATION.
- 7. SUPPLY, RETURN, EXHAUST DUCT & HEATING PIPE RISERS ARE PART OF PHASE II SCOPES.
- 8. PROVIDE 3X10 DUCT TRANSITION TO GO UNDERNEATH BELOW BEAM. (TYPICAL)
- 9. PROVIDE DUCT TRANSITION.
- 10. S/A DUCT THROUGH SHEAR WALL. REFER TO DETAIL #17/SS.3.
- 11. PROVIDE ACOUSTIC FLEX DUCT TRANSFER PLENUM SPACE AT ALL PRIVATE OFFICES (TYPICAL) DETAIL #10/M3.1
- 12. LOCATE BUILDING PRESSURE SENSOR AS SPECIFIED PER M-6.1.

Space pressure sensor locations as indicated on sheet M2.1A.  
 - Utilize the sensor location on the west side of the building to control AHU 1, 2, 5, & 6.  
 - Utilize the sensor location on the east side of the building to control AHU 3, 4, & 7.

RFI 626 - AIRFLOW DISCREPANCIES (ROOM 231, VAV 2-2, VAV 2-32, VAV2-11, VAV 4-32, VAV 5-4)

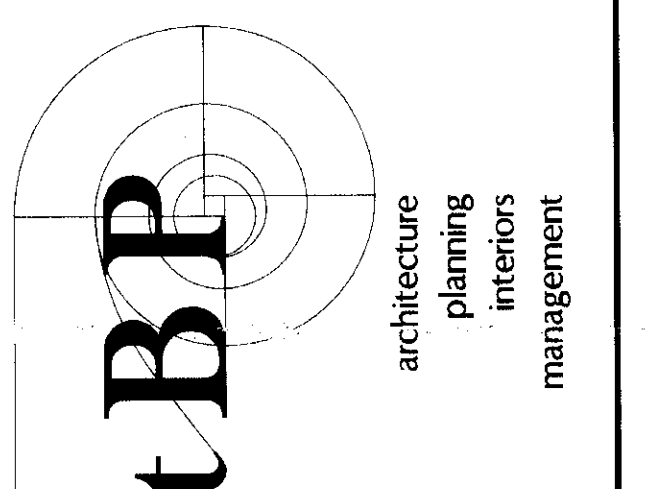

tBP Architecture  
 1000 Burnett Avenue Suite 140  
 Concord, CA 94520  
 PH: 925.246.6495  
 FX: 925.246.6495  
 architect

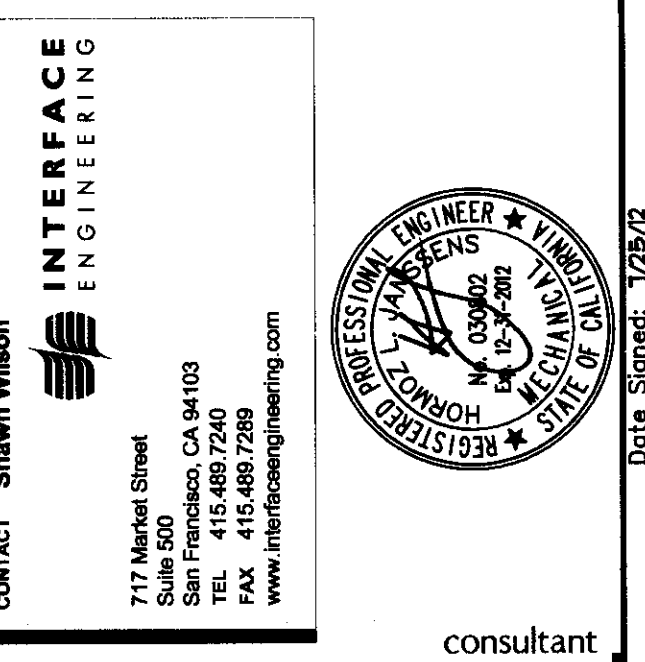

INTERFACE ENGINEERING  
 777 Market Street  
 San Francisco, CA 94103  
 TEL: 415.469.7200  
 FAX: 415.469.7201  
 WWW: interfaceengineering.com  
 consultant

FILE #/CI  
 DIVISIONS NAME  
 OFFICE OF THE STATE ARCHITECT  
 APPL 01/12/22  
 K. [Signature]  
 DATE: JUL 31 2012

**L-612 STUDENT SERVICES CENTER REMODEL COLLEGE COMPLEX BID DOCUMENTS**

owner  
 LOS MEDANOS COLLEGE  
 2700 EAST LELAND DRIVE  
 PITTSBURG, CA 94565


tBP project number : 20670200  
 file name: 0106M2.dwg  
 drawn by: GE checked by: BC  
 date: JULY 31, 2012  
 Rev. date: description:

THIS DRAWING AND THE DESIGN, CONCEPTS, IDEAS, AND OTHER INFORMATION CONTAINED HEREIN CONSTITUTE UNPAID WORK OF ARCHITECTURE AND SHALL REMAIN THE PROPERTY OF INTERFAC ENGINEERING IN PERPETUITY. NO PART THEREOF SHALL BE REPRODUCED, COPIED, DISTRIBUTED, SOLD, PUBLISHED, OR OTHERWISE USED IN ANY MANNER WITHOUT THE EXPRESS WRITTEN CONSENT OF INTERFAC ENGINEERING.

drawing title:  
**SS3 LOWER LEVEL FLOOR PLAN - HVAC DUCTWORK**

drawing no:  
**M-2.1A**  
 drawing of

**1 SS3 LOWER LEVEL FLOOR PLAN - HVAC DUCTWORK**  
 SCALE: 1/8"=1'-0"

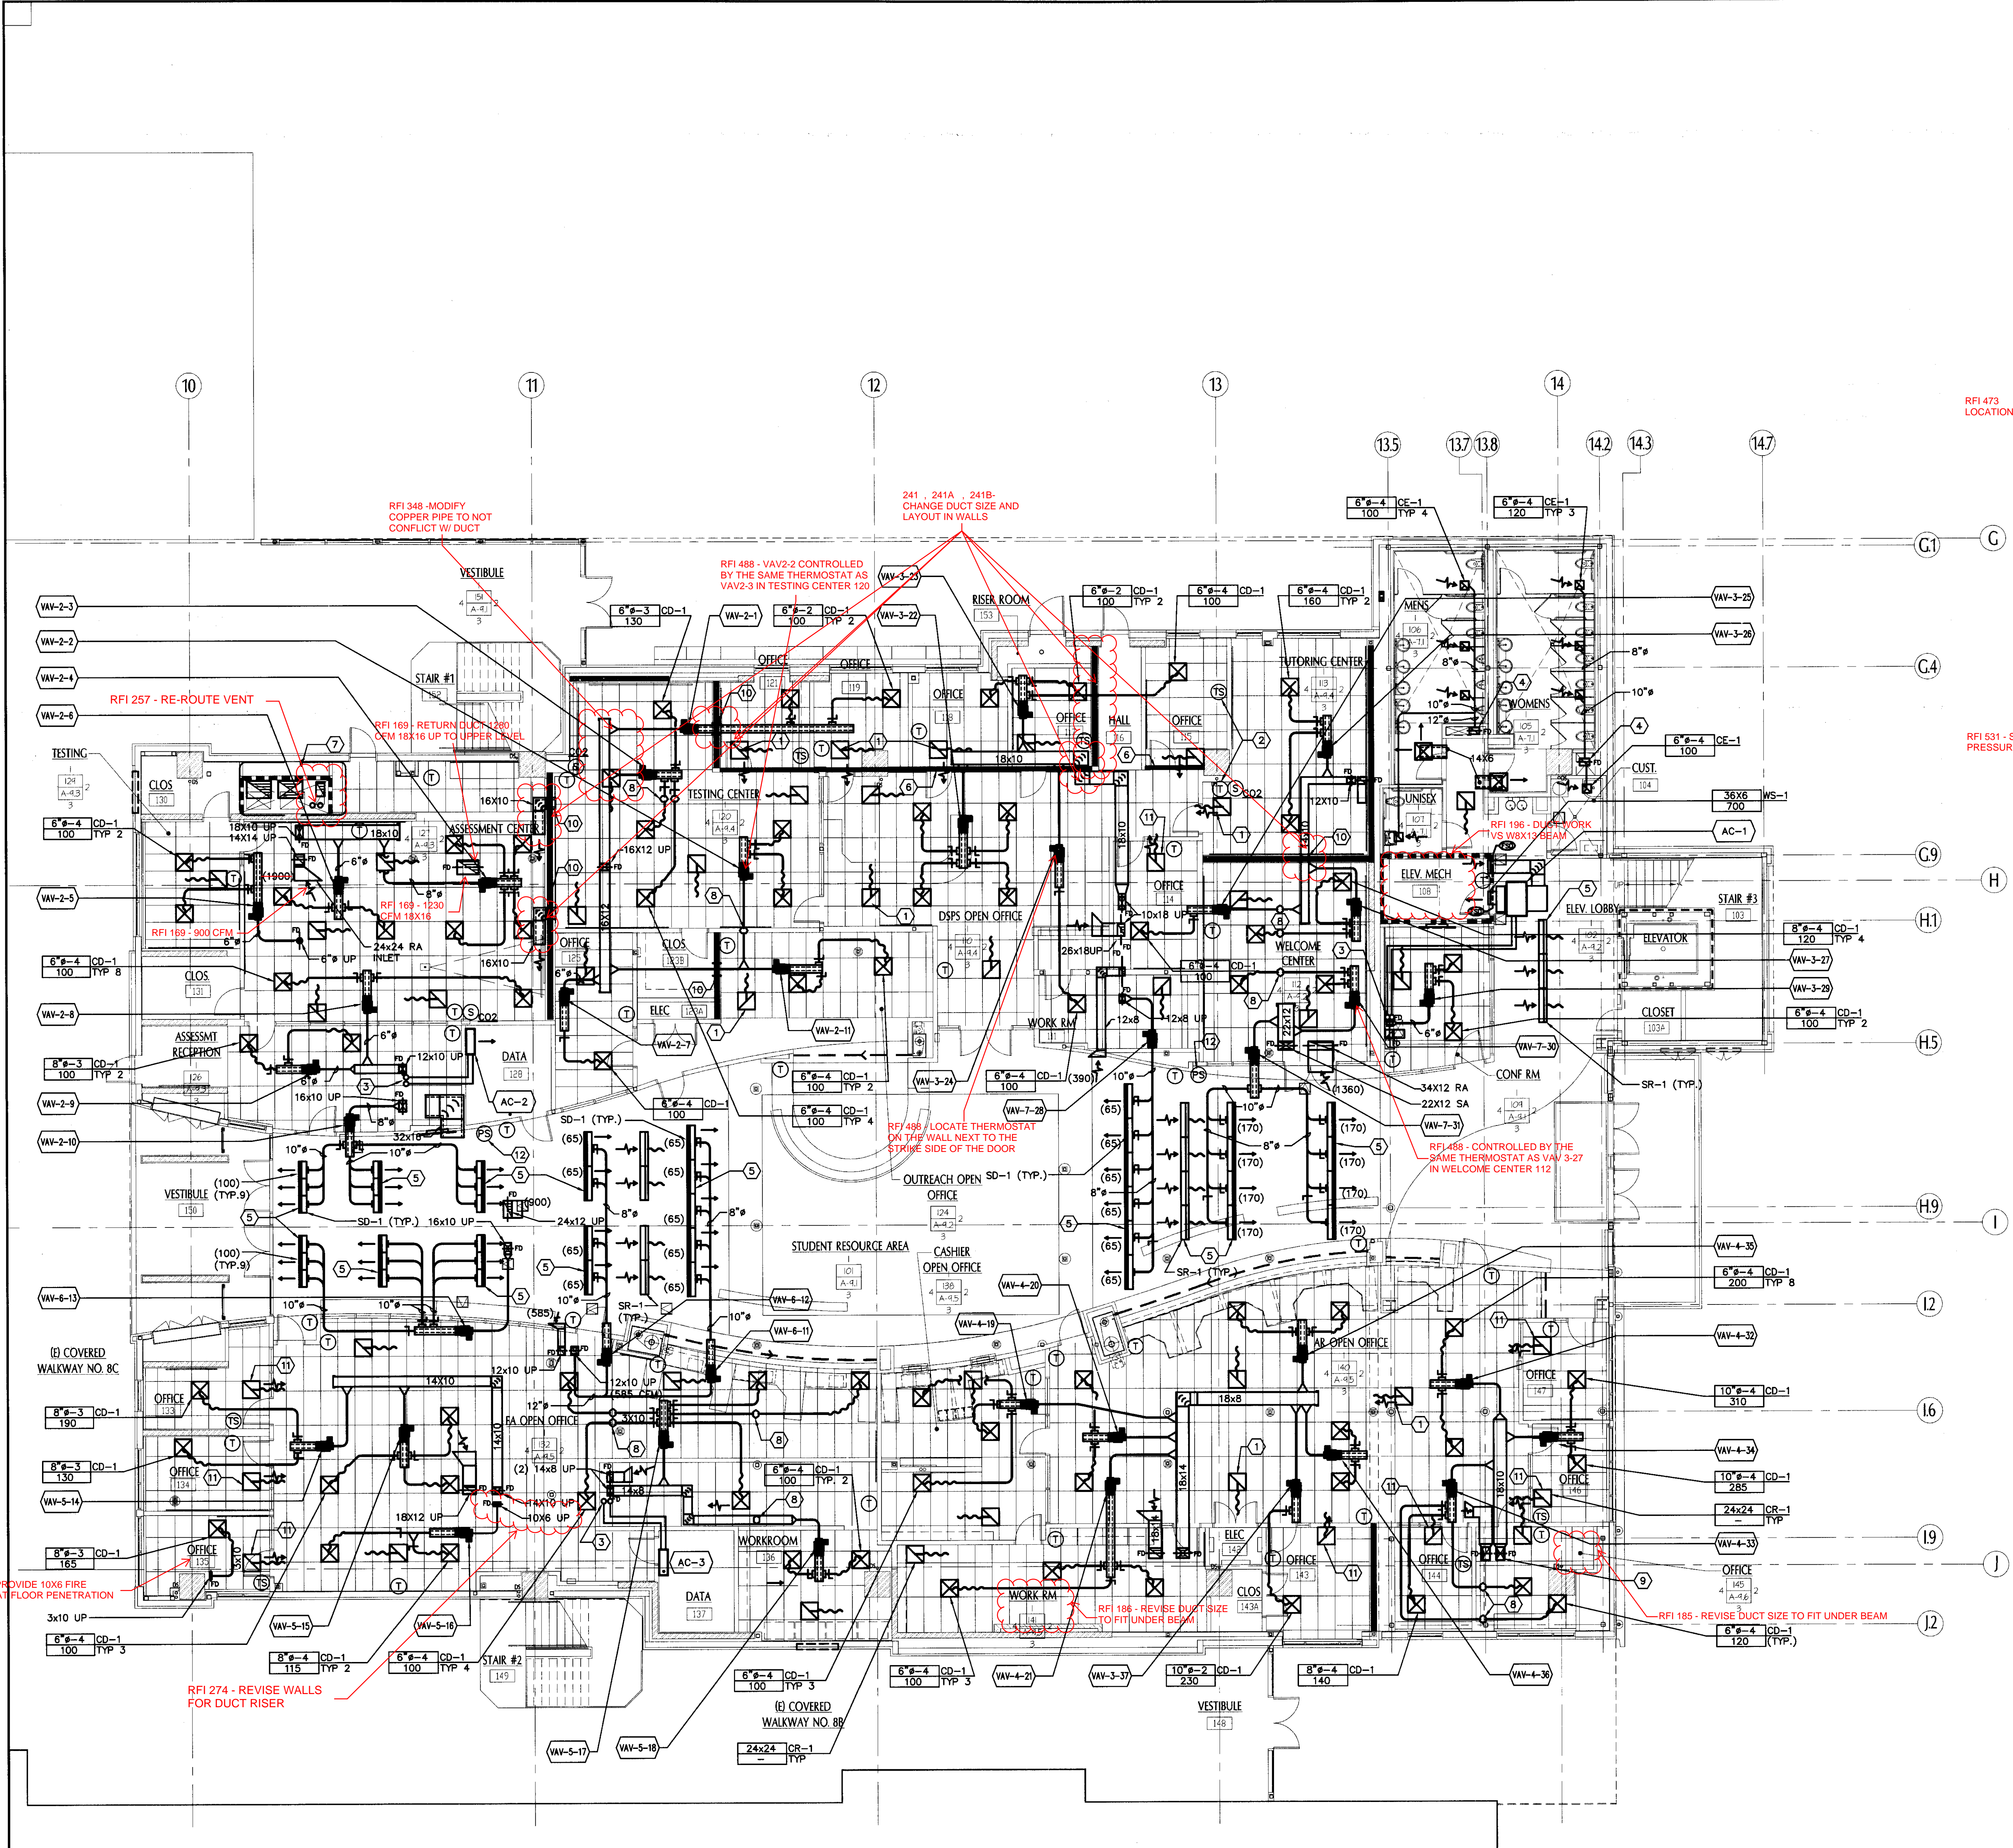

**GENERAL SHEET NOTES**


- A. SEE ARCHITECTURAL INTERIOR ELEVATION PLAN FOR EXACT LOCATIONS OF ALL THERMOSTAT.
- B. LOCATE ALL VAV BOXES SUCH THAT THEY CAN BE ACCESSIBLE FROM DROP-IN CEILING TO VAV'S CONTROLLER AND VALVES.
- C. LOCATE ALL VAV BOXES AWAY FROM RECESSED LIGHTING FIXTURES & T-BAR HANGERS.
- D. COORDINATION DOCUMENTS FOR ALL DIVISION 15 AND 16 TRADES SHALL BE SUBMITTED AND SIGNED OFF BY ALL TRADES. NO SHOP DRAWINGS SHALL BE REVIEWED BY AOR AND ENGINEERS UNLESS COORDINATION DOCUMENTS ARE SIGNED OFF.
- E. REFER TO VAV CONTROL DIAGRAM ON SHEET M-6.2 FOR VAV ZONES ADDRESSES FOR THERMOSTAT.
- F. REFER TO VAV SCHEDULE ON SHEET M-4.2 FOR VAV DUCT INLET SIZES.

**SHEET KEYNOTES**


- 1. CEILING RETURN GRILLE WITH MINIMUM 5' OF ACOUSTICAL FLEX DUCT IN RETURN PLENUM. (TYPICAL)
- 2. REFER TO ARCH INTERIOR ELEVATION FOR EXACT THERMOSTAT LOCATION. (TYPICAL ALL)
- 3. REFRIGERANT PIPE RISERS UP TO CONDENSER ON ROOF.
- 4. 14X10 EXHAUST DUCT UP. REFER TO PLUMBING DRAWINGS FOR HVAC CONDENSATE LINES.
- 5. DIFFUSER LENGTHS ARE TO MATCH SLOT LIGHT LENGTHS AS SHOWN. REFER TO SHEET M-4.1 FOR DIFFUSER SCHEDULE. (TYPICAL)
- 6. PROVIDE 3" HIGH CONTINUOUS SLOT OPENING IN FULL HEIGHT WALL ABOVE CEILING FOR RETURN AIR. SEE ARCHITECTURAL RCP DRAWING FOR ADDITIONAL INFORMATION.
- 7. SUPPLY, RETURN, EXHAUST DUCT & HEATING PIPE RISERS ARE PART OF PHASE II SCOPES.
- 8. PROVIDE 3X10 DUCT TRANSITION TO GO UNDERNEATH BELOW BEAM. (TYPICAL)
- 9. PROVIDE DUCT TRANSITION.
- 10. S/A DUCT THROUGH SHEAR WALL. REFER TO DETAIL #17/SS.3.
- 11. PROVIDE ACOUSTIC FLEX DUCT TRANSFER PLENUM SPACE AT ALL PRIVATE OFFICES (TYPICAL) DETAIL #10/M3.1
- 12. LOCATE BUILDING PRESSURE SENSOR AS SPECIFIED PER M-6.1.

Space pressure sensor locations as indicated on sheet M2.1A.  
 - Utilize the sensor location on the west side of the building to control AHU 1, 2, 5, & 6.  
 - Utilize the sensor location on the east side of the building to control AHU 3, 4, & 7.

RFI 626 - AIRFLOW DISCREPANCIES (ROOM 231, VAV 2-2, VAV 2-32, VAV2-11, VAV 4-32, VAV 5-4)

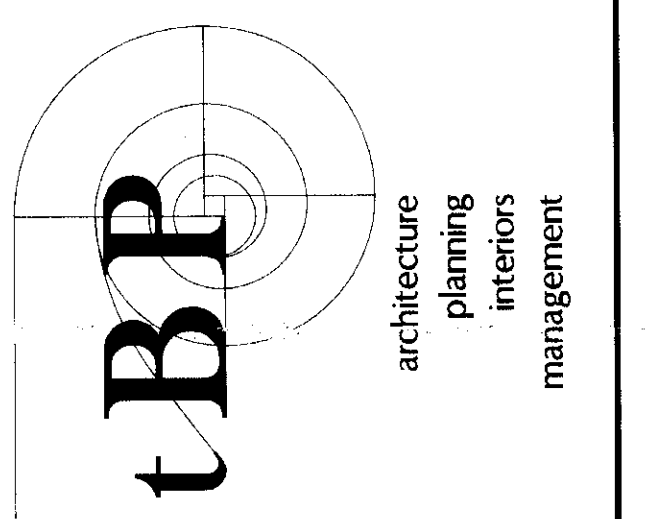

tBP Architecture  
 1000 Burnett Avenue Suite 140  
 Concord, CA 94520  
 PH: 925.246.6419 FX: 925.246.6495  
 architect

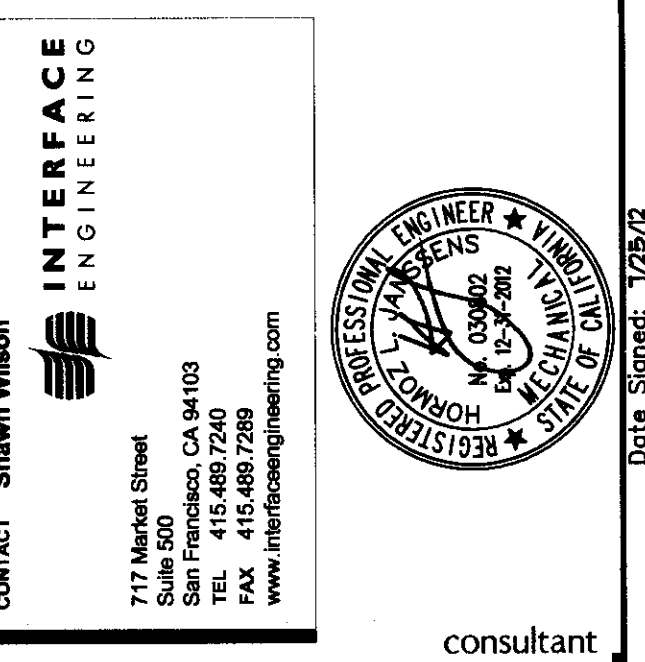

INTERFACE ENGINEERING  
 CONSULTANT  
 77 Market Street  
 San Francisco, CA 94103  
 TEL: 415.469.7260  
 WWW: www.interfaceeng.com  
 consultant

FILE #/CI  
 DATE: JUL 31 2012  
 name: \_\_\_\_\_  
 address: \_\_\_\_\_  
 city, state, zip: \_\_\_\_\_  
 agency: \_\_\_\_\_

**L-612 STUDENT SERVICES CENTER REMODEL COLLEGE COMPLEX BID DOCUMENTS**  
 LOS MEDANOS COLLEGE  
 2700 EAST LELAND DRIVE  
 PITTSBURG, CA 94565  
 owner

tBP project number: 20670200  
 file name: 0106M2.dwg  
 drawn by: GE checked by: BC  
 date: JULY 31, 2012  
 Rev. date: description:

THIS DRAWING AND THE DESIGN, CONCEPTS, IDEAS, AND OTHER INFORMATION CONTAINED HEREIN CONSTITUTE UNPUBLISHED WORK OF INVENTIVE DESIGN AND SHALL REMAIN THE PROPERTY OF INTERFAC ENGINEERING. NO PART THEREOF SHALL BE REPRODUCED, COPIED, DISTRIBUTED, SOLD, PUBLISHED, OR OTHERWISE USED IN ANY MANNER WITHOUT THE EXPRESS WRITTEN CONSENT OF INTERFAC ENGINEERING.

drawing title:  
**SS3 LOWER LEVEL FLOOR PLAN - HVAC DUCTWORK**  
 drawing no:  
**M-2.1A**  
 drawing of


**1 SS3 LOWER LEVEL FLOOR PLAN - HVAC DUCTWORK**  
 SCALE: 1/8"=1'-0"

**GENERAL SHEET NOTES**

- A. SEE ARCHITECTURAL INTERIOR ELEVATION PLAN FOR EXACT LOCATIONS OF ALL THERMOSTAT.
- B. LOCATE ALL VAV BOXES SUCH THAT THEY CAN BE ACCESSIBLE FROM DROP-IN CEILING TO VAV'S CONTROLLER AND VALVES.
- C. LOCATE ALL VAV BOXES AWAY FROM RECESSED LIGHTING FIXTURES & T-BAR HANGERS.
- D. COORDINATION DOCUMENTS FOR ALL DIVISION 15 AND 16 TRADES SHALL BE SUBMITTED AND SIGNED OFF BY ALL TRADES. NO SHOP DRAWINGS SHALL BE REVIEWED BY AOR AND ENGINEERS UNLESS COORDINATION DOCUMENTS ARE SIGNED OFF.

**SHEET KEYNOTES**

- 1 2"HWS/HWR HYDRONIC RISERS SERVING 2ND FLOOR (PHASE I).
- 2 HYDRONIC PIPING DOWN FROM UPPER LEVEL.
- 3 NOT USED.
- 4 REHEAT COIL CONNECTION KIT WITH 3-WAY VALVE.
- 5 HYDRONIC PIPING THROUGH SHEAR WALL REFER TO DETAIL #17/SS.3.
- 6 MINIMUM ALLOWABLE FOR END RUNS PIPING IS TO BE SIZED AT 3/4" (TYPICAL).

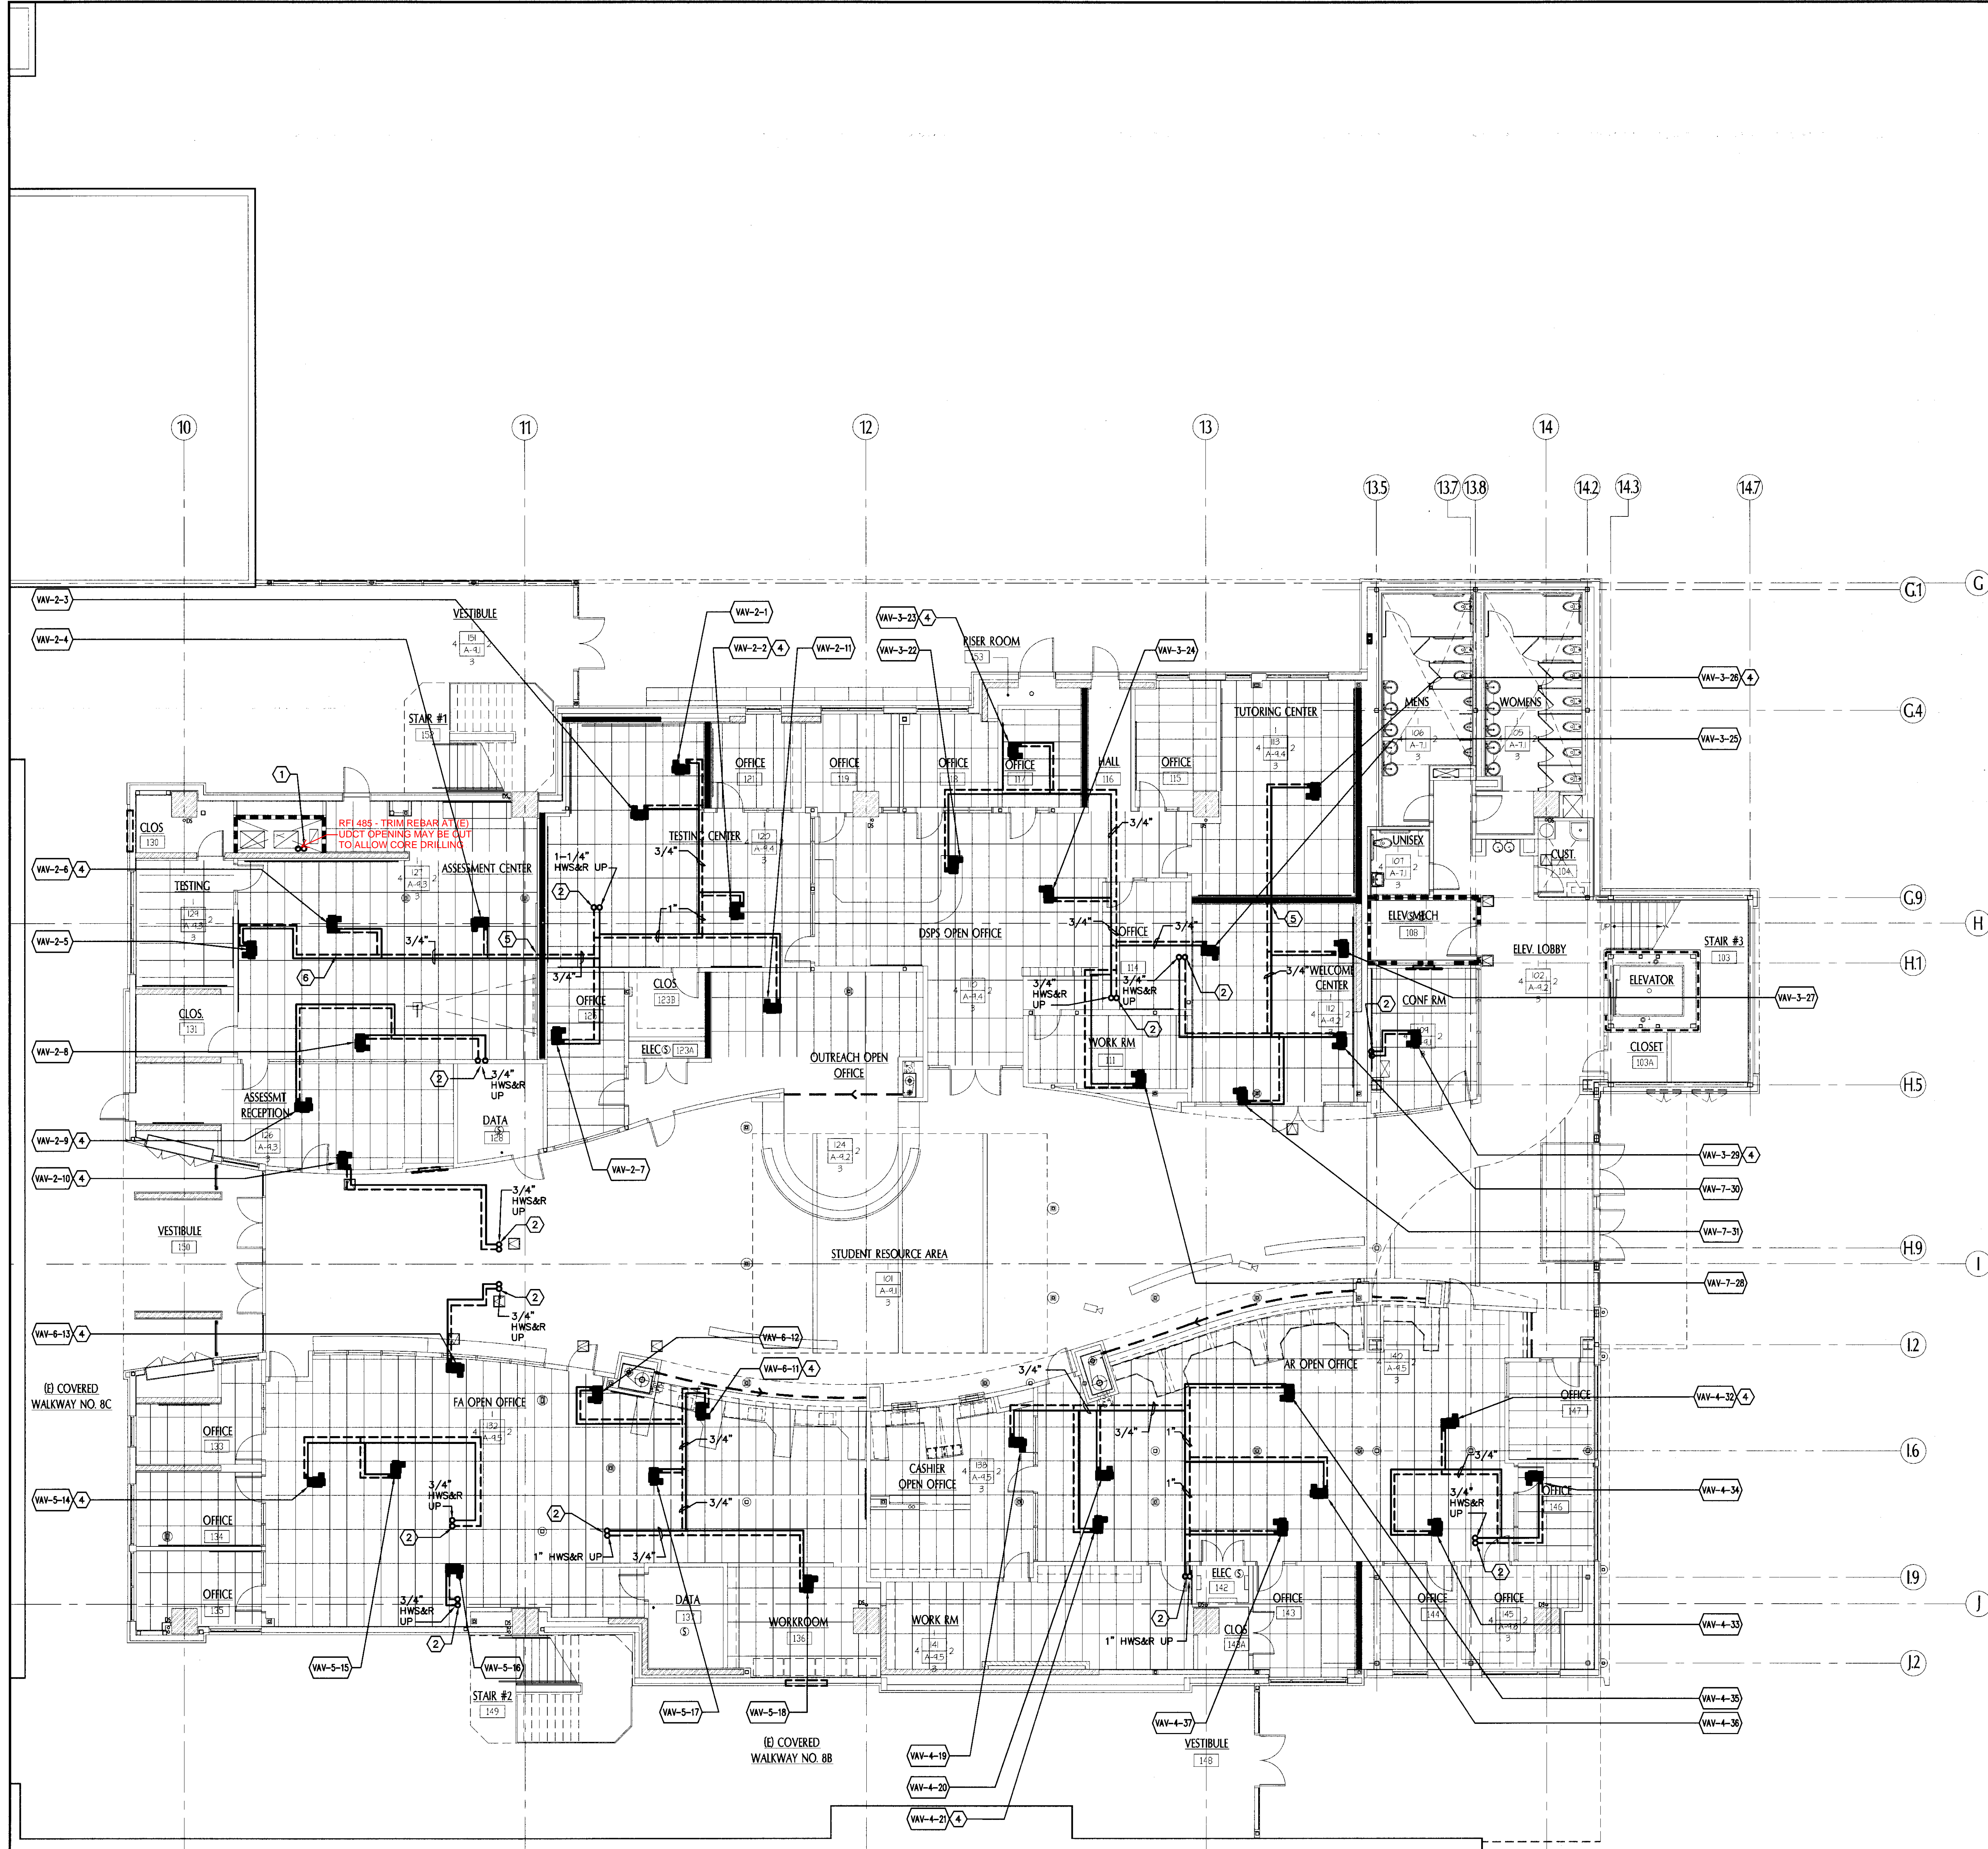

**1 SS3 LOWER LEVEL FLOOR PLAN - HVAC REHEAT PIPING**  
 SCALE: 1/8"=1'-0"

**tBP**  
 architecture  
 planning  
 interiors  
 management

1000 Burnett Avenue Suite 140  
 Concord, CA 94520  
 ph: 925.246.6495  
 fx: 925.246.6495

architect

**INTERFACE ENGINEERING**

PROJECT CONTACT: Shawn Wilson  
 717 Market Street  
 Suite 100  
 Concord, CA 94520  
 TEL: 925.488.2240  
 FAX: 925.488.2288  
 www.interface-engineering.com

consultant

**RE/C/I**

EXPIRES: JUL 31 2012

name  
 address  
 city, state, zip  
 ph.  
 agency

**L-612 STUDENT SERVICES CENTER REMODEL COLLEGE COMPLEX BID DOCUMENTS**


LOS MEDANOS COLLEGE  
 2700 EAST LELAND DRIVE  
 PITTSBURG, CA 94565

owner

tBP project number :	2061000
file name :	0106M21B.dwg
drawn by :	GE
checked by :	BC
date :	JULY 31, 2012
Rev. date :	description

drawing title:  
**SS3 LOWER LVL FLR PLAN - HVAC REHEAT PIPING**

drawing no:  
**M-2.1B**  
 drawing of

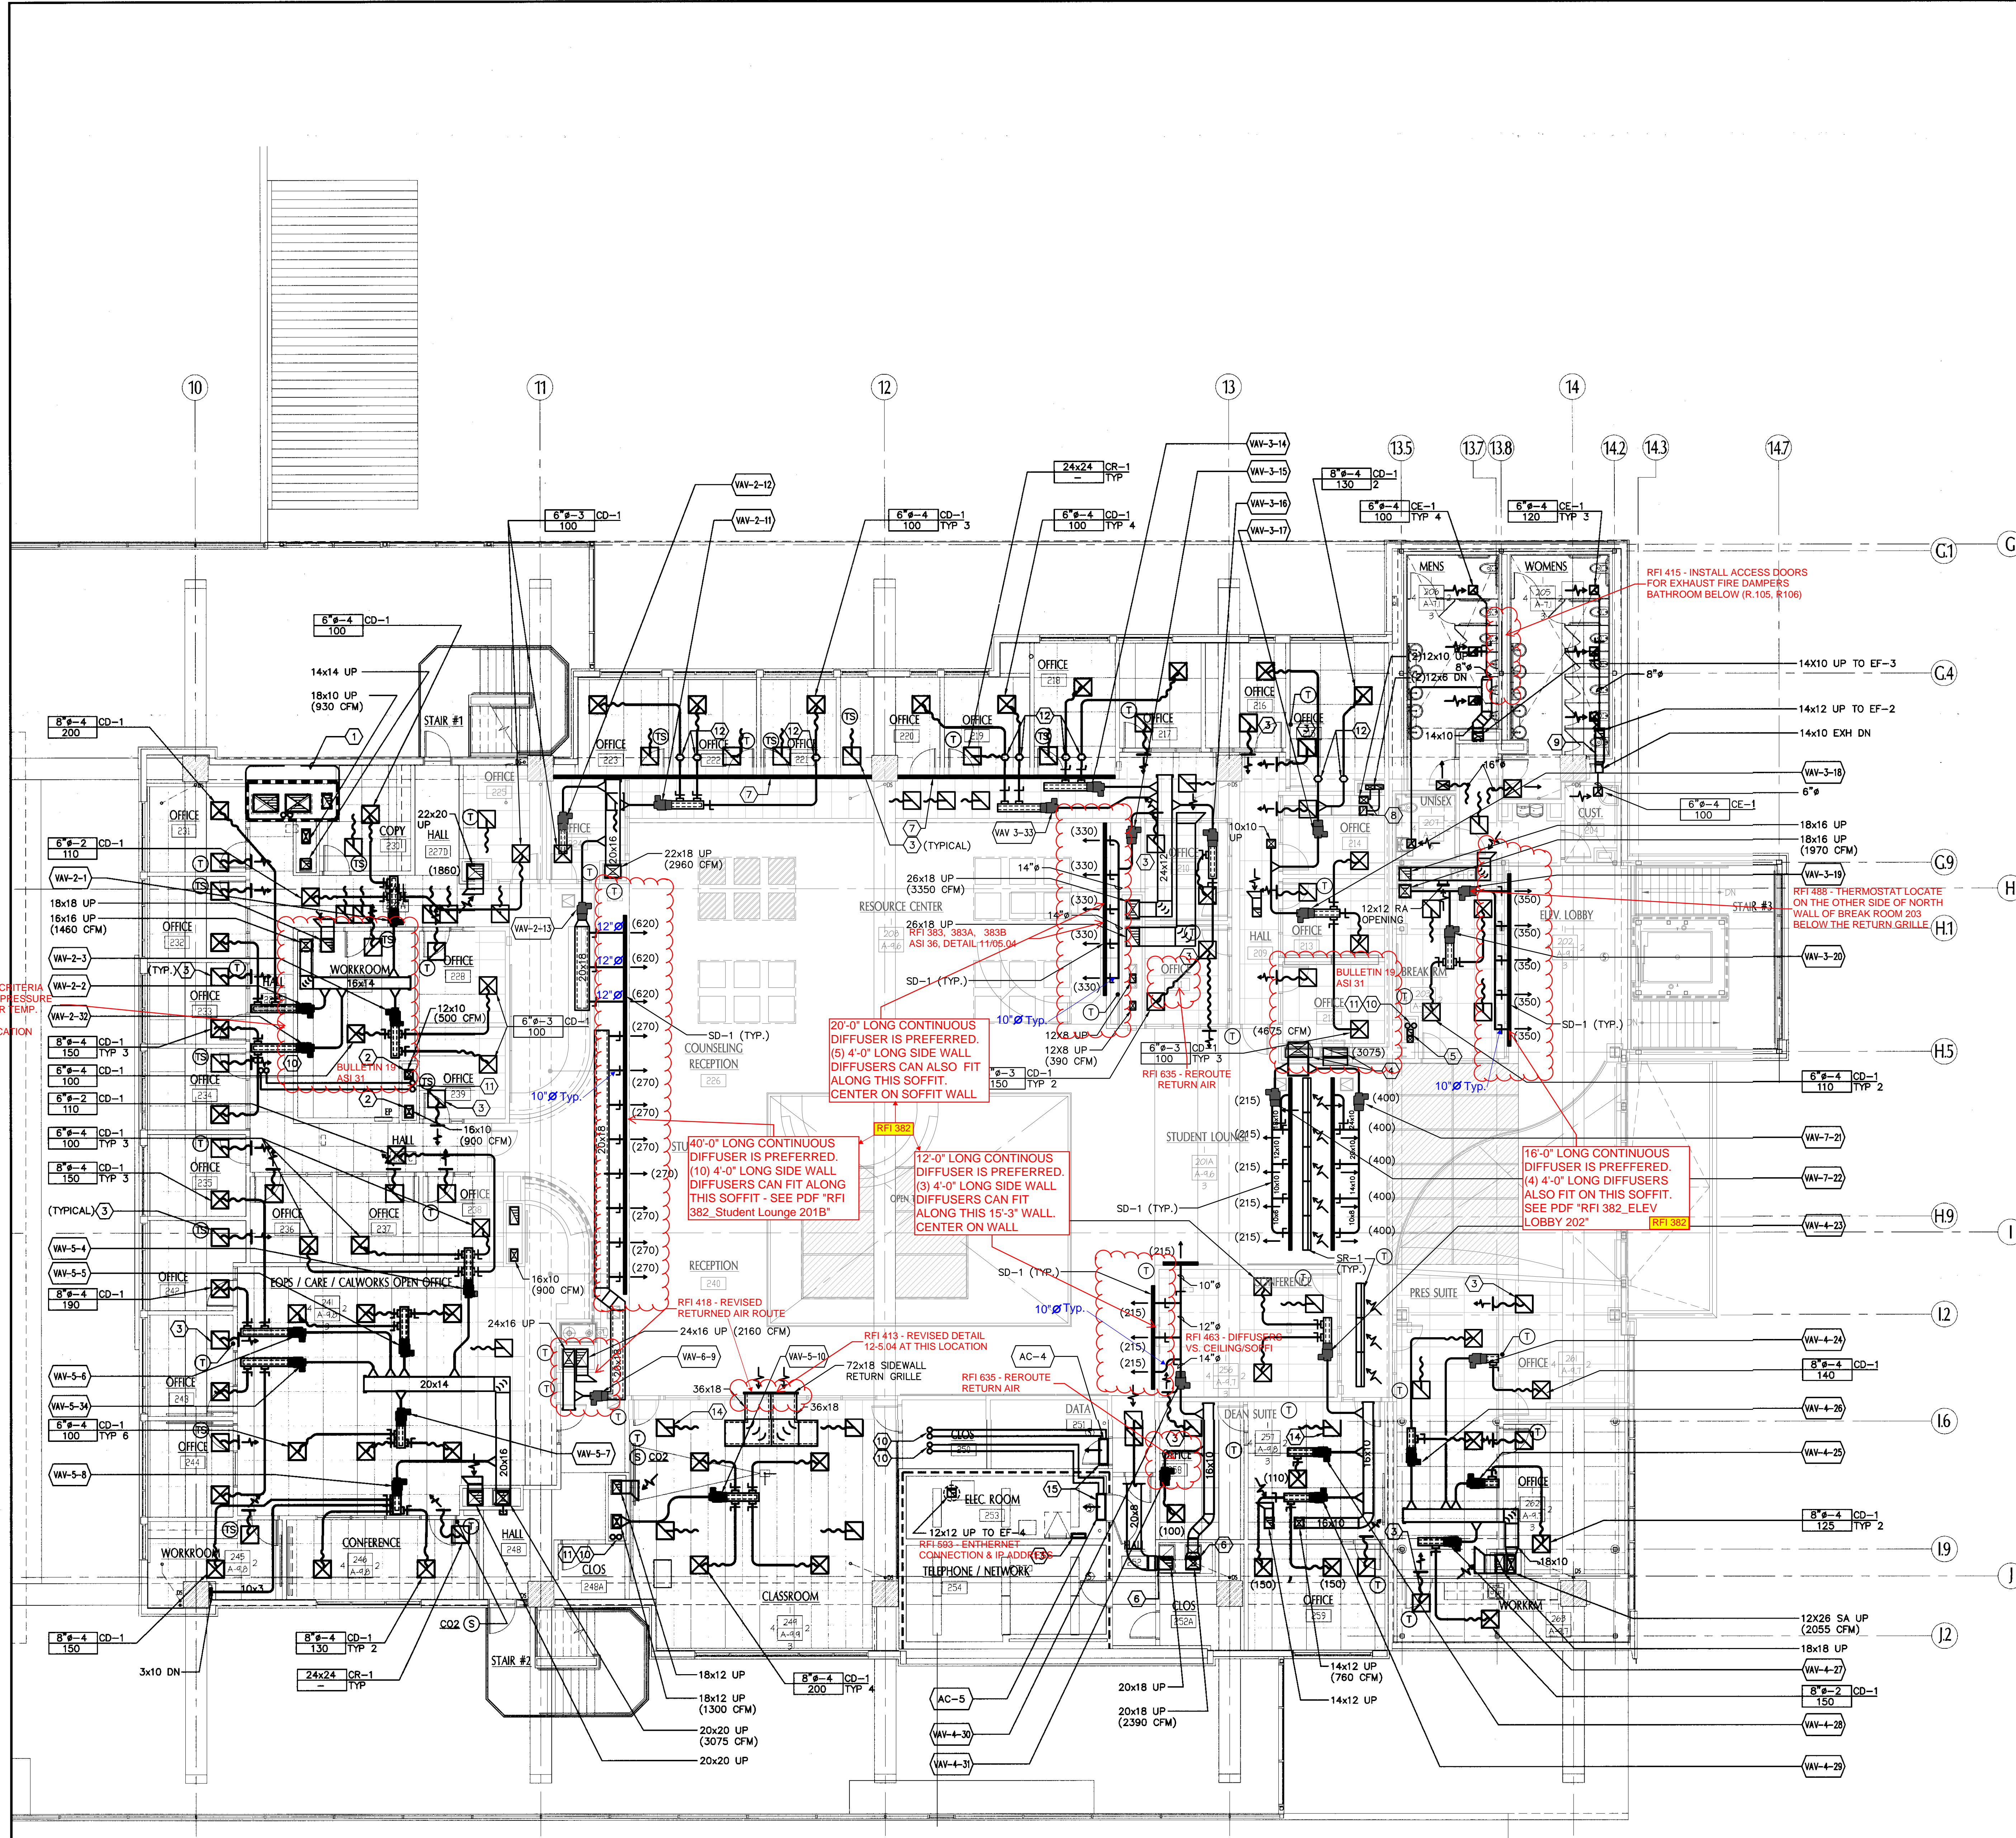

**GENERAL SHEET NOTES**

- A. SEE ARCHITECTURAL INTERIOR ELEVATION PLAN FOR EXACT LOCATIONS OF ALL THERMOSTAT.
- B. LOCATE ALL VAV BOXES SUCH THAT THEY CAN BE ACCESSIBLE FROM DROP-IN CEILING TO VAV'S CONTROLLER AND VALVES.
- C. LOCATE ALL VAV BOXES AWAY FROM RECESSED LIGHTING FIXTURES & T-BAR HANGERS.
- D. COORDINATION DOCUMENTS FOR ALL DIVISION 15 AND 16 TRADES SHALL BE SUBMITTED AND SIGNED OFF BY ALL TRADES. NO SHOP DRAWINGS SHALL BE REVIEWED BY AOR AND ENGINEERS UNLESS COORDINATION DOCUMENTS ARE SIGNED OFF.
- E. REFER TO VAV CONTROL DIAGRAM ON SHEET M-6.2 FOR VAV ZONES ADDRESSES FOR THERMOSTAT.
- F. REFER TO VAV SCHEDULE ON SHEET M-4.2 FOR VAV DUCT INLET SIZES.

**SHEET KEYNOTES**

- 1 (N)SUPPLY, RETURN, EXHAUST, HYDRONIC PIPE RISERS SERVING COLLEGE COMPLEX LEVEL CC2. SEE DIVISION 1 SECTION 0105 PROJECT PHASING.
- 2 SUPPLY DUCT DOWN TO LOWER LEVEL.
- 3 PROVIDE ACOUSTICAL FLEX DUCT TRANSFER TO PLENUM SPACE AT ALL PRIVATE OFFICES. (TYPICAL) DETAIL #10/M3.1.
- 4 PROVIDE TRANSITION FOR DUCTS TO GET INTO AIRSHaft TO LOWER FLOOR. 28x20 SA & RA DUCTS FROM ROOF. 34x12 SA & RA DOWN INSIDE SHAFT.
- 5 8x8 SA & RA DUCT RISERS IN SHAFT.
- 6 PROVIDE TRANSITION FOR DUCTS TO GET INTO AIRSHaft TO LOWER FLOOR. 20x18 SA & RA DUCTS FROM ROOF. 18x14 SA & RA DOWN INSIDE SHAFT.
- 7 PROVIDE 3" HIGH CONTINUOUS SLOT OPENING IN FULL HEIGHT WALL ABOVE CEILING FOR RETURN AIR. SEE ARCHITECTURAL RCP DRAWING FOR ADDITIONAL INFORMATION.
- 8 PROVIDE TRANSITION FOR DUCTS TO GET INTO AIRSHaft TO LOWER FLOOR. 12x10 SA & RA DUCTS FROM ROOF. 12x6 SA & RA DOWN INSIDE SHAFT.
- 9 PROVIDE TRANSITION FOR DUCT TO GET INTO AIRSHaft TO LOWER FLOOR. 14x12 EA DUCT FROM ROOF. 14x10 EA DOWN INSIDE SHAFT.
- 10 REFRIGERANT LINE SET UP TO CONDENSING UNIT ON ROOF.
- 11 REFRIGERANT LINE SET DOWN TO LOWER LEVEL.
- 12 PROVIDE 3x10 DUCT TRANSITION TO GO BELOW BEAM. (TYPICAL)
- 13 BAS INFNET CONTROL PANEL. DIVISION 16 TO PROVIDE 120V POWER TO PANEL.
- 14 CEILING RETURN GRILLE WITH MINIMUM 5' OF ACOUSTICAL FLEX DUCT IN RETURN PLENUM. (TYPICAL FOR ALL ROOMS)
- 15 REFER TO PLUMBING DRAWINGS FOR HVAC CONDENSATE LINES. (TYPICAL)
- 16 DIFFUSER LENGTHS ARE TO MATCH SLOT LIGHT LENGTHS AS SHOWN. REFER TO SHEET M-4.1 FOR DIFFUSER SCHEDULE. (TYPICAL)

RFI 626 - AIRFLOW DISCREPANCIES (ROOM 231, VAV 2.2, VAV 2.32, VAV2-11, VAV 4-32, VAV 5-4)

**tBP**  
 architecture  
 planning  
 interiors  
 management

1000 Burnett Avenue Suite 140  
 Concord, CA 94520  
 PH: 925.246.6419 FX: 925.246.6495

architect

**INTERFACE**  
 ENGINEERING

PROJECT: 2008-0108  
 CONTRACT: Shimm Wilson

717 Market Street  
 San Francisco, CA 94103  
 TEL: 415.488.2200  
 FAX: 415.488.2201  
 www.interfaceengineering.com

consultant

**RFI #/CI**

DATE: JUL 31 2012

name: \_\_\_\_\_  
 address: \_\_\_\_\_  
 city, state, zip: \_\_\_\_\_  
 agency: \_\_\_\_\_

**L-612 STUDENT SERVICES CENTER REMODEL COLLEGE COMPLEX**  
 BID DOCUMENTS

LOS MEDANOS COLLEGE  
 2700 EAST LEAND DRIVE  
 PITTSBURG, CA 94565

owner

tBP project number :	20081000
file name :	0106M22A.dwg
drawn by :	GE
checked by :	BC
date :	JULY 31, 2012
Rev. date :	
description :	

drawing title:  
**SS4 UPPER LEVEL FLOOR PLAN- HVAC DUCTWORK**

drawing no:  
**M-2.2A**  
 drawing of

**1 SS4 UPPER LEVEL FLOOR PLAN - HVAC DUCTWORK**


SCALE: 1/8"=1'-0"

**GENERAL SHEET NOTES**

- A. SEE ARCHITECTURAL INTERIOR ELEVATION PLAN FOR EXACT LOCATIONS OF ALL THERMOSTATS.
- B. LOCATE ALL VAV BOXES SUCH THAT THEY CAN BE ACCESSIBLE FROM DROP-IN CEILING TO VAV'S CONTROLLER AND VALVES.
- C. LOCATE ALL VAV BOXES AWAY FROM RECESSED LIGHTING FIXTURES & T-BAR HANGERS.
- D. COORDINATION DOCUMENTS FOR ALL DIVISION 15 AND 16 TRADES SHALL BE SUBMITTED AND SIGNED OFF BY ALL TRADES. NO SHOP DRAWINGS SHALL BE REVIEWED BY AOR AND ENGINEERS UNLESS COORDINATION DOCUMENTS ARE SIGNED OFF.

**SHEET KEYNOTES**

- 1 2"HWS/HWR HYDRONIC RISERS SERVING COLLEGE COMPLEX G22 LEVEL FLOOR (PHASE II)
- 2 HYDRONIC PIPING DOWN TO SS 3 LOWER LEVEL.
- 3 HYDRONIC PIPING DOWN FROM ROOF.
- 4 REHEAT COIL CONNECTION KIT WITH 3-WAY VALVE.
- 5 MINIMUM ALLOWABLE FOR END RUNS PIPING IS TO BE SIZED AT 3/4" (TYPICAL).

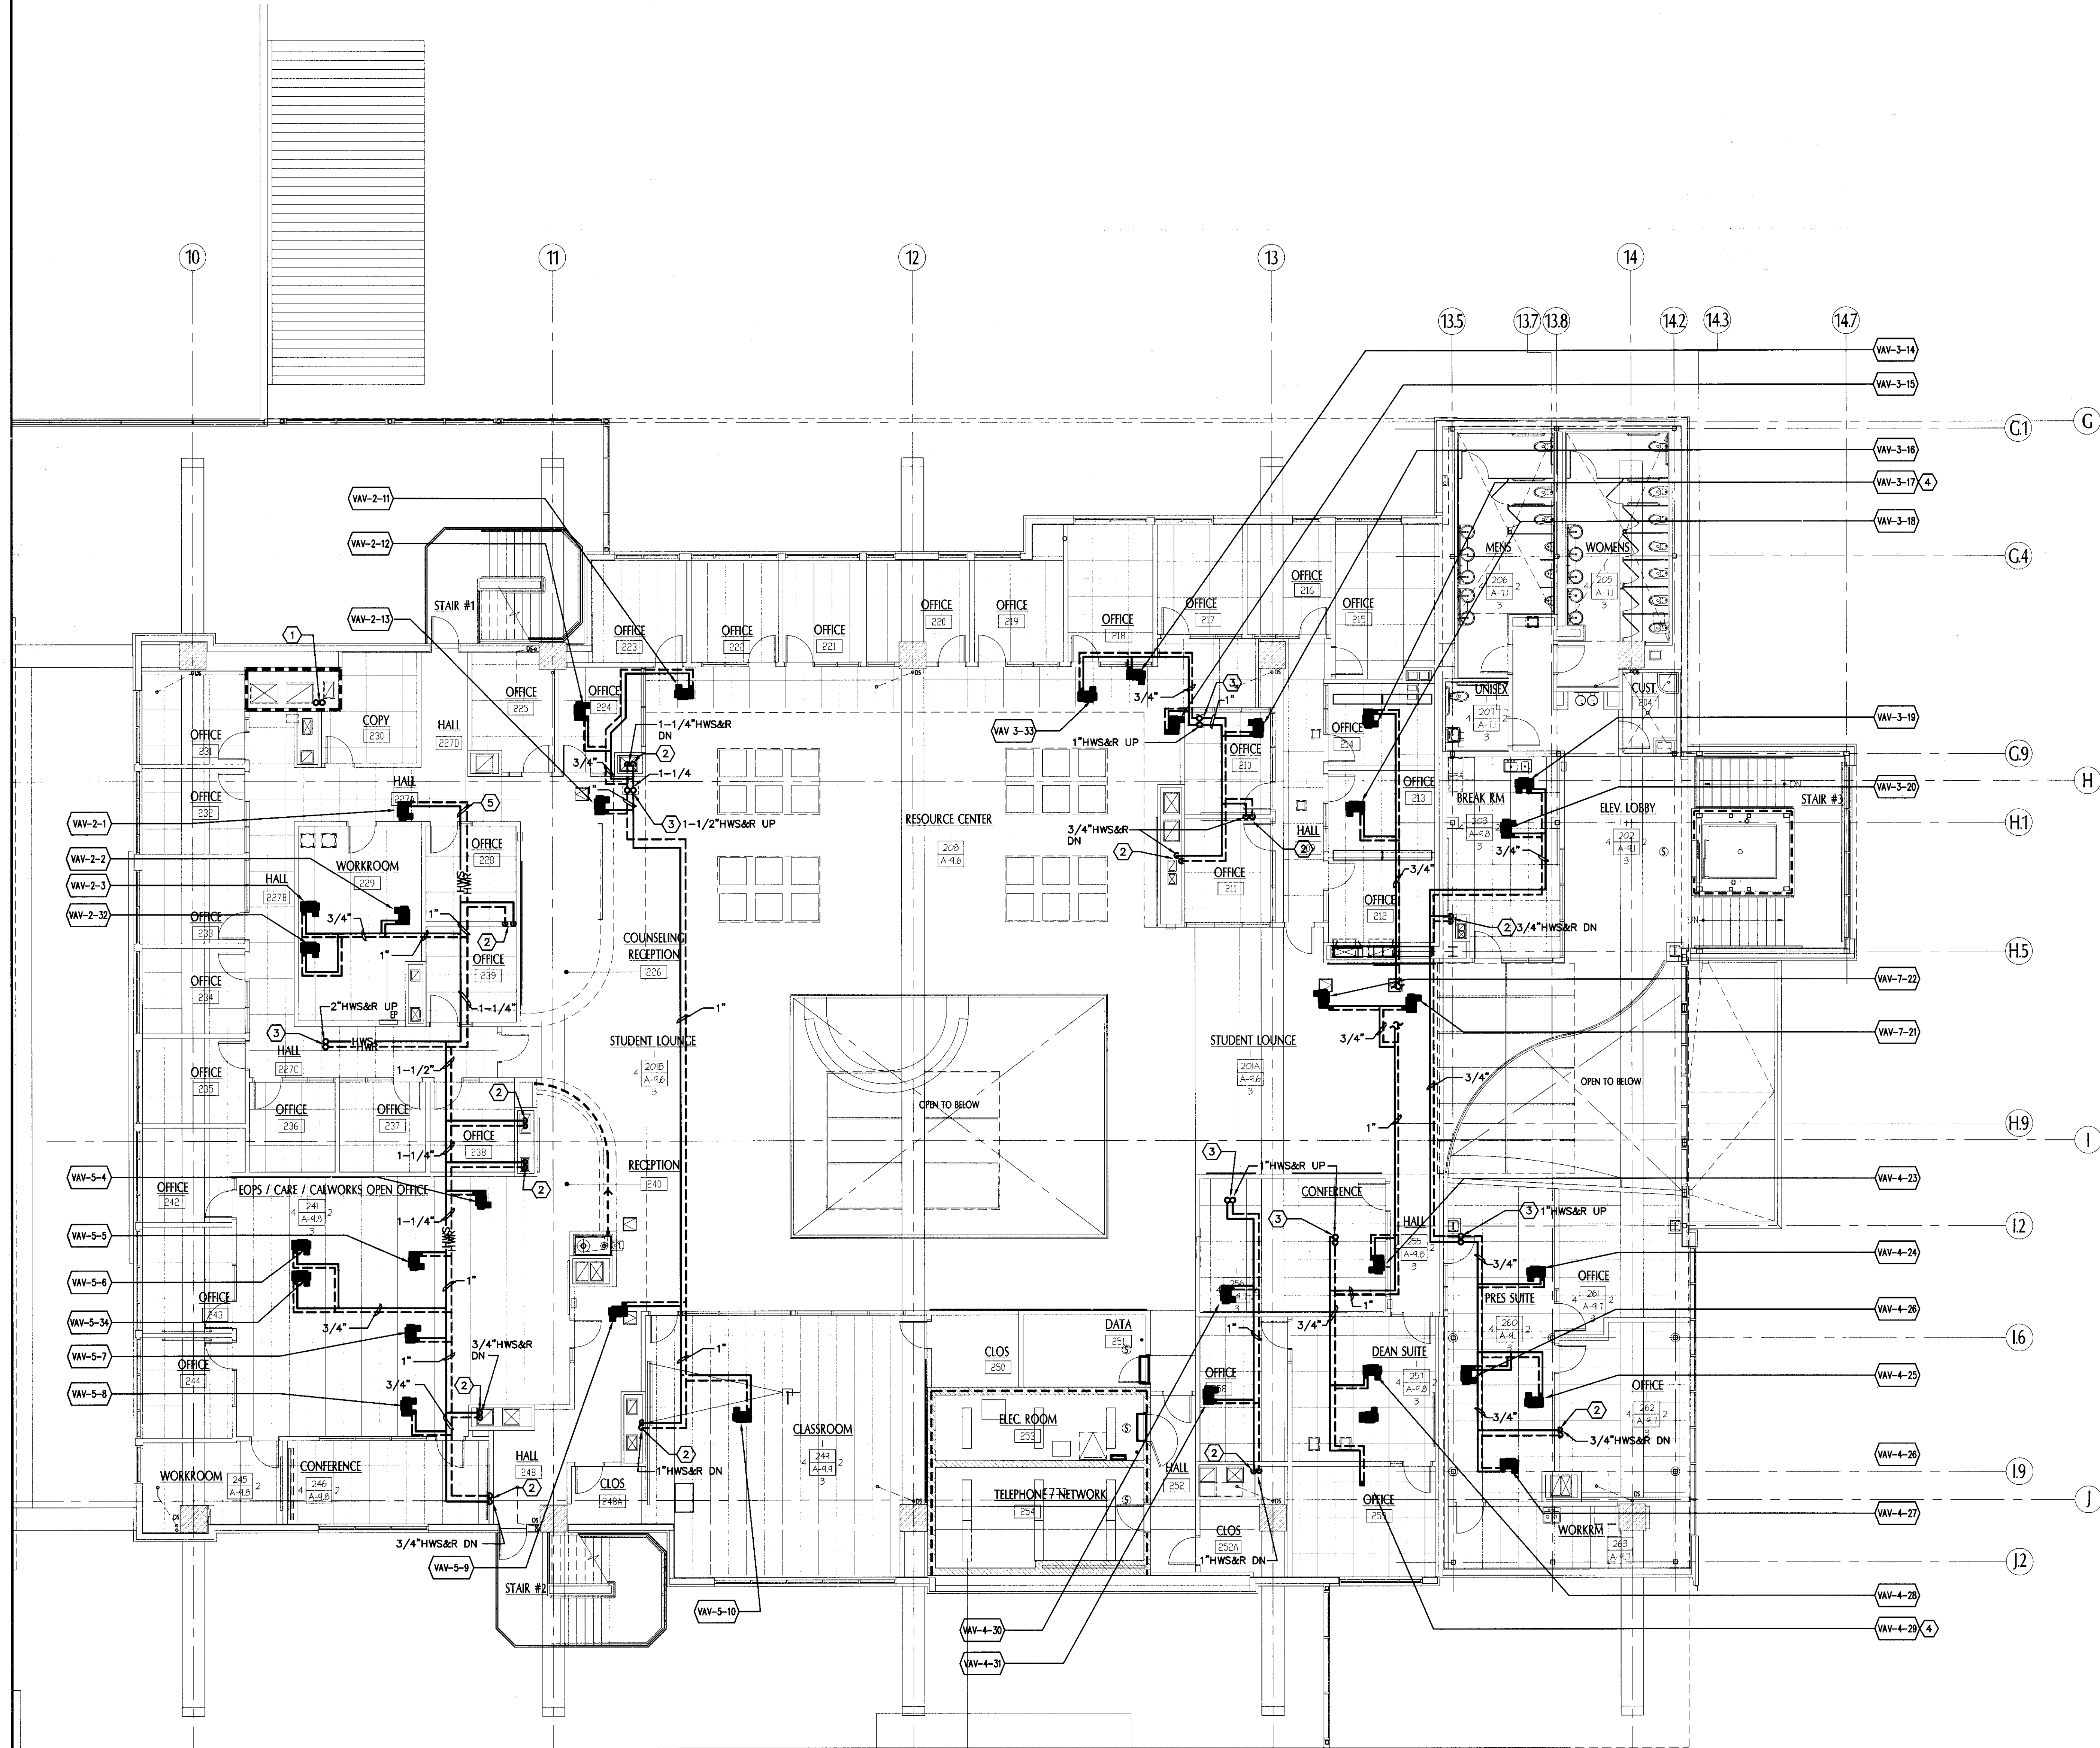

**1 SS4 UPPER LEVEL FLOOR PLAN - HVAC REHEAT PIPING**  
 SCALE: 1/8"=1'-0"

**tBP**  
 architecture  
 planning  
 interiors  
 management

1000 Burnett Avenue Suite 140  
 Concord, CA 94520  
 ph: 925.246.6419 fx: 925.246.6495

architect

**INTERFACE ENGINEERING**

PROJECT: 2008-0108  
 CONTRACT: Shawn Wilson

717 Market Street  
 Suite 200  
 Concord, CA 94520  
 TEL: 415.469.2400  
 FAX: 415.469.2299  
 www.interfaceeng.com

consultant

**RE #/CI**

REGISTRATION STAMP  
 DIVISION OF THE STATE ARCHITECT  
 OFFICE OF REGULATION SERVICES  
 APPL 01-112727  
 AC [Signature]  
 DATE: JUL 31 2012

name \_\_\_\_\_  
 address \_\_\_\_\_  
 city, state, zip \_\_\_\_\_  
 ph \_\_\_\_\_  
 agency \_\_\_\_\_

**L-612 STUDENT SERVICES CENTER REMODEL COLLEGE COMPLEX**  
 BID DOCUMENTS

LOS MEDANOS COLLEGE  
 2700 EAST LELAND DRIVE  
 PITTSBURG, CA 94565

owner

tBP project number : 20670.00  
 file name: 0106M22B.dwg  
 drawn by: GE checked by: BC  
 date: **JULY 31, 2012**  
 Rev. date: description

drawing title:  
**SS4 UPPER LVL FLR PLAN - HVAC REHEAT PIPING**


drawing no:  
**M-2.2B**  
 drawing of

**GENERAL SHEET NOTES**

A. CONTRACTOR SHALL COORDINATE DUCT DETECTOR REQUIREMENTS BETWEEN MECHANICAL, ELECTRICAL AND FIRE ALARM DRAWINGS AND SPECIFICATIONS.

**SHEET KEYNOTES**

- 1 PROVIDE STEP LADDER OVER PIPING, SEE ARCHITECTURAL DETAIL # 1/701. (TYPICAL)
- 2 HEATING WATER SUPPLY/RETURN DOWN THROUGH ROOF. PROVIDE SEISMIC PIPE LOOP IN PIPING BETWEEN HIGH ROOF AND NEW ADDITION.
- 3 SUPPLY/RETURN DUCT DN TO SS4 UPPER LEVEL CEILING.
- 4 SUPPLY/RETURN DUCT DN TO SS3 LOWER CEILING. MAXIMUM 30X30 THROUGH EXISTING CONCRETE WAFFLE STRUCTURE.
- 5 SUPPLY/RETURN DUCT DN TO CC2 SECOND FLOOR CEILING. MAXIMUM 30X30 THROUGH EXISTING CONCRETE WAFFLE STRUCTURE.
- 6 INSTALL ISOLATION VALVES DURING BUILDING OFF HOUR. SCHEDULE VALVES INSTALLATION WITH LMC FACILITY MANAGER. (PHASE II)
- 7 PROVIDE NEMA 3R ENCLOSURE FOR PUMP CONTROLS & VFD MOUNT ON EXISTING CONCRETE WALL NOT USED.
- 8
- 9 PROVIDE CHILLER & HEATING WATER PUMPS, ISOLATION VALVES AND ALL ASSOCIATED HYDRONIC COMPONENTS FOR A COMPLETE BOOSTER PUMP SYSTEM.
- 10 (E) AC UNITS TO REMAIN AND KEEP OPERATIONAL DURING CONSTRUCTION.
- 11 PROVIDE DUCT SUPPORTS. SEE DETAIL 4/M-3.2 (TYPICAL)
- 12 REFRIGERANT LINE SET DOWN THROUGH ROOF TO ASSOCIATED FAN COIL UNIT.
- 13 PROVIDE PIPE SUPPORT FOR REFRIGERANT PIPING. SEE DETAIL 1/M3.2 (TYPICAL)

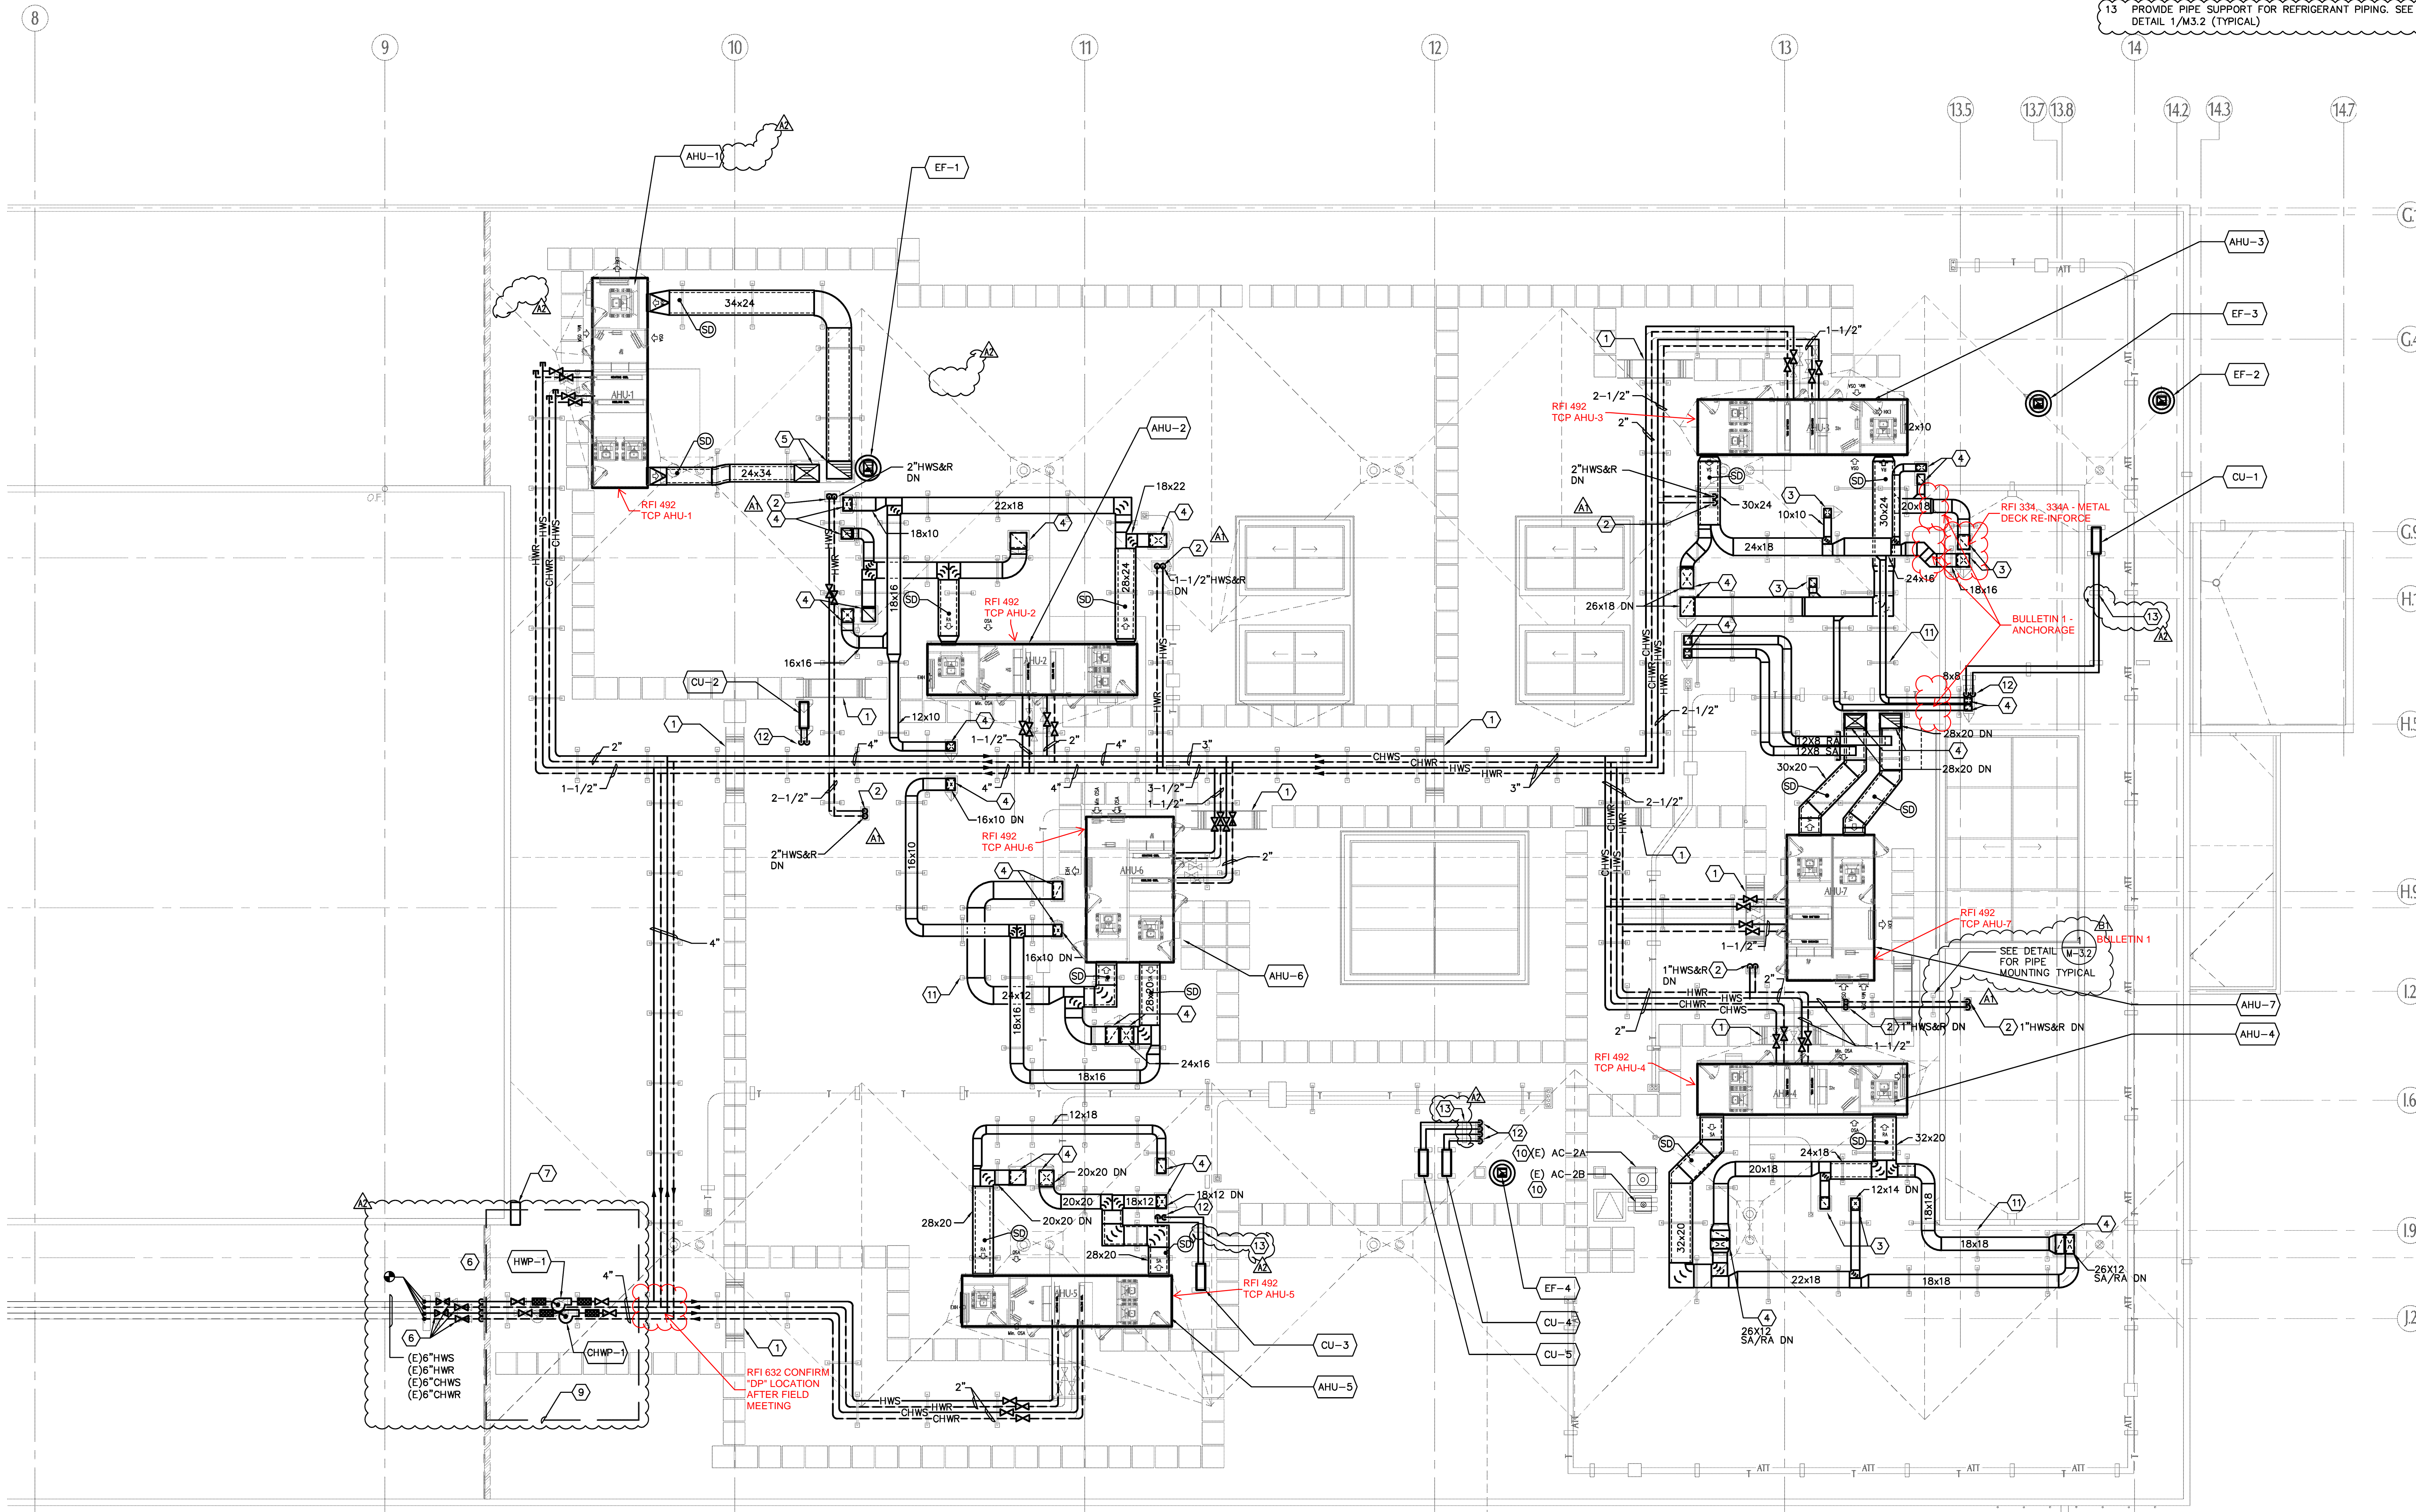

**1 ROOF FLOOR PLAN - MECHANICAL**  
 SCALE: 1/8"=1'-0"

**tBP**  
 architecture  
 planning  
 interiors  
 management

tBP/Architecture  
 1000 Burnett Avenue Suite 140  
 Concord, CA 94520  
 ph: 925.246.6419 fx: 925.246.6495  
 architect

**INTERFACE**  
 ENGINEERING

PROJECT: 2008-0108  
 CONTRACT: Shimm Wilson

1777 Market Street  
 San Francisco, CA 94103  
 No. 028802  
 Lic. 8-3-2007  
 www.interfaceengineering.com

PROFESSIONAL ENGINEER - MECHANICAL  
 CIVIL ENGINEER - MECHANICAL  
 REGISTERED ARCHITECT - MECHANICAL

consultant

**FILE #/CI**

IDENTIFICATION SYMBOL  
 DIVISION OF REGULATION SERVICES  
 APRIL 01-112272  
 AC: RLS  
 DATE: \_\_\_\_\_

name \_\_\_\_\_  
 address \_\_\_\_\_  
 city, state, zip \_\_\_\_\_  
 ph \_\_\_\_\_  
 agency \_\_\_\_\_

**L-612 STUDENT SERVICES CENTER REMODEL COLLEGE COMPLEX**  
**BID DOCUMENTS**

LOS MEDANOS COLLEGE  
 2700 EAST LELAND DRIVE  
 PITTSBURG, CA 94565

owner


tBP project number: 20610.00  
 file name: 0106M23.dwg  
 drawn by: GE checked by: BC  
 date: **JULY 31, 2012**

Rev.	date	description
9/2/12		ADDENDUM #1
10/10/12		ADDENDUM #2

THIS DRAWING AND THE DESIGN, SPECIFICATIONS, LEGS AND OTHER INFORMATION CONTAINED HEREIN CONSTITUTE UNPUBLISHED WORK OF UNPUBLISHED WORK AND SHALL REMAIN THE PROPERTY OF UNPUBLISHED WORK. NO PART THEREOF SHALL BE REPRODUCED, COPIED, EITHER WHOLLY OR IN PART, OR OTHERWISE USED IN ANY MANNER WITHOUT THE ADVANCED EXPRESS WRITTEN CONSENT OF UNPUBLISHED WORK.


drawing title:  
**ROOF FLOOR PLAN - MECHANICAL**

drawing no:  
**M-23**  
 drawing of

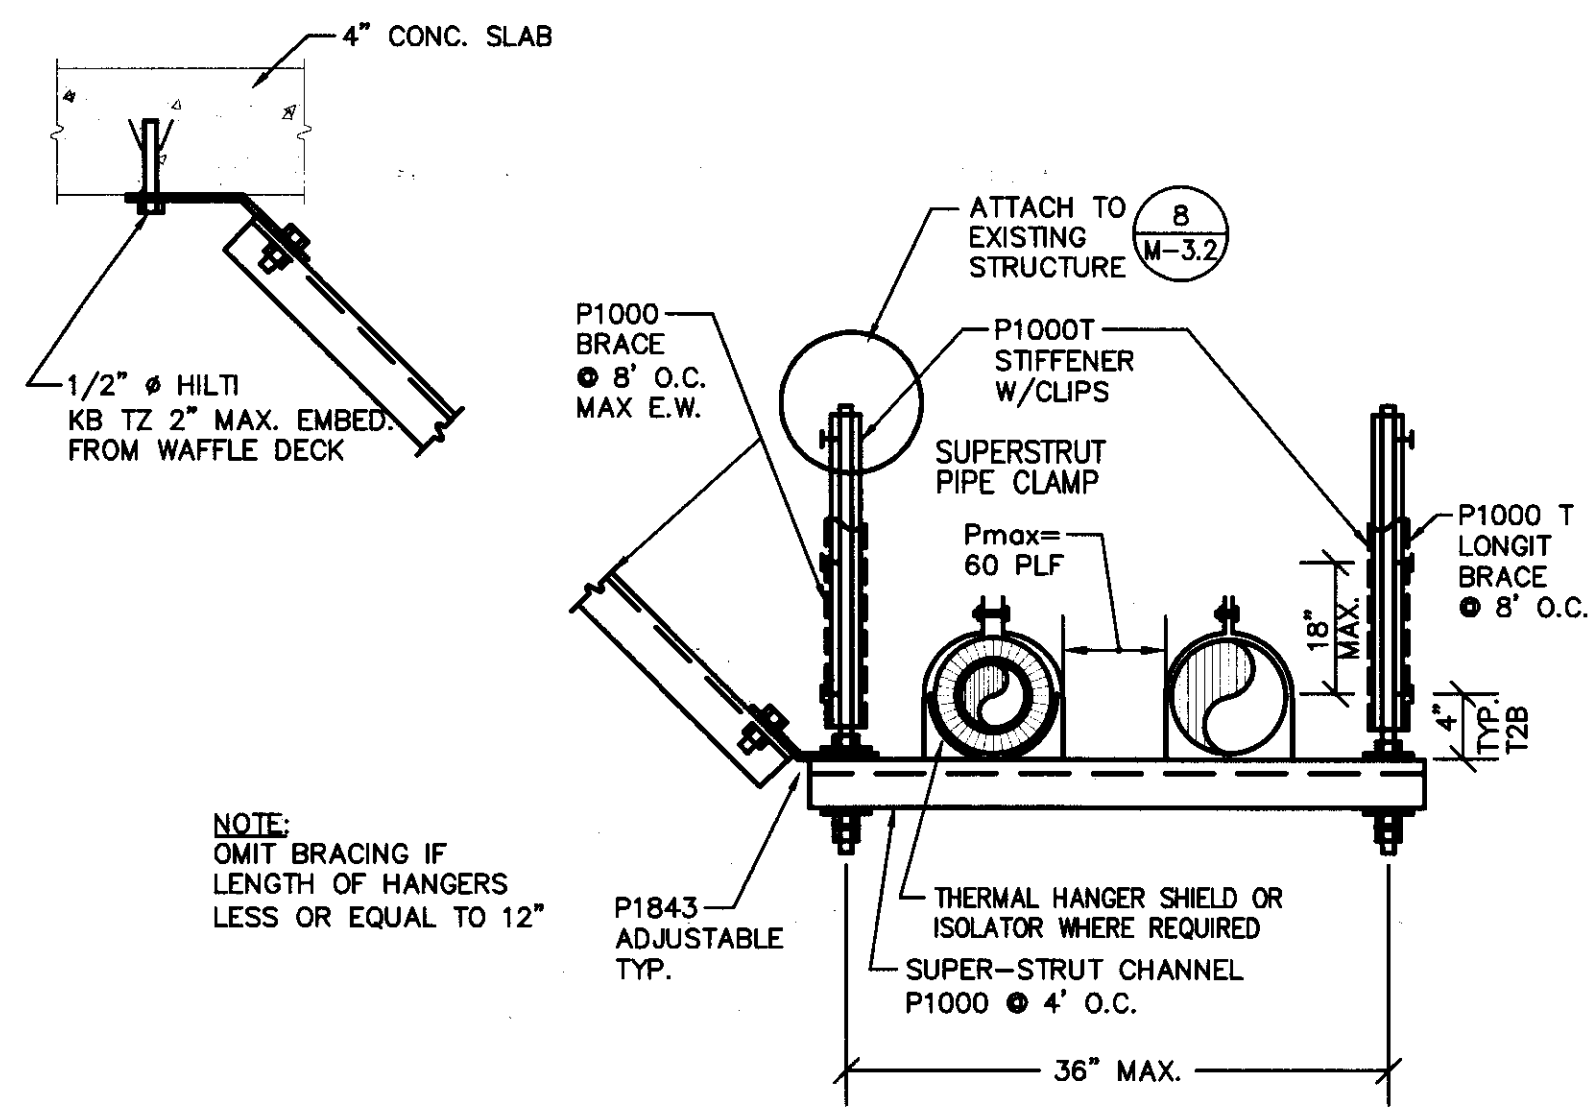

PER OPA-0349


1 TRAPEZE PIPE HANGER DETAIL  
NO SCALE

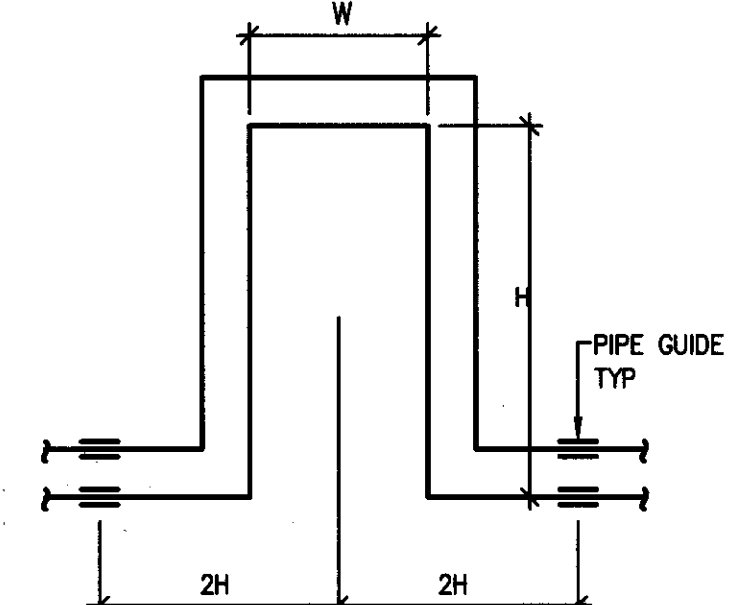

PIPE SIZE	W-MIN	H-MIN
4"	48"	98"
2-1/2" TO 3"	42"	84"
1-1/4" TO 2"	36"	72"
1" & LESS	24"	48"

BASED ON STEEL PIPE ANCHOR TO ANCHOR 6" EXPANSION


4 PIPE THERMAL EXPANSION LOOP DETAIL  
NO SCALE

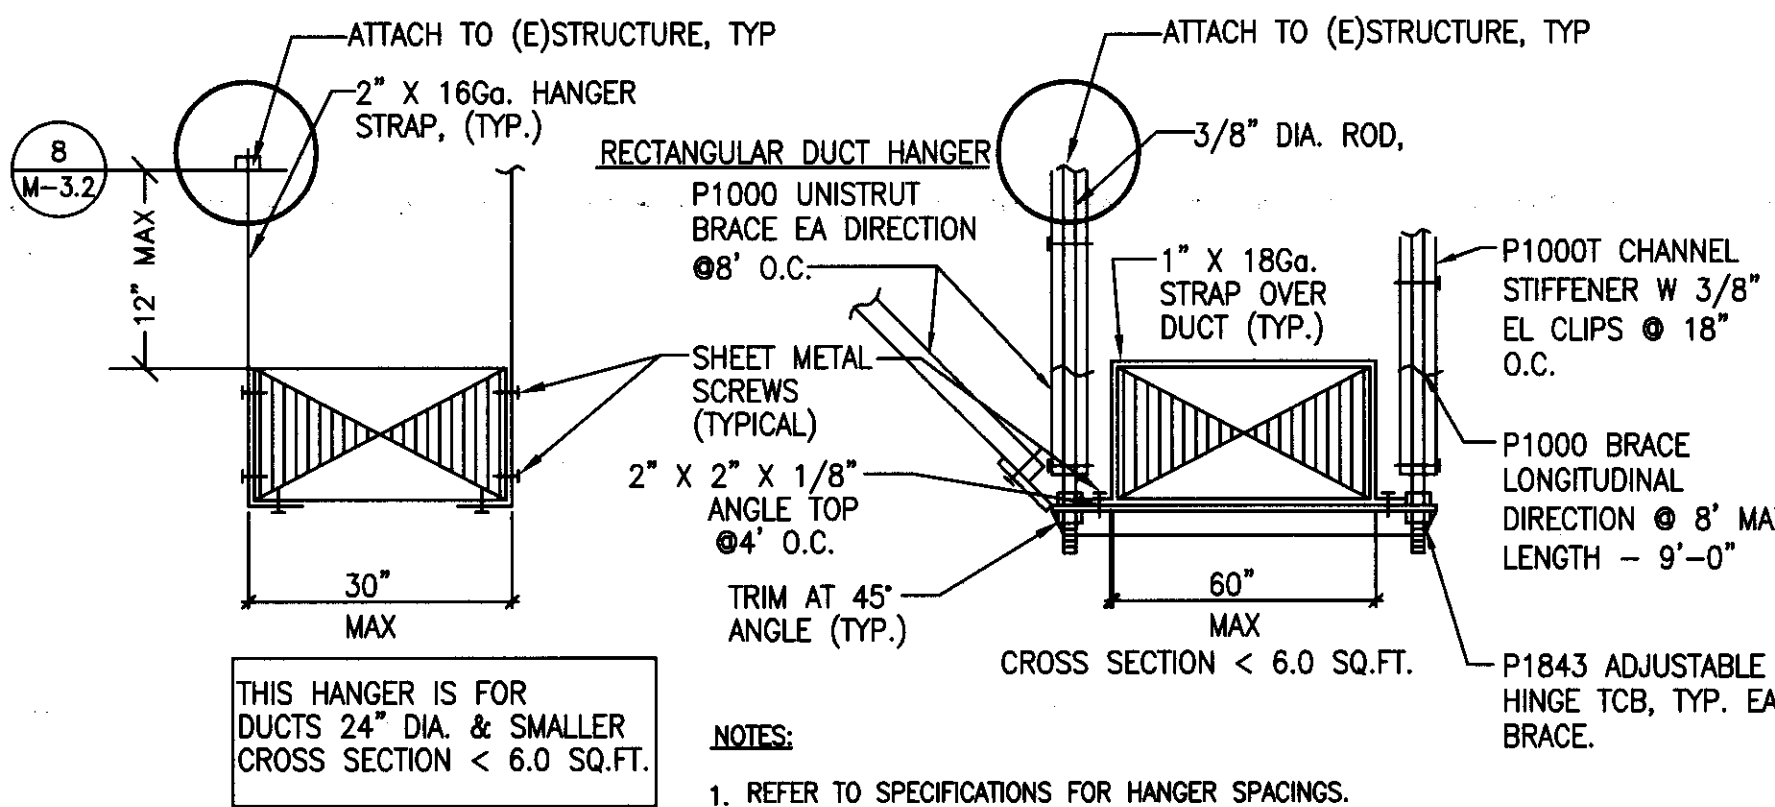


THIS HANGER IS FOR DUCTS 24" DIA. & SMALLER CROSS SECTION < 6.0 SQ.FT.

- NOTES:
- REFER TO SPECIFICATIONS FOR HANGER SPACINGS.
  - ATTACHMENTS TO OVERHEAD STRUCTURE SHALL BE MADE IN ACCORDANCE WITH STRUCTURAL ENGINEERS REQUIREMENTS AND WEIGHT LIMITATIONS. ALL ATTACHMENT METHODS TO STRUCTURE SHALL BE SUBMITTED TO ARCHITECT AND STRUCTURAL ENGINEER FOR REVIEW.
  - PROVIDE SWAY & SEISMIC BRACING PER ISAT SEISMIC GUIDELINES AND THE LATEST EDITION OF CALIFORNIA BUILDING CODE. CONTRACTOR SHALL INDICATE LOCATIONS OF SEISMIC BRACING ON THE SHOP DRAWING SUBMITTALS.
  - HANGER MATERIAL SUPPORTING FLEXIBLE DUCT SHALL IN NO CASE BE LESS THAN 1 1/2 INCHES WIDE. FLEXIBLE DUCT SHALL BE SUPPORTED PER MANUFACTURER'S RECOMMENDED MATERIALS, BUT AT NO GREATER DISTANCE THAN 4 FEET MAX. PERMISSIBLE SAG IS MAX. 1/2 INCHES PER FOOT OF SPACING BETWEEN SUPPORTS.
  - HANGER STRAP/ROD SECURE TO STRUCTURE AS REQ'D SEE DETAIL #6/M-3.2

7 CONCEALED DUCT HANGER DETAIL  
NO SCALE

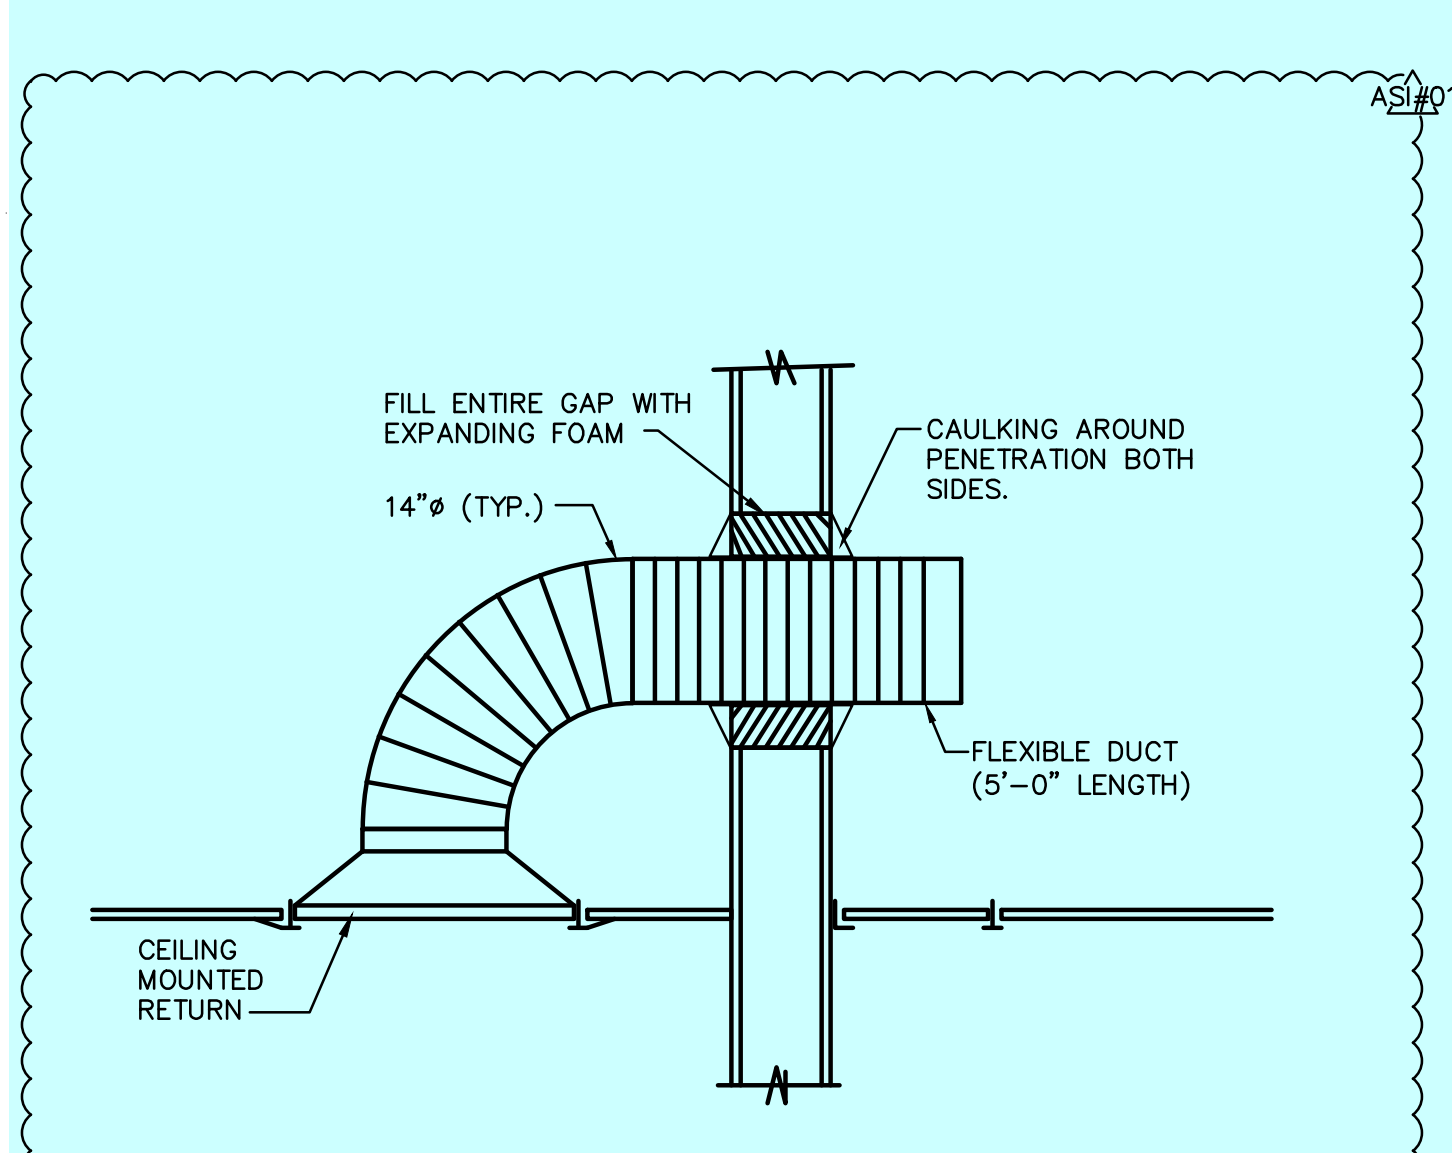


10 FLEXIBLE DUCT PENETRATION DETAIL  
NO SCALE

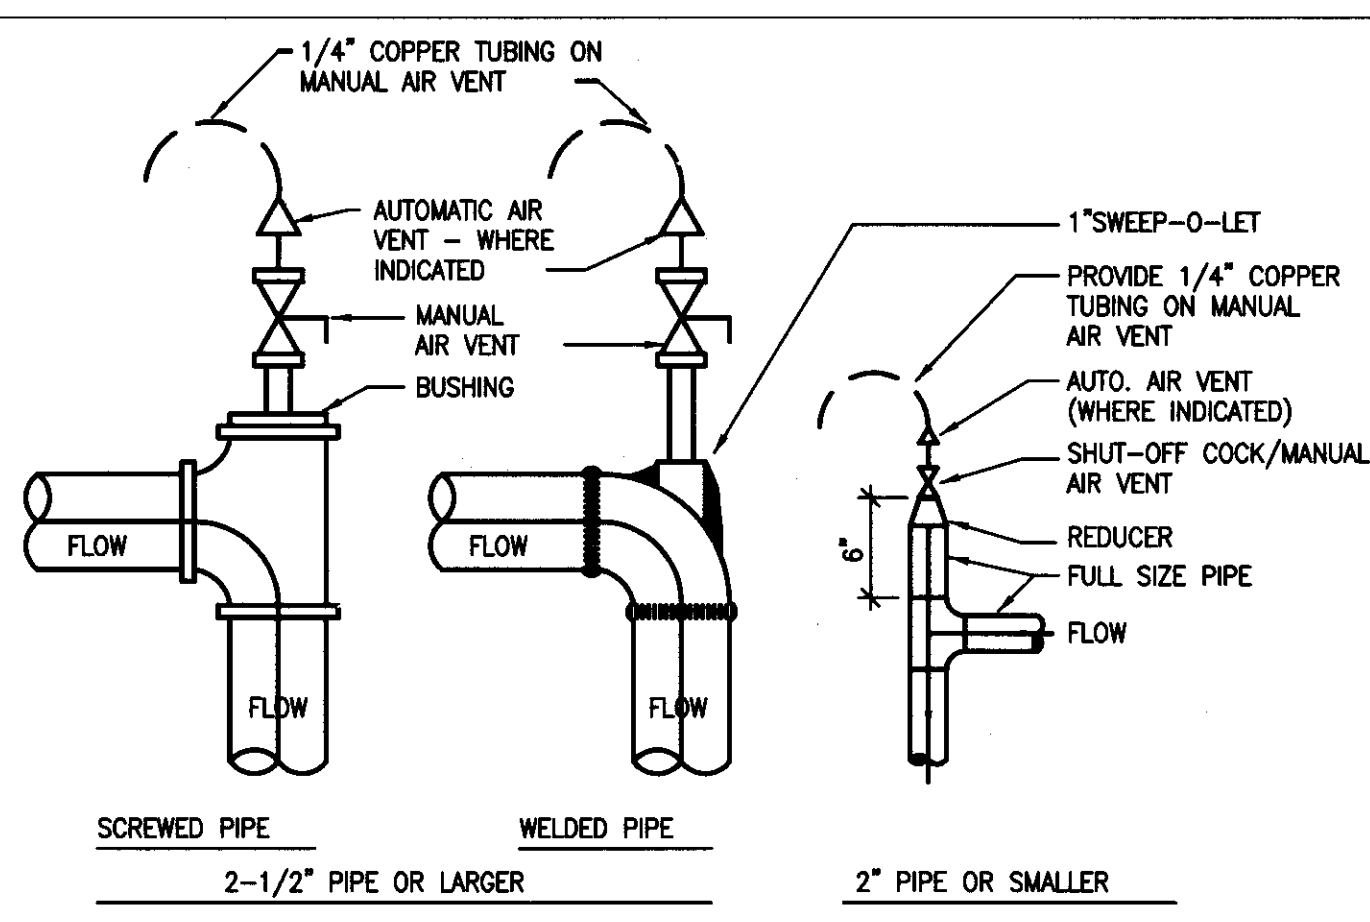


- NOTES:
- PROVIDE MANUAL AIR VENTS AT ALL PIPING HIGH POINTS & AT POINTS IN THE SYSTEM WHERE AIR CAN GET TRAPPED.
  - LOCATE AIR VENTS IN ELBOWS AS INDICATED ABOVE. WATER FLOW SHOULD ALWAYS BE HORIZONTAL TOWARD THE ELBOW & THEN VERTICALLY DOWN.
  - PROVIDE A 1/4" MINIMUM TUBE ON THE DISCHARGE OF BOTH MANUAL & AUTOMATIC VENTS. TERMINATE TUBING WHERE ACCESSIBLE FOR VENTING INTO A CAN OR AT NEAREST AIR GAP WASTE.
  - ALL AIR VENTS SHALL BE ACCESSIBLE. PROVIDE ACCESS DOOR AS NECESSARY.
  - PROVIDE AUTOMATIC AIR VENTS WHERE VENTS WHERE INDICATED AND/OR SPECIFIED. PROVIDE AT LEAST TWO AIR VENTS IN EACH PIPING SYSTEM.

2 AIR VENT DETAIL  
NO SCALE

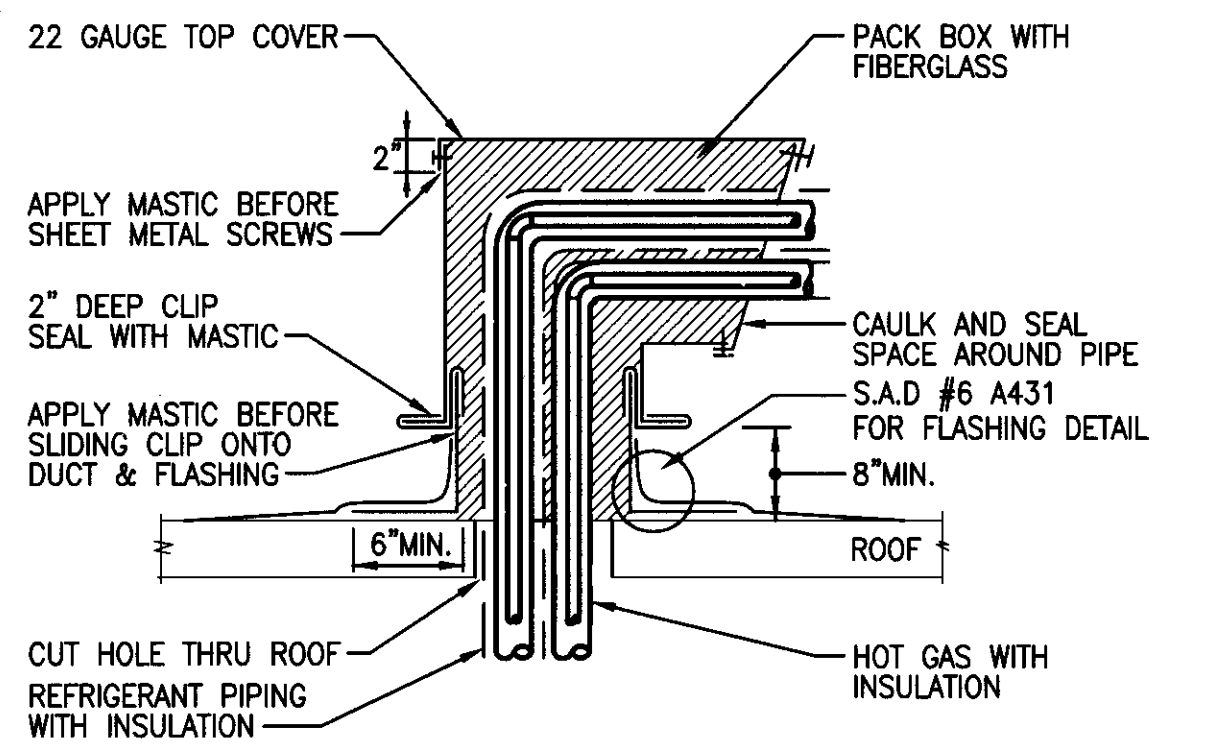


- NOTE: 1. PAINT ALL EXPOSED SHEET METAL PARTS WITH WEATHER RESISTANT PAINT. (COLOR PER M&O)  
2. PAINT ALL EXPOSED REFRIGERANT PIPING INSULATION ON ROOF.

5 REFRIGERANT PIPING PENETRATION DETAIL  
NO SCALE

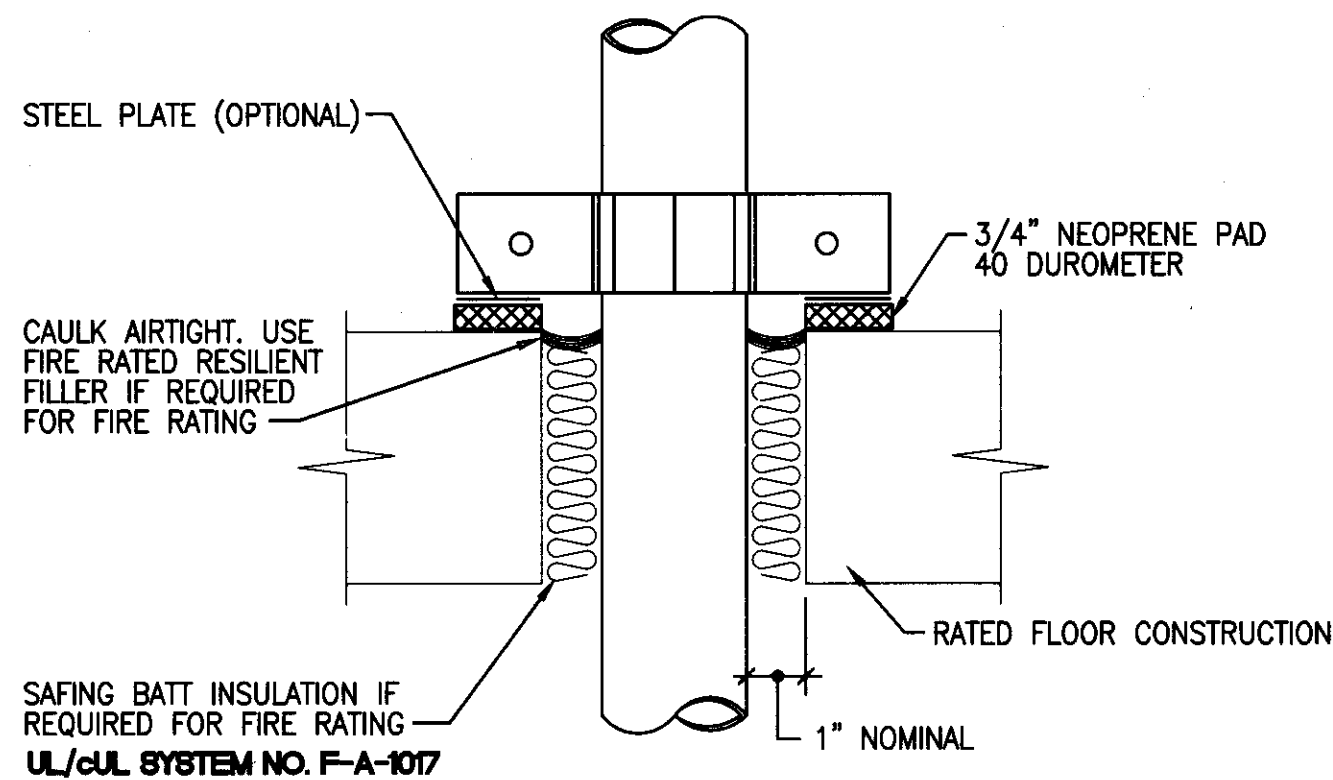

- NOTE: IF PIPE IS SUSPENDED FROM OR DIRECTLY ATTACHED TO STRUCTURE OR OTHER BUILDING ELEMENTS, USE 1/2" THICK, 40-DUROMETER NEOPRENE AS SLEEVE BETWEEN PIPE AND PIPE COLLAR.


8 PIPE ISOLATION AT FLOOR PENETRATION  
NO SCALE

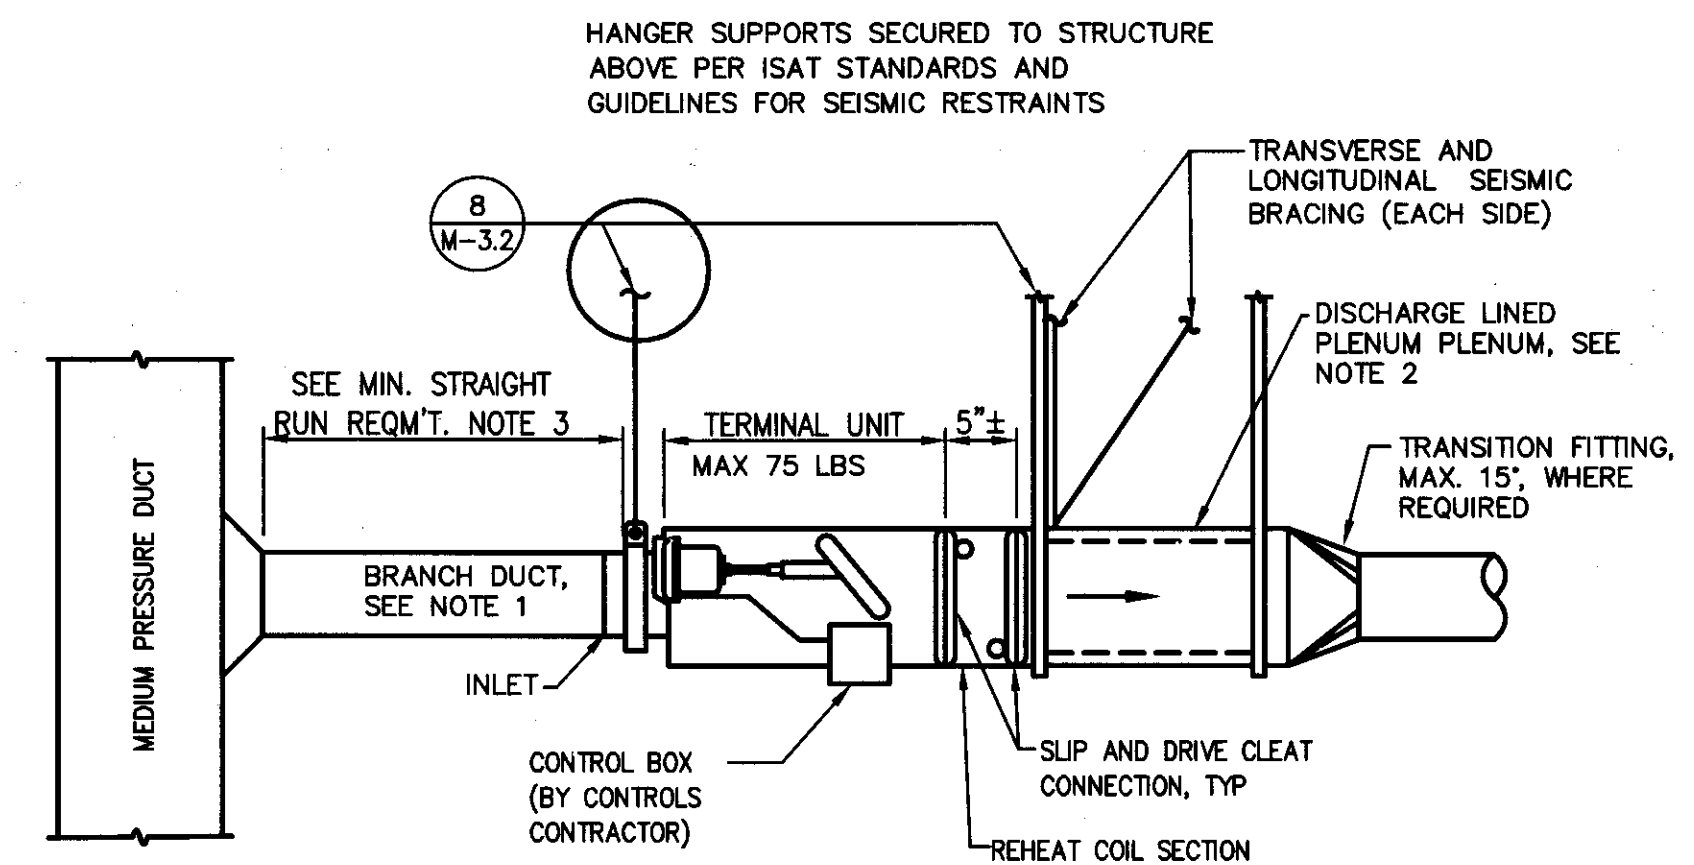

- NOTES:
- BRANCH DUCT SIZE TO MATCH UNIT INLET CONNECTION. FOR BRANCH DUCTS OVER SIX FEET IN LENGTH, INCREASE BRANCH DUCT ONE SIZE AND PROVIDE TRANSITION IMMEDIATELY UPSTREAM OF MINIMUM STRAIGHT DUCT RUN.
  - MINIMUM 4'-0" LONG LINED PLENUM EQUAL TO TERMINAL BOX OUTLET SIZE.
  - MINIMUM STRAIGHT DUCT RUN:
  - CONTRACTOR TO VERIFY ORIENTATION OF VAV BOXES TO ALLOW FOR MAINTENANCE ACCESS.

DUCT DIA (IN)	MIN STRAIGHT RUN (IN)
6	24
8	32
10	40
12	48
14-16	60


11 TERMINAL UNIT INSTALLATION DETAIL  
NO SCALE

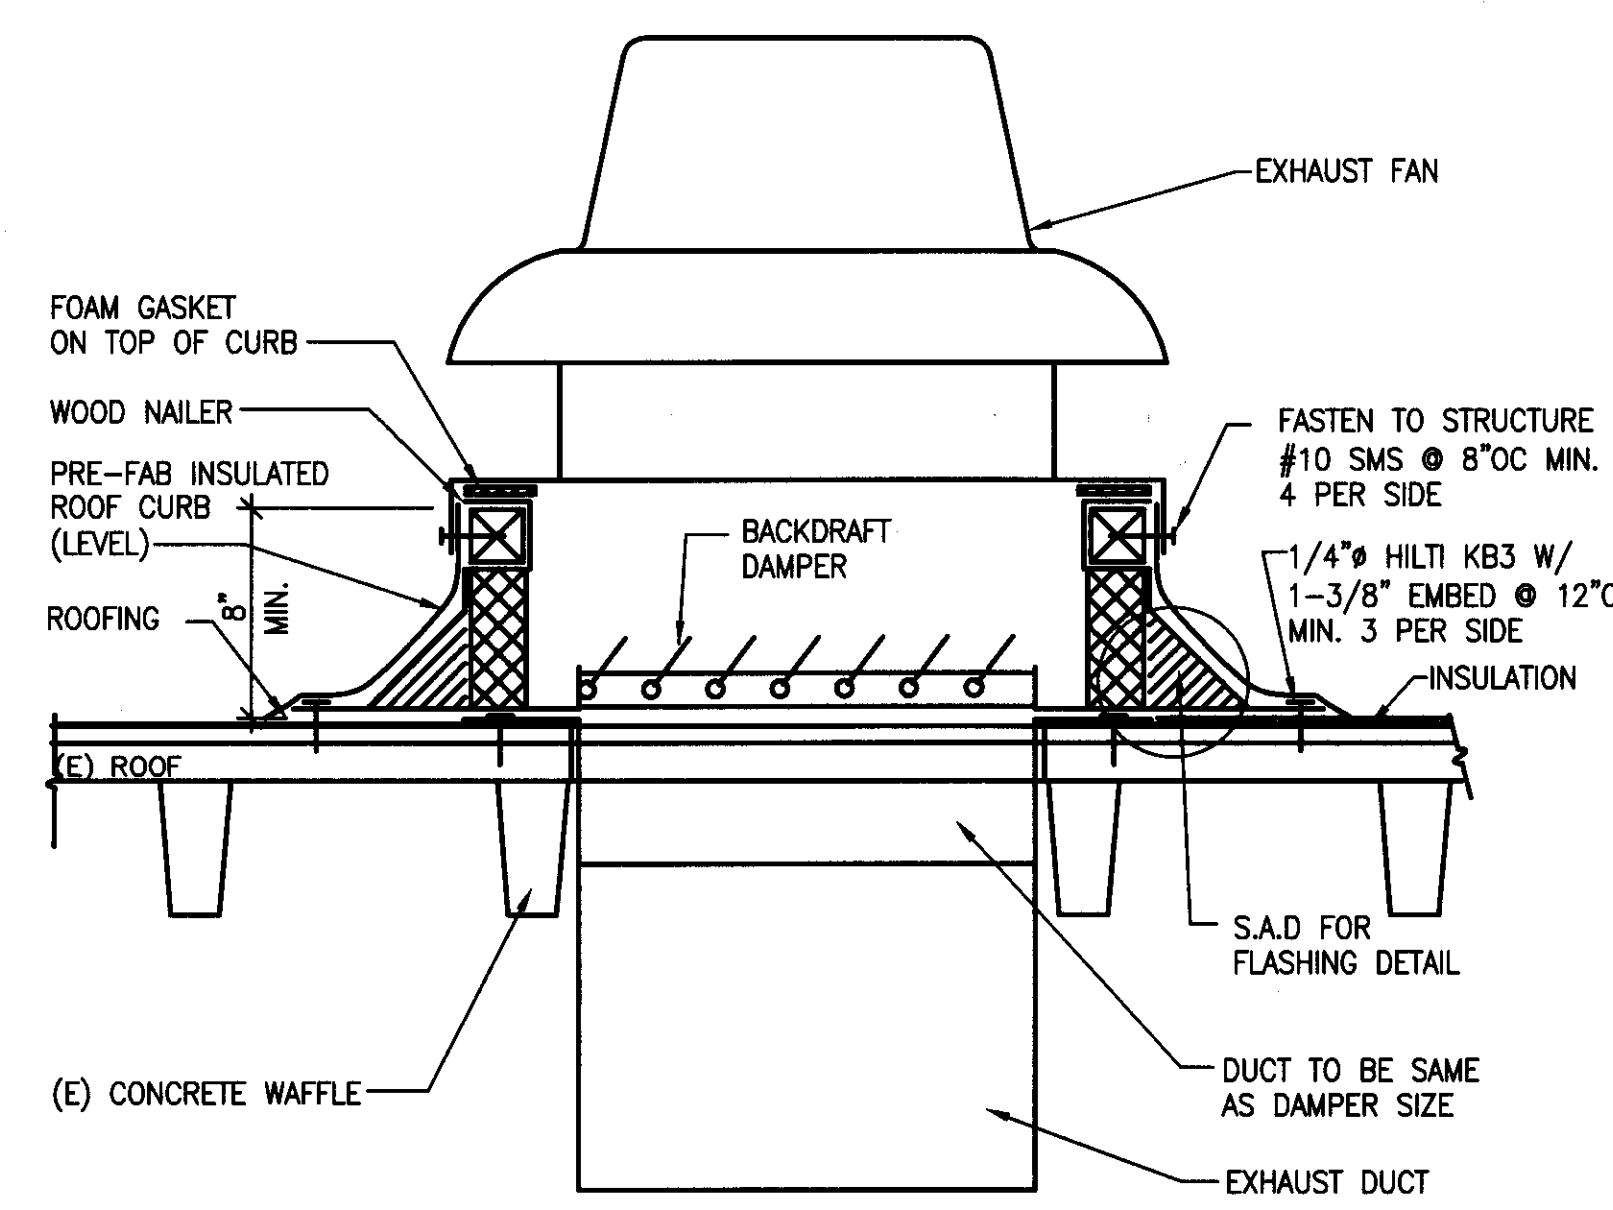


NOTE: SEE ARCH. AND STRUCT. DWGS FOR ROOF PENETRATION, FLASHING & ROOFING DETAILS.

3 EXHAUST FAN MOUNTING DETAIL  
NO SCALE

Qty.	Size	A Weld/Thread	B	Movement *		Max. Working Pressure (psi)	Support Bracket	Note
				Seismic All Directions	Axial			
	1/2"	15"	18"	4"	+/-4"	150	1/2"	
	3/4"	15-1/4"	20"	4"	+/-4"	150	1/2"	
	1"	16"	22"	4"	+/-4"	150	5/8"	
	1-1/4"	16-3/4"	22"	4"	+/-4"	150	5/8"	
	1-1/2"	17-1/2"	23"	4"	+/-4"	150	5/8"	
	2"	20"	25"	4"	+/-4"	150	5/8"	

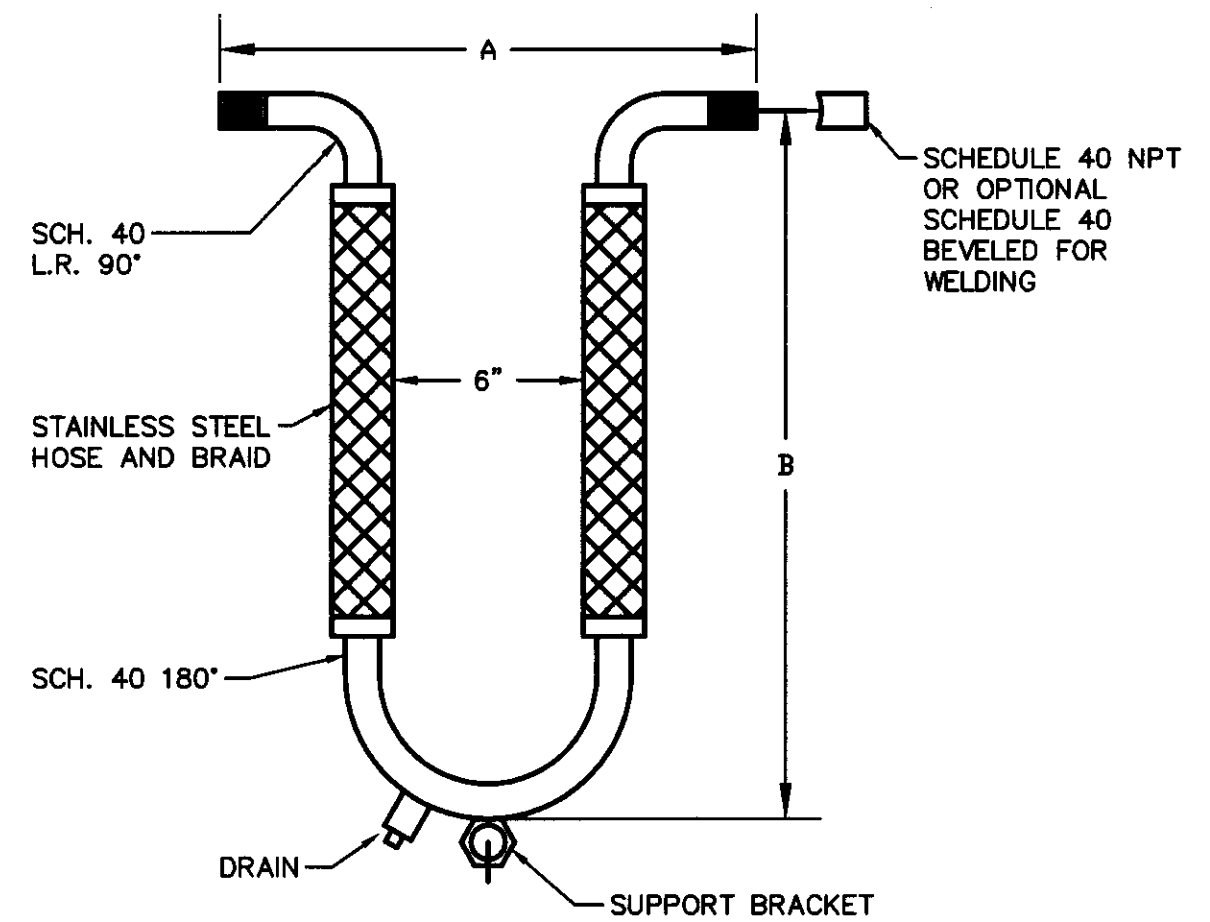


6 FLEXIBLE THERMAL EXPANSION LOOP  
NO SCALE

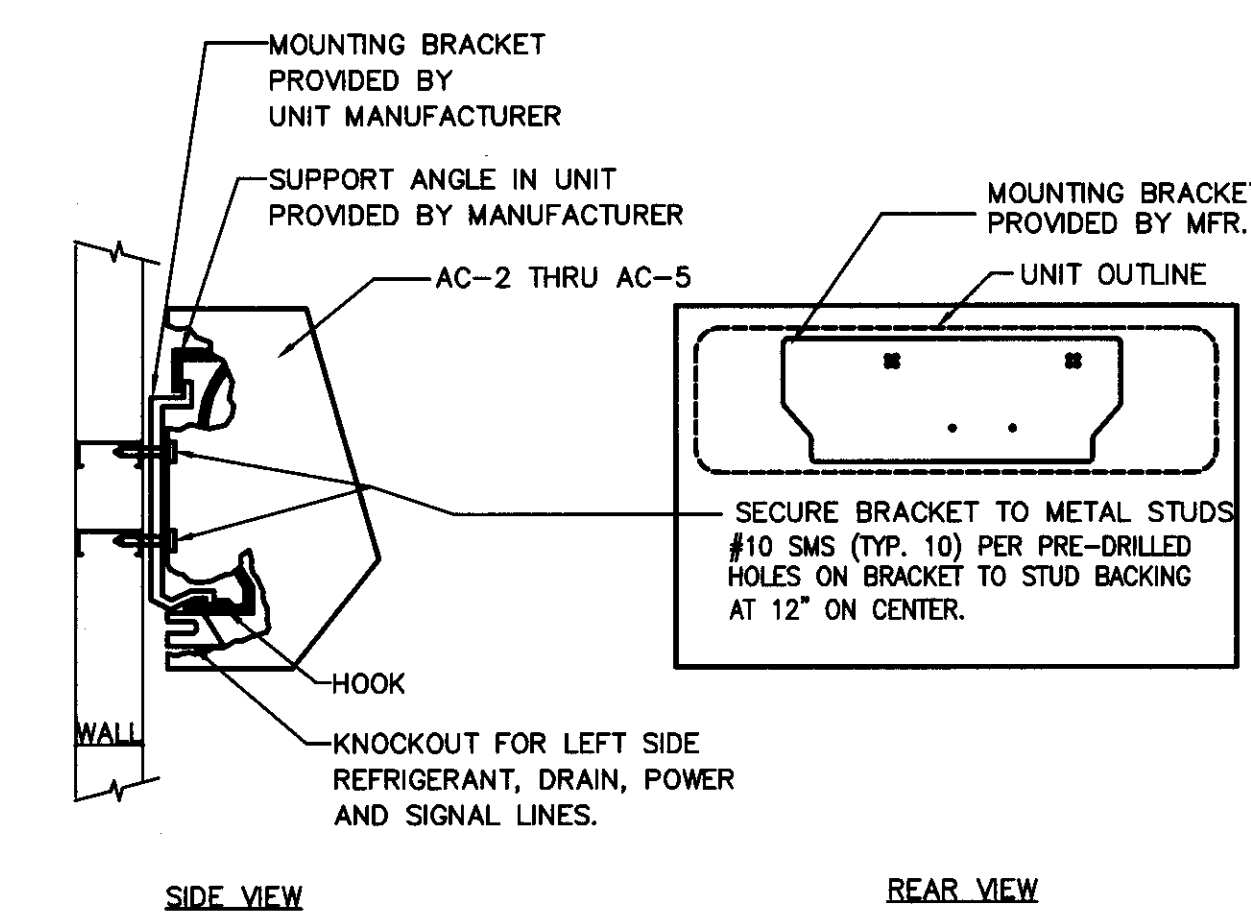


- NOTE:
- FOR DRAIN CONNECTION, REFER TO PLUMBING DRAWINGS.
  - REFER TO MFR. INSTALLATION MANUAL FOR UNIT MOUNTING INSTRUCTION
  - UNIT OPERATING WEIGHT = 46 LBS.

9 WALL MOUNTED FAN COIL DETAIL  
NO SCALE

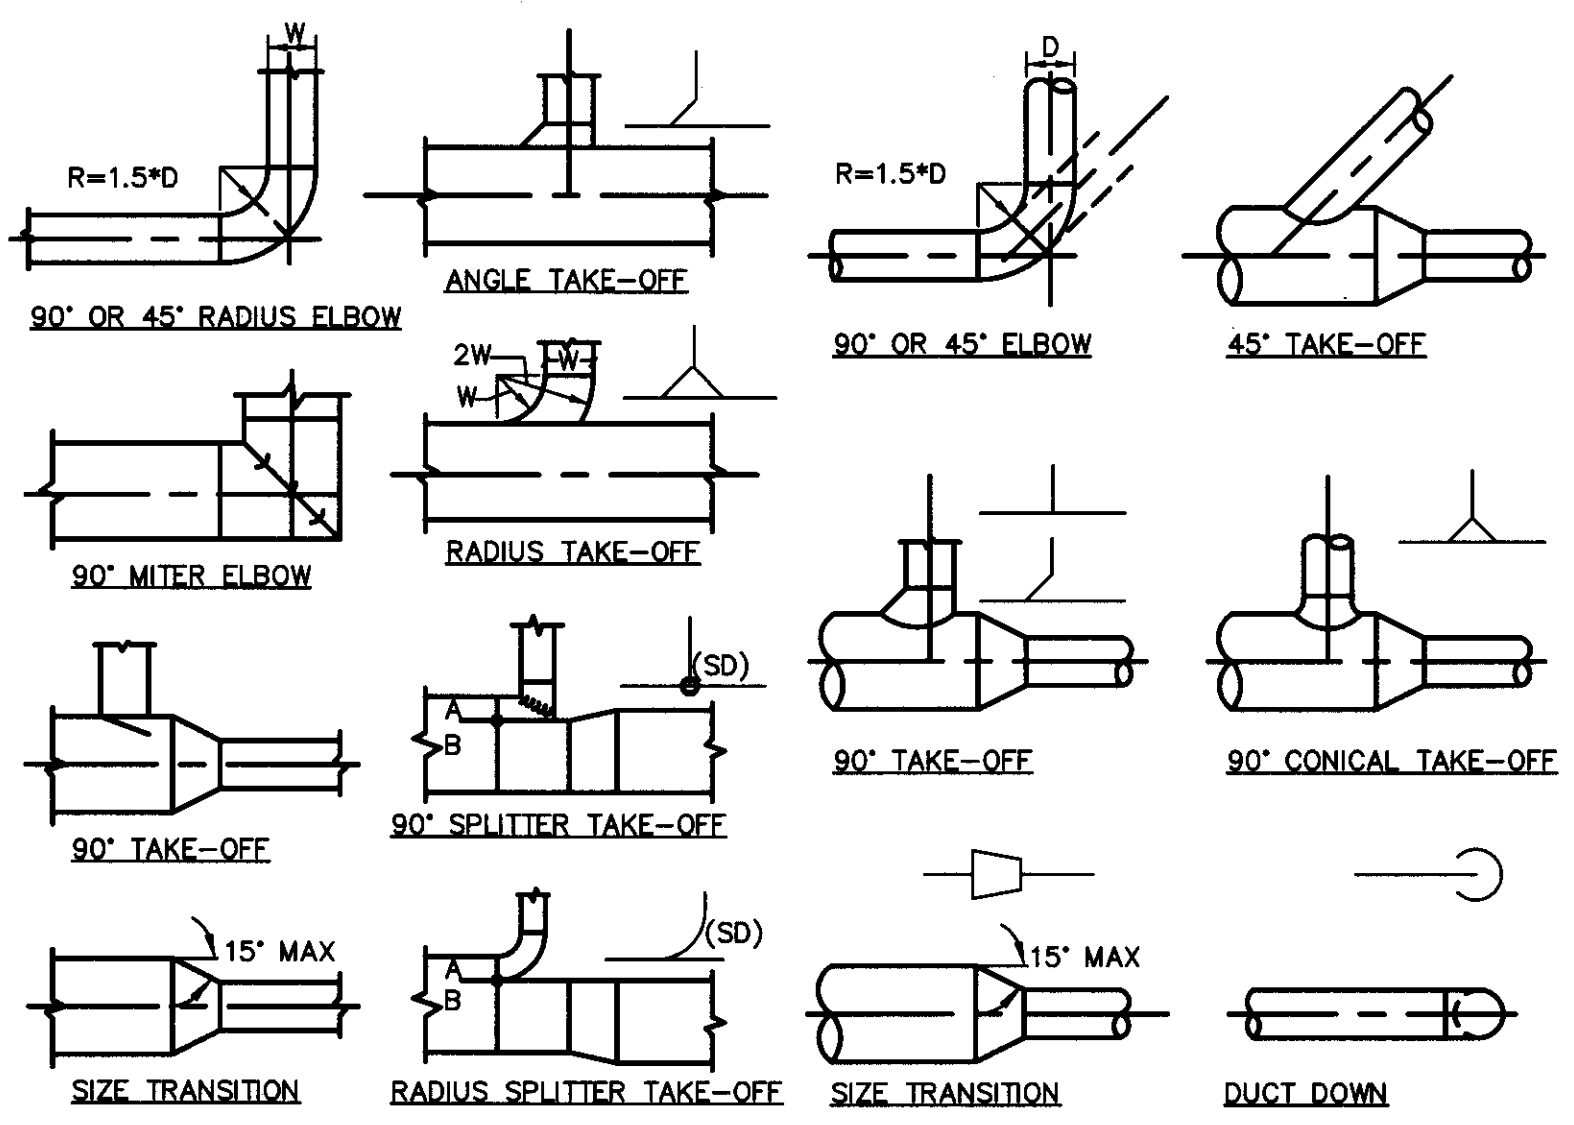

- NOTES:
- SINGLE-LINE ILLUSTRATIONS ARE SYMBOLS USED ON DRAWINGS
  - SIZE A&B DIMENSIONS IN PROPORTION TO AIR QUANTITIES IN EACH LEG SPLIT

12 DUCT BRANCHING DETAIL  
NO SCALE

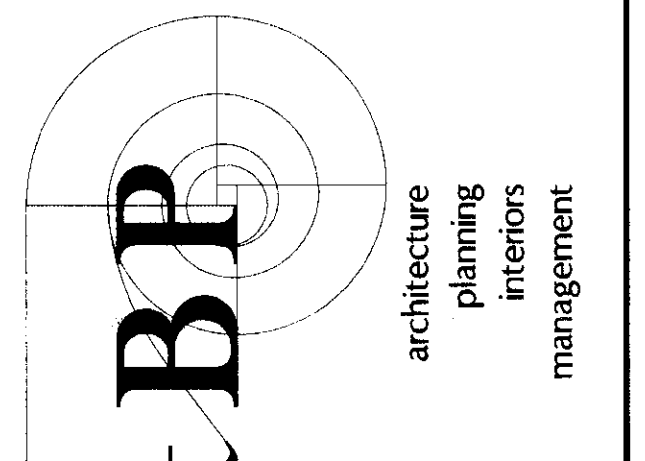

architecture  
planning  
interiors  
management

INTERFACE  
ENGINEERING

PROJECT: 2008-0108  
CONTRACT: Shawn Wilson  
777 Market Street  
Suite 400  
Oakland, CA 94612  
TEL: 415-488-2242  
WWW: www.interfaceengineering.com





name:  
address:  
city, state, zip:  
ph:  
agency:

L-612 STUDENT SERVICES  
CENTER REMODEL  
COLLEGE COMPLEX  
BID DOCUMENTS


owner:  
LOS MEDANOS COLLEGE  
2700 EAST LELAND DRIVE  
PITTSBURG, CA 94565

tBP project number: 20610100  
file name: 0106M3.dwg  
drawn by: GE checked by: EC  
date: JULY 31, 2012  
Rev. date: description

drawing title:  
MECHANICAL  
DETAILS  
drawing no.:  
M-3.1  
drawing of

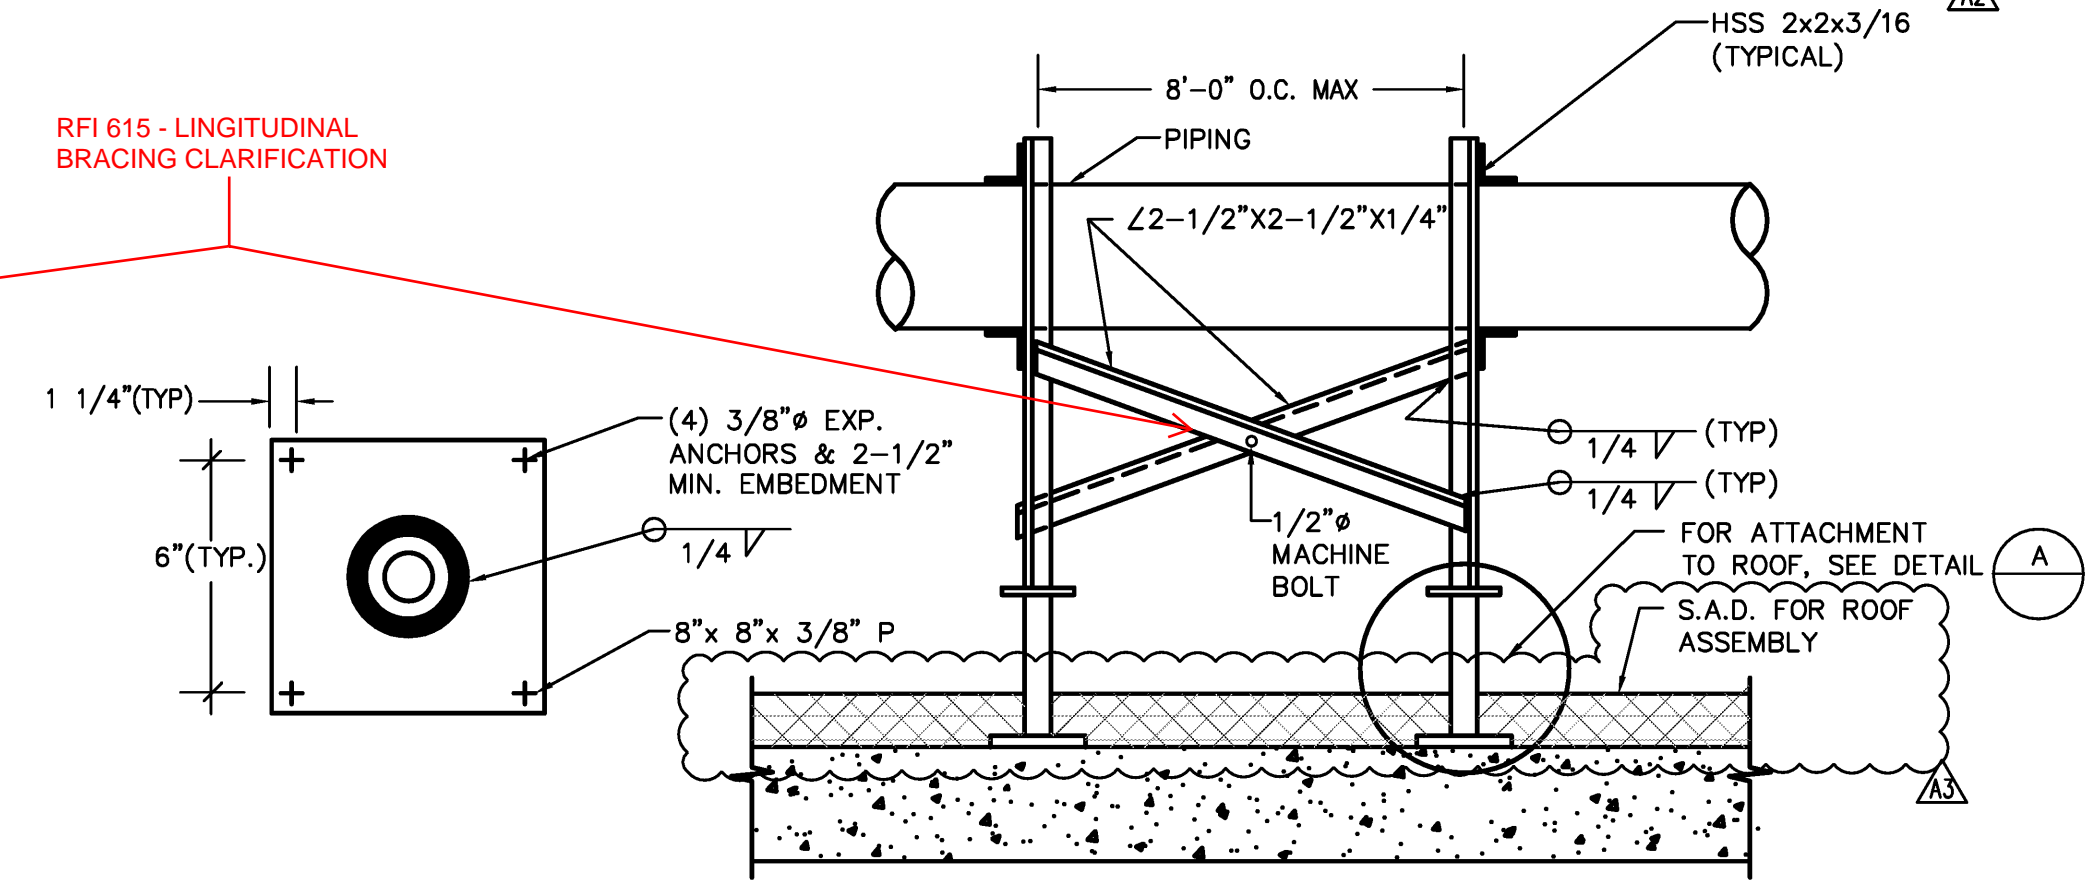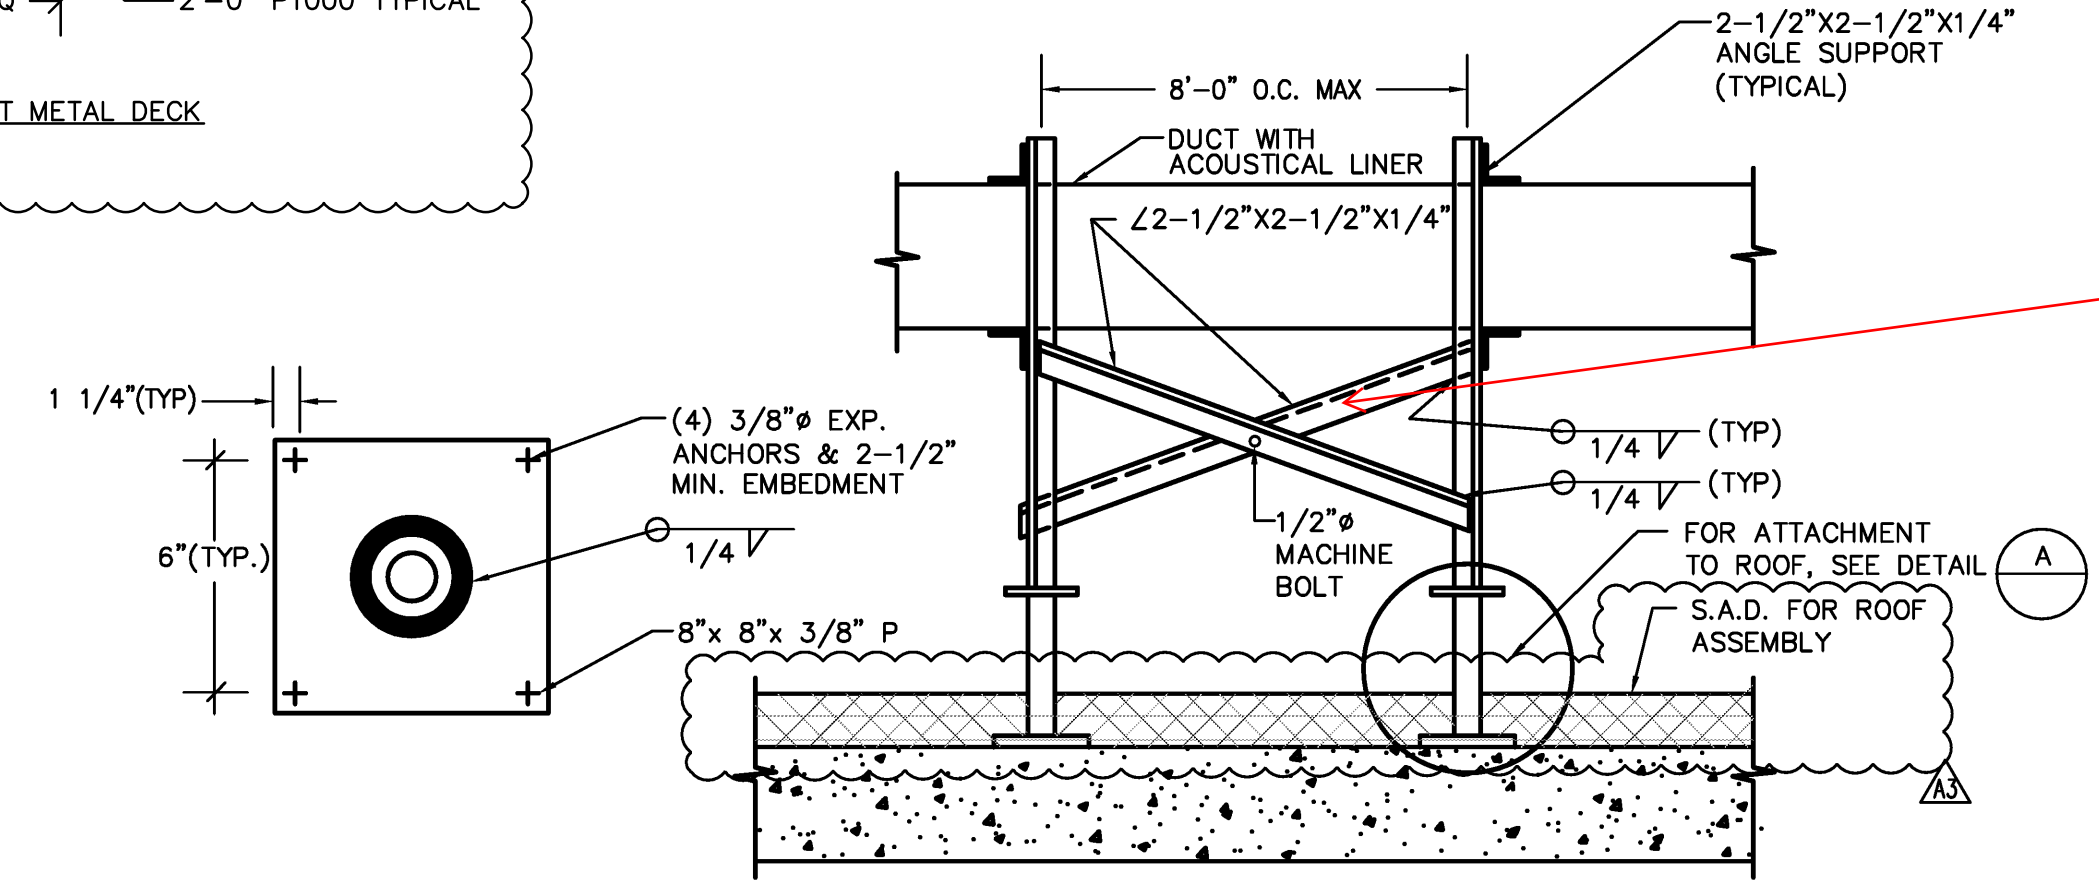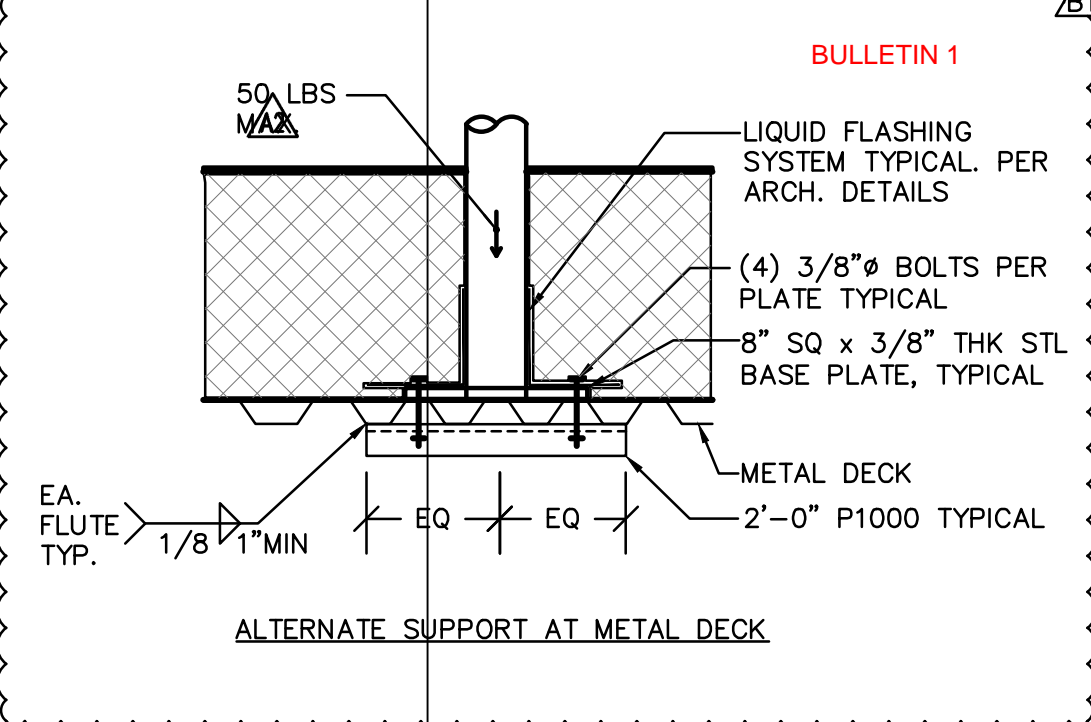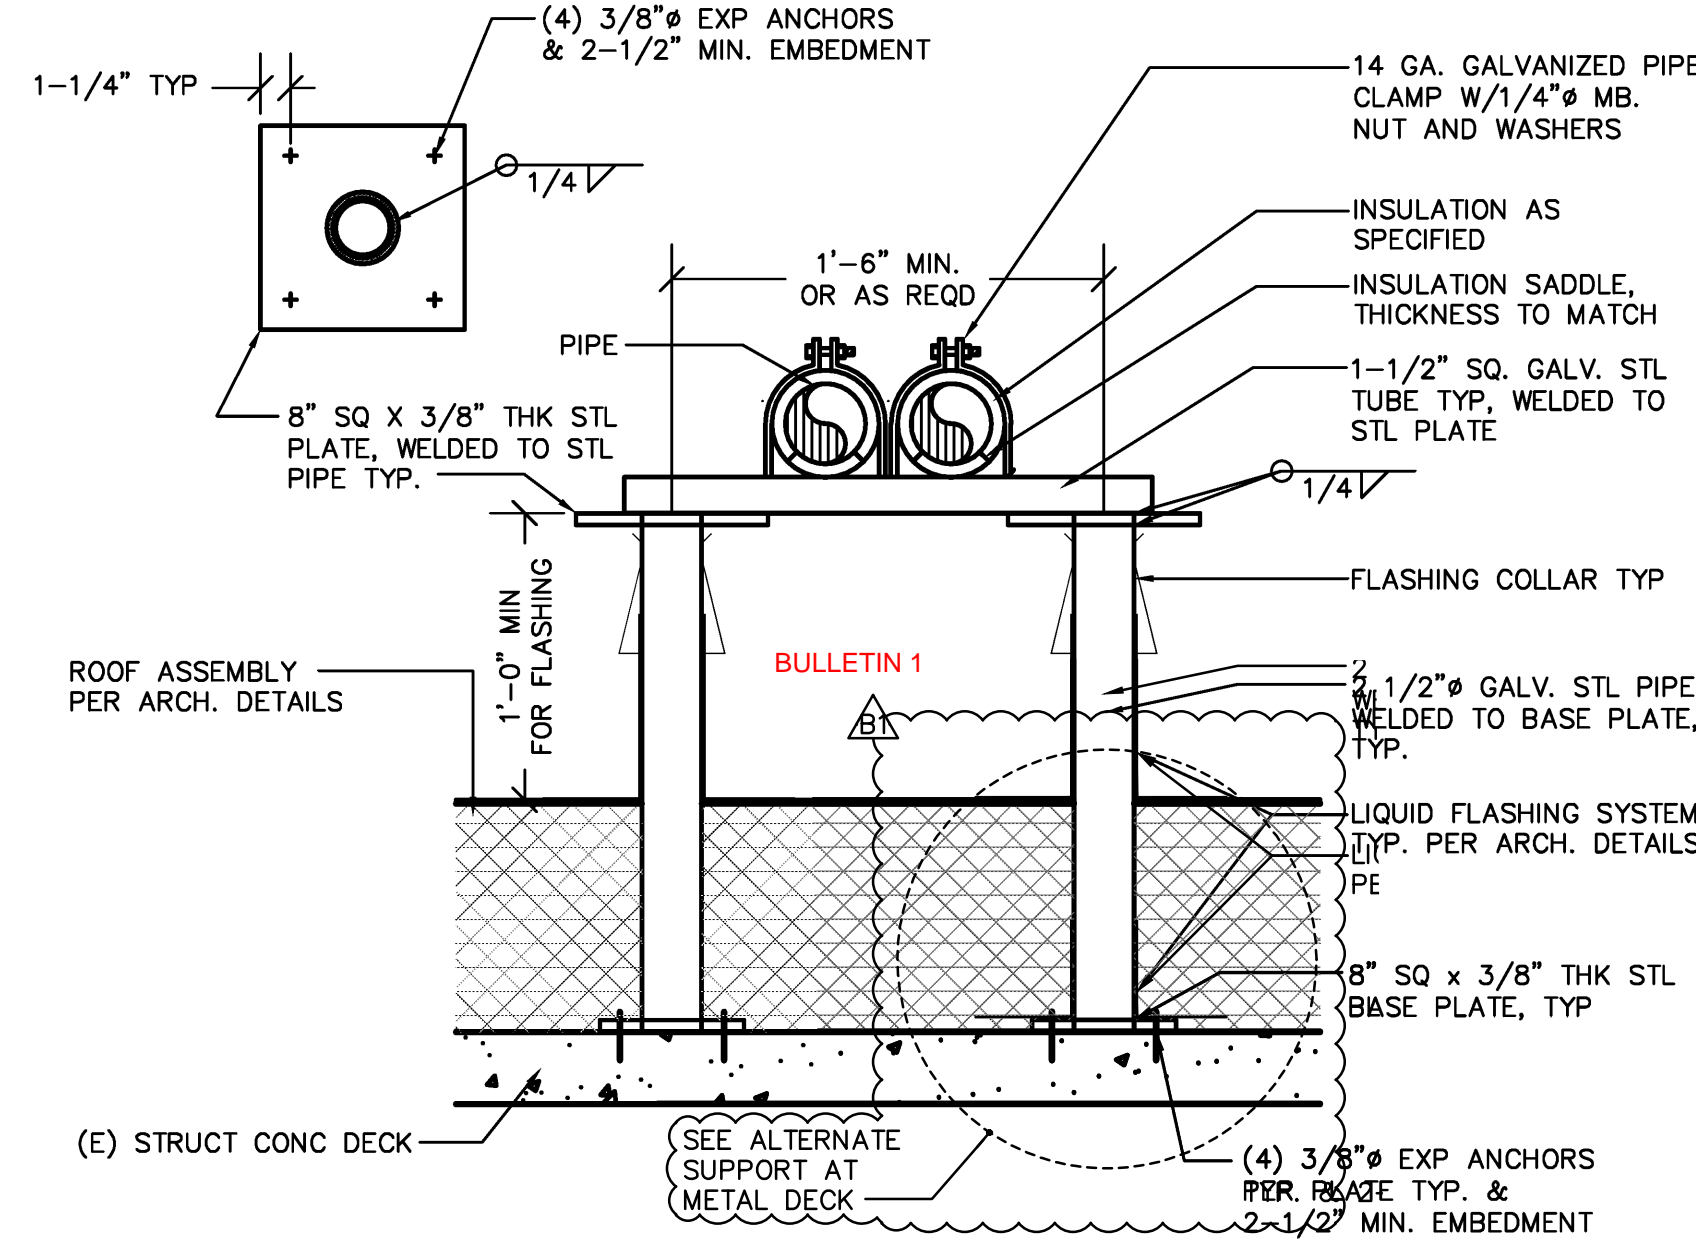


**1 REFRIGERANT PIPE SUPPORT ON ROOF DETAIL**  
NO SCALE

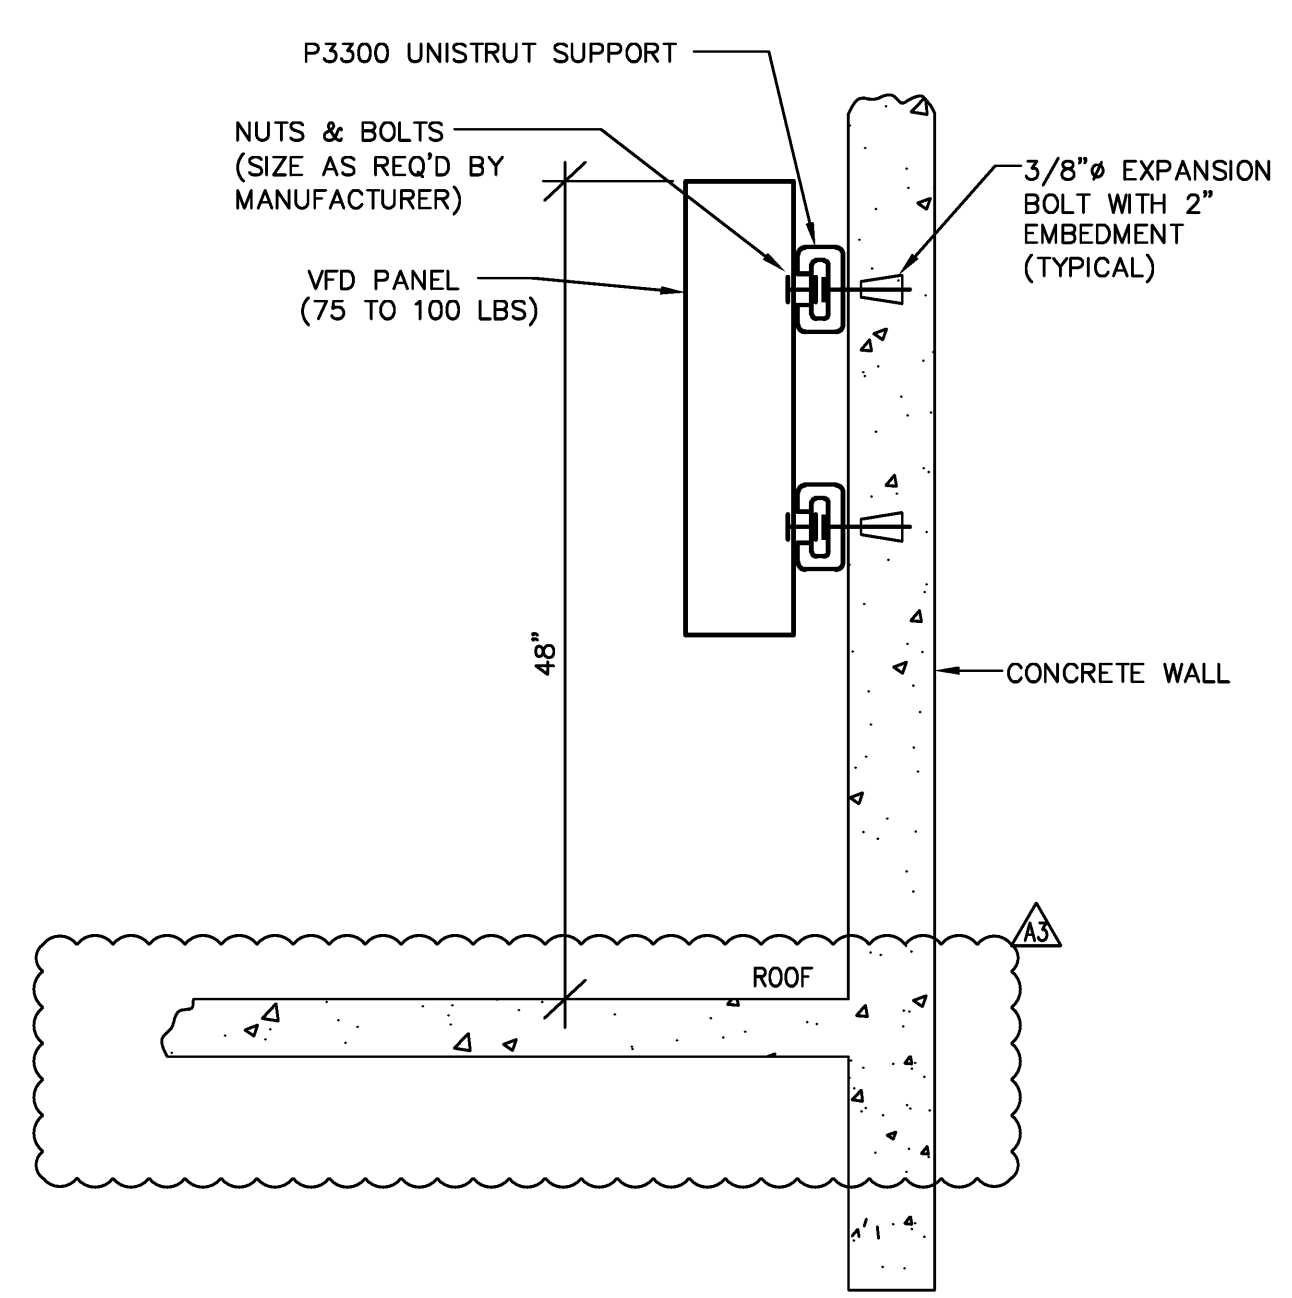


NOTE:  
1. FOR COMPLETE INSTALLATION PROCEDURE, REFER TO MANUFACTURER'S RECOMMENDATION.

**2 WALL MOUNTED VFD DETAIL**  
NO SCALE

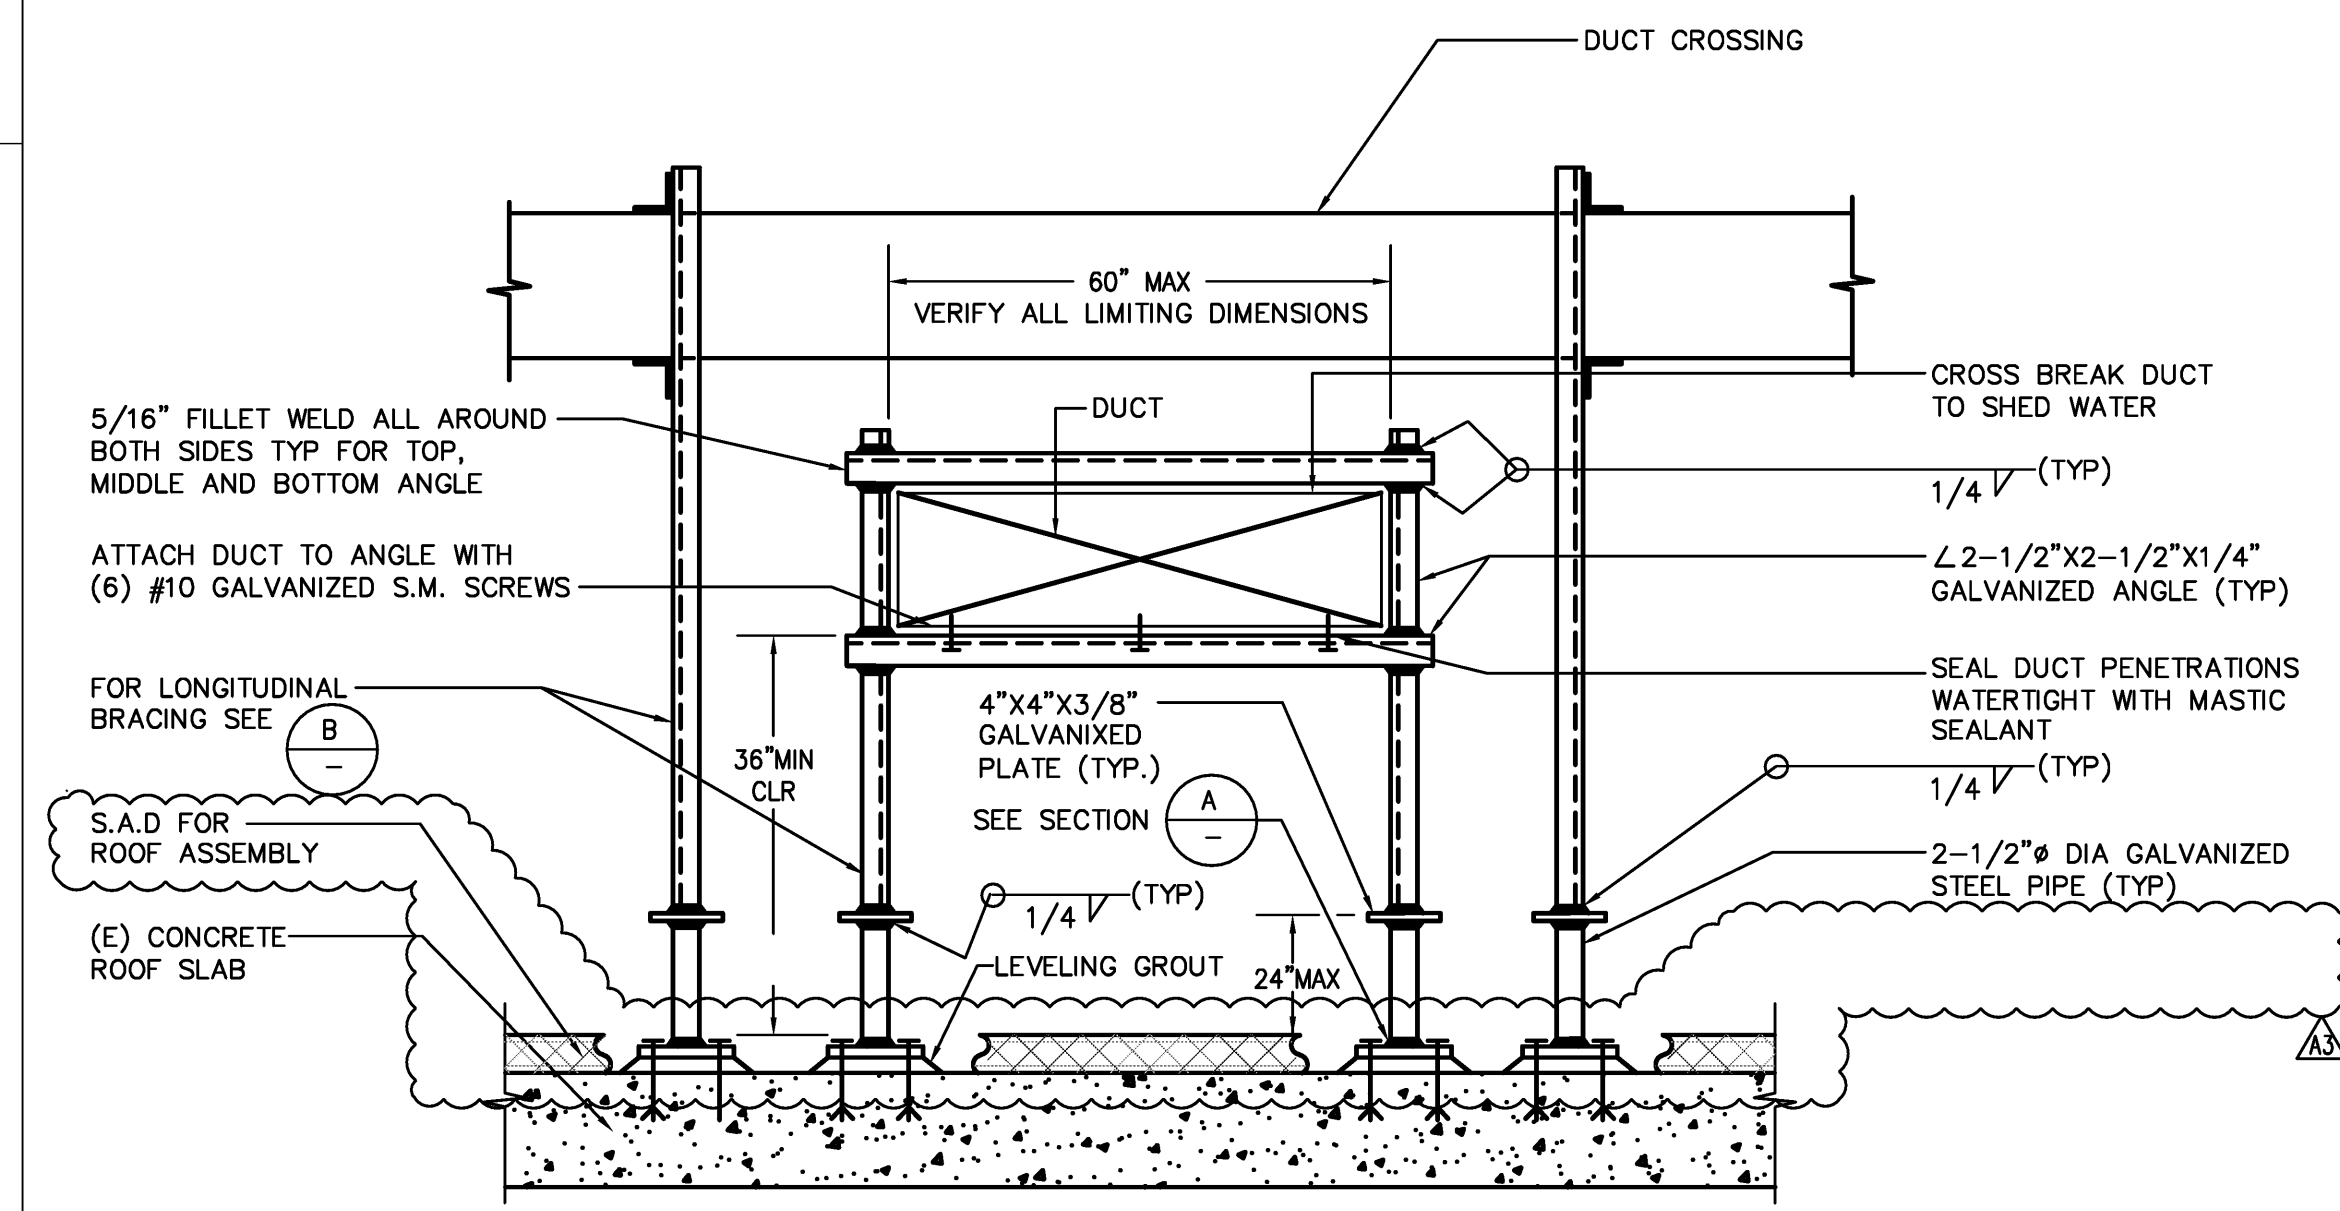


- NOTES:
- SUPPORT SPACING ON ROOF AT 6'-0" O.C. MAX, AT ALL OFFSETS, CHANGES IN DIRECTION, PRIOR TO ROOF PENETRATION AND WHERE SHOWN ON DRAWINGS.
  - COMPLETE SUPPORT ASSEMBLY SHALL BE HOT GALVANIZED AFTER FABRICATION.
  - COLD GALVANIZE ALL WELDED JOINTS.
  - CONTRACTOR SHALL SUBMIT SHOP DRAWING ON ANY SUBSTITUTIONS OF DUCT SUPPORT.
  - SEE ARCH DET. 17/7.01 FOR FLASHING REQUIREMENTS.
  - COORDINATE THE BOTTOM OF DUCT SUPPORT AT CROSSOVERS WITH HYDRONIC PIPING.

**4 DUCT SUPPORT ON ROOF DETAIL**  
NO SCALE

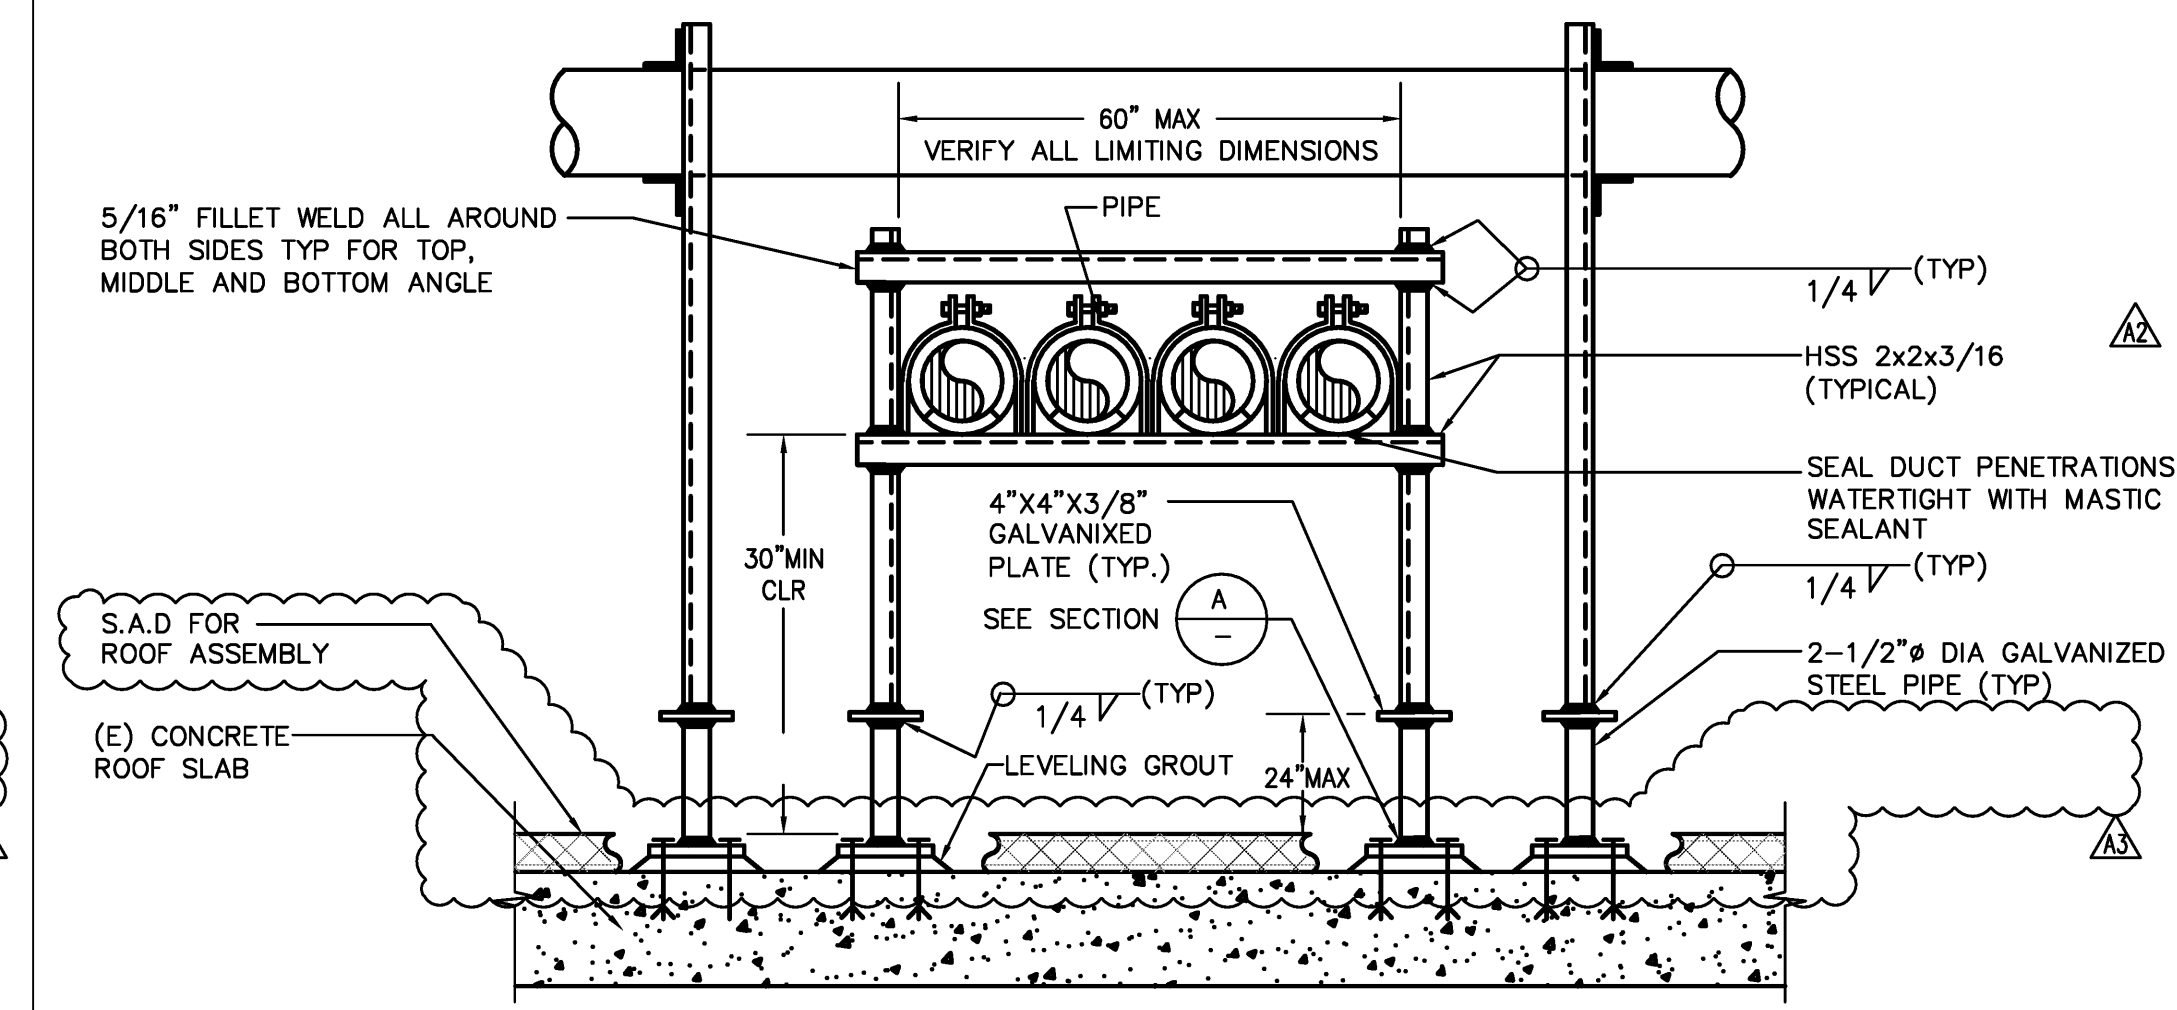


- NOTES:
- SUPPORT SPACING ON ROOF AT 6'-0" O.C. MAX, AT ALL OFFSETS, CHANGES IN DIRECTION, PRIOR TO ROOF PENETRATION AND WHERE SHOWN ON DRAWINGS.
  - COMPLETE SUPPORT ASSEMBLY SHALL BE HOT GALVANIZED AFTER FABRICATION.
  - COLD GALVANIZE ALL WELDED JOINTS.
  - CONTRACTOR SHALL SUBMIT SHOP DRAWING ON ANY SUBSTITUTIONS OF DUCT SUPPORT.
  - SEE ARCH DET. 17/7.01 FOR FLASHING REQUIREMENTS.
  - COORDINATE THE BOTTOM OF DUCT SUPPORT AT CROSSOVERS WITH HYDRONIC PIPING.

**6 PIPE SUPPORT ON ROOF DETAIL**  
NO SCALE

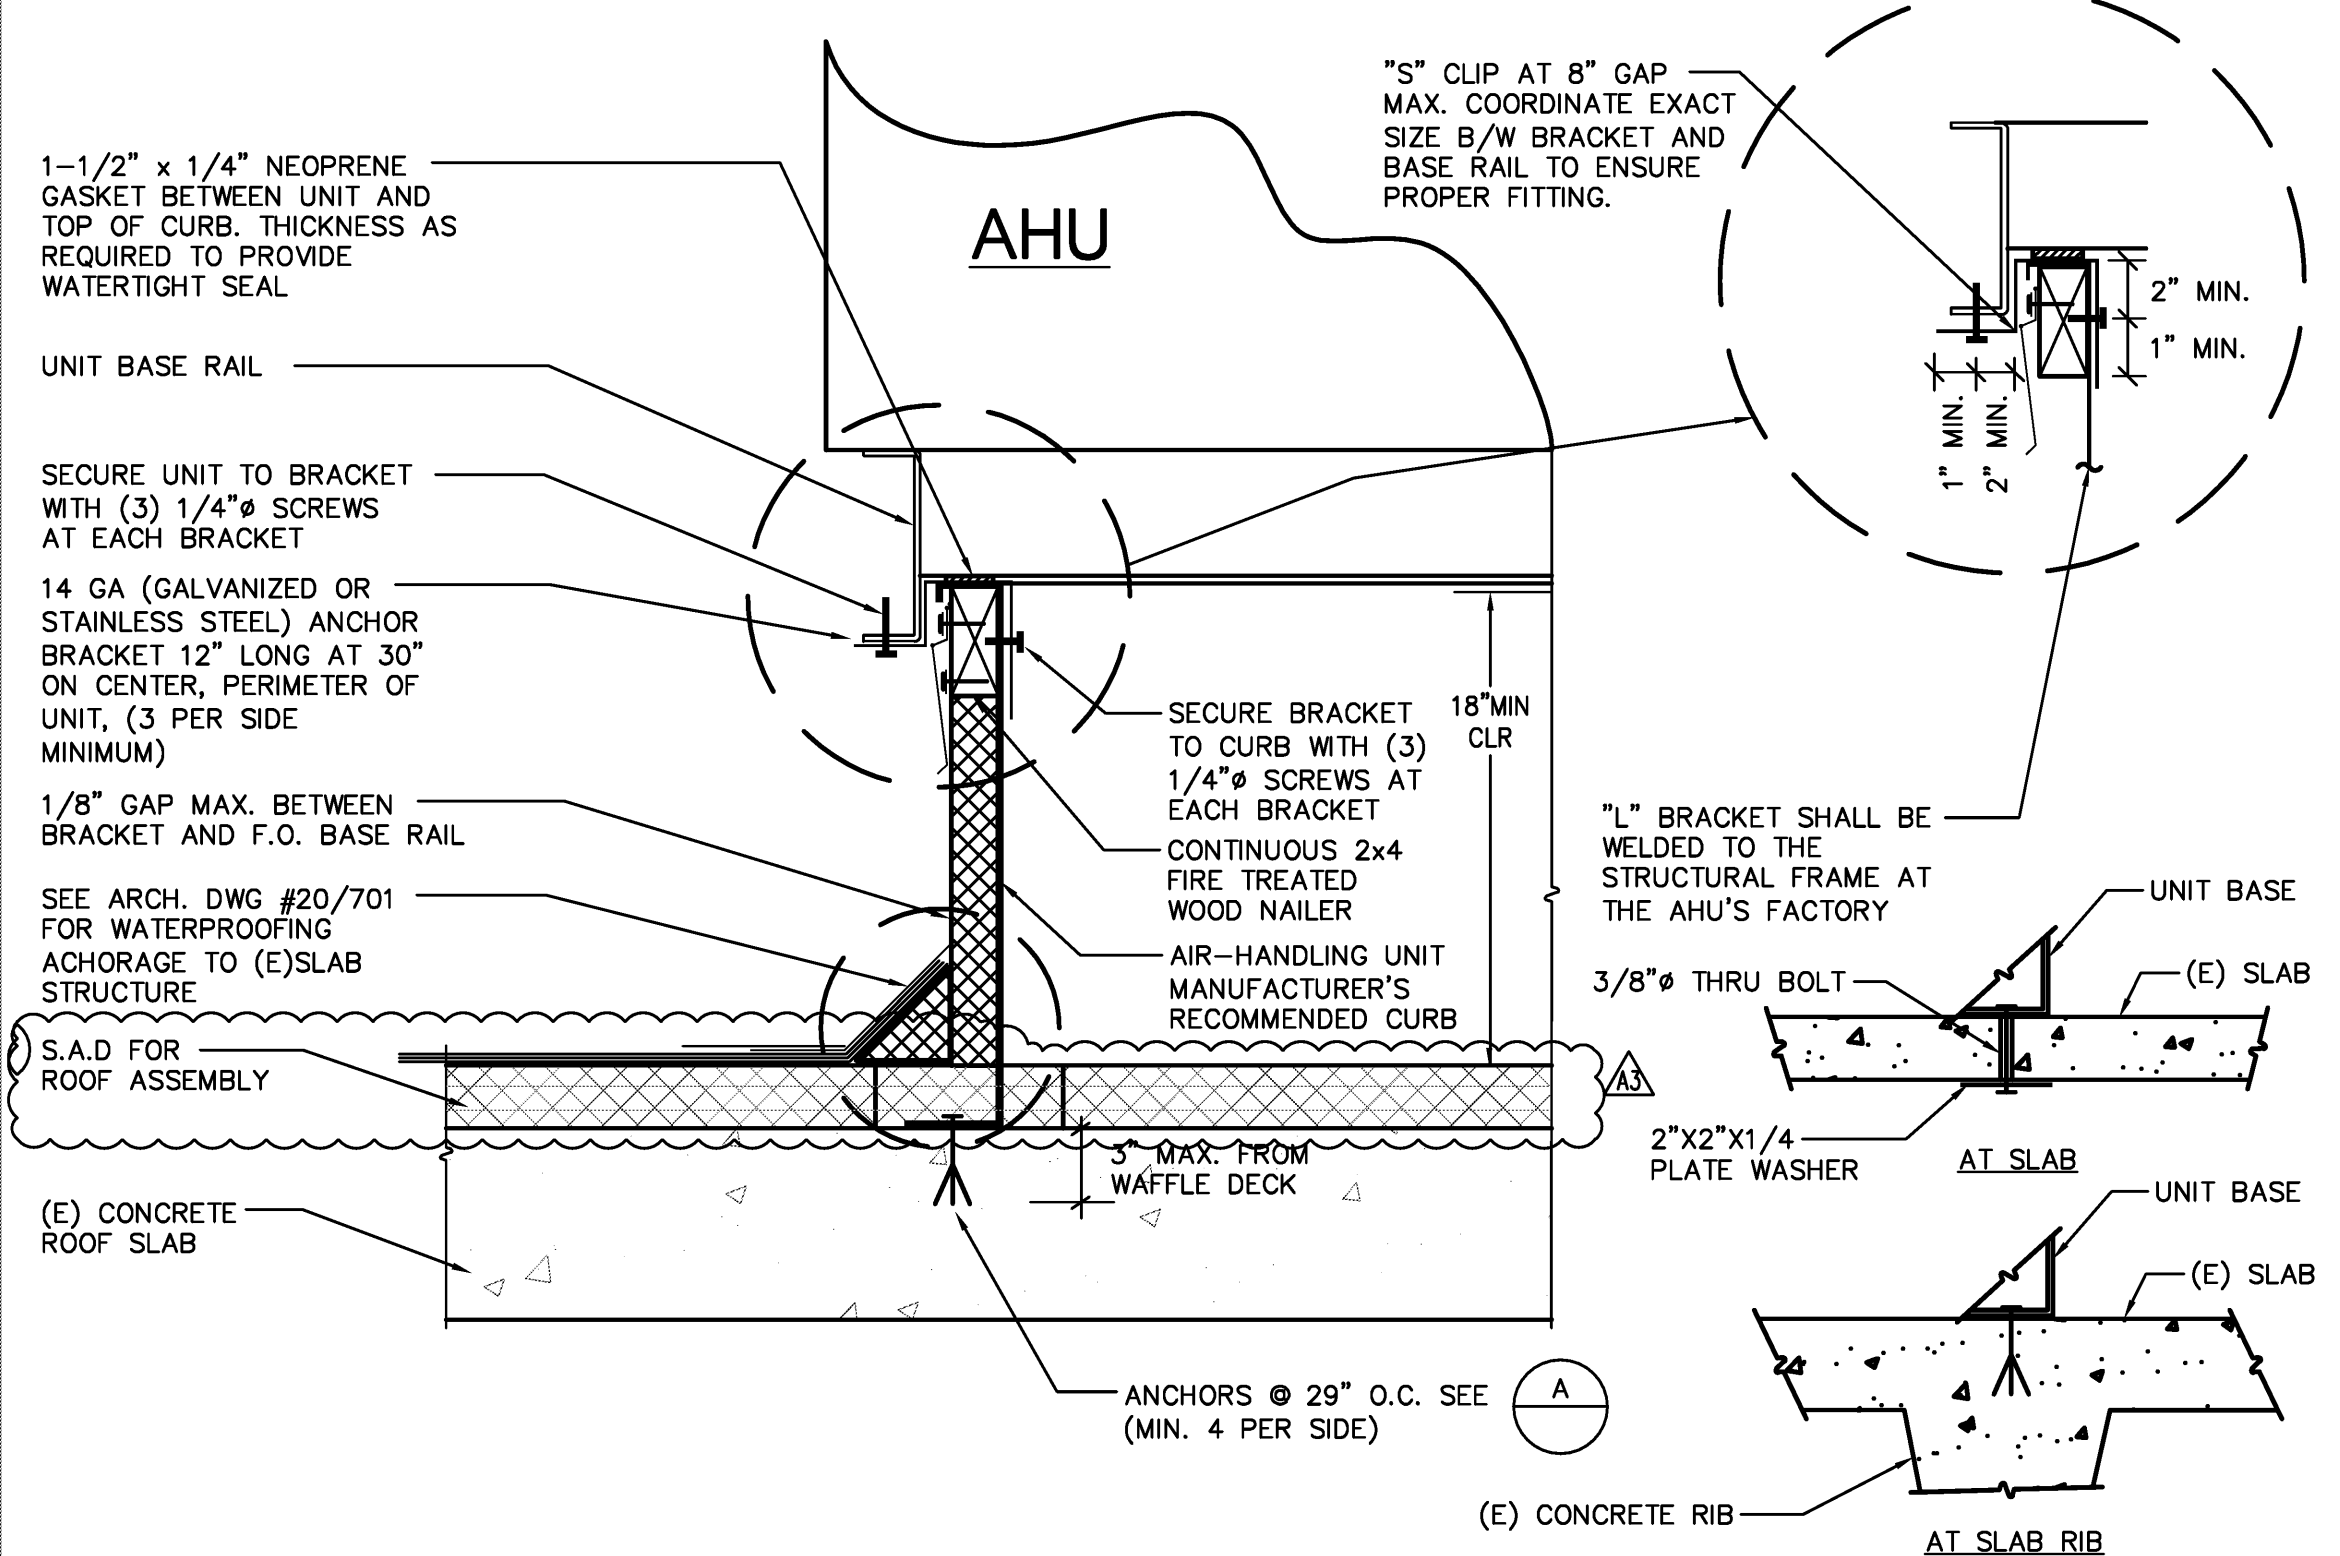


**3 AHU SUPPORT CURB DETAIL**  
NO SCALE

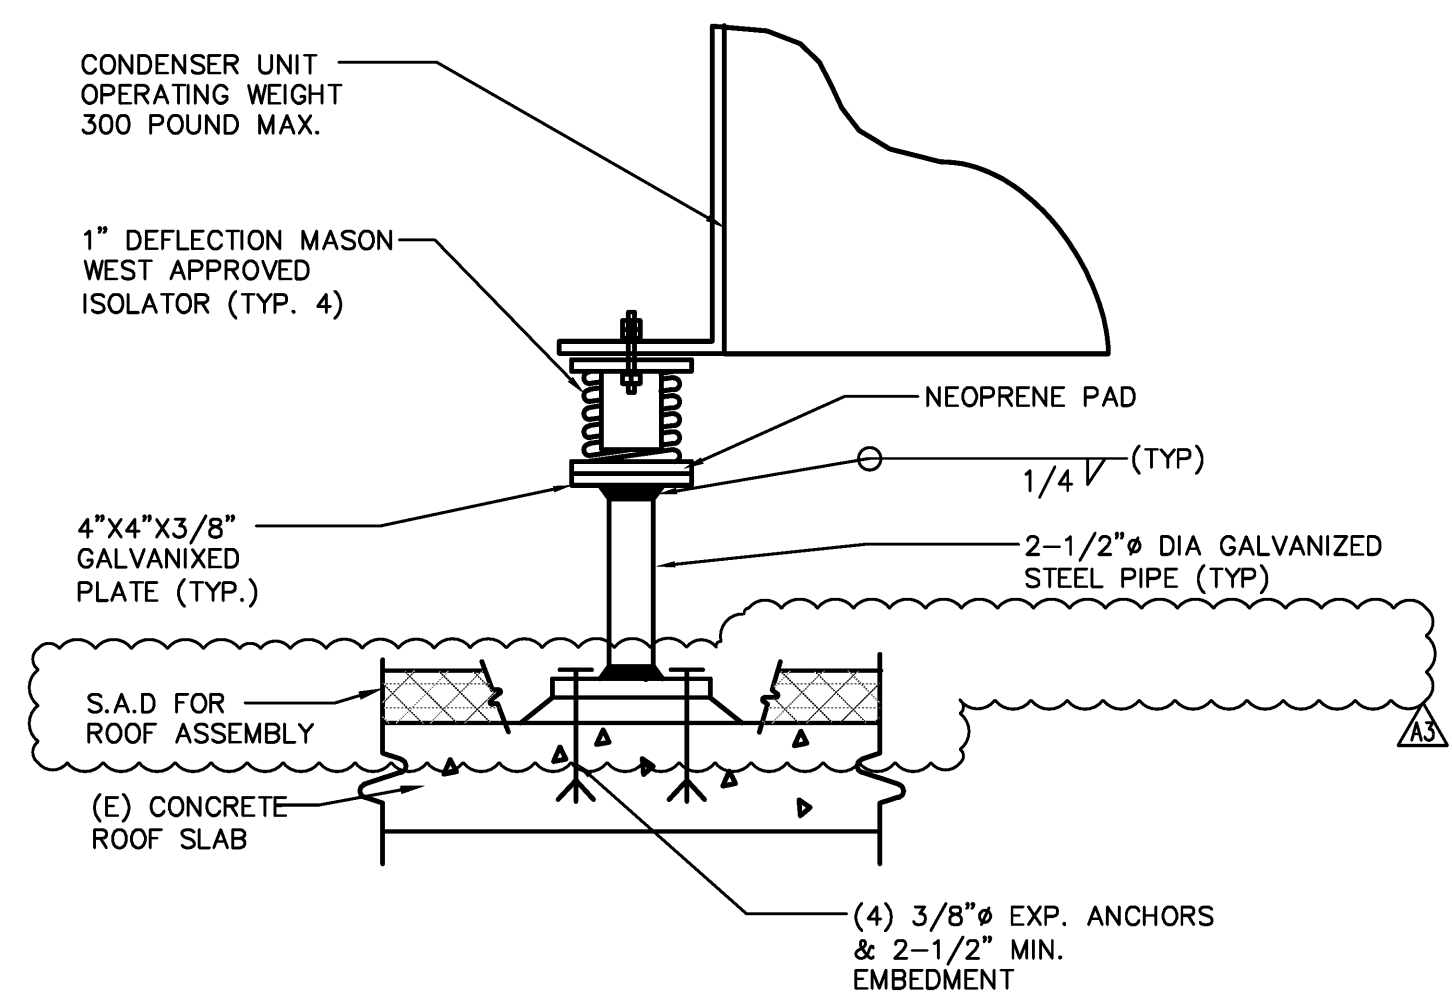

RFI 288 - IT IS ACCEPTABLE TO USE THIS DETAIL FOR THE SPLIT SYSTEM FOR THE MPOE AND 4-TON UNIT ON SUPPORT STANCHIONS

**5 CONDENSING UNIT MOUNTING DETAIL**  
NO SCALE

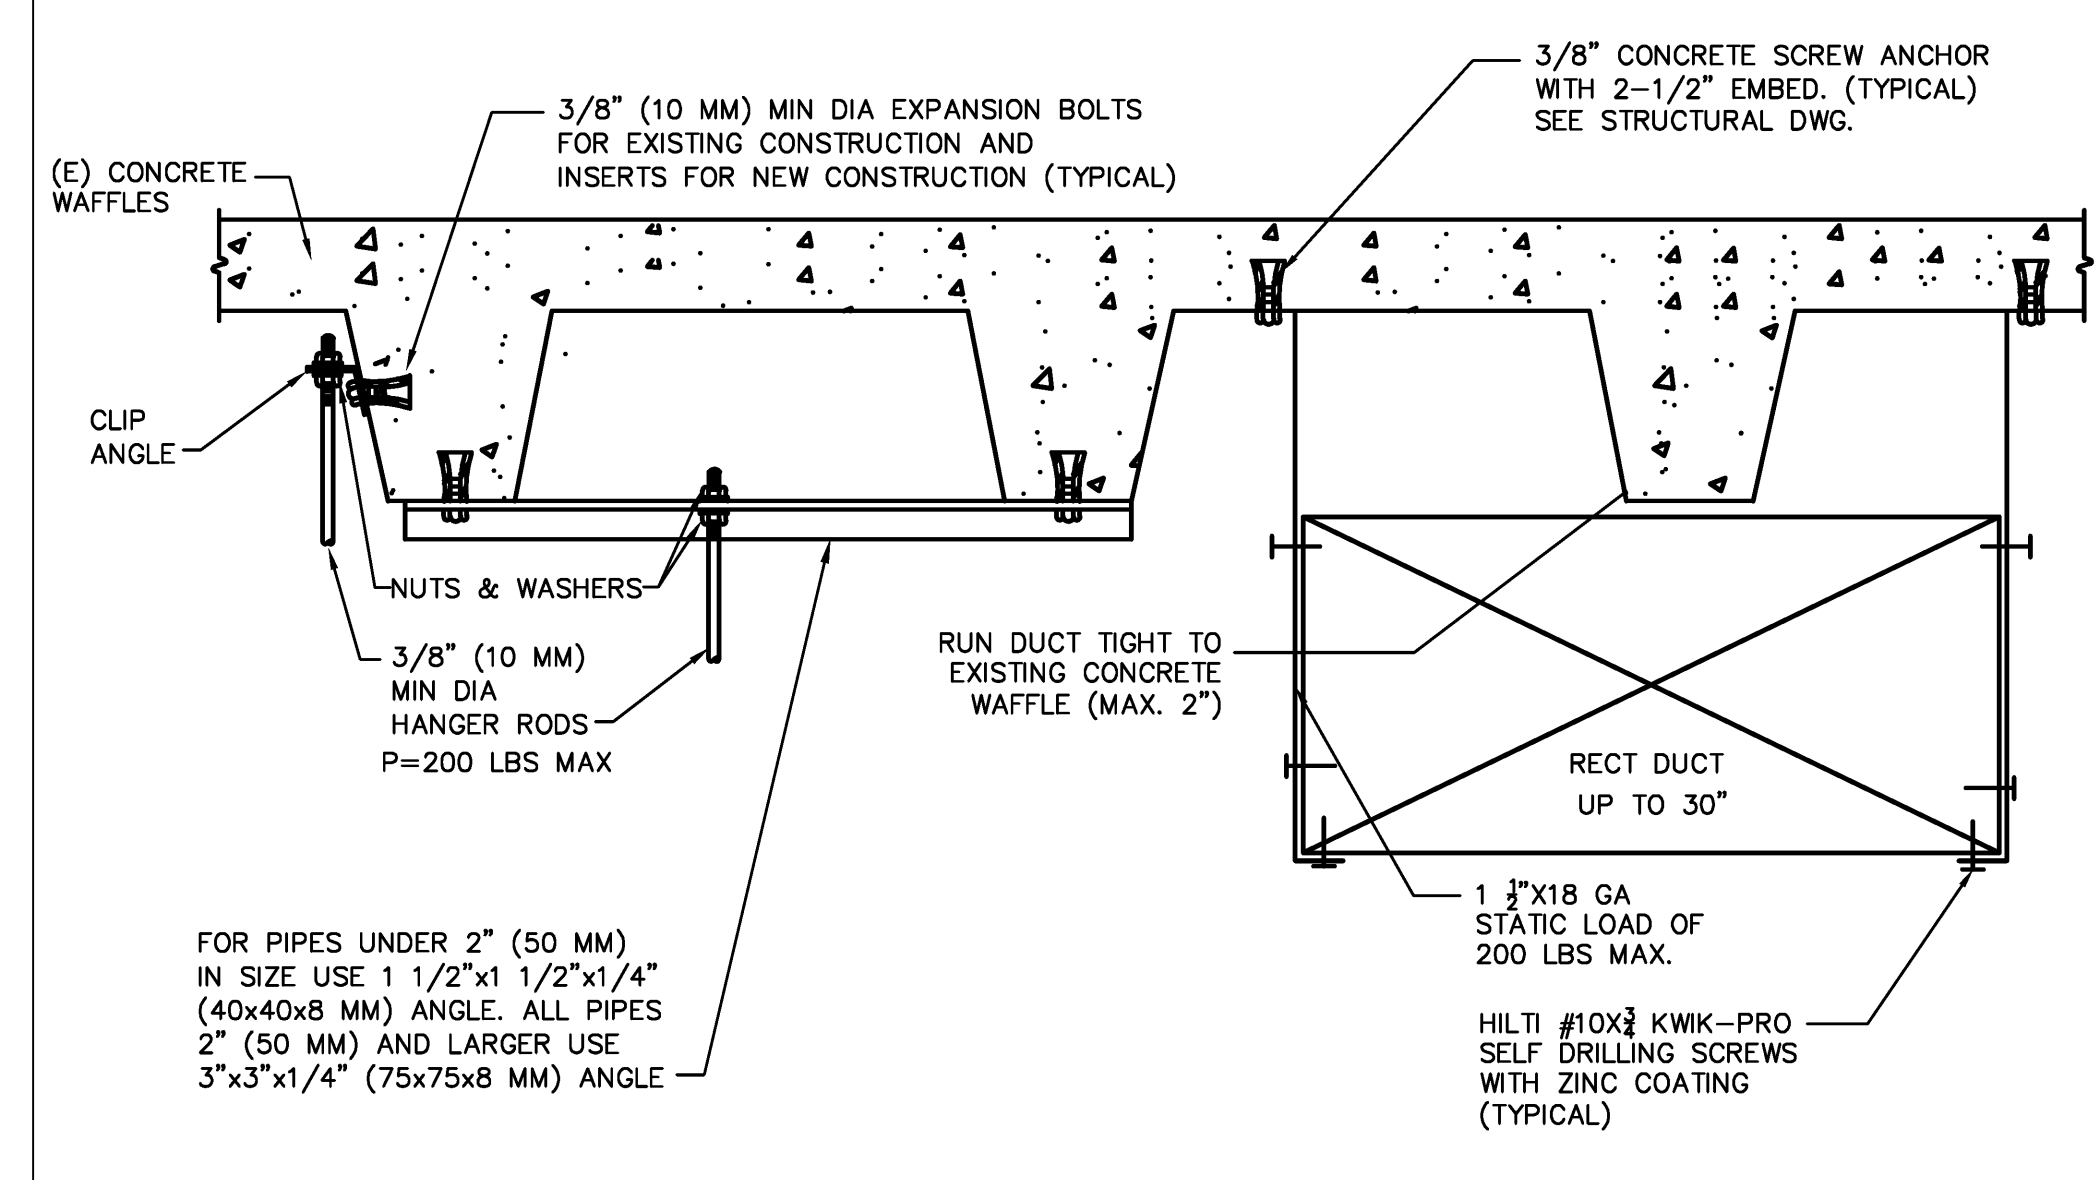

- NOTES:
- BOTTOM OF DUCT ELEVATION MAX IS 8'-4" A.F.F. AT SS3 WHERE CEILINGS ARE 7'-11" A.F.F.
  - BOTTOM OF DUCT ELEVATION MAX IS 10'-2" A.F.F. AT SS4 WHERE CEILINGS ARE 9'-0" A.F.F.

**7 ATTACHMENT TO (E) CONCRETE WAFFLE DETAIL**  
NO SCALE

**tBP**  
architecture  
planning  
interiors  
management

1000 Burnett Avenue Suite 140  
Concord, CA 94520  
ph: 925.246.6495  
fx: 925.246.6495

architect

**INTERFACE**  
ENGINEERING

2008-0108  
PROJECT: Shawn Wilson  
CONTRACT: 1777 Alameda Street  
San Francisco, CA 94103  
DATE: 01/11/2012  
SCALE: 1/4" = 1'-0"

name: \_\_\_\_\_  
address: \_\_\_\_\_  
city, state, zip: \_\_\_\_\_  
ph: \_\_\_\_\_  
agency: \_\_\_\_\_

**FILE #/CI**

REGISTRATION STATE: CALIFORNIA  
OFFICE OF REGULATION SERVICES  
APPL. 01-112272  
AC: \_\_\_\_\_ R/S: \_\_\_\_\_ SS: \_\_\_\_\_  
DATE: \_\_\_\_\_

**L-612 STUDENT SERVICES CENTER REMODEL COLLEGE COMPLEX**  
BID DOCUMENTS

LOS MEDANOS COLLEGE  
2700 EAST LELAND DRIVE  
PITTSBURG, CA 94565

tBP project number: 20610.00  
owner

file name: 0106M32.dwg  
drawn by: GE checked by: BC  
date: **JULY 31, 2012**


Rev. date: description:  
10/10/12 ADDENDUM #2  
10/24/12 ADDENDUM #3

THIS DRAWING AND THE DETAILS, SPECIFICATIONS, NOTES AND OTHER INFORMATION CONTAINED HEREIN CONSTITUTE UNPUBLISHED WORK OF INTERPRETATION AND SHALL REMAIN THE PROPERTY OF INTERFAC ENGINEERING IN PERPETUITY. NO PART THEREOF SHALL BE REPRODUCED, ENLARGED, DIMINISHED, SOLD, RENTED OR OTHERWISE USED IN ANY MANNER WITHOUT THE ADVANCED EXPRESS WRITTEN CONSENT OF INTERFAC ENGINEERING.


drawing title:  
**MECHANICAL DETAILS**

drawing no:  
**M-3.2**  
drawing of




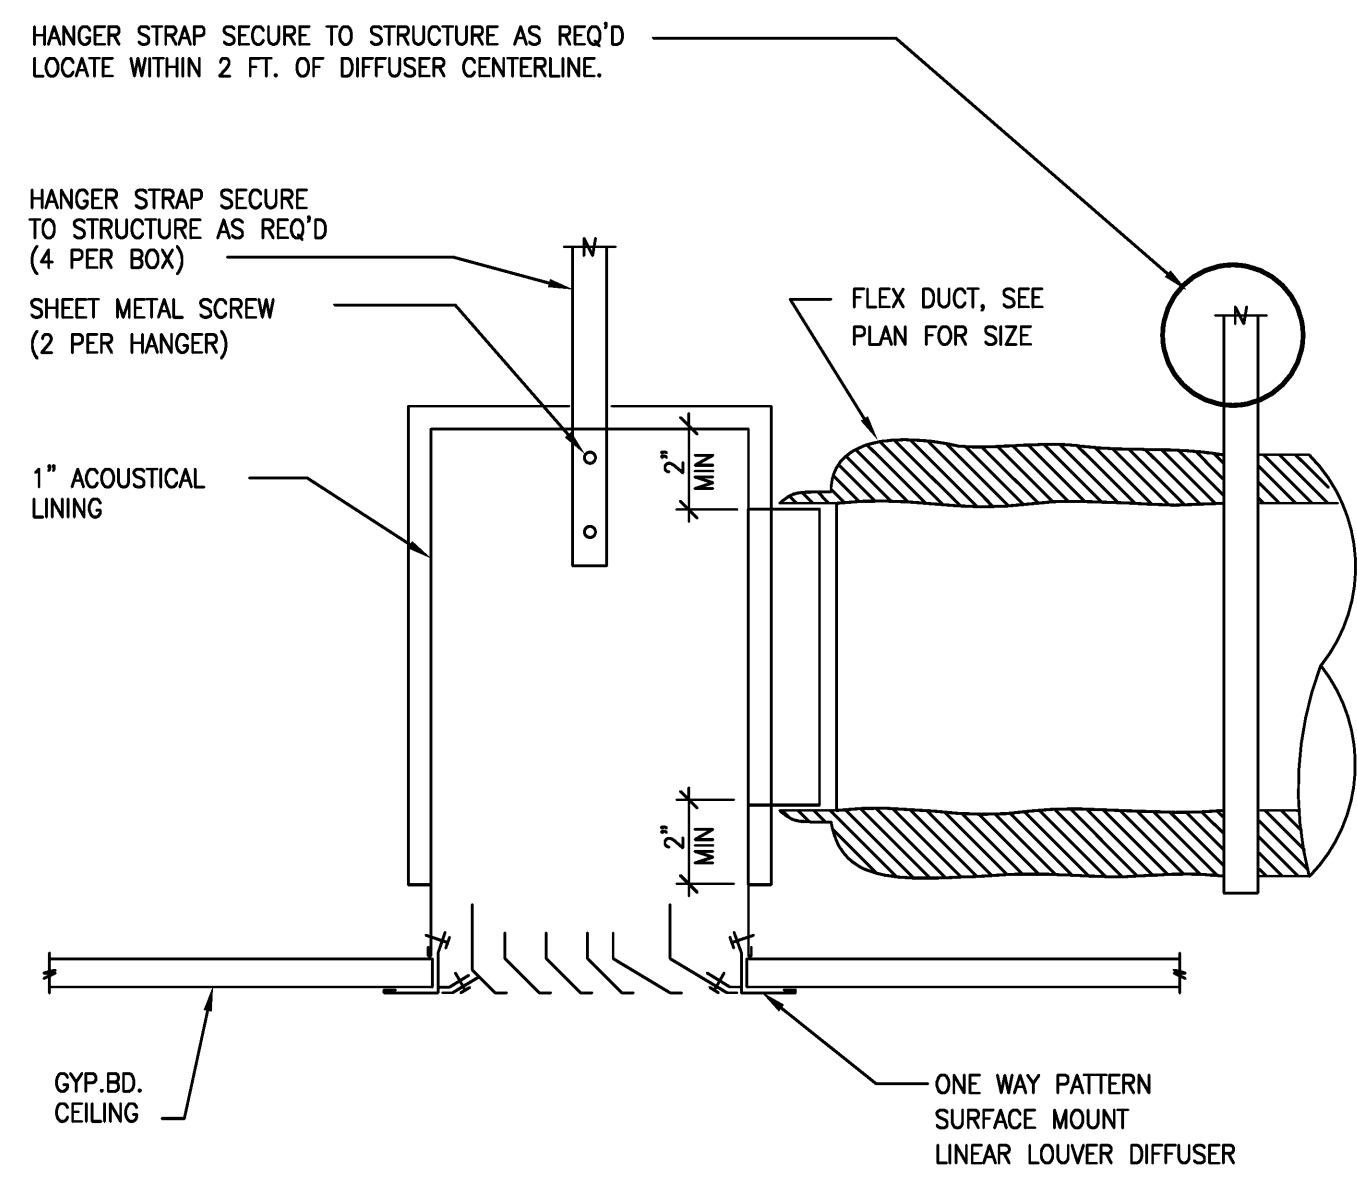


**1 LINEAR DIFFUSER CONNECTION DETAIL**  
NO SCALE

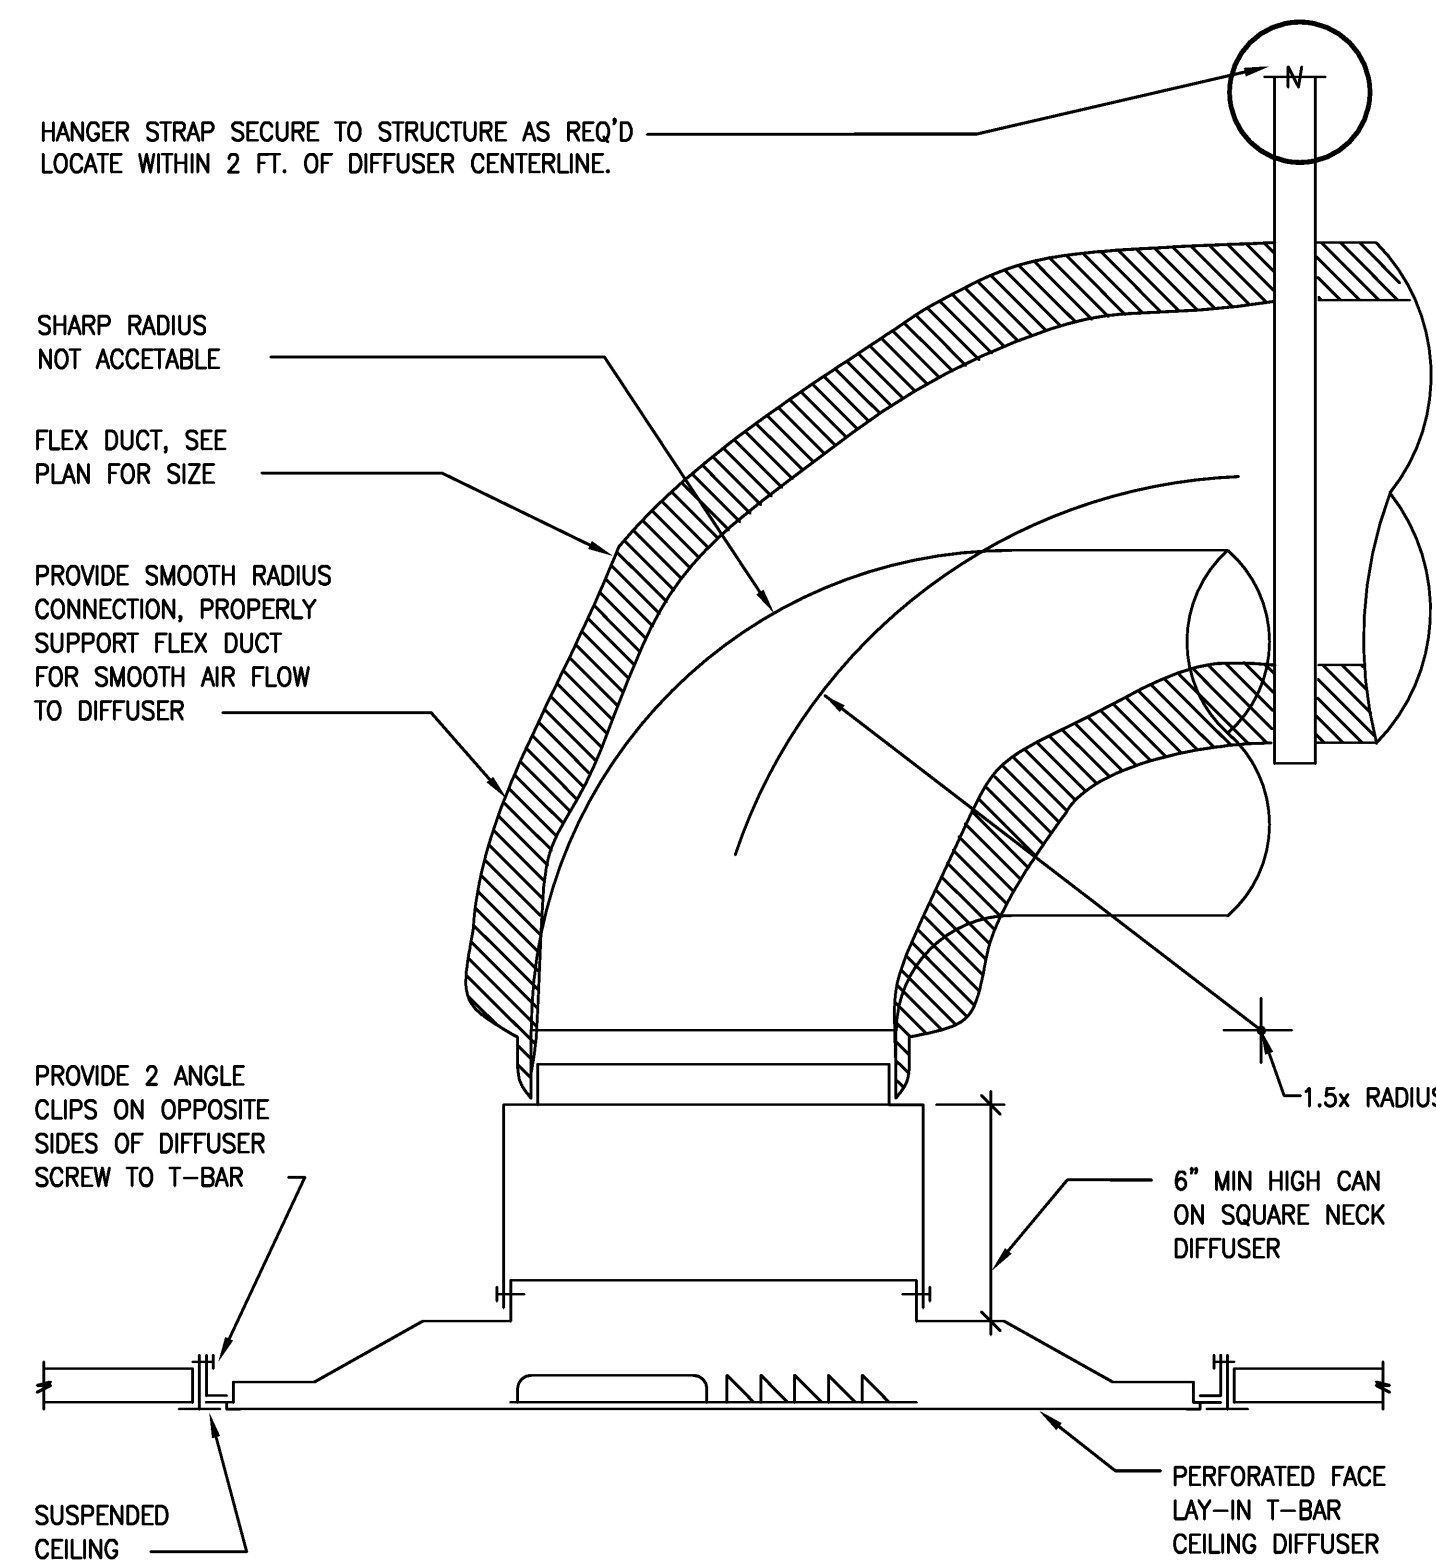


**2 CEILING DIFFUSER CONNECTION DETAIL**  
NO SCALE

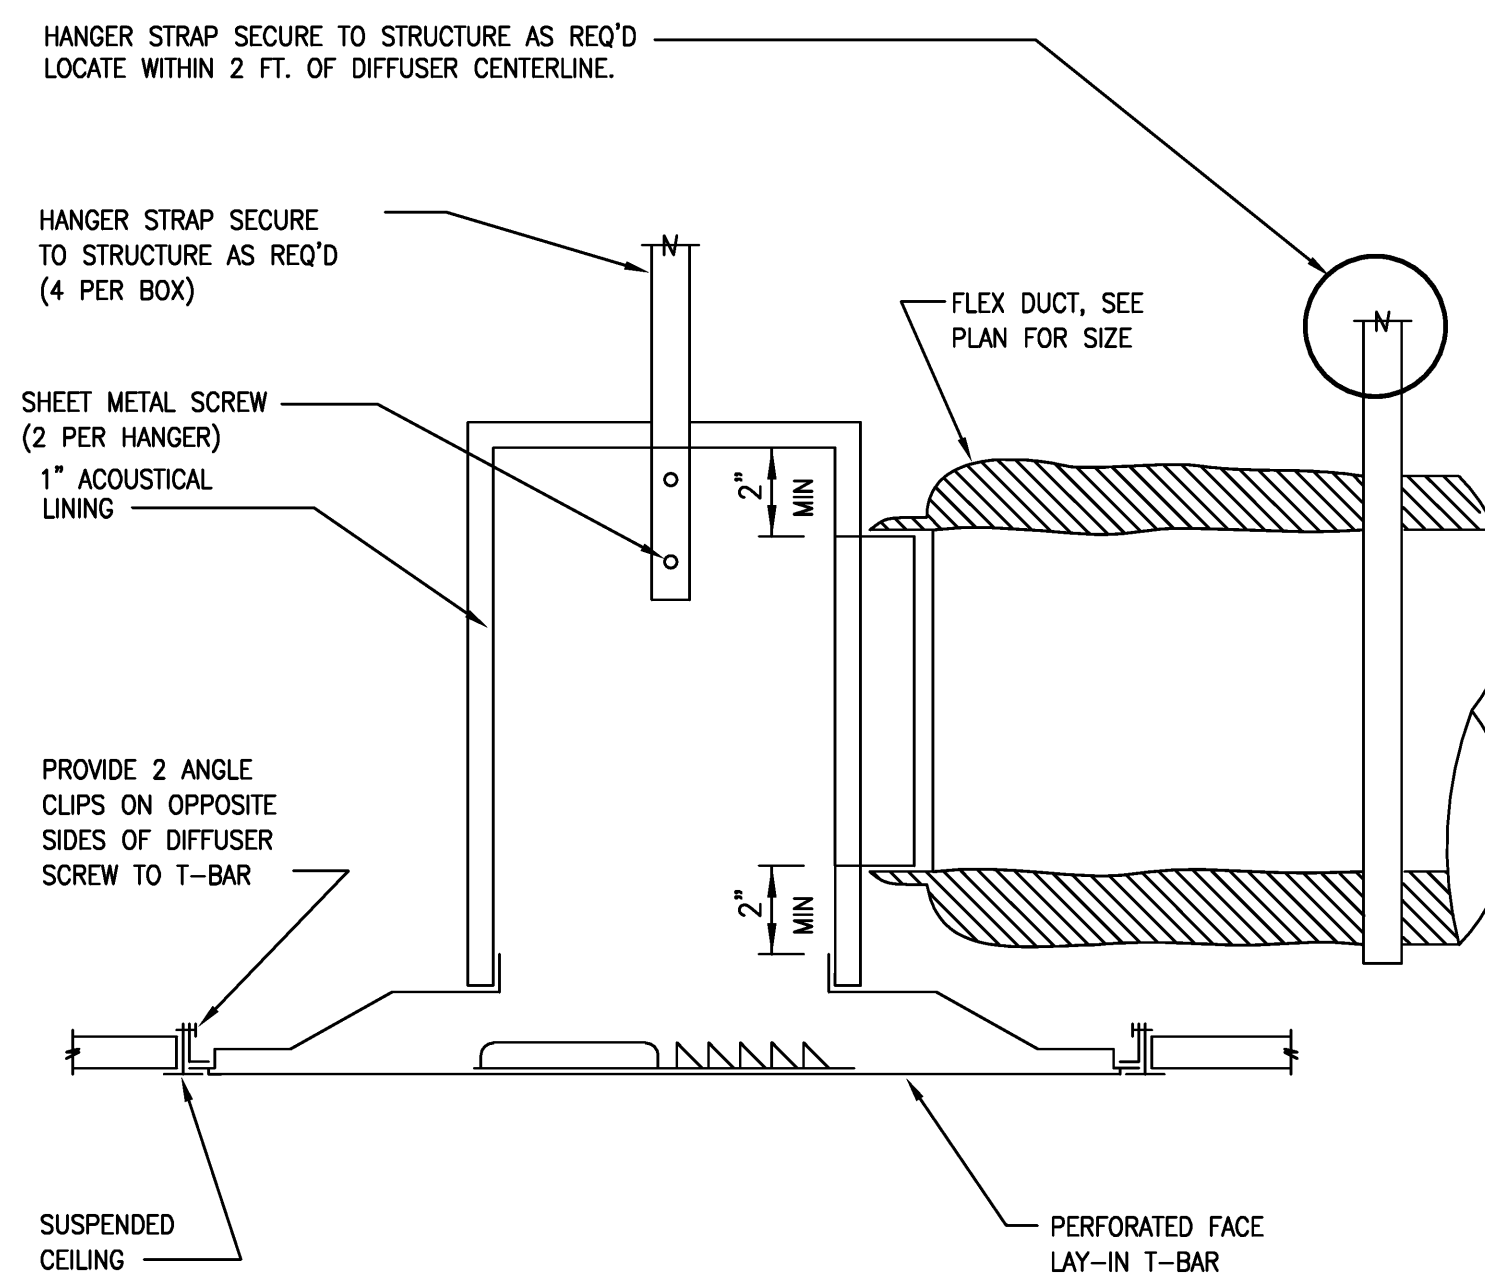

**3 ACOUSTIC TRANSFER AIR BOOT DETAIL**  
NO SCALE

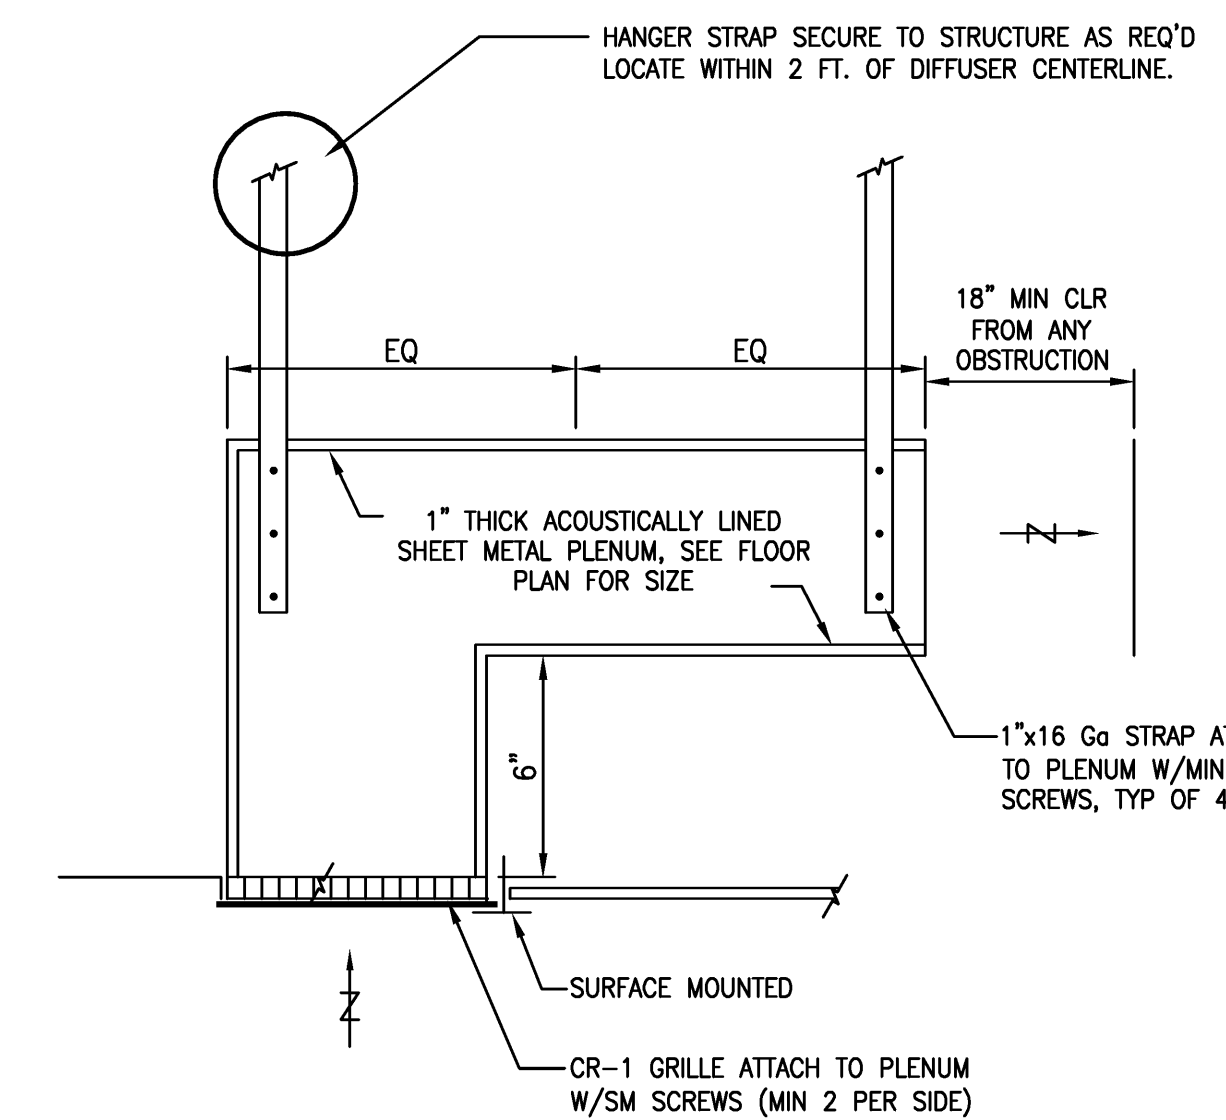


NOTE:  
1. PROVIDE AT ALL ROOMS BOUND BY FULL HEIGHT WALLS, AND WHERE SHOWN ON PLANS.

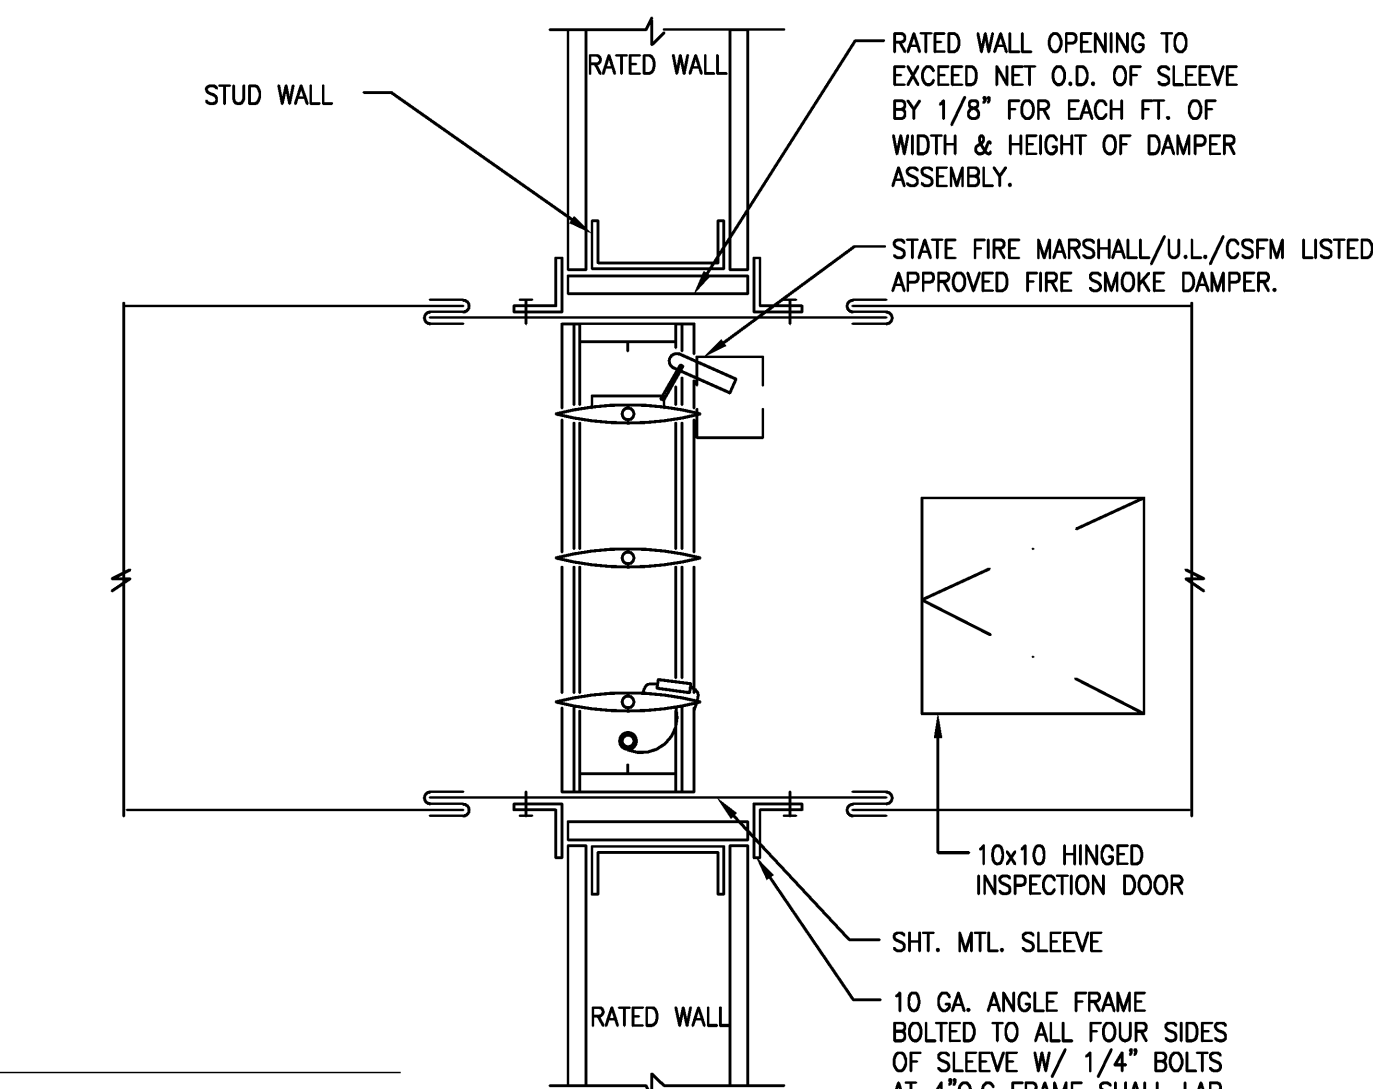


NOTES:  
1. USE "UNITED DUCT SEALER" OR EQUAL WHERE DUCTS CONNECT TO SLEEVE. DUCT SEALER MUST MEET RULE #1168 LOW V.O.C LIMITS PER LEED REQUIREMENT.  
2. IF ROUND DUCT, PROVIDE WELDED ROUND DUCT COLLAR ON BOTH SIDES. SIMILAR TO HIGH VELOCITY FIRE DAMPER. OPENING SIZE = DUCT SIZE + 1\"/>

**4 FIRE SMOKE DAMPER DETAIL**  
NO SCALE VERTICAL INSTALLATION

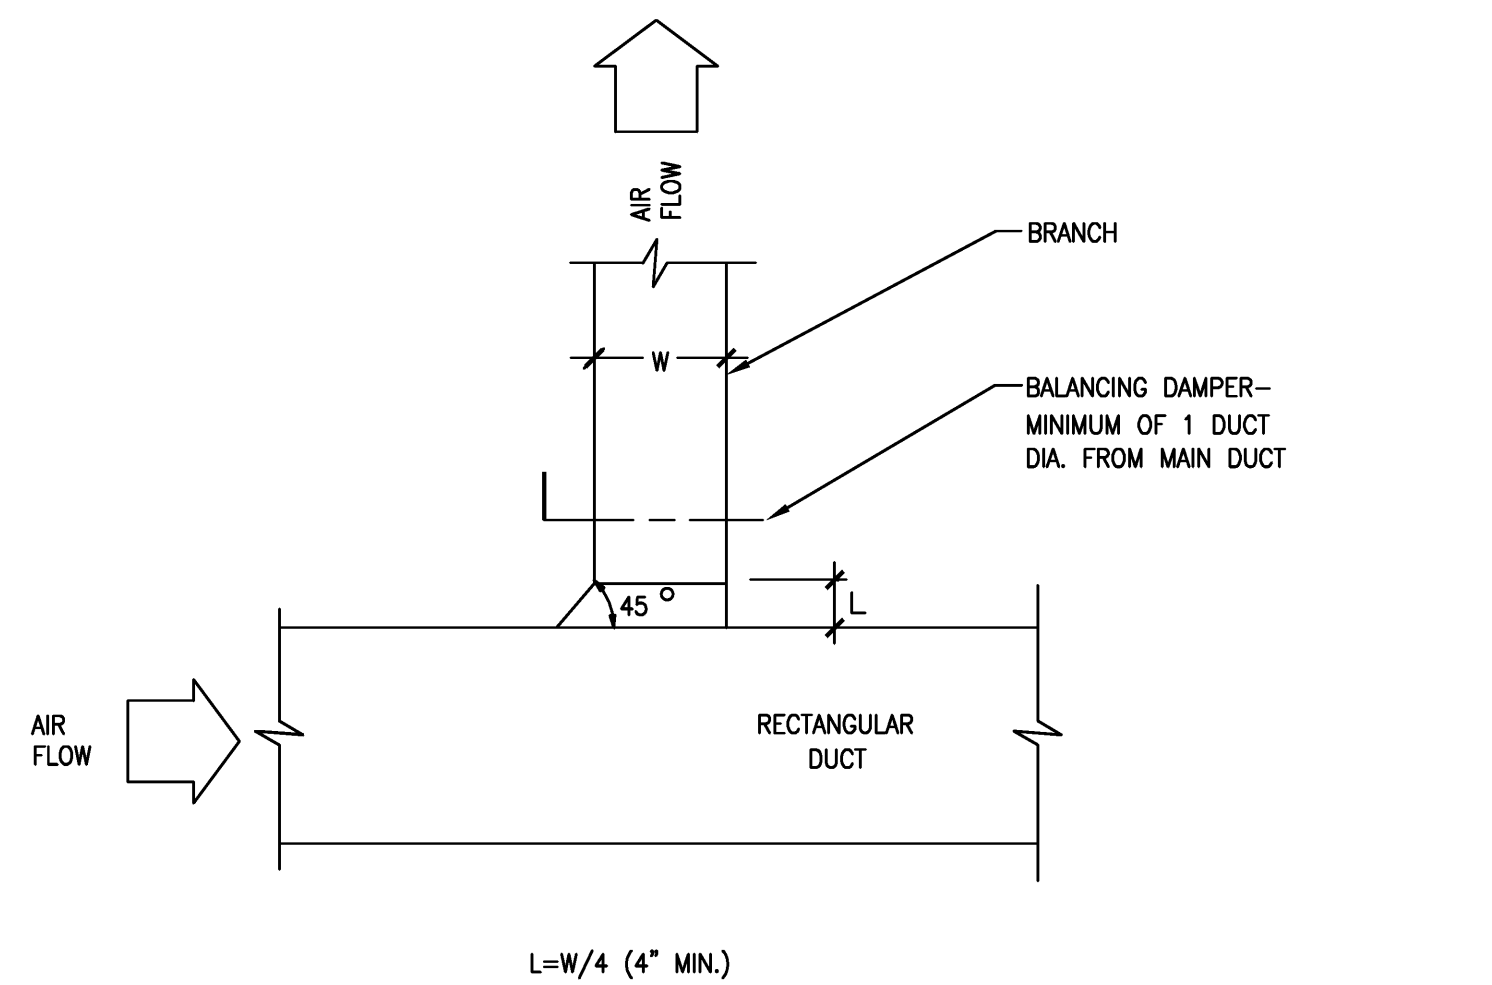


NOTE: 1. SHALL BE USED ON ALL DUCTS DOWNSTREAM OF VAV VOLUME BOXES

**5 RECTANGULAR SUPPLY BRANCH DETAIL**  
NO SCALE

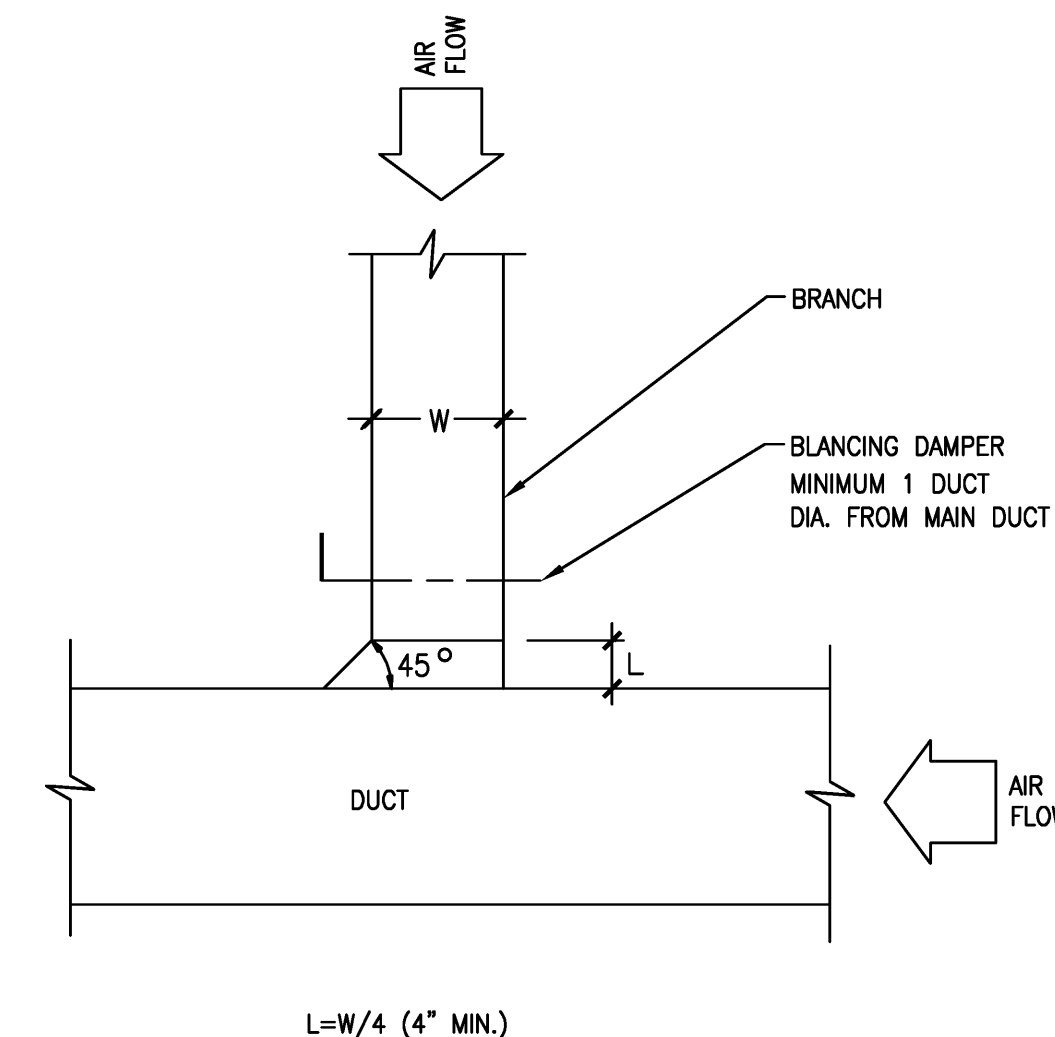


**6 RECTANGULAR EXHAUST BRANCH DETAIL**  
NO SCALE

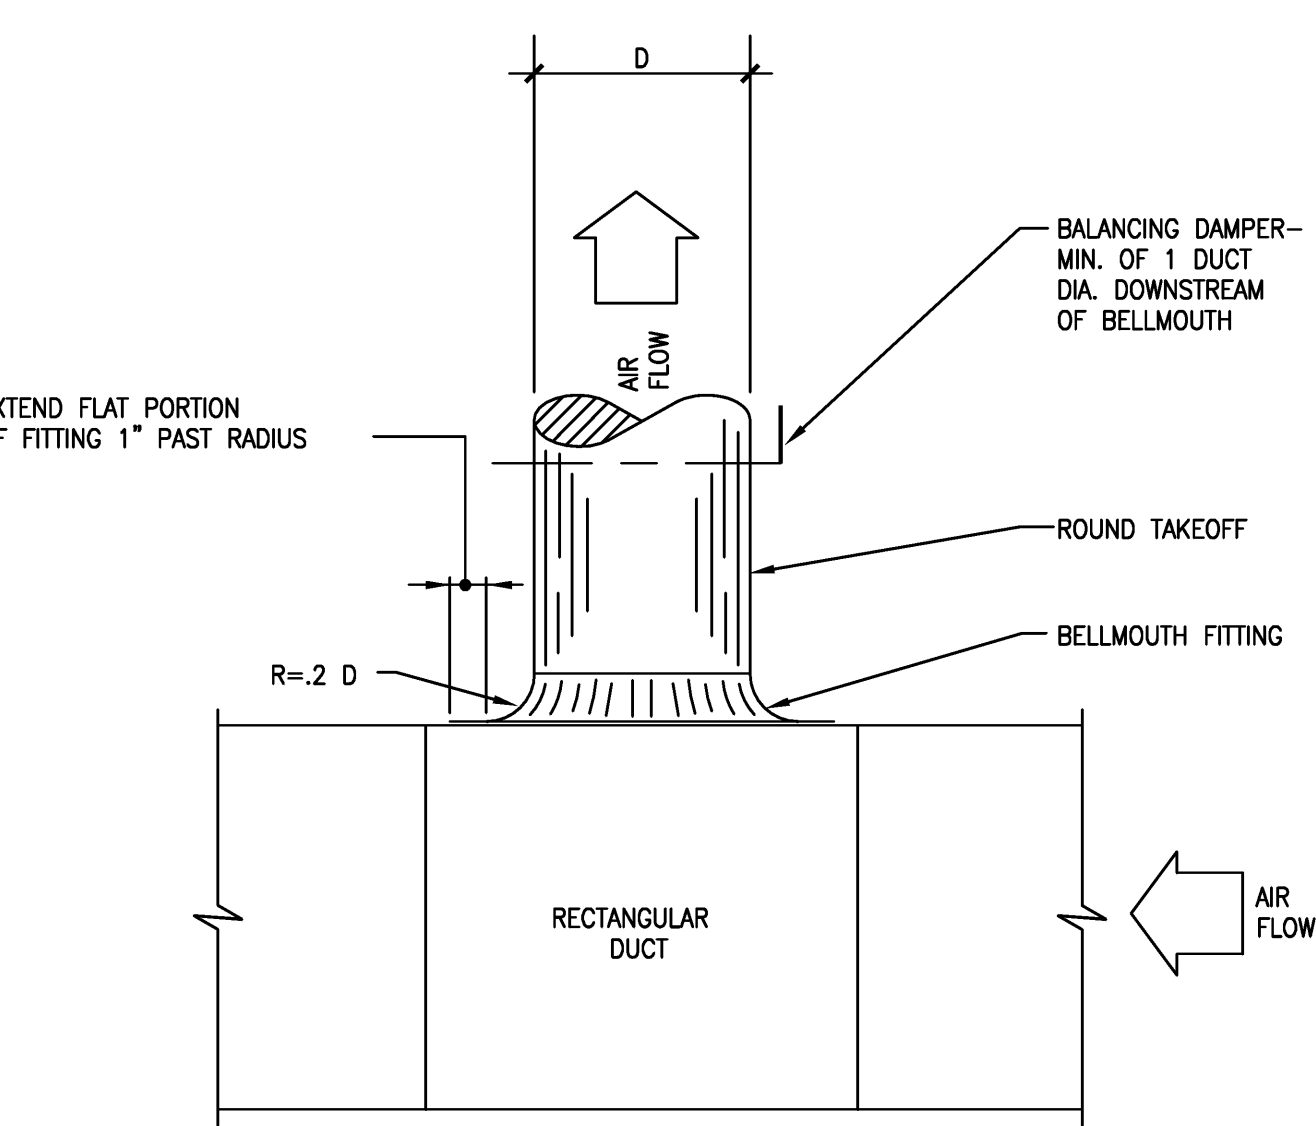


NOTE: 1. SHALL BE USED ON ALL DUCTS UPSTREAM OF CONSTANT VOLUME BOXES

**8 ROUND DUCT TAPPING DETAIL**  
NO SCALE

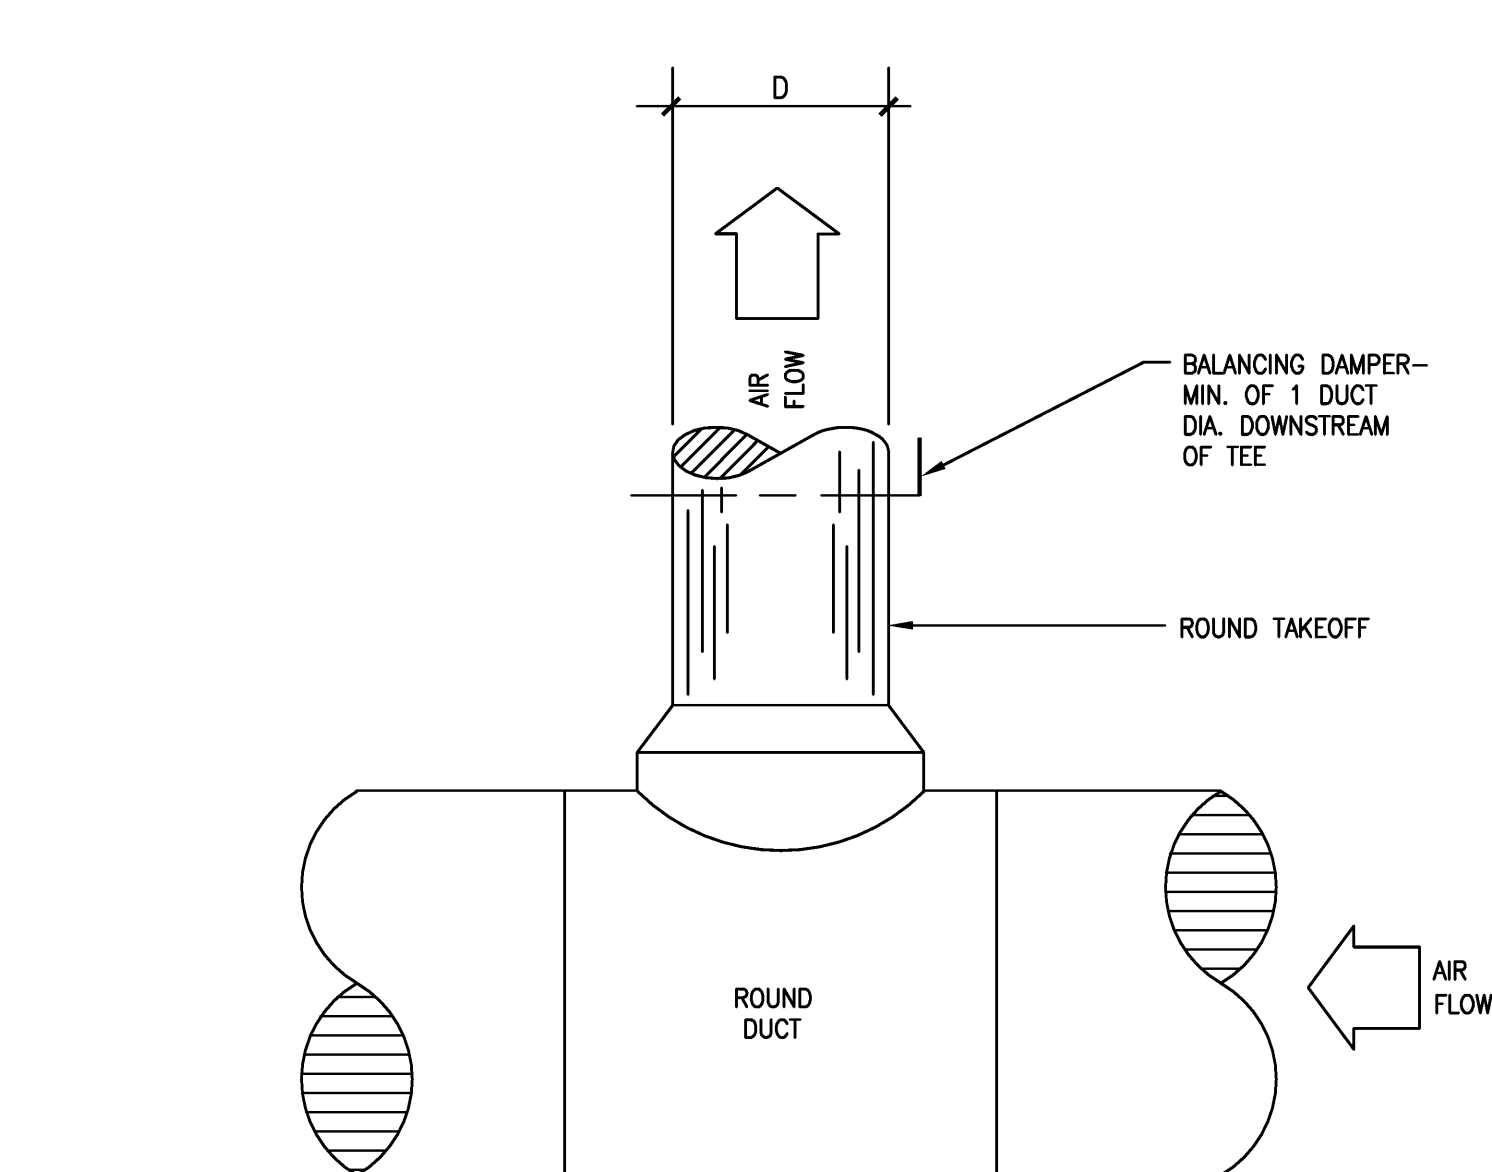


NOTE: 1. SHALL BE USED ON ALL DUCTS UPSTREAM OF TERMINAL UNITS

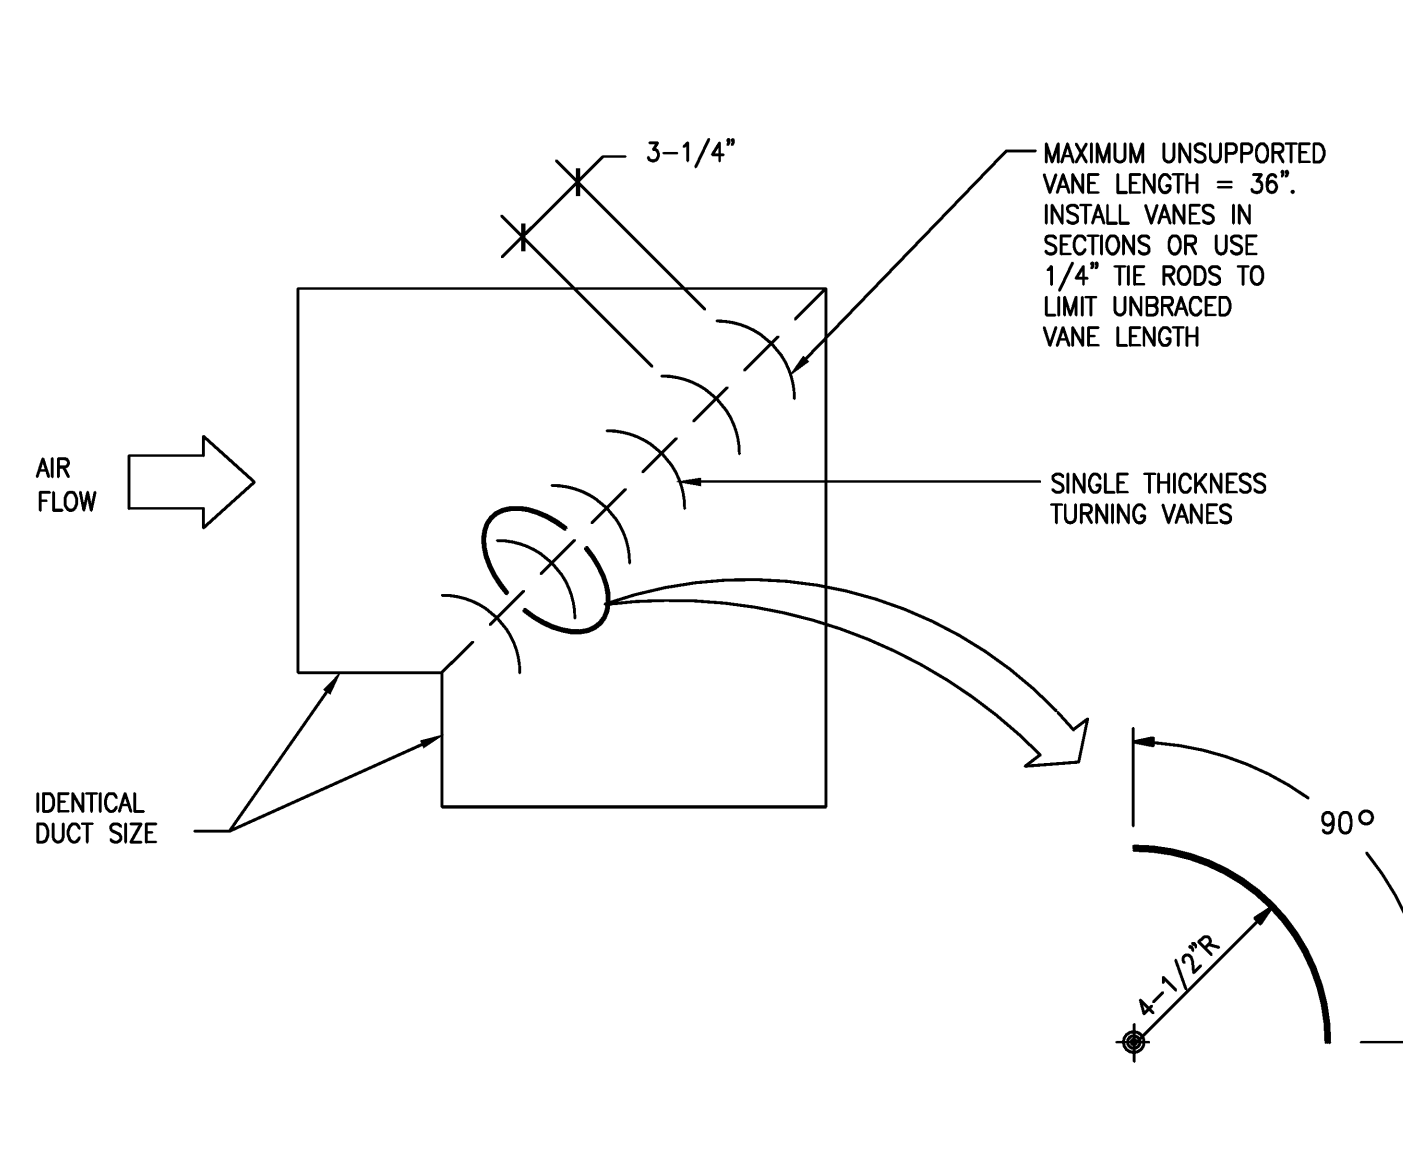


NOTE: REFER TO SMACNA FOR DUCTS ON NON-IDENTICAL SIZES.

**9 MITER ELBOW DETAIL**  
NO SCALE

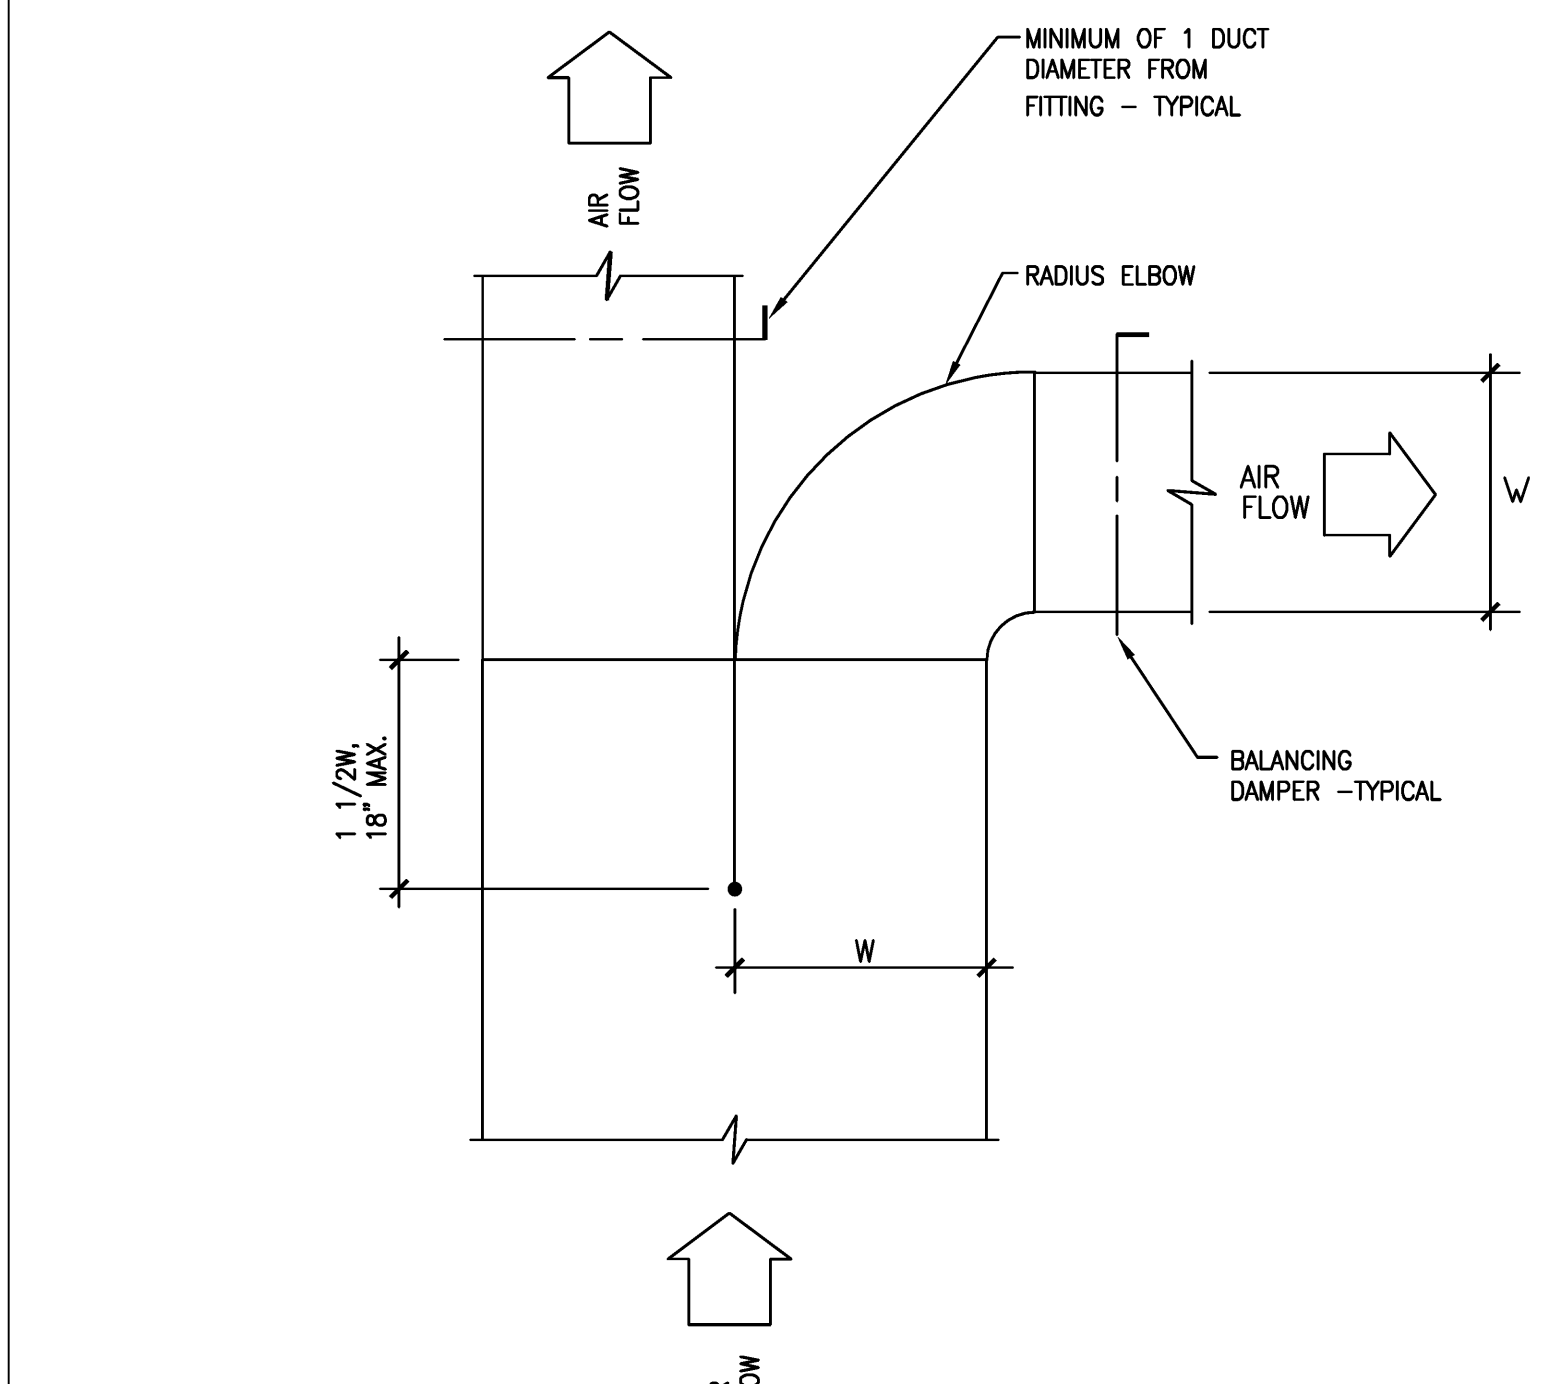

**7 DUCT SPLIT DETAIL**  
NO SCALE

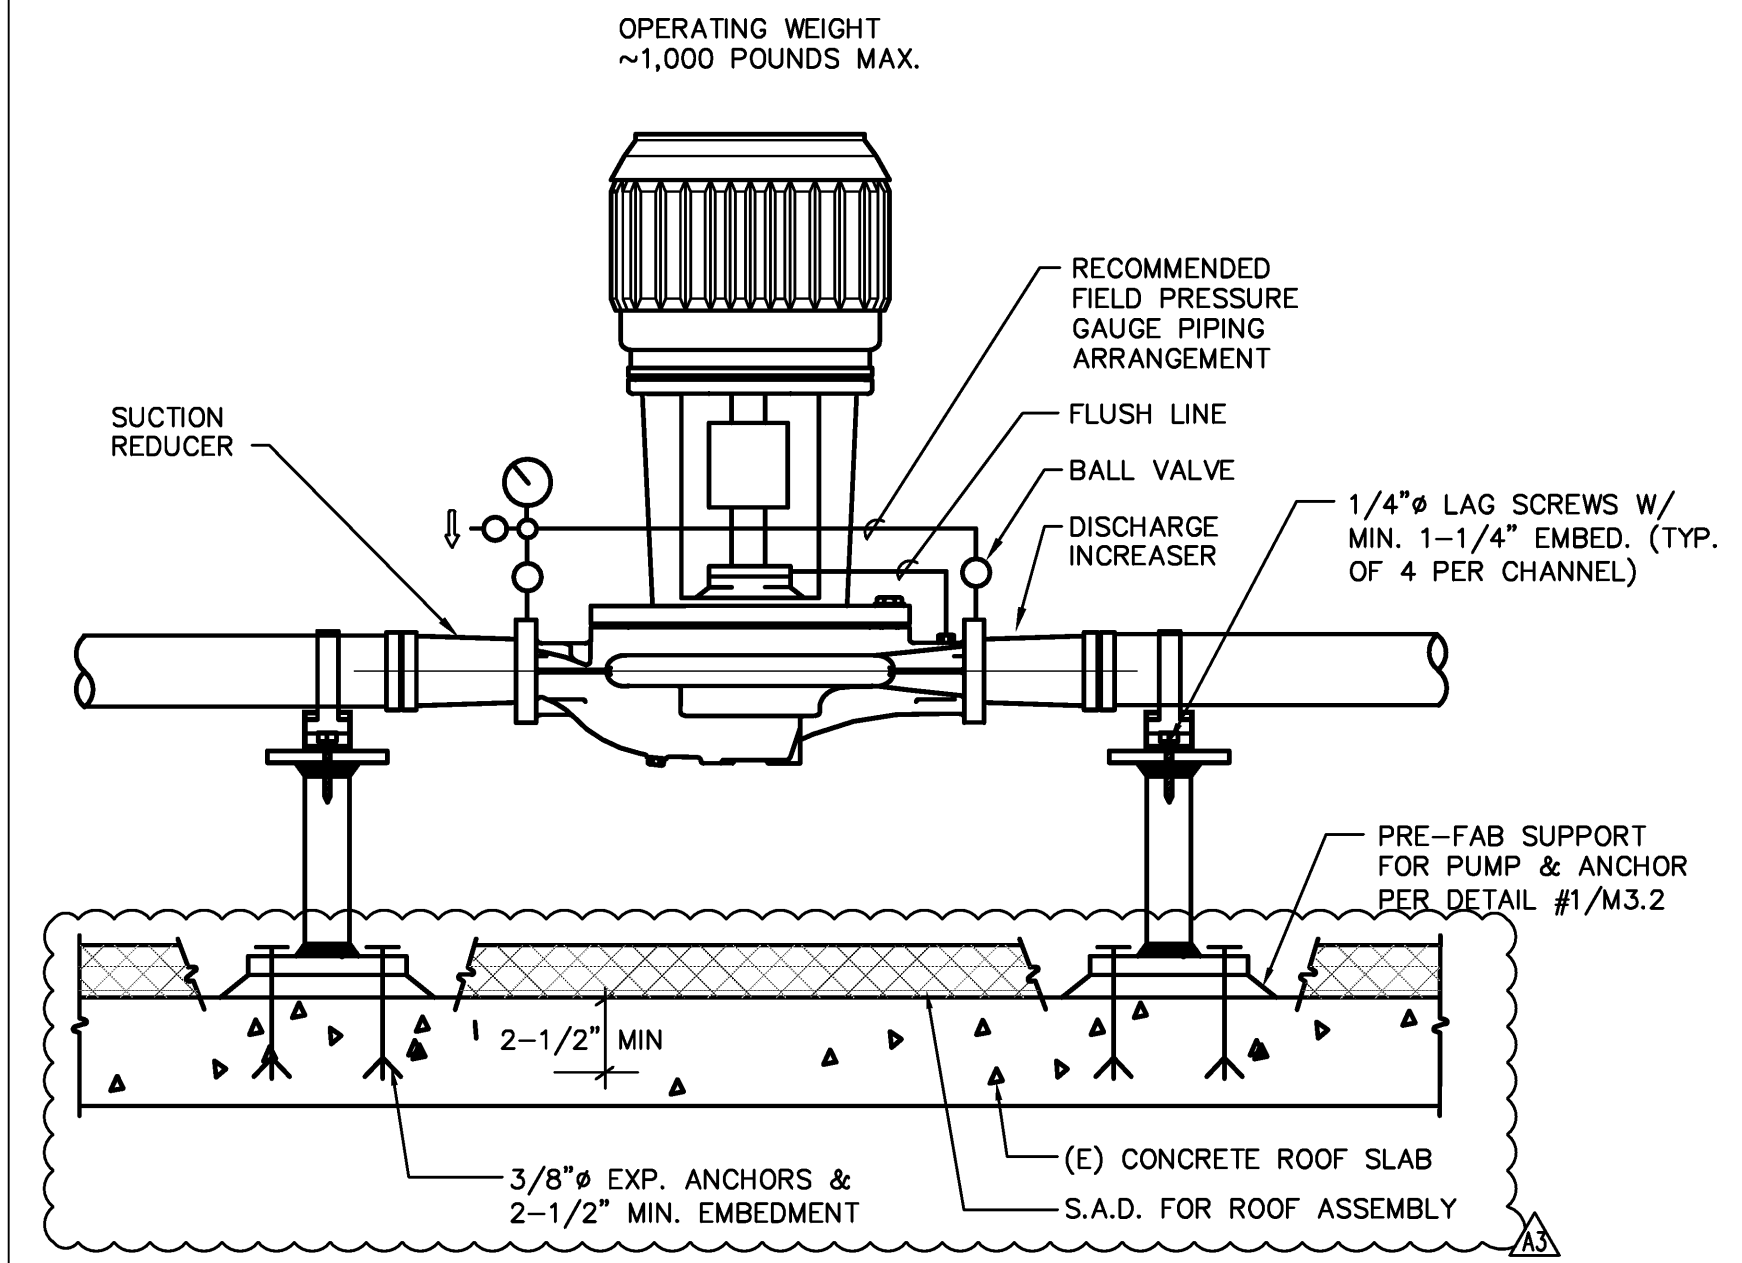

**10 VERTICAL IN-LINE PUMP SUPPORT DETAIL**  
NO SCALE

**tBP**  
architecture  
planning  
interiors  
management

ARCHITECT & INTERIORS  
tBP/Architecture  
1000 Burnett Avenue Suite 140  
Concord, CA 94520  
ph: 925.246.6419 fx: 925.246.6495  
architect

**INTERFACE**  
ENGINEERING

PROJECT: 2008-0108  
CONTRACT: Shawn Wilson

1777 Market Street  
San Francisco, CA 94103  
San Jose, CA 95128  
Ph: 415-488-7898  
www.interfaceengineering.com

REGISTERED PROFESSIONAL ENGINEER  
STATE OF CALIFORNIA  
No. 51825  
Date 5/25/08

**FILE #/CI**

IDENTIFICATION SYMBOL  
DIV. OF REGULATION SERVICES  
APPL. 01-11272  
AC... R/S... S3  
DATE

name  
address  
city, state, zip  
ph  
agency

**L-612 STUDENT SERVICES CENTER REMODEL COLLEGE COMPLEX**  
BID DOCUMENTS

LOS MEDANOS COLLEGE  
2700 EAST LELAND DRIVE  
PITTSBURG, CA 94565

owner

tBP project number: 200810100

file name: 0106M33.dwg

drawn by: GE checked by: BC

date: JULY 31, 2012

Rev. date: description:

10/24/12 ADDENDUM #3

drawing title:  
**MECHANICAL DETAILS**

drawing no:  
**M-33**  
drawing of



**SINGLE DUCT VAV TERMINAL UNIT WITH HOT WATER HEAT SCHEDULE (3RD FLOOR LEVEL)**



SYMBOL	MODEL	SIZE		CFM		STATIC PRESSURE		NC LEVELS		HOT WATER HEATING COIL										CONTROL VALVE		MINIMUM BRANCH PIPE SIZE (IN)	REMARKS	
		INLET (DIA)	OUTLET (WH#)	MAX	MIN	INLET	DOWN	MIN	RAD.	DISCH.	CFM	MEH	EAT	LAT	APP	CFM	EWT	LWT	WPD	ROWS	TYPE 2 OR 3 WAY			SIZE Cv
VAV-2-1	DESV	6	12x8	200	80	1.00	0.30	0.15	22	20	80	3.5	55.0	95.0	0.14	0.5	160	140	0.3	2-RH	2-WAY	0.25	3/4"	SEE NOTES BELOW
VAV-2-3	DESV	6	12x8	330	80	1.00	0.30	0.15	22	20	100	4.3	55.0	95.0	0.14	0.5	160	140	0.3	2-RH	3-WAY	0.25	3/4"	SEE NOTES BELOW
VAV-2-2	DESV	6	12x8	200	80	1.00	0.30	0.21	22	20	80	3.5	55.0	95.0	0.20	0.5	160	140	0.8	2-RH	2-WAY	0.25	3/4"	SEE NOTES BELOW
VAV-2-4	DESV	6	12x8	400	80	1.00	0.30	0.15	22	20	120	5.2	55.0	95.0	0.14	0.5	160	140	0.3	2-RH	2-WAY	0.25	3/4"	SEE NOTES BELOW
VAV-2-5	DESV	6	12x8	200	80	1.00	0.30	0.15	22	20	80	3.5	55.0	95.0	0.14	0.5	160	140	0.3	2-RH	2-WAY	0.25	3/4"	SEE NOTES BELOW
VAV-2-6	DESV	6	12x8	200	80	1.00	0.30	0.21	22	20	80	3.5	55.0	95.0	0.20	0.5	160	140	0.8	2-RH	3-WAY	0.25	3/4"	SEE NOTES BELOW
VAV-2-7	DESV	4	12x8	100	50	1.00	0.30	0.09	24	23	50	2.2	55.0	95.0	0.03	0.5	160	140	0.1	2-RH	2-WAY	0.25	3/4"	SEE NOTES BELOW
VAV-2-8	DESV	6	12x8	200	80	1.00	0.30	0.21	22	20	80	3.5	55.0	95.0	0.20	0.5	160	140	0.8	2-RH	2-WAY	0.25	3/4"	SEE NOTES BELOW
VAV-2-9	DESV	6	12x8	200	80	1.00	0.30	0.21	22	20	80	3.5	55.0	95.0	0.20	0.5	160	140	0.8	2-RH	3-WAY	0.25	3/4"	SEE NOTES BELOW
VAV-2-10	DESV	10	14x12.5	900	230	1.00	0.30	0.21	22	20	270	11.7	55.0	95.0	0.20	0.5	160	140	0.8	2-RH	3-WAY	0.25	3/4"	SEE NOTES BELOW
VAV-2-11	DESV	6	12x8	200	80	1.00	0.30	0.16	20	19	80	3.5	55.0	95.0	0.14	0.5	160	140	0.2	2-RH	3-WAY	0.25	3/4"	SEE NOTES BELOW
VAV-6-11	DESV	6	12x8	325	80	1.00	0.30	0.17	22	20	100	4.3	55.0	95.0	0.16	0.5	160	140	0.3	2-RH	2-WAY	0.25	3/4"	SEE NOTES BELOW
VAV-6-12	DESV	6	12x8	260	80	1.00	0.30	0.17	22	20	80	3.5	55.0	95.0	0.16	0.5	160	140	0.3	2-RH	2-WAY	0.25	3/4"	SEE NOTES BELOW
VAV-6-13	DESV	10	14x12.5	900	230	1.00	0.30	0.21	22	20	270	11.7	55.0	95.0	0.20	0.5	160	140	0.8	2-RH	3-WAY	0.25	3/4"	SEE NOTES BELOW
VAV-5-14	DESV	6	12x8	320	80	1.00	0.30	0.20	21	15	100	4.3	55.0	95.0	0.13	0.5	160	140	0.2	2-RH	3-WAY	0.25	3/4"	SEE NOTES BELOW
VAV-5-15	DESV	6	12x8	300	90	1.00	0.30	0.21	22	20	90	3.9	55.0	95.0	0.20	0.5	160	140	0.8	2-RH	2-WAY	0.25	3/4"	SEE NOTES BELOW
VAV-5-16	DESV	6	12x8	230	80	1.00	0.30	0.20	21	15	80	3.5	55.0	95.0	0.13	0.5	160	140	0.2	2-RH	2-WAY	0.25	3/4"	SEE NOTES BELOW
VAV-5-17	DESV	8	12x10	500	150	1.00	0.30	0.21	22	20	150	6.5	55.0	95.0	0.20	0.5	160	140	0.8	2-RH	2-WAY	0.25	3/4"	SEE NOTES BELOW
VAV-5-18	DESV	6	12x8	200	80	1.00	0.30	0.20	21	15	80	3.5	55.0	95.0	0.13	0.5	160	140	0.2	2-RH	2-WAY	0.25	3/4"	SEE NOTES BELOW
VAV-4-19	DESV	6	12x8	300	80	1.00	0.30	0.14	21	15	90	3.9	55.0	95.0	0.13	0.5	160	140	0.2	2-RH	2-WAY	0.25	3/4"	SEE NOTES BELOW
VAV-4-20	DESV	6	12x8	200	80	1.00	0.30	0.17	22	20	80	3.5	55.0	95.0	0.16	0.5	160	140	0.3	2-RH	2-WAY	0.25	3/4"	SEE NOTES BELOW
VAV-4-21	DESV	6	12x8	300	80	1.00	0.30	0.20	21	15	90	3.9	55.0	95.0	0.13	0.5	160	140	0.2	2-RH	3-WAY	0.25	3/4"	SEE NOTES BELOW
VAV-3-22	DESV	6	12x8	400	150	1.00	0.30	0.14	21	15	150	6.5	55.0	95.0	0.13	0.5	160	140	0.2	2-RH	2-WAY	0.25	3/4"	SEE NOTES BELOW
VAV-3-23	DESV	6	12x8	300	80	1.00	0.30	0.13	20	18	90	3.9	55.0	95.0	0.12	0.5	160	140	0.1	2-RH	3-WAY	0.25	3/4"	SEE NOTES BELOW
VAV-3-24	DESV	4	12x8	100	50	1.00	0.30	0.17	22	20	50	2.2	55.0	95.0	0.16	0.5	160	140	0.3	2-RH	2-WAY	0.25	3/4"	SEE NOTES BELOW
VAV-3-25	DESV	4	12x8	100	50	1.00	0.30	0.17	22	20	50	2.2	55.0	95.0	0.16	0.5	160	140	0.3	2-RH	2-WAY	0.25	3/4"	SEE NOTES BELOW
VAV-3-26	DESV	6	12x8	320	80	1.00	0.30	0.14	20	18	100	4.3	55.0	95.0	0.12	0.5	160	140	0.1	2-RH	3-WAY	0.25	3/4"	SEE NOTES BELOW
VAV-3-27	DESV	6	12x8	240	80	1.00	0.30	0.22	22	18	80	3.5	55.0	95.0	0.11	0.5	160	140	0.1	2-RH	2-WAY	0.25	3/4"	SEE NOTES BELOW
VAV-7-28	DESV	6	12x8	390	140	1.00	0.30	0.19	21	17	140	6.1	55.0	95.0	0.09	0.5	160	140	0.1	2-RH	2-WAY	0.25	3/4"	SEE NOTES BELOW
VAV-3-29	DESV	6	12x8	200	80	1.00	0.30	0.13	20	18	80	3.5	55.0	95.0	0.12	0.5	160	140	0.1	2-RH	3-WAY	0.25	3/4"	SEE NOTES BELOW
VAV-7-30	DESV	6	12x8	240	80	1.00	0.30	0.16	20	19	80	3.5	55.0	95.0	0.14	0.5	160	140	0.2	2-RH	2-WAY	0.25	3/4"	SEE NOTES BELOW
VAV-7-31	DESV	12	16x15	1360	470	1.00	0.30	0.13	20	18	470	20.4	55.0	95.0	0.12	1.0	160	140	0.1	2-RH	2-WAY	0.50	3/4"	SEE NOTES BELOW
VAV-4-32	DESV	6	12x8	200	80	1.00	0.30	0.16	20	19	80	3.5	55.0	95.0	0.14	0.5	160	140	0.2	2-RH	3-WAY	0.25	3/4"	SEE NOTES BELOW
VAV-4-33	DESV	6	12x8	380	80	1.00	0.30	0.22	22	18	120	5.2	55.0	95.0	0.11	0.5	160	140	0.1	2-RH	2-WAY	0.25	3/4"	SEE NOTES BELOW
VAV-4-34	DESV	8	12x10	595	150	1.00	0.30	0.19	21	17	180	7.8	55.0	95.0	0.09	0.5	160	140	0.1	2-RH	2-WAY	0.25	3/4"	SEE NOTES BELOW
VAV-4-35	DESV	6	12x8	200	80	1.00	0.30	0.13	20	18	80	3.5	55.0	95.0	0.12	0.5	160	140	0.1	2-RH	2-WAY	0.25	3/4"	SEE NOTES BELOW
VAV-4-36	DESV	6	12x8	200	80	1.00	0.30	0.16	20	19	80	3.5	55.0	95.0	0.14	0.5	160	140	0.2	2-RH	2-WAY	0.25	3/4"	SEE NOTES BELOW
VAV-4-37	DESV	6	12x8	230	80	1.00	0.30	0.16	20	19	80	3.5	55.0	95.0	0.14	0.5	160	140	0.2	2-RH	2-WAY	0.25	3/4"	SEE NOTES BELOW

- NOTES:
- ALL BOXES SHALL BE PROVIDED WITH HIGH CFM CONTROL.
  - ALL BOXES SHALL BE PRESSURE INDEPENDENT AND COMPLETE WITH CENTER AVERAGING AIRFLOW SENSOR.
  - SEISMIC BRACE UNIT PER SMACMA GUIDELINES.
  - COIL CONNECTION AND CONTROL BOX SHALL BE ON OPPOSITE SIDE.
  - CONTROL VALVES TO BE FIELD INSTALLED AS REQUIRED. (2-WAY & 3-WAY)
  - ALL TERMINAL BOXES SHALL HAVE MINIMUM 1 INCH INSULATION CONFORMING TO UL181 AND NFPA90A.
  - ALL PERFORMANCE SHALL BE ARI CERTIFIED.
  - ROOM NC LEVEL SHOWN INCLUDES ATTENUATION TRANSFER FUNCTIONS OBTAINED FROM TABLES IN ARI STANDARD 885.
  - SOUND DATA SHALL BE OBTAINED FROM TESTS CONDUCTED IN ACCORDANCE WITH ARI STANDARD 880-98.
  - 120V POWER TO CONTROL TRANSFORMER BY DIVISION 16 WITH TOGGLE SWITCH TO ISOLATE POWER TO 24V. 24V DDC CONTROL WIRING BY "ANDOVER" CONTROL CONTRACTOR.





19.5

**SINGLE DUCT VAV TERMINAL UNIT WITH HOT WATER HEAT SCHEDULE (SS4 LEVEL)**

SYMBOL	MODEL	SIZE		CFM		STATIC PRESSURE		NC LEVELS		HOT WATER HEATING COIL										CONTROL VALVE		MINIMUM BRANCH PIPE SIZE (IN)	REMARKS	
		INLET (DIA)	OUTLET (WH#)	MAX	MIN	INLET	DOWN	MIN	RAD.	DISCH.	CFM	MEH	EAT	LAT	APP	CFM	EWT	LWT	WPD	ROWS	TYPE 2 OR 3 WAY			SIZE Cv
VAV-2-1	DESV	6	12x8	310	100	1.00	0.30	0.11	16	15	100	4.3	55.0	95.0	0.05	0.5	160	140	0.1	2-RH	2-WAY	0.25	3/4"	SEE NOTES BELOW
VAV-2-2	DESV	6	12x8	200	80	1.00	0.30	0.19	21	17	80	3.5	55.0	95.0	0.09	0.5	160	140	0.1	2-RH	2-WAY	0.25	3/4"	SEE NOTES BELOW
VAV-2-3	DESV	6	12x8	300	80	1.00	0.30	0.25	22	20	90	3.9	55.0	95.0	0.12	0.5	160	140	0.1	2-RH	2-WAY	0.25	3/4"	SEE NOTES BELOW
VAV-5-4	DESV	6	12x8	300	80	1.00	0.30	0.15	22	20	90	3.9	55.0	95.0	0.14	0.5	160	140	0.3	2-RH	2-WAY	0.25	3/4"	SEE NOTES BELOW
VAV-5-5	DESV	6	12x8	300	90	1.00	0.30	0.15	22	20	90	3.9	55.0	95.0	0.14	0.5	160	140	0.3	2-RH	2-WAY	0.25	3/4"	SEE NOTES BELOW
VAV-5-6	DESV	6	12x8	340	80	1.00	0.30	0.18	21	19	110	4.8	55.0	95.0	0.09	0.5	160	140	0.2	2-RH	2-WAY	0.25	3/4"	SEE NOTES BELOW
VAV-5-7	DESV	6	12x8	300	90	1.00	0.30	0.09	24	23	90	3.9	55.0	95.0	0.03	0.5	160	140	0.1	2-RH	2-WAY	0.25	3/4"	SEE NOTES BELOW
VAV-5-8	DESV	8	12x10	575	150	1.00	0.30	0.19	23	20	180	7.8	55.0	95.0	0.18	0.5	160	140	0.4	2-RH	2-WAY	0.25	3/4"	SEE NOTES BELOW
VAV-6-9	DESV	14	20x18	2160	450	1.00	0.30	0.14	18	16	650	28.2	55.0	95.0	0.07	1.5	160	140	0.1	2-RH	2-WAY	0.75	3/4"	SEE NOTES BELOW
VAV-5-10	DESV	10	14x12.5	800	230	1.00	0.30	0.31	24	21	240	10.4	55.0	95.0	0.14	0.5	160	140	0.1	2-RH	2-WAY	0.25	3/4"	SEE NOTES BELOW
VAV-2-11	DESV	6	12x8	200	80	1.00	0.30	0.11	19	18	80	3.5	55.0	95.0	0.10	0.5	160	140	0.1	2-RH	2-WAY	0.25	3/4"	SEE NOTES BELOW
VAV-2-12	DESV	4	12x8	100	50	1.00	0.30	0.15	21	15	50	2.2	55.0	95.0	0.12	0.5	160	140	0.2	2-RH	2-WAY	0.25	3/4"	SEE NOTES BELOW
VAV-2-13	DESV	14	20x18	1860	450	1.00	0.30	0.14	29	27	560	24.3	55.0	95.0	0.04	1.0	160	140	0.1	2-RH	2-WAY	0.50	3/4"	SEE NOTES BELOW
VAV-3-14	DESV	6	12x8	200	80	1.00	0.30	0.16	18	16	80	3.5	55.0	95.0	0.07	0.5	160	140	0.1	2-RH	2-WAY	0.25	3/4"	SEE NOTES BELOW
VAV-3-15	DESV	14	20x18	1650	450	1.00	0.30	0.20	29	27	500	21.7	55.0	95.0	0.19	1.0	160	140	0.2	2-RH	2-WAY	0.50	3/4"	SEE NOTES BELOW
VAV-3-16	DESV	6	12x8	300	80	1.00																		

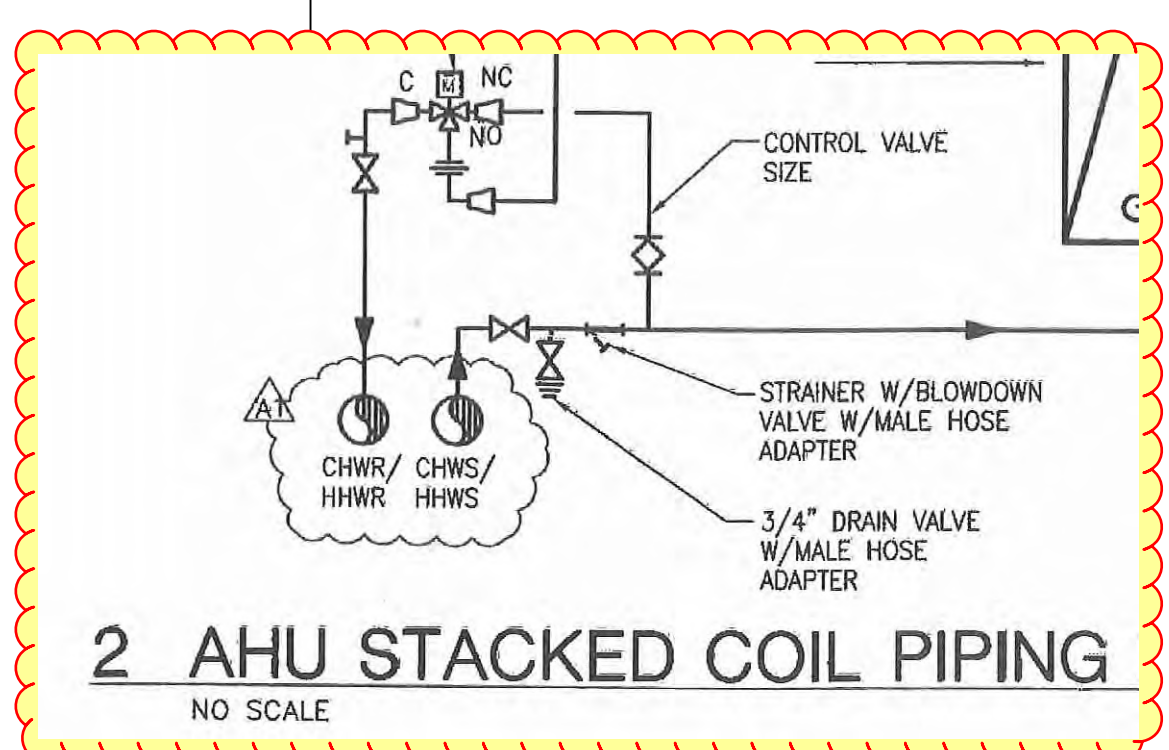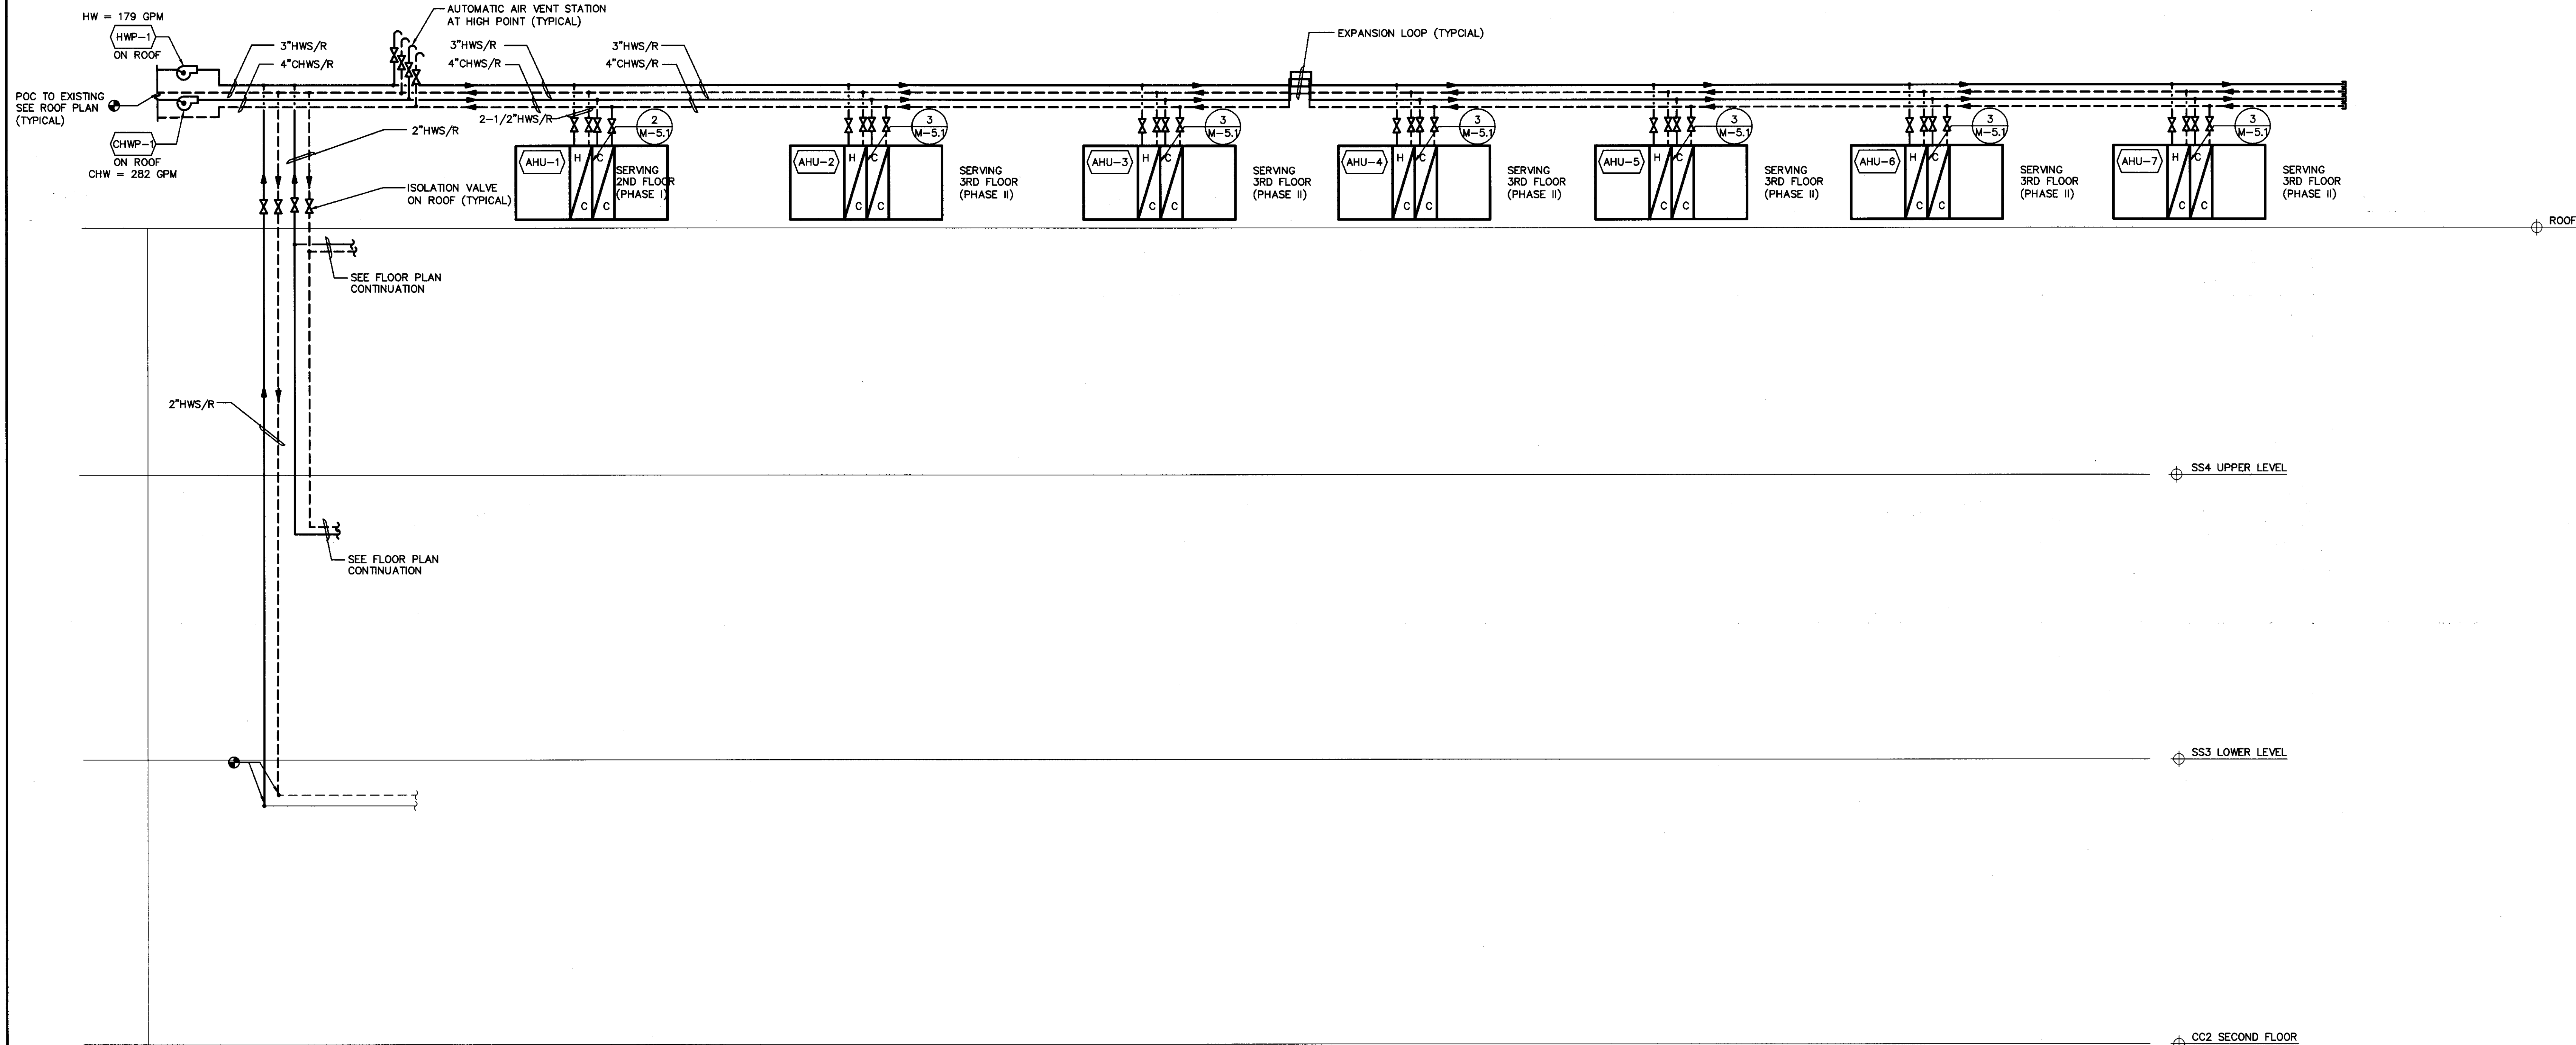

**1 CHILLED WATER AND HEATING HOT WATER FLOW DIAGRAM**  
NO SCALE

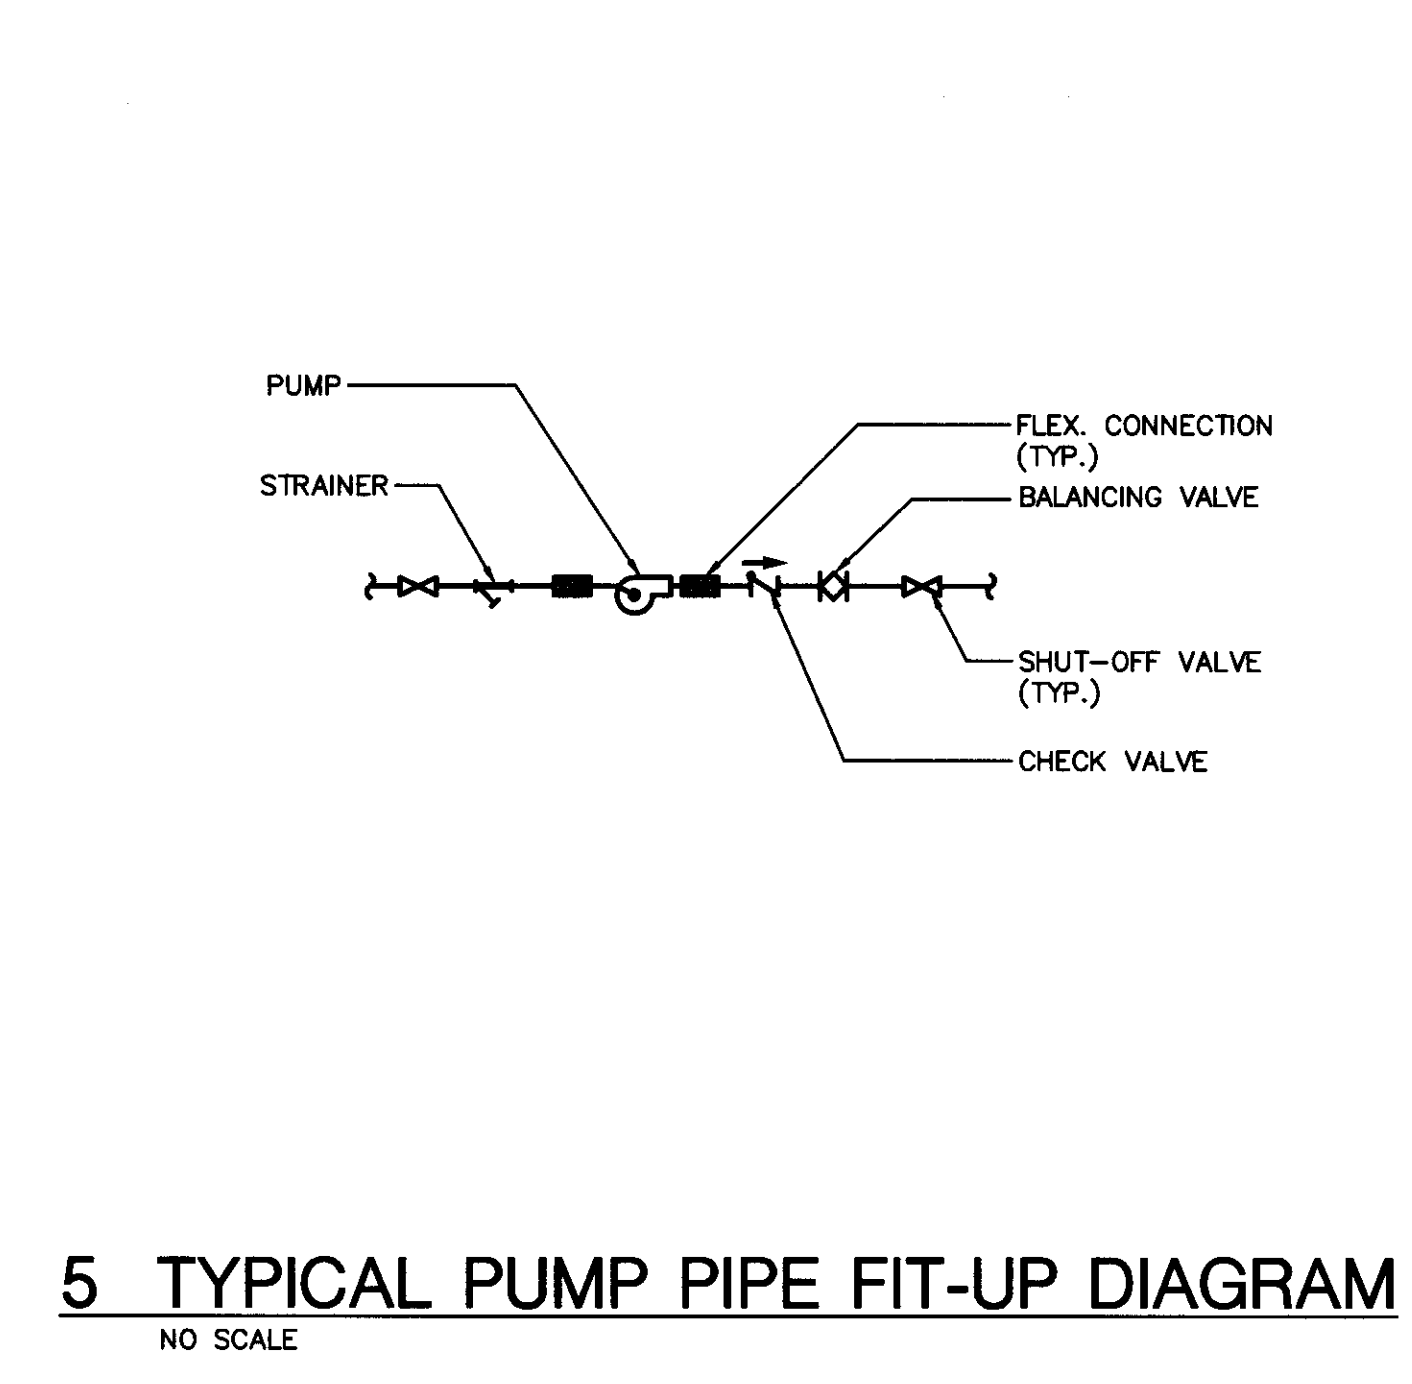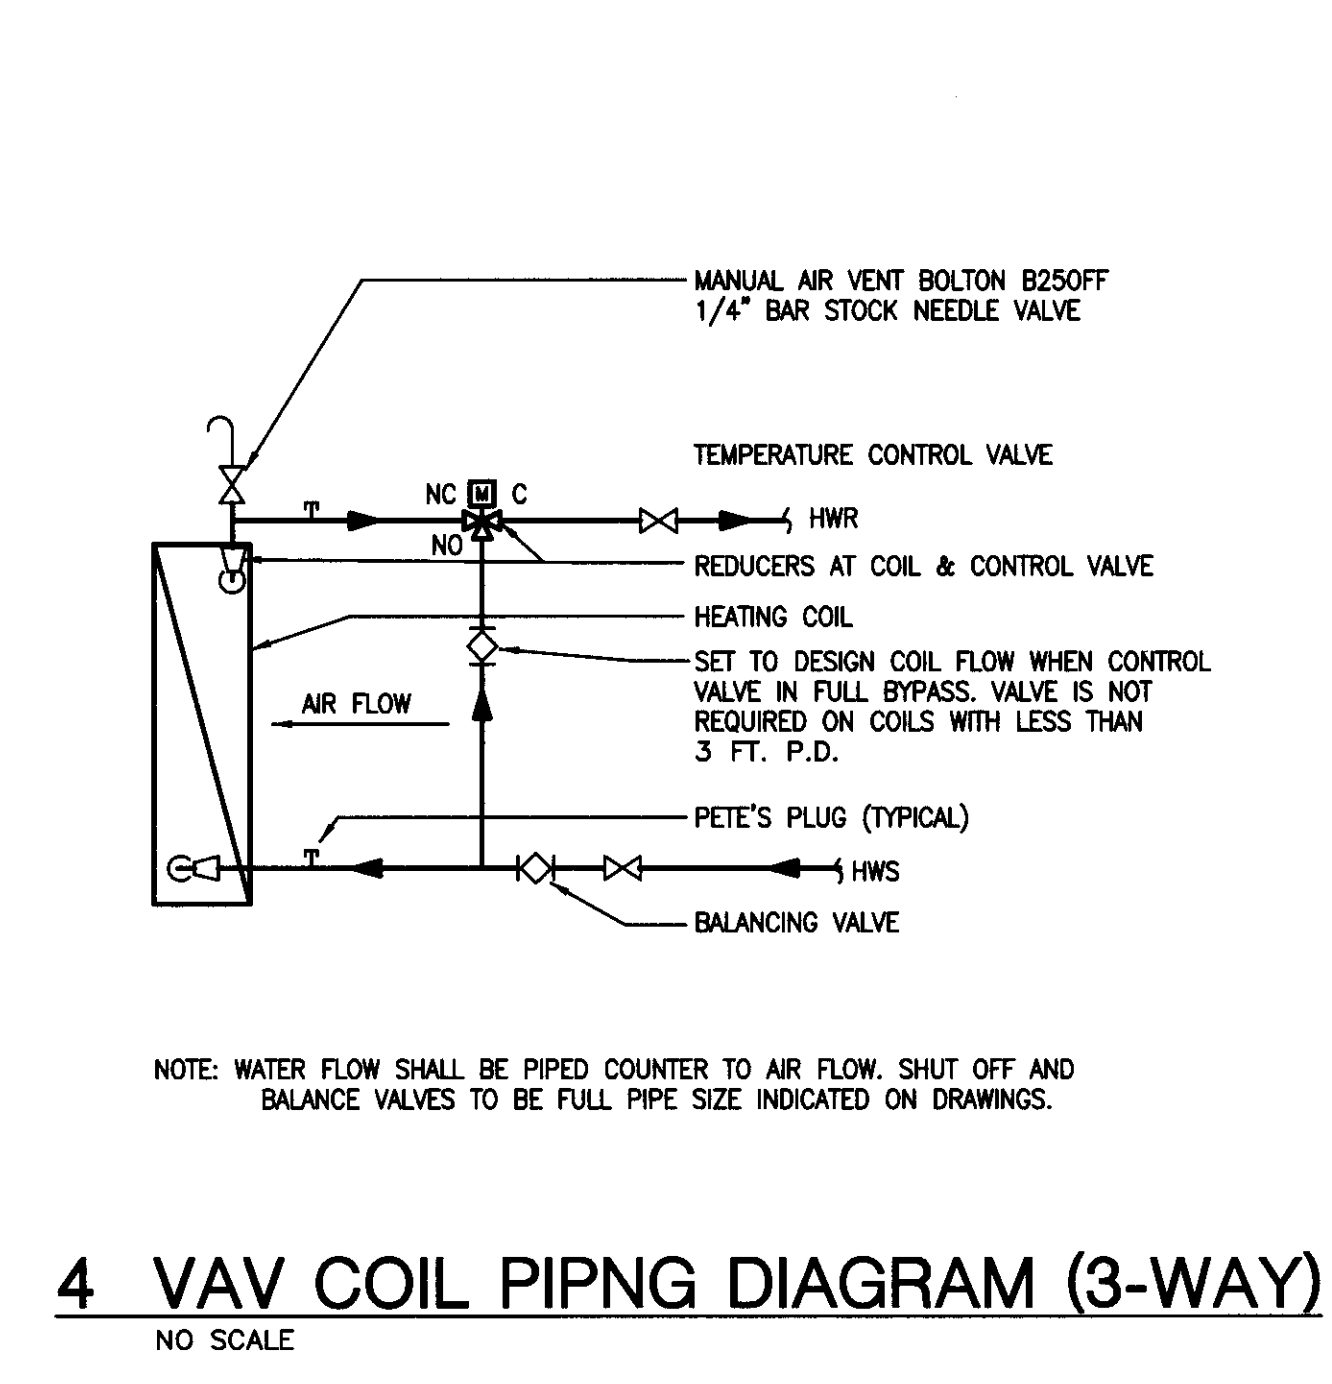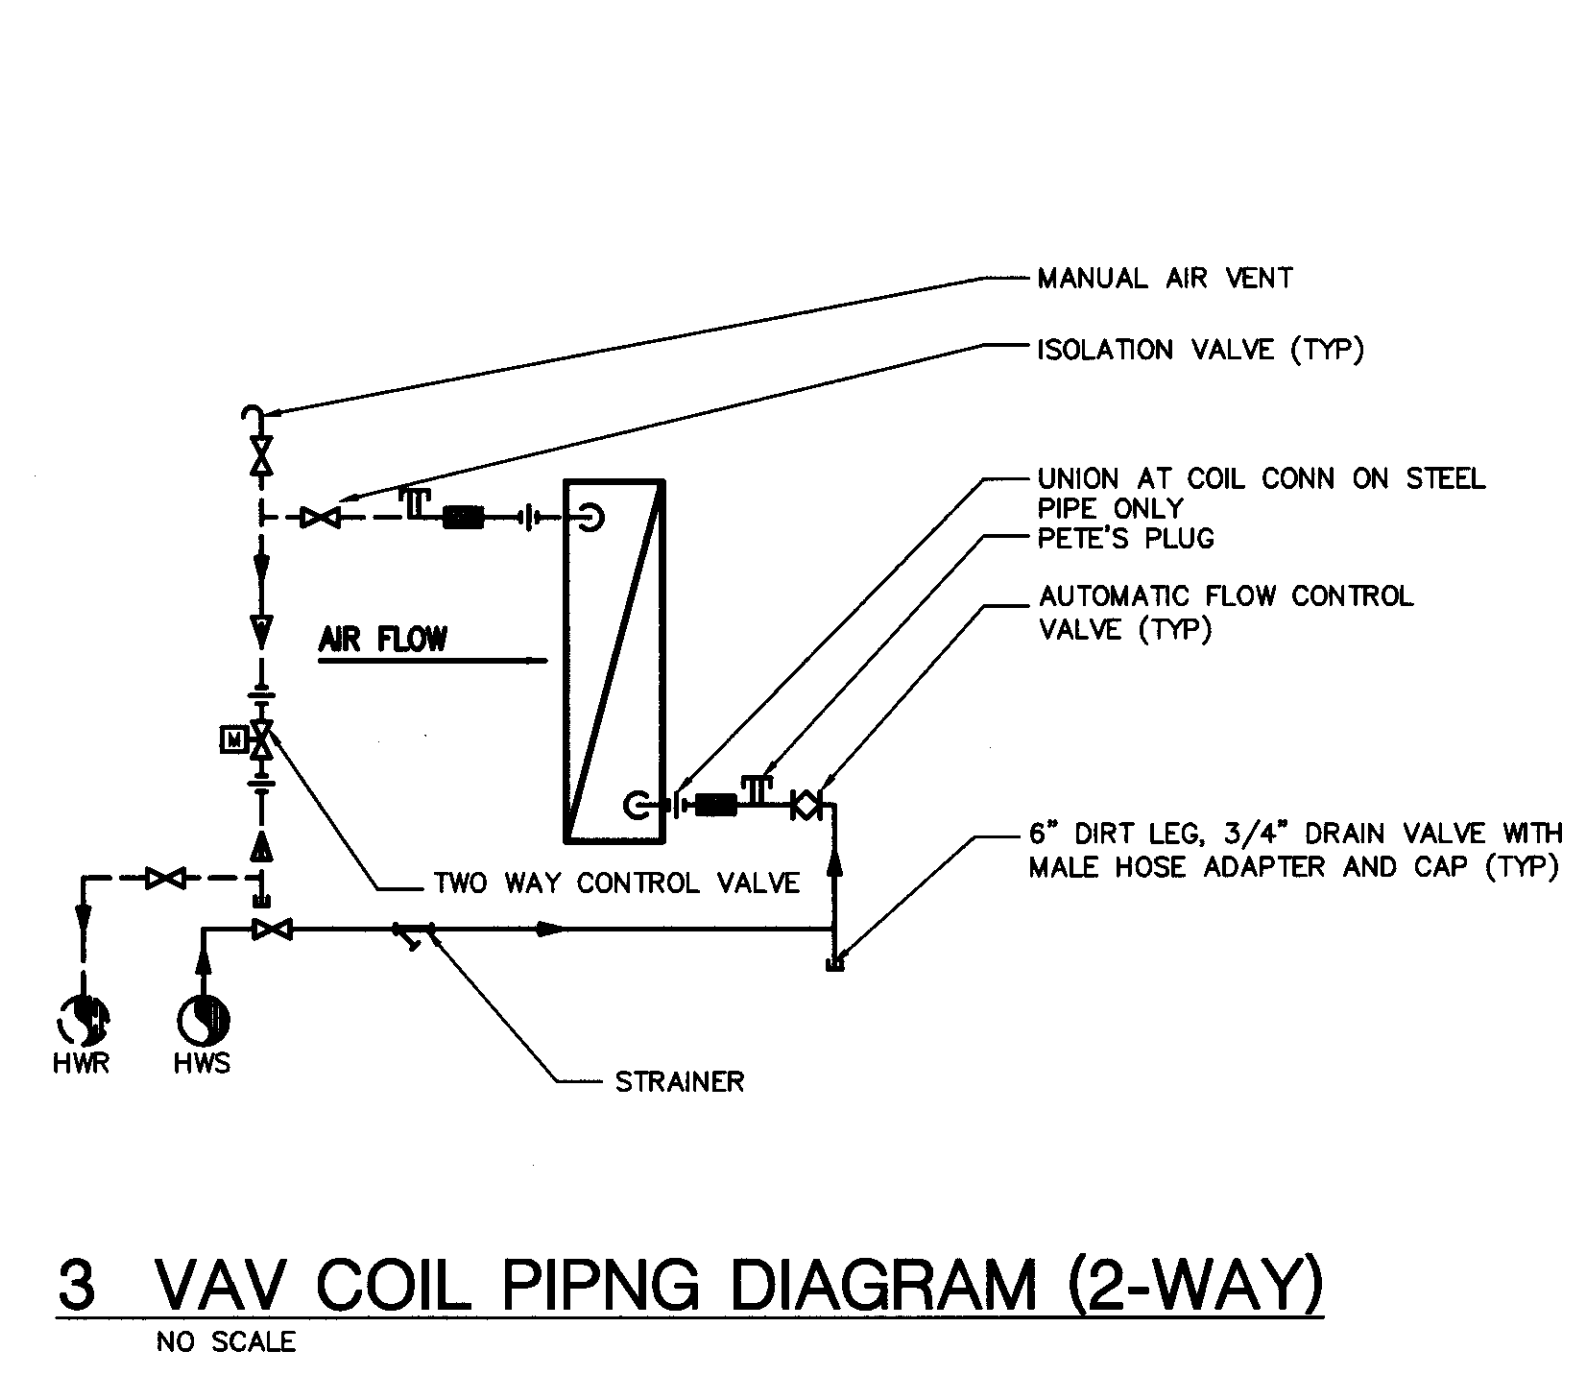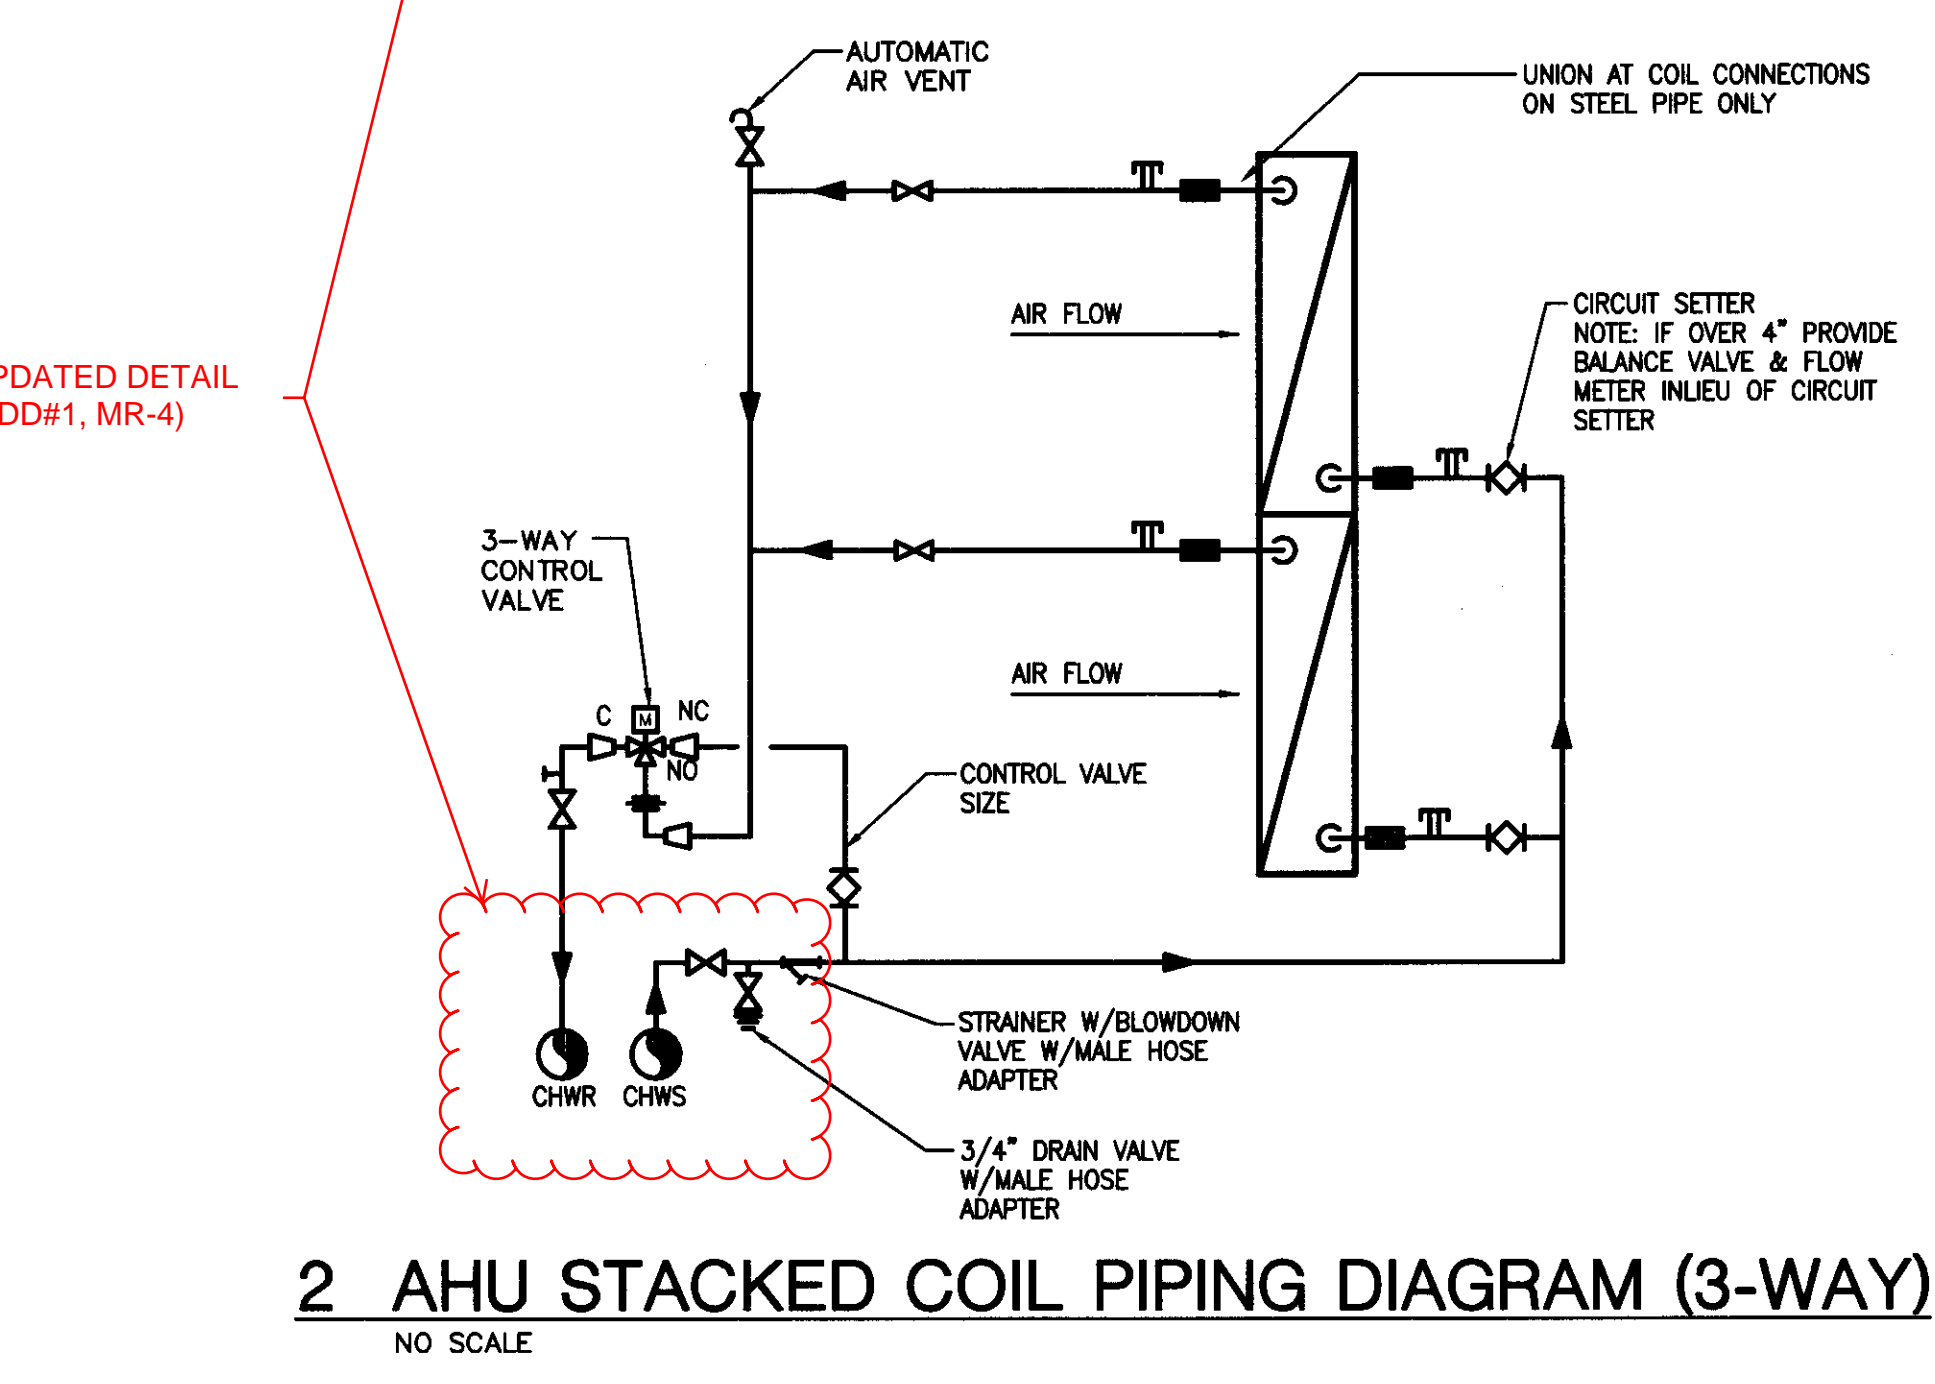

FILE: 0106M51.DWG - M51 | EDIT: 7/24/2012 3:51 PM BY ALLEN | PLOT: 7/25/2012 10:01 PM BY HAI PHAN

UPDATED DETAIL (ADD#1, MR-4)

**tBP** architecture planning interiors management

1887 Architecture  
1000 Burnett Avenue Suite 140  
Concord, CA 94520  
ph: 925.246.6419 fx: 925.246.6495

architect

**INTERFACE ENGINEERING**

PROJECT: 2008-0105  
CONTACT: Shimm Wilson  
717 Market Street  
San Francisco, CA 94103  
TEL: 415.488.9240  
WWW: www.interfaceengineering.com

consultant

**RE #7-C1**

IDENTIFICATION STAMP  
DIV. OF THE STATE ARCHITECT  
OFFICE OF REGISTRATION SERVICES  
APPL 01-112772  
DATE: JUL 31 2012

name: \_\_\_\_\_  
address: \_\_\_\_\_  
city, state, zip: \_\_\_\_\_  
ph: \_\_\_\_\_  
agency: \_\_\_\_\_


**L-612 STUDENT SERVICES CENTER REMODEL COLLEGE COMPLEX**  
BID DOCUMENTS

LOS MEDANOS COLLEGE  
2700 EAST LELAND DRIVE  
PITTSBURG, CA 94565


owner

tBP project number: 20081000  
file name: 0106M51.dwg  
drawn by: GE checked by: BC  
date: **JULY 31, 2012**  
Rev. date: description:

drawing title:  
**HYDRONIC PIPING DIAGRAM**  
drawing no:  
**M-5.1**  
drawing of

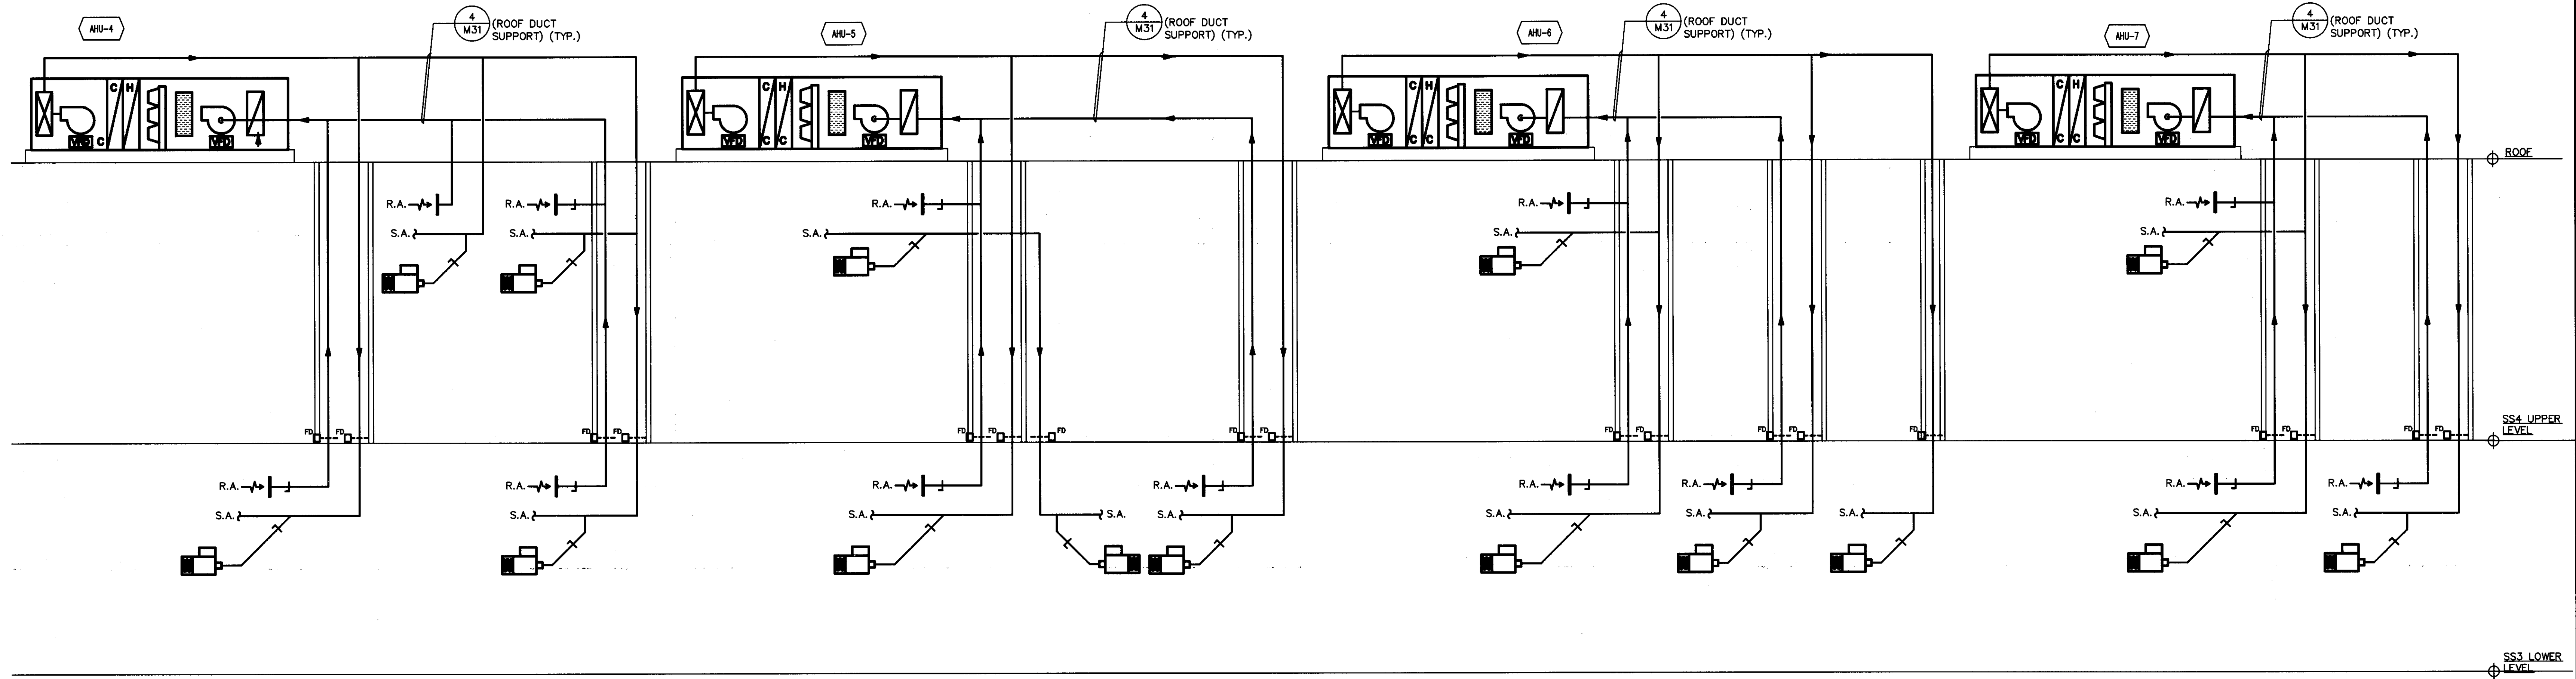

1 AIR FLOW DIAGRAM (STUDENT SERVICES CENTER)  
NO SCALE

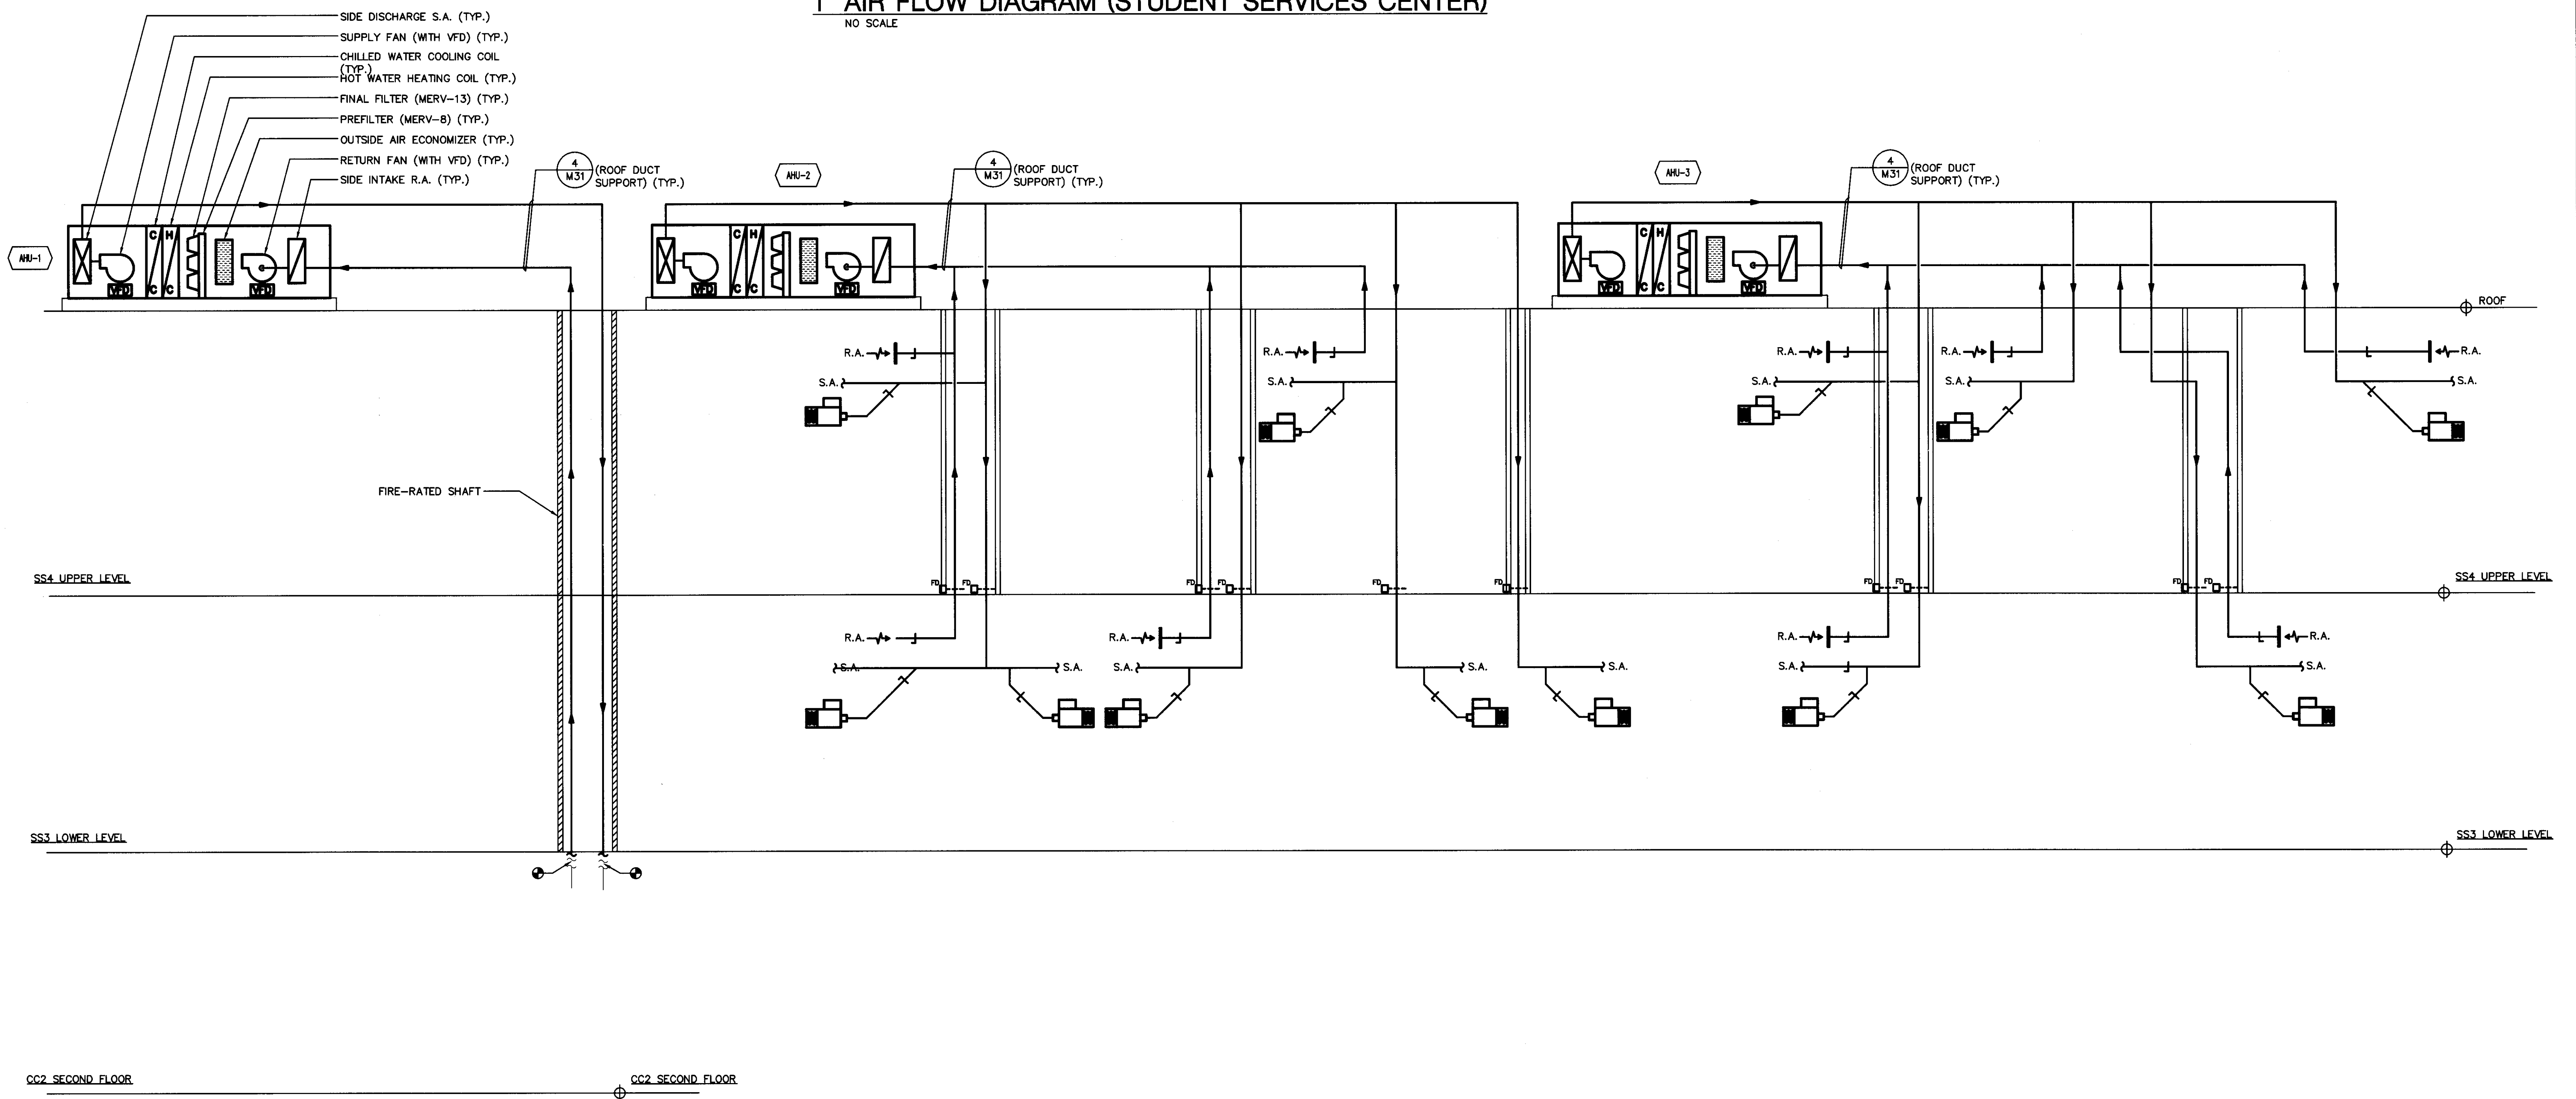

2 AIR FLOW DIAGRAM (STUDENT SERVICES CENTER)  
NO SCALE

FILE: D:\06M52.DWG - M52 | EDIT: 7/25/2012 7:38 PM BY SHAWN W | PLOT: 7/25/2012 10:00 PM BY HAI PHAN

**tBP**  
architecture  
planning  
interiors  
management

tBP/Architecture  
1000 Burnett Avenue Suite 140  
Concord, CA 94520  
ph: 925.246.6419 fx: 925.246.6495

architect

**INTERFACE**  
ENGINEERING

PROJECT: 20060518  
CONTACT: Shawn Wilson

777 Market Street  
Suite 500  
San Francisco, CA 94103  
TEL: 415.489.7240  
FAX: 415.489.7289  
www.interface-engineering.com

REGISTERED PROFESSIONAL ENGINEER  
No. 50922  
Mechanical  
State of California

consultant

**RE/FCI**

REGISTERED PROFESSIONAL ENGINEER  
No. 50922  
Mechanical  
State of California

APPL 01/12/27  
ACSP-15  
DATE: JUL 31 2012

name: \_\_\_\_\_  
address: \_\_\_\_\_  
city, state, zip: \_\_\_\_\_  
ph: \_\_\_\_\_  
agency: \_\_\_\_\_

**L-612 STUDENT SERVICES CENTER REMODEL COLLEGE COMPLEX**  
BID DOCUMENTS

LOS MEDANOS COLLEGE  
2700 EAST LELAND DRIVE  
PITTSBURG, CA 94565


owner

tBP project number:	20610.00
file name:	0106M52.dwg
drawn by:	GE
checked by:	EC
date:	JULY 31, 2012
Rev. date:	description:

THIS DRAWING AND THE DESIGN, SPECIFICATIONS, DETAILS AND OTHER INFORMATION CONTAINED HEREIN CONSTITUTE UNPUBLISHED WORK OF SPANARCHITECTURE AND SHALL REMAIN THE PROPERTY OF SPANARCHITECTURE IN PERMANENT POSSESSION. NO PART THEREOF SHALL BE REPRODUCED, TRANSMITTED, DISTRIBUTED, SOLD, RENTED, COPIED, OR OTHERWISE USED IN ANY MANNER WITHOUT THE ADVANCED EXPRESS WRITTEN CONSENT OF SPANARCHITECTURE.

drawing title:  
**AIR FLOW DIAGRAM**

drawing no:  
**M-5.2**  
drawing of

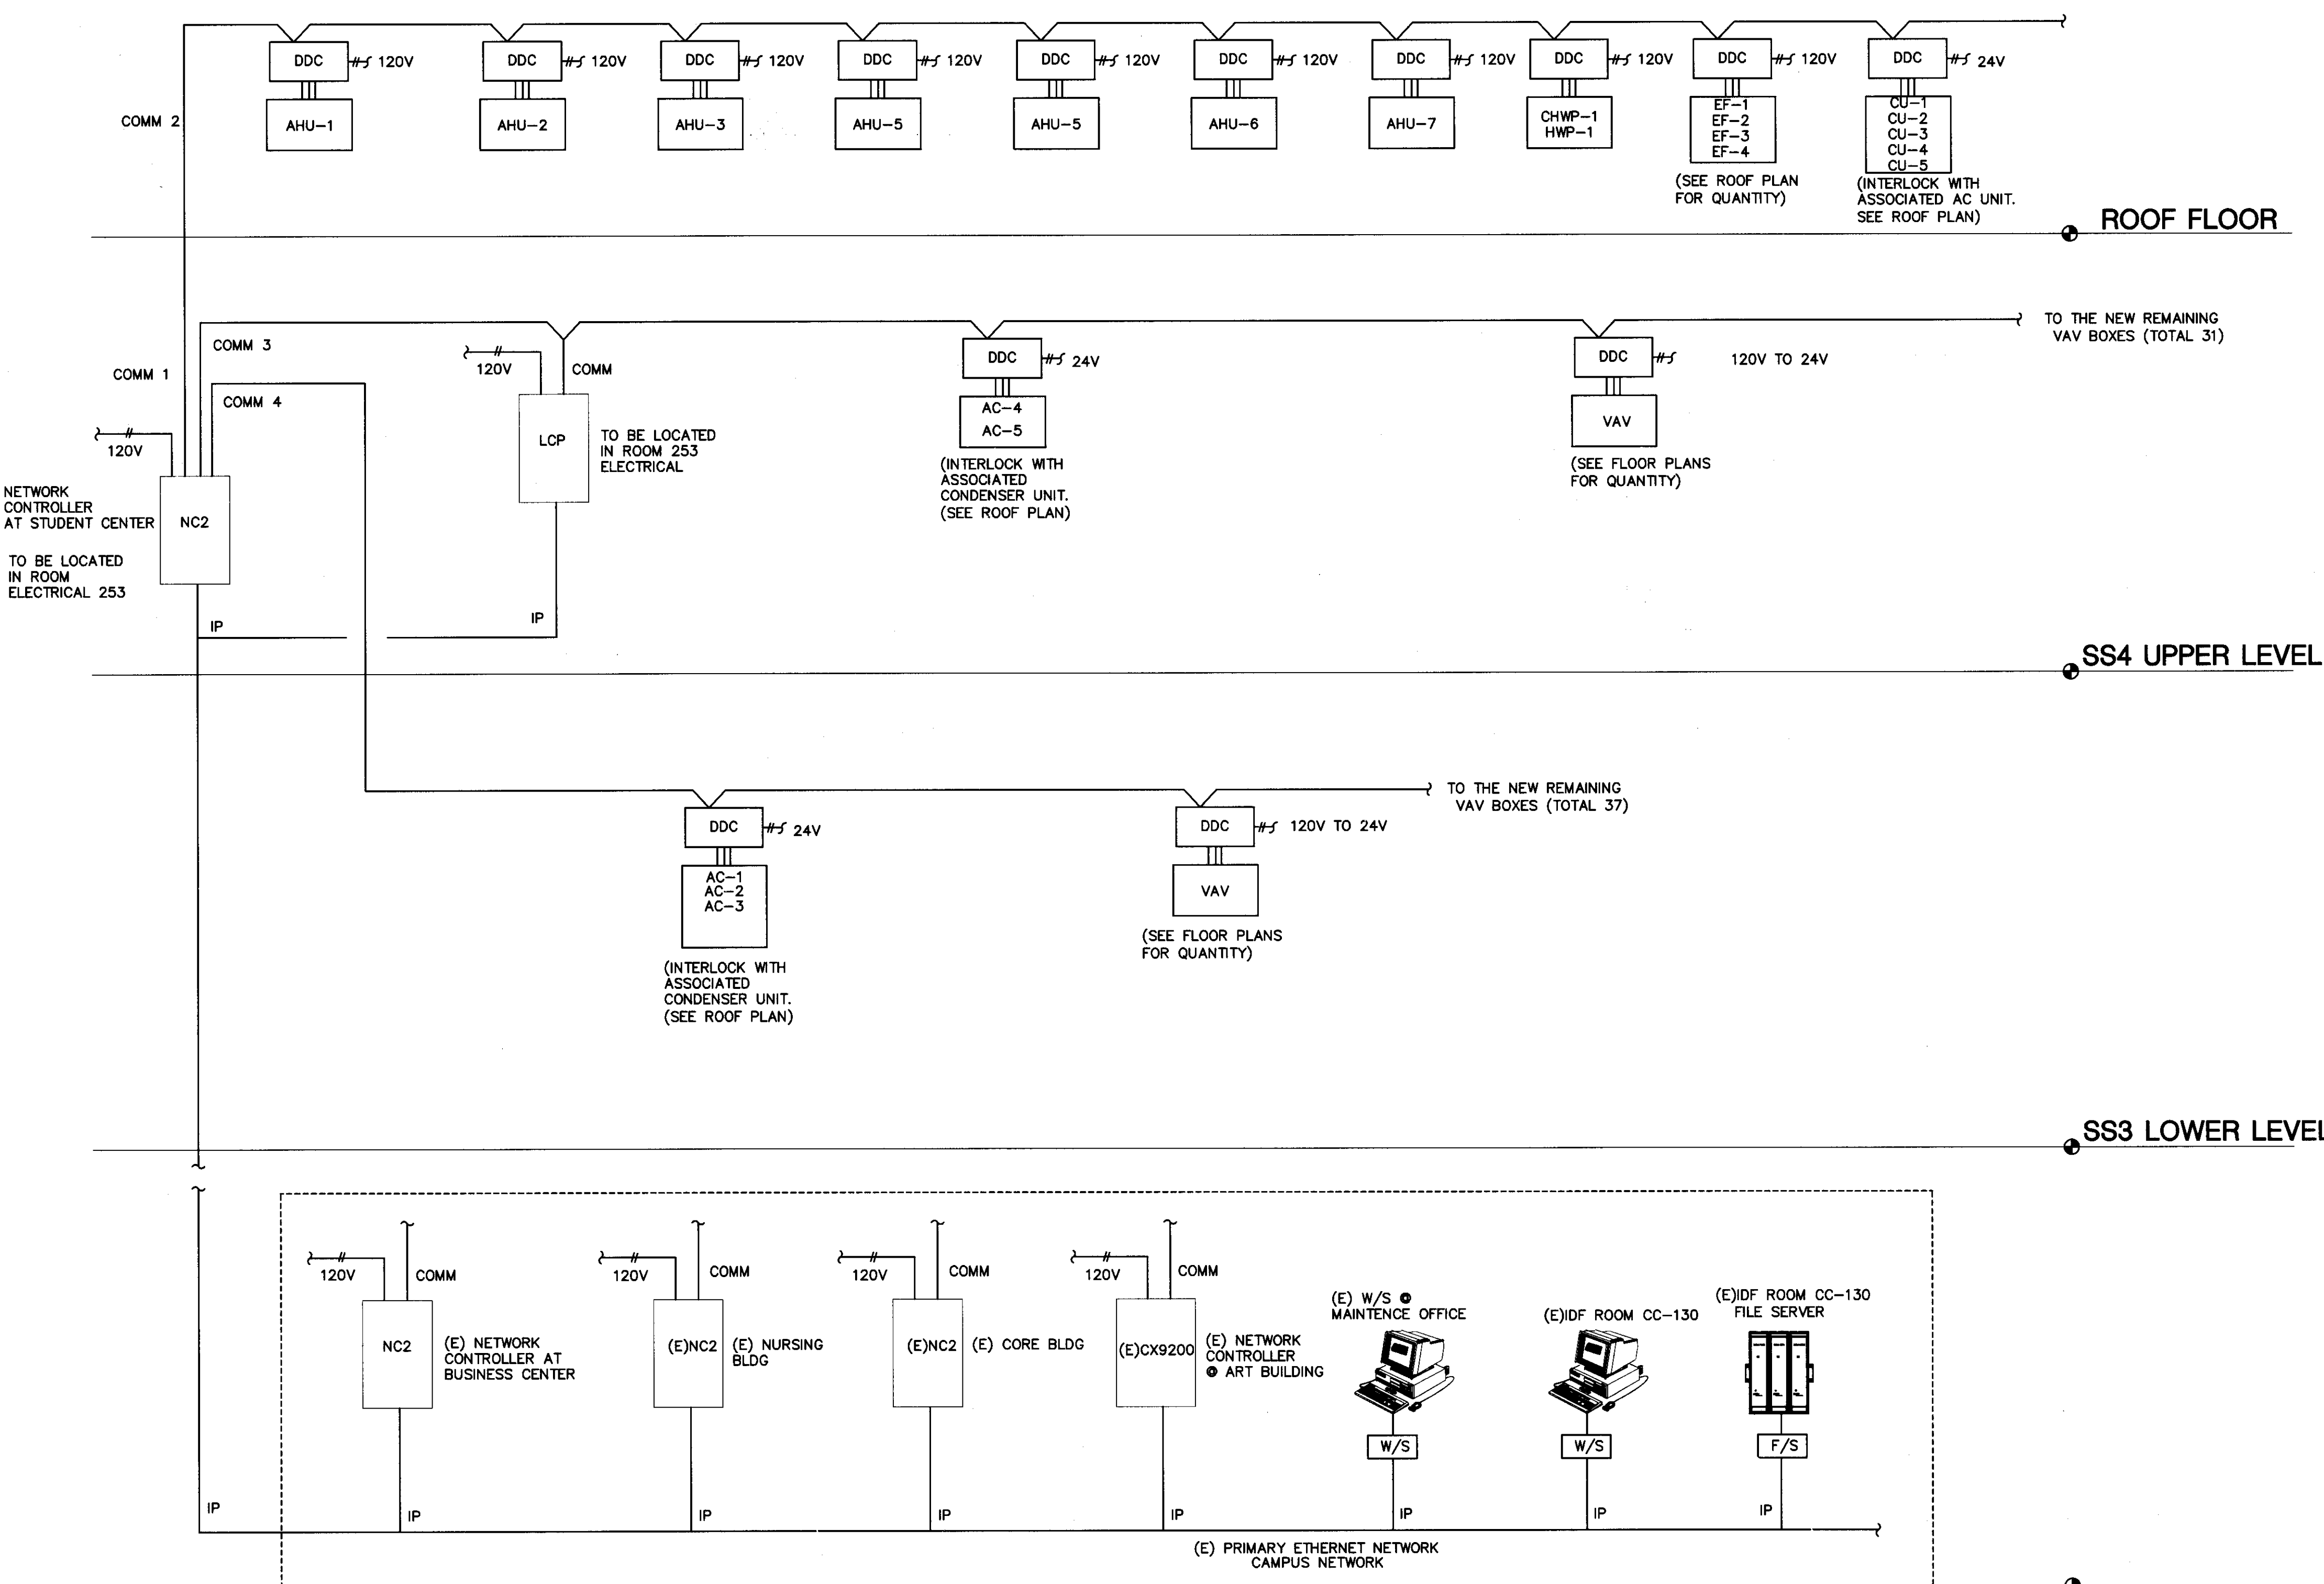

**CONTROL SHEET NOTES**

- DURING DEMO:**
- REMOVE EXISTING ANDOVER SXC 920 AND RETURN TO COLLEGE DISTRICT PERSONNEL FOR SALVAGING.
  - CAP OFF INFINET TO MAINTAIN NETWORK INTEGRITY
- DURING INSTALL:**
- RUN INFINET TO NEW VAV CONTROLLERS FROM NEW NC2 NETWORK CONTROLLER.
  - KEEP CONTROL NETWORK UP AT ALL TIMES.

- SMOKE DETECTOR SUPPLIED BY DIVISION 18
- SMOKE DETECTOR INSTALLED BY DIVISION 15
- SMOKE DETECTOR POWERED BY DIVISION 16
- SMOKE DETECTOR CONTACTS TO BE HARD WIRED THROUGH BOTH SA & RA DRIVES BY CONTROL CONTRACTOR

EBTRON AIR FLOW MONITORING STATIONS (AFMS) ARE FACTORY SUPPLIED AND INSTALLED AT MIN. OSA. RETURN AIR, SUPPLY AIR LOCATIONS. TO BE WIRED BY CONTROL CONTRACTOR

EACH FAN ARRAY SUPPLY/ RETURN FAN TO HAVE IT'S OWN VFD.



**CONTROL DIAGRAM SYMBOLS LIST**

ABBREVIATIONS	SYMBOLS
AFMS	AIR FLOW MEASURING STATION
AI	ANALOG INPUT
AO	ANALOG OUTPUT
BMS	BUILDING MANAGEMENT SYSTEM
CO2	CARBON DIOXIDE
CT	ELECTRIC CURRENT TRANSMITTER
DDC	DIRECT DIGITAL CONTROL
DI	DIGITAL INPUT
DO	DIGITAL OUTPUT
DP	PRESSURE SENSOR
EA	EXHAUST AIR
EF	EXHAUST FAN
HS	HIGH STATIC
HWR	HEATING HOT WATER RETURN
HWS	HOT WATER SUPPLY
M	MOTORIZED
MAU	MAKE UP AIR UNIT
M/S	STARTER
MD	MOTORIZED DAMPER
OA	OUTSIDE AIR
P	PRESSURE SENSOR
PPM	PART PER MILLION
RA	RETURN AIR
RF	FAN
SA	SUPPLY AIR
SF	SUPPLY FAN OR SQUARE FOOT
SD	SMOKE DETECTOR
T	TEMPERATURE SENSOR
TPI	THIRD PARTY INTERFACE
VFD	VARIABLE FREQUENCY DRIVE
XFMR	120V TO 24V TRANSFORMER

- NOTES:**
- PROVIDE THIRD PARTY INTERFACES, WHERE NOT PROVIDED BY MFR.
  - ALL CONTROL WIRING TO BE FURNISHED AND INSTALLED PER DIV. 15 & 16 SPECIFICATIONS. PLENUM RATED CABLE ABOVE REMOVABLE TILE CEILING, RACEWAY ABOVE HARD LID CEILINGS.
  - PROVIDE 24V POWER TO ALL CONTROL DEVICES. PROVIDE 120V POWER TO 24V TRANSFORMER FOR LOW VOLTAGE CONTROL POWER.
  - DIVISION 16 TO PROVIDE 120V POWER FOR ALL AIRFLOW MEASURING STATIONS AND BUILDING MANAGEMENT CONTROL SYSTEM INCLUDING ALL PANELS. FOLLOW DIV. 16 SPECIFICATIONS FOR PRODUCT AND INSTALLATION RELATED TO 120V POWER DISTRIBUTION. COORDINATE CIRCUITS DESIRED WITH ELECTRICAL.
  - PROVIDE DEVICES/PROGRAMMING OF BMS SYSTEM FOR OWNER OVERRIDE OF CONTROLLED SYSTEM.
  - MISCELLANEOUS POINTS: INTEGRATE BUILDING LIGHTING CONTROLS (SEE ELECTRICAL).
  - COLLEGE TO PROVIDE ALL TELECOMMUNICATIONS INFRASTRUCTURE REQUIRED FOR PROPER OPERATION OF SYSTEM AND COMMUNICATION TO DISTRICT CENTRAL AUTOMATION SYSTEMS. STATIC IP BMS NETWORK CONNECTION FOR NEW NETWORK CONTROLLER IN ELECTRICAL ROOM 253.
  - CONTROL DIAGRAMS, SEQUENCES, AND SPECIFICATIONS ARE PERFORMANCE BASED. PROVIDE FINAL SEQUENCES, POINTS LIST, TRENDRING LIST, AND ARCHITECTURAL RISER DIAGRAMS (SEE SPECIFICATIONS).

CONTROLS CONTRACTOR TO COORDINATE SEQUENCES AND POINTS WITH SELECTED EQUIPMENT AT BID TIME.

**1 DDC CONTROL ARCHITECTURE**  
 NO SCALE CAMPUS NETWORK (ANDOVER INFINET FAMILY)

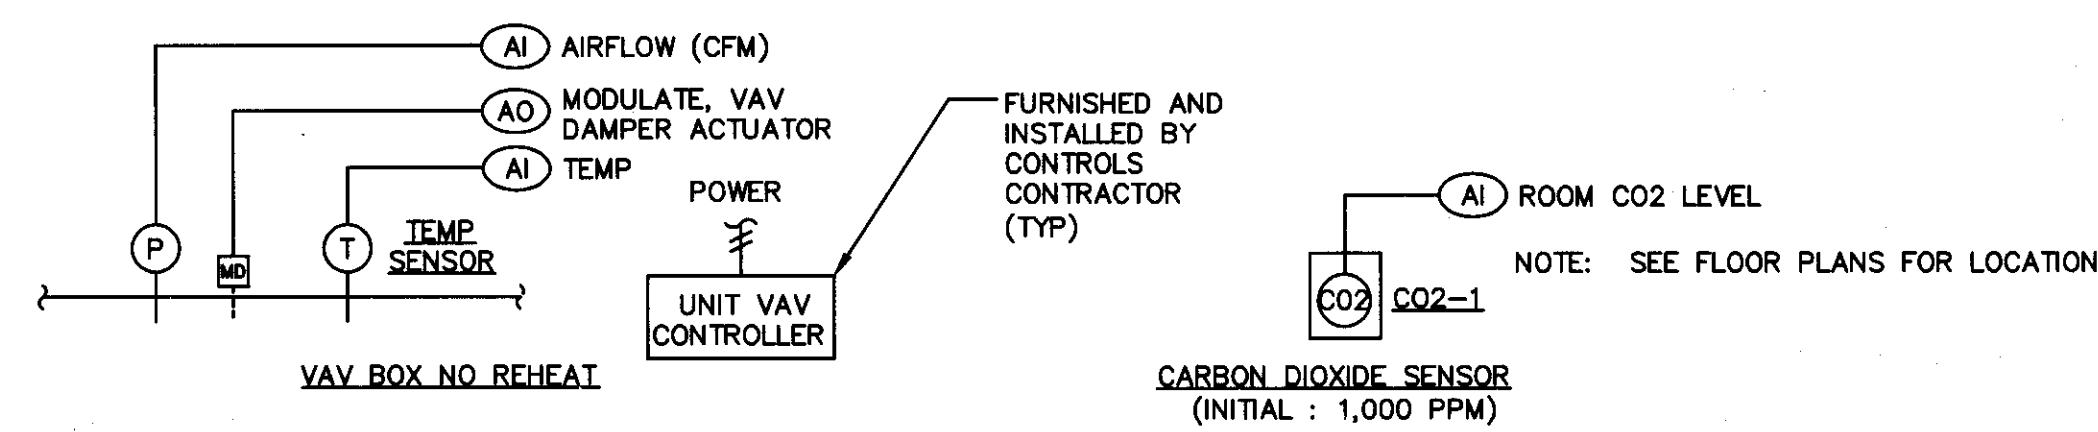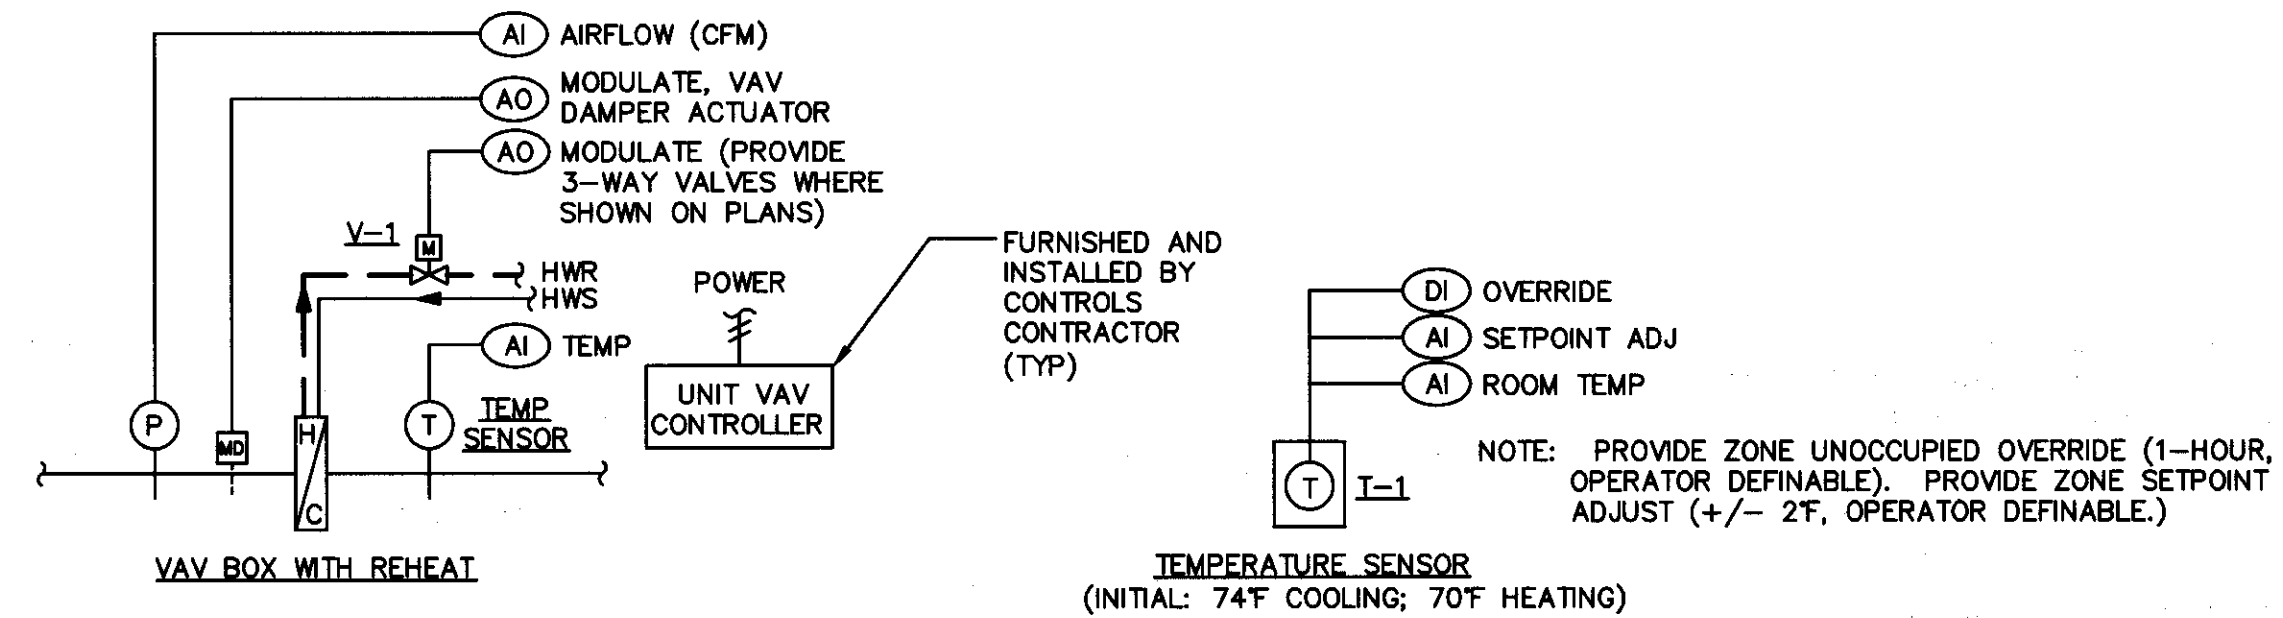

**1 VAV BOX CONTROL DIAGRAM**  
NO SCALE

**SEQUENCE OF OPERATION:**

**RUN CONDITIONS:**  
THE TERMINAL UNIT CONTROLLER SHALL TAKE AN INPUT FROM THE ROOM TEMPERATURE SENSOR TO MODULATE THE VAV DAMPER ACTUATOR TO MAINTAIN THE SPACE ROOM TEMPERATURE. PROVIDE ROOM TEMPERATURE SENSOR AT LOCATIONS AS INDICATED ON THE MECHANICAL FLOOR PLAN. FOR ZONES WITH MULTIPLE ROOM TEMPERATURE SENSORS, ONE SENSOR WILL BE THE MASTER ZONE SENSOR (OPERATOR DEFINABLE) FOR CONTROLLING THE VAV TERMINAL UNIT. AN ALARM WILL BE SENT IF THE ROOM TEMPERATURE AT ONE OF THE SECONDARY ROOM TEMPERATURE SENSORS IS FOUR (4) DEGREES (OPERATOR DEFINABLE) ABOVE OR BELOW THE MASTER ZONE SETPOINT.

**OCCUPIED COOLING:**  
ONCE THE ZONE TEMPERATURE INCREASES ABOVE THE COOLING SETPOINT BY TWO (2) DEGREES (OPERATOR DEFINABLE) THE TERMINAL UNIT WILL GO INTO COOLING MODE. PRIMARY CFM SETPOINT WILL CHANGE TO THE MINIMUM FLOW INDICATED IN THE VAV TERMINAL UNIT SCHEDULE. IF SPACE TEMPERATURE DOES NOT MEET SETPOINT, INCREMENTALLY MODULATE AIRFLOW UPWARDS UNTIL TERMINAL UNIT REACHES MAXIMUM FLOW. A TWO (2) DEGREE BELOW SETPOINT DEADBAND WILL BE UTILIZED TO MINIMIZE CYCLING (OPERATOR DEFINABLE).

**OCCUPIED HEATING:**  
ONCE THE ZONE TEMPERATURE DROPS BELOW THE HEATING SETPOINT BY TWO (2) DEGREES (OPERATOR DEFINABLE) THE TERMINAL UNIT WILL GO INTO THE HEATING MODE. PRIMARY CFM SETPOINT WILL CHANGE TO THE HEATING HOT WATER VALVE (V-1) WILL MODULATE TO MAINTAIN SPACE SETPOINT TEMPERATURE (OPERATOR DEFINABLE). IF SPACE TEMPERATURE DOES NOT MEET SETPOINT AND/OR IF DISCHARGE TEMPERATURE IS ABOVE 100° F, INCREMENTALLY MODULATE AIRFLOW UPWARDS UNTIL TERMINAL UNIT REACHES MAXIMUM FLOW. A TWO (2) DEGREE ABOVE SETPOINT DEADBAND WILL BE UTILIZED TO MINIMIZE CYCLING (OPERATOR DEFINABLE).

**MORNING WARM-UP:**  
DURING MORNING-WARM-UP, OPEN ALL VALVES (V-1) AND SET VAV TERMINAL UNIT TO MAXIMUM HEATING SETPOINT. IF AIR SYSTEM UNIT SERVING TERMINAL UNIT IS STILL IN HEATING AND ZONE HAS MET MORNING WARM-UP SET-POINT (70° F, OPERATOR DEFINABLE), MODULATE TERMINAL UNIT AIRFLOW TO MAINTAIN SETPOINT. UPON COMPLETION OF AIR SYSTEM MORNING WARM-UP SEQUENCE, RETURN TO OCCUPIED MODE.

**DEMAND BASED VENTILATION:**  
IN ROOMS WITH CO2 SENSORS (CO2-1), SEE FLOOR PLANS FOR LOCATION, WHEN THE COOLING SETPOINT IS MET, THE CO2 SENSOR SHALL ALLOW THE TERMINAL UNIT TO REDUCE ITS AIRFLOW DOWN TO MINIMUM FLOW INDICATED IN THE VAV TERMINAL UNIT SCHEDULE. DOCUMENT THIS MINIMUM FLOW DURING BALANCING. CO2 LEVELS ARE TO BE MAINTAINED AT ALL TIMES. UPON SPIKE IN CO2 LEVELS, (INCREASE OVER SETPOINT BY MORE THAN 100 PPM WITHIN A ONE MINUTE INTERVAL, OPERATOR DEFINABLE), ALLOW ADEQUATE TIME FOR CO2 LEVELS TO STABILIZE PRIOR TO INCREASING PRIMARY AIRFLOW (THREE MINUTES, OPERATOR DEFINABLE). INCREMENTALLY MODULATE AIR FLOW UPWARDS UNTIL TERMINAL UNIT REACHES MAXIMUM FLOW AS INDICATED IN THE VAV TERMINAL UNIT SCHEDULE. USE PROPORTIONAL ONLY CONTROLS FOR DEMAND BASE CONTROL.


**TRENDING:**  
AS A MINIMUM TREND THE FOLLOWING POINTS: SPACE TEMPERATURE, SPACE CO2, SUPPLY TEMPERATURE, AIRFLOW SUPPLY.

**LOAD SHEDDING:**  
UPON BAS INPUT FOR LOAD SHEDDING, RESET ROOM TEMPERATURE SETPOINTS UPWARDS TWO (2) DEGREES F (OPERATOR DEFINABLE - COOLING) OR DOWNWARDS TWO (2) DEGREES F (OPERATOR DEFINABLE - HEATING).

**DUCT STATIC RE-SET:**  
MONITOR VAV TERMINAL UNIT AIRFLOW AND DAMPER ACTUATOR POSITION FOR USE IN AIR SYSTEM DUCT STATIC RESET STRATEGIES.

**UNOCCUPIED MODE T-1:** SET TO TITLE 24 SET-BACK TEMPERATURE; V-1 CLOSED, DAMPER CLOSED.

**ALARMS:** SEND AN ALARM IF VALVE (V-1) IS COMMANDED OPEN/CLOSE BUT DISCHARGE TEMPERATURE DOES NOT INDICATE CHANGE IN TEMPERATURE. SEND AN ALARM FOR HIGH DISCHARGE TEMPERATURE (GREATER THAN 105° F, OPERATOR DEFINABLE). SEND AN ALARM FOR LOW DISCHARGE AIR TEMPERATURE (LESS THAN 50° F, OPERATOR DEFINABLE).

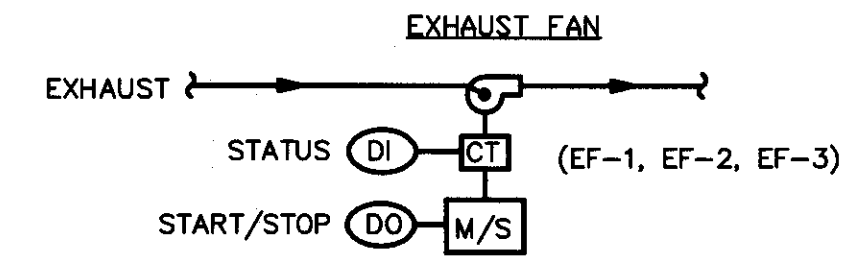

**SEQUENCE OF OPERATION:**

EXHAUST FAN - ON/OFF

**RUN CONDITIONS - SCHEDULED:**  
THE FAN SHALL RUN ACCORDING TO A USER DEFINABLE SCHEDULE.


**FAN:**  
THE FAN SHALL HAVE AN OPERATOR DEFINABLE MINIMUM RUNTIME.

**FAN STATUS:**  
THE CONTROLLER SHALL MONITOR THE FAN STATUS.

ALARMS SHALL BE PROVIDED AS FOLLOWS:

- FAN FAILURE: COMMANDED ON, BUT THE STATUS IS OFF.
- FAN IN HAND: COMMANDED OFF, BUT THE STATUS IS ON.
- FAN RUNTIME EXCEEDED: FAN STATUS RUNTIME EXCEEDS A USER DEFINABLE LIMIT (OPERATOR DEFINABLE).

**3 GENERAL EXHAUST FAN CONTROL DIAGRAM**  
NO SCALE

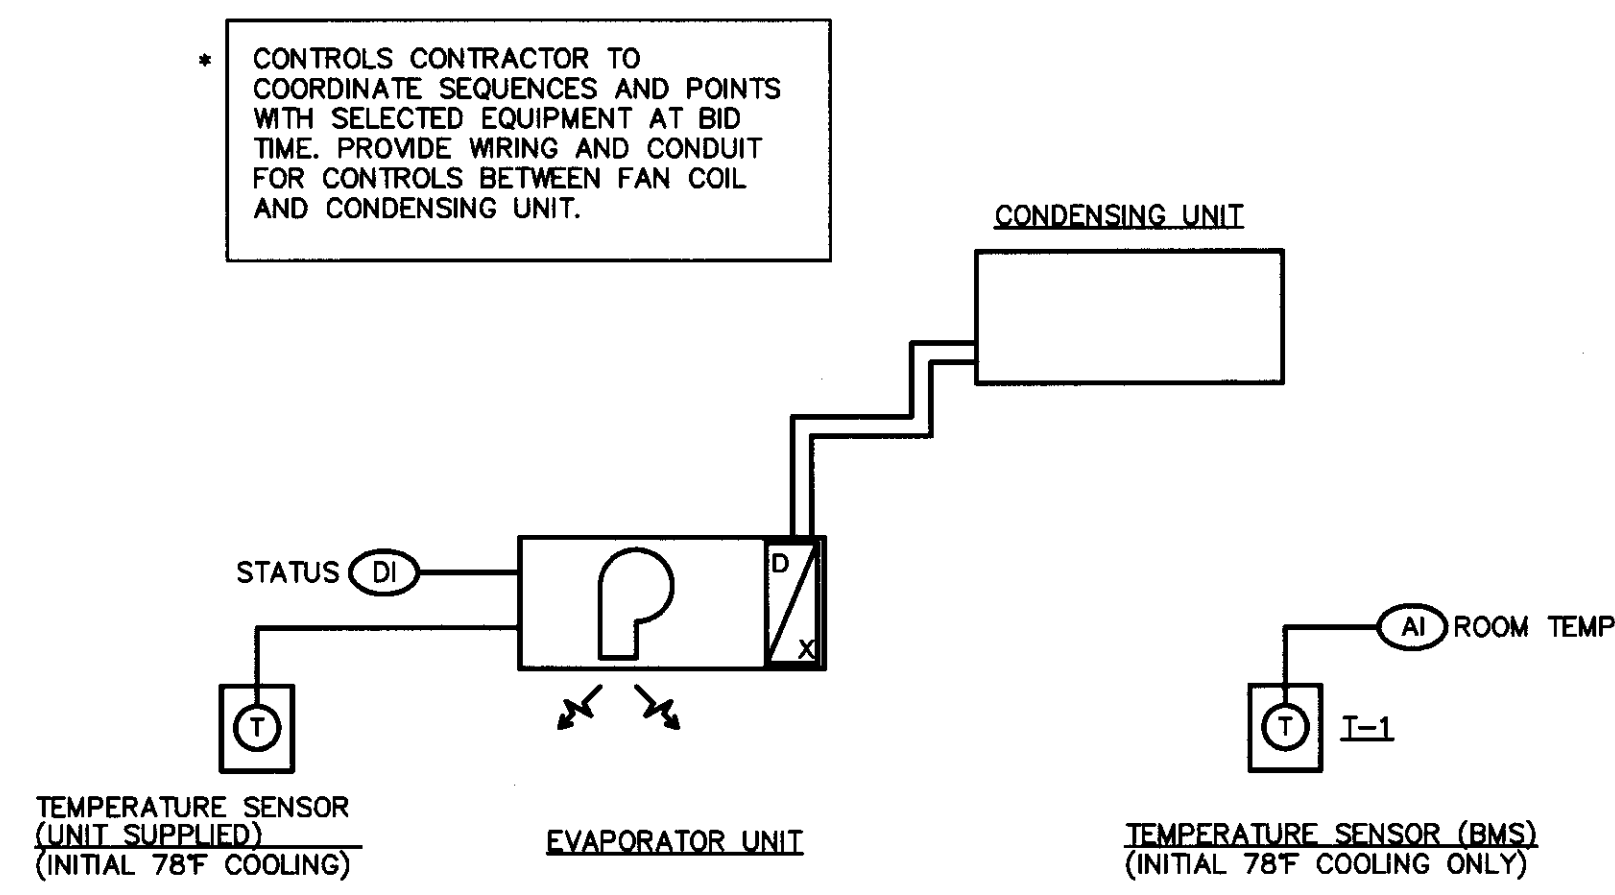

**2 SPLIT SYSTEM CONTROL DIAGRAM**  
NO SCALE

RFI 233 - CONFIRM 2/M-6.2 SHOULD BE FOLLOW

**SEQUENCE OF OPERATION:**

**SPLIT SYSTEM:** (AC-1, CU-1, AC-2, CU-2, AC-3, CU-3, AC-4, CU-4, AC-5, CU-5)

**RUN CONDITIONS - SCHEDULED:** THE UNIT SHALL RUN ACCORDING TO A USER DEFINABLE TIME SCHEDULE IN THE FOLLOWING MODES:  
**OCCUPIED MODE:** THE UNIT SHALL MAINTAIN A 78 DEGREES F (OPERATOR DEFINABLE) COOLING SETPOINT.

ALARMS SHALL BE PROVIDED AS FOLLOWS:

- HIGH ZONE TEMP: IF THE ZONE TEMPERATURE FROM THE BMS TEMP. SENSOR IS GREATER THAN THE COOLING SETPOINT BY A USER DEFINABLE AMOUNT (ADJ.).
- LOW ZONE TEMP: IF THE ZONE TEMPERATURE FROM THE BMS TEMP. SENSOR IS LESS THAN THE HEATING SETPOINT BY A USER DEFINABLE AMOUNT (ADJ.).

**FAN:**  
THE FAN SHALL RUN THROUGH THE UNIT CONTROLLER ANYTIME THE UNIT IS COMMANDED TO RUN, UNLESS SHUTDOWN ON SAFETIES.

**COOLING - 1 COMPRESSOR STAGE:**  
THE UNIT CONTROLLER SHALL MEASURE THE ZONE TEMPERATURE AND CYCLE THE COMPRESSOR TO MAINTAIN ITS SETPOINT THROUGH ITS OWN CONTROLLER. TO PREVENT SHORT CYCLING, THE STAGE SHALL HAVE AN OPERATOR DEFINABLE MINIMUM RUNTIME. THE COMPRESSOR SHALL RUN SUBJECT TO ITS OWN INTERNAL SAFETIES AND CONTROLS.


THE COOLING SHALL BE ENABLED WHENEVER:

- THE ZONE TEMPERATURE IS ABOVE THE COOLING SETPOINT.
- AND THE FAN IS ON.

**FAN STATUS:**  
THE BMS CONTROLLER SHALL MONITOR THE FAN (OR EVAPORATOR) STATUS.

ALARMS SHALL BE PROVIDED AS FOLLOWS:

- FAN FAILURE: COMMANDED ON (BASED ON BMS TEMP. SETPOINT), BUT THE STATUS IS OFF.
- FAN IN HAND: COMMANDED OFF (BASED ON BMS TEMP. SETPOINT), BUT THE STATUS IS ON.

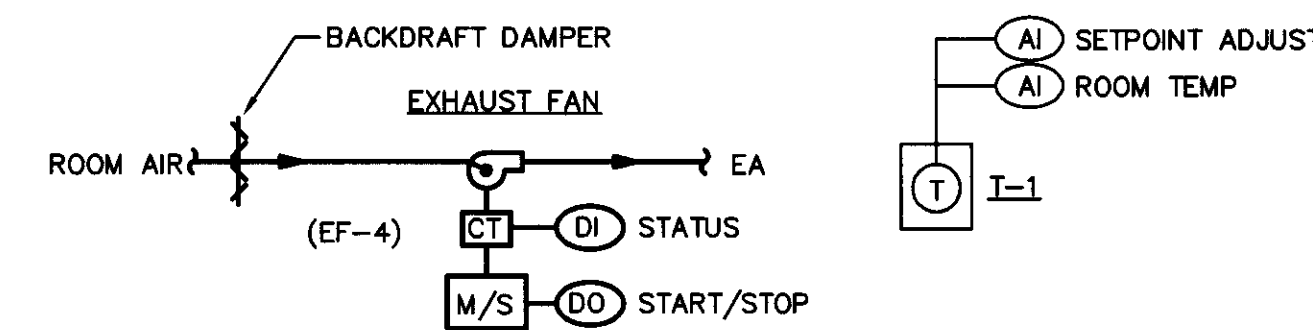

**SEQUENCE OF OPERATION:**

**RUN CONDITIONS - CONTINUOUS:**  
THE UNIT SHALL BE CONTINUOUSLY ENABLED TO MAINTAIN A ZONE TEMPERATURE COOLING SETPOINT OF 78° F (ADJ.) WITH A 2° F DEADBAND (ADJ.).

ALARMS SHALL BE PROVIDED AS FOLLOWS:

- HIGH ZONE TEMP: IF THE ZONE TEMPERATURE IS GREATER THAN THE COOLING SETPOINT BY A USER DEFINABLE AMOUNT (ADJ.).

**FAN:**  
THE FAN SHALL RUN ANYTIME THE ZONE TEMPERATURE RISES ABOVE COOLING SETPOINT BY 2° F (ADJ.) OR MORE, UNLESS SHUTDOWN ON SAFETIES.

**FAN STATUS:**  
THE CONTROLLER SHALL MONITOR THE FAN STATUS.

ALARMS SHALL BE PROVIDED AS FOLLOWS:

- FAN FAILURE: COMMANDED ON, BUT THE STATUS IS OFF.
- FAN IN HAND: COMMANDED OFF, BUT THE STATUS IS ON.
- FAN RUNTIME EXCEEDED: FAN STATUS RUNTIME EXCEEDS A USER DEFINABLE LIMIT (ADJ.).

**4 EXHAUST FAN COOLING**  
NO SCALE

**tBP** architecture planning interiors management  
1887 Architecture  
1000 Burnett Avenue Suite 140  
Concord, CA 94520  
ph: 925.246.6419 fx: 925.246.6495

**INTERFACE** ENGINEERING  
PROJECT: 2008-0108  
CONTRACT: Shawn Wilson  
717 Market Street  
San Francisco, CA 94102  
TEL: 415.488.7240  
FAX: 415.488.7241  
www.interfaceengineering.com


**FILE #/CI**  
DATE: JUL 31 2012  
APPL 01-11227  
name address city, state, zip ph agency

**L-612 STUDENT SERVICES CENTER REMODEL COLLEGE COMPLEX**  
**BID DOCUMENTS**  
LOS MEDANOS COLLEGE  
2700 EAST LELAND DRIVE  
PITTSBURG, CA 94565

tBP project number: 200810.00  
file name: 0106M62.dwg  
drawn by: GE checked by: BC  
date: JULY 31, 2012  
Rev. date: description:  
drawing title: MECHANICAL CONTROL DIAGRAM  
drawing no: M-6.2 drawing of

**NOTE:**

- 1 QTY. OF FANS DIFFERS PER AIR HANDLER (AHU). SEE AHU SCHEDULES FOR NUMBER OF FANS. POINTS SHOWN ARE PER FAN.
- RFI 184 - CONFIRM 3-WAY VALVES FOR CHW AND HHW COIL PIPES AS SHOWN ON DETAIL 1-M-5.1

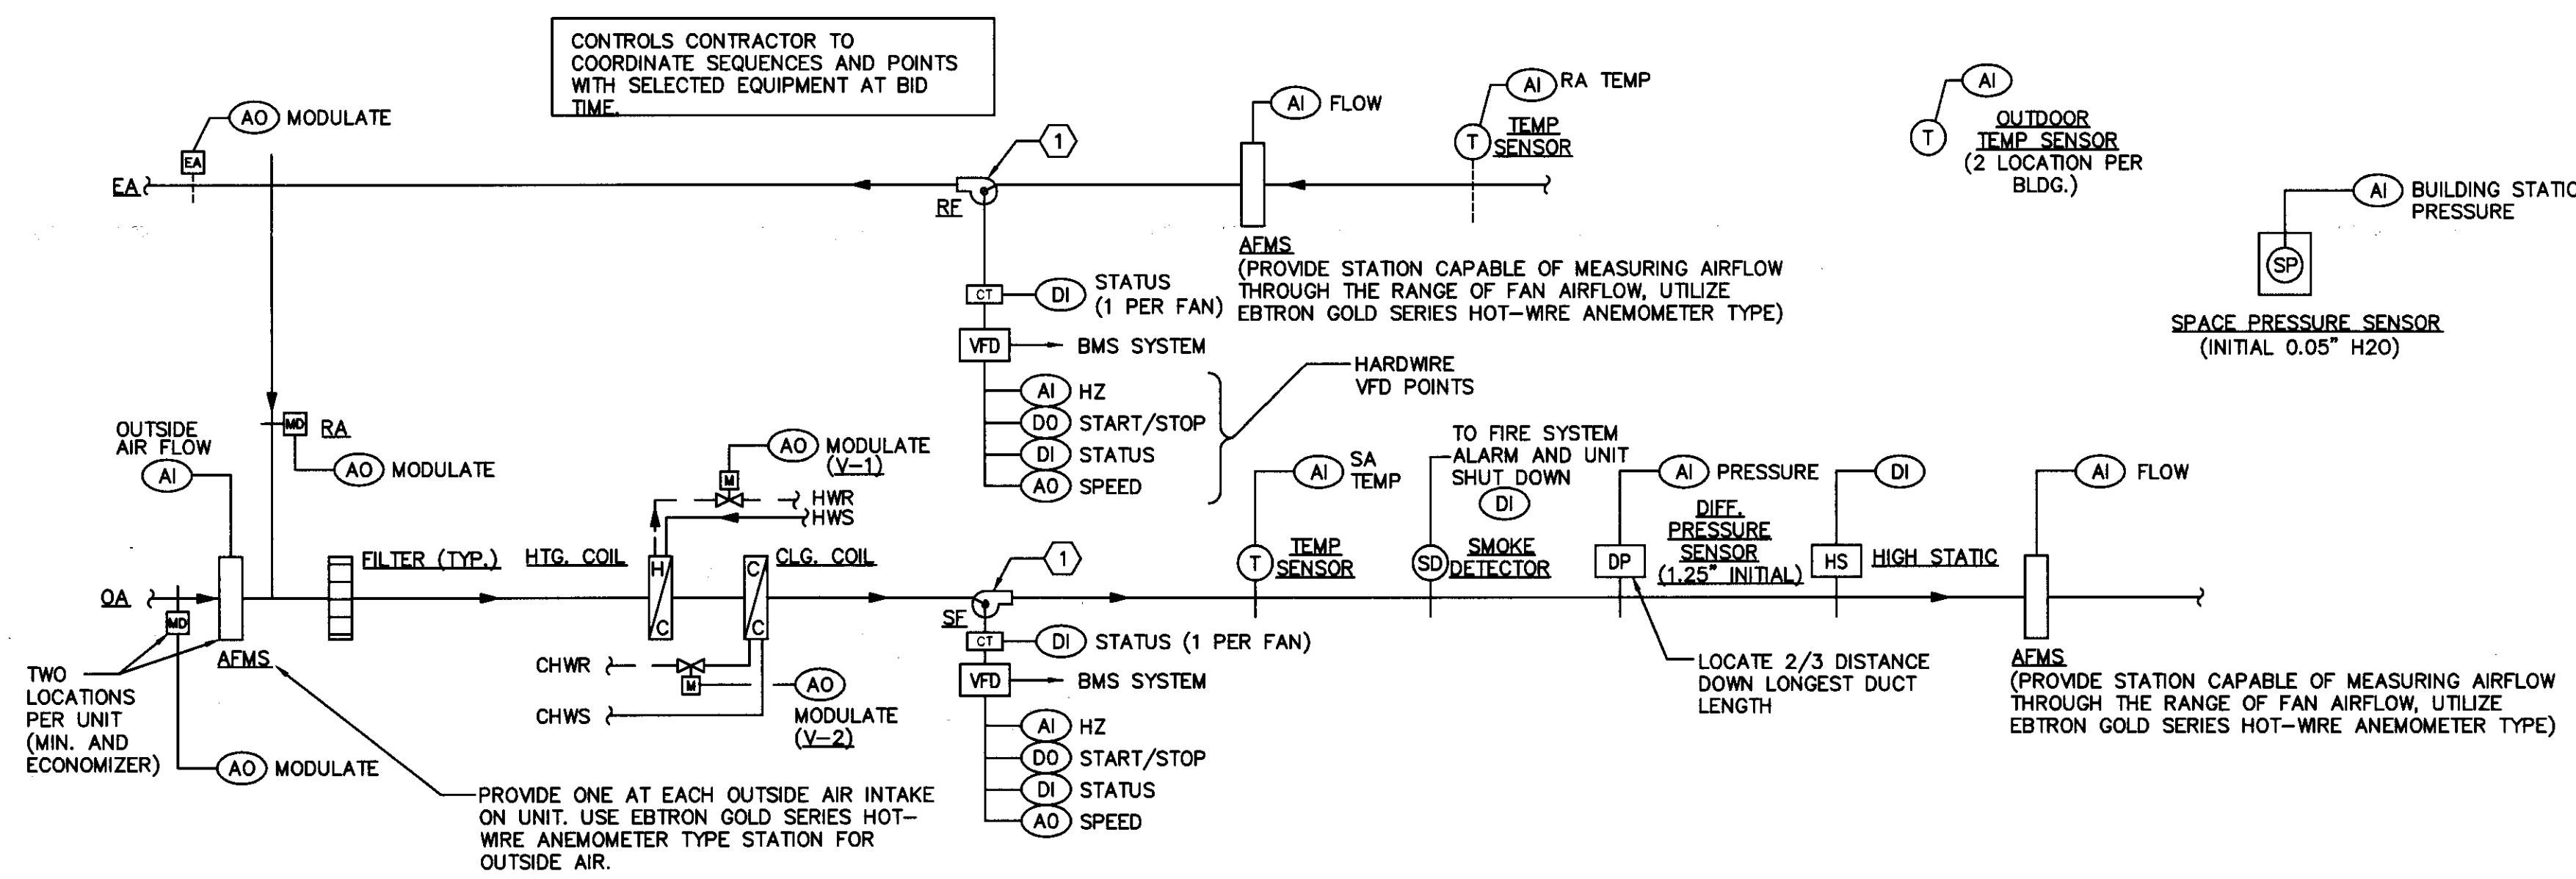

**VARIABLE AIR VOLUME - AHU**

**RUN CONDITIONS - SCHEDULED:**

THE UNIT SHALL RUN BASED UPON AN OPERATOR ADJUSTABLE SCHEDULE.

**HIGH STATIC SHUTDOWN:**

THE UNIT SHALL SHUT DOWN AND GENERATE AN ALARM UPON RECEIVING A HIGH STATIC SHUTDOWN SIGNAL.

**SUPPLY AIR SMOKE DETECTION:**

THE UNIT SHALL SHUT DOWN AND GENERATE AN ALARM UPON RECEIVING A SUPPLY AIR SMOKE DETECTOR STATUS.

**UNIT OPTIMAL START:**

THE UNIT SHALL START PRIOR TO SCHEDULED OCCUPANCY BASED ON THE TIME NECESSARY FOR THE ZONES TO REACH THEIR OCCUPIED SETPOINTS. THE START TIME SHALL AUTOMATICALLY ADJUST BASED ON CHANGES IN OUTSIDE AIR TEMPERATURE AND ZONE TEMPERATURES.

SCHEDULE TITLE 24 PRE-OCCUPANCY PURGE AND VENTILATION FOR 1-HOUR PRIOR TO MORNING WARM-UP OR COOL-DOWN.

UPON COMPLETION OF TITLE 24 PRE-OCCUPANCY PURGE AND VENTILATION, CLOSE OA DAMPERS (100%), OPEN RA DAMPER (100%), AND CLOSE EXHAUST DAMPER (100%), THEN START MORNING WARM-UP/COOL-DOWN. PROVIDE ECONOMIZER CONTROL FOR MORNING COOL-DOWN PER ECONOMIZER SEQUENCE. PROVIDE MORNING WARM-UP HEATING PER HEATING COIL SEQUENCE.

**DEMAND LIMITING - SETPOINT ADJUST:**

- THE SUPPLY AIR TEMPERATURE SETPOINT SHALL RELAX BY 2F (OPERATOR DEFINABLE) FOR EACH DEMAND THRESHOLD EXCEEDED.
- THE SETPOINTS IN THE ZONES SUPPLIED BY THIS UNIT SHALL BE RELAXED AS SPECIFIED IN THE SEQUENCE OF OPERATIONS FOR THE ZONES. THIS SHALL IN TURN RELAX THE UNIT'S SUPPLY AIR TEMPERATURE SETPOINT BY A USER DEFINABLE AMOUNT.

ALL SETPOINTS SHALL AUTOMATICALLY RETURN TO THEIR PREVIOUS SETTINGS WHEN THE FACILITY POWER CONSUMPTION DROPS BELOW THE THRESHOLDS.

**SUPPLY FAN(S):**

THE SUPPLY FAN SHALL RUN ANYTIME THE UNIT IS COMMANDED TO RUN, UNLESS SHUTDOWN ON SAFETIES. TO PREVENT SHORT CYCLING, THE SUPPLY FAN SHALL HAVE AN OPERATOR DEFINABLE MINIMUM RUNTIME. IF ANY INDIVIDUAL AIR HANDLER FAN FAILS AS DETECTED BY A RESPECTIVE CURRENT SENSOR AT EACH FAN WALL FAN, A FAN ALARM WILL BE GENERATED AT THE WORKSTATION ALARM BAR AND GRAPHIC.

**ALARMS SHALL BE PROVIDED AS FOLLOWS:**

- SUPPLY FAN FAILURE: COMMANDED ON, BUT THE STATUS IS OFF.

- SUPPLY FAN IN HAND: COMMANDED OFF, BUT THE STATUS IS ON.
- SUPPLY FAN RUNTIME EXCEEDED: STATUS RUNTIME EXCEEDS AN OPERATOR DEFINABLE LIMIT.

**SUPPLY AIR DUCT STATIC PRESSURE CONTROL:**

THE CONTROLLER SHALL MEASURE DUCT STATIC PRESSURE AND MODULATE THE SUPPLY FAN VFD SPEED TO MAINTAIN A DUCT STATIC PRESSURE SETPOINT. THE SPEED SHALL NOT DROP BELOW 25% (OPERATOR DEFINABLE). THE STATIC PRESSURE SETPOINT SHALL BE RESET BASED ON ZONE COOLING REQUIREMENTS.

- THE INITIAL DUCT STATIC PRESSURE SETPOINT SHALL BE 1.25IN H2O (OPERATOR DEFINABLE).
- AS AIRFLOW REQUEST INCREASES, THE SETPOINT SHALL INCREMENTALLY RESET UP TO A MAXIMUM OF 2.0IN H2O (OPERATOR DEFINABLE).
- AS AIRFLOW REQUEST DECREASES, THE SETPOINT SHALL INCREMENTALLY RESET DOWN TO A MINIMUM OF 0.5IN H2O (OPERATOR DEFINABLE).

ONE AIRFLOW REQUEST IS DEFINED AS ANY VAV BOX WITH A DAMPER POSITION GREATER THAN 90% (OPERATOR DEFINABLE) SETPOINT CHANGE EVALUATION INTERVAL SET TO 5 MINUTES (OPERATOR DEFINABLE) SETPOINT CHANGE INCREMENT SET TO 0.05" WG (OPERATOR DEFINABLE).

**ALARMS SHALL BE PROVIDED AS FOLLOWS:**

- HIGH SUPPLY AIR STATIC PRESSURE: IF THE SUPPLY AIR STATIC PRESSURE IS 25% (OPERATOR DEFINABLE) GREATER THAN SETPOINT.
- LOW SUPPLY AIR STATIC PRESSURE: IF THE SUPPLY AIR STATIC PRESSURE IS 25% (OPERATOR DEFINABLE) LESS THAN SETPOINT.
- SUPPLY FAN VFD FAULT.

**RETURN FAN(S):**

THE RETURN FAN SHALL RUN WHENEVER THE SUPPLY FAN RUNS. IF ANY INDIVIDUAL AIR HANDLER FAN FAILS AS DETECTED BY A RESPECTIVE CURRENT SENSOR AT EACH FAN WALL FAN, A FAN ALARM WILL BE GENERATED AT THE WORKSTATION ALARM BAR AND GRAPHIC.

**ALARMS SHALL BE PROVIDED AS FOLLOWS:**

- RETURN FAN FAILURE: COMMANDED ON, BUT THE STATUS IS OFF.
- RETURN FAN IN HAND: COMMANDED OFF, BUT THE STATUS IS ON.
- RETURN FAN RUNTIME EXCEEDED: STATUS RUNTIME EXCEEDS A USER DEFINABLE LIMIT (OPERATOR DEFINABLE).
- RETURN FAN VFD FAULT.

**BUILDING STATIC PRESSURE CONTROL:**

THE CONTROLLER SHALL MEASURE BUILDING STATIC PRESSURE AND MODULATE THE RETURN FAN VFD SPEED TO MAINTAIN A BUILDING STATIC PRESSURE SETPOINT OF 0.05IN H2O (OPERATOR DEFINABLE). THE RETURN FAN VFD SPEED SHALL NOT DROP BELOW 20% (OPERATOR DEFINABLE).

**ALARMS SHALL BE PROVIDED AS FOLLOWS:**

- HIGH BUILDING STATIC PRESSURE: IF THE BUILDING AIR STATIC PRESSURE IS 25% (OPERATOR DEFINABLE) GREATER THAN SETPOINT.
- LOW BUILDING STATIC PRESSURE: IF THE BUILDING AIR STATIC PRESSURE IS 25% (OPERATOR DEFINABLE) LESS THAN SETPOINT.

**HEATING COIL VALVE (PRE-HEATING):**

THE CONTROLLER SHALL MEASURE THE MIXED AIR TEMPERATURE AND MODULATE THE UNIT'S HEATING COIL VALVE (V-1) TO MAINTAIN SUPPLY AIR TEMPERATURE.

**THE HEATING SHALL BE ENABLED WHENEVER:**

- OUTSIDE AIR TEMPERATURE IS LESS THAN 60F (OPERATOR DEFINABLE).
- AND THE ECONOMIZER (IF PRESENT) IS DISABLED.
- AND THE SUPPLY FAN STATUS IS ON.

THE HEATING COIL VALVE (V-1) SHALL MODULATE TO MAINTAIN SUPPLY AIR TEMPERATURE SETPOINT 5F (OPERATOR DEFINABLE) ABOVE SUPPLY AIR TEMPERATURE SETPOINT WHENEVER:

- ALL TERMINAL UNITS ARE IN HEATING.

**FREEZE PROTECTION:**

DURING UNIT OPERATION THE HEATING COIL WILL PROVIDE FREEZE PROTECTION WHILE MAINTAINING SUPPLY AIR SETPOINT. SHOULD THE SUPPLY AIR TEMPERATURE DROP BELOW 32 DEGREES, A FREEZE ALARM SHALL BE INDICATED. THE AHU WILL SHUTDOWN, VALVES OPENED AND PUMPS TURNED ON. DURING OFF HOURS, AN OUTSIDE AIR TEMPERATURE BELOW 32 DEGREES WILL TURN PUMPS ON AND OPEN VALVES.

**SUPPLY AIR TEMPERATURE SETPOINT - OPTIMIZED:**

THE CONTROLLER SHALL MONITOR THE SUPPLY AIR TEMPERATURE AND SHALL MAINTAIN A SUPPLY AIR TEMPERATURE SETPOINT RESET BASED ON ZONE COOLING AND HEATING REQUIREMENTS.

THE SUPPLY AIR TEMPERATURE SETPOINT SHALL BE RESET FOR COOLING BASED ON ZONE COOLING REQUIREMENTS AS FOLLOWS:

- THE INITIAL SUPPLY AIR TEMPERATURE SETPOINT SHALL BE 60F (OPERATOR DEFINABLE).
- AS COOLING DEMAND INCREASES, THE SETPOINT SHALL INCREMENTALLY RESET DOWN TO A MINIMUM OF 53F (OPERATOR DEFINABLE).
- AS COOLING DEMAND DECREASES, THE SETPOINT SHALL INCREMENTALLY RESET UP TO A MAXIMUM OF 70F (OPERATOR DEFINABLE).
- DURING MORNING COOL-DOWN PROVIDE SUPPLY AIR TEMPERATURE AT 55F (OPERATOR DEFINABLE) UNTIL SPACE TEMPERATURE IN ALL ZONES REACH 74F (OPERATOR DEFINABLE).

COOLING DEMAND IS DEFINED AS ANY VAV BOX WITH AN AIR FLOW SETPOINT EQUAL TO OR GREATER THAN 90% (OPERATOR DEFINABLE) SETPOINT CHANGE EVALUATION INTERVAL SET INITIALLY TO 5 MINUTES (OPERATOR DEFINABLE) SETPOINT CHANGE INCREMENT SET TO 1.0 DEGREE (OPERATOR DEFINABLE) OPERATOR TO HAVE CAPABILITY TO REMOVE ROGUE ZONES FROM RESET CALCULATION.

**COOLING MODULATION:**

THE CONTROLLER SHALL MEASURE THE SUPPLY AIR TEMPERATURE AND MODULATE CHILLED WATER VALVE (V-2) TO MAINTAIN ITS COOLING SETPOINT.

**THE COOLING SHALL BE ENABLED WHENEVER:**

- OUTSIDE AIR TEMPERATURE IS GREATER THAN 58F (OPERATOR DEFINABLE).
- AND THE ECONOMIZER (IF PRESENT) IS NOT CAPABLE OF MEETING COOLING DEMAND BY ITSELF.
- AND THE SUPPLY FAN STATUS IS ON.
- AND THE HEATING (IF PRESENT) IS NOT ACTIVE.

MORNING COOL-DOWN SEQUENCE SHALL BE ENABLED WHENEVER:

- THE BUILDING IS IN MORNING COOL-DOWN BASED ON UNIT OPTIMAL START SEQUENCE.
- OR THE BUILDING TEMPERATURE GETS UP TO 80F (OPERATOR DEFINABLE).

**ALARMS SHALL BE PROVIDED AS FOLLOWS:**

- HIGH SUPPLY AIR TEMP: IF THE SUPPLY AIR TEMPERATURE IS 5F (OPERATOR DEFINABLE) GREATER THAN SETPOINT.
- LOW SUPPLY AIR TEMP: IF THE SUPPLY AIR TEMPERATURE IS 5F (OPERATOR DEFINABLE) LOWER THAN SETPOINT.

**HEATING COIL VALVE (MORNING WARM-UP):**

THE CONTROLLER SHALL OPEN HEATING COIL VALVE (V-1) TO ITS MAXIMUM FLOW (AS SCHEDULED) UNTIL SPACE TEMPERATURE IS 70F (OPERATOR DEFINABLE), AT WHICH TIME THE SYSTEM WILL RETURN TO OCCUPIED MODE.

**THIS HEATING SEQUENCE SHALL BE ENABLED WHENEVER:**

- THE BUILDING IS IN MORNING WARM-UP BASED ON UNIT OPTIMAL START OF SEQUENCE.
- OR BUILDING TEMPERATURES GET DOWN TO 55F (OPERATOR DEFINABLE).
- AND THE SUPPLY FAN STATUS IS ON.
- AND THE COOLING (IF PRESENT) IS NOT ACTIVE.

**ALARMS SHALL BE PROVIDED AS FOLLOWS:**

- LOW SUPPLY AIR TEMP: IF HEATING COIL VALVE (V-1) IS COMMANDED OPEN BUT THERE IS NO CHANGE IN SUPPLY AIR TEMPERATURE.

**ECONOMIZER:**

THE CONTROLLER SHALL MEASURE THE MIXED AIR TEMPERATURE AND MODULATE THE ECONOMIZER DAMPERS (OUTSIDE AIR, RETURN AIR, EXHAUST AIR) IN SEQUENCE TO MAINTAIN A SETPOINT 2F (OPERATOR DEFINABLE) LESS THAN THE SUPPLY AIR TEMPERATURE SETPOINT. THE OUTSIDE AIR DAMPERS SHALL MAINTAIN A MINIMUM ADJUSTABLE POSITION EQUAL TO UNIT SCHEDULED MINIMUM VENTILATION WHENEVER OCCUPIED.

**THE ECONOMIZER SHALL BE ENABLED WHENEVER:**

- THE OUTSIDE AIR TEMPERATURE (DRY BULB) IS LESS THAN THE RETURN AIR TEMPERATURE (DRY BULB) BY 2F (OPERATOR DEFINABLE).
- AND THE SUPPLY FAN STATUS IS ON.

**THE ECONOMIZER SHALL CLOSE WHENEVER:**

- WHEN THE OUTSIDE AIR TEMPERATURE (DRY BULB) IS HIGHER THAN 2F (OPERATOR DEFINABLE) LESS THAN RETURN AIR TEMPERATURE.
- OR ON LOSS OF SUPPLY FAN STATUS.

ALL DAMPERS SHALL CLOSE WHEN THE UNIT IS OFF. IF OPTIMAL START UP IS AVAILABLE THE MIXED AIR DAMPER SHALL OPERATE AS DESCRIBED IN THE OCCUPIED MODE EXCEPT THAT THE OUTSIDE AIR DAMPER SHALL MODULATE TO FULLY CLOSED.

**2 AHU-1 THROUGH AHU-7 CONTROL DIAGRAM (WITH VFD & BLDG STATIC)**  
NO SCALE

**SEQUENCE OF OPERATION:**

**CHILLED WATER SYSTEM RUN CONDITIONS:**

THE CHILLED WATER SYSTEM SHALL BE ENABLED TO RUN WHENEVER:

- A DEFINABLE NUMBER OF ZONES OR COOLING COILS NEED COOLING, MINIMUM ONE (OPERATOR DEFINABLE) CONTRACTOR TO MEASURE MINIMUM PUMP FLOW TO PREVENT DEAD HEAD CONDITION.
- AND OUTSIDE AIR TEMPERATURE IS HIGHER THAN 60F (OPERATOR DEFINABLE).
- AND CAMPUS CHILLER PLANT IS ENABLED.

TO PREVENT SHORT CYCLING, THE PUMPING SYSTEM SHALL RUN FOR AND BE OFF FOR MINIMUM ADJUSTABLE TIMES (BOTH OPERATOR DEFINABLE), UNLESS SHUTDOWN ON SAFETIES OR OUTSIDE AIR CONDITIONS.

**CHILLED WATER PUMP ALARMS:**

ALARMS SHALL BE PROVIDED AS FOLLOWS:

- CHILLED WATER PUMP 1
  - o FAILURE: COMMANDED ON, BUT THE STATUS IS OFF.
  - o RUNNING IN HAND: COMMANDED OFF, BUT THE STATUS IS ON.
  - o RUNTIME EXCEEDED: STATUS RUNTIME EXCEEDS A USER DEFINABLE LIMIT.
  - o VFD FAULT.

**CHILLED WATER DIFFERENTIAL PRESSURE CONTROL:**


THE CONTROLLER SHALL MEASURE CHILLED WATER DIFFERENTIAL PRESSURE AND MODULATE THE CHILLED WATER PUMP VFD TO MAINTAIN ITS CHILLED WATER DIFFERENTIAL PRESSURE SETPOINT.

THE FOLLOWING SETPOINTS ARE RECOMMENDED VALUES. ALL SETPOINTS SHALL BE FIELD ADJUSTED DURING THE COMMISSIONING PERIOD TO MEET THE REQUIREMENTS OF ACTUAL FIELD CONDITIONS.

THE CONTROLLER SHALL MODULATE CHILLED WATER PUMP SPEED TO MAINTAIN A CHILLED WATER DIFFERENTIAL PRESSURE OF 12 PSI (OPERATOR DEFINABLE). THE VFD MINIMUM SPEED SHALL NOT DROP BELOW 20% (A.U.).

**ALARMS SHALL BE PROVIDED AS FOLLOWS:**

- HIGH CHILLED WATER DIFFERENTIAL PRESSURE: IF 30% (OPERATOR DEFINABLE) GREATER THAN SETPOINT.
- LOW CHILLED WATER DIFFERENTIAL PRESSURE: IF 30% (OPERATOR DEFINABLE) LESS THAN SETPOINT.

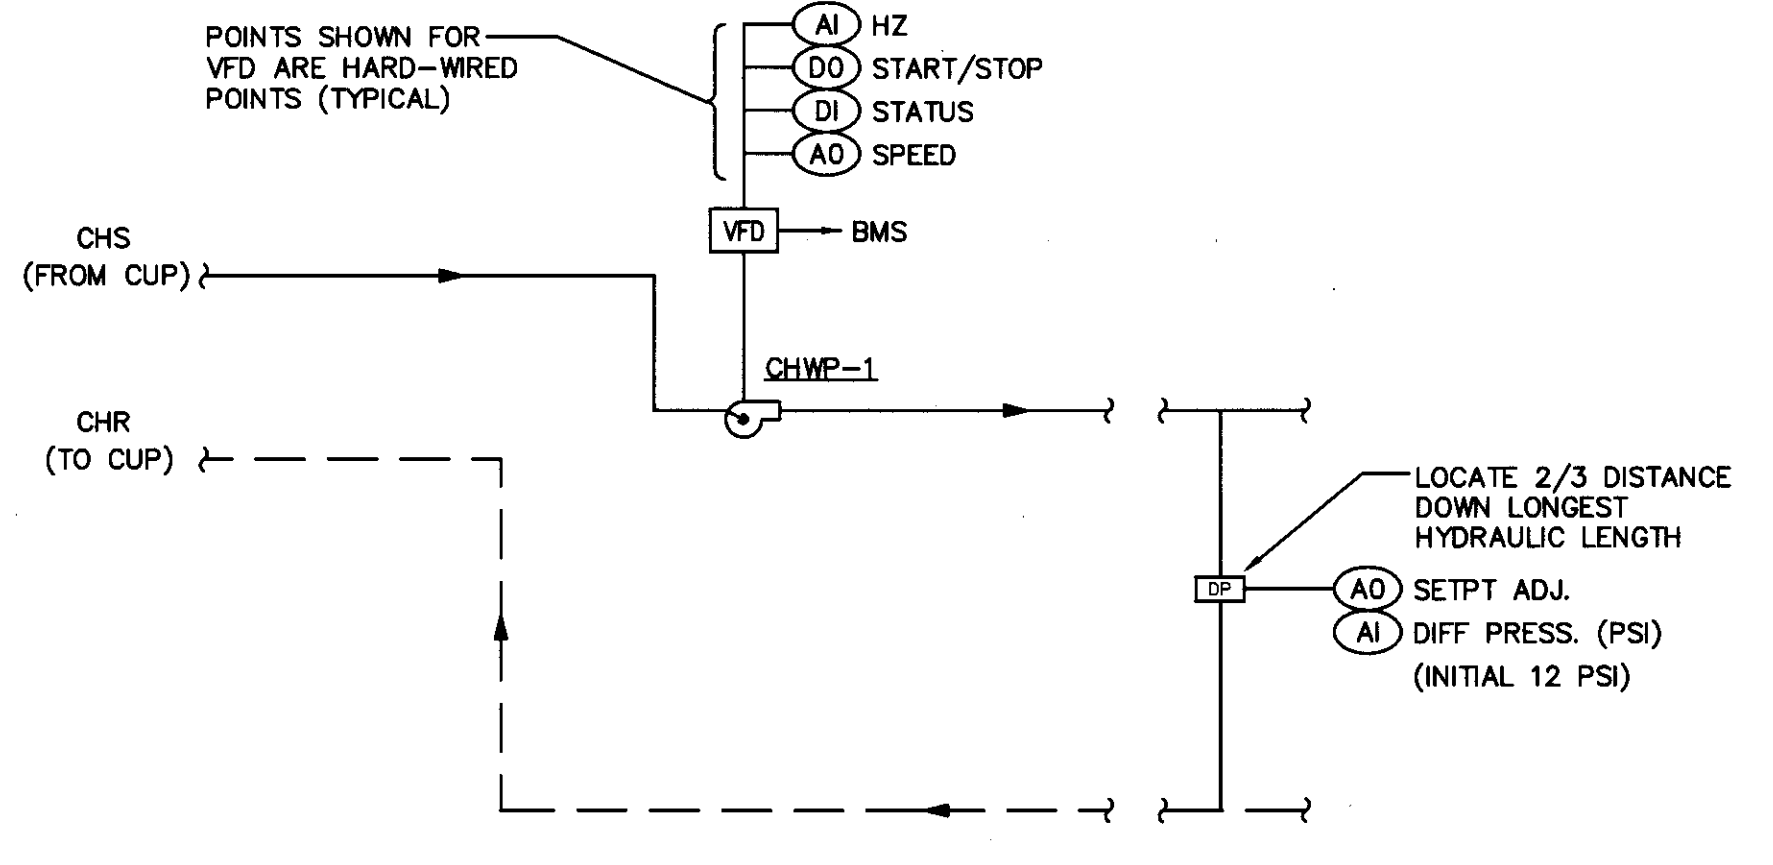

**2 CHILLED WATER PUMP CONTROL (CHWP-1)**  
NO SCALE

**SEQUENCE OF OPERATION:**

**HEATING SYSTEM RUN CONDITIONS:**

THE HEATING SYSTEM SHALL BE ENABLED TO RUN WHENEVER:

- A DEFINABLE NUMBER OF ZONES OR HOT WATER COILS NEED HEATING DURING THEIR RESPECTIVE SCHEDULED OCCUPIED RUN TIMES, MINIMUM TWO (OPERATOR DEFINABLE) CONTRACTOR TO MEASURE MINIMUM PUMP FLOW TO PREVENT DEAD HEAD CONDITION.
- AND OUTSIDE AIR TEMPERATURE IS LESS THAN 65F (OPERATOR DEFINABLE).
- AND CAMPUS CENTRAL HEATING PLAN IS ENABLED.

TO PREVENT SHORT CYCLING, THE PUMPING SYSTEM SHALL RUN FOR AND BE OFF FOR MINIMUM ADJUSTABLE TIMES (BOTH OPERATOR DEFINABLE), UNLESS SHUTDOWN ON SAFETIES OR OUTSIDE AIR CONDITIONS.

**HOT WATER PUMP ALARMS:**

ALARMS SHALL BE PROVIDED AS FOLLOWS:

- HOT WATER PUMP 1
  - o FAILURE: COMMANDED ON, BUT THE STATUS IS OFF.
  - o RUNNING IN HAND: COMMANDED OFF, BUT THE STATUS IS ON.
  - o RUNTIME EXCEEDED: STATUS RUNTIME EXCEEDS A USER DEFINABLE LIMIT.
  - o VFD FAULT.

**HOT WATER DIFFERENTIAL PRESSURE CONTROL:**


THE CONTROLLER SHALL MEASURE HOT WATER DIFFERENTIAL PRESSURE AND MODULATE THE HOT WATER PUMP VFD TO MAINTAIN ITS HOT WATER DIFFERENTIAL PRESSURE SETPOINT.

THE FOLLOWING SETPOINTS ARE RECOMMENDED VALUES. ALL SETPOINTS SHALL BE FIELD ADJUSTED DURING THE COMMISSIONING PERIOD TO MEET THE REQUIREMENTS OF ACTUAL FIELD CONDITIONS.

THE CONTROLLER SHALL MODULATE HOT WATER PUMP SPEED TO MAINTAIN A HOT WATER DIFFERENTIAL PRESSURE OF 12 PSI (OPERATOR DEFINABLE). THE VFD MINIMUM SPEED SHALL NOT DROP BELOW 20% (A.U.).

**ALARMS SHALL BE PROVIDED AS FOLLOWS:**

- HIGH HOT WATER DIFFERENTIAL PRESSURE: IF 30% (OPERATOR DEFINABLE) GREATER THAN SETPOINT.
- LOW HOT WATER DIFFERENTIAL PRESSURE: IF 30% (OPERATOR DEFINABLE) LESS THAN SETPOINT.

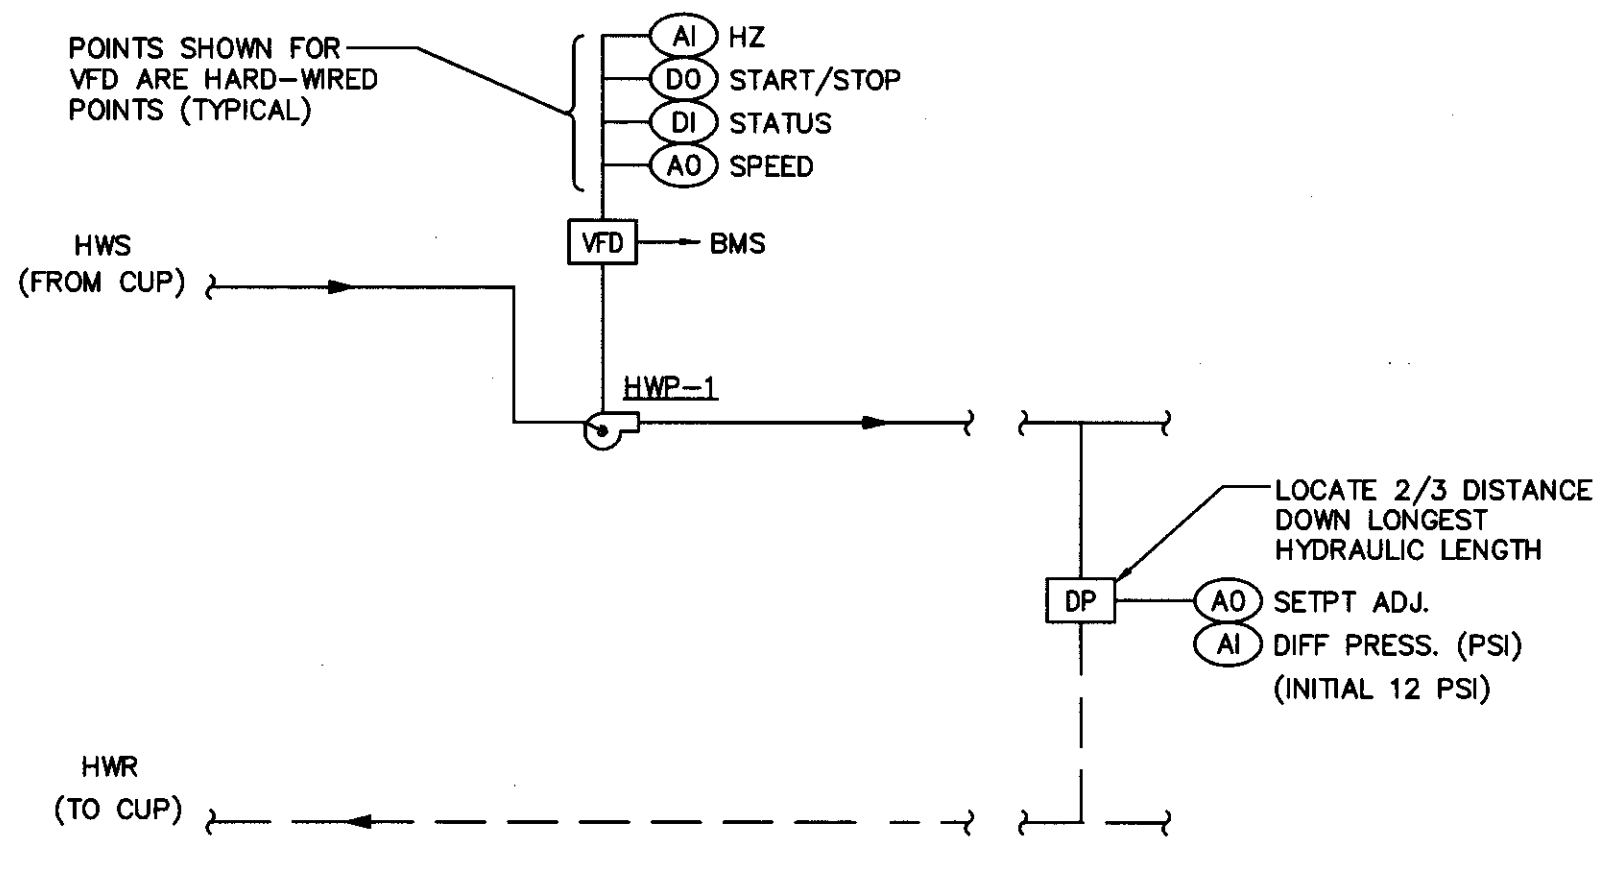

**3 HOT WATER PUMP CONTROL (HWP-1)**  
NO SCALE

**tBP** architecture  
planning  
interiors  
management

1887/Architecture  
1000 Burnett Avenue Suite 140  
Concord, CA 94520  
ph: 925.246.6419 fx: 925.246.6495

architect

**INTERFACE**  
ENGINEERING

2008-0108  
Shawn Wilson  
717 Market Street  
San Francisco, CA 94103  
TEL: 415.488.7240  
FAX: 415.488.7241  
www.interfaceeng.com

consultant

**REVISION**

DATE: JUL 31 2012

name \_\_\_\_\_  
address \_\_\_\_\_  
city, state, zip \_\_\_\_\_  
ph: \_\_\_\_\_  
agency \_\_\_\_\_

**L-612 STUDENT SERVICES CENTER REMODEL COLLEGE COMPLEX**

**BID DOCUMENTS**

owner  
**LOS MEDANOS COLLEGE**  
2700 EAST LELAND DRIVE  
PITTSBURG, CA 94565

tBP project number: 20810.00

file name: 0106M63.dwg

drawn by: GE checked by: BC

date: **JULY 31, 2012**

Rev. date: description:

drawing title:  
**MECHANICAL CONTROL DIAGRAM**

drawing no:  
**M-63**  
drawing of