

MECHANICAL LEGEND		
SYMBOL	ABBREVIATION	DESCRIPTION
	ABV	ABOVE
	ABC	ABOVE CEILING
	AF	ABOVE FLOOR
	AFF	ABOVE FINISHED FLOOR
	AFG	ABOVE FINISHED GRADE
	AC	AIR CONDITIONING
	APD	AIR PRESSURE DROP, INCHES WATER COLUMN
	BDD	[COUNTER BALANCED] BACK DRAFT DAMPER
	BFP	BACKFLOW PREVENTER
	BF	BELOW FLOOR
	BHP	BRAKE HORSEPOWER
	BTU(H)	BRITISH THERMAL UNITS (PER HOUR)
	CLG	CEILING
	CLR	CLEAR
— CD —	CD	CONDENSATE DRAIN LINE
	CONC	CONCRETE
	COND	CONDENSER
	CONN	CONNECT OR CONNECTION
	CONT	CONTINUATION
	CFM	CUBIC FEET OF AIR FLOW PER MINUTE
		DEGREES FAHRENHEIT
	DIA	DIAMETER
ΔP	ΔP	DIFFERENTIAL PRESSURE SENSOR, PIPE MOUNTED
	DL	DOOR LOUVER
	DN	DOWN
	DR	DRAIN
(D)	(D)	DROP
	DB	DRY BULB (DEGREES FAHRENHEIT)
	DTR	DUCT THRU ROOF
	ELEC.	ELECTRIC, ELECTRICAL
	EDB	ENTERING DRY BULB
	EW	ENTERING WATER
	EWT	ENTERING WATER TEMPERATURE
	EWB	ENTERING WET BULB
	EA	EXHAUST AIR
	EAD	EXHAUST AIR DAMPER
(E), EXIST.		EXISTING
	ESP	EXTERNAL STATIC PRESSURE
	PPM	FEET PER MINUTE
F	FD	FIRE DAMPER
FS	FS	FIRE/SMOKE DAMPER
	FC	FLEXIBLE OR FLEXIBLE CONNECTION
	FLR	FLOOR
		FLOW IN DIRECTION OF ARROW
	FA	FROM ABOVE
	FB	FROM BELOW
	FLA	FULL LOAD AMPS
	GPH	GALLONS PER HOUR
	GPM	GALLONS PER MINUTE
	GALV	GALVANIZED
	OSM	GALVANIZED SHEET METAL
	GA	GAUGE
GYP. BD.		GYPSUM BOARD
HTG		HEATING
HP		HORSEPOWER
HR		HOUR
IN. WC., IN. WG.		INCHES WATER GAGE, INCHES WATER COLUMN
	KW	KILOWATTS
	KWH	KILOWATT HOUR
	LDB	LEAVING DRY BULB IN DEGREES FAHRENHEIT
	LWB	LEAVING WET BULB IN DEGREES FAHRENHEIT
	LRA	LOCKED ROTOR AMPERES
	MAY	MANUAL AIR VENT
	MAD, MD	MANUAL AIR DAMPER
	MFR	MANUFACTURER
	MAX	MAXIMUM
	MOC	MAXIMUM OVER CURRENT PROTECTION
	MBH	THOUSANDS OF BRITISH THERMAL UNITS
	MIN	MINIMUM
	MCC	MOTOR CONTROL CENTER
	OC	ON CENTER
	OA	OUTSIDE AIR
	OAD	OUTSIDE AIR DAMPER
	OH	OVERHEAD
	PH	PHASE
	POC	POINT OF CONNECTION
	LB, LBS	POUND, POUNDS
PSI (G) (A)		POUNDS PER SQUARE INCH (GAUGE) (ABSOLUTE)
PG		PRESSURE GAUGE
PRV		PRESSURE REDUCING VALVE

MECHANICAL LEGEND cont'd		
SYMBOL	ABBREVIATION	DESCRIPTION
— RS —	RS	REFRIGERANT SUCTION PIPING
— RL —	RL	REFRIGERANT LIQUID PIPING
	RA	RETURN AIR
	RAD	RETURN AIR DAMPER
	RPM	REVOLUTIONS PER MINUTE
	(R)	RISE
		RISER DOWN (ELBOW)
		RISER UP (ELBOW)
	RLA	RUNNING LOAD AMPERES
		SEISMIC EXPANSION JOINT
	SM	SHEET METAL
	SD	SMOKE DAMPER
	SKD	SMOKE DETECTOR
	SQFT, FT ²	SQUARE FEET
	SQIN, IN ²	SQUARE INCHES
	SP	STATIC PRESSURE
	SPD	STATIC PRESSURE DROP
	SP	STATIC PRESSURE SENSOR (DUCT AND SPACE)
	SA	SUPPLY AIR
	SF	SUPPLY FAN
	TCV	TEMPERATURE CONTROL VALVE
	TCV	TEMPERATURE CONTROL PANEL
	T	TEMPERATURE SENSOR, "X" INDICATES DEVICE CONTROLLED
	TA	TO ABOVE
	TB	TO BELOW
	TP	TOTAL PRESSURE
	TSP	TOTAL STATIC PRESSURE
	TYP	TYPICAL
	UG	UNDERGROUND
	UF	UNDER FLOOR
	UON	UNLESS OTHERWISE NOTED
	VLV	VALVE
	WPD	WATER PRESSURE DROP
	W	WATTS
	WT	WEIGHT
	WB	WET BULB
	WMS	WIRE MESH SCREEN
	WP	WORKING PRESSURE
CHWS	CHWS	CHILLED WATER SUPPLY PIPING
CHWR	CHWR	CHILLED WATER RETURN PIPING
HWS	HWS	HOT WATER SUPPLY PIPING
HWR	HWR	HOT WATER RETURN PIPING
CD	CD, D	CONDENSATE DRAIN, DRAIN
TR		DUCT TRANSITION, LARGE TO SMALL
AV, TCV	AV, TCV	VALVE WITH MOTOR/ACTUATOR
CBV	CBV	BUTTERFLY VALVE WITH MOTOR/ACTUATOR
ANV	ANV	CALIBRATED BALANCE VALVE
BFP	BFP	ANGLE VALVE
BFV	BFV	BACKFLOW PREVENTER
BV	BV	BUTTERFLY VALVE
CKV	CKV	BALL VALVE
CP	CP	CHECK VALVE
GV	GV	CIRCULATING PUMP
GLV	GLV	BALL VALVE
GCK	GCK	GLOBE VALVE
HV	HV	GAGE COCK
PRV	PRV	HAND VALVE
RV or P&TRV	RV or P&TRV	PRESSURE REDUCING VALVE
TCV	TCV	RELIF VALVE OR PRESSURE & TEMPERATURE RELIEF VALVE
TCV	TCV	TEMPERATURE CONTROL VALVE (2-WAY)
FMS	FMS	TEMPERATURE CONTROL VALVE (3-WAY)
		FLOW MEASURING STATION
		VALVE IN RISER (TYPE AS INDICATED OR NOTED)
		FLOW IN DIRECTION OF ARROW
	UN	PITCH DOWN IN DIRECTION OF FLOW
	FL	UNION
		FLANGE
		EXISTING TO BE REMOVED
	EXP LP	EXPANSION LOOP
		PIPE ANCHOR
		PIPE GUIDE

NOTE: NOT ALL SYMBOLS AND ABBREVIATIONS MAY BE USED ON PLANS.

PIPING, DUCTWORK & ELECTRICAL DISTRIBUTION SYSTEM BRACING NOTE

PIPING, DUCTWORK, AND ELECTRICAL DISTRIBUTION SYSTEMS SHALL BE BRACED TO COMPLY WITH THE FORCES AND DISPLACEMENTS PRESCRIBED IN ASCE 7-10 SECTION 13.3 AS DEFINED IN ASCE 7-10 SECTION 13.6.8, 13.6.7, 13.6.5.6, AND 2013 CBC, SECTIONS 1616A.1.23 THROUGH 1616A.1.26.

THE BRACING AND ATTACHMENTS TO THE STRUCTURE SHALL BE DETAILED ON THE APPROVED DRAWINGS OR THEY SHALL COMPLY WITH ONE OF THE OSHPD PRE-APPROVALS (OPA #) AS MODIFIED TO SATISFY ANCHORAGE REQUIREMENTS OF ACI 318, APPENDIX D.

COPIES OF THE MANUAL SHALL BE AVAILABLE ON THE JOBSITE PRIOR TO THE START OF HANGING AND BRACING OF THE PIPE, DUCTWORK, AND ELECTRICAL DISTRIBUTION SYSTEMS.

THE STRUCTURAL ENGINEER OF RECORD SHALL VERIFY THE ADEQUACY OF THE STRUCTURE TO SUPPORT THE HANGER AND BRACE LOADS.

MEP COMPONENT ANCHORAGE NOTE

ALL MECHANICAL, PLUMBING, AND ELECTRICAL COMPONENTS SHALL BE ANCHORED AND INSTALLED PER THE DETAILS ON THE DSA APPROVED CONSTRUCTION DOCUMENTS. WHERE NO DETAIL IS INDICATED, THE FOLLOWING COMPONENTS SHALL BE ANCHORED OR BRACED TO MEET THE FORCE AND DISPLACEMENT REQUIREMENTS PRESCRIBED IN THE 2013 CBC, SECTIONS 1616A.1.18 THROUGH 1616A.1.26 AND ASCE 7-10 CHAPTER 13 AND 26.

- ALL PERMANENT EQUIPMENT AND COMPONENTS.
- TEMPORARY OR MOVABLE EQUIPMENT THAT IS PERMANENTLY ATTACHED (e.g. HARD WIRED) TO THE BUILDING UTILITY SERVICES SUCH AS ELECTRICITY, GAS OR WATER.
- MOVABLE EQUIPMENT WHICH IS STATIONED IN ONE PLACE FOR MORE THAN 8 HOURS AND HEAVIER THAN 400 POUNDS ARE REQUIRED TO BE ANCHORED WITH TEMPORARY ATTACHMENTS.

THE ATTACHMENT OF THE FOLLOWING MECHANICAL AND ELECTRICAL COMPONENTS SHALL BE POSITIVELY ATTACHED TO THE STRUCTURE, BUT NEED NOT BE DETAILED ON THE PLANS. THESE COMPONENTS SHALL HAVE FLEXIBLE CONNECTIONS PROVIDED BETWEEN THE COMPONENT AND ASSOCIATED DUCTWORK, PIPING, AND CONDUIT.

- COMPONENTS WEIGHING LESS THAN 400 POUNDS AND HAVE A CENTER OF MASS LOCATED 4 FEET OR LESS ABOVE THE ADJACENT FLOOR OR ROOF LEVEL THAT DIRECTLY SUPPORT THE COMPONENT.
- COMPONENTS WEIGHING LESS THAN 20 POUNDS, OR IN THE CASE OF DISTRIBUTION SYSTEMS, LESS THAN 5 POUNDS PER FOOT, WHICH ARE SUSPENDED FROM A ROOF OR FLOOR OR HUNG FROM A WALL.

FOR THOSE ELEMENTS THAT DO NOT REQUIRE DETAILS ON THE APPROVED DRAWINGS, THE INSTALLATION SHALL BE SUBJECT TO THE APPROVAL OF THE STRUCTURAL ENGINEER OF RECORD AND THE DSA DISTRICT STRUCTURAL ENGINEER. THE PROJECT INSPECTOR WILL VERIFY THAT ALL COMPONENTS AND EQUIPMENT HAVE BEEN ANCHORED IN ACCORDANCE WITH ABOVE REQUIREMENTS.

DUCT LEGEND

SINGLE LINE SYMBOL	DOUBLE LINE SYMBOL	DESCRIPTION
24x12	24x12	RECTANGULAR DUCT - WIDTH x DEPTH (PLAN VIEW) DEPTH x WIDTH (SECTION VIEW)
26x14L	26x14L	ACOUSTICALLY LINED RECTANGULAR DUCT-DIMENSIONS ARE OUTSIDE DIMENSION
R OR D	RISE OR DROP	MANUAL AIR DAMPER
R OR D	RISE OR DROP	RISE OR DROP DUCT IN DIRECTION OF AIR FLOW
	OR	RECTANGULAR TO RECTANGULAR TRANSITION, MAX. SLOPE OF 1:3 RECTANGULAR TO ROUND TRANSITION, MAX. SLOPE OF 1:3
		ELBOW, RECTANGULAR, SMOOTH RADIUS, WITHOUT TURNING VANES
		SQUARE/RECTANGULAR DUCT ELBOW WITH TURNING VANES
		CONVERGING OR DIVERGING TEE, 45° ENTRY, RECTANGULAR MAIN AND BRANCH, WHEN REDUCING MAIN, SIDE OF TAKE OFF OR ENTRY BRANCH TO BE FLAT, OTHER SIDES MAX. SLOPE OF 1:3
		ROUND DUCT TAKE OFF FROM RECTANGULAR VIA SMOOTH CONVERGING BELL MOUTH
		RECTANGULAR DUCT TEE MAD'S ON THE 2 BRANCHES, THROAT SIZED FOR EQUAL PRESSURE DROP
		RECTANGULAR DUCT SPLIT MAD'S, THROAT SIZED FOR EQUAL PRESSURE DROP
		3-WAY RECTANGULAR SPLIT WITH TWO TRANSITIONAL ELBOWS AND TRANSITIONING MAIN, DOWNSTREAM MAD'S ON THE TREE BRANCHES. THROATS SIZED FOR EQUAL PRESSURE DROP.
		FOR CONCEALED DUCT: DROP TO DIFFUSER SHALL BE FULL SIZE OF DIFFUSER NECK. FOR EXPOSED DUCT: DROP SHALL BE FULL SIZE OF OD DIFFUSER FRAME, FLANGE FOR MOUNTING DIFFUSER TURNED IN. AIR EXTRACTOR AND EQUALIZER GRID AT CONNECTION TO MAIN.
		SUPPLY AIR, SUPPLY AIR DUCT IN SECTION, SUPPLY DROP
		RETURN AIR, RETURN AND OUTSIDE AIR DUCT IN SECTION, RETURN AIR DROP
		EXHAUST AIR, EXHAUST AIR DUCT IN SECTION, EXHAUST AIR DROP
		FLEXIBLE DUCT (ROUND)
		FLEXIBLE DUCT (FABRIC)
		45° REDUCING LATERAL FITTING
		90° REDUCING TEE FITTING

SHEET INDEX

M0.1	HVAC LEGENDS, SCHEDULES AND NOTES
M0.2	HVAC SCHEDULES
M0.3	TITLE-24
M1.0	HVAC DEMO FLOOR PLAN
M1.1	HVAC DEMO PIPING PLAN
M2.0	HVAC FLOOR PLAN
M2.1	HVAC PIPING PLAN
M5.1	HVAC DETAILS
M6.1	HVAC CONTROLS

MECHANICAL GENERAL NOTES

- ALL WORK SHALL COMPLY WITH ALL APPLICABLE CODES, SPECIFICATIONS, LOCAL ORDINANCES AND INDUSTRY STANDARDS.
- COORDINATE EXACT LOCATION OF EQUIPMENT AND ALL PENETRATIONS THROUGH WALLS & ROOFS WITH ARCHITECTURAL DRAWINGS AND STRUCTURAL COMPONENTS PRIOR TO COMMENCING WORK.
- COORDINATE EXACT SIZE AND ROUTING OF DUCTWORK AND PIPING ON THE JOB PRIOR TO FABRICATION AND INSTALLATION WITH ARCHITECTURAL, STRUCTURAL, PLUMBING, AND ELECTRICAL. NOT ALL RISES AND DROPS ARE SHOWN. PROVIDE AS REQUIRED TO ACCOMMODATE STRUCTURE AND EXISTING CONDITIONS. HOLD ALL PIPING AS HIGH AS POSSIBLE UNLESS OTHERWISE INDICATED.
- PROVIDE AND INSTALL MANUAL AIR DAMPERS AT ALL DUCT BRANCH TAKEOFFS TO A SINGLE SUPPLY DIFFUSER/REGISTER OR FROM A SINGLE RETURN OR EXHAUST REGISTER/GRILLE.
- ALL WORK SHOWN IS NEW UNLESS NOTED OTHERWISE. CAREFULLY COORDINATE CONNECTION OF NEW WORK TO EXISTING WORK.
- FIELD VERIFY LOCATIONS OF ALL EXISTING DUCTWORK, PIPING, EQUIPMENT, ETC. PRIOR TO START OF WORK. ADJUST NEW WORK AS NECESSARY TO COMPENSATE FOR VARIATIONS IN LOCATIONS OF EXISTING.
- PENETRATIONS OF RATED FIRE ASSEMBLIES SHALL BE FIRESTOPPED. FIRE-STOPPING SHALL BE OF AN APPROVED MATERIAL AS PRESCRIBED BY THE STATE FIRE MARSHAL.
- INFORMATION PERTAINING TO EXISTING CONDITIONS AND SYSTEMS IS BASED ON REVIEW OF AVAILABLE RECORD DRAWINGS AND CURSORY REVIEW OF FACILITY. CONTRACTOR SHALL VISIT SITE PRIOR TO COMMENCING WORK TO BECOME THOROUGHLY FAMILIAR WITH EXISTING CONDITIONS AND SYSTEMS. MODIFY NEW WORK TO SUIT EXISTING CONDITIONS. DOCUMENT EXISTING SYSTEMS AND MODIFICATIONS TO NEW WORK REQUIRED, IF ANY, WITH SHOP DRAWING SUBMISSION.
- SEE ARCHITECTURAL REFLECTED CEILING PLAN FOR EXACT LOCATION OF ALL CEILING DIFFUSERS, REGISTERS AND GRILLES.
- ACCESS PANELS SHALL BE PROVIDED AS NECESSARY TO PROPERLY ACCESS THE MECHANICAL SYSTEMS INCLUDING VALVES, EQUIPMENT AND DAMPERS. COORDINATE WITH ARCHITECTURAL REFLECTED CEILING PLAN.
- SUPPORTS, ANCHORAGE AND RESTRAINTS FOR ALL PIPING, DUCTWORK AND EQUIPMENT SHALL BE AN OSHPD PRE-APPROVED SYSTEM SUCH AS ISAT, MASON OR EQUAL. SYSTEM SHALL HAVE A CURRENT OPA NUMBER AND SHALL MEET THE REQUIREMENTS OF THE AUTHORITY HAVING JURISDICTION. SEE SPECIFICATIONS FOR ADDITIONAL INFORMATION.
- FLEXIBLE DUCTWORK CONNECTIONS TO CEILING DIFFUSERS ARE LIMITED TO 8' MAXIMUM LENGTH.
- WHERE INLET DUCT DIAMETER & DIFFUSER NECK SIZE ARE THE SAME (I.E. 9" & 9x9) CONTRACTOR SHALL OVERSIZE THE SHEET METAL PLENUM TO ACCOMMODATE THE ROUND DUCT CONNECTION.
- THERMOSTAT TO BE INSTALLED AT 48" ABOVE FINISHED FLOOR (TOP OF THERMOSTAT), DO NOT INSTALL THERMOSTAT OVER CASEWORK OR SHELVING OVER 24" IN DEPTH & 34" IN HEIGHT.


TABLE OF BRANCH DUCT (SA, RA, EA) SIZES TO INDIVIDUAL DIFFUSERS, GRILLES, & REGISTERS

CFM	DUCT SIZE (INCHES) ①				REMARKS ③ ④
	ROUND	SQUARE	RECTANGULAR	MIN. AREA (SQ. IN.) ②	
0-210	8"	8x8	8x8	48	8x8 MIN ON RA & EA
211-380	10"	10x10	10x8	80	
381-600	12"	12x12	12x10, 16x8	120	
601-900	14"	14x14	14x12, 18x10, 20x8	160	
901-1300	16"	16x16	16x14, 18x12, 22x10	220	
1301-1800	18"	18x18	18x16, 20x14, 22x12	264	
1801-2400	20"	20x20	22x16, 24x14, 30x12	340	

NOTES:

- SIZE OF BRANCH DUCT IF SHOWN ON PLANS OR FROM ABOVE TABLE IS NOT THE INLET SIZE TO DIFFUSER, GRILLE OR REGISTER. PROVIDE PLENUM BOX PER 5/M5.1. SEE NOTE ③.
- MINIMUM DUCT AREA TO BE USED FOR ALTERNATE DUCT SIZES (DIFFERENT THAN THIS TABLE) WHEN REQUESTED BY CONTRACTOR FOR SA, RA, AND EA.
- SEE 5/M5.1 FOR PLENUM BOX AT DIFF/REG/GRILLE AND FOR DETAIL OF DUCT BRANCH CONNECTION TO OUTLET (AND INLET) PLENUMS AT DIFF/REG/GRILLE.
- ALL DUCT SIZES SHALL BE SHOWN CLEARLY ON THE CONTRACTOR'S SUBMITTAL DRAWINGS. SHOW SIZE OF EACH DUCT ON THE PLANS AT EACH DUCT LOCATION.

AS-BUILT

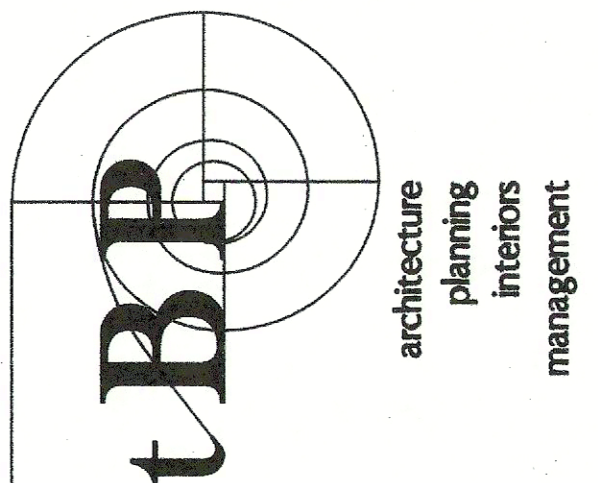


tBP Architecture
1777 Oakland Avenue, Suite 320
Walnut Creek, CA 94596
pt 9252460419
architect



DATE SIGNED: 07/15/2016

CAPITAL
ENGINEERING CONSULTANTS, INC.
RANCHO CORONA, CALIFORNIA
10 - WVA/ALP 150225.00
PROJECT NO.

consultant

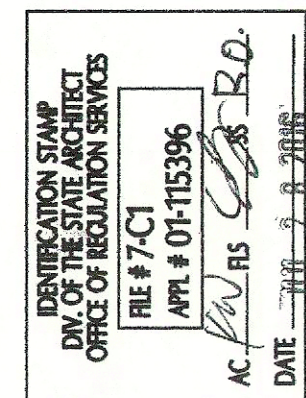

Division of the State Architect
1515 Clay Street, Suite 1201
Oakland, CA, 94612
pt (510) 622-3101
agency

LEVEL 2 REMODEL
SECTORS 5A, 5B & 6
COLLEGE COMPLEX
LOS MEDANOS COLLEGE
2700 EAST LELAND DRIVE
PITTSBURG, CA 94565

owner

tBP project number : 2084200
file name:
drawn by: checked by:
date: MAY 16, 2016
Rev. date: description:
12/5/15 DSA SUBMITTAL
5/16/16 DSA
7/1/16 BID SET
12/09/16 Revised Bid Set

THIS DRAWING AND THE DESIGN, SPECIFICATIONS, IDEAS AND OTHER INFORMATION CONTAINED HEREIN CONSTITUTE UNPUBLISHED WORK OF ARCHITECTURE AND SHALL REMAIN THE PROPERTY OF ARCHITECTURE IN PERPETUITY. NO PART THEREOF SHALL BE REPRODUCED, DISCLOSED, DISTRIBUTED, SOLD, RENTED OR OTHERWISE USED IN ANY MANNER WITHOUT THE ADVANCED EXPRESS WRITTEN CONSENT OF ARCHITECTURE.


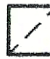





drawing title:
HVAC LEGEND,
SCHEDULES & NOTES

drawing no:
M0.1
drawing of

AIR HANDLER SCHEDULE																																						
UNIT	SERVES	"TEMTROL" MODEL	LOCATED	SUPPLY FAN		RETURN CFM		CHILLED WATER COIL														HOT WATER COIL														MIN. OA CFM	UNIT WT. LBS.	REMARKS
				CFM	TSP/ESP IN.W.G.	HP	CFM	TSP/ESP IN.W.G.	HP	ROWS	FPI	EDB °F	EWB °F	LDB °F	SENS. LOAD (MBH)	TOTAL LOAD (MBH)	GPM	EWT °F	LWT °F	AIR Δ P IN.W.G.	WATER Δ P FT.HEAD	TCV		ROWS	FPI	EDB °F	LOAD (MBH)	GPM	EWT °F	LWT °F	AIR Δ P IN.W.G.	WATER Δ P FT.HEAD	TCV					
																						TYPE	CV										TYPE	CV				
(E) AHU 5A.1	(E) SECTOR 5A	"TEMTROL" WF-RDHR14	OUTDOOR	6,650	4.5 2.0	2Φ 5 HP	5,850	1.75 1.45	3	4	12	85	64	51	227	236	49	45	55	0.29	4.97	3-WAY	-	1	7	54	208	20	160	140	0.03	2.92	3-WAY	-	2,660	6,850	1, 2.	
(E) AHU 6.1	(E) SECTOR 6 (ALSO SECTOR 3 OUT OF SCOPE)	"TEMTROL" IIF-RDHR22	OUTDOOR	-	-	15	-	-	7.5	6	10	84	66	52	366	457	91	45	55	0.77	12.4	2-WAY	-	1	6	56	202	10	160	120	0.06	3.95	2-WAY	-	2,500	9,720	3, 5	
(E) AHU 8	(E) SECTOR 5B (ALSO SECTOR 13 OUT OF SCOPE)	"TEMTROL"	OUTDOOR	-	-	4Φ 6.5 HP	-	-	4Φ 5 HP	-	-	-	-	-	-	-	132	-	-	-	-	3-WAY	27.3	1	8	35	645	66	-	-	-	-	3-WAY	38	5,000	16,950	4, 5	



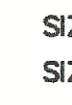



NOTES:

- BALANCE AIR HANDLING UNIT SUPPLY AIR TO VALUE INDICATED.
- EXISTING OUTSIDE AIR FLOW SETPOINT OF 2660 CFM IS OK AS IS. VERIFY DURING AIR BALANCE.
- MAINTAIN THE SAME SUPPLY & RETURN AIRFLOW TO SECTOR 3 (FIRST FLOOR) WHICH IS OUTSIDE THE SCOPE OF WORK. BALANCE SECTOR 6 SUPPLY & RETURN AIRFLOW TO WHAT IS SHOWN ON FLOOR PLAN.
- MAINTAIN THE SAME SUPPLY & RETURN AIRFLOW TO SECTOR 13 (THIRD FLOOR) WHICH IS OUTSIDE THE SCOPE OF WORK. BALANCE SECTOR 5B SUPPLY & RETURN AIRFLOW TO WHAT IS SHOWN ON FLOOR PLAN.
- BALANCE AIR HANDLING UNIT OUTSIDE AIR TO VALUE INDICATED. THE CALCULATED OA VALUE INDICATED INCORPORATES ALL AREAS SERVED BY THIS AHU INCLUDING THOSE SPACES OUTSIDE THE SCOPE OF WORK.

DIFFUSER, REGISTER & GRILLE SCHEDULE					
SYMBOL	DESCRIPTION	TITUS	PRICE	METALAIR	KRUEGER
	MODULAR CORE SURFACE MOUNT PERFORATED CEILING DIFFUSER FLAT FRAME	PMC - BORDER TYPE 1C	PDMC-FRAME1	7950-1	6400 FRAME 22
CR, CE 	CEILING RETURN WITH 1/2" x 1/2" x 1" EGG CRATE CORE, SURFACE MOUNT	MODEL 50 F - BORDER TYPE 1	80	CCSD	EGC-5
CRL, CEL 	CEILING RETURN WITH 1/2" x 1/2" x 1" EGG CRATE CORE, IN 24x24 PANEL FOR T-BAR CEILING	MODEL 50 F - BORDER TYPE 3	80 - TBP	CCSD-TBD	EGC-5TB
S S  	DOUBLE DEFLECTION SUPPLY GRILLE WITH VERTICAL FRONT BARS, 1/4" SPACING	300 RS	520 S	V 4004 S	880 V
R & E *  	RETURN OR EXHAUST GRILLE WITH 35° OR 45° HORIZONTAL BARS.	350 RL	530L	SRH	S 80 H

NOTES:

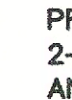1. ALL SYMBOLS NOTED MAY NOT BE USED. REFER TO PLANS FOR SIZE AND QUANTITY.
2. ALL SUPPLY AIR DIFFUSERS ARE 4 WAY BLOW UNLESS SHOWN OTHERWISE.
3. FURNISH ALL PRODUCTS OF A SINGLE MANUFACTURER.
4. COORDINATE DIFFUSER TYPE WITH REFLECTED CEILING PLAN.
5. OPPOSED BLADE DAMPERS ARE NOT REQUIRED AT DIFFUSERS, REGISTERS OR GRILLES.
6. PROVIDE MANUAL AIR DAMPERS AT EACH BRANCH DUCT TO A SINGLE DIFFUSER, REGISTER OR GRILLE.
7. FOR MOUNTING SEE 5/M5.1.

TERMINAL UNIT SCHEDULE												
UNIT	AREA SERVED	TITUS® ESV SERIES	MAX CFM	MIN CFM	DISCHARGE CONN SIZE	TOTAL AIR PRESSURE DROP	NC		2-ROW REHEAT COIL			VALVE
							DISCHARGE	RADIATED	MBH	GPM	PD (FT H ₂ O)	
	SECTOR 5A	16	2000	750	24x18	0.35	< 20	22	32	2.0	0.3	2-WAY
	SECTOR 5A	10	800	800	14x13	0.35	21	27	35	2.0	0.3	2-WAY
	SECTOR 5A	6	300	150	12x8	0.34	20	23	6	0.5	0.1	2-WAY
	SECTOR 5A	4	150	75	12x8	0.26	25	27	3	0.5	0.1	2-WAY
	SECTOR 5A	4	150	75	12x8	0.26	25	27	3	0.5	0.1	2-WAY
	SECTOR 5A	16	2000	750	24x18	0.35	< 20	22	32	2.0	0.3	2-WAY
	SECTOR 5A	4	150	75	12x8	0.26	25	27	3	0.5	0.1	2-WAY
	SECTOR 5A	6	300	150	12x8	0.34	20	23	6	0.5	0.1	2-WAY
	SECTOR 5A	10	800	850	14x13	0.35	21	27	28	1.5	0.5	3-WAY
	SECTOR 5B	10	1000	720	14x13	0.55	23	28	31	2.0	0.3	2-WAY
	SECTOR 5B	10	800	800	14x13	0.35	21	27	35	2.0	0.3	2-WAY
	SECTOR 5B	5	200	100	12x8	0.55	< 20	< 20	4	0.5	0.1	2-WAY
	SECTOR 5B	6	300	150	12x8	0.34	20	23	6	0.5	0.1	2-WAY
	SECTOR 5B	10	1000	660	14x13	0.55	23	28	28	1.5	0.5	2-WAY
	SECTOR 5B	6	300	150	12x8	0.34	20	23	6	0.5	0.1	2-WAY
	SECTOR 5B	10	1000	675	14x13	0.55	23	28	29	1.5	0.5	2-WAY
	SECTOR 5B	6	300	150	12x8	0.34	20	23	6	0.5	0.1	2-WAY
	SECTOR 5B	10	1000	675	14x13	0.55	23	28	29	1.5	0.5	3-WAY
	SECTOR 6	8	600	450	12x10	0.45	25	25	19	1.0	0.3	2-WAY
	SECTOR 6	8	600	375	12x10	0.45	25	25	16	1.0	0.3	2-WAY

NOTES:

PROVIDE BOX W/DAMPER AND LINKAGE AND AVERAGING VELOCITY SENSOR. FOR CONTROLS SEE SHEET M6.1.
HW ΔT = 40F , 180F EWT , 140F LWT, FOR BOX MOUNTING SEE 4/M5.1. FOR HW COIL PIPING SEE 1/M5.1 & 2/M5.1. TERMINAL UNITS HAVE BEEN SELECTED WITH 1.0" INLET STATIC PRESSURE FOR NOISE CRITERIA DATA.


PROVIDE 3-WAY TEMPERATURE CONTROL VALVES AS NOTED ON SCHEDULE AT END OF RUNS AND DISTANT BOXES, 2-WAY VALVES ALL OTHER TERMINAL BOX COILS. VAV REHEAT COIL MBH's CALCULATED AT MINIMUM CFM. ALL CAV AND VAV COILS SHALL BE 2 ROWS, 8 FPI MINIMUM


WEIGHTS:


SIZE 6 = 70 LBS SIZE 8 = 75 LBS SIZE 12 = 105 LBS SIZE 16 = 145 LBS

SIZE 7 = 75 LBS SIZE 10 = 90 LBS SIZE 14 = 120 LBS

AS-BUILT

 <p>tBP</p> <p>architecture planning interiors management</p> <p>tBP/Architecture 1777 Oakland Avenue, Suite 320 Walnut Creek, CA 94596 ph: 925-246.6419</p>	<p>architect</p>
--	------------------

	<p>DATE SIGNED: 07/15/2016</p>
---	--------------------------------

 <p>CAPITAL ENGINEERING CONSULTANTS, INC. RUSTON COSSON, CALIFORNIA</p>	<p>10 - \$B/\$MR 150225.00 P/E - THOMAS ALAN DAVIS PROJECT NO.</p>
consultant	

<div style="border: 1px solid black; padding: 5px; margin-bottom: 10px;"> <p style="font-size: small;">INDEPENDENT FIRM DIV. OF THE STATE ARCHITECT OFFICE OF REGULATION SERVICES</p> <p style="text-align: center;">NO. 00115396 REV. 07/15/2016</p> <p style="text-align: right;">AC <i>[Signature]</i> R.O. DATE: 7-15-2016</p> </div>	<p>Division of the State Architect 1515 Clay Street, Suite 1201 Oakland, Ca., 94612 ph: (510) 622-3101</p>
---	--

	agency
--	--------

<h1 style="margin: 0;">LEVEL 2 REMODEL SECTORS 5A, 5B & 6 COLLEGE COMPLEX</h1>	<h1 style="margin: 0;">LOS MEDANOS COLLEGE 2700 EAST LELAND DRIVE PITTSBURG, CA 94565</h1>
--	--

	owner
--	-------

tBP project number :	2084200
----------------------	---------

file name:	
------------	--

drawn by:	checked by:
-----------	-------------

date:	MAY 15, 2016
-------	--------------


Rev.	date:	description:
	12/15/15	DSA SUBMITTAL
	5/16/16	DSA
	7/1/16	BID SET
	12/09/16	Revised Bid Set

THIS DRAWING AND THE DESIGN, SPECIFICATIONS, IDEAS AND OTHER INFORMATION CONTAINED HEREIN CONSTITUTE UNPUBLISHED WORKS OF APPROPRIATE CREATIVITY AND SHALL REMAIN THE PROPERTY OF APPROPRIATE CREATIVITY IN PERPETUITY. NO PART THEREOF SHALL BE REPRODUCED, DISCLOSED, DISTRIBUTED, SOLD, PUBLISHED OR OTHERWISE USED IN ANY WAY WITHOUT THE ADVANCED EXPRESS WRITTEN CONSENT OF APPROPRIATE CREATIVITY.

drawing title:	HVAC SCHEDULES
----------------	-------------------

drawing no:	M0.2
-------------	------

drawing	of
---------	----

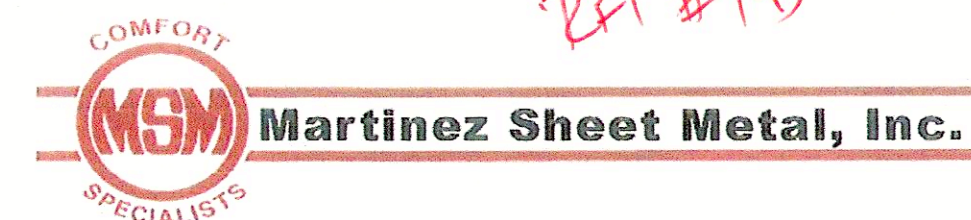

REQUEST FOR INFORMATION

REF #		Facility	Pittsburg
Date:	7/25/2017	D.C.A.	
From:	Martinez Sheet Metal	Project Name	LMC Sector 5A
To:	W A Thomas	Date Information Required	ASAP
		Priority	Routine
		Expedite	
Subject:	Duct Modification	Urgent	XXXX
Category			
<input type="checkbox"/>	Information not shown on contract documents	Contract Drawing Ref.:	
<input type="checkbox"/>	Interpretation of contract documents	Shop Drawing Ref.:	
<input type="checkbox"/>	Conflict in contract documents	Specification Ref.:	
<input checked="" type="checkbox"/>	Coordination problem	Possible Cost Impact	<input type="checkbox"/> Yes <input checked="" type="checkbox"/> No
<input type="checkbox"/>	Possible code conflict	Possible Time Impact	<input type="checkbox"/> Yes <input checked="" type="checkbox"/> No
<input type="checkbox"/>	Other	Job Site PU	
		Job Site Fax	

COMMENTS: Do to existing conditions could we relocate the ductwork as noted in red and reuse the exiting 10" ductwork to the men's restroom?

RESPONSE:

Answered by: _____ Date: _____

RFI # 143

L-640 College Complex Remodel
2006 CIP/LMC - Los Medanos College
2006 CIP

Printed 07/25/2017, Page 1 of 1

HVAC Ductwork in Restrooms 230 & 231

Submitted : 07/25/2017
Submitted To: Critical Solutions, Inc., W A Thomas
Status: Pending
Priority: High
Due Date: 07/25/2017
Pending On User: Felix Canani
Pending On Org: IBP/Architecture, Inc.

Created By: W A Thomas, Jim Smith
Created: 07/25/2017

The due date will automatically be set at 14 calendar days from submission. Use the Requested Response Date field to request a different turnaround time.
Requested Response Date: 06/29/2017

Request:

Reference is made to the attached Martinez Sheet Metal RFI dated 7/25/2017. Can the ductwork shown in red be relocated and the 10" existing ductwork to the men's restroom be reused?

Suggestion:

Note to Contractor: This Form Cannot Modify Contract Amount or Milestones and/or Contract Time.

References


Drawing M1.0 Published

Files


MSM RFI #142.pdf 613.71 KB

We do not take exception to the coordinated duct location and reuse of existing ductwork proposed by the contractor.


Bob Barcelon, CECI 7/27/17

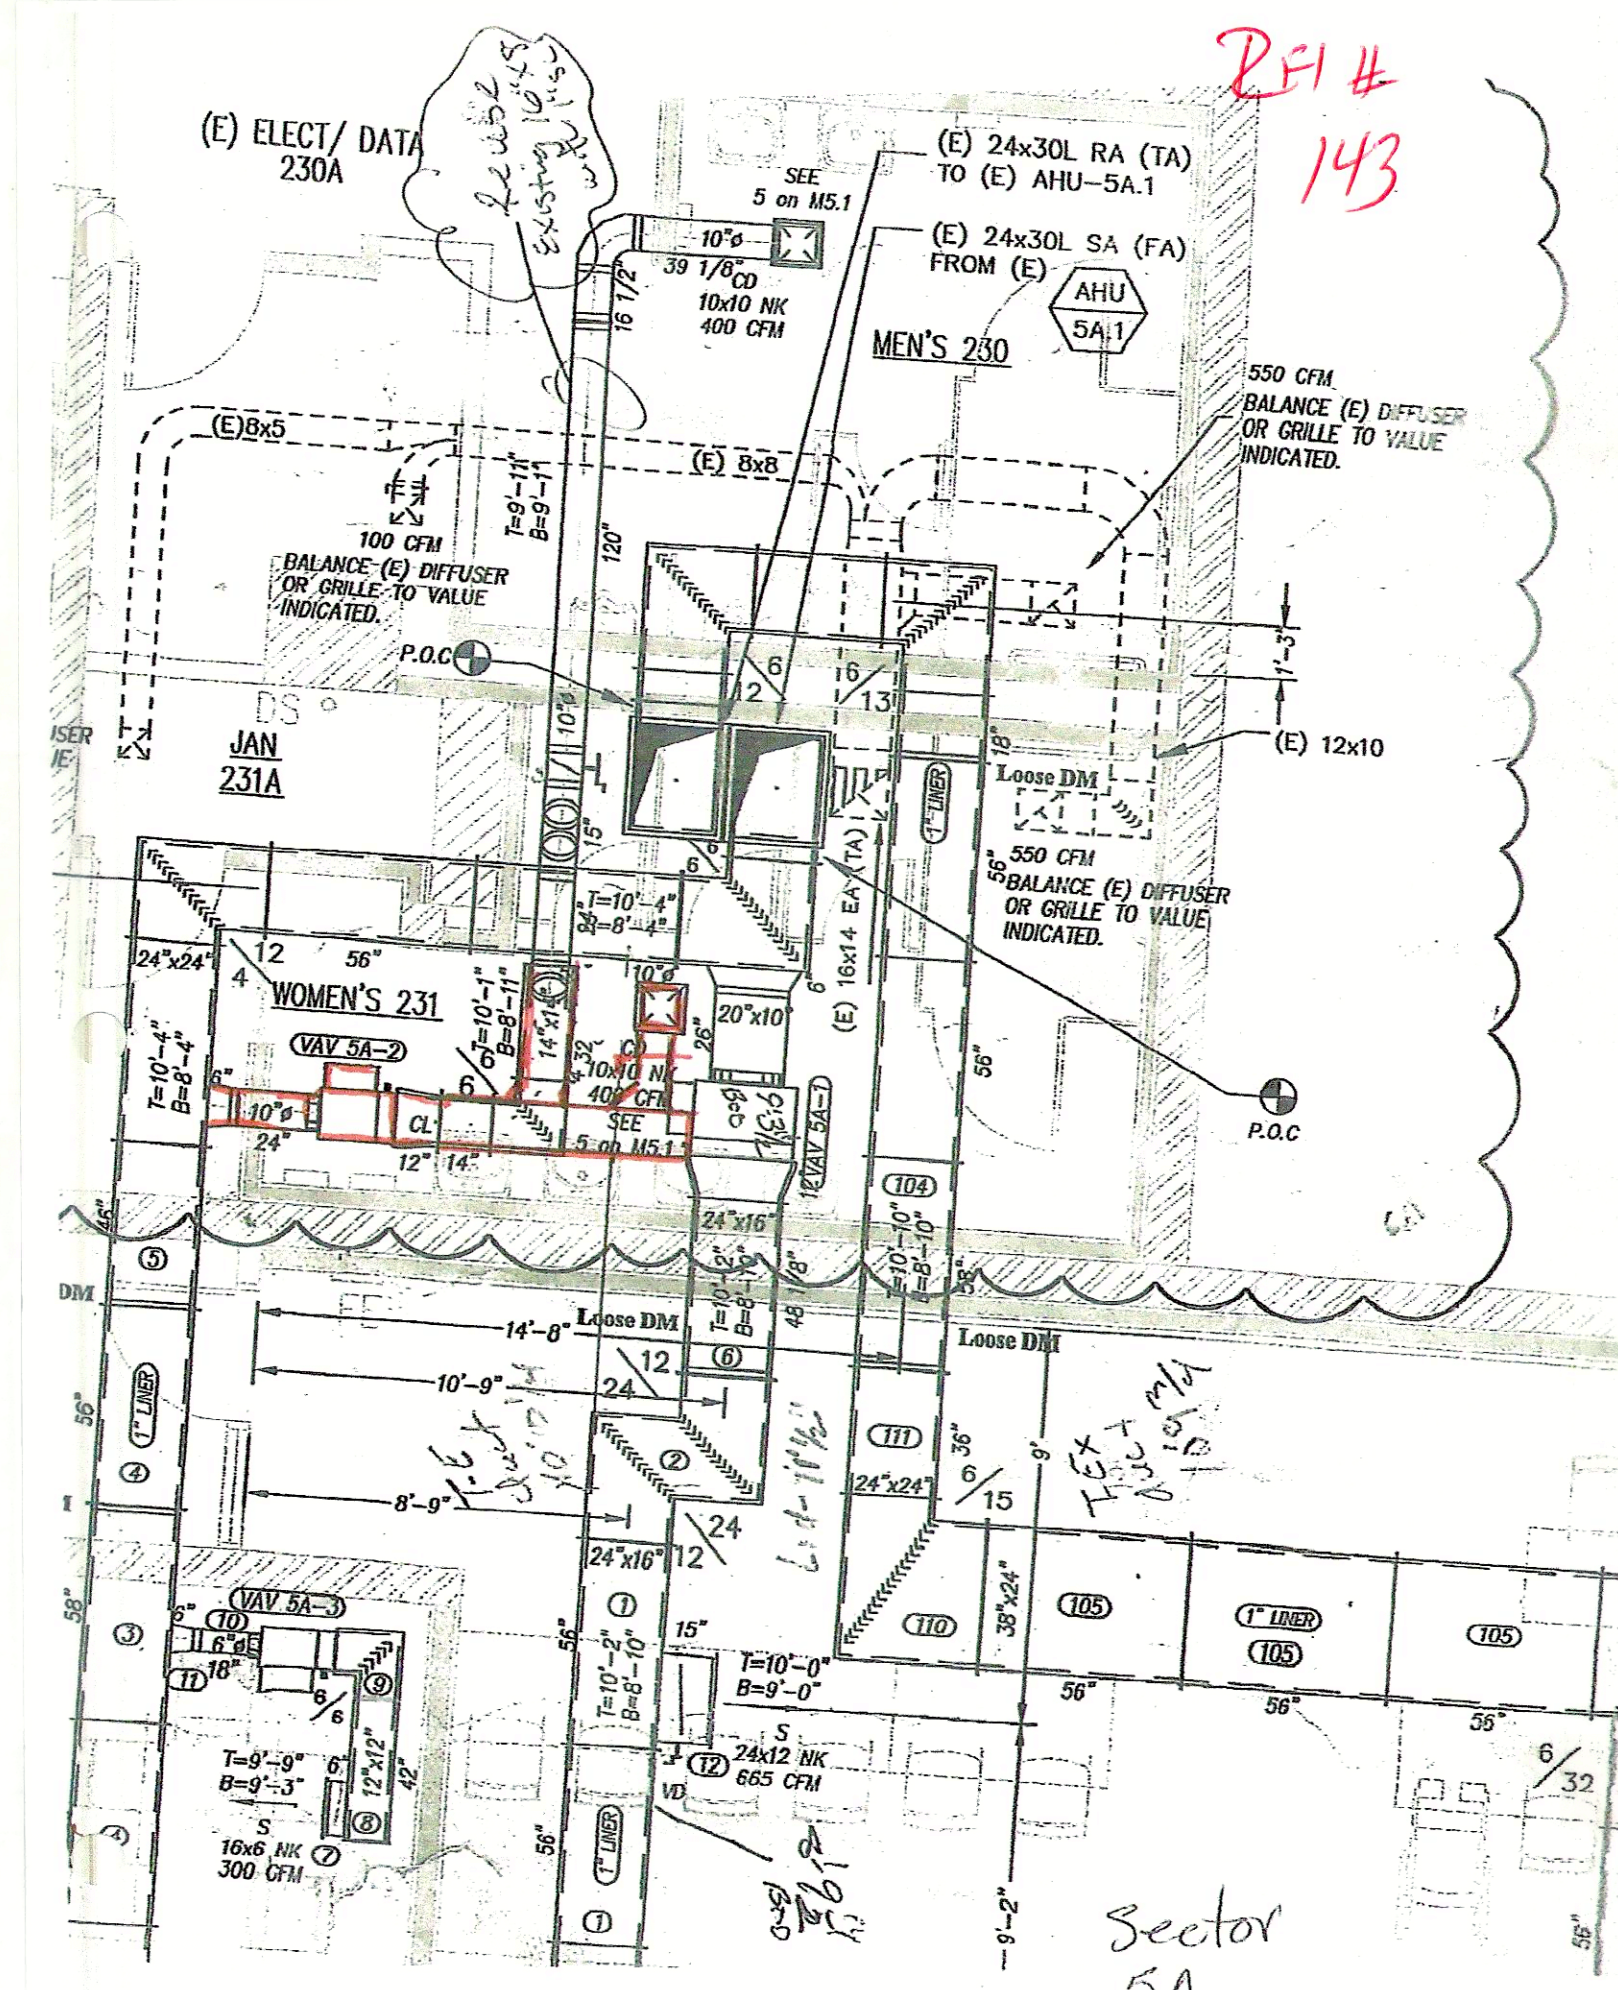

QC
INI %

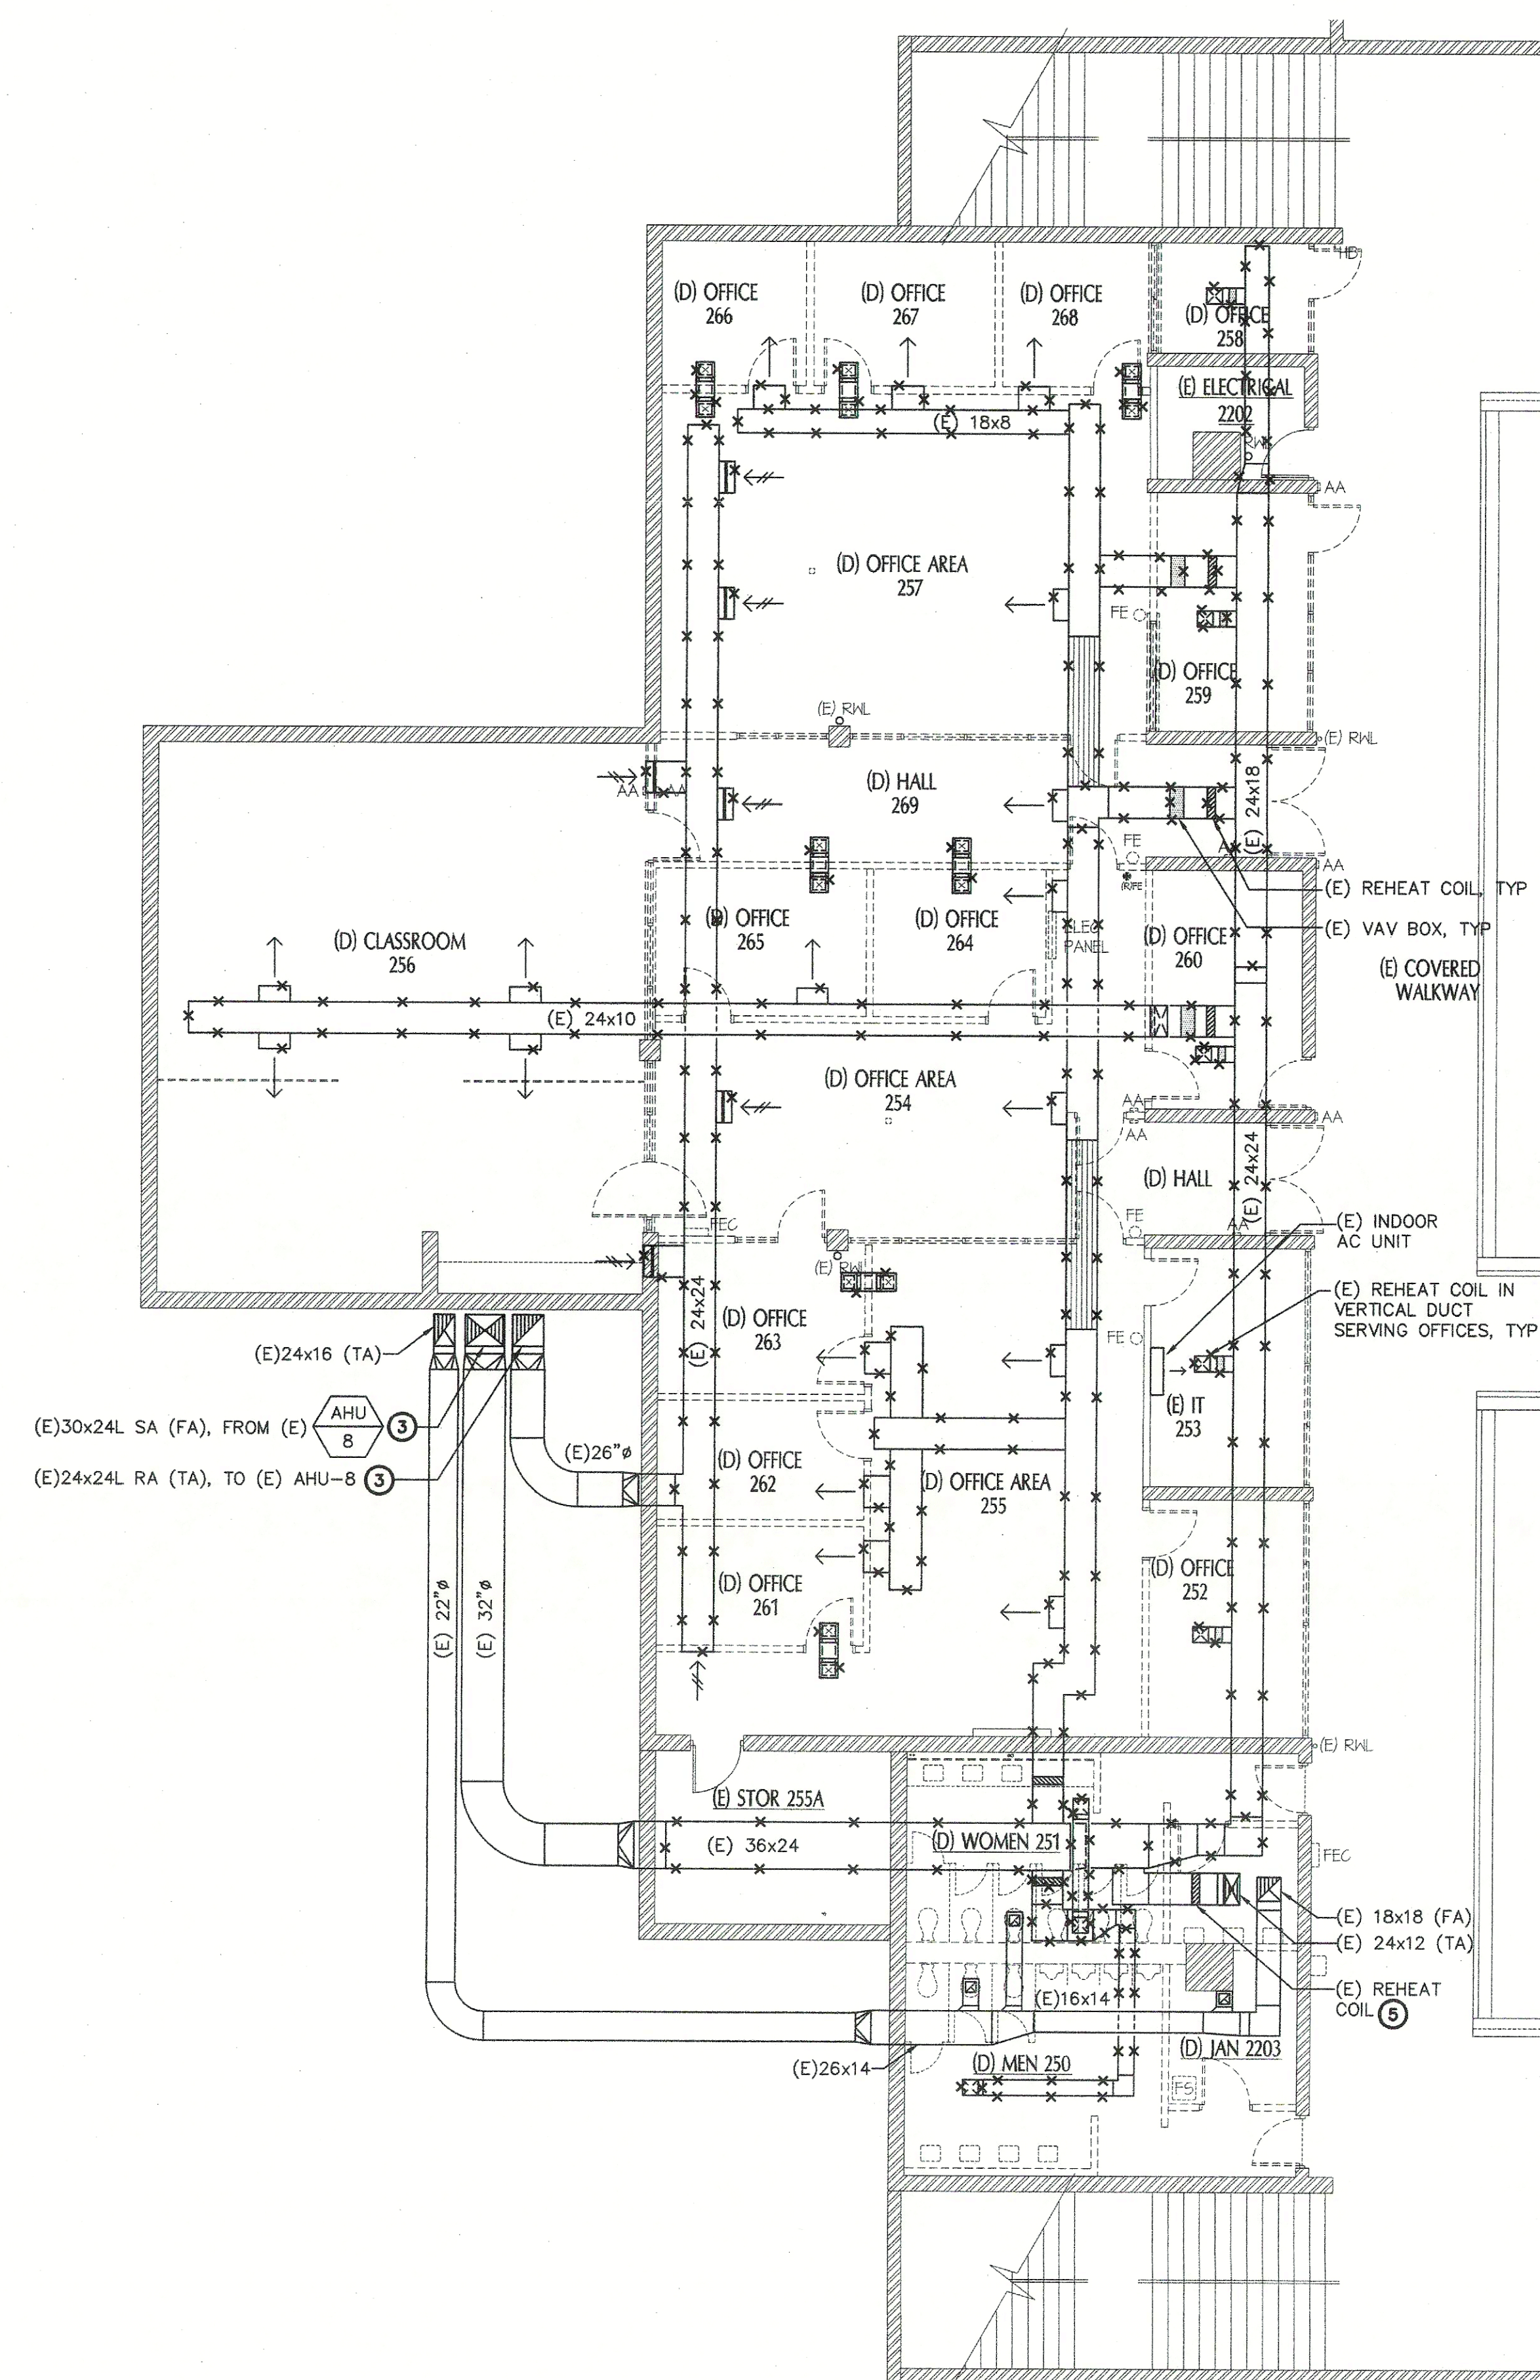

HVAC DEMO FLOOR PLAN - SECTOR 5B **1**
SCALE : 1/8" = 1'-0" **M1.0**

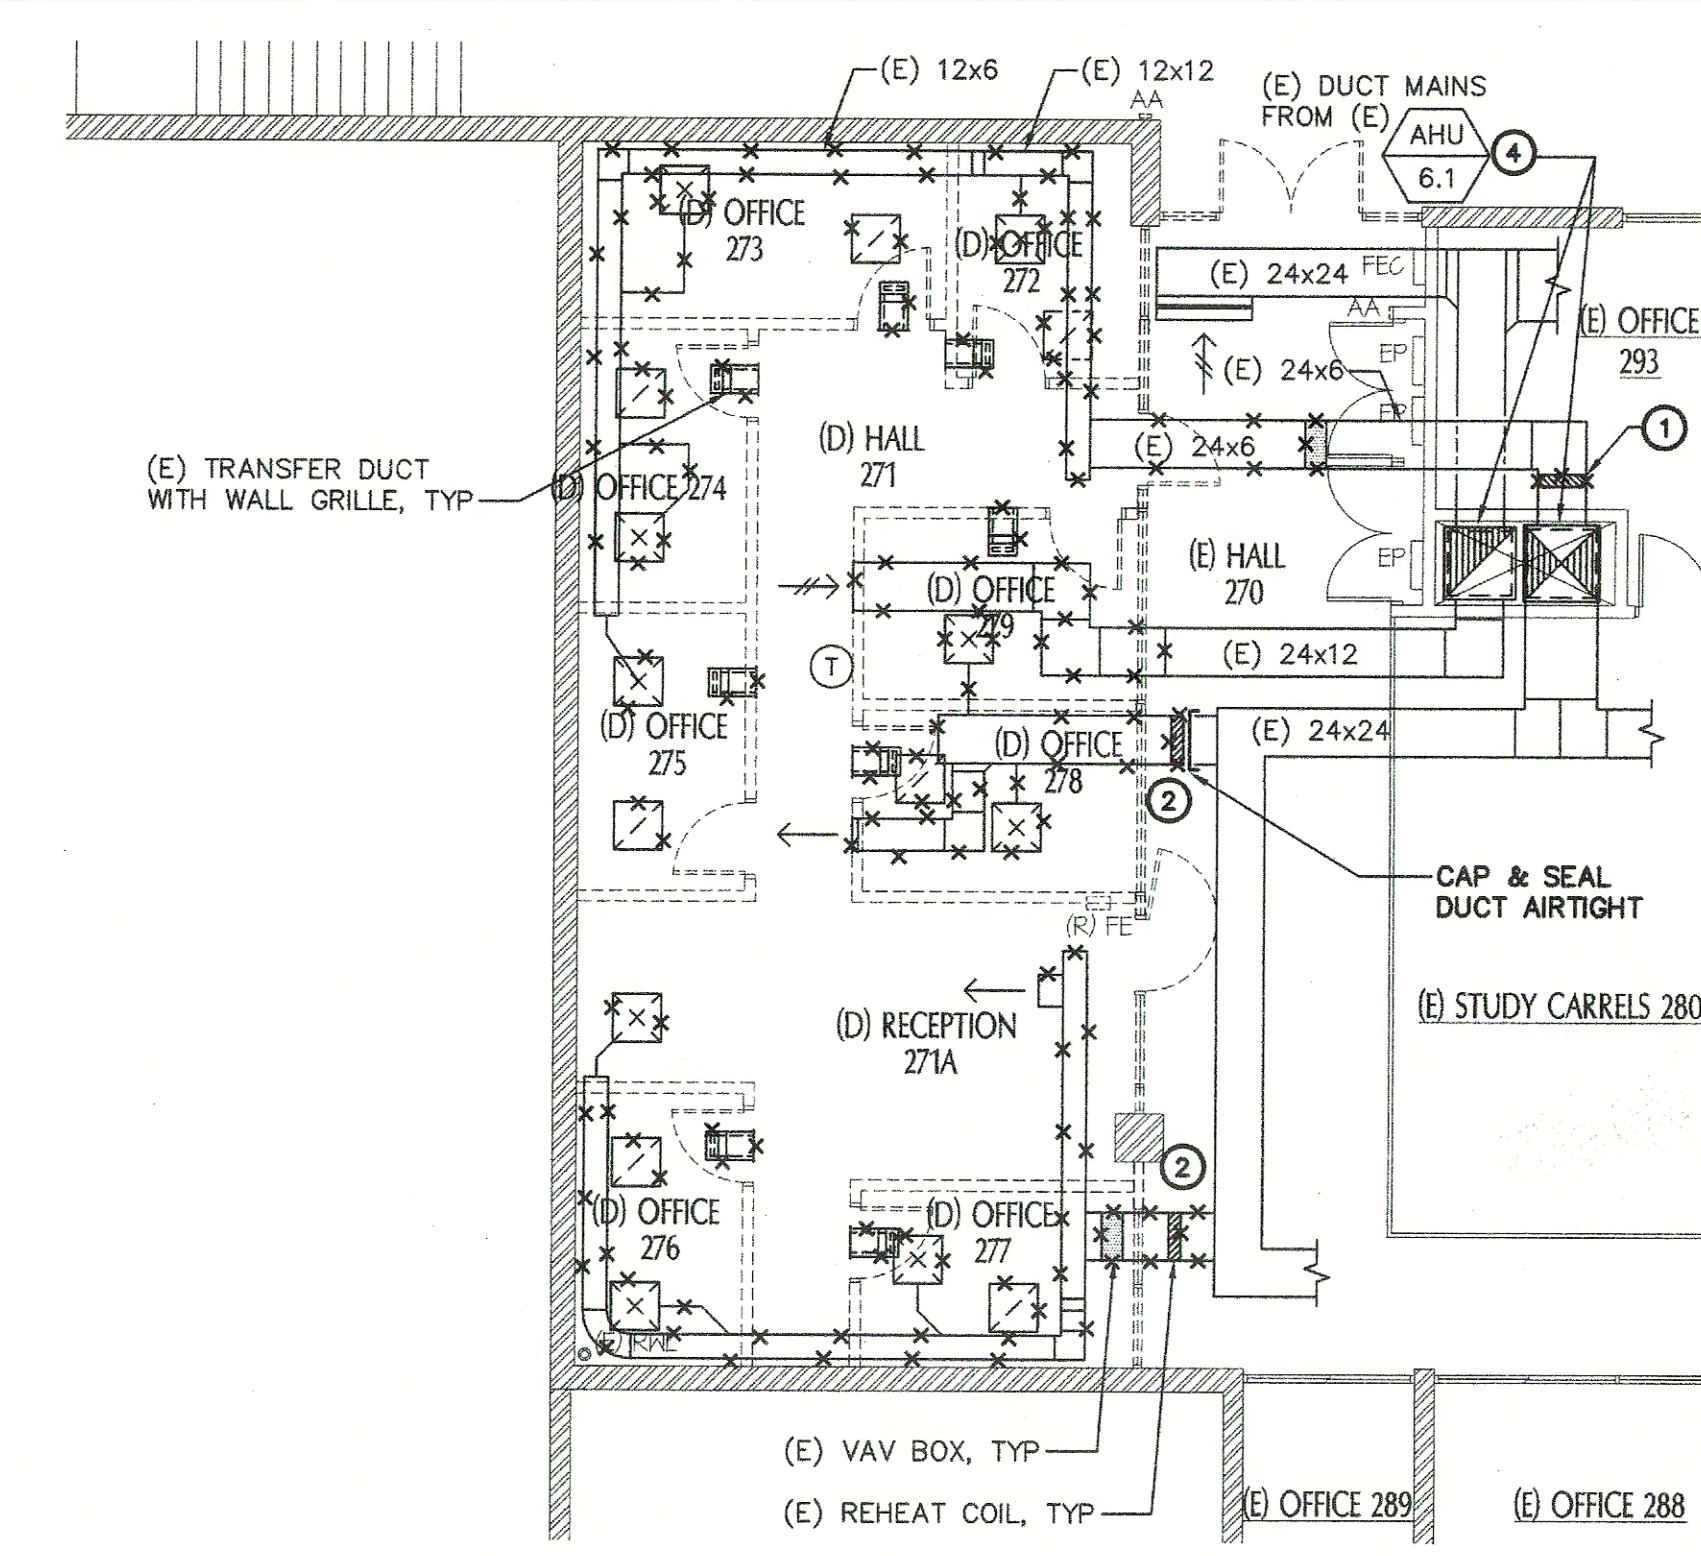


HVAC DEMO FLOOR PLAN - SECTOR 6 **3**
SCALE : 1/8" = 1'-0" **M1.0**

REF #143
Relocate
duct work in
Rm 200 / Re-use AHU 101
in main row

- SHEET NOTES:**
- 1 REMOVE (E) REHEAT COIL AND PREPARE TO REPLACE WITH NEW LENGTH OF DUCT.
 - 2 EXISTING DUCT MAIN SERVES OTHER SPACES ADJACENT TO THE REMODEL AREA. SCHEDULE WORK THAT AFFECTS ADJACENT SPACES WITH THE OWNER PRIOR.
 - 3 (E) AHU-8 ALSO SERVES SECTOR 13 ON THE THIRD FLOOR ABOVE. SCHEDULE AC UNIT SHUTDOWN WITH THE OWNER PRIOR.
 - 4 (E) AHU-6.1 ALSO SERVES SECTOR 3 ON THE FIRST FLOOR BELOW. SCHEDULE AC UNIT SHUTDOWN WITH THE OWNER PRIOR.
 - 5 (E) REHEAT COIL SERVES THIRD FLOOR BATHROOM CORE ABOVE, TO REMAIN.

SHUTDOWN SCHEDULING NOTE:
THE DEMOLITION OF THE EXISTING DUCT SYSTEMS AFFECTS OTHER OCCUPIED AREAS WITHIN THE BUILDING. DURING CONSTRUCTION, NO MECHANICAL HEATING OR COOLING WILL BE AVAILABLE TO THE ADJACENT SPACES SERVED BY THE SAME SYSTEM. THE CONTRACTOR SHALL NEGOTIATE THE DURATION AND SPECIFIC TIME AND DATE OF ANY SYSTEM SHUTDOWN WITH THE DISTRICT. THE DISTRICT WILL NOTIFY ALL BUILDING USERS WHEN THIS WILL OCCUR. NOTIFY MAINTENANCE DEPARTMENT TWO WEEKS IN ADVANCE OF ANY MECHANICAL SYSTEM REDUCTION OR SHUTDOWN.

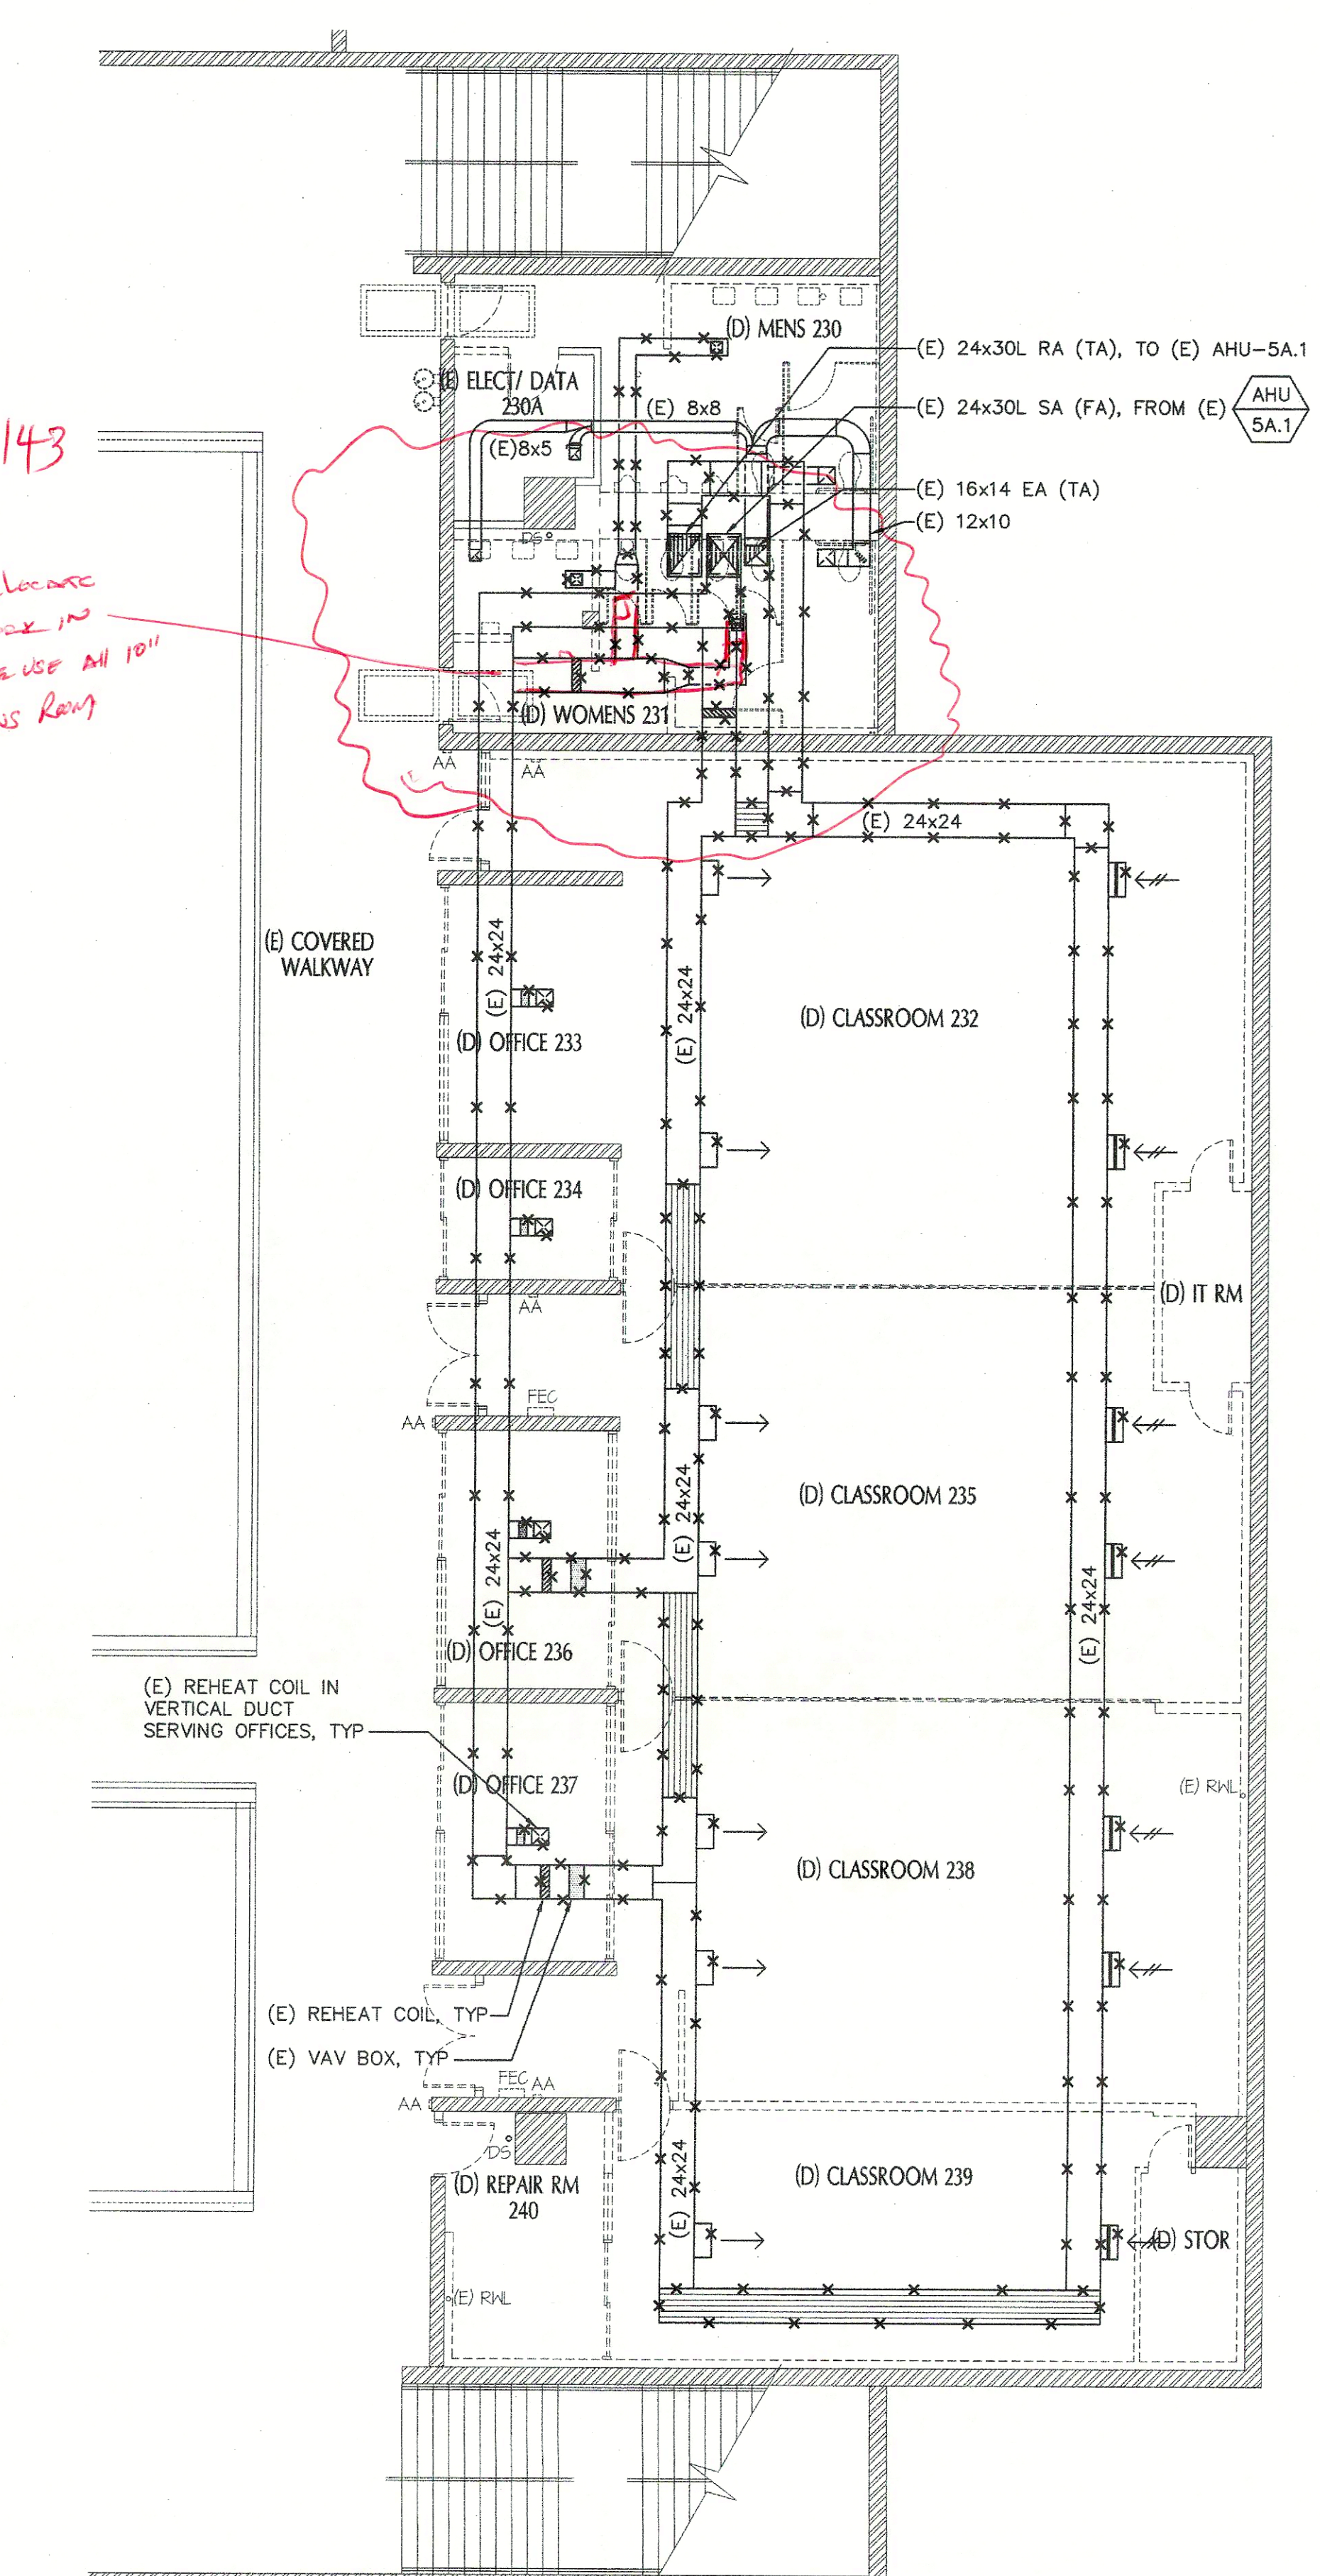

HVAC DEMO FLOOR PLAN - SECTOR 5A **2**
SCALE : 1/8" = 1'-0" **M1.0**

AS-BUILT


LEVEL 2 REMODEL
SECTORS 5A, 5B & 6
COLLEGE COMPLEX
LOS MEDANOS COLLEGE
2700 EAST LELAND DRIVE
PITTSBURG, CA 94565

owner


tBP project number :	2084200
file name:	
drawn by:	checked by:
date:	MAY 16, 2016
Rev. date:	description:
12/15/15	DSA SUBMITTAL
5/16/16	DSA
7/1/16	BID SET
12/09/16	Revised Bid Set

THIS DRAWING AND THE DESIGNS, SPECIFICATIONS, IDEAS AND OTHER INFORMATION CONTAINED HEREIN CONSTITUTE UNPUBLISHED WORK OF INVENTORSHIP AND SHALL REMAIN THE PROPERTY OF tBP/ARCHITECTURE IN PERPETUITY. NO PART THEREOF SHALL BE REPRODUCED, DISCLOSED, COPIED, OR OTHERWISE USED IN ANY MANNER WITHOUT THE WRITTEN CONSENT OF tBP/ARCHITECTURE.

drawing title:
HVAC DEMO FLOOR PLAN
drawing no:
M1.0
drawing of

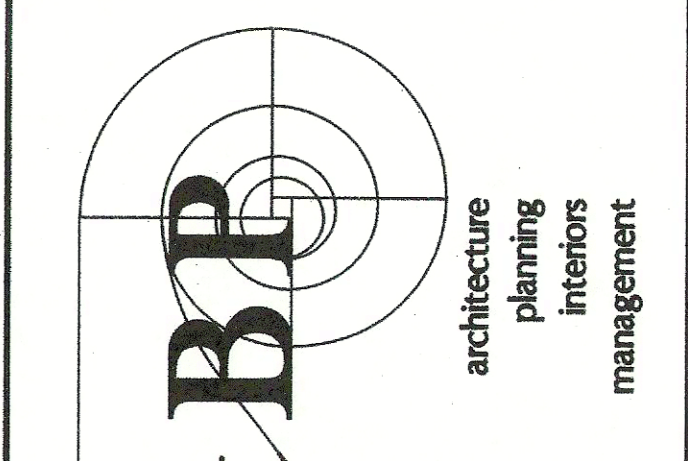

tBP/Architecture
1777 Oakland Avenue, Suite 220
Walnut Creek, CA 94596
ph: 925.246.6419
architect

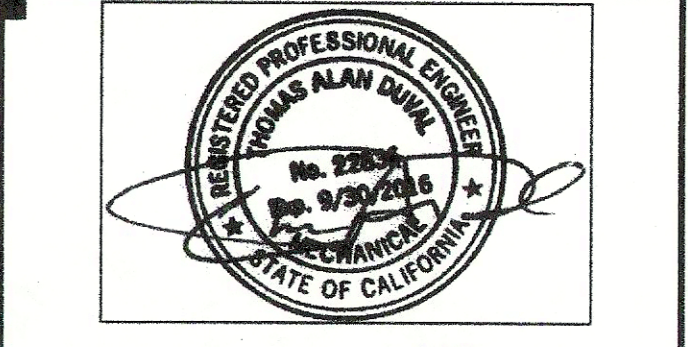

DATE SIGNED: 07/15/2016
CAPITAL
ENGINEERING CONSULTANTS, INC.
Reno, Oregon, California
TO: tBP/ARCHITECT
FROM: DESIGN TEAM
150225.00
PROJECT NO.
consultant

Division of the State Architect
1515 Clay Street, Suite 1201
Oakland, Ca, 94612
ph: (510) 622-3101
agency

RFI #160 2/1/20

RFI # 160
L-640 College Complex Remodel
2006 CIP/LMC - Los Medanos College
2006 CIP

Printed 08/24/2017, Page 1 of 4

HVAC HW Connection for Sector 5A	Submitted : 08/23/2017 Submitted To: Critical Solutions, Inc., W A Thomas Status: Pending Priority: Critical Due Date: 08/28/2017 Pending On Org: tBPI/Architecture, Inc.
Created By: W A Thomas, Jim Smith Created: 08/23/2017	

The due date will automatically be set at 14 calendar days from submission. Use the Requested Response Date field to request a different turnaround time.
Requested Response Date: 08/25/2017

Request:
Reference is made to HVAC Piping plan 2/M2.0 on M2.1. The point of connection to the existing how water piping is shown in room 230. After extensive investigation, it appears that the existing piping at this location is not active and has been disconnected at a point further down the line. capped pipes were located and believed to have been done with the new Student Services project. Please indicate how we are to proceed.

Suggestion:

Note to Contractor: This Form Cannot Modify Contract Amount or Milestones and/or Contract Time.

References
Drawing M2.1 Published


Files
Images continued on next page.
Per telecon with Danny Dosier with Martinez Sheetmetal this morning there are live 1 1/4" HW lines coming down from the roof with isolation valves at the roof and terminating in Womens 231 with caps. Contractor to tie into the HW piping in Womens 231 to provide HW supply and return in Sector 5A. Demo abandoned existing piping to avoid any confusion in the future.

Bob Sanchez CEO 8/25/17

RFI #160


RFI # 160
L-640 College Complex Remodel
2006 CIP/LMC - Los Medanos College
2006 CIP

Printed 08/24/2017, Page 2 of 4


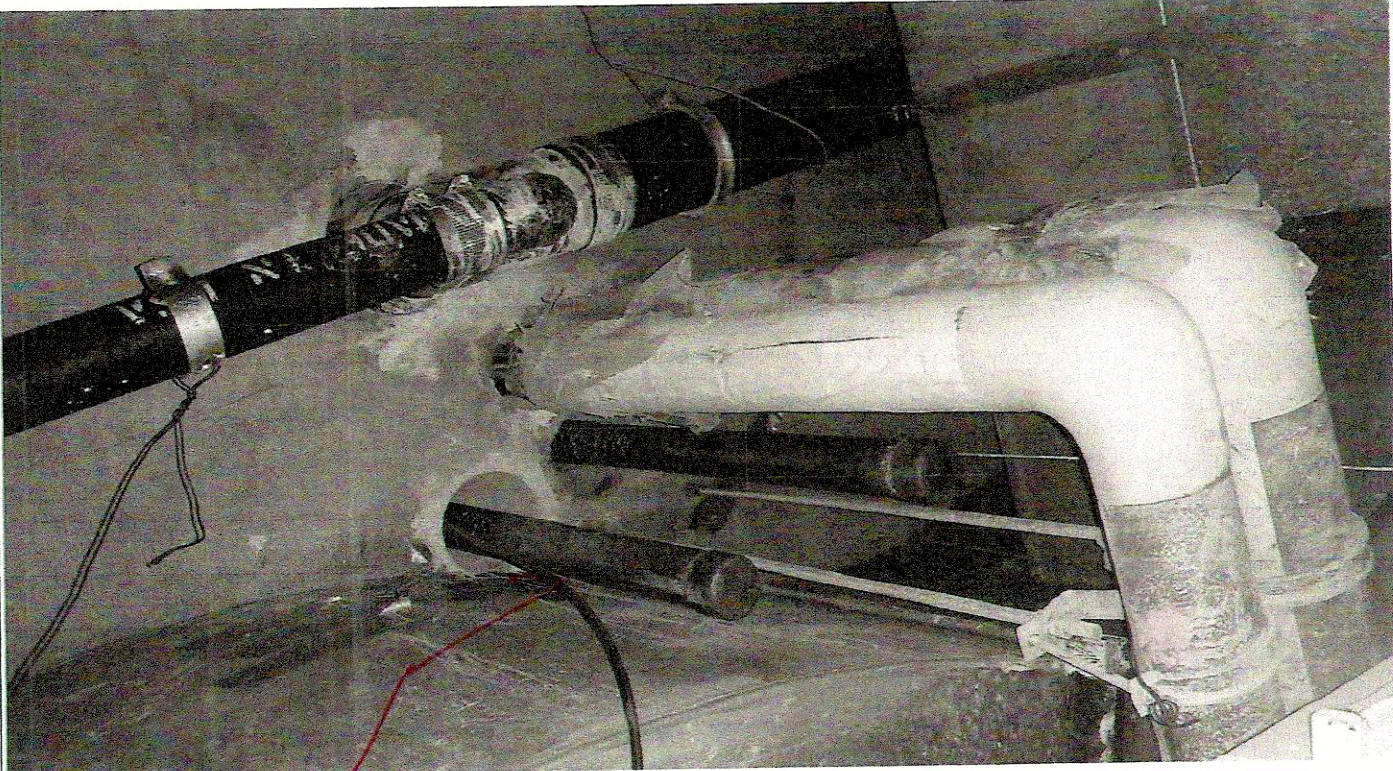



New Connection
PIPES

CE17073 Sector 5A HW picture #03.jpg

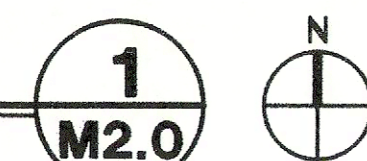

- RFI # 160
HVAC HW CONNECTION

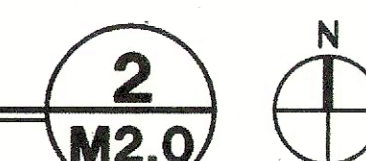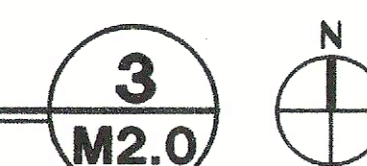

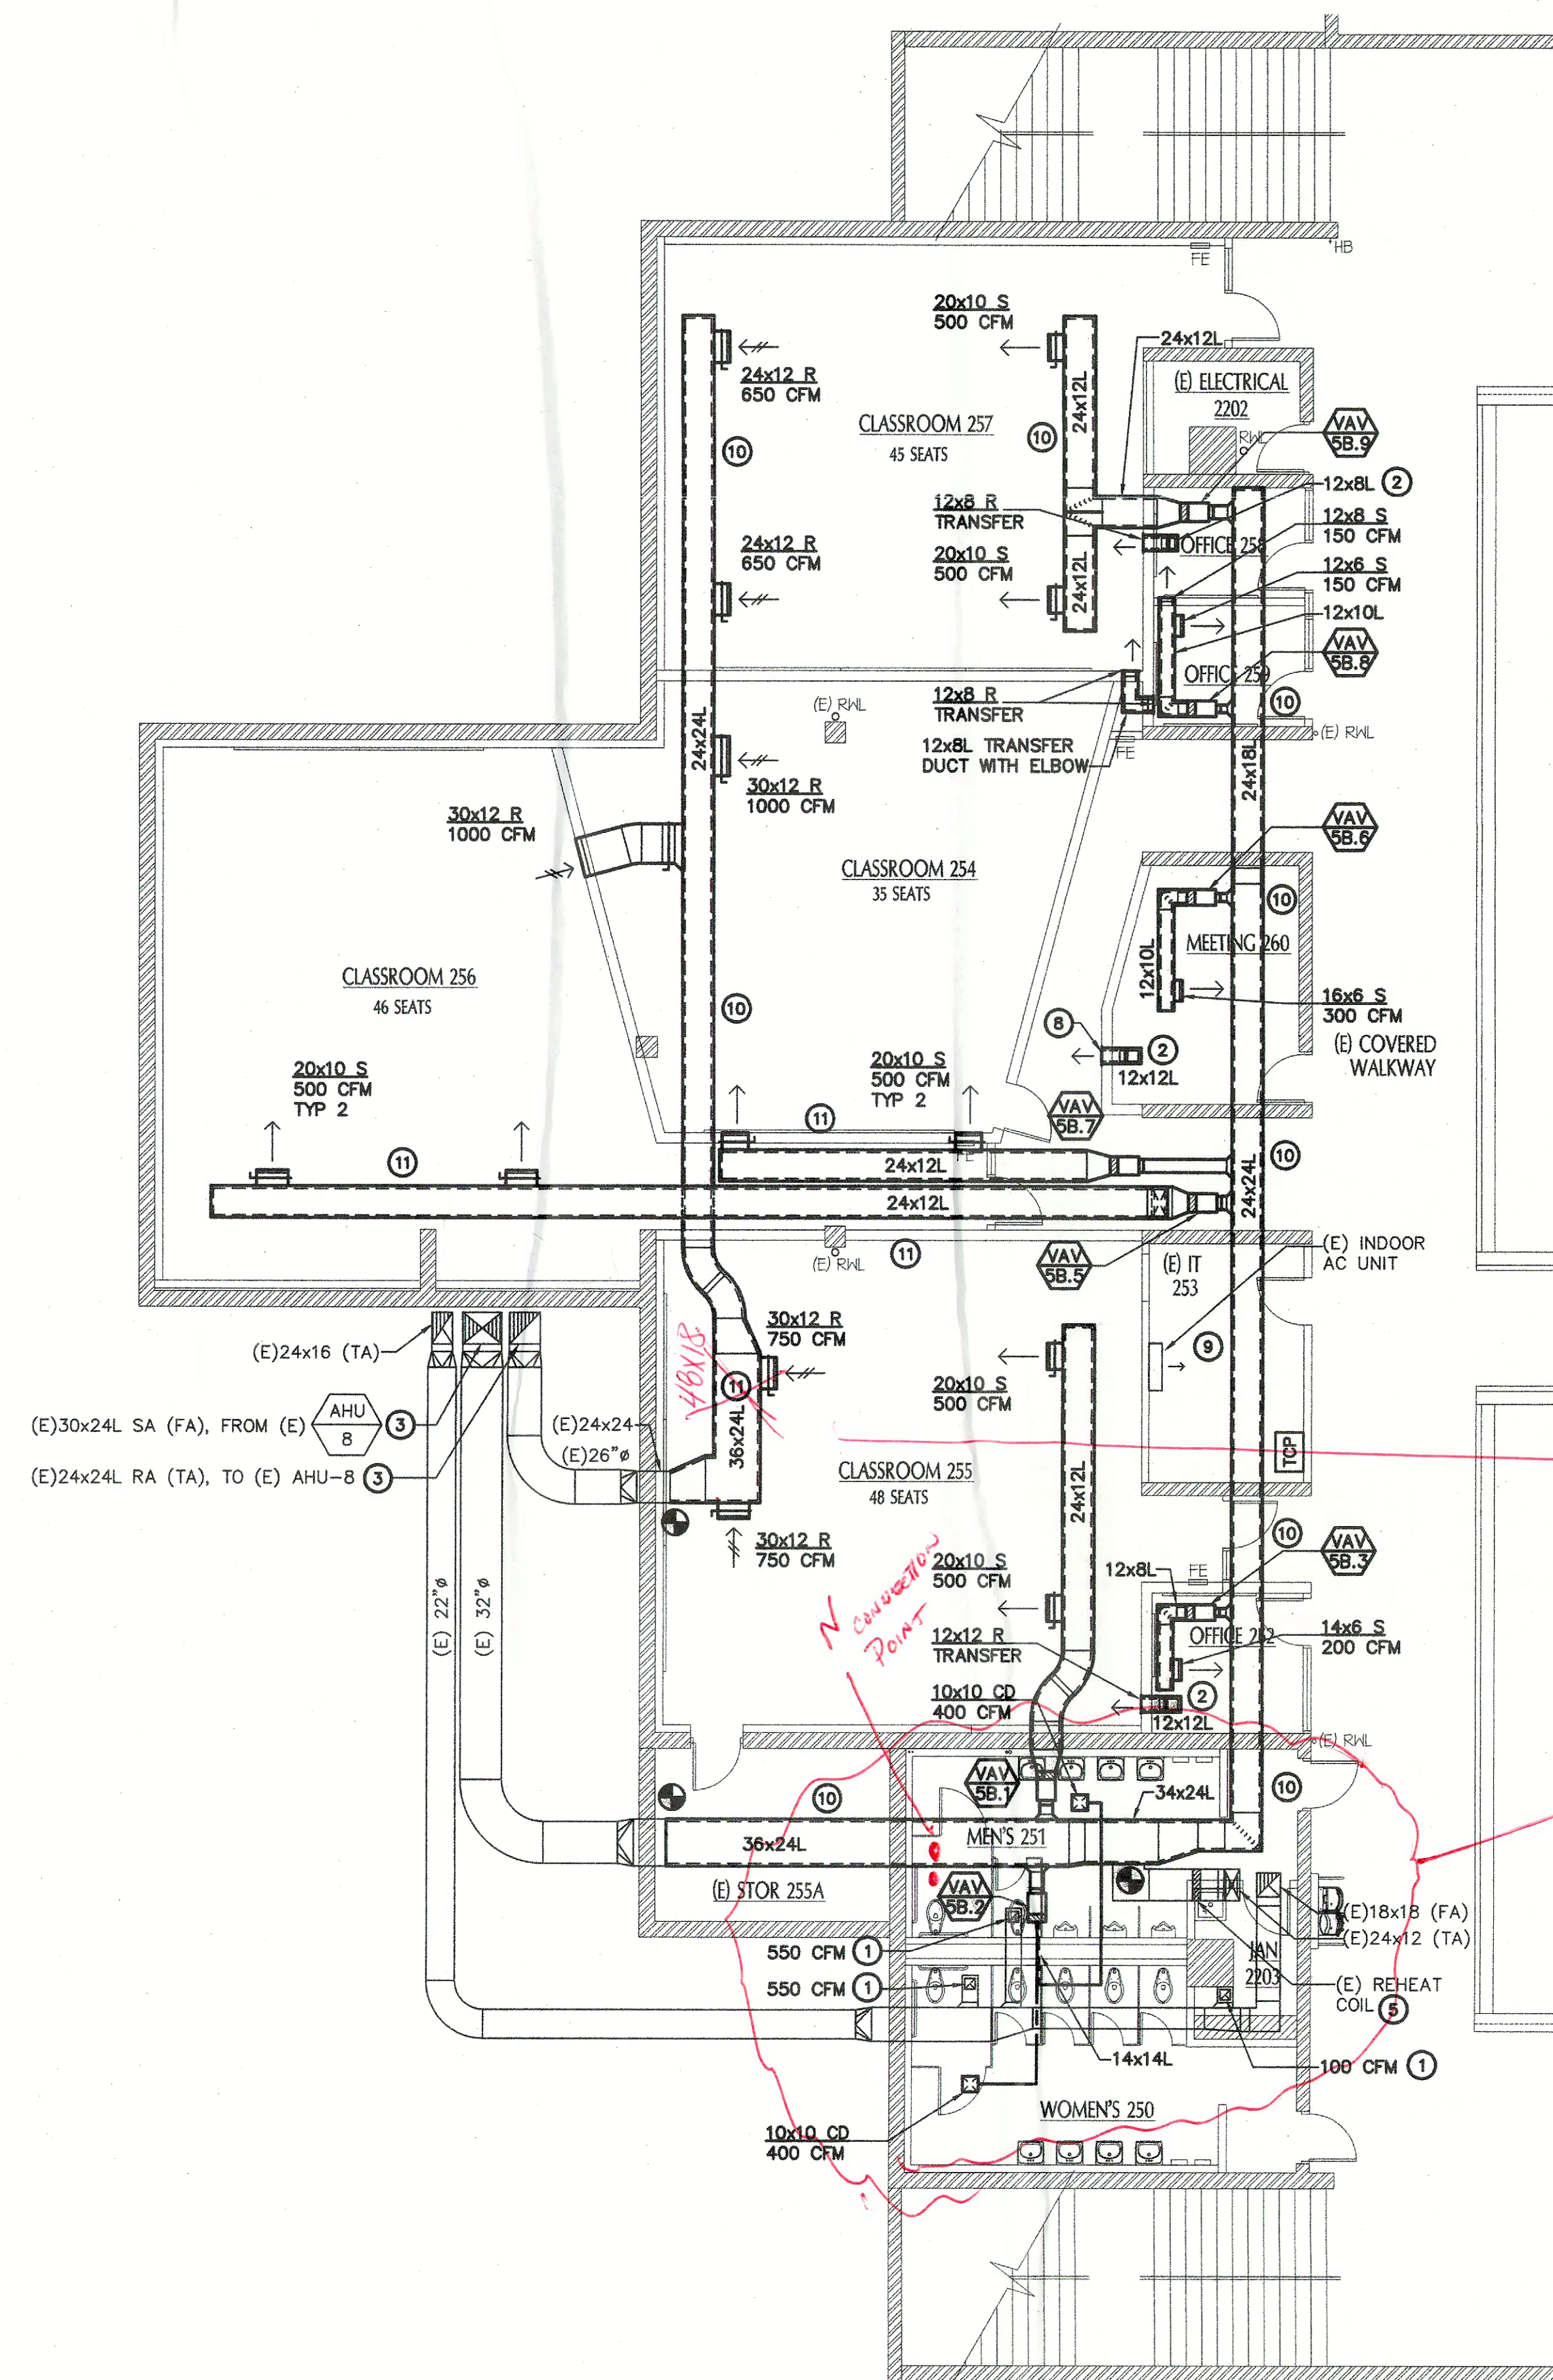


HVAC FLOOR PLAN - SECTOR 5B
SCALE: 1/8" = 1'-0"

- GENERAL NOTES:**
- SEE TABLE OF DUCT SIZES ON SHEET M0.1 FOR SIZE OF BRANCH DUCTS TO INDIVIDUAL DIFFUSERS, REGISTERS & GRILLES SHOWN ON PLAN UNLESS THE DUCT SIZE IS SHOWN ON THE FLOOR PLAN.
 - SEE TERMINAL UNIT SCHEDULE ON SHEET M0.2 FOR VAV BOX SIZES. SIZE OF DUCT SHOWN TO TERMINAL UNIT SHALL BE THE BOX INLET SIZE AS SCHEDULED UNLESS NOTED OTHERWISE ON FLOOR PLAN.
 - REFER TO M2.1 FOR THERMOSTAT LOCATIONS.
 - PAINT EXPOSED DUCT. REFER TO ARCHITECTURAL DRAWINGS.


- SHEET NOTES:**
- BALANCE (E) DIFFUSER OR GRILLE TO VALUE INDICATED.
 - TRANSFER BOOT, SEE DETAIL 10/M5.1.
 - (E) AHU-8 ALSO SERVES SECTOR 13 ON THE THIRD FLOOR ABOVE. SCHEDULE AC UNIT SHUTDOWN WITH THE OWNER PRIOR.
 - (E) AHU-6.1 ALSO SERVES SECTOR 3 ON THE FIRST FLOOR BELOW. SCHEDULE AC UNIT SHUTDOWN WITH THE OWNER PRIOR.
 - (E) REHEAT COIL THAT SERVES THIRD FLOOR BATHROOM CORE TO REMAIN. MAINTAIN THE SAME AIRFLOW TO THE SPACE THAT WAS PROVIDED PRIOR TO CONSTRUCTION.
 - REFRIGERANT PIPING, REFER TO SCHEDULE FOR SIZES. ROUTE TO OUTDOOR UNIT SCU-5A.1.
 - DECORATIVE DUMMY DUCT SECTION. SIZE SHALL BE THE SAME AS THE ADJACENT DUCT. SUPPORTS AND BRACING SHALL BE THE SAME AS OTHER DUCTS.
 - 12x12 RELIEF AIR LOUVER.
 - IT ROOM 253 MUST REMAIN FULLY OPERATIONAL THROUGHOUT CONSTRUCTION. CAREFULLY COORDINATE CONSTRUCTION WORK TIME WITHIN THE ROOM WITH DISTRICT. ENSURE THAT EQUIPMENT REMAINS UNDISTURBED DURING WORK.
 - DUCT MAIN (SAME SIZE OR SMALLER THAN THE (E) DUCT REMOVED) MOUNTED TO (E) SUPPORT, REFER TO DETAIL 8/M5.1.
 - DUCT MAIN MOUNTED TO NEW SUPPORT, REFER TO DETAIL 9/M5.1.

Duct work re-confirmed size/shape see ASI #5


RFA #1610 HVAC HW connection

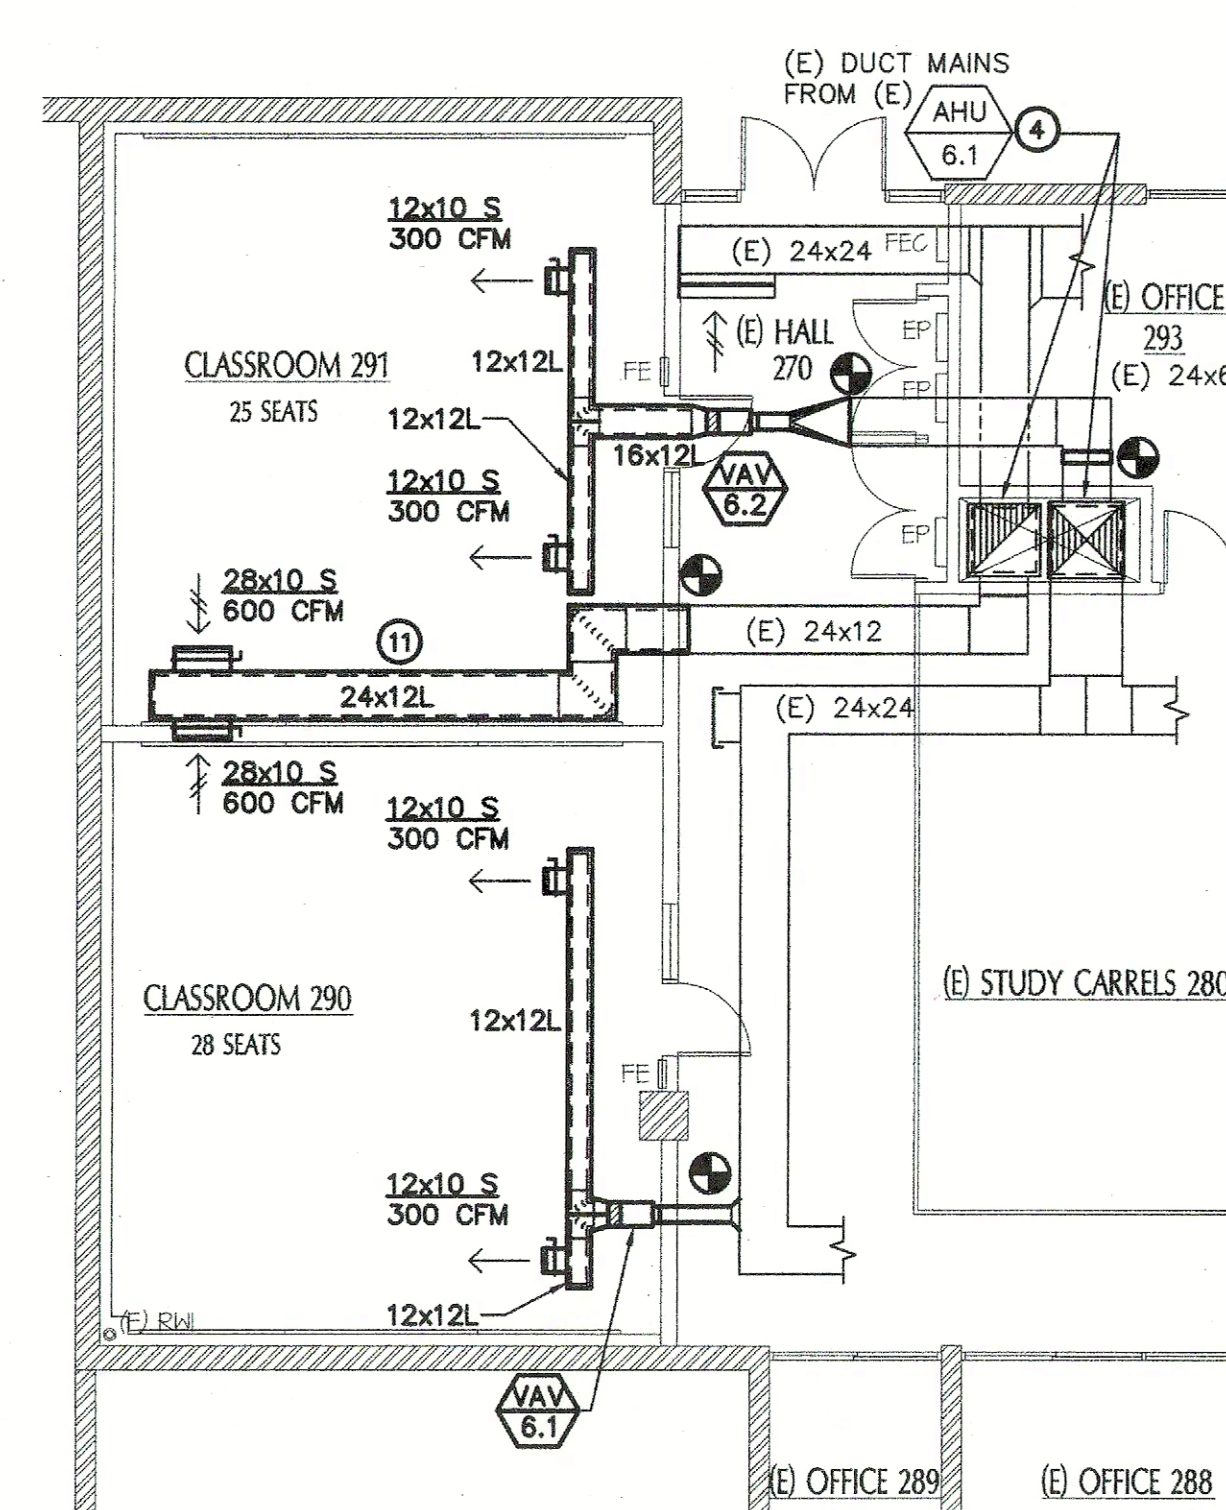

HVAC FLOOR PLAN - SECTOR 6
SCALE: 1/8" = 1'-0"

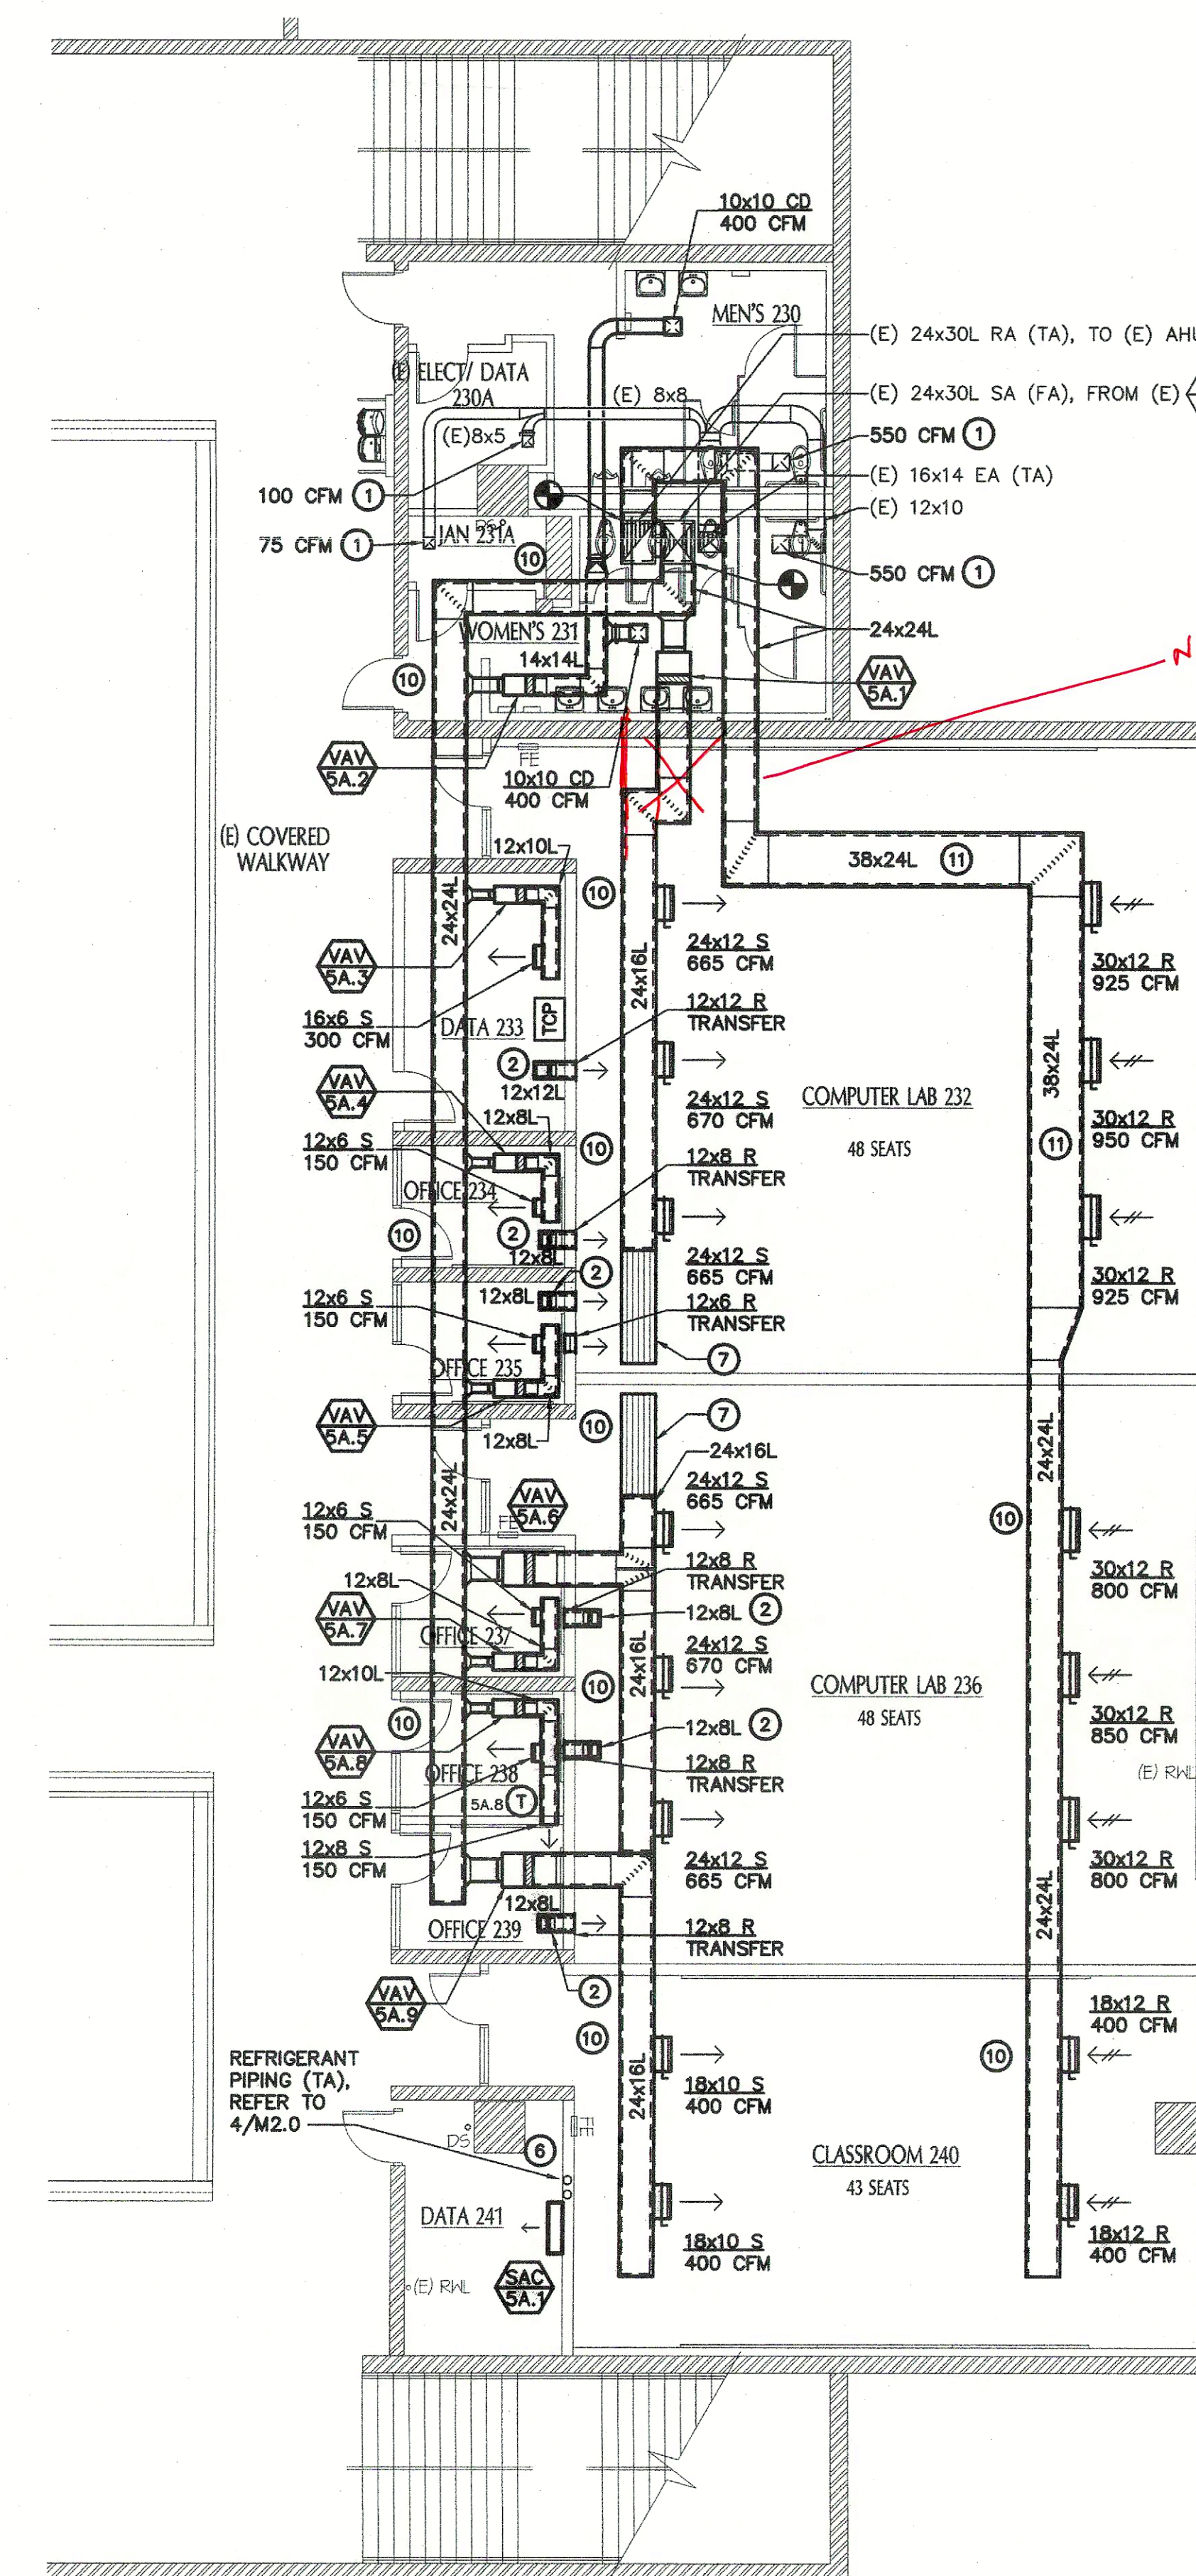

HVAC FLOOR PLAN - SECTOR 5A
SCALE: 1/8" = 1'-0"

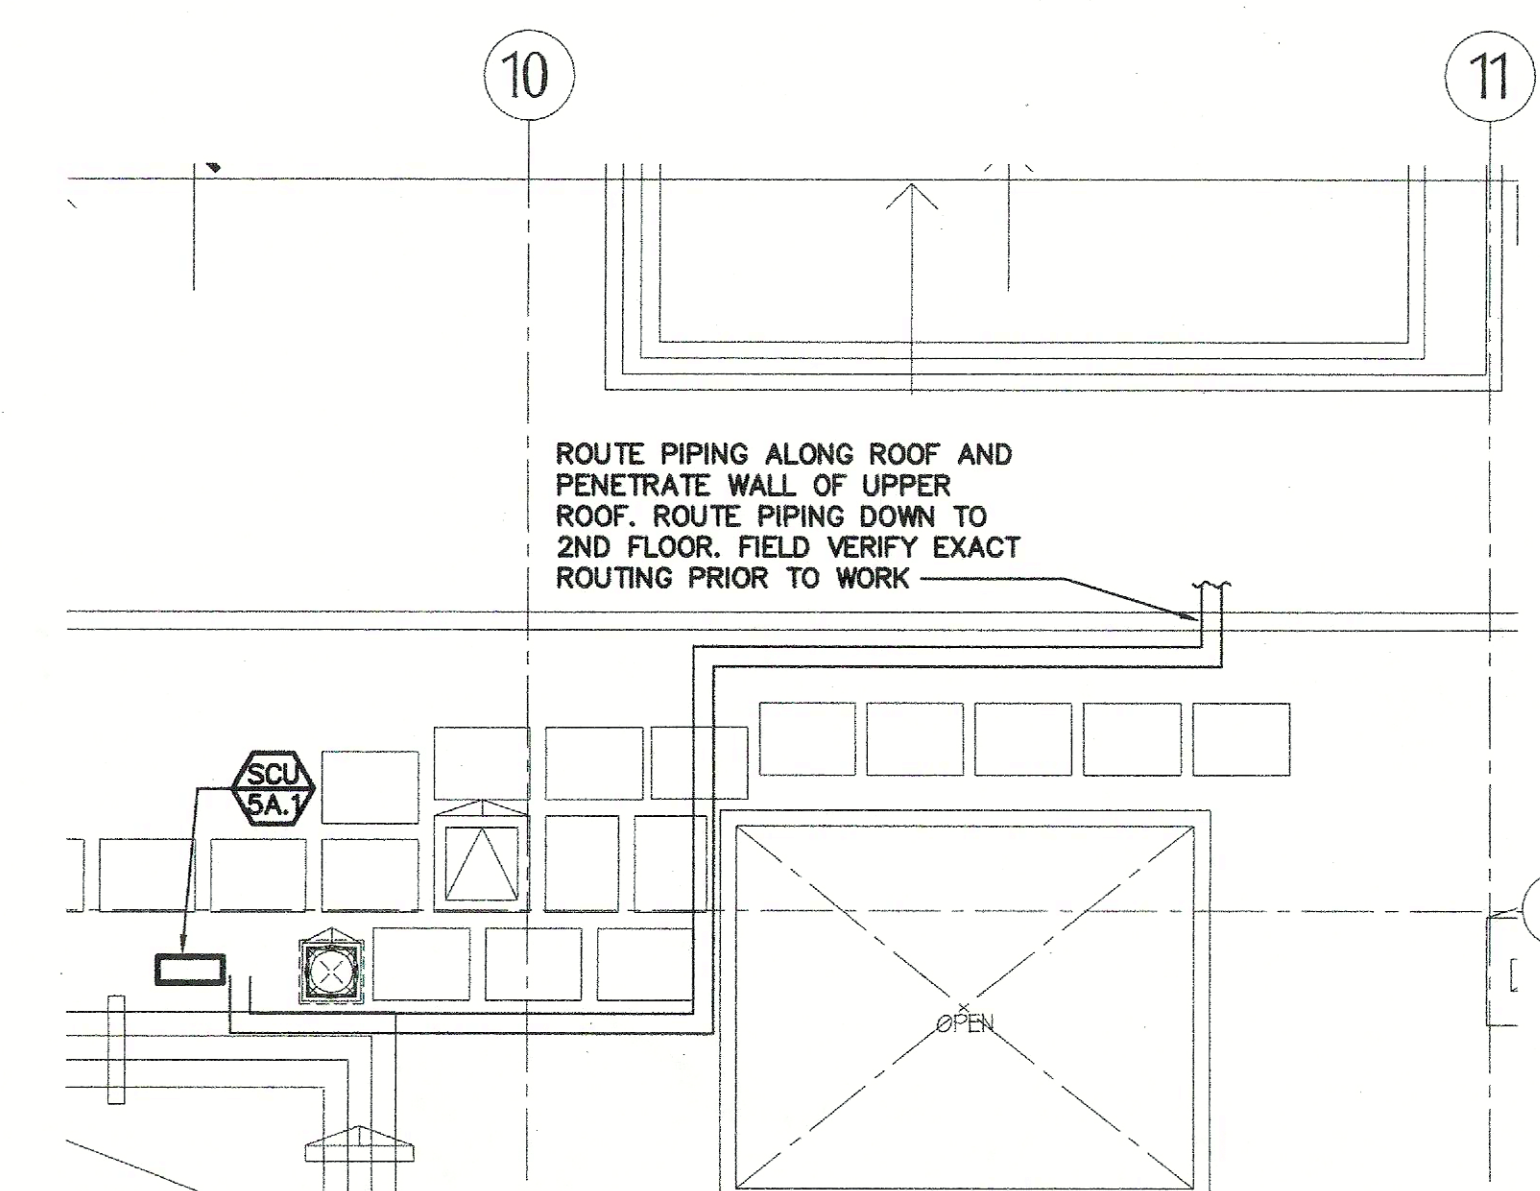

HVAC ROOF PLAN - SECTOR 5A
SCALE: 1/8" = 1'-0"

**LEVEL 2 REMODEL
SECTORS 5A, 5B & 6
COLLEGE COMPLEX**
LOS MEDANOS COLLEGE
2700 EAST ISLAND DRIVE
PITTSBURG, CA 94565

tBP project number:	2084200
file name:	
drawn by:	checked by:
date:	MAY 16, 2016
Rev. date:	description:
12/15/15	DSA SUBMITTAL
5/16/16	DSA
1/1/16	BID SET
12/09/16	Revised Bid Set

drawing title:
HVAC FLOOR PLAN
drawing no:
M2.0
drawing of

tBP
architecture
planning
interiors
management
tBP/Architecture
1000 Burnett Avenue Suite 320
Concord, CA 94520
ph: 925.246.6419 fax: 925.246.6495
architect

CAPITAL
ENGINEERING CONSULTANTS, INC.
RANCHO CALICO, CALIFORNIA
10 - 10/16/16
10/22/16
PROJECT NO.
consultant

Division of the State Architect
1515 Clay Street, Suite 1201
Oakland, Ca, 94612
ph: (510) 622-3101
agency



RFI #152

Subject: IBP/Architecture, Inc. Response to RFI # 152
Status: Pending
Created By: IBP/Architecture, Inc. Felix Canan
Type: Final

Response: Bracing may be installed to wall or deck per 14/A7.3 (see attached marked up photo)

Files: IBP/Architecture
Exe: VP
8/3/17
172.48 KB
Pages from MSM RFI_0X_080317.pdf

RFI # 152 Response # 1

L-640 College Complex Remodel
2006 CIP/LMC - Los Medanos College
2006 CIP

Printed 08/04/2017, Page 1 of 1

RFI #152

Response: Use 3"x3"x1/4"x 0"x6" angle.
Bob Barceon, CECT 5/23/17

Request: Please refer to attached Martinez Sheet Metal RFI # 04 dated 5/22/2017. Please clarify required angle clip shown in detail 4/A5.1

Suggestion: Note to Contractor: This Form Cannot Modify Contract Amount or Milestones and/or Contract Time.

References: Drawing MS.1
Published

Files: MSM Hanger RFI#4 062217.pdf 420.89 KB

RFI # 110

L-640 College Complex Remodel
2006 CIP/LMC - Los Medanos College
2006 CIP

Printed 05/22/2017, Page 1 of 1

Submitted: 05/22/2017
Submitted To: Critical Solutions, Inc. W.A. Thomas
Status: Pending
Priority: Medium
Due Date: 05/24/2017
Pending On User: Felix Canan
Pending On Org: IBP/Architecture, Inc.

Created By: W.A. Thomas, Jim Smith
Created: 05/22/2017

RFI #110 4/MS.1

REQUEST FOR INFORMATION

COMMENTS: We need to know how we are to secure the VAV boxes where they are extremely close the walls and cannot be selected as noted on the drawings and specifications? Attached are pictures.

RESPONSE:

Answered By: _____
Date: _____

Category: ☒ Information not shown on contract documents
☐ Interpretation of contract documents
☐ Confusion problem
☐ Possible code conflict
☐ Other

Subject: Seismic supports

To: W.A. Thomas
From: Martinez Sheet Metal
Date: 8/3/2017

Project Name: LMC Section 5 & 6
Facility: D.C.A.
Priority: Routine
Urgent XXXX

Contract Drawing Ref: _____
Shop Drawing Ref: _____
Specification Ref: _____

Information Required: ASAP
Urgent XXXX



RFI # 152

L-640 College Complex Remodel
2006 CIP/LMC - Los Medanos College
2006 CIP

Printed 08/04/2017, Page 1 of 1

RFI #152

Request: Detail 8/A5.1 shows the Hill KB-1Z anchors installed inward from the vertical support. The existing support studs are centered on the concrete beam above with a stud/coupler connection (see attached photos). The existing support studs will need to be ground flush to make room. Question: what is the minimum distance needed between new and old anchors? Please advise. URGENT

Suggestion: Note to Contractor: This Form Cannot Modify Contract Amount or Milestones and/or Contract Time.

References: Drawing MS.1
Published

Files: Gobhan Akalan, S.E. 5/3/17

RFI # 95

L-640 College Complex Remodel
2006 CIP/LMC - Los Medanos College
2006 CIP

Printed 05/03/2017, Page 1 of 2

Submitted: 05/03/2017
Submitted To: Critical Solutions, Inc. Stefan Johnson, W.A. Thomas
Status: Pending
Priority: Critical
Due Date: 05/03/2017
Pending On User: Felix Canan
Pending On Org: IBP/Architecture, Inc.

Created By: W.A. Thomas, Mike Gutierrez
Created: 05/03/2017

RFI #95

RFI # 152 Response # 2

L-640 College Complex Remodel
2006 CIP/LMC - Los Medanos College
2006 CIP

Printed 08/18/2017, Page 1 of 1

RFI #152

Subject: W.A. Thomas Response to RFI # 152
Status: Pending
Created By: W.A. Thomas, Jim Smith
Type: Supplement

Response: There are approximately 6 locations where the seismic brace detail for the HVAC VAV boxes will not work, they are too close to a wall. This typically occurs in the smaller offices in sectors 5A and 5B. Martinez Sheet Metal is proposing to attach the boxes to the adjacent wall with Unistrut, similar to the installation shown in the attached picture. This picture is in room 252.

References: Drawing MS.1
Published












Files: RFI# 152.1 MSM Photo Bracing.jpg 101.34 KB
Gobhan Akalan IBP/Arch. 8/18/17

RFI # 95


L-640 College Complex Remodel
2006 CIP/LMC - Los Medanos College
2006 CIP

Printed 05/03/2017, Page 1 of 2



RFI #95

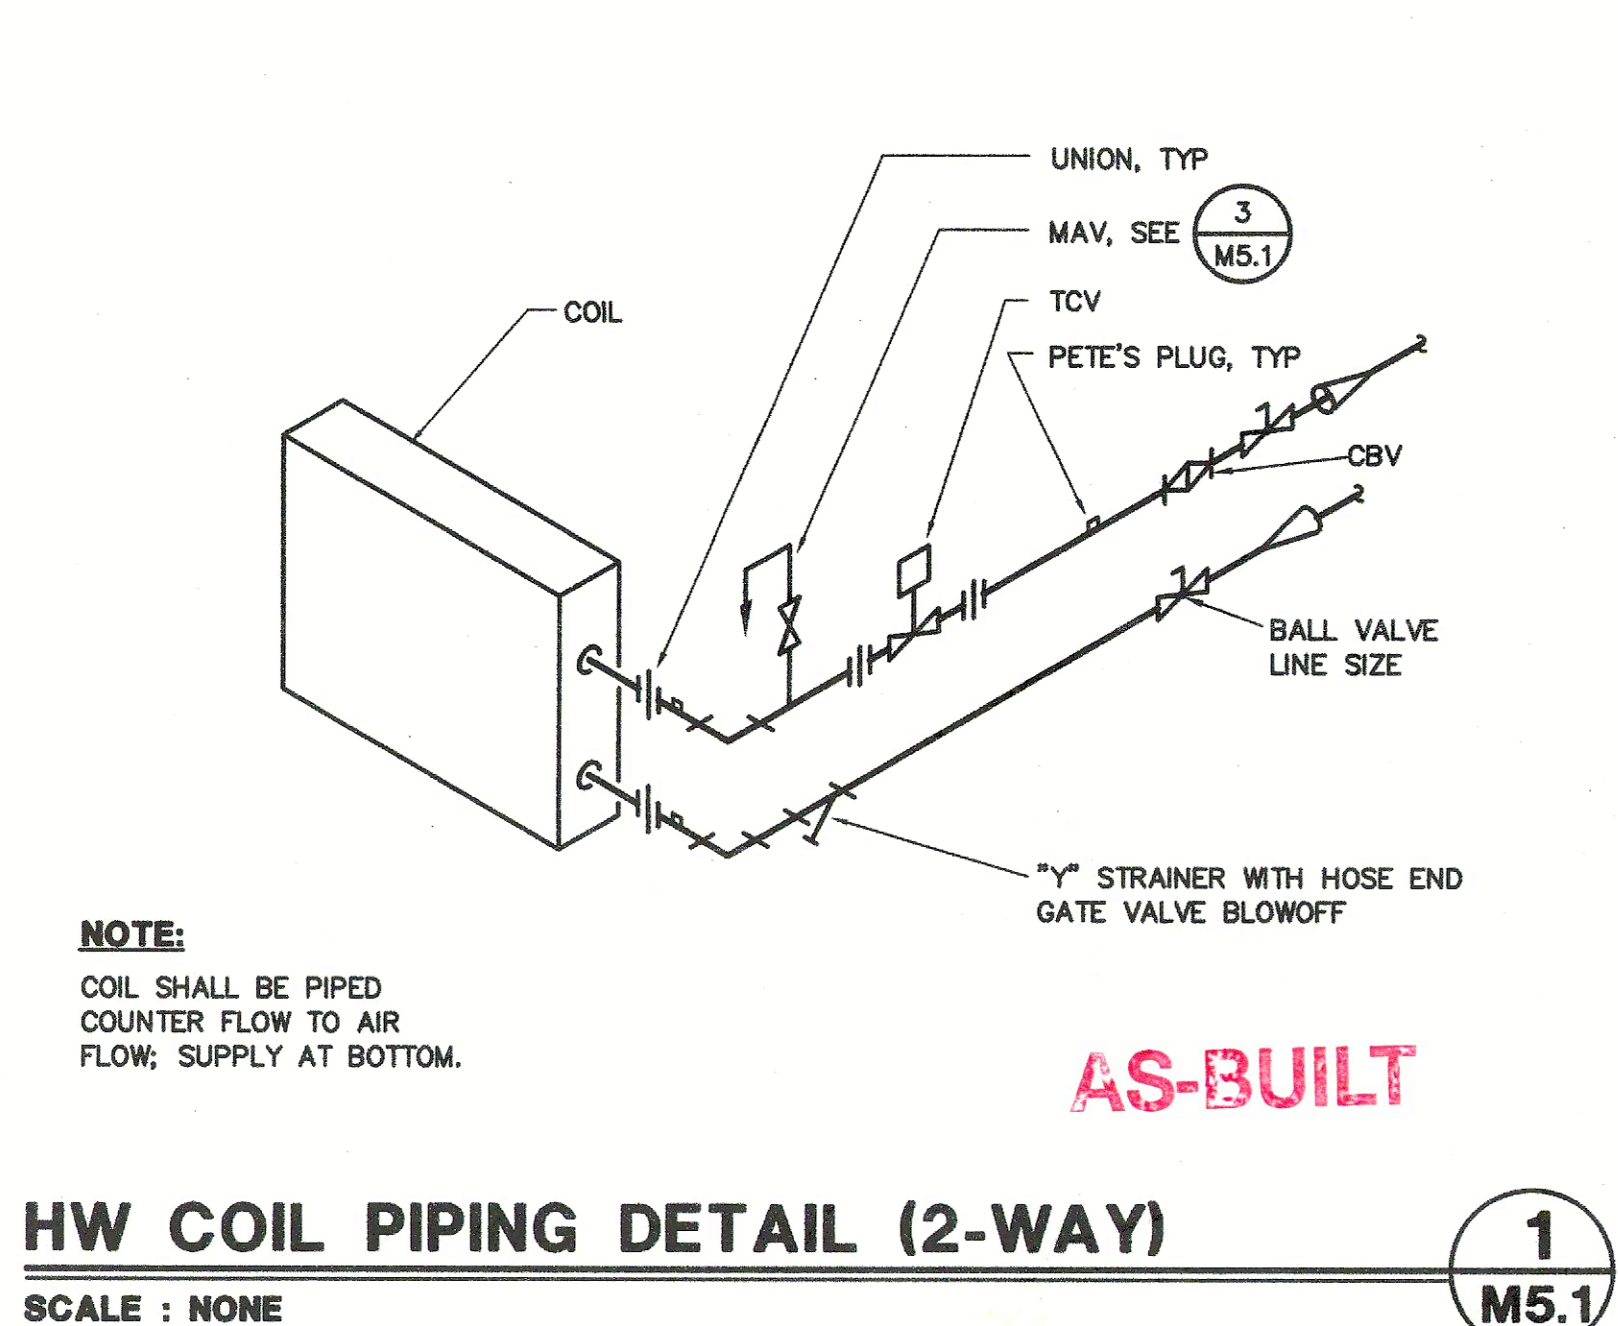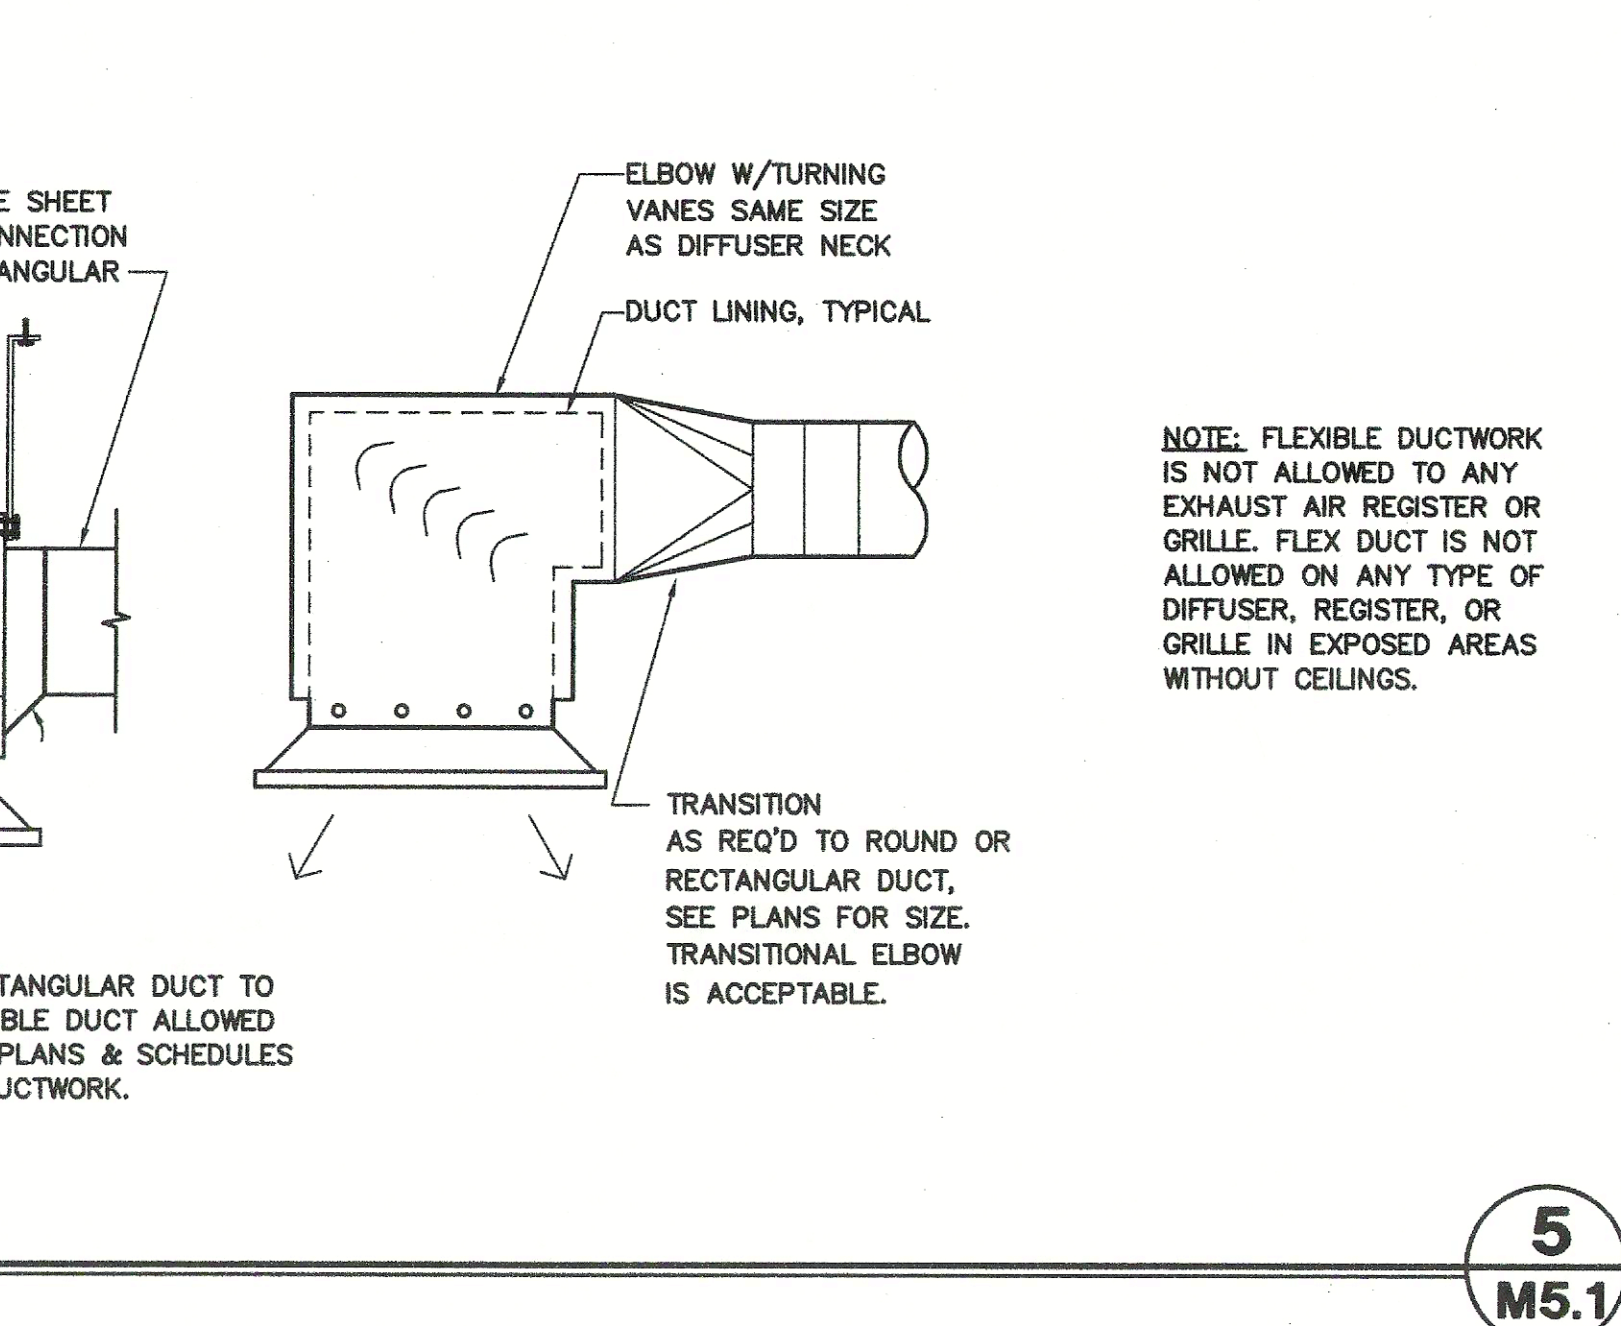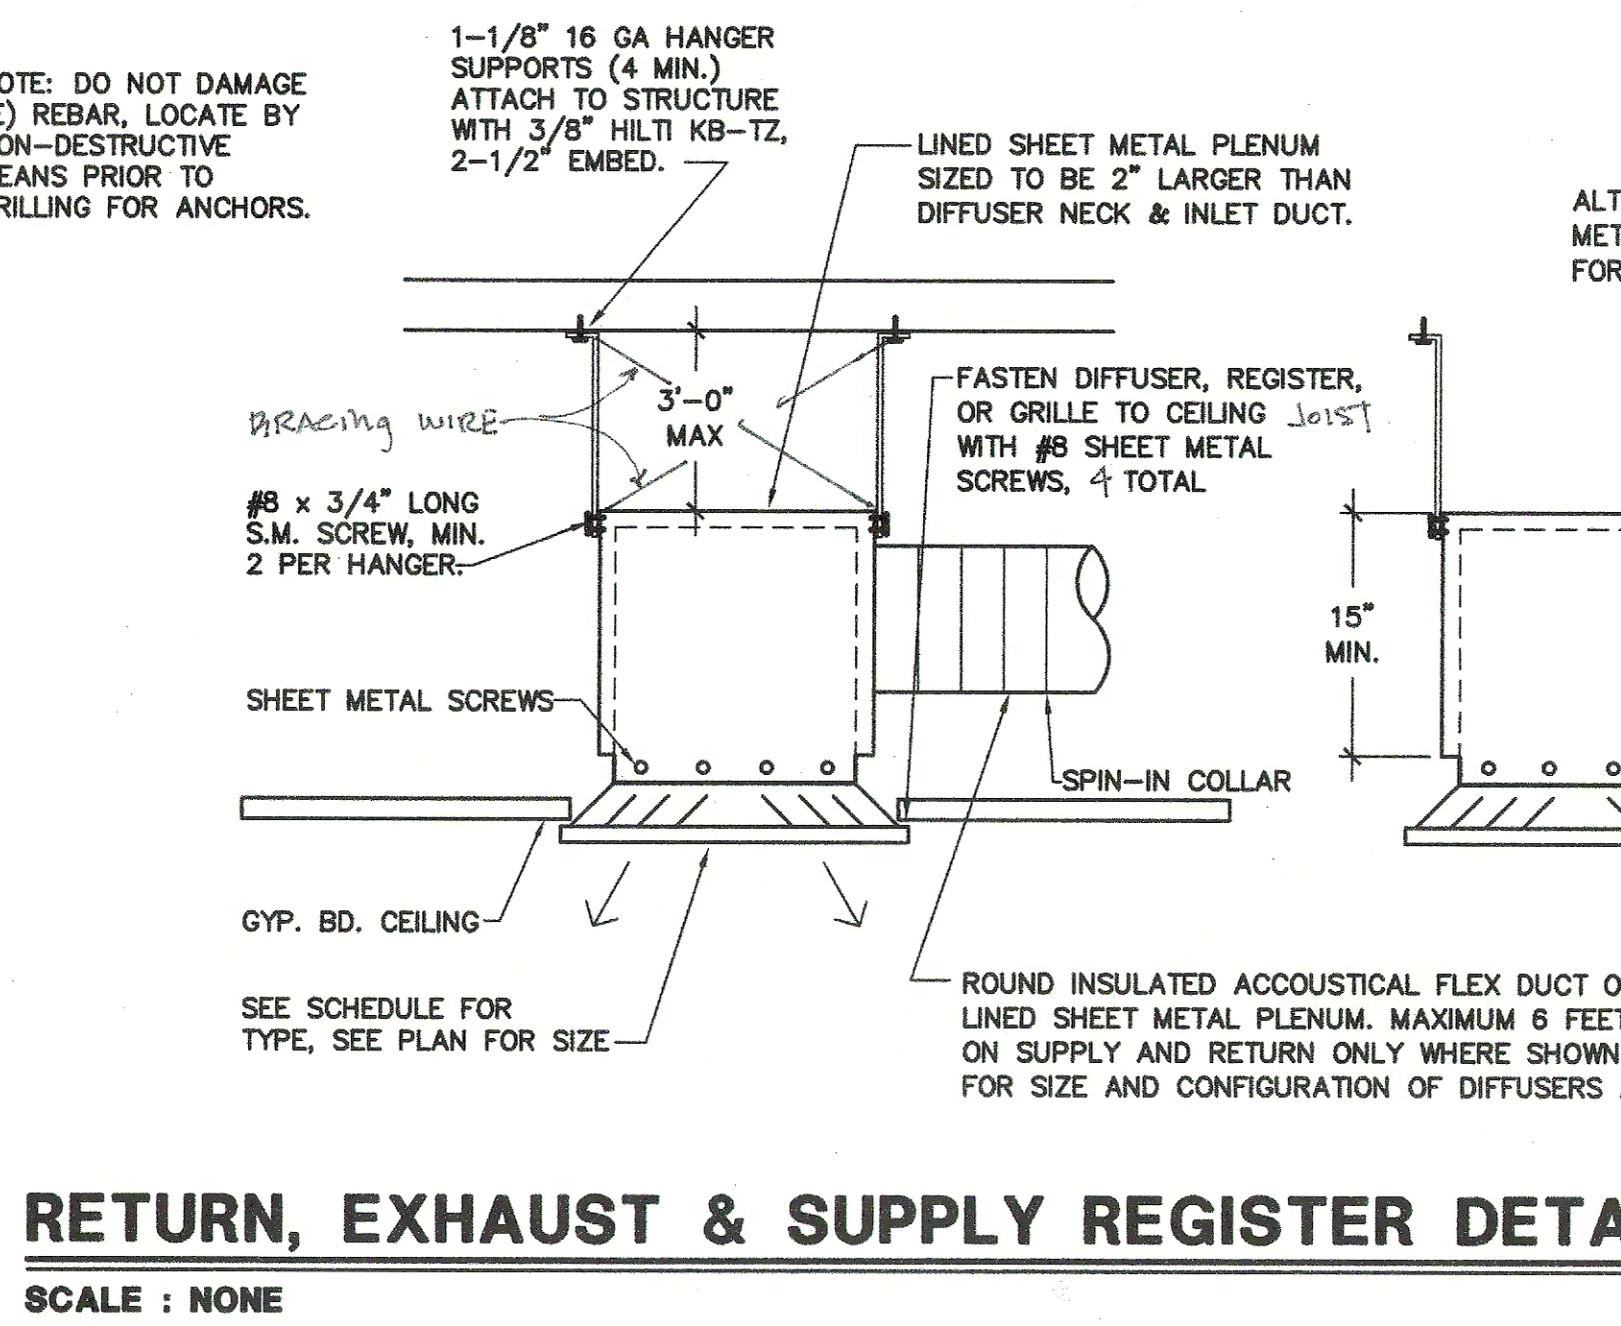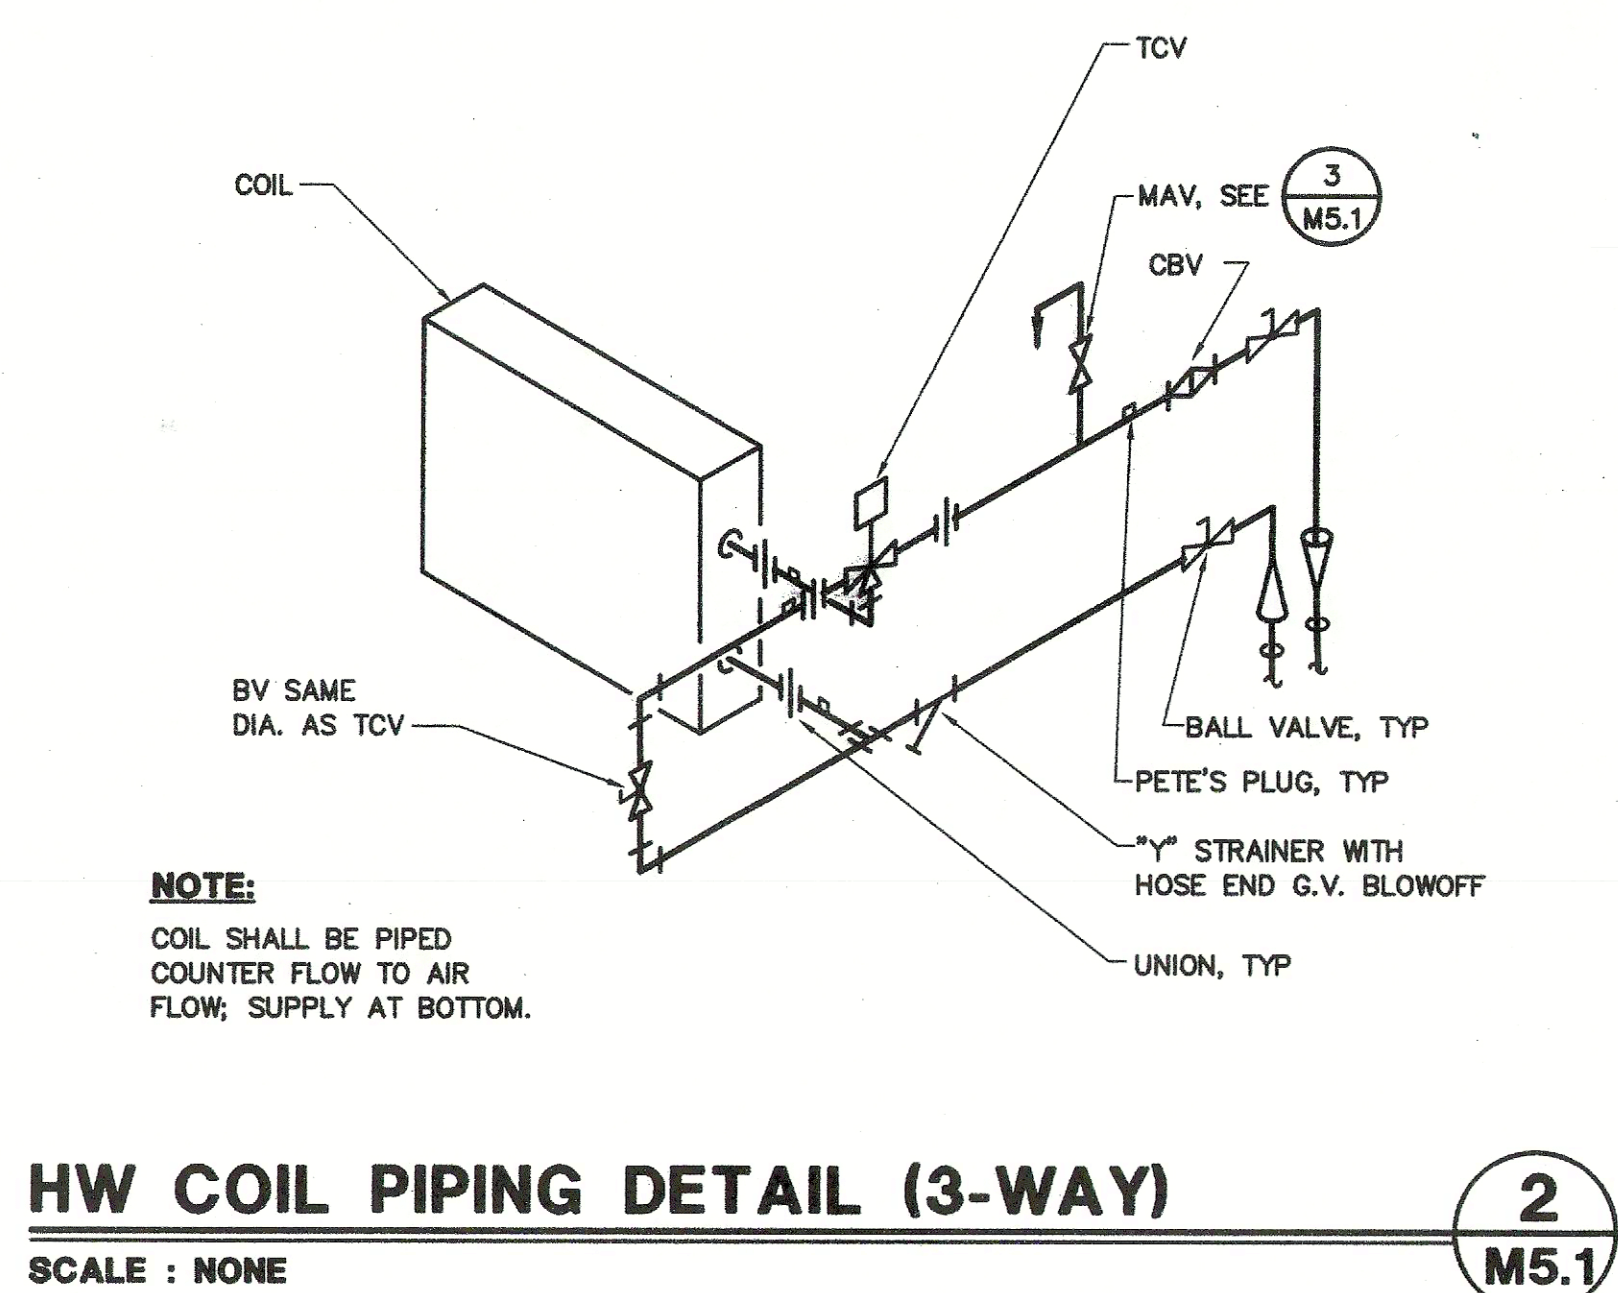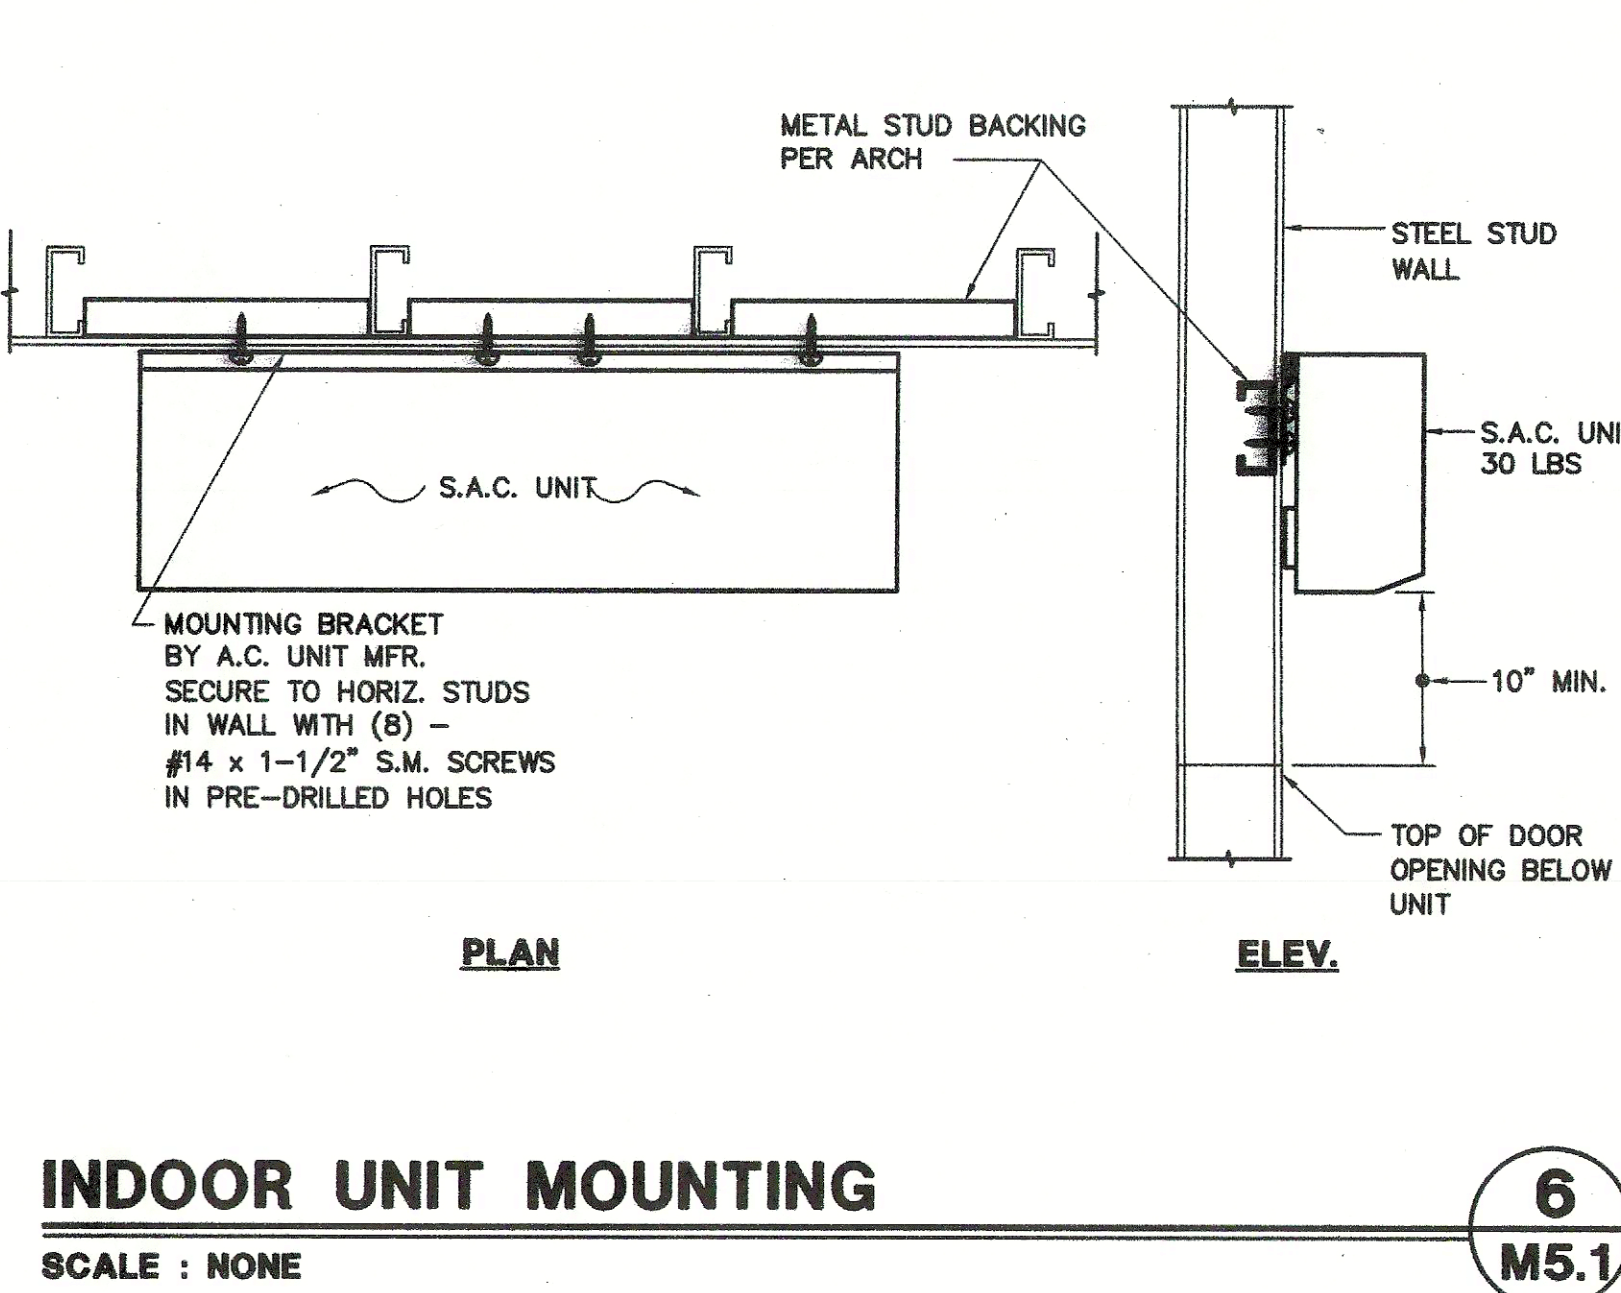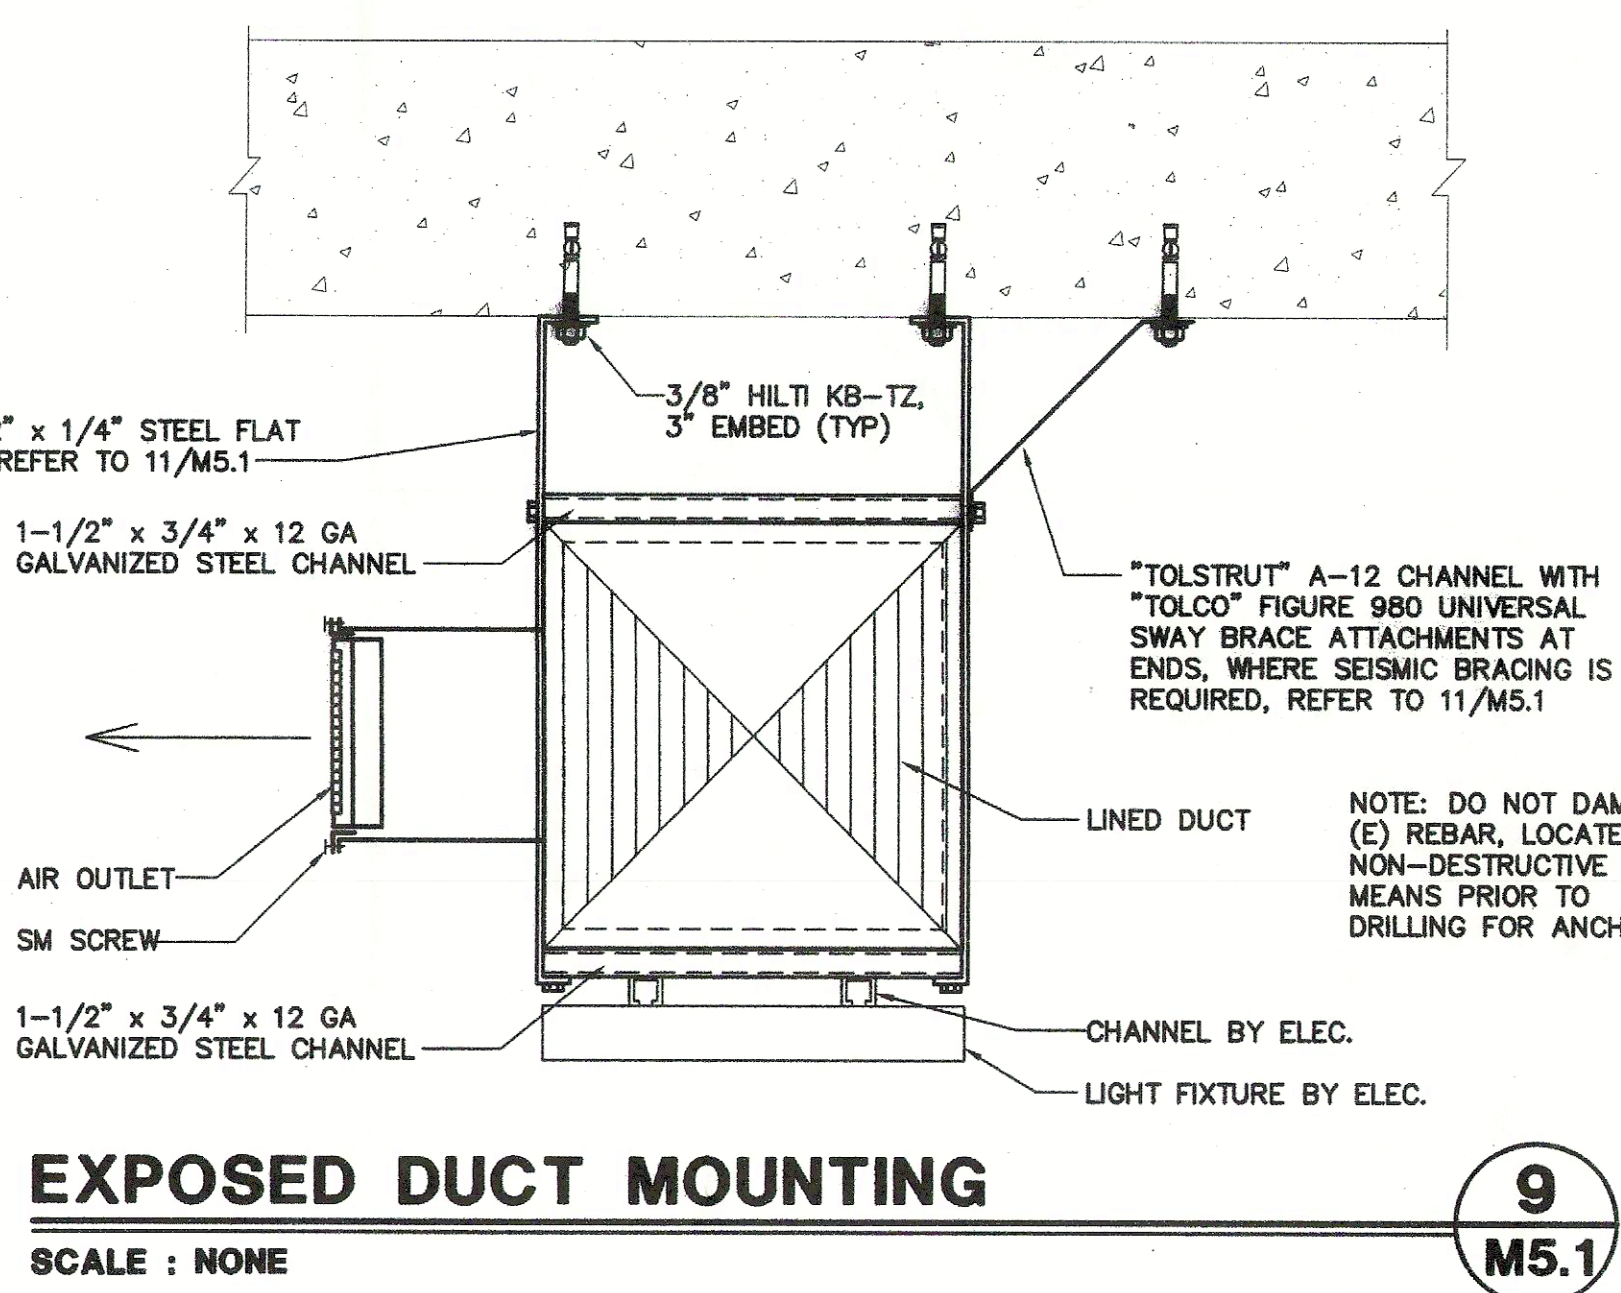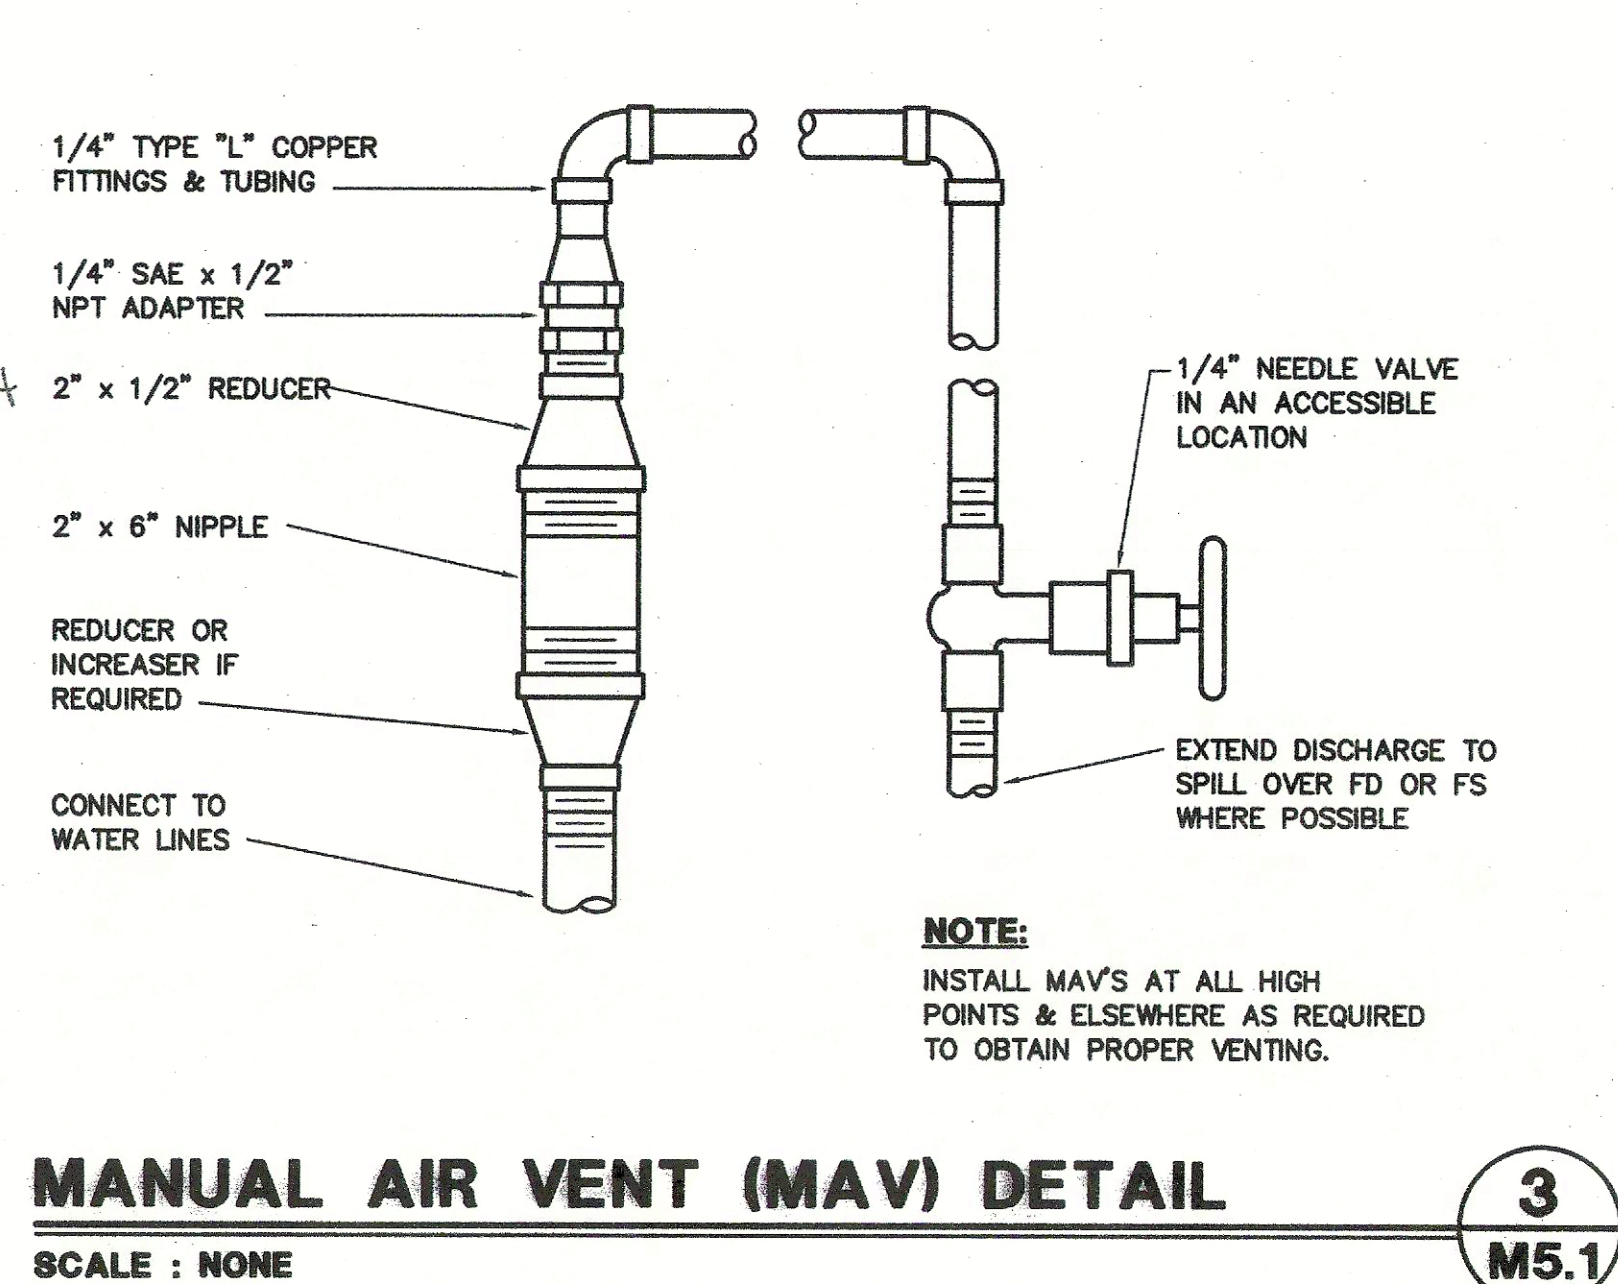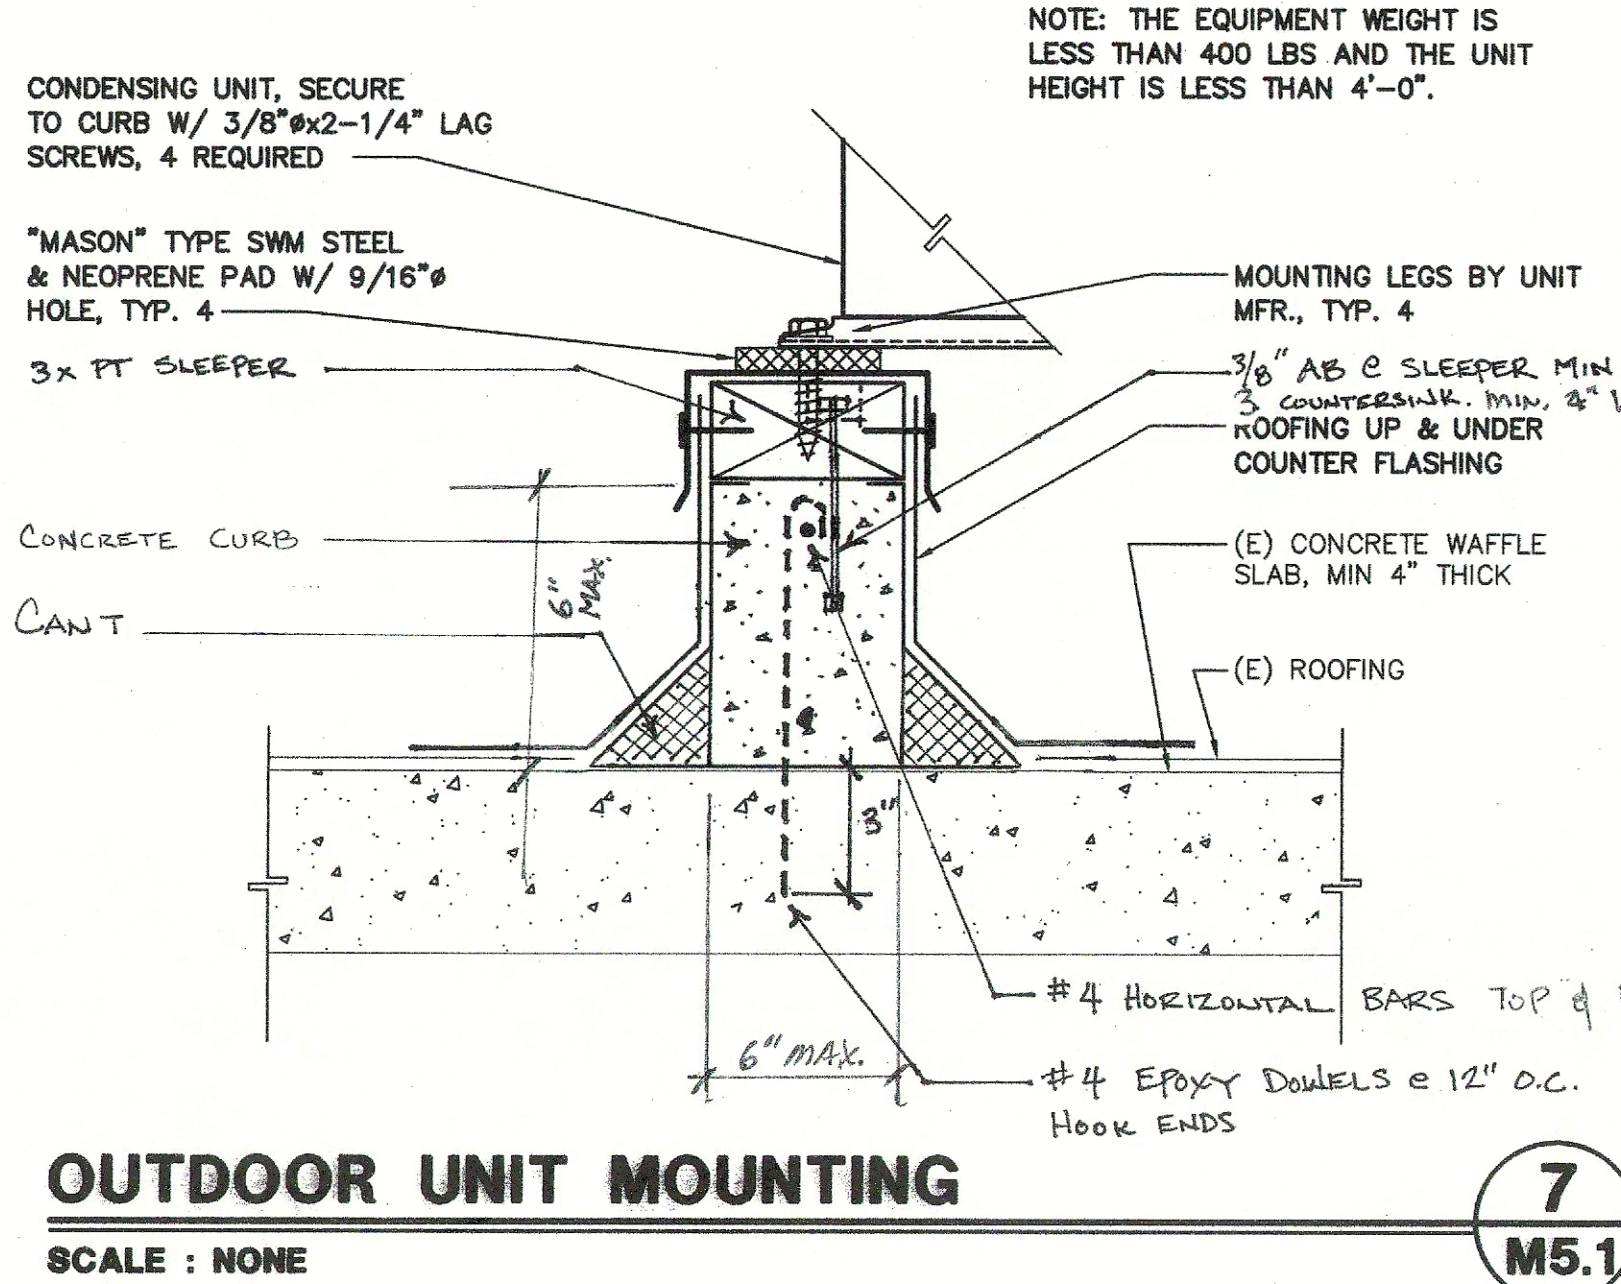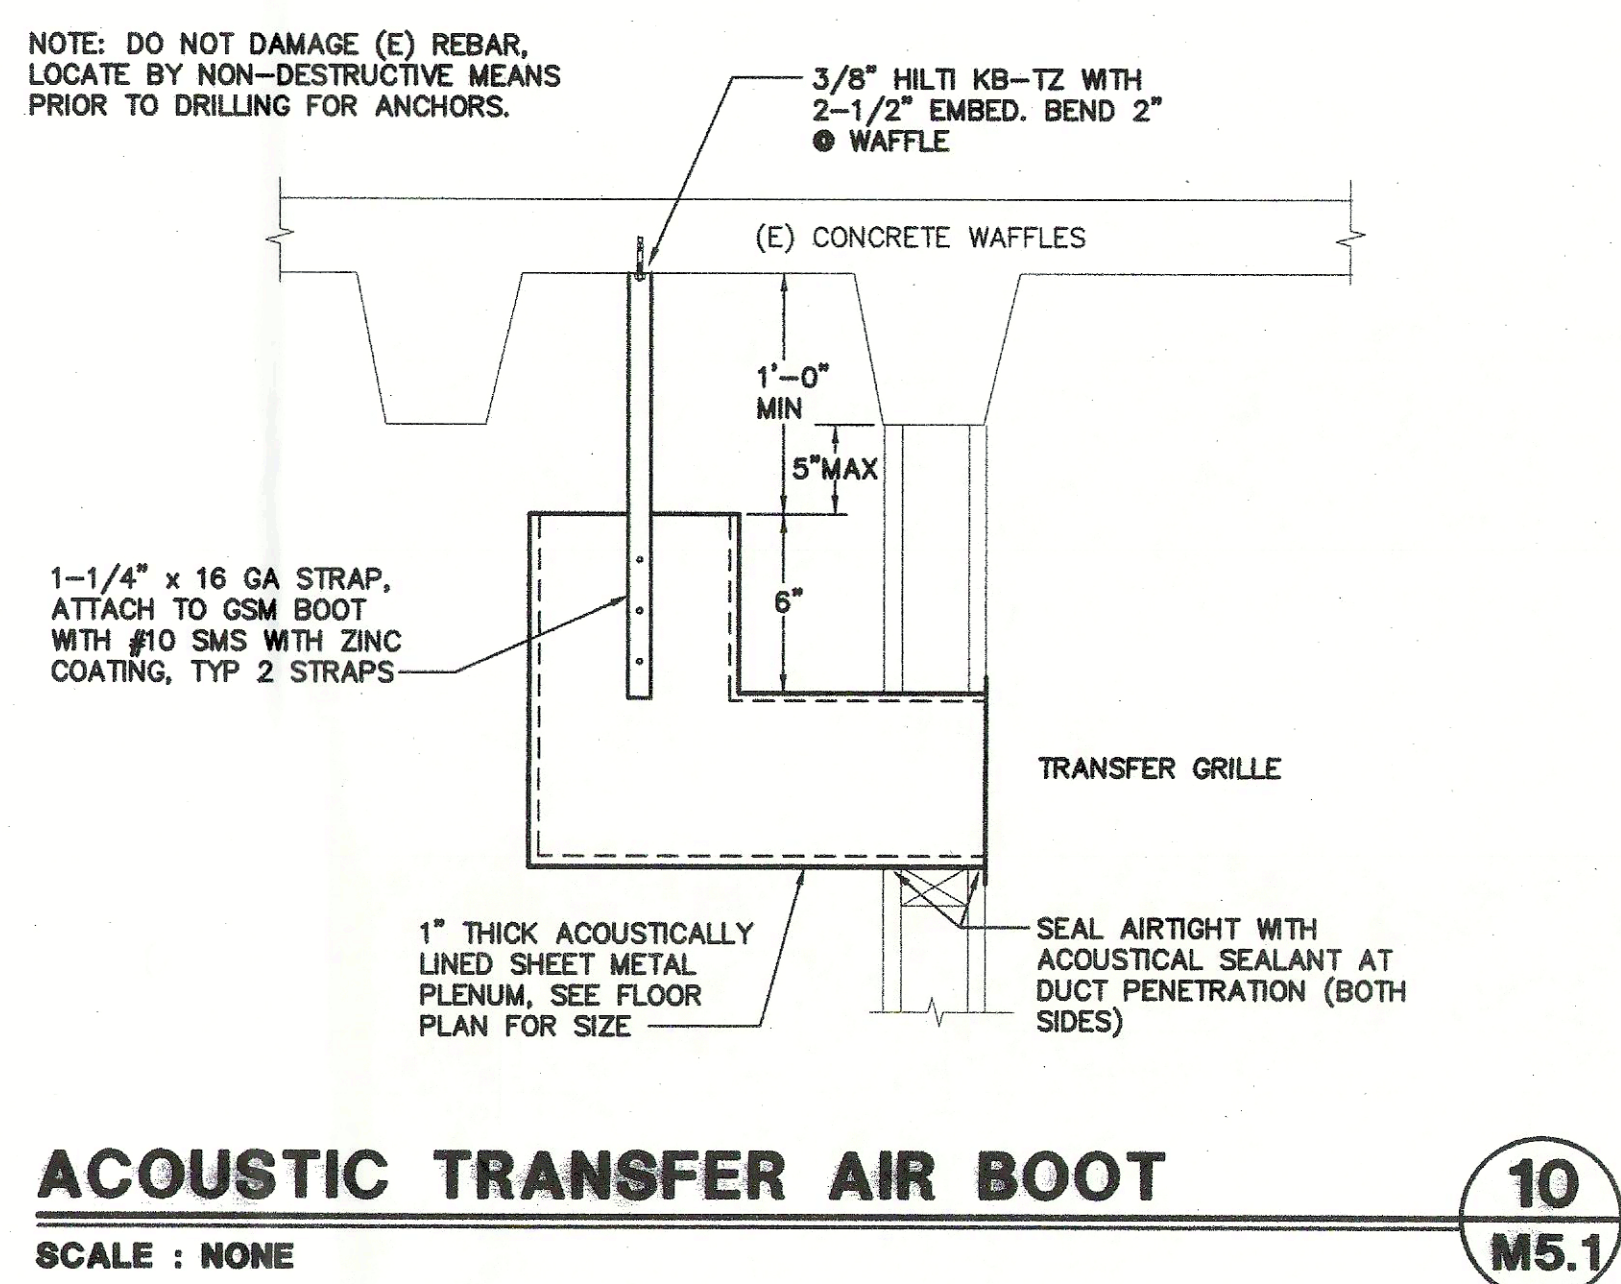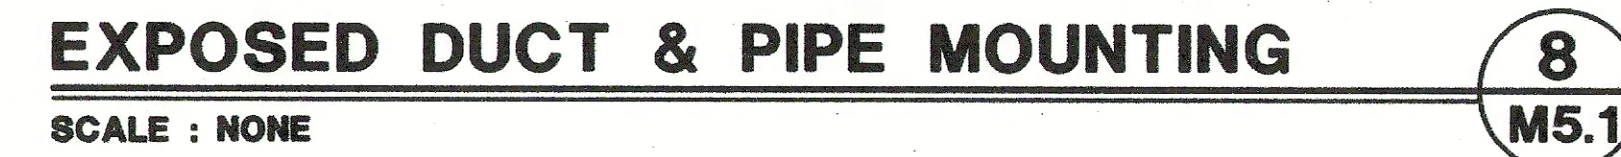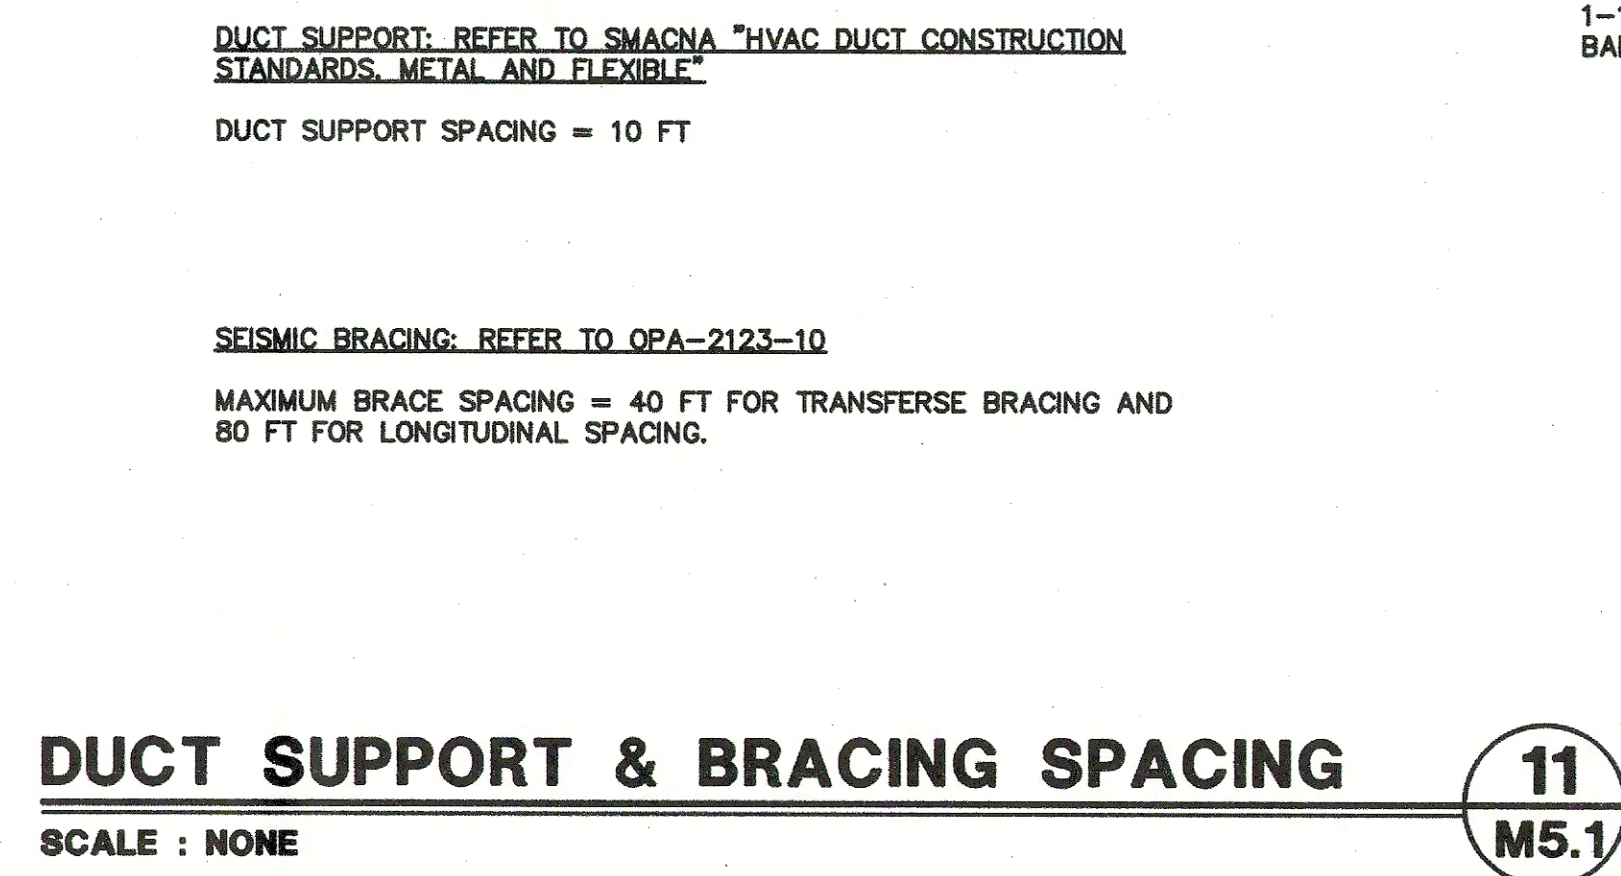

QC	INI	%

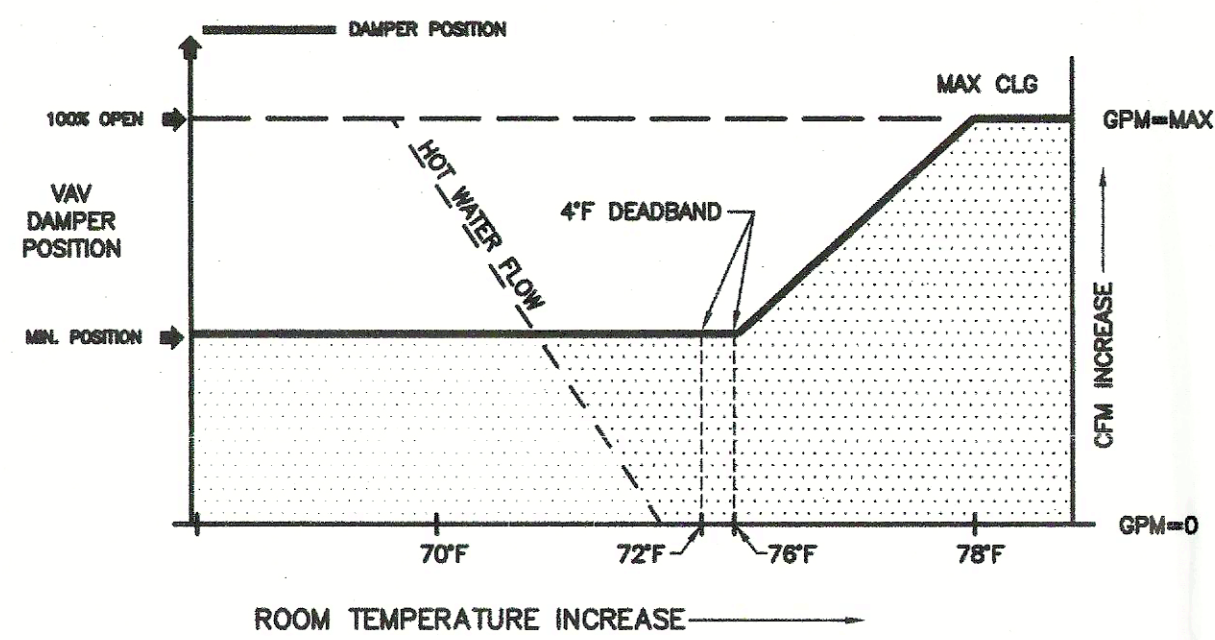


VAV BOX WITH REHEAT TEMPERATURE CONTROL

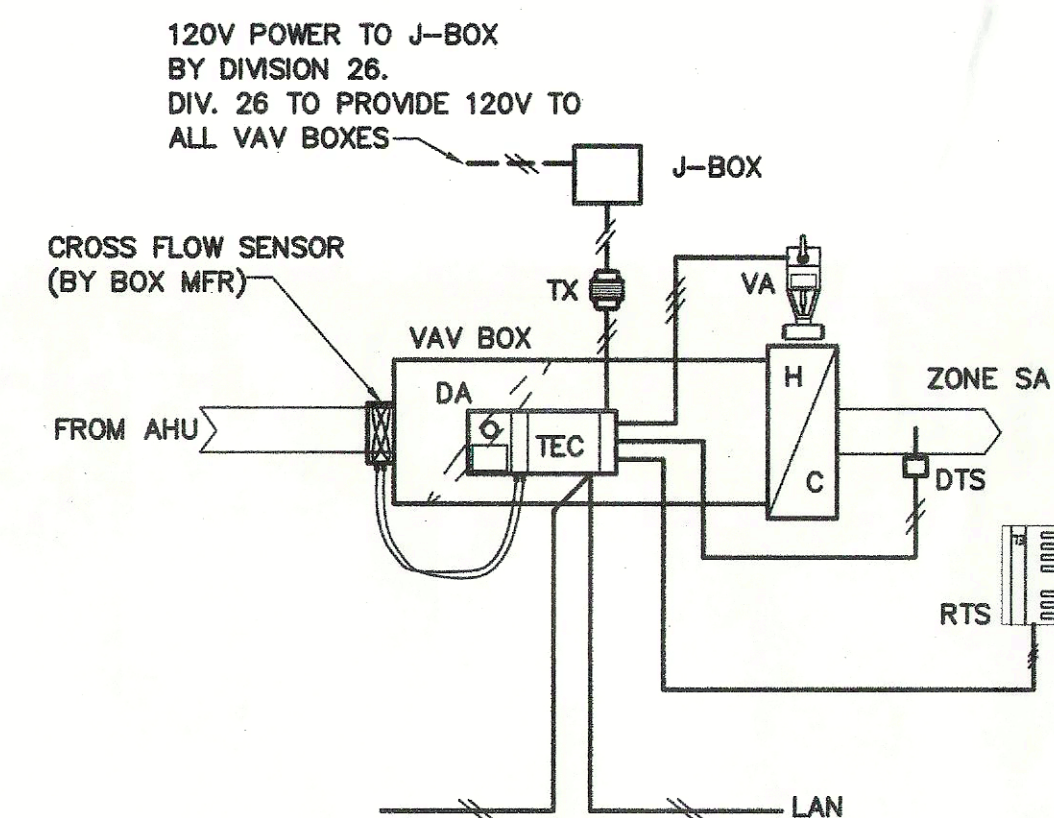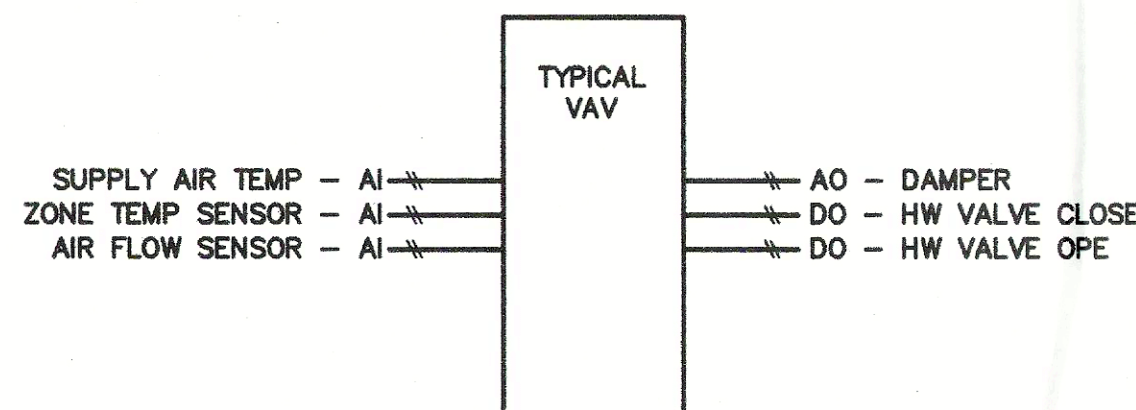

VAV BOX WITH REHEAT CONTROL DIAGRAM


- NOTES:
1. SEE SCHEDULES AND PLANS FOR QUANTITIES AND LOCATIONS
 2. MOUNT PLENUM RATED VAV CONTROLLER ONTO VAV BOX
 3. PROVIDE ISOLATION TRANSFORMER FOR EACH VAV CONTROLLER

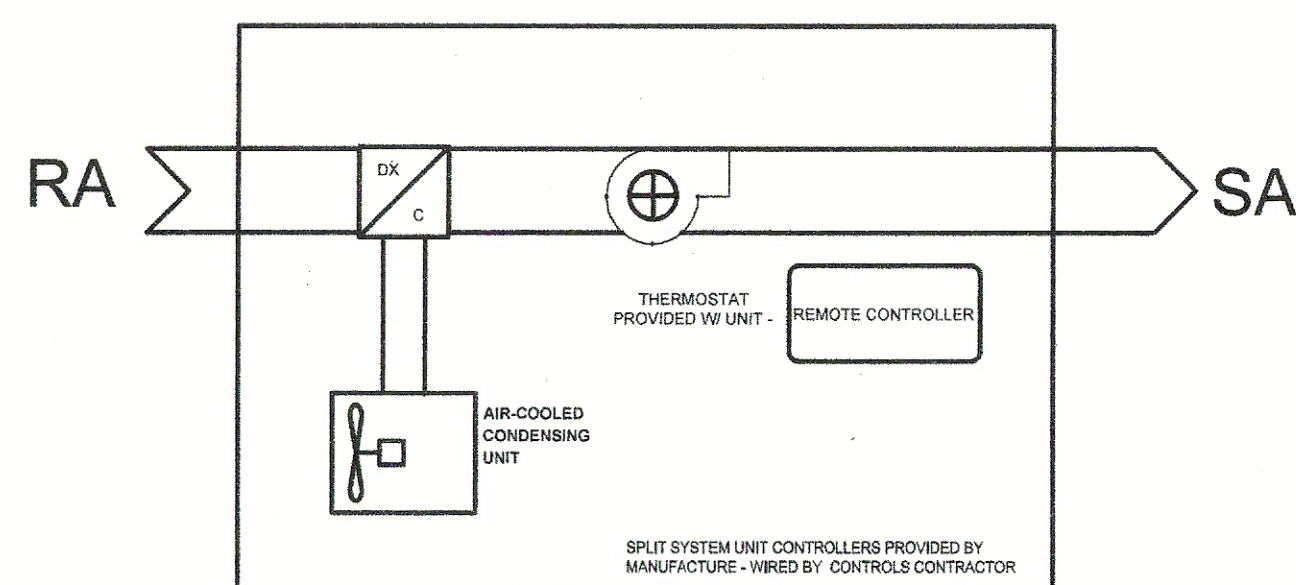

SEQUENCE OF OPERATION

PROGRAM CONTROL: BY REMOTE CONTROLLER. AC UNIT SHALL ENGAGE ANY TIME THE TEMPERATURE IN THE SPACE EXCEEDS 75°F (ADJ.). SYSTEM WILL BE PROGRAMMED SO THAT WHEN TEMPERATURE IN THE SPACE EXCEEDS SETPOINT, THE AC UNIT WILL TURN ON IN ORDER TO SATISFY SETPOINT.

SPLIT SYSTEM AC UNIT

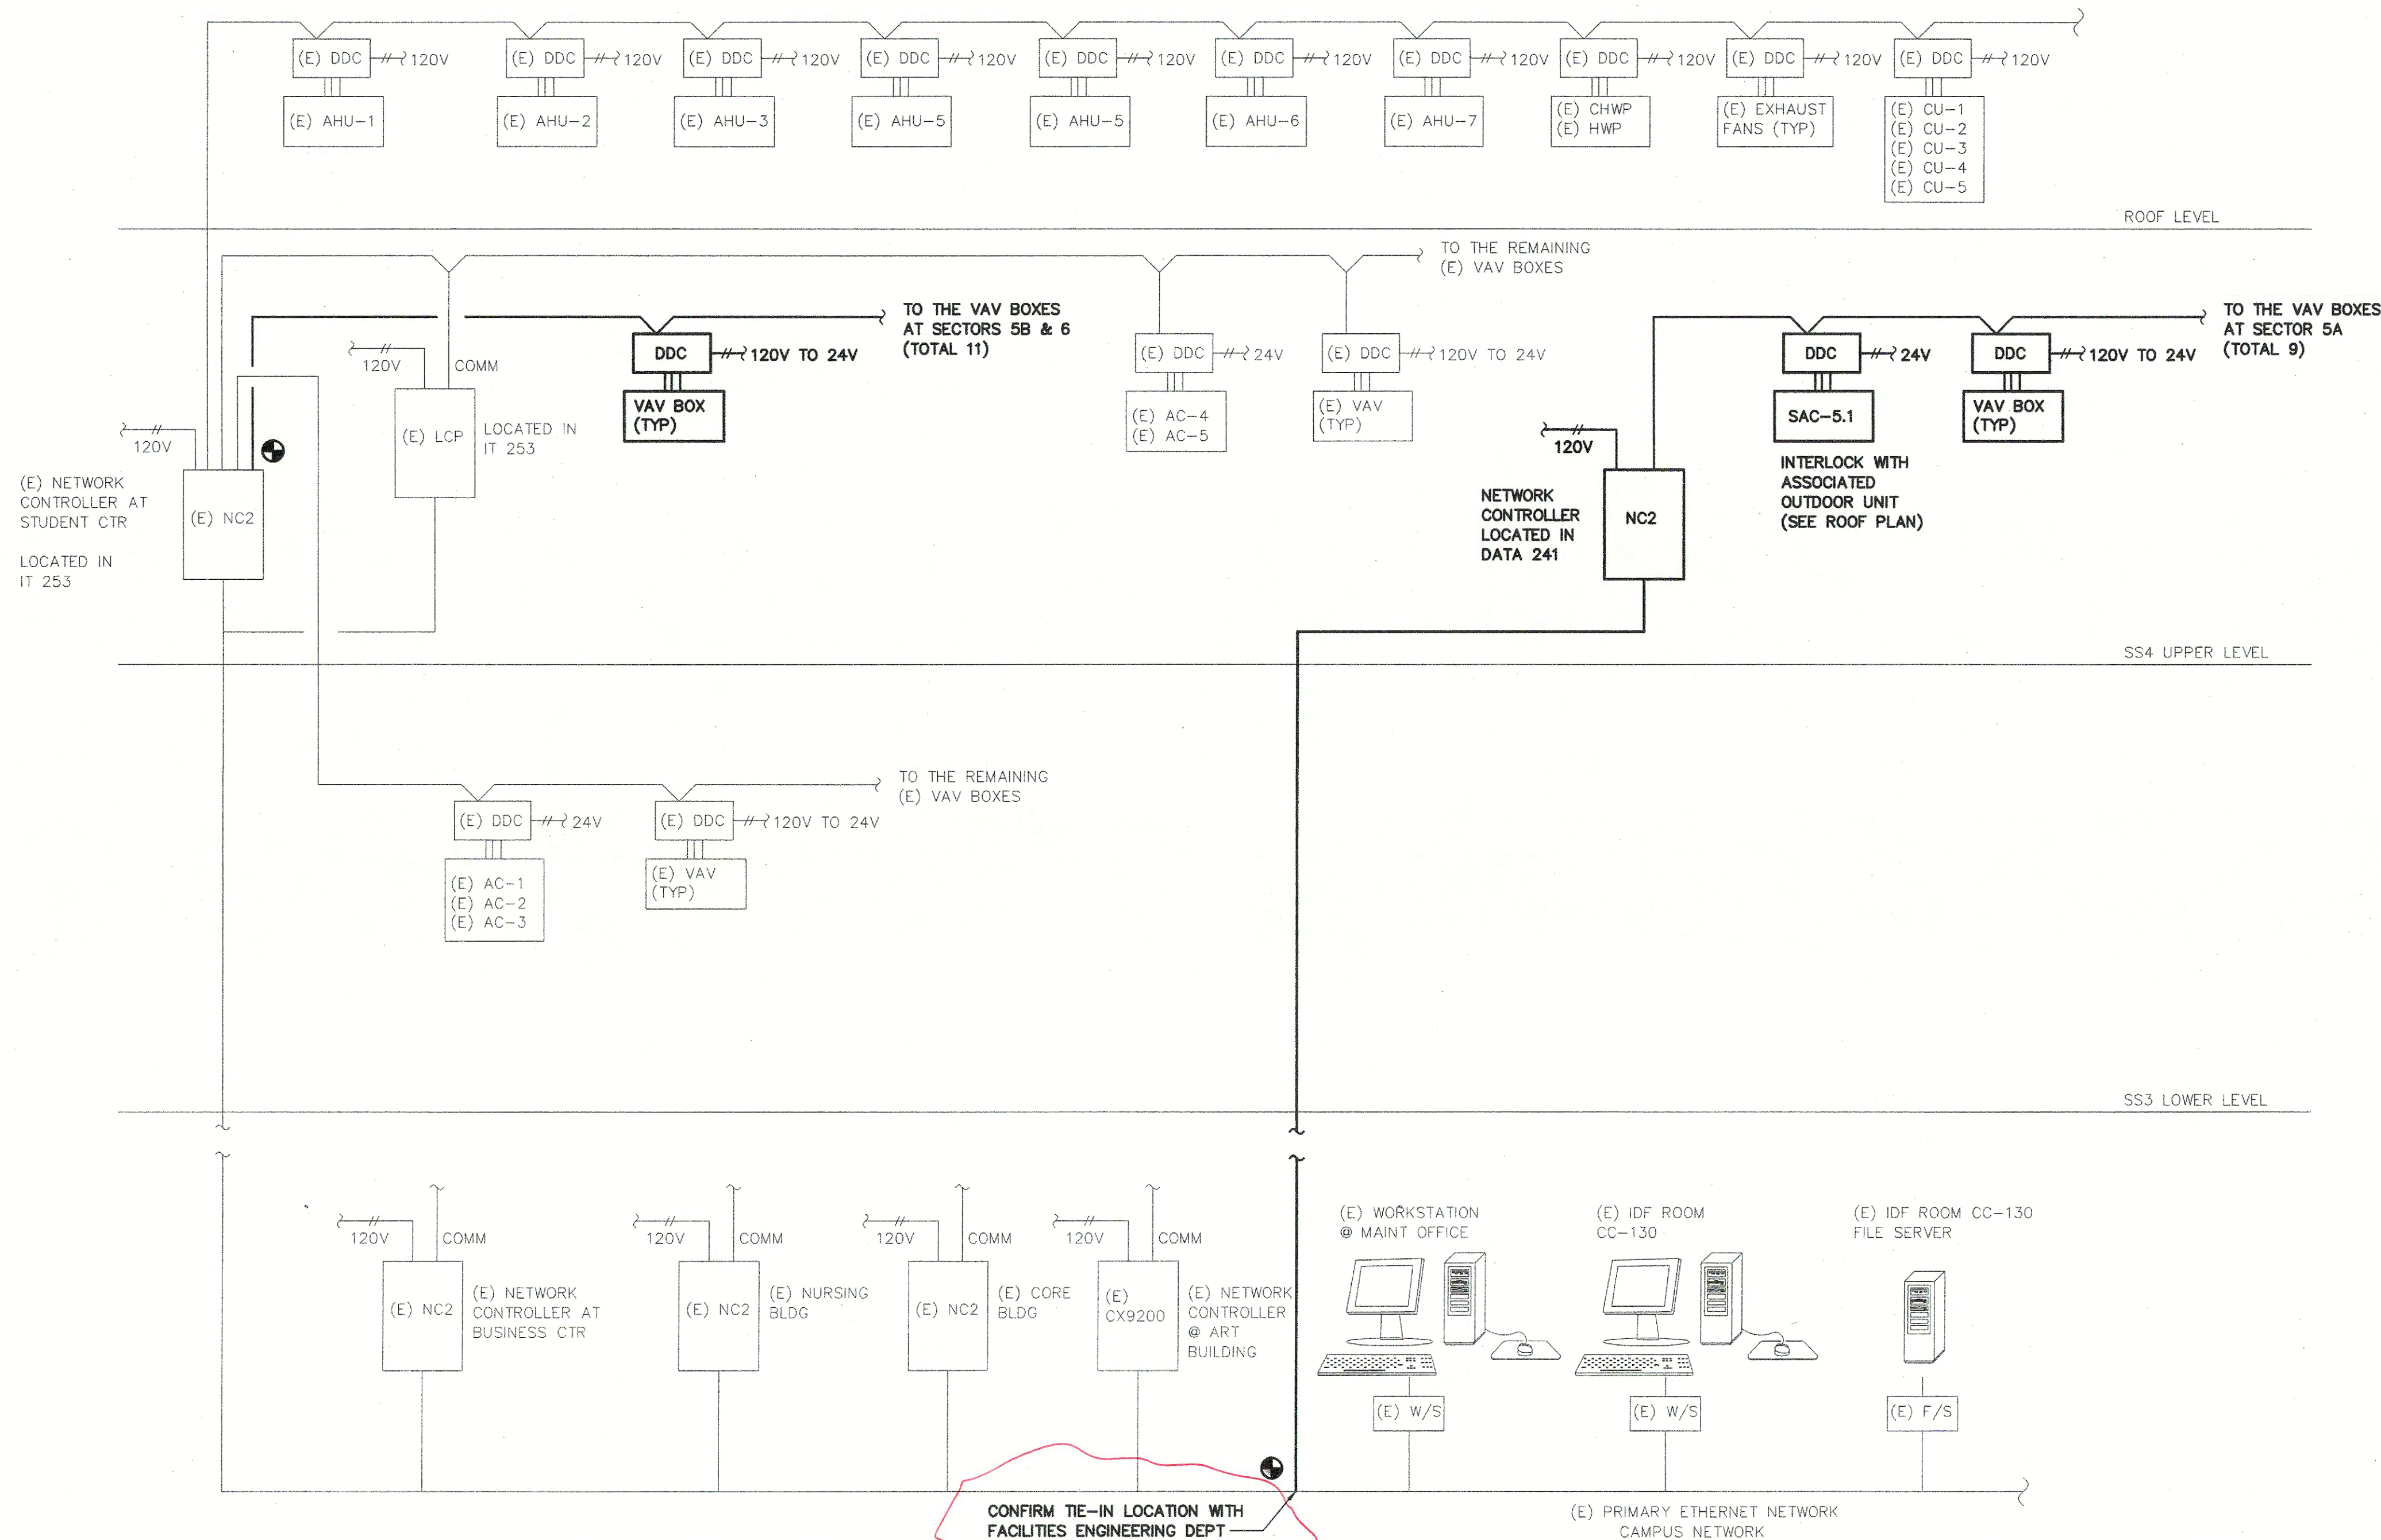

ENERGY MANAGEMENT SYSTEM ARCHITECTURE

CAMPUS NETWORK (ANDOVER INFINET FAMILY)

NOTES:

1. PROVIDE QUANTITY OF CONTROLLERS FOR EQUIPMENT AS NECESSARY. REFER TO SEQUENCE OF OPERATION AND DRAWINGS FOR PROGRAMMING AND POINT COUNT.
2. SUBMITTAL DRAWINGS MUST BE PROVIDED WHICH SHOW PLAN LOCATIONS OF ALL TEMPERATURE CONTROL PANELS, SYSTEM COMPUTER, AND SENSORS (TEMP, PRESSURE, ETC.).

RFI # 77
Locations Rm # 253 & 241

AS-BUILT

tBP
architecture
planning
interiors
management

tBP/Architecture
1777 Oakland Avenue, Suite 320
Walnut Creek, CA 94596
ph: 925.246.6419

DATE SIGNED: 07/15/2016
CAPITAL
ENGINEERING CONSULTANTS, INC.
Rancho Cordova, California
TS - ME/MEP
PM - DESIGN TEAM
PROJECT NO.

INTERLOCK WITH ASSOCIATED OUTDOOR UNIT (SEE ROOF PLAN)

INSTRUCTION SHEET
DIV. OF THE STATE ARCHITECT
OFFICE OF REGULATION SERVICES
FILE # 7-11336
REV. 10/1/13
DATE: JUL 28 2016

Division of the State Architect
1515 Clay Street, Suite 1201
Oakland, Ca, 94612
ph: (510) 622-3101

owner

tBP project number : 2084200

file name:

drawn by: checked by:

date: MAY 16, 2016

Rev.	date:	description:
12/15/15	DSA SUBMITTAL	
5/16/16	DSA	
7/1/16	BID SET	
12/09/16	Revised Bid Set	

THIS DRAWING AND THE DESIGN, SPECIFICATIONS, IDEAS AND OTHER INFORMATION CONTAINED HEREIN CONSTITUTE UNPUBLISHED WORK OF ARCHITECTURE AND SHALL REMAIN THE PROPERTY OF ARCHITECTURE IN PERPETUITY. NO PART HEREOF SHALL BE REPRODUCED, DISCLOSED, FORWARDED, SOLD, RENTED, OR OTHERWISE USED IN ANY MANNER WITHOUT THE ADVANCED EXPRESS WRITTEN CONSENT OF ARCHITECTURE.

drawing title:
HVAC
CONTROLS

drawing no:
M6.1
drawing of