


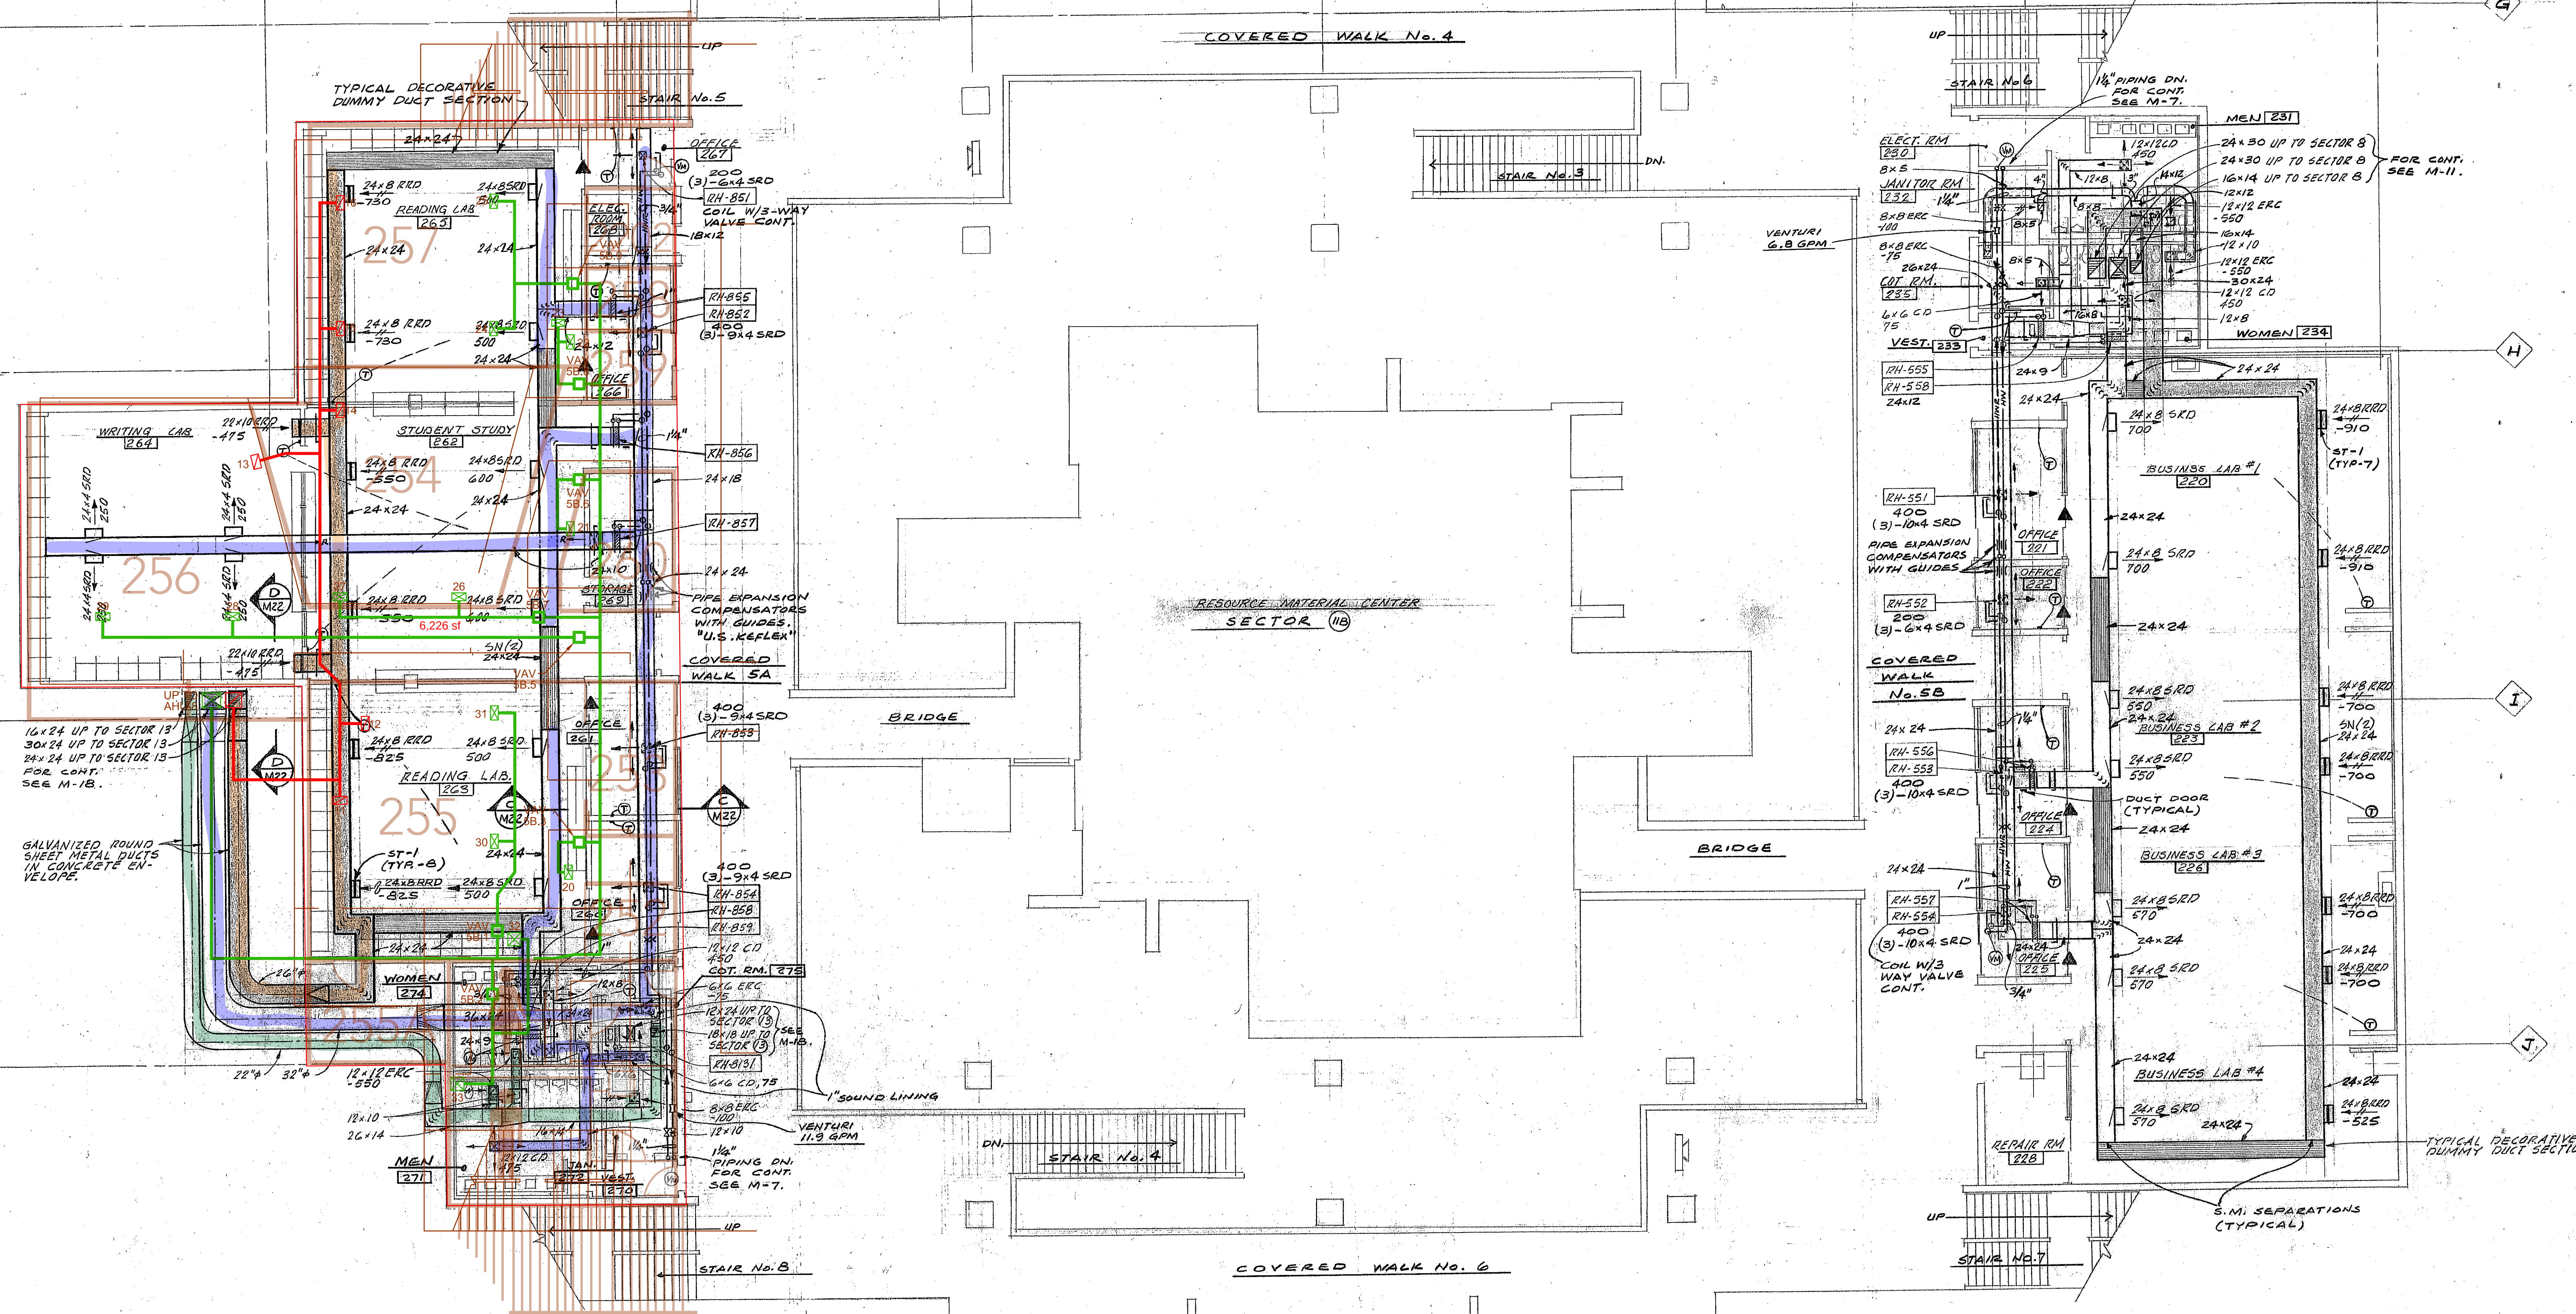



MECHANICAL SECTOR 5 SECOND FLOOR PLAN

SCALE: 1/8" = 1'-0"

SHEET NOTES

1. ▲ INDICATES AIR RELIEF THRU ARCH. SPECIAL DOOR FRAME, SEE ARCH. DWGS.
2. ALL DUCTWORK ON SYSTEMS [5-5], [5-6], [5-8] & [2-8] SHALL BE LINED WITH 1" SOUND LINING. DUCT SIZES SHOWN FOR EXPOSED AREAS ARE MAXIMUM OUTSIDE DIMENSIONS. DUCT SIZES SHOWN FOR CONCEALED AREAS ARE NET INSIDE DIMENSIONS. DUMMY DUCT NEED NOT BE LINED.

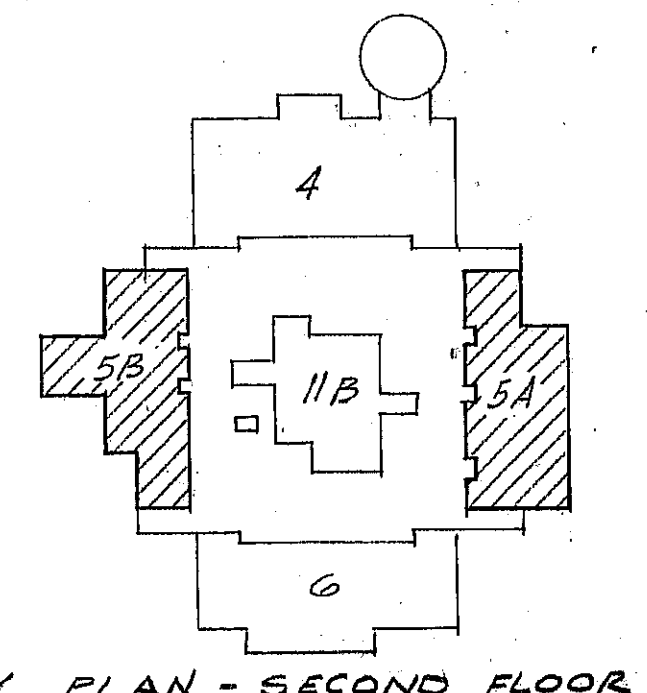

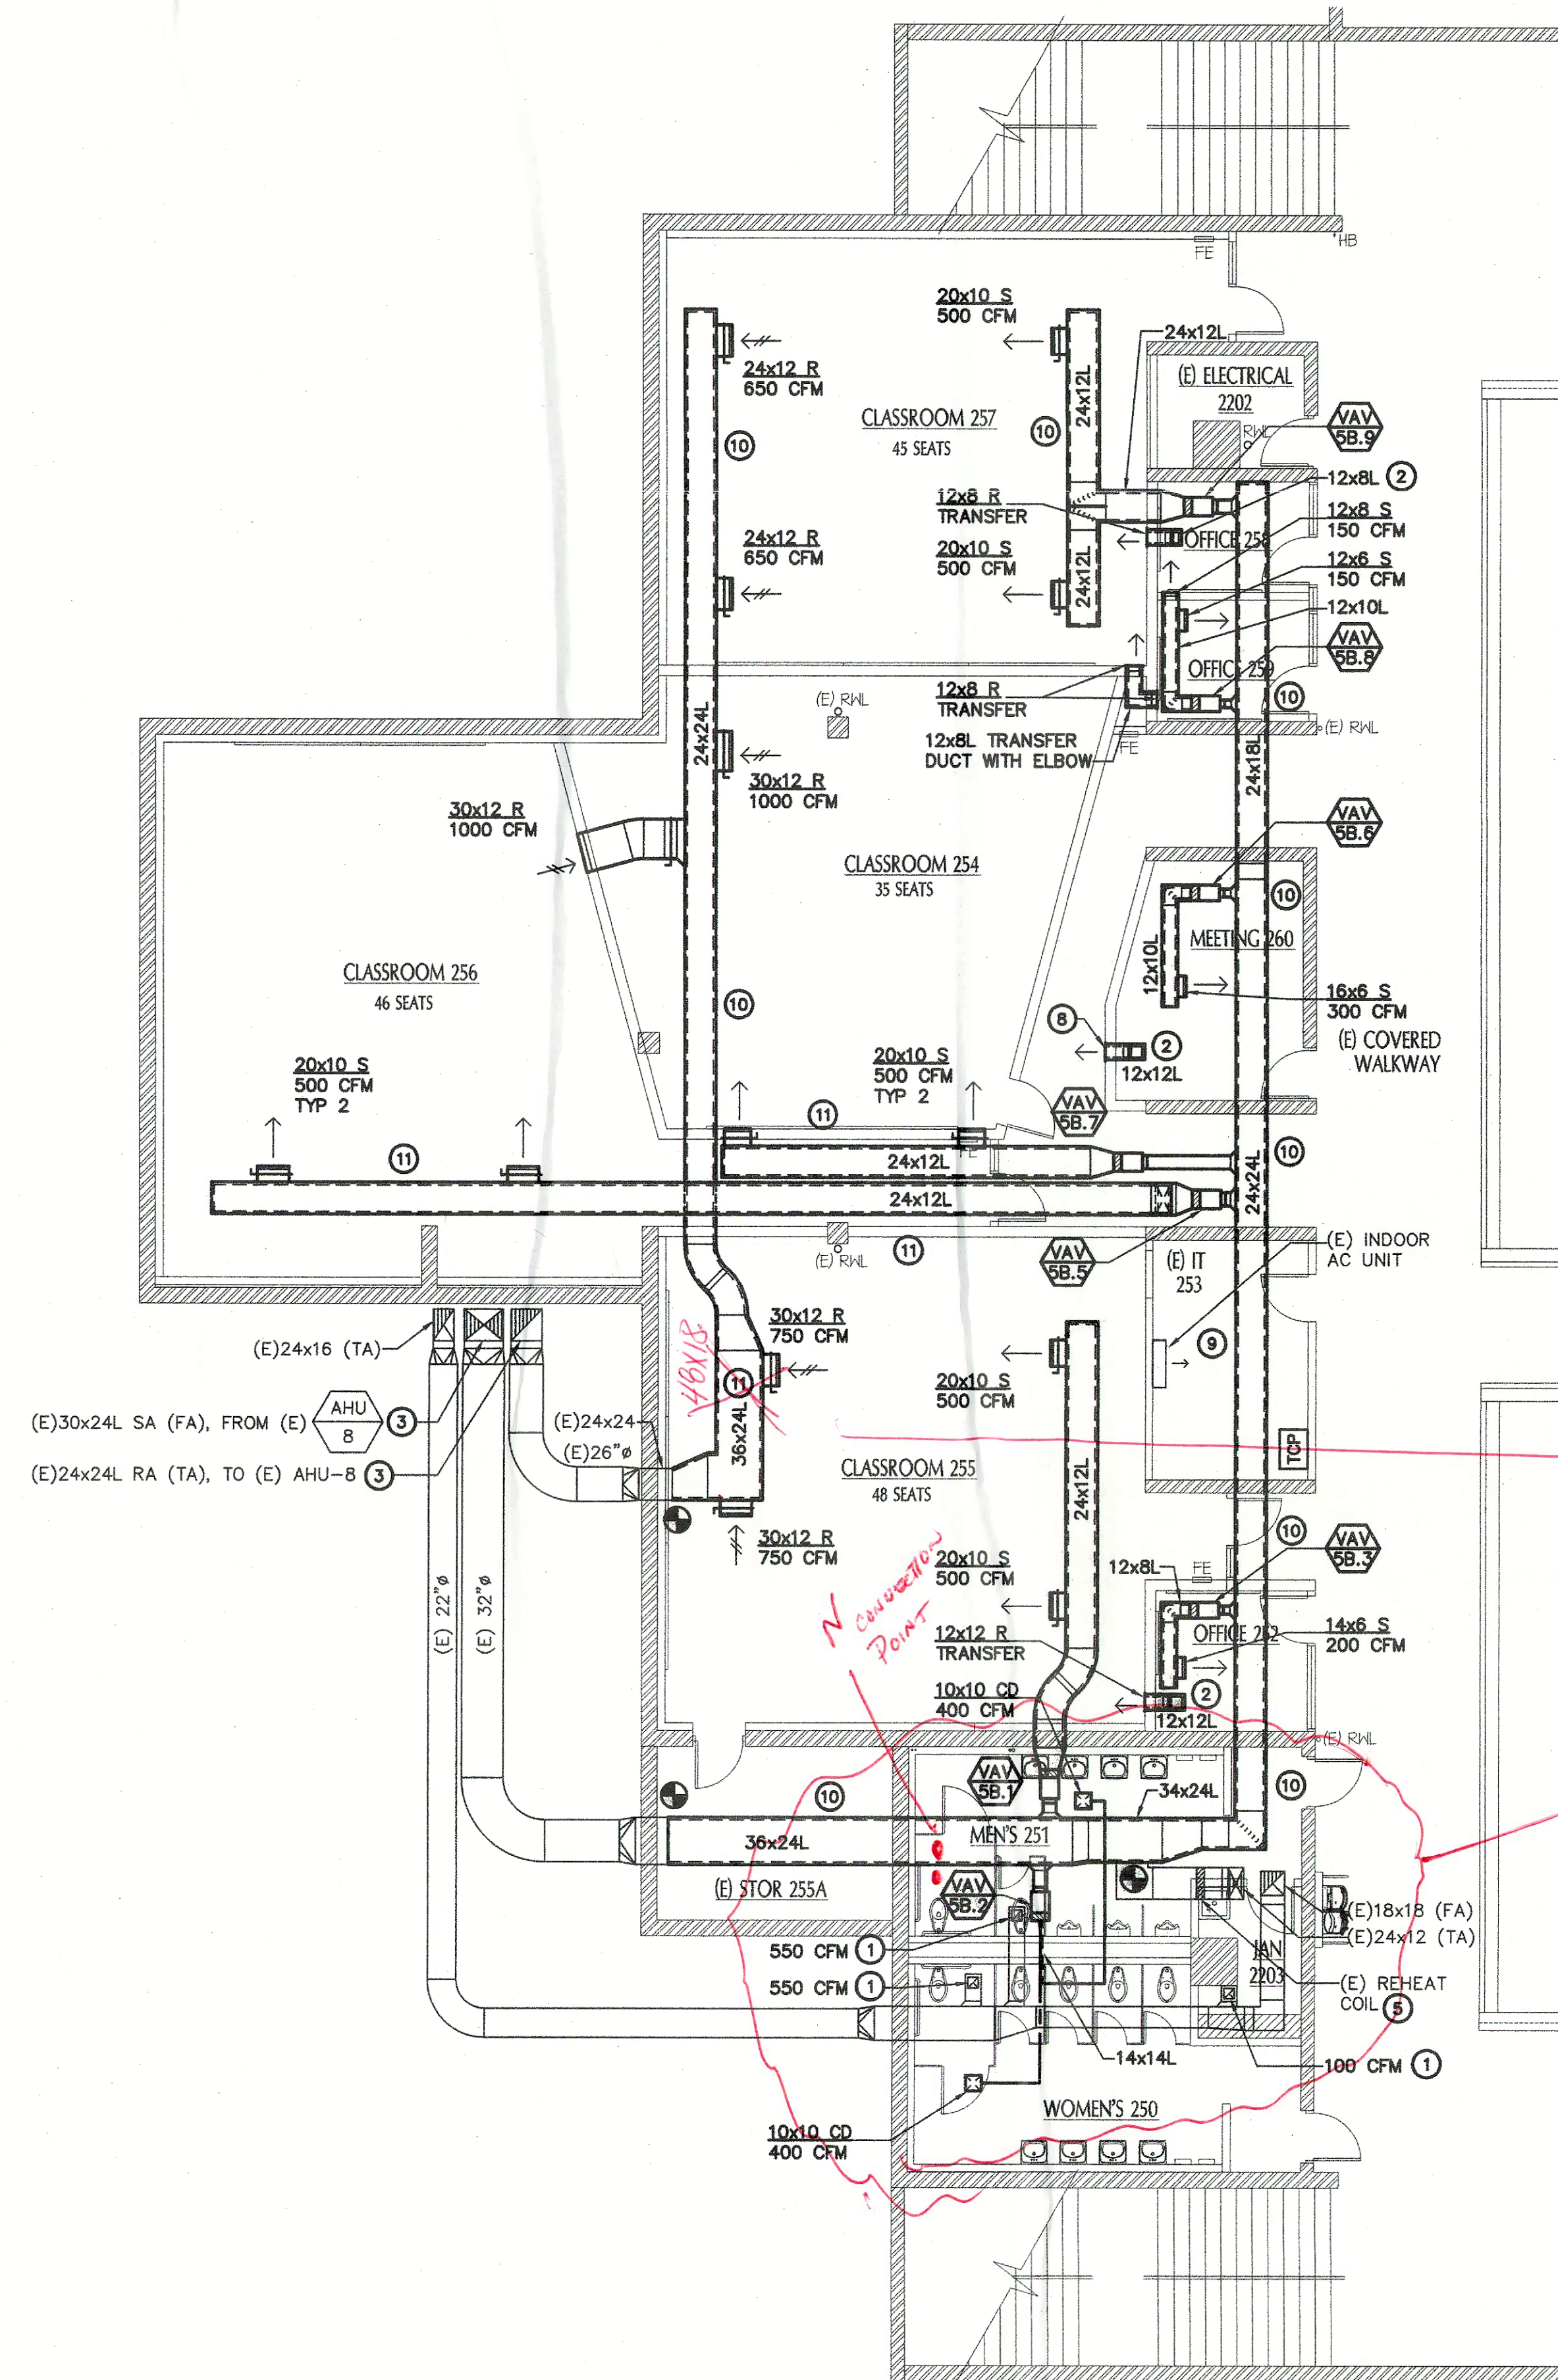

HVAC FLOOR PLAN - SECTOR 5B

SCALE: 1/8" = 1'-0"


1
M2.0

- GENERAL NOTES:**
- SEE TABLE OF DUCT SIZES ON SHEET M0.1 FOR SIZE OF BRANCH DUCTS TO INDIVIDUAL DIFFUSERS, REGISTERS & GRILLES SHOWN ON PLAN UNLESS THE DUCT SIZE IS SHOWN ON THE FLOOR PLAN.
 - SEE TERMINAL UNIT SCHEDULE ON SHEET M0.2 FOR VAV BOX SIZES. SIZE OF DUCT SHOWN TO TERMINAL UNIT SHALL BE THE BOX INLET SIZE AS SCHEDULED UNLESS NOTED OTHERWISE ON FLOOR PLAN.
 - REFER TO M2.1 FOR THERMOSTAT LOCATIONS.
 - PAINT EXPOSED DUCT. REFER TO ARCHITECTURAL DRAWINGS.

- SHEET NOTES:**
- BALANCE (E) DIFFUSER OR GRILLE TO VALUE INDICATED.
 - TRANSFER BOOT, SEE DETAIL 10/M5.1.
 - (E) AHU-8 ALSO SERVES SECTOR 13 ON THE THIRD FLOOR ABOVE. SCHEDULE AC UNIT SHUTDOWN WITH THE OWNER PRIOR.
 - (E) AHU-6.1 ALSO SERVES SECTOR 3 ON THE FIRST FLOOR BELOW. SCHEDULE AC UNIT SHUTDOWN WITH THE OWNER PRIOR.
 - (E) REHEAT COIL THAT SERVES THIRD FLOOR BATHROOM CORE TO REMAIN. MAINTAIN THE SAME AIRFLOW TO THE SPACE THAT WAS PROVIDED PRIOR TO CONSTRUCTION.
 - REFRIGERANT PIPING, REFER TO SCHEDULE FOR SIZES. ROUTE TO OUTDOOR UNIT SCU-5A.1.
 - DECORATIVE DUMMY DUCT SECTION. SIZE SHALL BE THE SAME AS THE ADJACENT DUCT. SUPPORTS AND BRACING SHALL BE THE SAME AS OTHER DUCTS.
 - 12x12 RELIEF AIR LOUVER.
 - IT ROOM 253 MUST REMAIN FULLY OPERATIONAL THROUGHOUT CONSTRUCTION. CAREFULLY COORDINATE CONSTRUCTION WORK TIME WITHIN THE ROOM WITH DISTRICT. ENSURE THAT EQUIPMENT REMAINS UNDISTURBED DURING WORK.
 - DUCT MAIN (SAME SIZE OR SMALLER THAN THE (E) DUCT REMOVED) MOUNTED TO (E) SUPPORT, REFER TO DETAIL 8/M5.1.
 - DUCT MAIN MOUNTED TO NEW SUPPORT, REFER TO DETAIL 9/M5.1.

*DUCT WORK RE-CONVEYED
SIZE/SHAPE
SEE AS1.45*


*REF # 1610
HVAC HW CONNECTION*

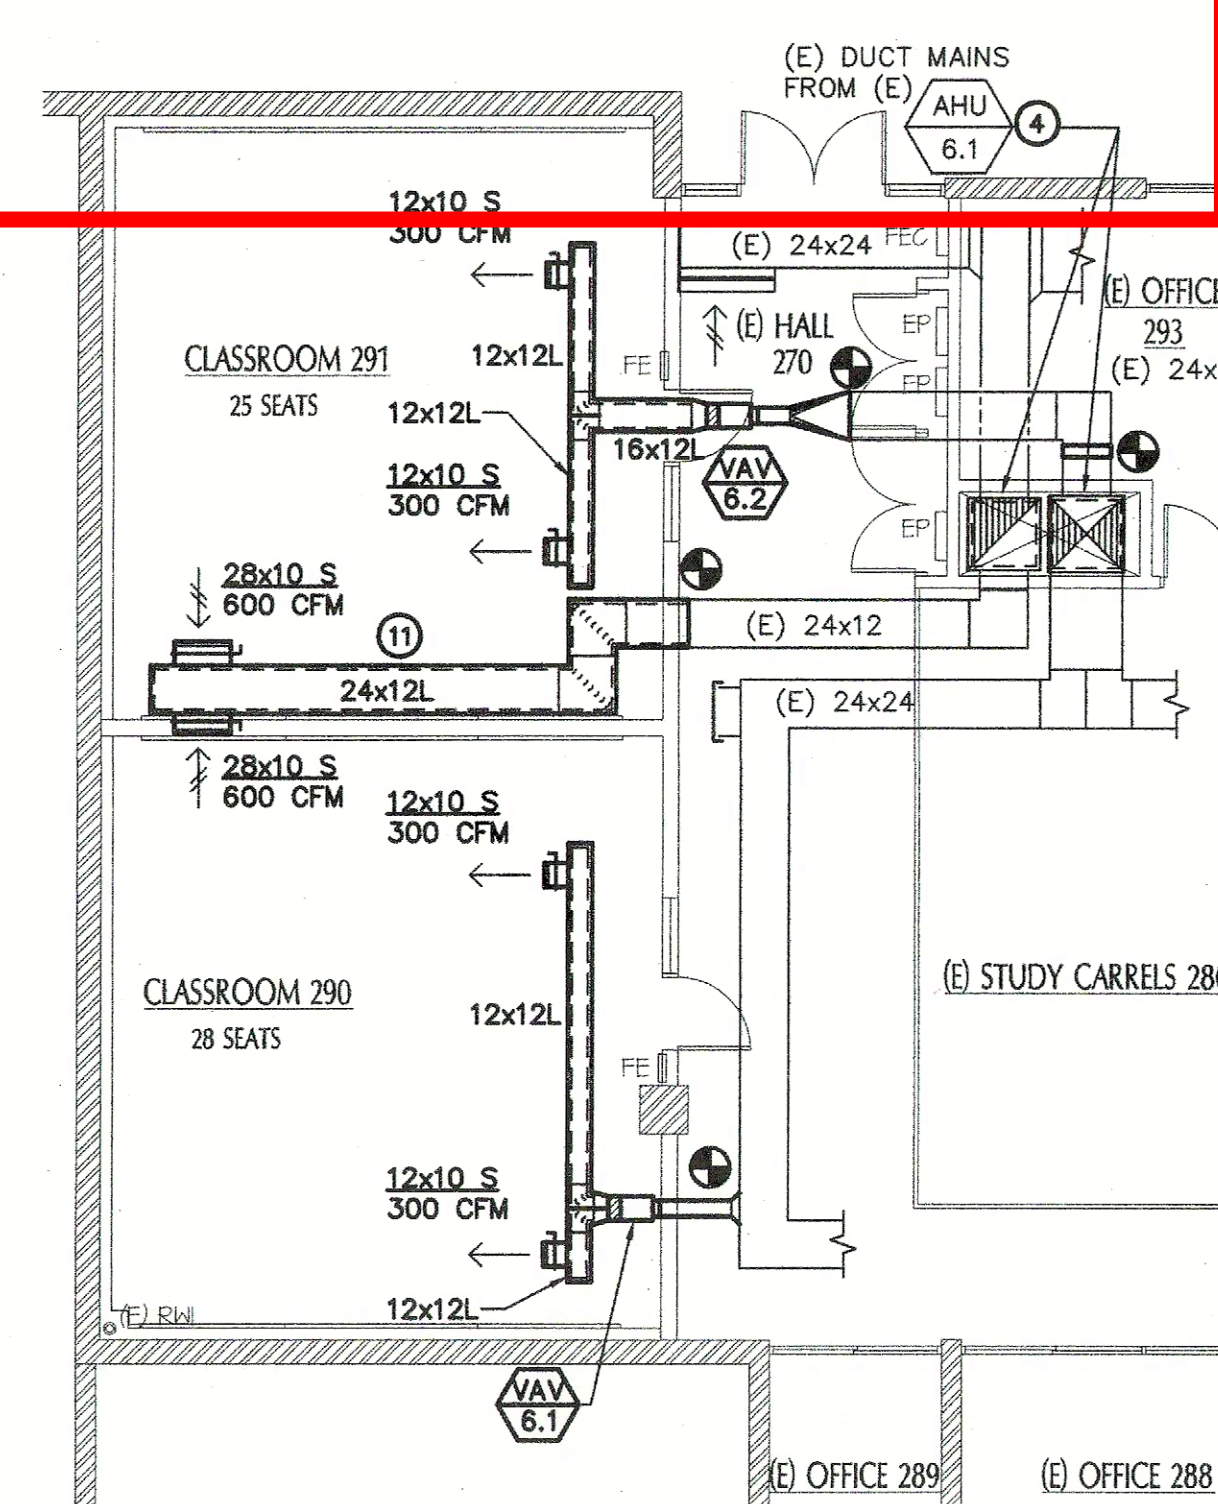


HVAC FLOOR PLAN - SECTOR 6

SCALE: 1/8" = 1'-0"

3
M2.0

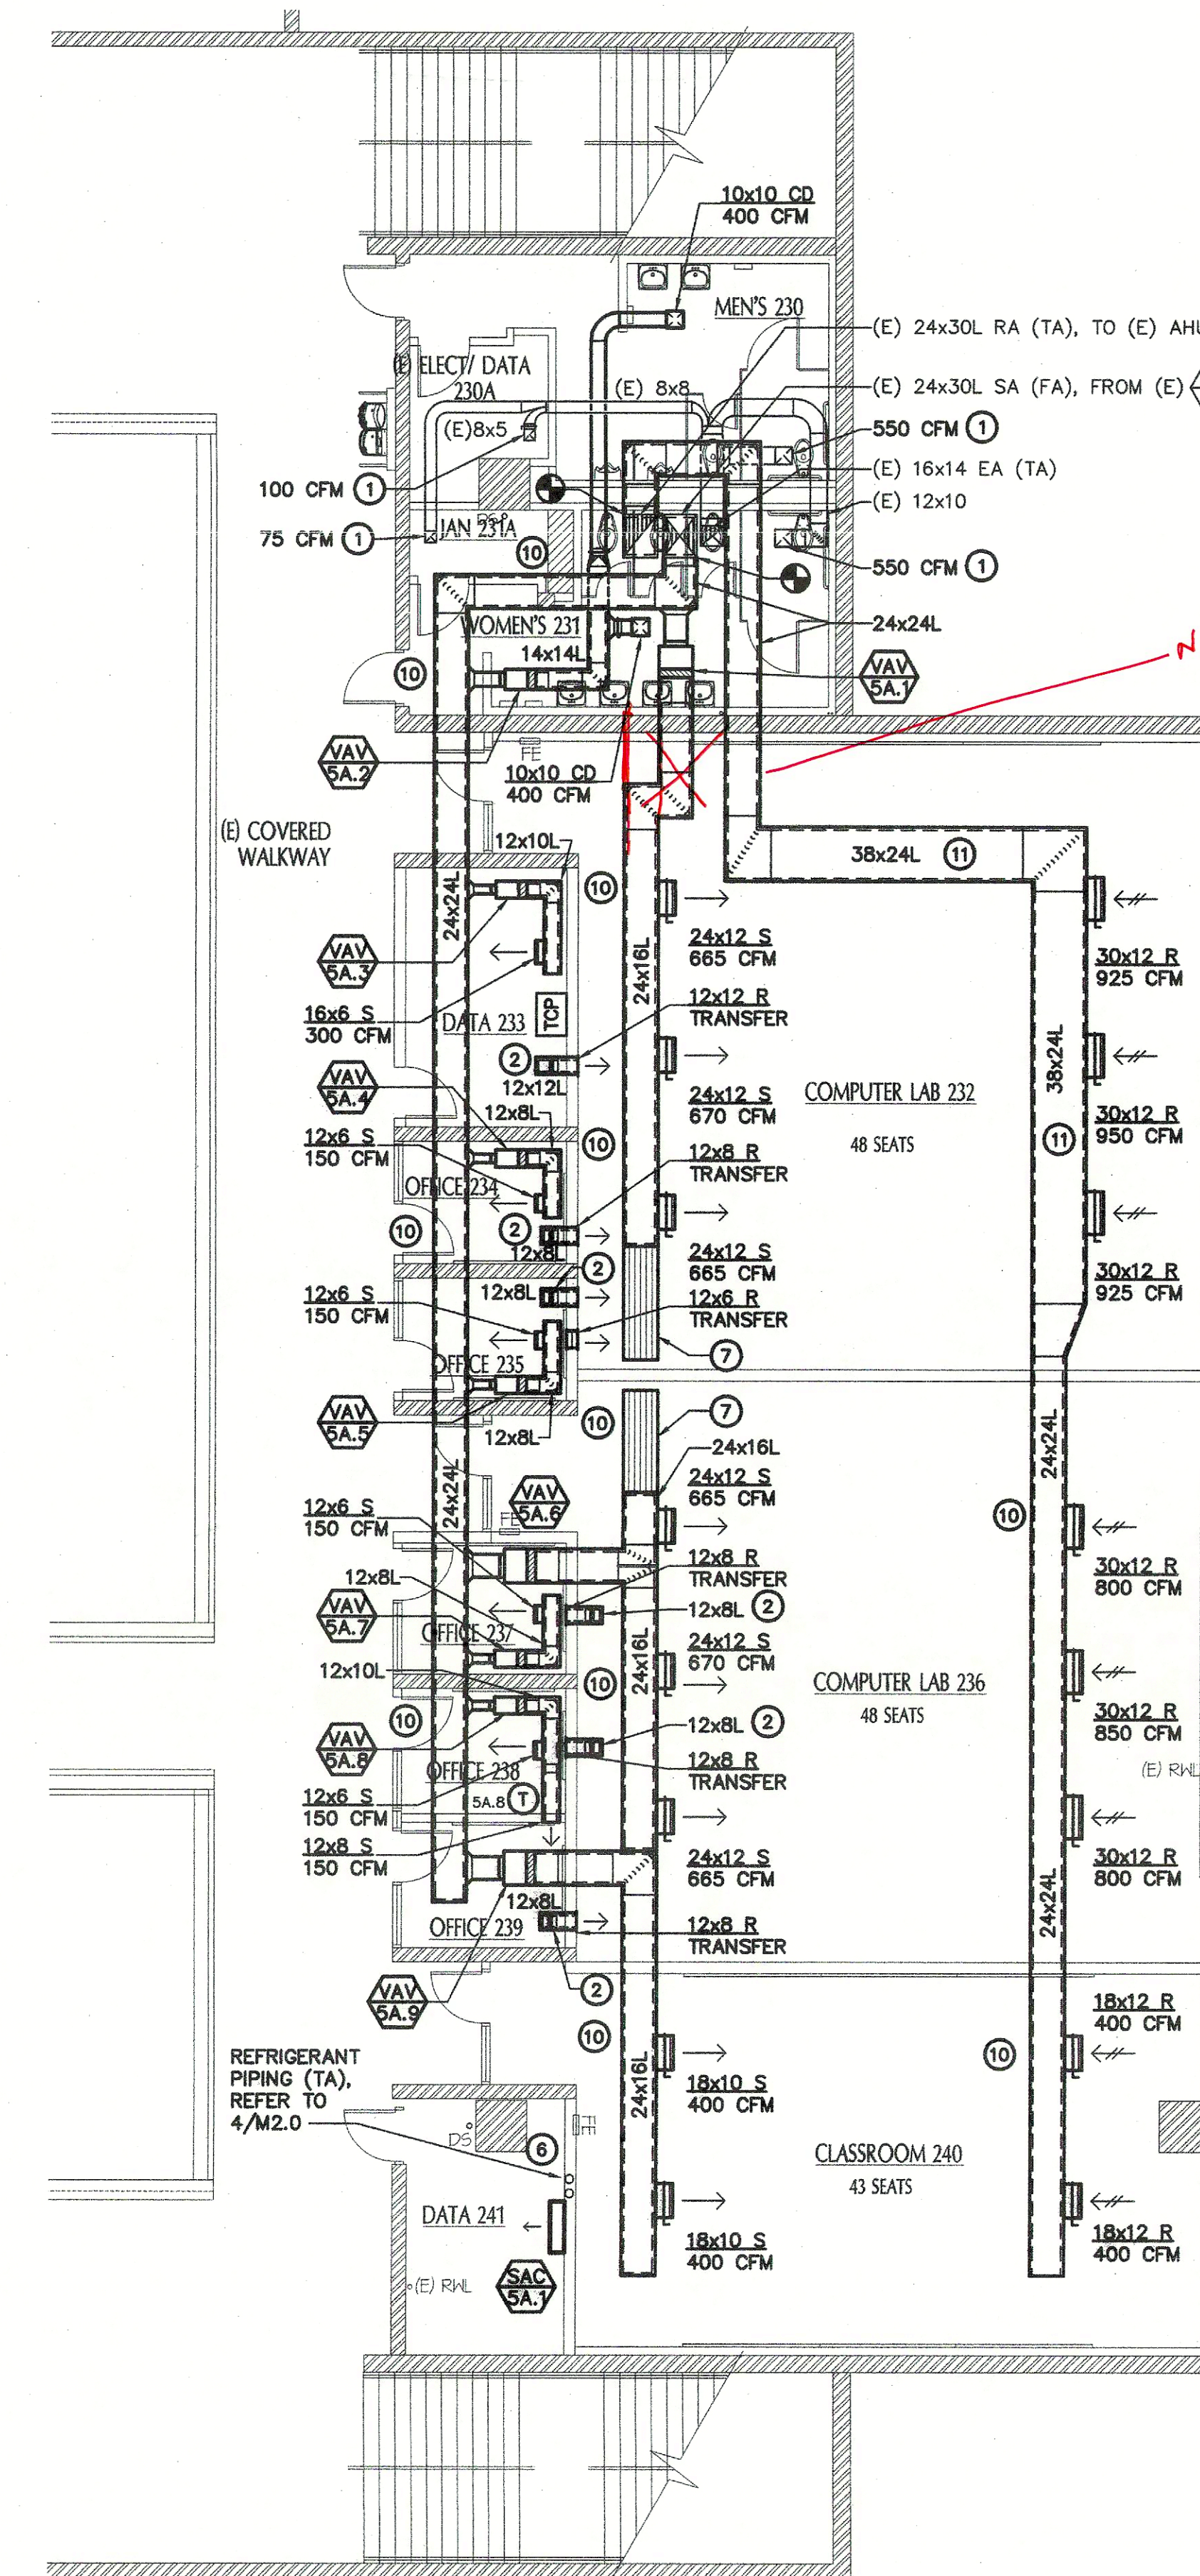




FAN SCHEDULE														
STATIC DEFLECT. INCHES	MARK	MINIMUM FAN CHARACTERISTICS				MOTOR CHARACTERISTICS				AREA SERVED	ACCEPTABLE MANUFACTURER'S DESIGNATION	REMARKS	APPROX. WT. IN LBS.	
		WHEEL DIA. INCHES	CFM	EST. S.P.	B.H.P.	WHEEL TYPE	R.P.M.	MIN. H.P.	START. TYPE	VOLTAGE AND PHASE	START. CONTROL			
	E-131	24	2975	1/2	—	B.1.	570	1/2	MAN.	120-16	S-B	SECTOR (3)	BRADERT L6-2407	ROOF EXH. FAN
														300

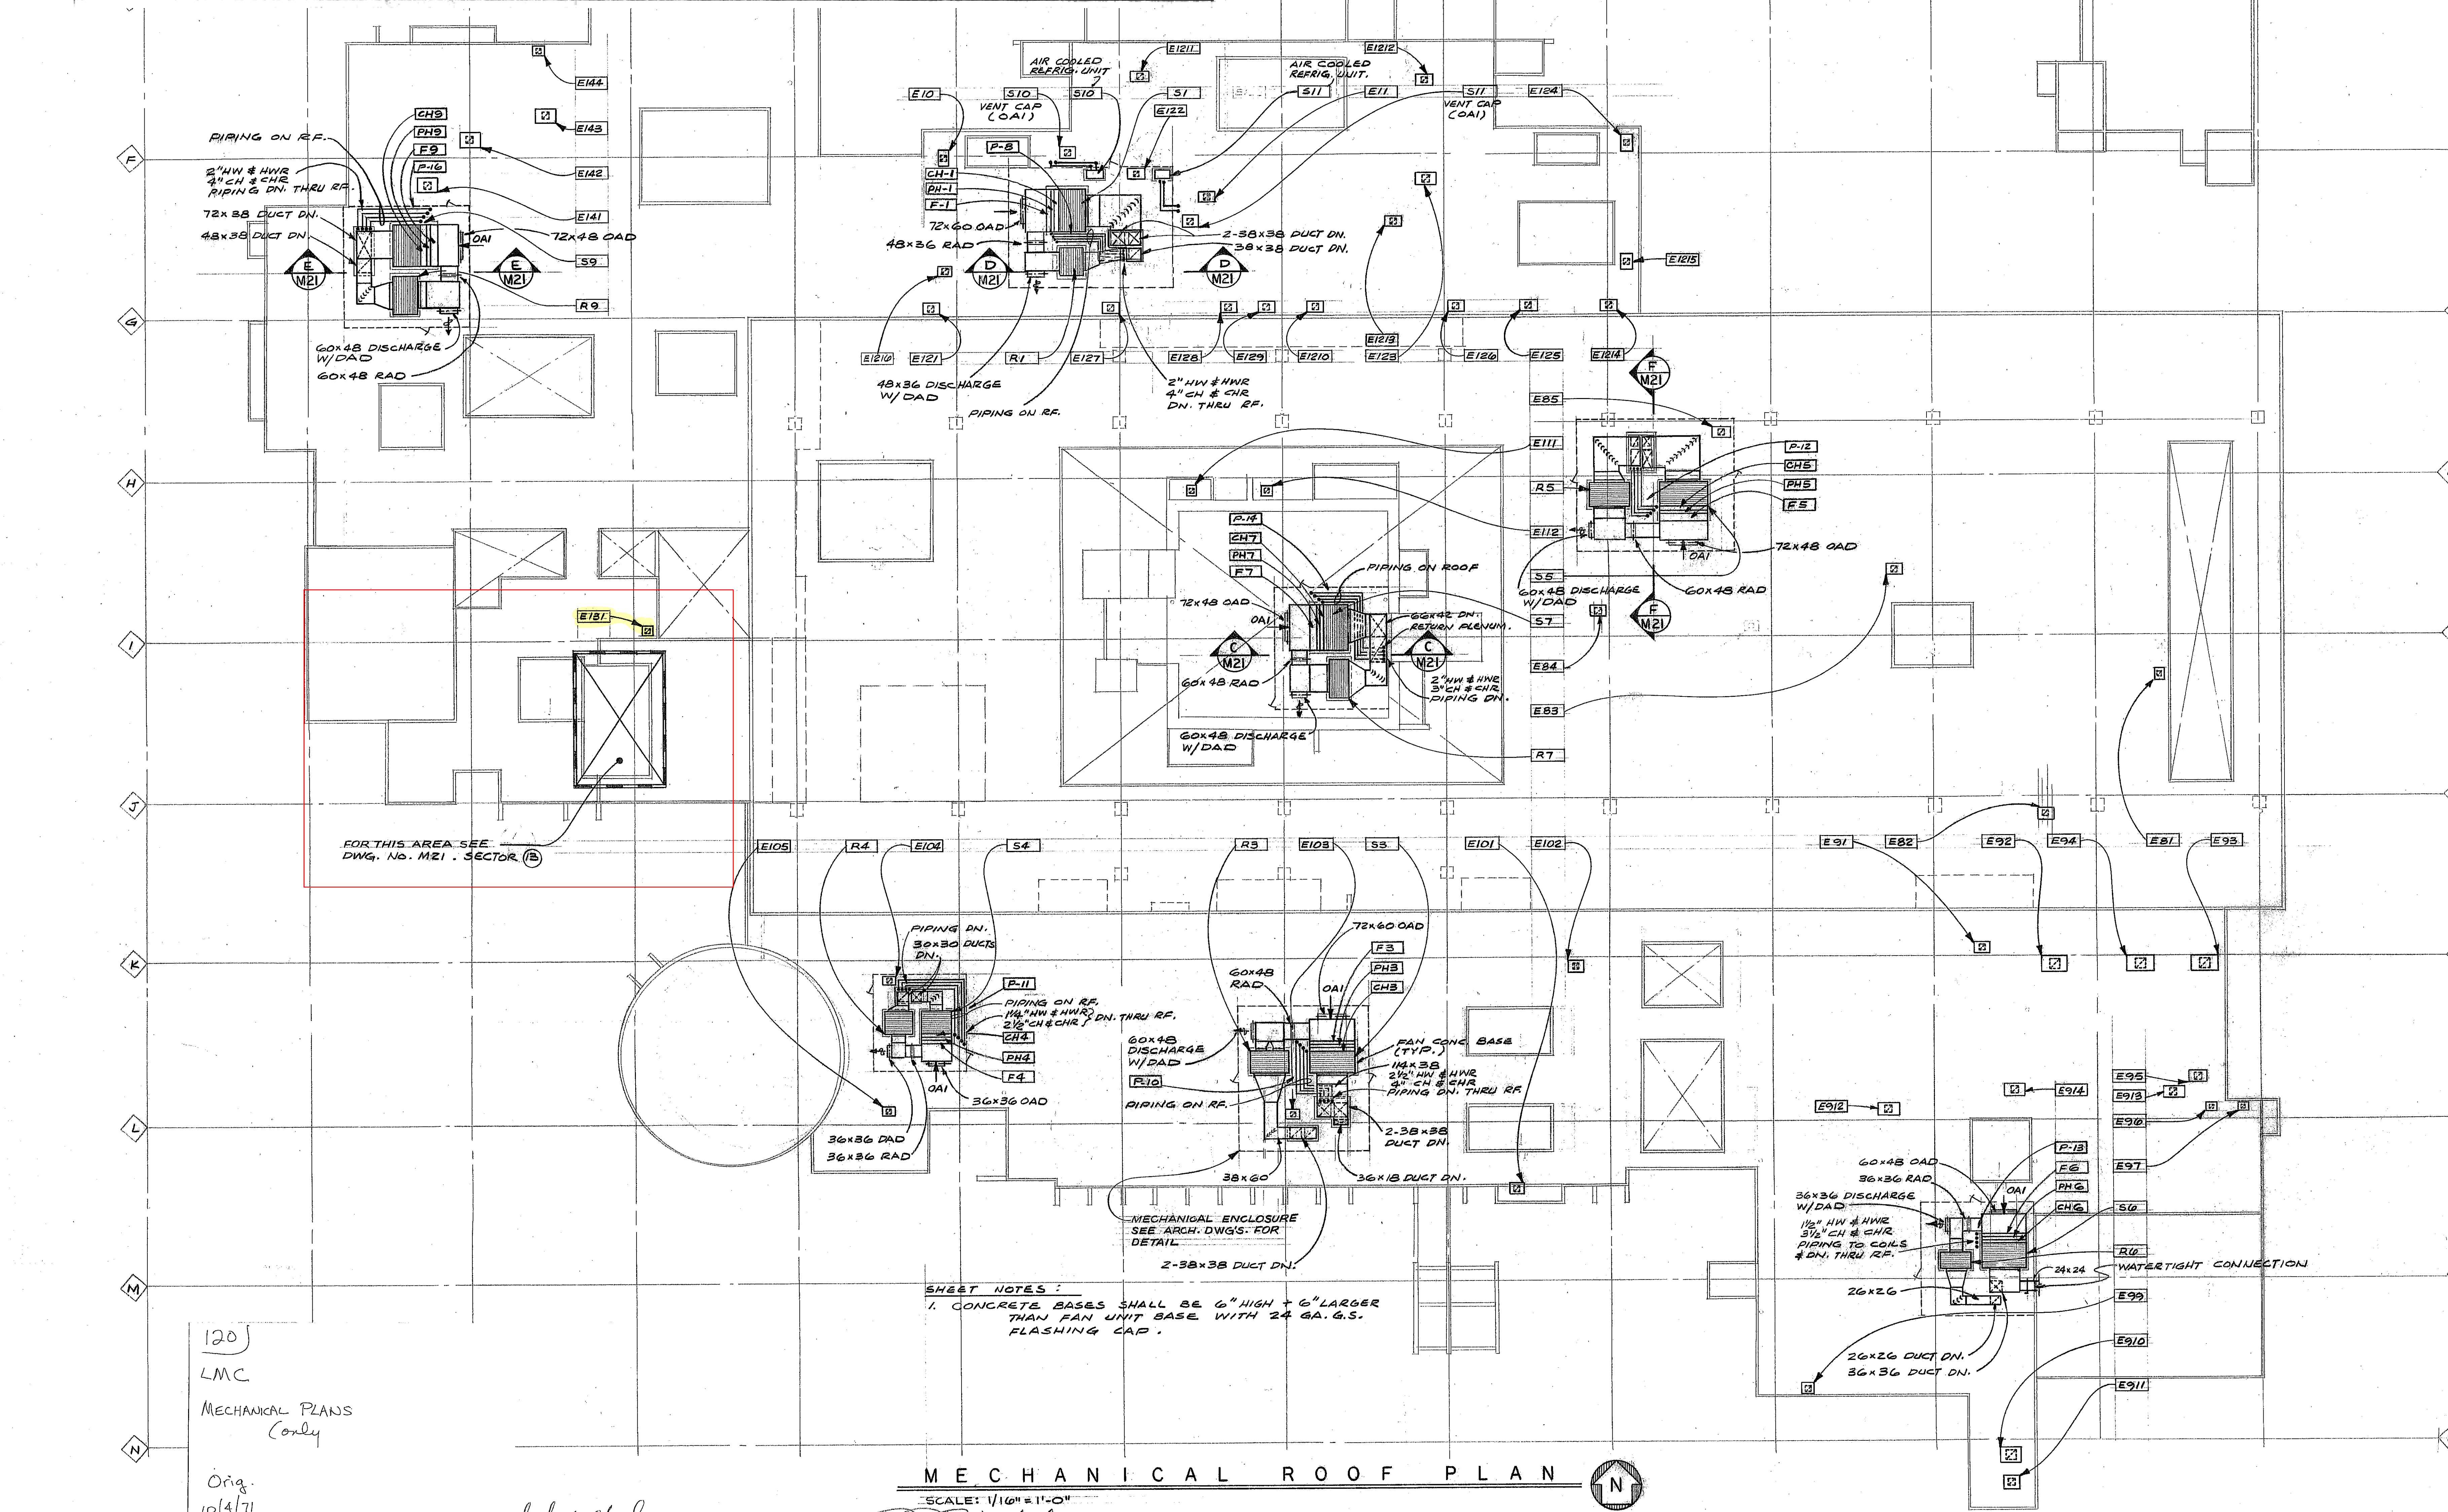

SHEET NOTES:
 1. CONCRETE BASES SHALL BE 6" HIGH + 6" LARGER THAN FAN UNIT BASE WITH 24 GA. G.S. FLASHING CAP.



120
 LMC
 MECHANICAL PLANS
 Only
 Orig.
 10/4/71

MECHANICAL ROOF PLAN
 SCALE: 1/16" = 1'-0"

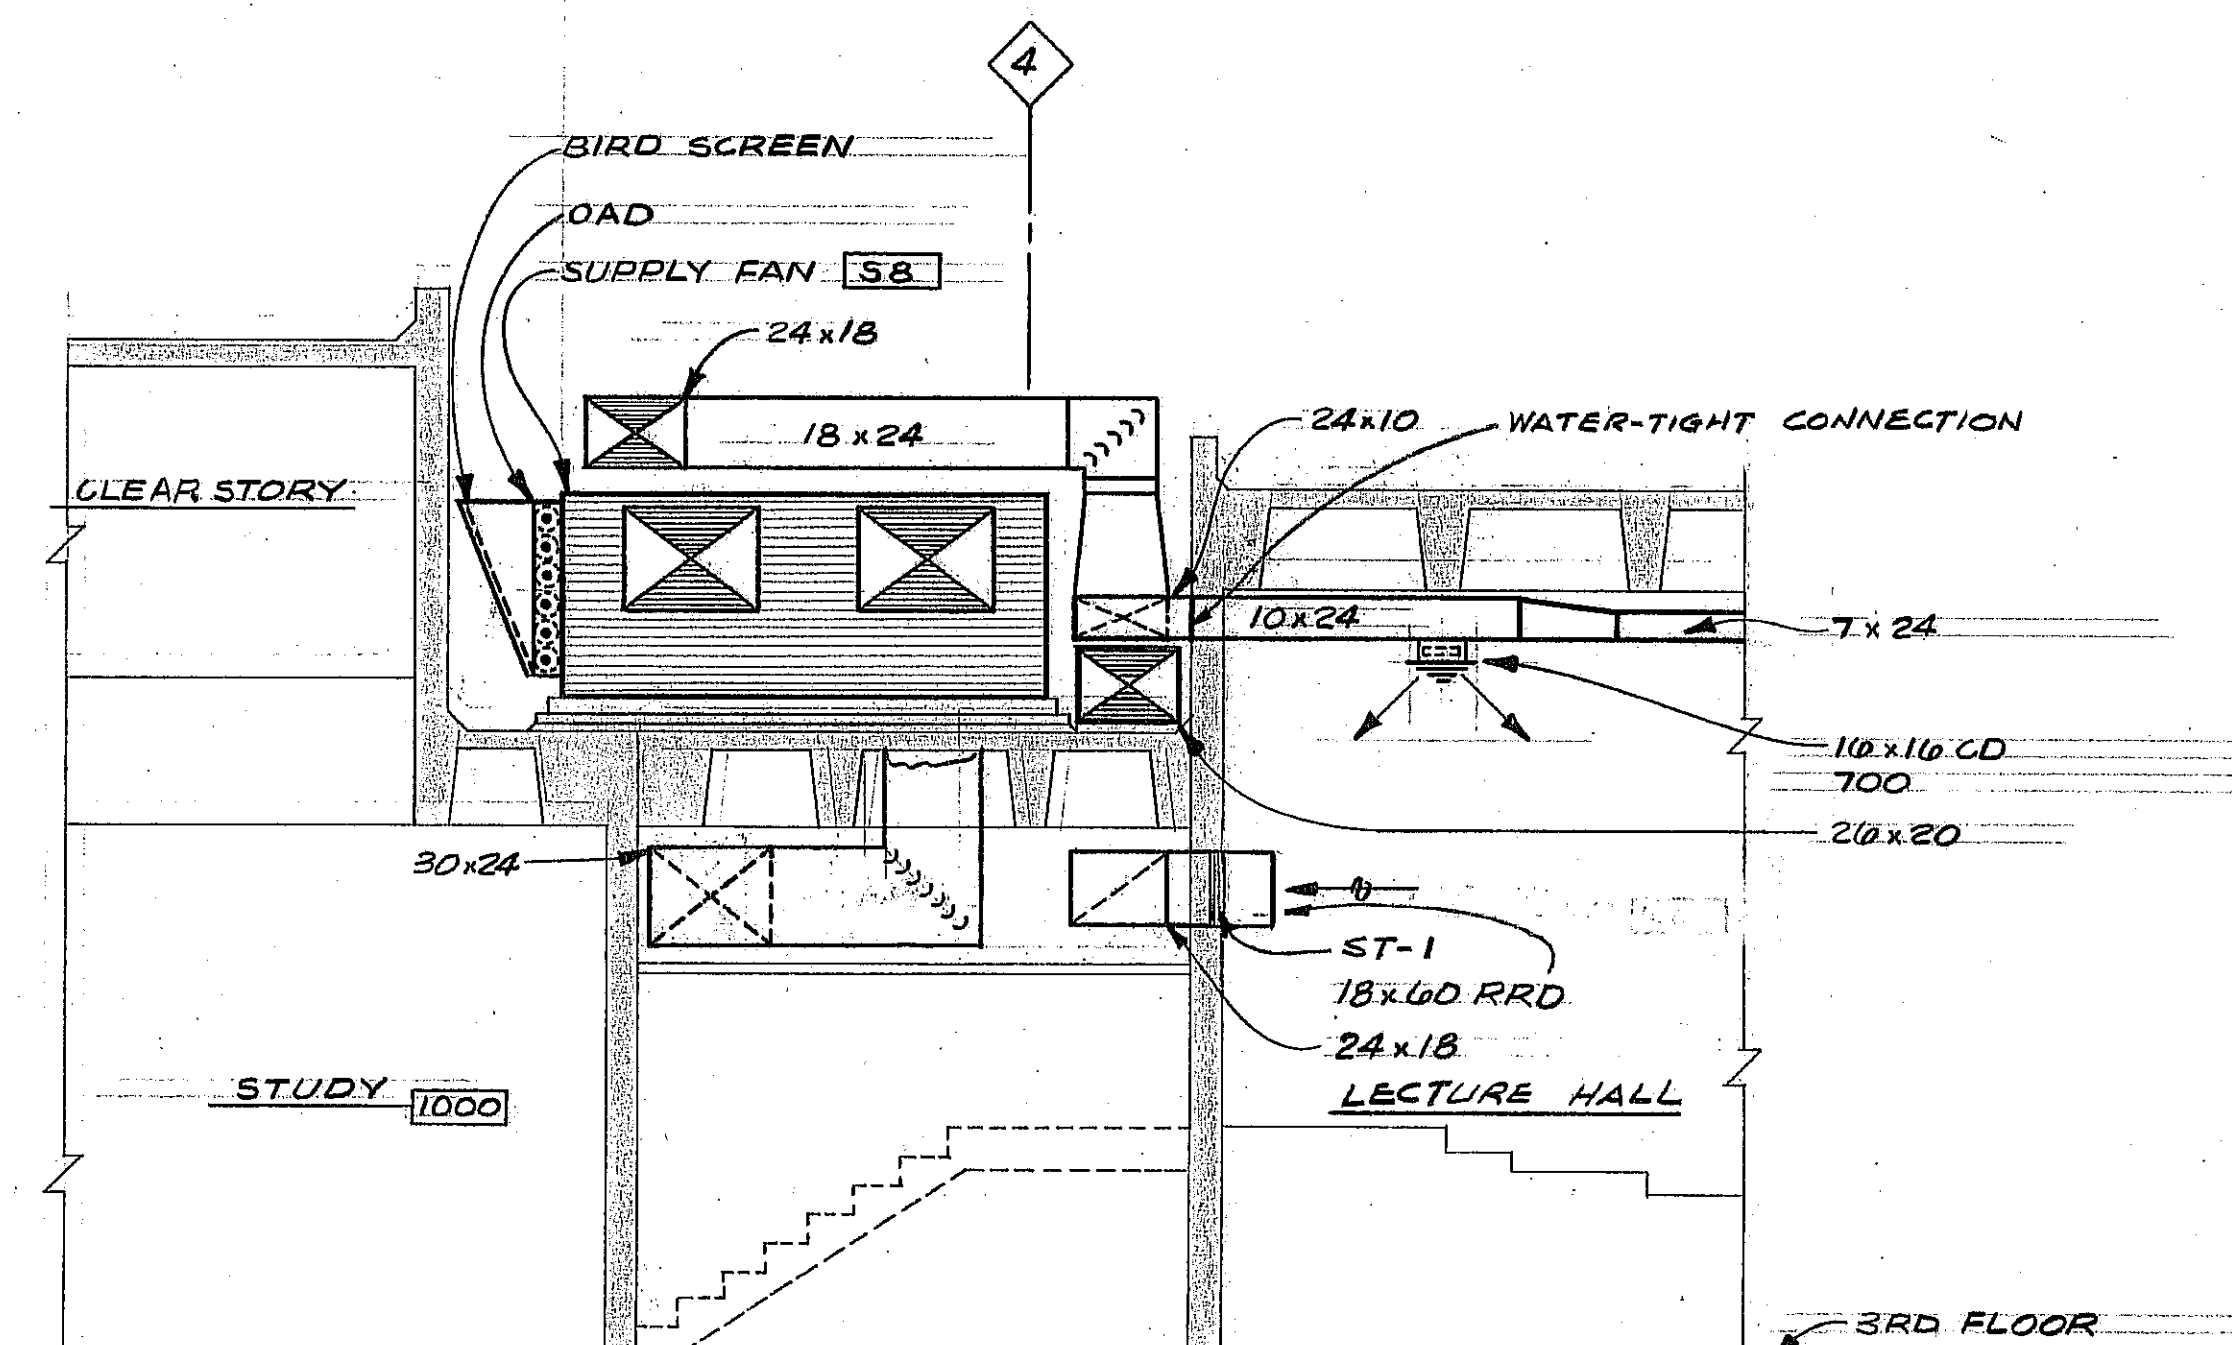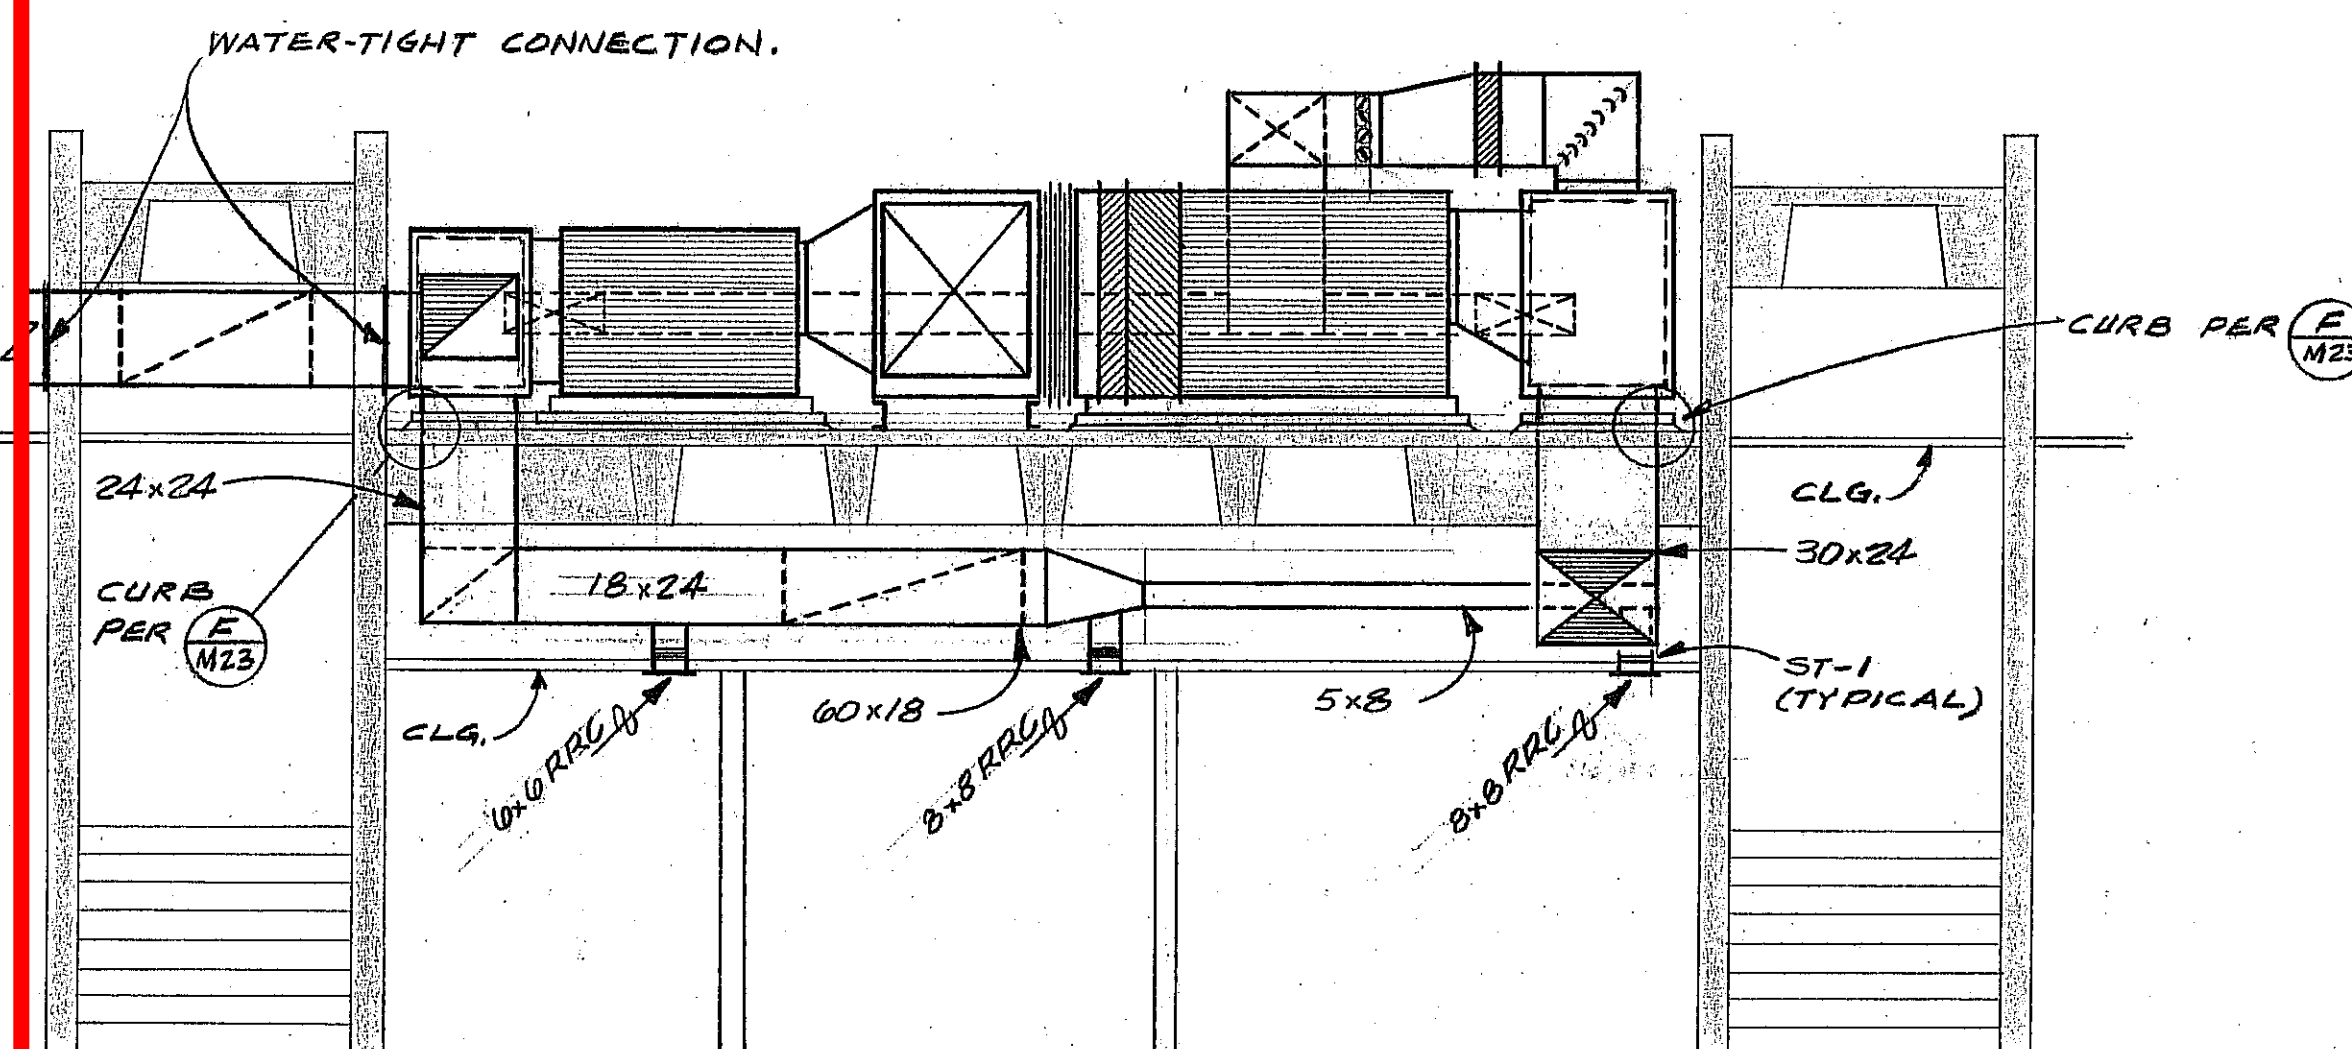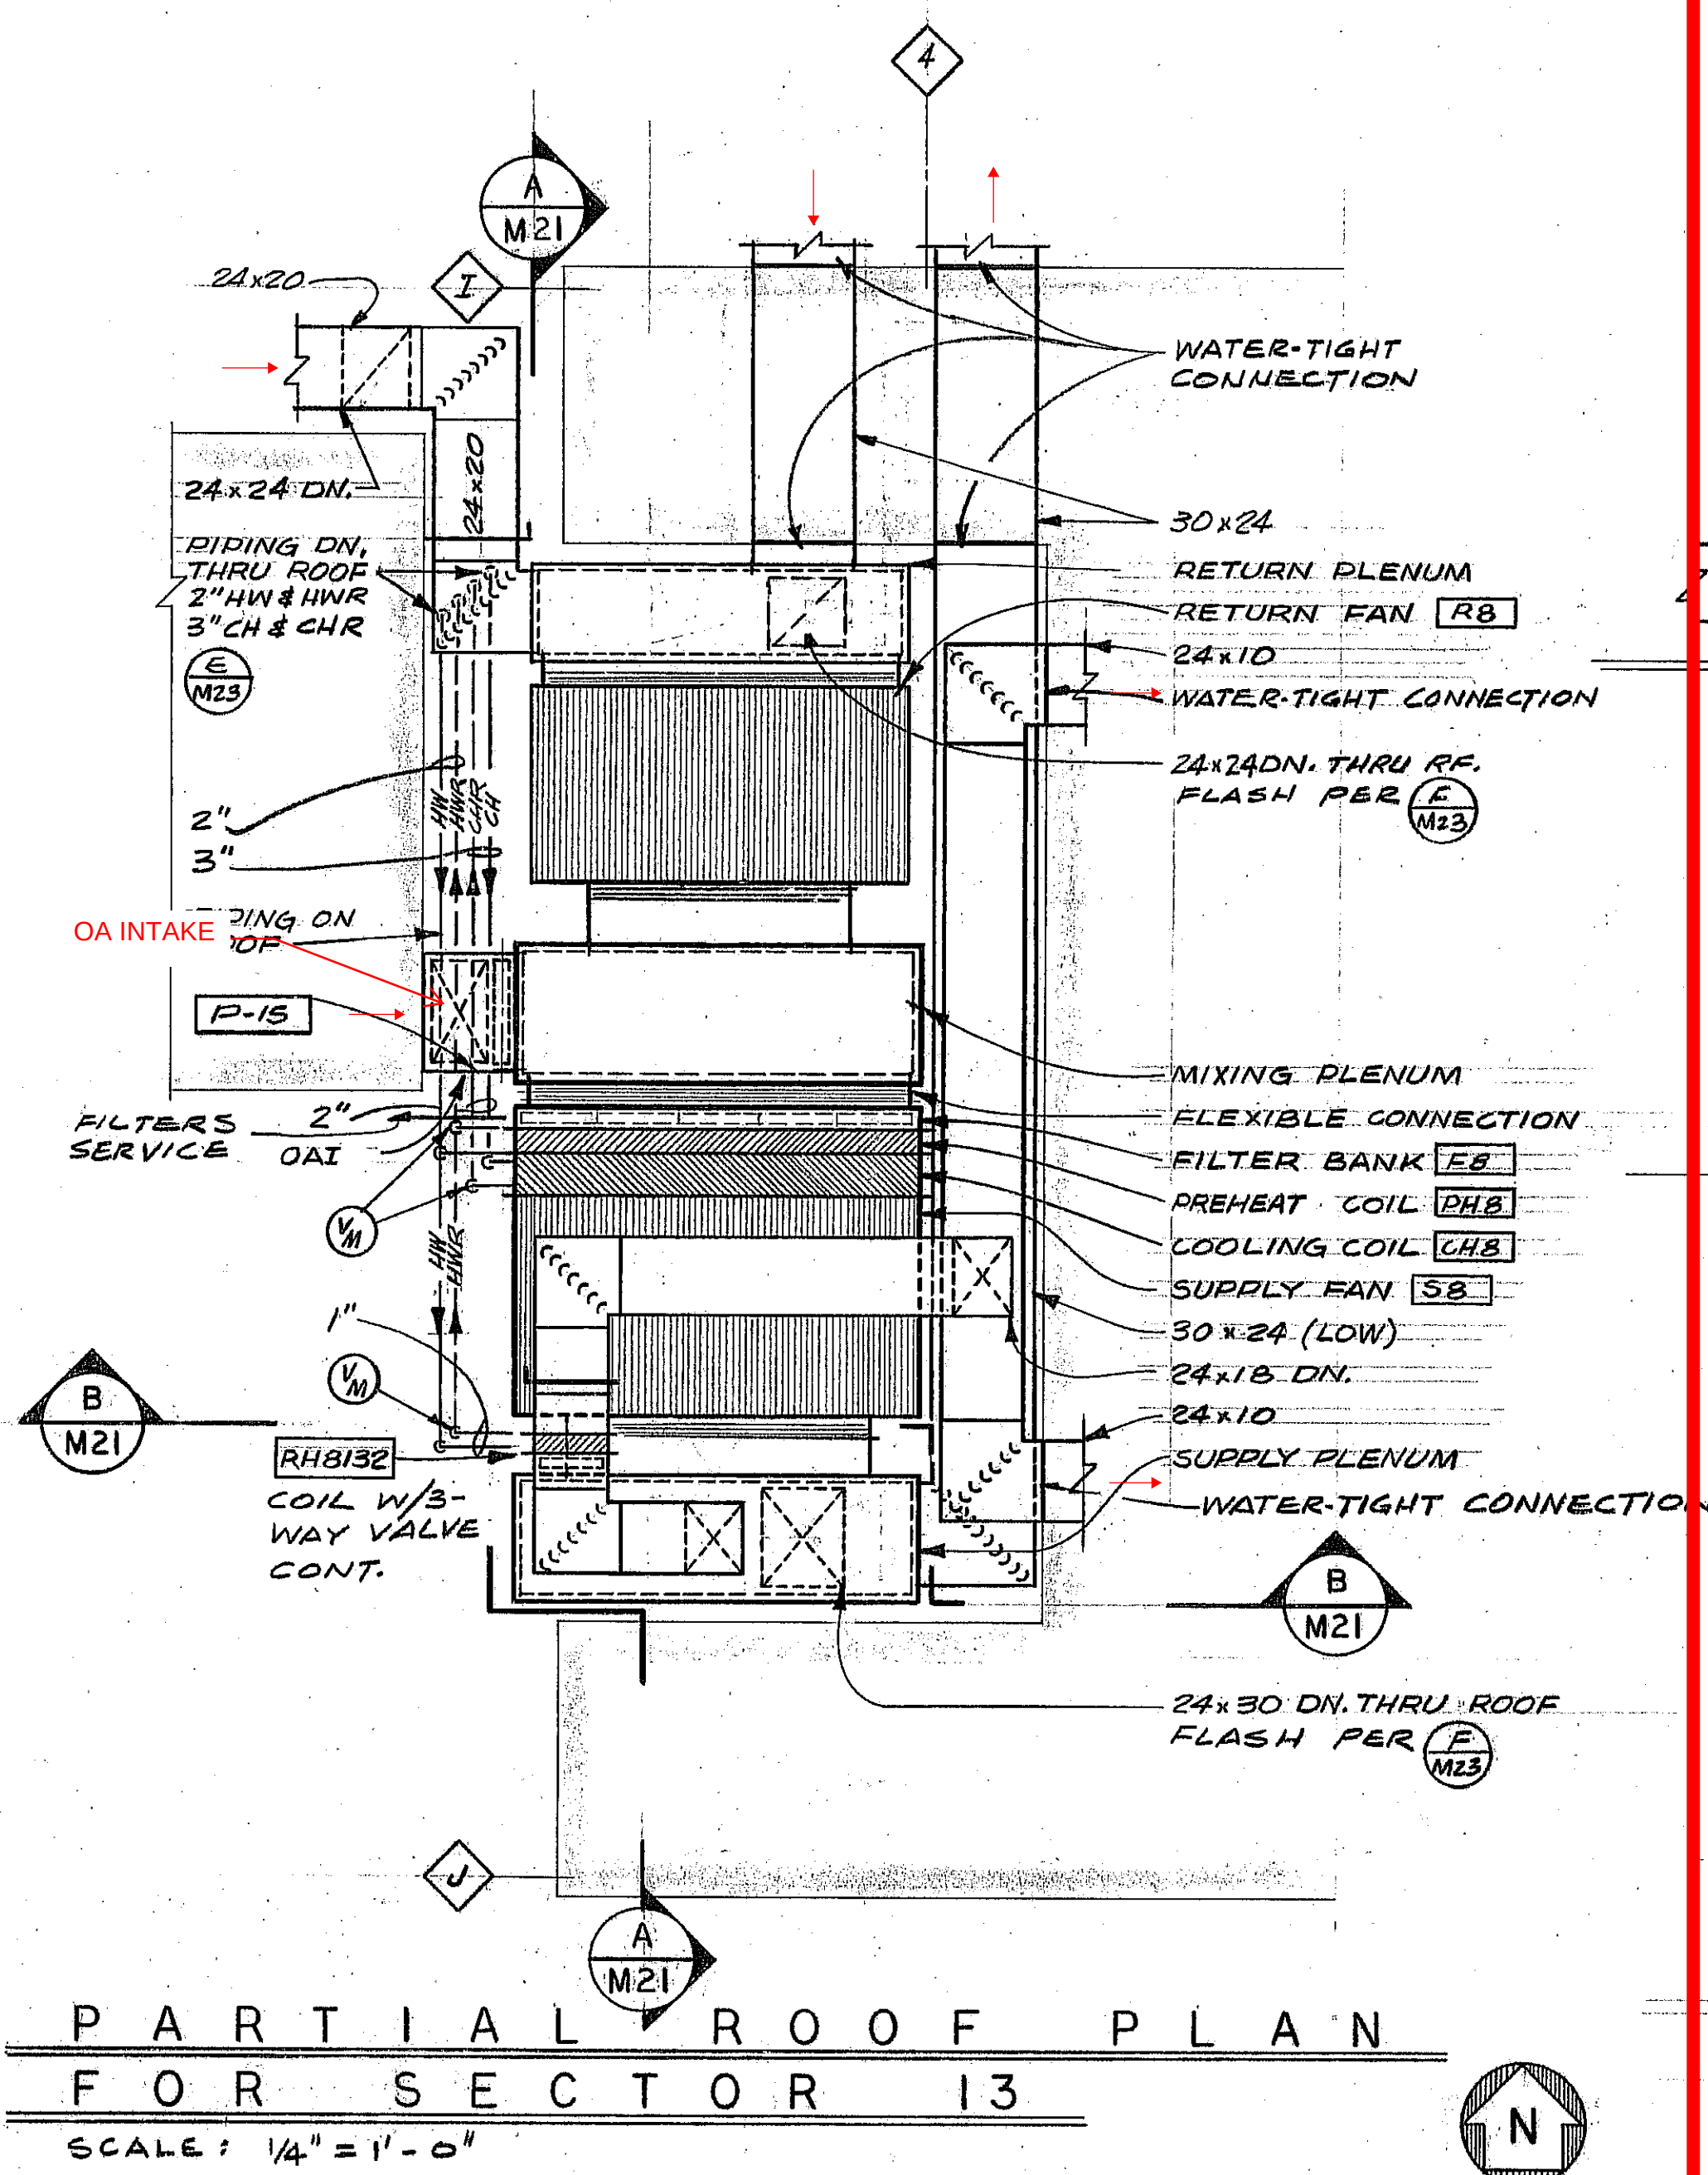



SECTION A
SCALE: 1/4" = 1'-0"

SECTION B
SCALE: 1/4" = 1'-0"

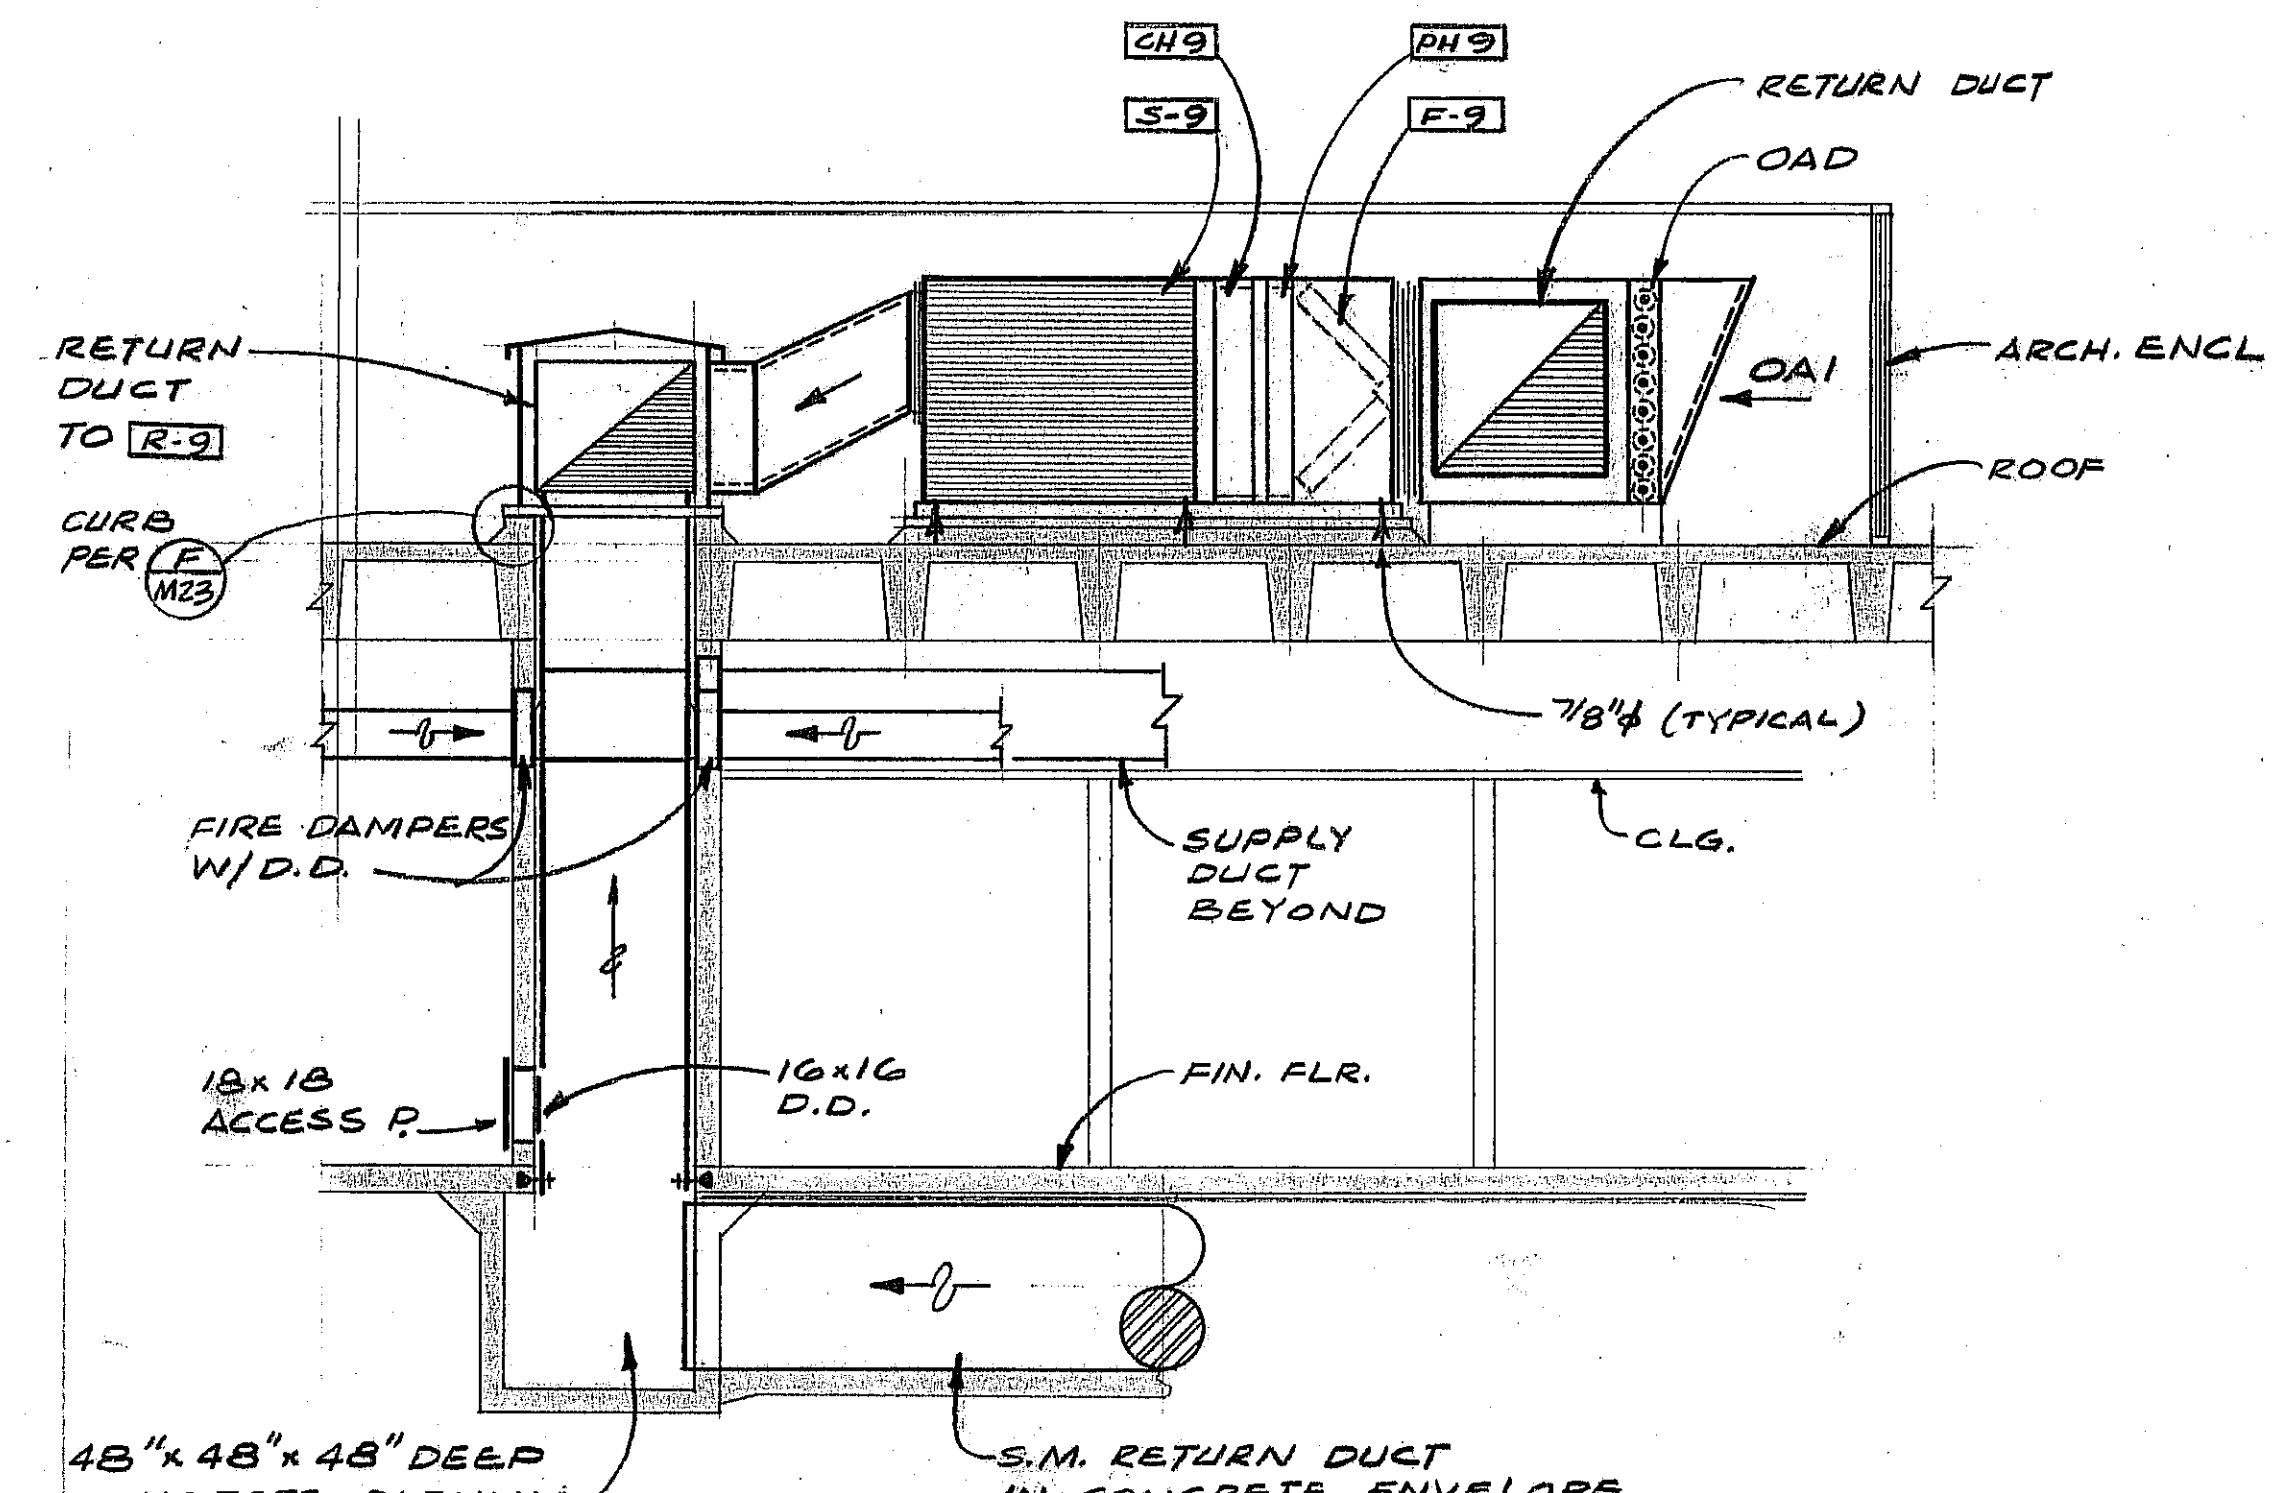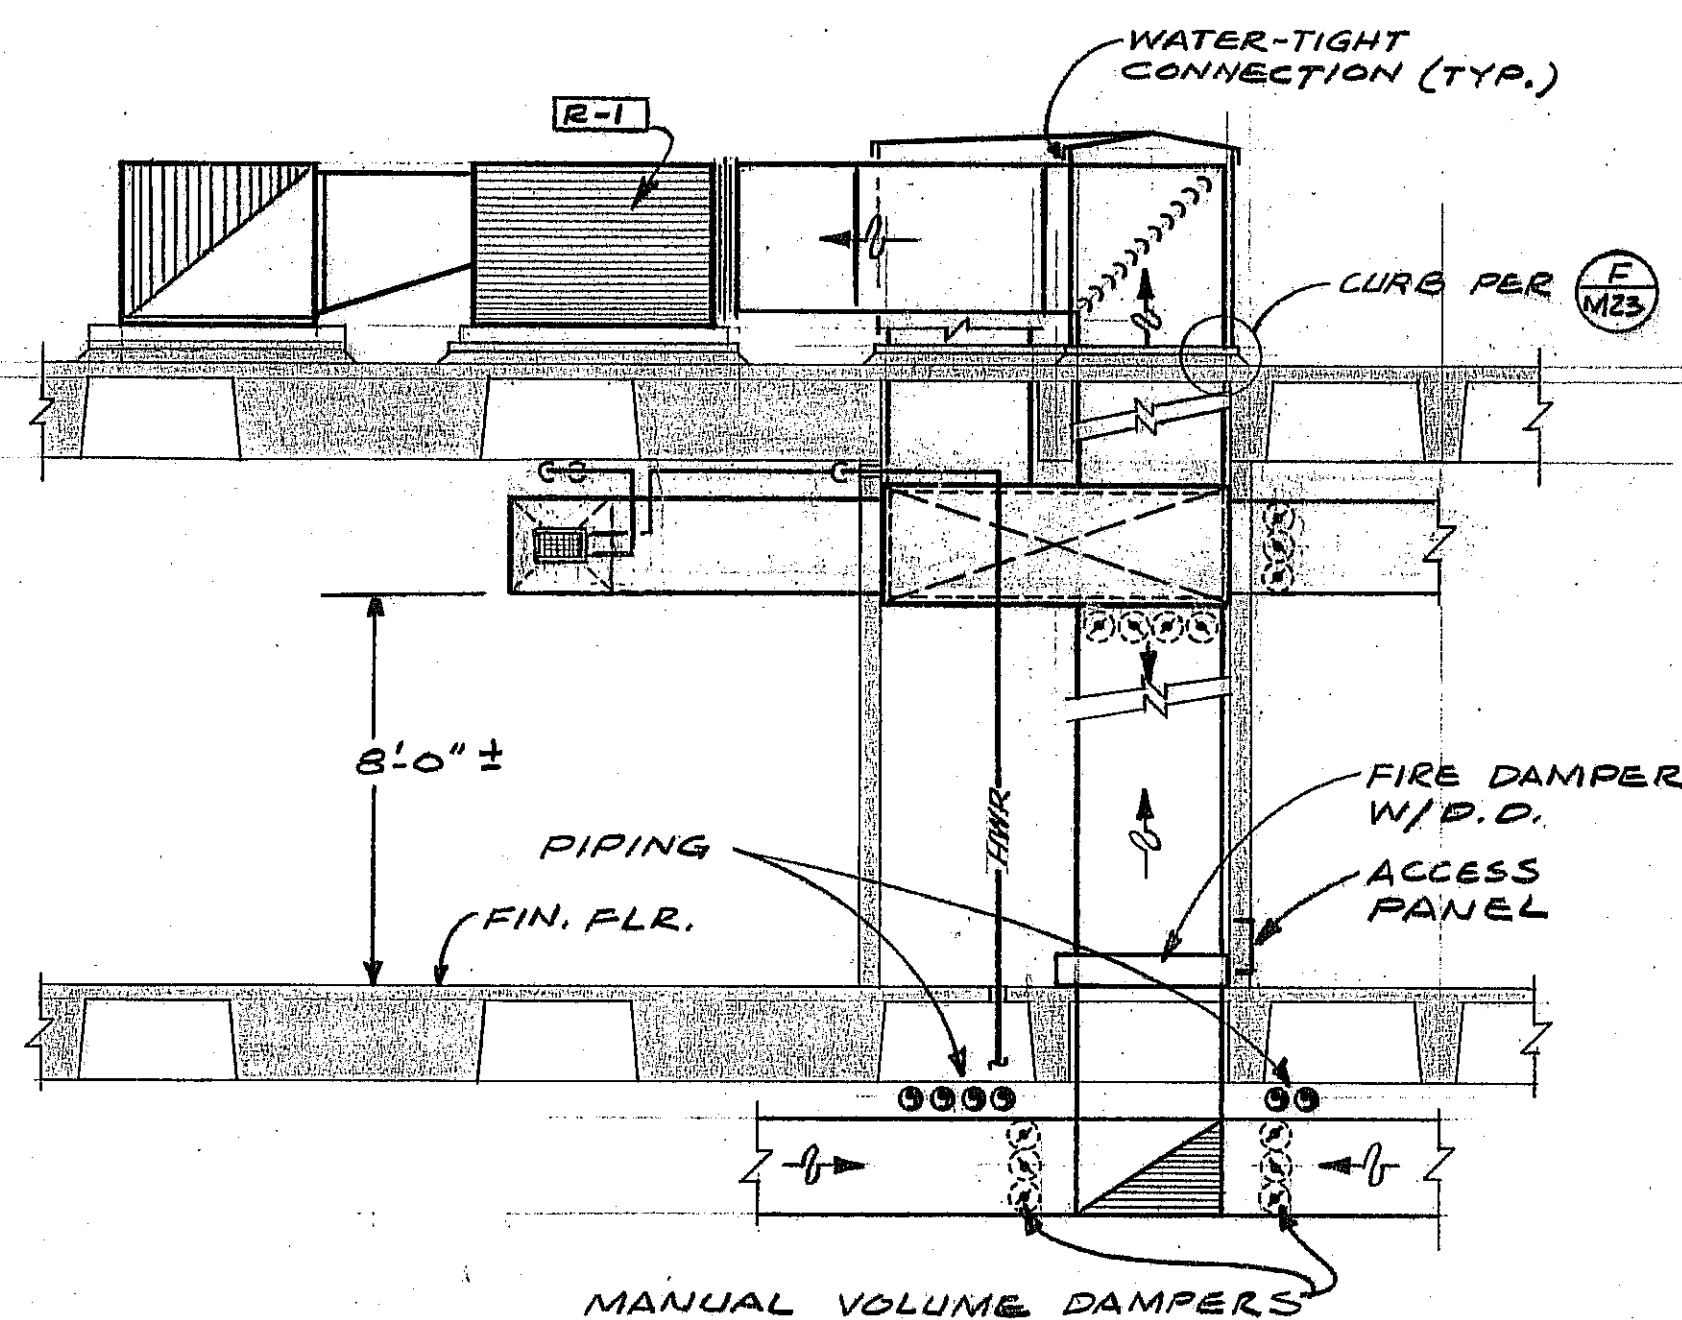

SECTION C
SCALE: 1/4" = 1'-0"

SECTION D
SCALE: 1/4" = 1'-0"

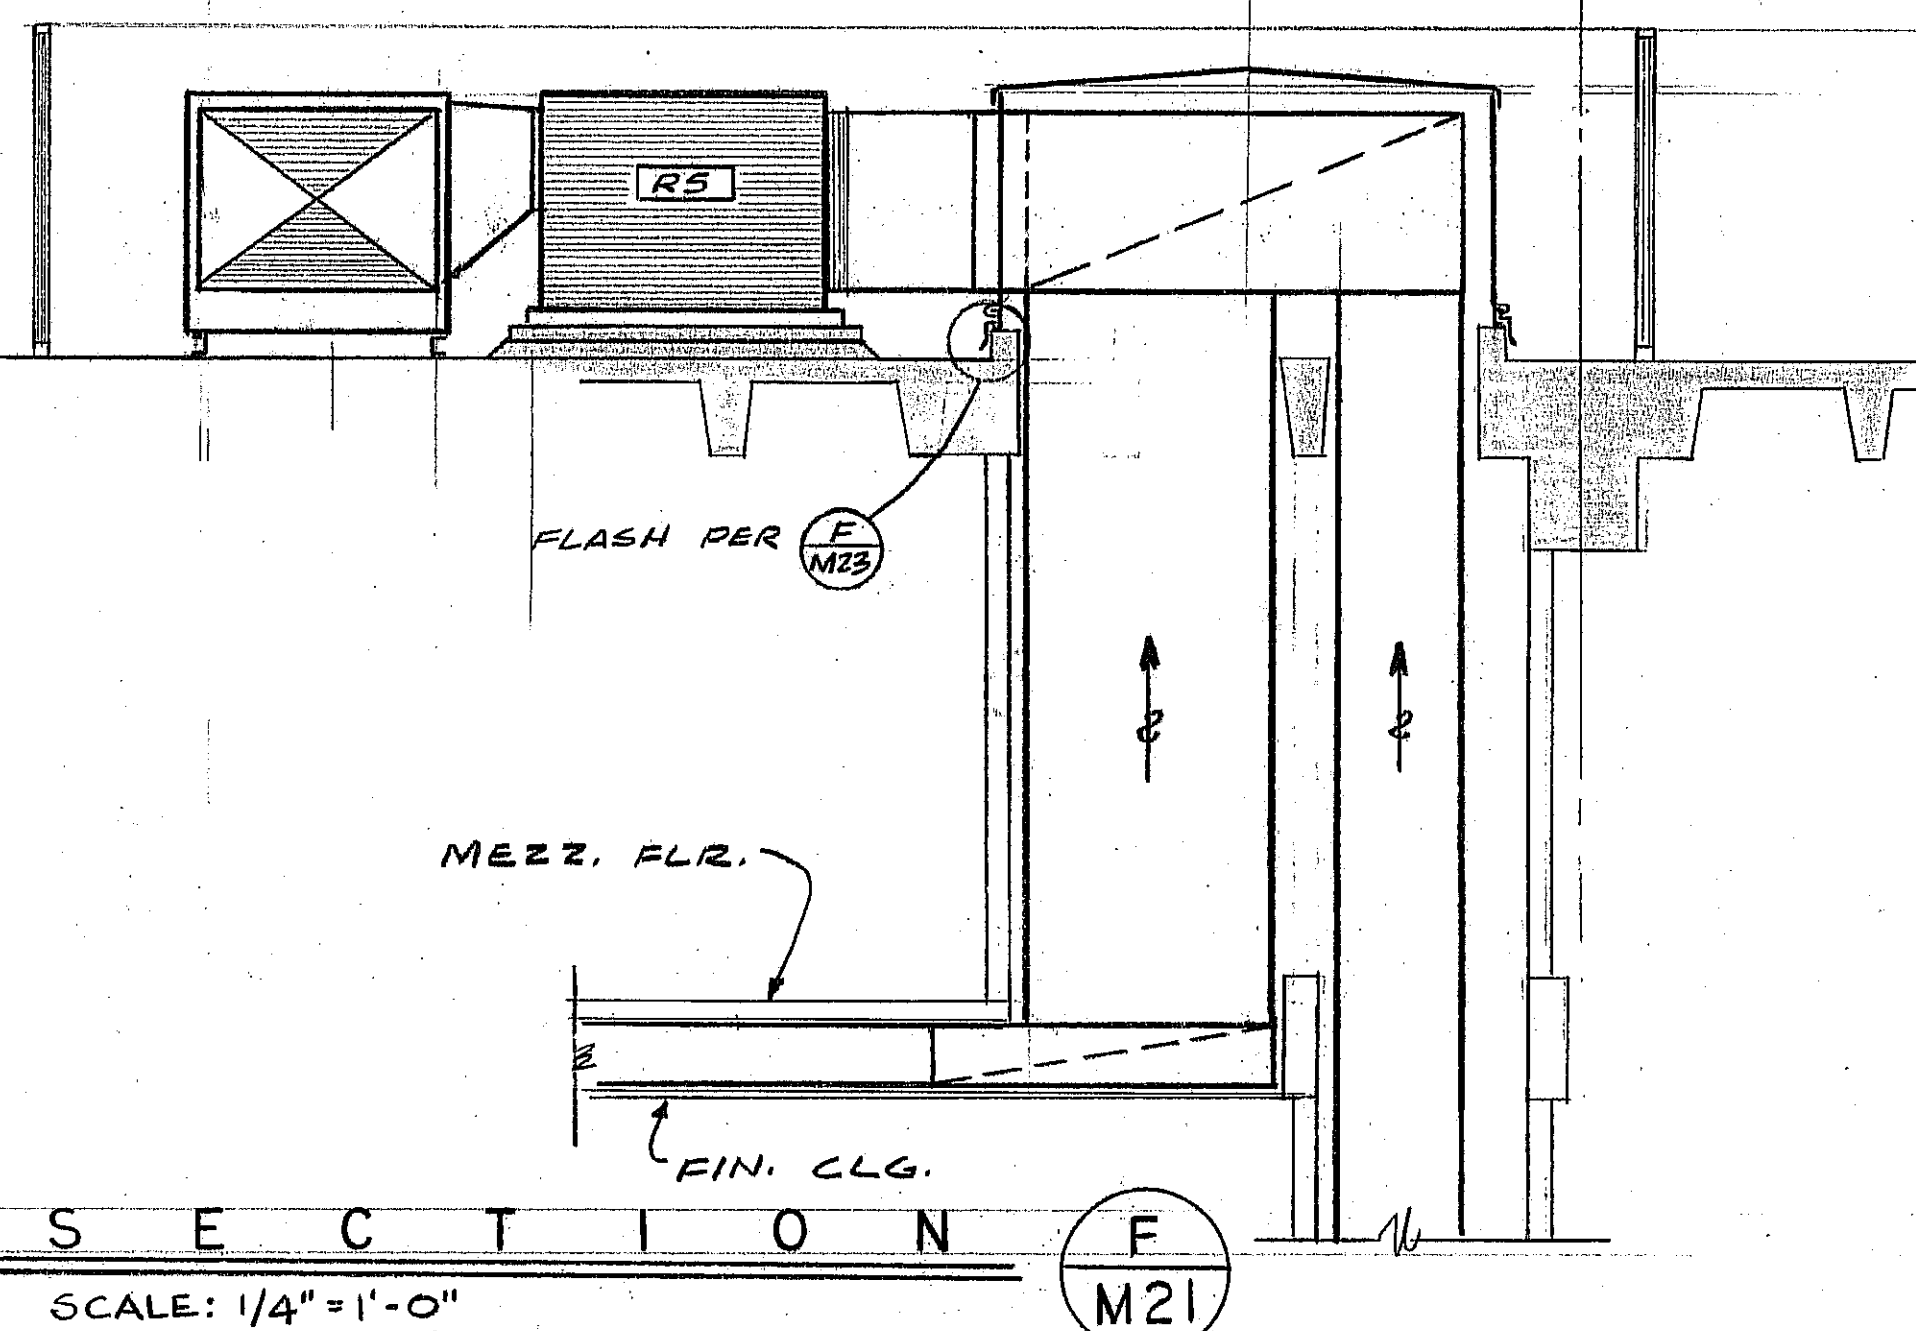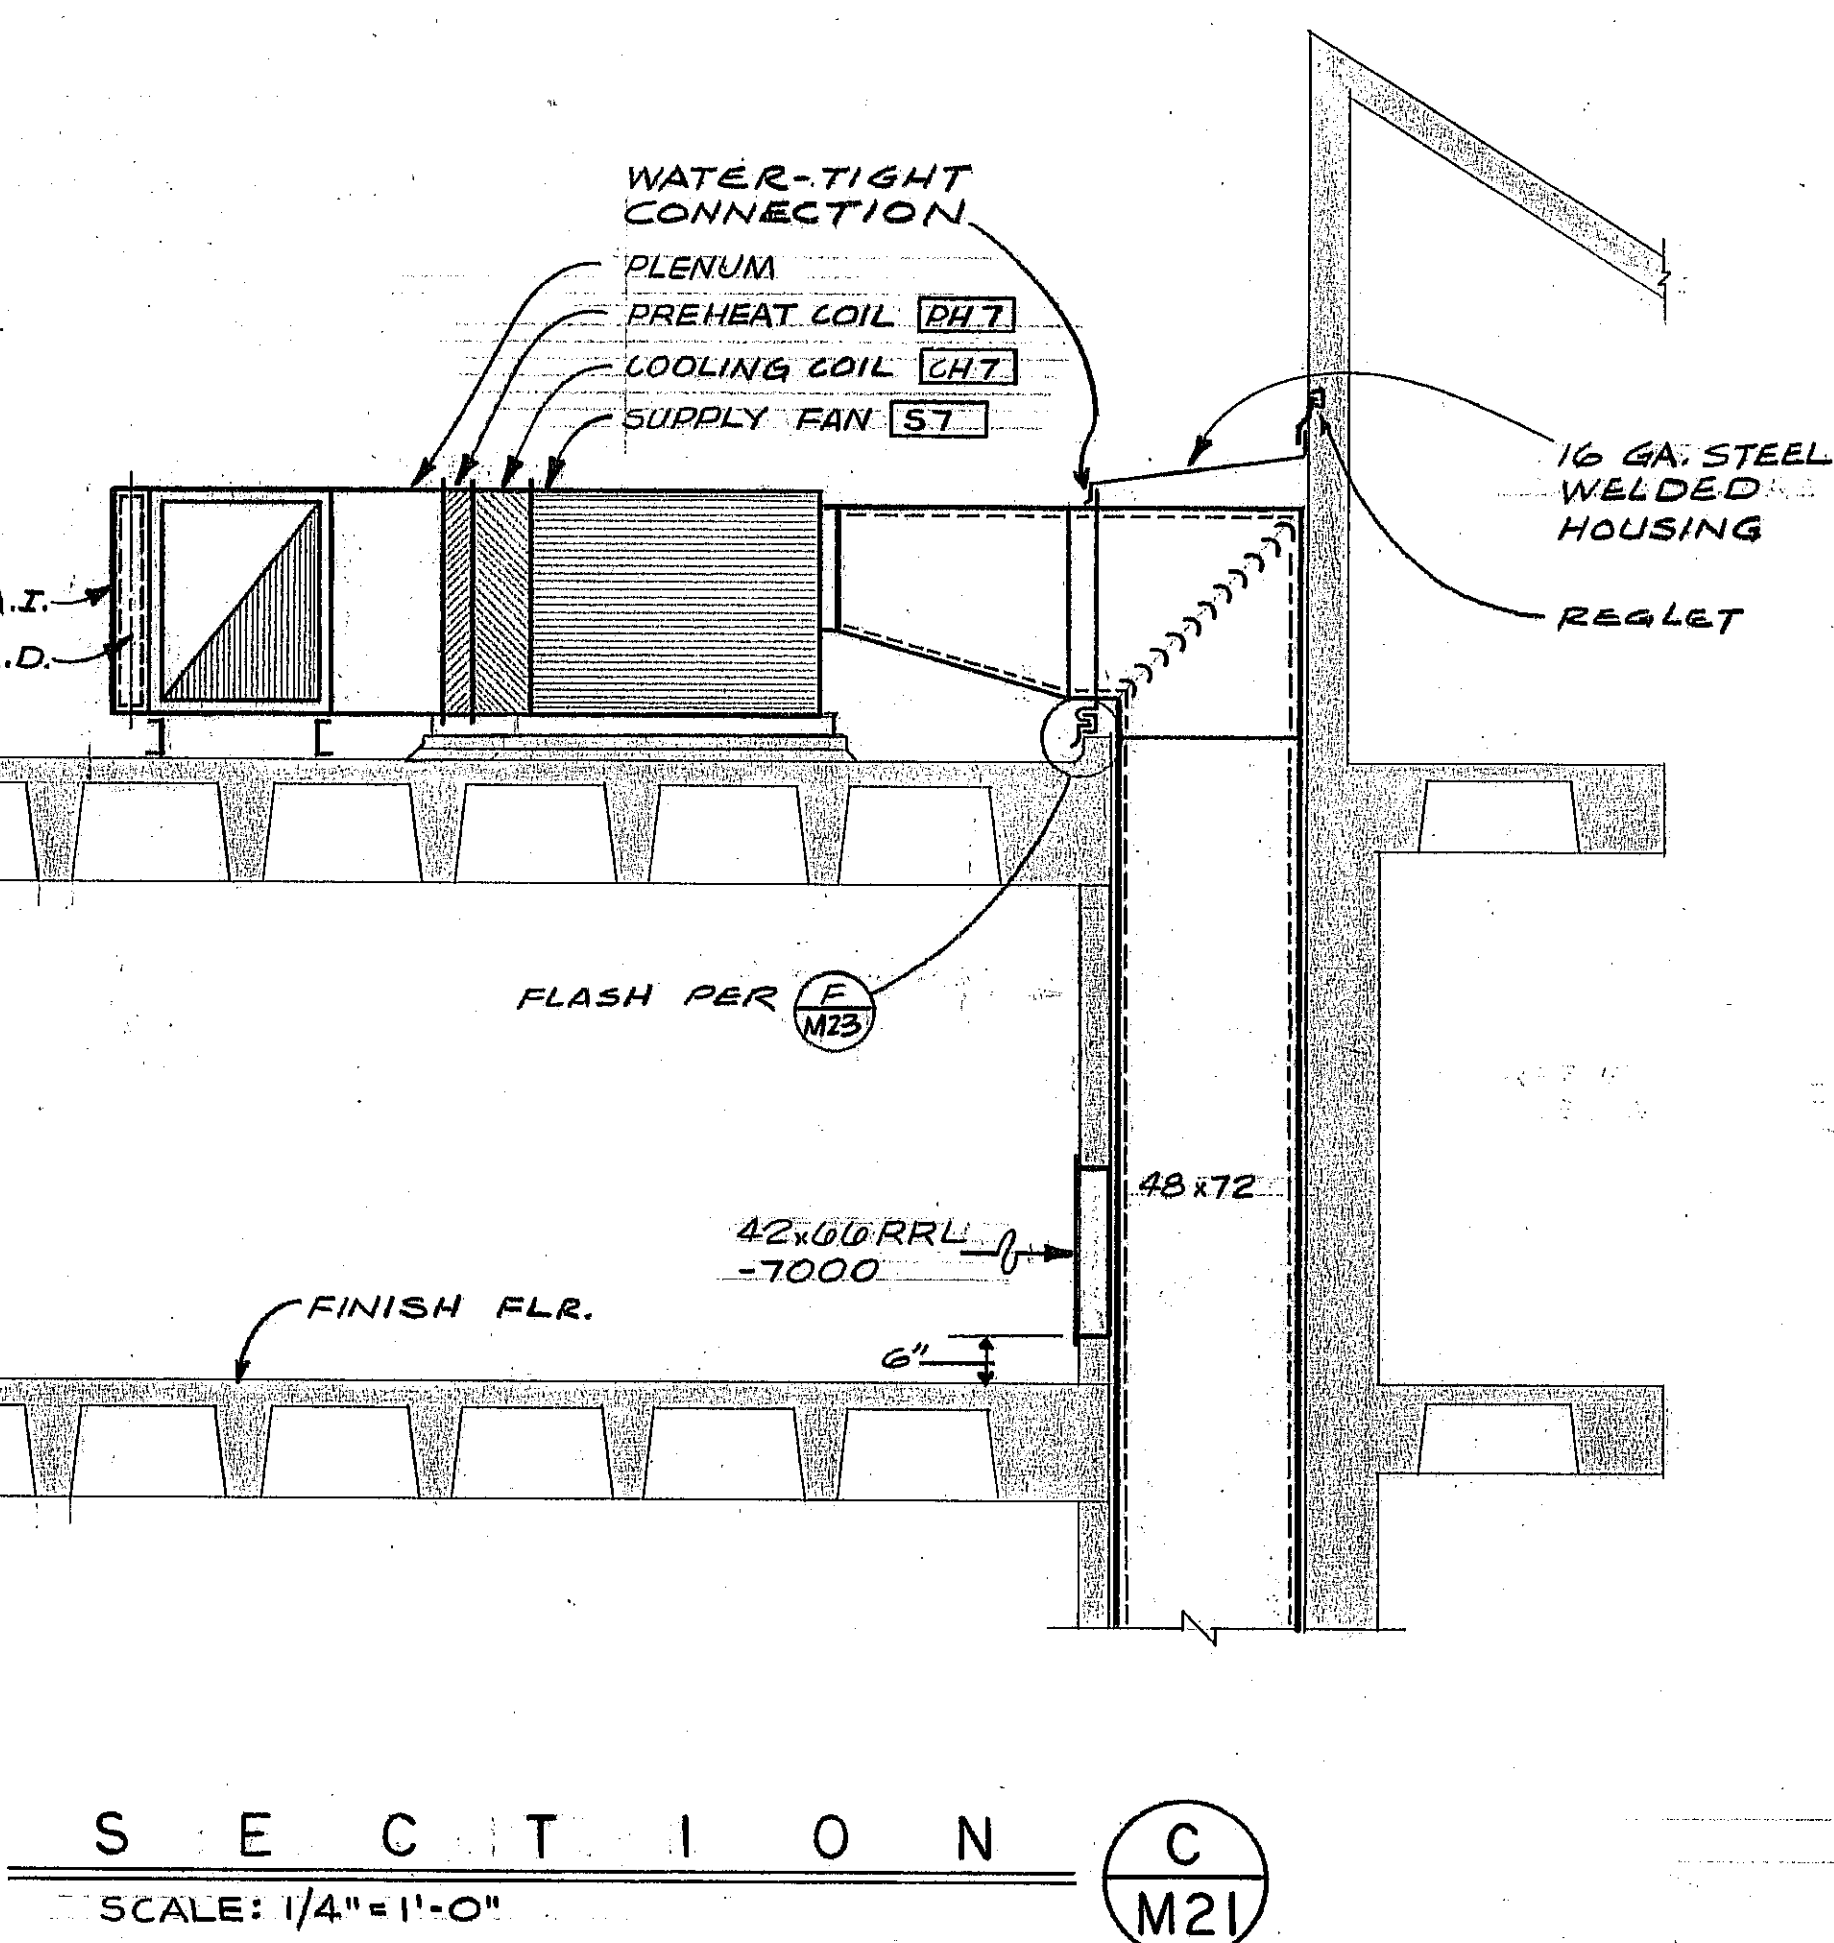

SECTION E
SCALE: 1/4" = 1'-0"

SECTION F
SCALE: 1/4" = 1'-0"

STATE FIRE MARSHAL APPROVAL
APPROVED
STATE FIRE MARSHAL
DATE: 10-4-71
BY: [Signature]

OFFICE OF ARCH. & CONST. APPROVAL
OFFICE OF ARCHITECTURE AND CONSTRUCTION
DATE: 10-4-71
APPROVED OCT 8 1971
BY: [Signature]

CONSULTANTS
#1052
CHARLES / and / BRAUN
CONSULTING ENGINEERS
San Francisco, California
(415) 434-2720

COMETTA AND CIANFICHI
3516 MACDONALD AVENUE RICHMOND, CALIF. 94804
FREDERICK L.R. CONFER + ASSOCIATES
1200 CONTRA COSTA BLVD. CONCORD, CALIF. 94601
E. A. COMETTA, ARCHITECT F. L. R. CONFER, ARCHITECT J. H. GROSSEN, ARCHITECT
P. D. CIANFICHI, ARCHITECT ASSOCIATED ARCHITECTURAL FIRMS P. W. CONFER

EAST CAMPUS
CONTRA COSTA JUNIOR COLLEGE DISTRICT
EAST LELAND ROAD
CONTRA COSTA COUNTY
PITTSBURG
CALIFORNIA

MECHANICAL SECTIONS
& DETAILS

JOB No. 348-68
DATE 10-4-71
REVISIONS
SHEET
M-21
OF SHEETS

THIS DRAWING IS 30" X 42" AT FULL SIZE, 15" X 21" AT HALF SIZE. © 2008 BY SALAS O'BRIEN ENGINEERS, INC.

1/2" = 1'-0"

1/4" = 1'-0"

1/8" = 1'-0"

1" = 30'-0"

1" = 60'-0"

1" = 120'-0"

1" = 240'-0"

CONTROLS

DDC POINTS LIST									
Point ID.	Control Device	Control Description	Control Device Location	AI	AO	DI	DO	NOTES	
DAMPERS/OA/HWR/CHW									
AHU EA DAMPER	DAMPER ACTUATOR	AHU EXHAUST AIR DAMPER CONTROL	ROOF	3				B	
AHU RA DAMPER	DAMPER ACTUATOR	AHU RETURN AIR DAMPER CONTROL	ROOF	3				B	
AHU OA DAMPER	DAMPER ACTUATOR	AHU OUTSIDE AIR DAMPER CONTROL	ROOF	3				B	
AHU CHWR VALVE	VALVE ACTUATOR	AHU CHILLED WATER VALVE CONTROL	ROOF	3				B	
AHU HWR VALVE	VALVE ACTUATOR	AHU HOT WATER VALVE CONTROL	ROOF	3				B	
AHU RH VALVE	VALVE ACTUATOR	AHU REHEAT WATER VALVE CONTROL	ROOF	1				K	
AHU OA AF	AIR FLOW SENSOR	AHU OUTSIDE AIR FLOW	ROOF	3				B	
RETURN AIR									
AHU RF CT	CURRENT TRANSDUCER	AHU RETURN FAN MOTOR CURRENT TRANSDUCER	ROOF	12				D, E, H	
AHU RF VFD FAULT	VFD	AHU RETURN FAN VFD FAULT	ROOF	3				B, J	
AHU RF VFD S/S	RELAY	AHU RETURN FAN VFD START STOP	ROOF			3		B, J	
AHU RF VFD SPD FB	VFD	AHU RETURN FAN VFD SPEED FEEDBACK	ROOF	3				B, J	
AHU RF VFD SPD	VFD	AHU RETURN FAN VFD SPEED CONTROL	ROOF		3			B, J	
AHU RA AF	AIR FLOW SENSOR	AHU RETURN AIR FLOW	ROOF	3				B	
AHU RA TEMP	TEMP SENSOR	AHU RETURN AIR TEMPERATURE	ROOF	3				B	
SUPPLY AIR									
AHU SF CT	CURRENT TRANSDUCER	AHU SUPPLY FAN MOTOR CURRENT TRANSDUCER	ROOF	12				C, E, G	
AHU SF VFD FAULT	VFD	AHU SUPPLY FAN VFD FAULT	ROOF	3				B, J	
AHU SF VFD S/S	RELAY	AHU SUPPLY FAN VFD START STOP	ROOF			3		B, J	
AHU SF VFD SPD FB	VFD	AHU SUPPLY FAN VFD SPEED FEEDBACK	ROOF	3				B, J	
AHU SF VFD SPD	VFD	AHU SUPPLY FAN VFD SPEED CONTROL	ROOF		3			B, J	
AHU SA AF	AIR FLOW SENSOR	AHU SUPPLY AIR FLOW	ROOF	3				B	
AHU SA TEMP	TEMP SENSOR	AHU SUPPLY AIR TEMPERATURE	ROOF	3				B	
MISCELLANEOUS									
AHU MA TEMP	TEMP SENSOR	AHU MIXED AIR TEMPERATURE	ROOF	3				B	
AHU-X SMOKE ALARM	SMOKE DETECTOR	AHU MOUNTED SMOKE DETECTOR	ROOF			3		B	
AHU-X SA FIRE	SMOKE DETECTOR	AHU MOUNTED SMOKE DETECTOR AUX.	ROOF			3		B	
AHU-X FILTER STATUS	DIFF PRESS TRANSDUCER	AHU FILTER STATUS	ROOF	3				B	
AHU-X DUCT STATIC PRESSURE									
AHU-X OA TEMP	TEMP SENSOR	DUCT PRESSURE SENSOR BLDG OUTSIDE AIR TEMP SENSOR	DUCT ROOF	3 1				I A	
PUMPS									
CHWP STS	CURRENT TRANSDUCER	CHILLED WATER BOOSTER PUMP STATUS	ROOF	3				B	
CHWP S/S	RELAY	CHILLED WATER BOOSTER PUMP START/STOP	ROOF			3		B	

NOTES:

TOTAL: 101

- A) PROVIDE AND INSTALL ON EXTERIOR OF AHU-8 WITH WEATHER SHIELD OUT OF DIRECT SUNLIGHT.
B) TYPICAL 1 ON EACH AHU (AHU 4, 8 & 9).
C) TYPICAL 2 ON AHU-4 SUPPLY FAN.
D) TYPICAL 2 ON AHU-8 RETURN FAN.
E) TYPICAL 4 ON AHU-8 SUPPLY FAN.
F) TYPICAL 4 ON AHU-8 RETURN FAN.
G) TYPICAL 6 ON AHU-9 SUPPLY FAN.
H) TYPICAL 6 ON AHU-9 RETURN FAN.
I) PROVIDE AND INSTALL PRESSURE TRANSDUCER 2/3 DOWN THE MOST REMOTE DUCT.
J) HARDWARE POINT
K) HARDWARE POINT

CONTROL VALVE SCHEDULE

MARK	AHU	SERVICE	PIPE SIZE	TYPE	GPM	CV	POSITION	BODY SIZE	VALVE TYPE	MAKE/MODEL
CV-4C	AHU-4	CHW	2.5"	3-WAY	47.3	27.3	LAST	2"	BALL	BELIMO B340L-ARX24-MFT
CV-8C	AHU-8	CHW	4"	3-WAY	132.5	76.5	LAST	3"	GLOBE	BELIMO G780S+RVX24-MFT
CV-9C	AHU-9	CHW	5"	3-WAY	181.1	104.6	LAST	3"	GLOBE	BELIMO G780S++250+RVX24-MFT
CV-4H	AHU-4	HHW	2"	3-WAY	25.2	14.5	LAST	2"	BALL	BELIMO B320L+HRX24-MFT
CV-8H	AHU-8	HHW	3"	3-WAY	65.8	38.0	LAST	2"	BALL	BELIMO B332L+HRX24-MFT
CV-9H	AHU-9	HHW	4"	3-WAY	126.4	73.0	LAST	3"	GLOBE	BELIMO G780S+RVX24-MFT
CV-RH1832	AHU-8	HHW	1-1/4"	3-WAY	9.2	5.3	LAST	1"	GLOBE	BELIMO G325+NFV24-MFT-X1

NOTES:

- 1) PROVIDE AND INSTALL ACTUATOR IN WEATHERPROOF BOX.

SEQUENCE OF OPERATIONS

AIR HANDLING UNIT AHU-4, 8 & 9

BASED ON TIME OF DAY SCHEDULE (TODS), THE FAN SPEED SHALL BE CONTROLLED TO MAINTAIN THE STATIC PRESSURE SETPOINT. THE STATIC PRESSURE SHALL RESET BASED ON MAINTAINING MOST OPEN BOX AT 90%.

SUPPLY AIR TEMPERATURE SHALL BE CONTROLLED THRU MODULATION OF ECONOMIZER DAMPERS AND COOLING COIL OR PREHEAT COIL CONTROL VALVE TO MAINTAIN A FLOATING SETPOINT (ENDPOINTS ADJUSTABLE FROM GRAPHIC) AS FOLLOWS:

OUTSIDE AIR TEMPERATURE	SUPPLY AIR TEMPERATURE
35	70
90	55

THE RESET SCHEDULE SHALL BE AUTOMATICALLY OVERRIDDEN DURING MORNING WARM-UP, OR NIGHT PURGE COOL DOWN. A NIGHT PURGE CYCLE SHALL BE INITIATED AFTER MIDNIGHT WHEN THE FOLLOWING DAY IS OCCUPIED WHENEVER OAT IS 10F LESS THAN INDOOR AIR TEMPERATURE. WARM-UP PERIOD SHALL BE SELF-TUNING FOR START-TIME. DURING WARM-UP, PRIOR TO OCCUPANCY SCHEDULE, THE OUTSIDE AIR DAMPERS SHALL BE 100% CLOSED.

ECONOMIZER MODE: OUTSIDE, RETURN AND EXHAUST AIR DAMPERS CONTROLS BASED ON MIXED AIR TEMPERATURE. OUTSIDE AIR SHALL BE USED FOR COOLING WHENEVER IT IS MORE THAN 2 DEGREES COOLER THAN THE RETURN AIR TEMPERATURE. WHEN THIS CONDITION IS MET, THE OUTSIDE, RETURN AND EXHAUST AIR DAMPERS SHALL MODULATE TO MAINTAIN THE MIXED AIR TEMPERATURE TO THE SUPPLY AIR TEMPERATURE SETPOINT. WHEN THIS CONDITION IS NOT MET (OR WARMER THAN SET) THE OA DAMPERS SHALL BE AT MINIMUM POSITION AND COOLING COIL CONTROL VALVE SHALL MODULATE TO MAINTAIN SETPOINT.

THE MINIMUM OUTSIDE AIR FOR AHU-4 SHALL BE 1200 CFM, AHU-8 SHALL BE 4650 CFM AND AHU-9 SHALL BE 4020 CFM. THE OUTSIDE AIR DAMPER WILL HAVE AN AIR FLOW SENSOR AND SHALL MODULATE TO THE CFM SETPOINTS MENTIONED ABOVE.

FAN SYSTEM SHALL SHUT DOWN WHEN ASSOCIATED DUCT DETECTOR IS ACTIVATED. COORDINATE W/ FIRE ALARM CONTRACTOR FOR FIRE ALARM ANNUNCIATION.

CHILLED WATER BOOSTER PUMP: WHEN ON CALL FOR COOLING AND CHILLED WATER VALVE MODULATE OPEN, TURN PUMP ON AT A USER ADJUSTABLE DELAY TIME. INITIALLY SET FOR ONE MINUTE. WHEN COOLING IS NO LONGER REQUIRED, TURN PUMP OFF AND CLOSE CHILLED WATER VALVE AT A USER ADJUSTABLE DELAY TIME. INITIALLY SET AT ONE MINUTE. CHILLED WATER BOOSTER PUMPS SHALL BE INTERLOCKED WITH CHILLER PUMPS, WHEN CHILLER PUMPS ARE ON THEN CHILLED WATER BOOSTER PUMPS CAN BE

ENABLED WHEN ON CALL FOR COOLING AND WHEN CHILLER PUMPS ARE OFF THEN CHILLED WATER BOOSTER PUMPS ARE DISABLED.

COOLING COIL LOCKOUT: COOLING SHALL BE LOCKED OUT WHEN OUTSIDE AIR TEMPERATURES ARE BELOW 65 (USER ADJUSTABLE).

HEATING COIL LOCKOUT: HEATING SHALL BE LOCKED OUT WHEN OUTSIDE AIR TEMPERATURES ARE ABOVE 60 (USER ADJUSTABLE).

REHEAT CONTROL VALVE: THE REHEAT CONTROL VALVE SHALL MODULATE TO MAINTAIN HEATING SETPOINT.

AHU FILTER STATUS: WHEN PRESSURE ACROSS THE FILTER DIFFERENTIAL PRESSURE SENSOR GOES BEYOND THE SETPOINT, AN ALARM SHALL BE LOGGED AND GENERATED.

TRENDING:

SET UP TRENDS FOR EACH POINT AS DIRECTED BY THE ENGINEER/DISTRICT.

ALARMS:

ALARMS SHALL BE LOGGED WHENEVER THE ACTUAL STATE DOES NOT MATCH COMMANDING STATE AFTER AN ADJUSTABLE TIME-DELAY PERIOD. CRITICAL ALARMS SHALL INITIATE A DIAL OUT PAGING OF LOS MEDANOS COLLEGE DESIGNATED PERSONNEL. COORDINATE WITH PERSONNEL FOR CRITICAL ALARMS. PROVIDE SUPPLY TEMP ALARMS WHEN TEMPERATURE IS 5F (USER ADJUSTABLE) GREATER THAN SETPOINT. PROVIDE LOW TEMP ALARMS WHEN TEMPERATURE IS 5F (USER ADJUSTABLE) LOWER THAN SETPOINT.

START-UP PROGRAMMING AND COMMISSIONING:

THE CONTROLS CONTRACTOR SHALL BE RESPONSIBLE FOR ALL SEQUENCES, SHALL TEST, TUNE, ADJUST AS REQUIRED FOR A FULLY FUNCTIONAL AIR HANDLING UNIT. CONTROLS CONTRACTOR SHALL COORDINATE WITH BALANCING CONTRACTOR FOR APPLICABLE FIELD DETERMINED SETPOINTS AND REQUIRED ADJUSTMENTS (SUCH AS STATIC PRESSURE CONTROL, OUTSIDE AIR DAMPER CONTROL AT VARYING SUPPLY AIR FAN SPEEDS, ETC.)

CONTROLLER LOCATION

PROVIDE AND INSTALL DDC CONTROLLER INSIDE AHU VFD PANEL. THERE WILL BE A DEDICATED SPACE FOR CONTROLLER.

SCHEDULES

PUMP SCHEDULE

SERVICE	MARK	GPM	TDH (FT)	HP	RPM	MIN. PUMP EFF.	SIZE	VOLTS/PH. & HZ	OPER. WT.	NOTES
AHU-4 CHW	P-11	48	20	0.75	1750	43.0%	2x2x7	460/3/60	160	B&G SERIES 80
AHU-8 CHW	P-15	133	27	2	1750	65.2%	3x3x7B	460/3/60	180	B&G SERIES 80
AHU-9 CHW	P-16	182	27	2	1750	68.3%	3x3x7B	460/3/60	180	B&G SERIES 80

REHEAT COIL SCHEDULE

SERVICE	MARK	CFM	ENT DB	ENT WB	LVG DB	LVG WB	APD (N/WG)	GPM	EWT	LWT	WPD (FT)	ROWS	FINS PER INCH	WIDTH (IN)	HEIGHT (IN)	WEIGHT (LBS)	TOTAL CAPACITY (BTU/H)	REMARKS
AHU-8	RH-1832	2,400	55	-	90.9	-	0.35	9.2	160	140	0.30	2	10	49	21	100	94,282	DAIKIN MODEL 5WB1002C

AHU-4 AIR HANDLER SCHEDULE

MARK	AHU-4
AREA SERVED	SECTOR 10
MANUFACTURER	TEMPROL
QUOTE NUMBER	042414-012K
DIMENSIONS	72'X35'1"X54'8" (W X L X H)
EXTERIOR CABINET MATERIAL	16GA WITH STANDARD PAINT
INTERIOR CABINET MATERIAL	20GA G90 GALV
FANS	SUPPLY FAN: 1X2 ARRAY, 2 FANS, 5 HP AT 4 BHP EACH RETURN FANS: 1X2 ARRAY, 2 FANS, 2 HP AT 1.2 BHP EACH
CFM	SUPPLY FAN: 6560 @ 5.50" TOTAL SP RETURN FAN: 6560 @ 1.5" TOTAL SP
FAN MOTORS	TEAO
ACCESS DOORS	SEE DRAWINGS
PIPING CONNECTIONS	SEE DRAWINGS
VOLTAGE/PHASE	480V/3 PHASE
CHILLED WATER COIL	QTY: 1, 4 ROWS, 11 FPI, COPPER 0.008" FINS, 0.020" COPPER TUBE, 0.625" TUBE O.D., 1.5" X 1.299" TUBE SPACING, 16 GA 304 SS CASING AND DRAIN PAN, EADB 83.5F/EAWB 65.5F, LADB 53.8F/LAWB 52.6F, 47.3 GPM. TOTAL CAP: 237.3 MBH, 432.53 FPM FACE VELOCITY, EWT 45F
HOT WATER COIL	QTY: 1, 1 ROW, 8 FPI, COPPER 0.008" FINS, 0.020" COPPER TUBE, 0.625" TUBE O.D., 1.5" X 1.299" TUBE SPACING, 16 GA 304 SS CASING, EADB 35F, LADB 67.6F, 25.2 GPM. TOTAL CAP: 247.8 MBH, 432.53 FPM FACE VELOCITY, EWT 160F/LWT 140F, WPD 4.38 FT
SHIPPING METHOD	ONE SECTION
VFD	VFD BY ABB, SUPPLY FAN WILL HAVE (1) VFD AND RETURN FAN WILL HAVE (1) VFD
PRE/FINAL FILTER	FILTER RACK MATERIAL IS 304 STAINLESS STEEL, 2" MERV 8 PREFILTER, 12" MERV 13 FINAL FILTER
WEIGHT	9072 LBS W/ROOF CURB
OPTIONS	STANDARD MELAMINE COPLANAR INSULATION BACKDRAFT DAMPERS (1) LIGHT SWITCH/120V OUTLET WITH GFCI FAN SAFETY GUARDS MOTOR OVERLOAD PROTECTION WITH FAULT OUTPUT (6) VAPOR PROOF 23 W COMPACT FLR LIGHTS PRESSURE GAUGE, MAGNETHELIC 2003, SIGNAL FLAG, HINGED COVER


AHU-8 AIR HANDLER SCHEDULE

MARK	AHU-8
AREA SERVED	SECTOR 5, SECTOR 13
MANUFACTURER	TEMPROL
QUOTE NUMBER	042414-012K
DIMENSIONS	96'X26'1"X21'50" (W X L X H)
EXTERIOR CABINET MATERIAL	16GA WITH STANDARD PAINT
INTERIOR CABINET MATERIAL	20GA G90 GALV
FANS	SUPPLY FAN: 2X2 ARRAY, 4 FANS, 6.5 HP AT 5.9 BHP EACH RETURN FANS: 2X2 ARRAY, 4 FANS, 5 HP AT 1.9 BHP EACH
CFM	SUPPLY FAN: 17520 @ 6.05" TOTAL SP RETURN FAN: 17520 @ 1.55" TOTAL SP
FAN MOTORS	TEAO
ACCESS DOORS	SEE DRAWINGS
PIPING CONNECTIONS	SEE DRAWINGS
VOLTAGE/PHASE	480V/3 PHASE
CHILLED WATER COIL	QTY: 2, 6 ROWS, 9 FPI, COPPER 0.008" FINS, 0.020" COPPER TUBE, 0.625" TUBE O.D., 1.5" X 1.299" TUBE SPACING, 16 GA 304 SS CASING AND DRAIN PAN, EADB 81F/EAWB 64.9F, LADB 51.9F/LAWB 51.4F, 132.5 GPM. TOTAL CAP: 665.0 MBH, 438.00 FPM
HOT WATER COIL	QTY: 2, 1 ROW, 8 FPI, COPPER 0.008" FINS, 0.020" COPPER TUBE, 0.625" TUBE O.D., 1.5" X 1.299" TUBE SPACING, 16 GA 304 SS CASING, EADB 35F, LADB 66.7F, 65.8 GPM. TOTAL CAP: 645.4 MBH, 438.00 FPM FACE VELOCITY, EWT 160F/LWT 140F, WPD 3.74 FT
SHIPPING METHOD	ONE SECTION
VFD	VFD BY ABB, SUPPLY FAN WILL HAVE (1) VFD AND RETURN FAN WILL HAVE (1) VFD
PRE/FINAL FILTER	FILTER RACK MATERIAL IS 304 STAINLESS STEEL, 2" MERV 8 PREFILTER, 12" MERV 13 FINAL FILTER
WEIGHT	16947 LBS W/ROOF CURB
OPTIONS	STANDARD MELAMINE COPLANAR INSULATION BACKDRAFT DAMPERS (1) LIGHT SWITCH/120V OUTLET WITH WEATHERPROOF COVER FAN SAFETY GUARDS MOTOR OVERLOAD PROTECTION WITH FAULT OUTPUT (3) VAPOR PROOF 23 W COMPACT FLR LIGHTS (3) VAPOR PROOF 100W INC BULB LIGHTS PRESSURE GAUGE, MAGNETHELIC 2003, SIGNAL FLAG, HINGED COVER
NOTE	ELECTRICAL PANEL RF RED VFD AND SF RED VFD WILL BE FIELD MOUNTED & WIRED. SEE ELECTRICAL DRAWINGS.

AHU-9 AIR HANDLER SCHEDULE

MARK	AHU-9
AREA SERVED	SECTOR 14
MANUFACTURER	TEMPROL
QUOTE NUMBER	042414-012K
DIMENSIONS	104'00'X36'0"X109'50" (W X L X H)
EXTERIOR CABINET MATERIAL	16GA WITH STANDARD PAINT
INTERIOR CABINET MATERIAL	20GA G90 GALV
FANS	SUPPLY FAN: 3X3 ARRAY, 6 FANS, 6.5 HP AT 5.7 BHP EACH RETURN FANS: 3X2 ARRAY, 6 FANS, 2.5 HP AT 1.6 BHP EACH
CFM	SUPPLY FAN: 25070 @ 6.00" TOTAL SP RETURN FAN: 25070 @ 1.50" TOTAL SP
FAN MOTORS	TEAO
ACCESS DOORS	SEE DRAWINGS
PIPING CONNECTIONS	SEE DRAWINGS
VOLTAGE/PHASE	480V/3 PHASE
CHILLED WATER COIL	QTY: 2, 6 ROWS, 8 FPI, COPPER 0.008" FINS, 0.020" COPPER TUBE, 0.625" TUBE O.D., 1.5" X 1.299" TUBE SPACING, 16 GA 304 SS CASING AND DRAIN PAN, EADB 81F/EAWB 64.9F, LADB 52.8F/LAWB 52.0F, 181.1 GPM. TOTAL CAP: 908.7 MBH, 455.82 FPM
HOT WATER COIL	QTY: 2, 2 ROWS, 6 FPI, COPPER 0.008" FINS, 0.020" COPPER TUBE, 0.625" TUBE O.D., 1.5" X 1.299" TUBE SPACING, 16 GA 304 SS CASING, EADB 35F, LADB 77.7F, 126.4 GPM. TOTAL CAP: 1241.5 MBH, 488.38 FPM FACE VELOCITY, EWT 160F/LWT 140F, WPD 4.31 FT
SHIPPING METHOD	ONE SECTION
VFD	VFD BY ABB, SUPPLY FAN WILL HAVE (1) VFD AND RETURN FAN WILL HAVE (1) VFD
PRE/FINAL FILTER	FILTER RACK MATERIAL IS 304 STAINLESS STEEL, 2" MERV 8 PREFILTER, 12" MERV 13 FINAL FILTER
WEIGHT	20683 LBS W/ROOF CURB
OPTIONS	STANDARD MELAMINE COPLANAR INSULATION BACKDRAFT DAMPERS (1) LIGHT SWITCH/120V OUTLET WITH GFCI WITH WEATHERPROOF COVER FAN SAFETY GUARDS MOTOR OVERLOAD PROTECTION WITH FAULT OUTPUT (6) VAPOR PROOF 23 W COMPACT FLR LIGHTS PRESSURE GAUGE, MAGNETHELIC 2003, SIGNAL FLAG, HINGED COVER

NOTE:
ALL AHU TO BE FABRICATED FROM CSHP CERTIFICATION #OSP-CCTA-10

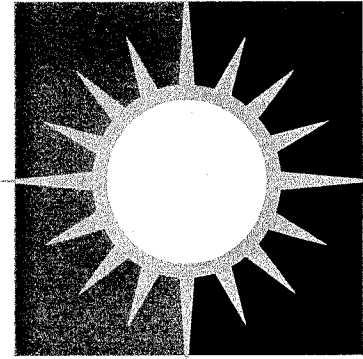

SALAS O'BRIEN

| expect a difference |

305 South 11th Street
San Jose, California 95112-2218
408.282.1500 | 408.297.2995 (f)

salasobrien.com

Boseman | Los Angeles | Monterey
Oakland | Orange County | Sacramento
San Diego | San Luis Obispo | Seattle

AIR HANDLER SCHEDULE																																						
UNIT	SERVES	"TEMPROL" MODEL	LOCATED	SUPPLY FAN		RETURN CFM		CHILLED WATER COIL														HOT WATER COIL														MIN. OA CFM	UNIT WT. LBS.	REMARKS
				CFM	TSP/ESP IN. WG.	HP	CFM	TSP/ESP IN. WG.	HP	ROWS	FPI	EDB OF	EWB OF	LDB OF	SENS. LOAD (MBH)	TOTAL LOAD (MBH)	GPM	EWT OF	LWT OF	AIR Δ P IN. WG.	WATER Δ P FT. HEAD	TCV		ROWS	FPI	EDB OF	LOAD (MBH)	GPM	EWT OF	LWT OF	AIR Δ P IN. WG.	WATER Δ P FT. HEAD	TCV					
																						TYPE	CV										TYPE	CV				
(E) AHU 5A.1	(C) SECTOR 5A	"TEMPROL" WF-RDHRE14	OUTDOOR	6,650	4.5 2.0	2Φ 5 HP	5,850	1.75 1.45	3	4	12	85	64	51	227	236	49	45	55	0.29	4.97	3-WAY	-	1	7	54	208	20	160	140	0.03	2.92	3-WAY	-	2,660	6,850	1, 2,	
(E) AHU 6.1.7	(E) SECTOR 6 (ALSO SECTOR 3 OUT OF SCOPE)	"TEMPROL" HTF-RDHRE22	OUTDOOR	-	-	15	-	-	7.5	6	10	84	66	52	366	457	91	45	55	0.77	12.4	2-WAY	-	1	6	56	202	10	160	120	0.06	3.95	2-WAY	-	2,500	9,720	3, 5	
(E) AHU 8	(C) SECTOR 5B (ALSO SECTOR 13 OUT OF SCOPE)	"TEMPROL"	OUTDOOR	-	-	4Φ 6.5 HP	-	-	4Φ 5 HP	-	-	-	-	-	-	-	132	-	-	-	-	3-WAY	27.3	1	8	35	645	66	-	-	-	-	3-WAY	38	5,000	16,950	4, 5	

NOTES:

- BALANCE AIR HANDLING UNIT SUPPLY AIR TO VALUE INDICATED.
- EXISTING OUTSIDE AIR FLOW SETPOINT OF 2660 CFM IS OK AS IS. VERIFY DURING AIR BALANCE.
- MAINTAIN THE SAME SUPPLY & RETURN AIRFLOW TO SECTOR 3 (FIRST FLOOR) WHICH IS OUTSIDE THE SCOPE OF WORK. BALANCE SECTOR 6 SUPPLY & RETURN AIRFLOW TO WHAT IS SHOWN ON FLOOR PLAN.
- MAINTAIN THE SAME SUPPLY & RETURN AIRFLOW TO SECTOR 13 (THIRD FLOOR) WHICH IS OUTSIDE THE SCOPE OF WORK. BALANCE SECTOR 5B SUPPLY & RETURN AIRFLOW TO WHAT IS SHOWN ON FLOOR PLAN.
- BALANCE AIR HANDLING UNIT OUTSIDE AIR TO VALUE INDICATED. THE CALCULATED OA VALUE INDICATED INCORPORATES ALL AREAS SERVED BY THIS AHU INCLUDING THOSE SPACES OUTSIDE THE SCOPE OF WORK.


DIFFUSER, REGISTER & GRILLE SCHEDULE					
SYMBOL	DESCRIPTION	TITUS	PRICE	METALAIR	KRUEGER
	MODULAR CORE SURFACE MOUNT PERFORATED CEILING DIFFUSER FLAT FRAME	PMC - BORDER TYPE 1C	PDMC-FRAME1	7950-1	6400 FRAME 22
CR, CE 	CEILING RETURN WITH 1/2" x 1/2" x 1" EGG CRATE CORE, SURFACE MOUNT	MODEL 50 F - BORDER TYPE 1	80	CCSD	EGC-5
CRL, CEL 	CEILING RETURN WITH 1/2" x 1/2" x 1" EGG CRATE CORE, IN 24x24 PANEL FOR T-BAR CEILING	MODEL 50 F - BORDER TYPE 3	80 - TBP	CCSD-TBD	EGC-5TB
S S  	DOUBLE DEFLECTION SUPPLY GRILLE WITH VERTICAL FRONT BARS, 1/4" SPACING	300 RS	520 S	V 4004 S	880 V
R & E *  	RETURN OR EXHAUST GRILLE WITH 35° OR 45° HORIZONTAL BARS.	350 RL	530L	SRH	S 80 H

NOTES:

1. ALL SYMBOLS NOTED MAY NOT BE USED. REFER TO PLANS FOR SIZE AND QUANTITY.
2. ALL SUPPLY AIR DIFFUSERS ARE 4 WAY BLOW UNLESS SHOWN OTHERWISE.
3. FURNISH ALL PRODUCTS OF A SINGLE MANUFACTURER.
4. COORDINATE DIFFUSER TYPE WITH REFLECTED CEILING PLAN.
5. OPPOSED BLADE DAMPERS ARE NOT REQUIRED AT DIFFUSERS, REGISTERS OR GRILLES.
6. PROVIDE MANUAL AIR DAMPERS AT EACH BRANCH DUCT TO A SINGLE DIFFUSER, REGISTER OR GRILLE.
7. FOR MOUNTING SEE 5/M5.1.

BBP
 architecture
 planning
 interiors
 management

1871/Architecture
 1777 Oakland Avenue, Suite 320
 Walnut Creek, CA 94596
 ph: 925/2466419

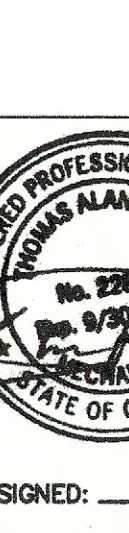

DATE SIGNED: 07/15/2016



CAPITAL
 ENGINEERING CONSULTANTS, INC.
 RANCHO CONCORD, CALIFORNIA

TD - 1871/AR
PK - DESIGN YEAR

150226.00
PROJECT NO.

consultant

DIVISION IV, CAMP
 DIV OF THE STATE ARCHITECT
 OFFICE OF REGULATION SERVICES
 APR 6 10 15 AM '16
 APR 6 10 15 AM '16
 R.D.
 RECD BY Alan Dunk % R.D.
 DATE 07-15-2016

Division of the State Architect

1515 Jay Street, Suite 1201

Oakland, Ca. 94612

ph: (510) 622-3701

agent

**LEVEL 2 REMODEL
SECTORS 5A, 5B & 6
COLLEGE COMPLEX**

**LOS MEDANOS COLLEGE
2700 EAST LELAND DRIVE
PITTSBURG, CA 94565**

t8P project number:		2084200	owner
file name:			
drawn by:		checked by:	
date:	MAY 15, 2016		
Rev.	date:	description:	
	12/15/15	DSA SUBMITTAL	
	5/16/16	DSA	
	7/1/16	BID SET	
	12/09/16	Revised Bid Set	
THIS DRAWING AND THE SEPARATE SPECIFICATIONS, LEGEND AND OTHER INFORMATION CONTAINED HEREIN CONSTITUTE UNPAID WORK OF AN ARCHITECTURE AND ENGINEERING FIRM. NO PART OF THIS DRAWING OR ANY INFORMATION CONTAINED HEREIN IS TO BE REPRODUCED OR TRANSMITTED IN ANY FORM OR BY ANY MEANS, ELECTRONIC OR MECHANICAL, INCLUDING PHOTOCOPYING, RECORDING, OR BY ANY INFORMATION STORAGE AND RETRIEVAL SYSTEM, WITHOUT THE WRITTEN PERMISSION OF THE ARCHITECTURE AND ENGINEERING FIRM.			
drawing title:		HVAC SCHEDULES	
drawing no.:		MO.2 drawing of	