








LIGHTING FIXTURE SCHEDULE


REFER TO ARCHITECTURAL DRAWINGS FOR CEILING TYPES.

TYPE	DESCRIPTION	CATALOG No.	MOUNT	VOLT	LAMPS	WEIGHT	REMARKS
A1 62	2'x4', 2 LAMP FLUORESCENT FIXTURE WITH PARABOLIC LOUVER. 18 CELLS.	LITHONIA #2PM4	RECESSED	277	2F32T8	35LBS	
A2 70	2'x4', 2 LAMP FLUORESCENT FIXTURE WITH PARABOLIC LOUVER. DIMMING BALLAST. 18 CELLS.	LITHONIA #2PM4	RECESSED	277	2F32T8	35LBS	LUTRON HI-LUME DIMMING BALLAST
A3 70	SIMILAR TO FIXTURE TYPE 'A2', ALSO CONTAINS EMERGENCY BALLAST.	LITHONIA #2PM4	RECESSED	277	2F32T8	35LBS	LUTRON HI-LUME DIMMING BALLAST
A4 62	4' INDUSTRIAL FLUORESCENT FIXTURE WITH REFLECTOR. EMERGENCY BALLAST.	LITHONIA #AF10	SURFACE	277	2F32T8	17LBS	
A5 62	SIMILAR TO FIXTURE TYPE 'A1' EXCEPT ALSO CONTAINS AN EMERGENCY BALLAST.	LITHONIA #2PM4	RECESSED	277	2F32T8	35LBS	
A6 62	9"x4', 2 LAMP FLUORESCENT FIXTURE WITH PARABOLIC LOUVER.	LITHONIA #9PM0	RECESSED	277	2F32T8	33LBS	
A7 62	SIMILAR TO FIXTURE TYPE 'A6' EXCEPT ALSO CONTAINS AN EMERGENCY BALLAST.	LITHONIA #9PM0	RECESSED	277	2F32T8	33LBS	
A8 62	SIMILAR TO FIXTURE TYPE 'A4' EXCEPT IS 8' LENGTH, AND EMERGENCY BALLAST CONTAINS 2 LAMPS.	LITHONIA #AF10	SURFACE	277	2F32T8	35LBS	
A9 86	SIMILAR TO FIXTURE TYPE 'A1' EXCEPT CONTAINS 3 LAMPS.	LITHONIA #2PM4	RECESSED	277	3F32T8	35LBS	
A10 70	2'x4', 2 LAMP FLUORESCENT FIXTURE WITH PRISMATIC LENS. DIMMING BALLAST.	LITHONIA #SP8	RECESSED	277	2F32T8	35LBS	LUTRON HI-LUME DIMMING BALLAST
A11 70	SIMILAR TO FIXTURE TYPE 'A10' EXCEPT ALSO CONTAINS EMERGENCY BALLAST.	LITHONIA #SP8	RECESSED	277	2F32T8	35LBS	LUTRON HI-LUME DIMMING BALLAST
A12 62	2'x4', 2 LAMP FLUORESCENT FIXTURE WITH PRISMATIC LENS.	LITHONIA #SP8	RECESSED	277	2F32T8	35LBS	
A13 62	SIMILAR TO FIXTURE TYPE 'A4' EXCEPT NO EMERGENCY BALLAST.	LITHONIA #AF10	SURFACE	277	2F32T8	17LBS	
A14 32	4' PERIMETER FLUORESCENT FIXTURE WITH PARABOLIC LOUVER. EMERGENCY BALLAST.	LITHONIA #RP	RECESSED	277	1F32T8	35LBS	
A15 62	SIMILAR TO FIXTURE TYPE 'A14' EXCEPT 8' LENGTH.	LITHONIA #RP	RECESSED	277	2F32T8	50LBS	
A16 94	SIMILAR TO FIXTURE TYPE 'A14' EXCEPT EXCEPT 12' LENGTH AND NO EMERGENCY BALLAST.	LITHONIA #RP	RECESSED	277	3F32T8	65LBS	
A17 156	SIMILAR TO FIXTURE TYPE 'A14' EXCEPT 20' LENGTH AND NO EMERGENCY BALLAST.	LITHONIA #RP	RECESSED	277	5F32T8	75LBS	
A18 124	8' LENGTH INDIRECT OPEN FLUORESCENT FIXTURE WITH REFLECTOR.	PEERLITE #10CRM2	PENDANT	277	4F32T8	35LBS	
A19 124	SIMILAR TO FIXTURE TYPE 'A18' EXCEPT CONTAINS AN EMERGENCY BALLAST.	PEERLITE #10CRM2	PENDANT	277	4F32T8	35LBS	
A20 86	SIMILAR TO FIXTURE TYPE 'A9' AND ALSO CONTAINS AN EMERGENCY BALLAST.	LITHONIA #2PM4	RECESSED	277	3F32T8	35LBS	
A21 96	SIMILAR TO FIXTURE TYPE 'A2' EXCEPT CONTAINS 3 LAMPS	LITHONIA #2PM4	RECESSED	277	3F32T8	35LBS	LUTRON HI-LUME DIMMING BALLAST
A22 96	SIMILAR TO FIXTURE TYPE 'A21' EXCEPT ALSO CONTAINS AN EMERGENCY BALLAST.	LITHONIA #2PM4	RECESSED	277	3F32T8	35LBS	LUTRON HI-LUME DIMMING BALLAST
A23	NOT USED — BULLETIN 51						
A24 62	SIMILAR TO FIXTURE TYPE 'A4' EXCEPT 120 VOLT BALLAST	LITHONIA #AF10	SURFACE	120	(2)F32T8	17LBS	
A25 32	4'Wx4' LENGTH FLUORESCENT FIXTURE WITH PRISMATIC ACRYLIC LENS	SELUX #M1NOEM	RECESSED	277	(1)F32T8	20LBS	
A26 124	8', 4 LAMP FLUORESCENT FIXTURE WITH EMERGENCY BALLAST.	PRUDENTIAL #WAL-8-SD-WM	SURFACE	277	(4)F32T8	50LBS	
A27 62	4', 2 LAMP FLUORESCENT FIXTURE WITH EMERGENCY BALLAST.	PRUDENTIAL #WAL-4-SD-WM	SURFACE	277	(2)F32T8	35LBS	
B1 35	8" DIA. COMPACT FLUORESCENT FIXTURE WITH CLEAR ALZAK REFLECTOR	GOTHAM #AF8	RECESSED	277	(1)32TRT	17LBS	
B2 35	SIMILAR TO FIXTURE TYPE 'B1' EXCEPT ALSO CONTAINS AN EMERGENCY BALLAST	GOTHAM #AF8	RECESSED	277	(1)32TRT	20LBS	
B3 45	8" DIA. COMPACT FLUORESCENT FIXTURE WITH CLEAR ALZAK REFLECTOR AND DIMMING BALLAST	GOTHAM #AF8	RECESSED	277	(1)32TRT	20LBS	LUTRON HI-LUME DIMMING BALLAST
B4 45	SIMILAR TO FIXTURE TYPE 'B3' EXCEPT ALSO CONTAINS AN EMERGENCY BALLAST	GOTHAM #AF8	RECESSED	277	(1)32TRT	20LBS	
B5 40	SIMILAR TO FIXTURE TYPE 'B3' EXCEPT ALSO CONTAINS A WALL WASH LENS.	GOTHAM #AFW	RECESSED	277	(1)32TRT	20LBS	LUTRON HI-LUME DIMMING BALLAST
B6 42	14" DIA. COMPACT FLUORESCENT FIXTURE WITH WHITE OPAL GLASS SHADE	BETA CALLO #ZEDOS 68-OP-SN	SURFACE	277	(1)40W CIRCLINE	25LBS	
C1 17	WALL MOUNTED COMPACT FLUORESCENT FIXTURE WITH POLY CARBONATE DIFFUSER.	LITHONIA #WPCW	SURFACE	277	(1)13W QUAD	25LBS	
C2 125	13" DIA. HIGH INTENSITY DISCHARGE LIGHT FIXTURE	KENALL #MRBF-SL	SURFACE	277	(1)150W METAL HALIDE	30LBS	
C3	"NOT USED" — BULLETIN 51						
C4 50	7"DIA. COMPACT FLUORESCENT WITH FRESNAL LENS	GOTHAM #LGF	RECESSED	277	(1)42TRT	17LBS	BULLETIN 7
C5 100	100 WATT METAL HALIDE LIGHT FIXTURE WITH SILVER LOUVER. GASKETED	SELUX #QDISPWH100SV	SURFACE	277	(1)100W METAL HALIDE	36LBS	
C6	11"x5"x3" LED STEP LIGHT WITH RED LAMP AND HORIZONTAL GRILL.	INTENSE #FS90S-LED	RECESSED	120	LED	10LBS	
E1 2	SINGLE FACE GREEN LED EXIT SIGN, EMERGENCY BATTERY PACK	LITHONIA #LES	SURFACE	277	LED	5LBS	
E2 2	DOUBLE FACE GREEN LED EXIT SIGN, EMERGENCY BATTERY PACK	LITHONIA #LES	SURFACE	277	LED	5LBS	

GENERAL NOTES

1. PENETRATIONS OF PIPES, CONDUITS, ETC. IN WALLS REQUIRING PROTECTED OPENINGS SHALL BE FIRE STOPPED. FIRE STOP MATERIAL SHALL BE TESTED ASSEMBLY APPROVED BY THE STATE FIRE MARSHAL.
2. ALL EMPTY CONDUITS SHALL BE SUPPLIED WITH NYLON PULL STRING.
3. EACH RECEPTACLE AND FIXED ELECTRICAL EQUIPMENT SHALL BE GROUNDED BY MEANS OF AN INSULATED COPPER CONDUCTOR (MINIMUM #12 AWG) SIZES IN ACCORDANCE WITH C.E.C. TABLE 250-95.
4. FOR TELEPHONE AND DATA OUTLETS, INSTALL A 3/4" CONDUIT WITH PULL STRING AND HOMERUN BACK TO TELEPHONE/DATA CLOSET, UNLESS OTHERWISE NOTED. TERMINATE CONDUIT WITH BUSHING IN CLOSET AT TELEPHONE/DATA BACKBOARD.

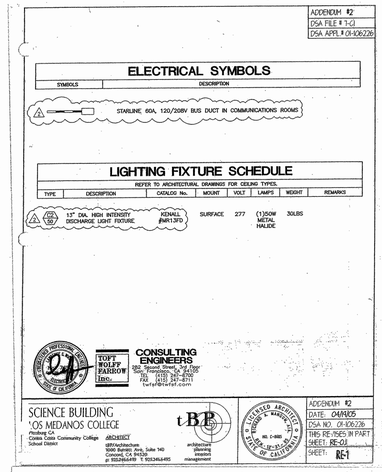

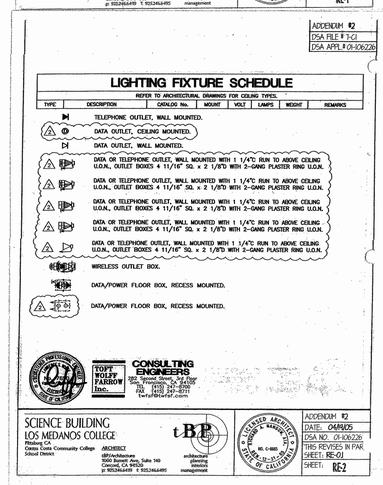

ELECTRICAL SYMBOLS

SYMBOL	DESCRIPTION
———	CONCEALED CONDUIT IN CEILING OR IN WALL.
— - —	CONDUIT CONCEALED IN OR UNDER FLOOR.
----------	EXPOSED CONDUIT.
——o	CONDUIT TURNING UP.
——•	CONDUIT TURNING DOWN.
A-1,3	HOMERUN TO PANEL "A", CIRCUIT NUMBERS 1 AND 3.
~	FLEXIBLE CONDUIT.
✕✕✕✕✕✕	REMOVE OR ABANDON CONDUIT, AS NOTED, REMOVE EXISTING CONDUCTORS.
——T——	TELEPHONE SYSTEM CONDUIT.
——D——	DATA SYSTEM CONDUIT.
J	CEILING MOUNTED JUNCTION BOX.
JH	WALL MOUNTED JUNCTION BOX.
FJ	UNDER FLOOR JUNCTION BOX.
3 a	FLUORESCENT LIGHTING FIXTURE CONTROLLED BY SWITCH "a", ON CIRCUIT "3". TYPICAL DESIGNATION FOR ALL OUTLETS.
	FLUORESCENT LIGHTING FIXTURE. SHADING INDICATES FIXTURE CONTAINS EMERGENCY BATTERY PACK. U.O.N. NL = NIGHT LIGHT
	FLUORESCENT LIGHTING FIXTURE, WALL MOUNTED.
	"STRIP" FLUORESCENT LIGHTING FIXTURE.
	INCANDESCENT, COMPACT FLUORESCENT OR HIGH INTENSITY DISCHARGE LIGHTING FIXTURE, CEILING MOUNTED, AS NOTED.
H	INCANDESCENT, COMPACT FLUORESCENT OR HIGH INTENSITY DISCHARGE LIGHTING FIXTURE, WALL MOUNTED, AS NOTED.
	INCANDESCENT, COMPACT FLUORESCENT OR HIGH INTENSITY DISCHARGE LIGHTING FIXTURE, RECESSED CEILING MOUNTED, AS NOTED.
L	LANDSCAPE LIGHT FIXTURE, POLE MOUNTED, AS NOTED.
	EXIT LIGHT, CEILING MOUNTED WITH INDICATED DIRECTIONAL ARROWS. SHADED AREA(S) INDICATES ILLUMINATED FACE(S).
H	EXIT LIGHT, SAME AS EXCEPT WALL MOUNTED.
S	SINGLE POLE SWITCH.
S_3	"3-WAY" SWITCH.
S_M	MANUAL MOTOR STARTER.
S_a	SWITCH CONTROLLING OUTLET "a".
S_D	WALL DIMMER.
S_K	KEY OPERATED SWITCH.
1	ZONE CONTROL SWITCH FOR LIGHTS, NUMBER INDICATES ZONE CONTROLLED.
S	OCCUPANCEY SENSOR, WALL MOUNTED
S_O	OCCUPANCEY SENSOR, CEILING MOUNTED
	DUPLEX CONVENIENCE RECEPTACLE, WALL MOUNTED. 15" MIN. FROM FLOOR.
H	SPECIAL PURPOSE RECEPTACLE, RATING AS NOTED, WALL MOUNTED.
F	COMBINATION POWER/SIGNAL POKE-THRU BOX. F = FURNITURE FEED POKE-THRU.
	DOUBLE DUPLEX RECEPTACLE UNDER ONE COVER PLATE.

ELECTRICAL SYMBOLS

SYMBOL	DESCRIPTION
	TELEPHONE OUTLET, FLOOR MOUNTED.
	TELEPHONE OUTLET, WALL MOUNTED.
	DATA OUTLET, FLOOR MOUNTED.
	DATA OUTLET, WALL MOUNTED.
	DATA OUTLET, WALL MOUNTED.
	DATA OUTLET, WALL MOUNTED.
	DATA OUTLET, WALL MOUNTED.
	DATA OUTLET, WALL MOUNTED.
	WIRELESS OUTLET BOX.
	DATA/POWER FLOOR BOX, RECESS MOUNTED.
	DATA/POWER FLOOR BOX, RECESS MOUNTED.
	SINGLE SNAKETRAY, SIZE AS NOTED
	DOUBLE SNAKETRAY, SIZE AS NOTED
	PANELBOARD (120/208V).
	PANELBOARD, FLUSH MOUNTED.
	PANELBOARD (277/480V).
	PANELBOARD, FLUSH MOUNTED.
	POWER DISTRIBUTION PANEL OR SWITCHBOARD, AS INDICATED.
3	MOTOR OUTLET. NUMBER INDICATES HORSEPOWER RATING.
3P 30 15	DISCONNECT SWITCH, SIZE AS INDICATED. (30 AMPERE RATING, 3-POLE). NON-FUSIBLE UNLESS FUSE SIZE (15 AMPERE) IS SHOWN ALONGSIDE SWITCH.
	MAGNETIC MOTOR CONTROLLER.
	FUSE; TYPE AND SIZE AS NOTED.
	ELECTRICAL CONNECTION.
	MOLDED CASE CIRCUIT BREAKER, STATIONARY TYPE.
3	NOTE REFERENCE: "SEE NOTE #3 ON THIS SHEET".
A 150	LIGHTING FIXTURE TYPE "A", 150 WATTS INPUT; SEE FIXTURE SCHEDULE.
A 10	DETAIL REFERENCE: "SEE DETAIL 'A' ON SHEET E-10".
5	EQUIPMENT ITEM NUMBER.

ABBREVIATIONS:

A	AMPERE	KW	KILOWATT
AFF	ABOVE FINISHED FLOOR	MCM	THOUSAND CIRCULAR MILS
AL	ALUMINUM	NTS	NOT TO SCALE
C	CONDUIT	NL	NIGHT LIGHT
CAT	CATALOG	P	POLE
CB	CIRCUIT BREAKER	(RL)	RELOCATE
CO	CONDUIT ONLY	(RLD)	RELOCATED
CU	COPPER	(R)	REMOVE
G	GROUND	(RT)	RETAIN
GFI	GROUND FAULT INTERRUPTER	TYP	TYPICAL
(E)	EXISTING	UON	UNLESS OTHERWISE NOTED
(N)	NEW	V	VOLT
KVA	KILOVOLT AMPERE	VIF	VERIFY IN FIELD
		WP	WEATHERPROOF

NOTE: SYMBOLS LISTED ARE FOR GENERAL USE. DISREGARD ANY SYMBOLS THAT ARE NOT USED ON PLAN.

Bulletin No.07


Date: February 1, 2006
To: S.J. Amoroso Construction, 390 Bridge Parkway, Redwood shores CA 94065
Project: LOS MEDANOS COLLEGE SCIENCE BUILDING, Contra Costa Community College District, DSA No. 01-106226 File # 7-C1, tBP PIN 20247.00
Description: REFERENCE: E-0.1, E-1.1, Submittal #20:
Provide wall mounted light Kenall #MR7FIL in locations as indicated on SKRS-07.1 to SKRS-07.5 in place of downlights at entrance canopies. Fixture is to be located +9'-0" AFF typical. Provide Re-submittal #20 for C-4.
Issued By: Architect
Requested By: Architect
Reason: Lighting coordination
Enclosures: SKRS-07.1 to SKRS-07.5
Distribution:

Copies:	Name:	Organization:
1 copy	Mark Delgado	S. J. Amoroso
1 copy	Cara Pereira	CCCCDistrict
1 copy	Bob Harkin	Inspector of Record
1 copy	Tom Beckett	tBP/Architecture
1 copy	File 20247.007.4	tBP/Architecture
1 copy	Larry Lai	Toft Wolff Farrow Inc.

Action: ☒ For Information/Clarification only ☐ Provide Price/Credit Proposal. (Refer to this Bulletin No. when responding) ☐ Requires DSA review and approval ☐ Proceed as authorized by District

cc: EVA Brandt

tBP/Architecture, 1000 Burnett Ave, Suite 140, Concord, CA 94520. ph: 925.246.6419, fax: 925.246.6495

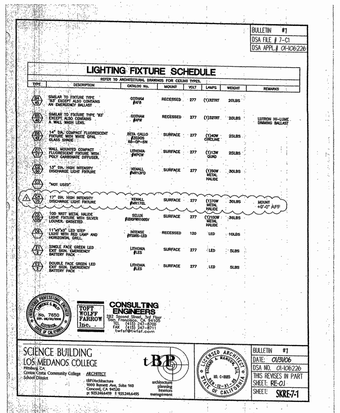

S. J. AMOROSO
Request For Information/Clarification

DSA FILE NO. 7-C1
DSA APPL. No. 01-106226

To: tBP/Architecture, 1000 Burnett Ave, Suite 140, Concord, CA 94520
Attn: Calla Chiang, Tom Beckett
Fax: 925-246-6495
Subj.: Overhead Conduit Fasteners
Reference (dwg, spec.):
Reply Requested By: 9/13/06

Project: LOS MEDANOS COLLEGE SCIENCE BUILDING, Contra Costa Community College District
tBP p/n: 20247.00
RFI No: 339
Subcontractor RFI: EWS 29
Date: 9/8/06

INFORMATION REQUESTED:
Please note the attached Edward Scott Electric RFI No. 29 regarding overhead conduit fasteners. Please advise.

SUGGESTED SOLUTION:
Cost Impact: ☐ Schedule Impact: ☐ days By: Justin Warren

RESPONSE: DATE:

TWF takes no exception to the proposed conduit fasteners, but recommends that the conduit fastener cut sheets be forwarded to the structural engineer for his review and comment.

Larry Lai/TWF - 9/25/06


DSA takes no exception to proposed conduit fastener for conduits up to 1". 9-29-06

EDWARD W. SCOTT ELECTRIC CO., INC.
450 HARRET STREET
San Francisco, CA 94103-4914
Phone: (415) 626-0701 Fax: (415) 626-2837

REQUEST FOR INFORMATION

PROJECT: SCIENCE BLDG. R.F.I.# 29 R.F.I. Date 9/16/06
JOB: 9451 ACTUAL REPLY DATE:
TO: MARK DELGADO LMC
GF: ANDERSON CONST.
REF. DWG: NONE
LOCATION: THROUGHOUT
POTENTIAL COST IMPACT: ___ COST ___ C. SCHEDULE ___ OTHER ___ LABOR ___ NO IMPACT ___ MATERIAL
INFORMATION REQUESTED: IF NO OBJECTIONS WE WOULD LIKE TO USE THESE CONDUIT FASTENERS WITH 3/8" THREADED ROD TO SUPPORT OVER HEAD CONDUITS SIZES 3/4" & 1". (PLEASE SEE ATTACHED)
REPLY REQUIRED BY: ASAP SIGNED:
NOTE: IF NO REPLY IS RECEIVED BY US BY THE ABOVE NOTED DATE, A TIME EXTENSION WILL BE REQUIRED WITH POSSIBLE COST IMPACTS.
RESPONSE:



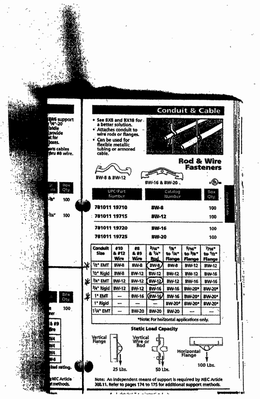

TWF #03058.00

tBP
architecture
planning
interiors
management
tBP/Architecture
1000 Burnett Avenue, Suite 140
Concord, CA 94520
p: 925.246.6419 f: 925.246.6495
architect
CONSULTING ENGINEERS
TOFT WOLFF FARROW Inc.
consultant
IDENTIFICATION STAMP
DIV. OF THE STATE ARCHITECT
OFFICE OF REGULATION SERVICES
APP. # 01-106226
DATE 1-11-06
name
address
city, state, zip
ph:
fx:
agency

SCIENCE BUILDING
LOS MEDANOS COLLEGE
Contra Costa Community College District

owner

tBP project number : 20241.00
file name: SYMBOLS
drawn by: LLAI checked by: LSW
date: NOVEMBER 15, 2004

drawing title:
SYMBOLS, NOTES AND LIGHT FIXTURE SCHEDULE

LMC SCIENCE 313-023-112.01-0-00.00
drawing no:
E-0.1

S. J. AMOROSO
Request For Information/Clarification

DSA FILE NO. 7-C1
DSA APPL. No. 01-106226

To: tBP/Architecture
1000 Burnett Ave, Suite 140
Concord, CA 94520

Attn: Celia Chiang, Tom Beckett
Fax: 925-246-8495

Subj.: Power Pull Box "ISB"

Reference (dwg, spec.): E0.2

Project: LOS MEDANOS COLLEGE
SCIENCE BUILDING
Contra Costa Community College District

tBP p/n: 20247.00

RFI No: **496**
Subcontractor RFI: EWS 72

Reply Requested By: 3/13/07

INFORMATION REQUESTED: Date: 3/6/07

Please note the attached EWS RFI No. 72 regarding Power Pull Box "ISB" which they need to know the hot (high Volt) side to plug into the box. EWS was advised to test the loops and plug into the hot one due to the fact that they may be miss labeled. Please advise.

SUGGESTED SOLUTION:
Cost Impact: ☐ Schedule Impact: ☐ days By: Justin Warren

RESPONSE: DATE:

Pursuant to verbal discussion with Joe of Scott electric at site on 3/8/07, there is one 5KV electrical circuit that consists of both an "A" and "B" loop. Both loops should be energized.
Primary electrical subcontractor to verify prior to any work proceeding. If both loops are energized, connection can be at either "A" or "B" disconnectable elbow taps/sockets.

Tom Beckett

3/7/07

USeb North Loop "A"

RFI # 000
Page 1

SHEET NOTES


1. HANDHOLE, UTILITY VAULT #2436.


ADDENDUM #1
DSA FILE # 7-C1
DSA APPL # 01-106226

SCIENCE BUILDING
LOS MEDANOS COLLEGE
Pittsburg CA
Contra Costa Community College School District
ARCHITECT
tBP/Architecture
1000 Burnett Ave, Suite 140
Concord, CA 94520
p: 925.246.6495 f: 925.246.6496


tBP architecture planning interiors management


ADDENDUM #1
DATE: 03/08/05
DSA NO: 01-106226
THIS REVISES IN PART
SHEET: RE-0.2
SHEET: RE-2.2

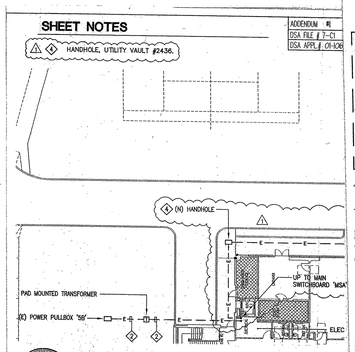


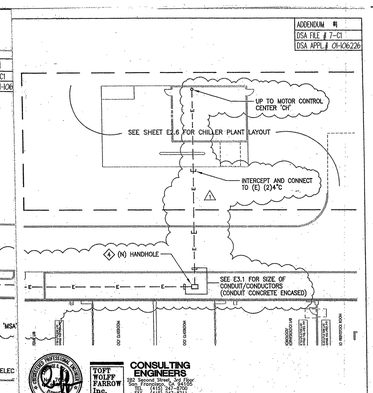

TOFT WOLFF FARROW Inc. CONSULTING ENGINEERS
283 Second Street, Ste 100
San Francisco, CA 94105
PH (415) 247-8711
FX (415) 247-8711
twfar@twfar.com

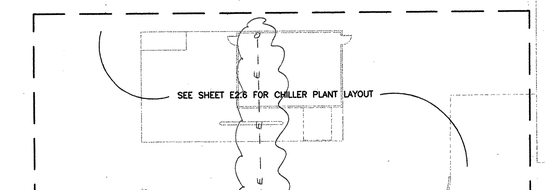

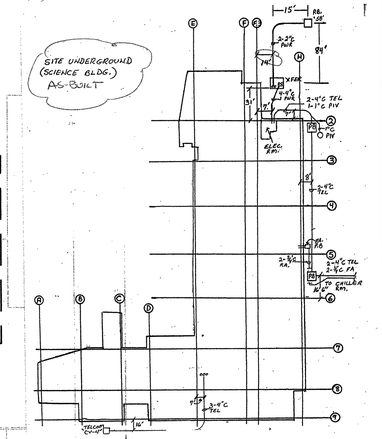

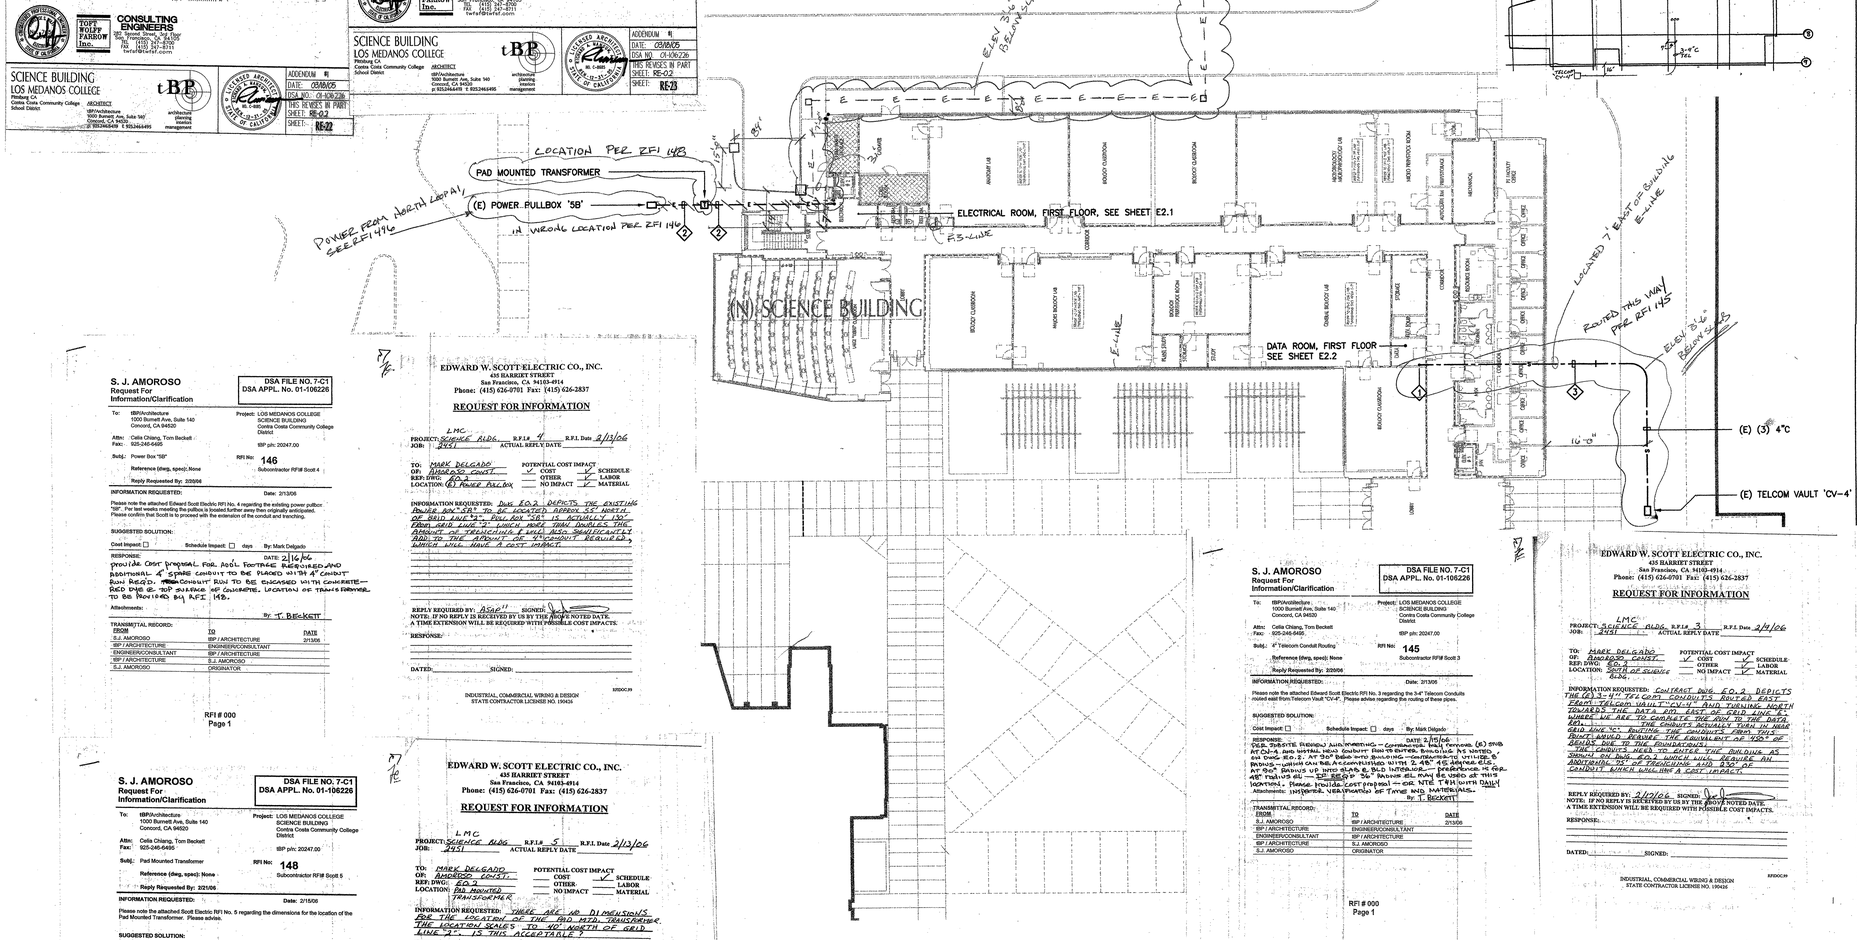

S. J. AMOROSO
Request For Information/Clarification

DSA FILE NO. 7-C1
DSA APPL. No. 01-106226

To: tBP/Architecture, 1000 Burnett Ave, Suite 140, Concord, CA 94520
Project: LOS MEDANOS COLLEGE SCIENCE BUILDING, Contra Costa Community College District
Attn: Celia Chiang, Tom Beckett
Fax: 925-246-6495
tBP p/n: 20247.00
Subj.: Power Box "5B"
RFI No: 146
Reference (dwg, spec): None
Subcontractor RFI# Scott 4
Reply Requested By: 2/20/06

INFORMATION REQUESTED: Date: 2/13/06

Please note the attached Edward Scott Electric RFI No. 4 regarding the existing power pullbox "5B". The last weeks mending the pullbox in located further away then originally anticipated. Please confirm that Scott is to proceed with the extension of the conduit and trenching.

SUGGESTED SOLUTION:

Cost Impact: ☐ Schedule Impact: ☐ days By: Mark Delgado

RESPONSE: DATE: 2/16/06
PROVIDE COST PROPOSAL FOR ADDL FOOTAGE REQUIRED AND ADDITIONAL 4" SPARE CONDUIT TO BE PLACED WITH 4" CONDUIT RUN REQ'D. TRENCH/CONDUIT RUN TO BE ENCASED WITH CONCRETE — RED DYE TO BE ADDED AT CONCRETE. LOCATION OF TRANCH APPROVED TO BE PROVIDED BY RFI 148.

Attachments: By: T. BECKETT

TRANSMITTAL RECORD:

FROM	TO	DATE
S.J. AMOROSO	tBP / ARCHITECTURE	2/13/06
tBP / ARCHITECTURE	ENGINEER/CONSULTANT	
ENGINEER/CONSULTANT	tBP / ARCHITECTURE	
tBP / ARCHITECTURE	S.J. AMOROSO	
S.J. AMOROSO	ORIGINATOR	

RFI # 000
Page 1

EDWARD W. SCOTT ELECTRIC CO., INC.
435 HARRIET STREET
San Francisco, CA 94103-4914
Phone: (415) 626-0701 Fax: (415) 626-2837

REQUEST FOR INFORMATION

PROJECT: LMC / SCIENCE BLDG. RFI# 4 R.F.I. Date 2/13/06
JOB: 2451 ACTUAL REPLY DATE

TO: MARK DELGADO
OF: AMOROSO CONST.
REF. DWG: E0.2
LOCATION: (E) POWER PULLBOX

POTENTIAL COST IMPACT
___ COST ___ SCHEDULE
___ OTHER ___ LABOR
___ NO IMPACT ___ MATERIAL

INFORMATION REQUESTED: PLAN E0.2 DEPICTS THE EXISTING PULLBOX "5B" TO BE LOCATED APPROX. 5'-0" NORTH OF GRID LINE "2". PULLBOX "5B" IS ACTUALLY 190' FROM GRID LINE "2" WHICH MORE THAN DOUBLES THE AMOUNT OF TRENCHING & WIRE. ACCO. SIGNIFICANTLY ADD TO THE AMOUNT OF "CHANGE" REQUESTED, WHICH WILL HAVE A COST IMPACT.

REPLY REQUIRED BY: ASAP!! SIGNED:
NOTE: IF NO REPLY IS RECEIVED BY US BY THE ABOVE NOTED DATE, A TIME EXTENSION WILL BE REQUIRED WITH POSSIBLE COST IMPACTS.

RESPONSE:

DATED: SIGNED:

INDUSTRIAL, COMMERCIAL WIRING & DESIGN
STATE CONTRACTOR LICENSE NO. 190436

RFIDOC.09

S. J. AMOROSO
Request For Information/Clarification

DSA FILE NO. 7-C1
DSA APPL. No. 01-106226

To: tBP/Architecture, 1000 Burnett Ave, Suite 140, Concord, CA 94520
Project: LOS MEDANOS COLLEGE SCIENCE BUILDING, Contra Costa Community College District
Attn: Celia Chiang, Tom Beckett
Fax: 925-246-6495
tBP p/n: 20247.00
Subj.: Pad Mounted Transformer
RFI No: 148
Reference (dwg, spec): None
Subcontractor RFI# Scott 5
Reply Requested By: 2/21/06

INFORMATION REQUESTED: Date: 2/15/06

Please note the attached Scott Electric RFI No. 5 regarding the dimensions for the location of the Pad Mounted Transformer. Please advise.

SUGGESTED SOLUTION:

Cost Impact: ☐ Schedule Impact: ☐ days By: Mark Delgado

RESPONSE: DATE: 2.27.06
Southeast corner of transformer pad to be located 31'-0" north of grid line 2 and 24'-0" west of grid line H. This should place the south edge of the pad approximately 4'-0" north of the drive adjacent to the freight elevator entrance. Pad size to be determined by transformer submittal requirements, which on past projects for transformers of specified size are approximately 10'-0" square.

Attachments: By: C. Chiang/tBP

TRANSMITTAL RECORD:

FROM	TO	DATE
S.J. AMOROSO	tBP / ARCHITECTURE	2/15/06
tBP / ARCHITECTURE	ENGINEER/CONSULTANT	
ENGINEER/CONSULTANT	tBP / ARCHITECTURE	
tBP / ARCHITECTURE	S.J. AMOROSO	2.27.06
S.J. AMOROSO	ORIGINATOR	

RFI # 000
Page 1

EDWARD W. SCOTT ELECTRIC CO., INC.
435 HARRIET STREET
San Francisco, CA 94103-4914
Phone: (415) 626-0701 Fax: (415) 626-2837

REQUEST FOR INFORMATION

PROJECT: LMC / SCIENCE BLDG. RFI# 5 R.F.I. Date 2/13/06
JOB: 2451 ACTUAL REPLY DATE

TO: MARK DELGADO
OF: AMOROSO CONST.
REF. DWG: E0.2
LOCATION: PAD MOUNTED TRANSFORMER

POTENTIAL COST IMPACT
___ COST ✓ SCHEDULE
___ OTHER ___ LABOR
___ NO IMPACT ___ MATERIAL

INFORMATION REQUESTED: THERE ARE NO DIMENSIONS FOR THE LOCATION OF THE PAD MTD. TRANSFORMER. THE LOCATION SCALES TO 40' NORTH OF GRID LINE "2". IS THIS ACCEPTABLE?

REPLY REQUIRED BY: ASAP!! SIGNED:
NOTE: IF NO REPLY IS RECEIVED BY US BY THE ABOVE NOTED DATE, A TIME EXTENSION WILL BE REQUIRED WITH POSSIBLE COST IMPACTS.

RESPONSE:

DATED: SIGNED:

INDUSTRIAL, COMMERCIAL WIRING & DESIGN
STATE CONTRACTOR LICENSE NO. 190436

RFIDOC.09

S. J. AMOROSO
Request For Information/Clarification

DSA FILE NO. 7-C1
DSA APPL. No. 01-106226

To: tBP/Architecture, 1000 Burnett Ave, Suite 140, Concord, CA 94520
Project: LOS MEDANOS COLLEGE SCIENCE BUILDING, Contra Costa Community College District
Attn: Celia Chiang, Tom Beckett
Fax: 925-246-6495
tBP p/n: 20247.00
Subj.: 4" Telecom Conduit Routing
RFI No: 145
Reference (dwg, spec): None
Subcontractor RFI# Scott 3
Reply Requested By: 2/20/06

INFORMATION REQUESTED: Date: 2/13/06

Please note the attached Edward Scott Electric RFI No. 3 regarding the 3-4" Telecom Conduits routed east from Telecom Vault "CV-4". Please advise regarding the routing of these pipes.

SUGGESTED SOLUTION:

Cost Impact: ☐ Schedule Impact: ☐ days By: Mark Delgado

RESPONSE: DATE: 2/16/06
PER REVISED ROUTING — CONTRACTOR WILL TRENCH (E) DWB AT CA-3 AND INSTALL NEW CONDUIT RUN AS NOTED ON DWG. E2.2. AT 90' DUE NTH OF BUILDING — CONTRACTOR WILL STUB 4 RISERS — WHICH CAN BE ACCOMPLISHED WITH 2.45' 45 DEGREE ELL AT 90' BRINGS UP INTO SLAB & 90 INTERIOR — PROVIDE 45 DEG 45' TRAVEL EL — 90 REQ'D 36" RADIUS ELL RUN BE USED AT THIS LOCATION. PLEASE CONFIRM — WE TRENCH TODAY!

Attachments: (SKETCHES, VERIFICATION) OF TIME AND MATERIALS. By: T. BECKETT

TRANSMITTAL RECORD:

FROM	TO	DATE
S.J. AMOROSO	tBP / ARCHITECTURE	2/13/06
tBP / ARCHITECTURE	ENGINEER/CONSULTANT	
ENGINEER/CONSULTANT	tBP / ARCHITECTURE	
tBP / ARCHITECTURE	S.J. AMOROSO	
S.J. AMOROSO	ORIGINATOR	

RFI # 000
Page 1

EDWARD W. SCOTT ELECTRIC CO., INC.
435 HARRIET STREET
San Francisco, CA 94103-4914
Phone: (415) 626-0701 Fax: (415) 626-2837

REQUEST FOR INFORMATION

PROJECT: LMC / SCIENCE BLDG. RFI# 3 R.F.I. Date 2/9/06
JOB: 2451 ACTUAL REPLY DATE

TO: MARK DELGADO
OF: AMOROSO CONST.
REF. DWG: E0.2
LOCATION: 2nd FLOOR

POTENTIAL COST IMPACT
___ COST ✓ SCHEDULE
___ OTHER ___ LABOR
___ NO IMPACT ___ MATERIAL

INFORMATION REQUESTED: CONTRACT DOC E0.2 DEPICTS THE (E) 3-4" TEL CONDUITS ROUTED EAST FROM TELCOM VAULT "CV-4" AND TURNING NORTH TOWARDS THE DATA RM. EAST AND NORTH RUNS ARE WHERE WE ARE TO CONDUIT THE DATA RM. ETC. THE CONDUITS ACTUALLY TURN AT GRID LINE "C". ROUTING THE CONDUITS FROM THE FRONT WOULD REQUIRE THE EQUIVALENT OF 450' OF TRENCH DUE TO THE FOUNDATION. THE CONDUITS NEED TO ENTER THE BUILDING AS SHOWN ON DWG. E0.2 WHICH WILL REQUIRE AN ADDITIONAL 75' OF TRENCHING AND 250' OF CONDUIT WHICH WILL HAVE A COST IMPACT.

REPLY REQUIRED BY: 2/10/06 SIGNED:
NOTE: IF NO REPLY IS RECEIVED BY US BY THE ABOVE NOTED DATE, A TIME EXTENSION WILL BE REQUIRED WITH POSSIBLE COST IMPACTS.

RESPONSE:

DATED: SIGNED:

INDUSTRIAL, COMMERCIAL WIRING & DESIGN
STATE CONTRACTOR LICENSE NO. 190436

RFIDOC.09

S. J. AMOROSO
Request For Information/Clarification

DSA FILE NO. 7-C1
DSA APPL. No. 01-106226

To: tBP/Architecture, 1000 Burnett Ave, Suite 140, Concord, CA 94520
Project: LOS MEDANOS COLLEGE SCIENCE BUILDING, Contra Costa Community College District
Attn: Celia Chiang, Tom Beckett
Fax: 925-246-6495
tBP p/n: 20247.00
Subj.: PVC Piping per Section 16050
RFI No: 137
Reference (dwg, spec):
Subcontractor RFI#
Reply Requested By: 2/15/06

INFORMATION REQUESTED: Date: 2/9/06

Per John Lambert's letter all telecom building entrance pipe is supposed to be 4 inch schedule 40 PVC TC-2. Per Note 3 on 3.02 it is called out as 4" C NEMA TC-14A Heavy Wall Epoxy Fiberglass Conduits. Please advise on which pipe is to be used.

SUGGESTED SOLUTION:

Cost Impact: ☐ Schedule Impact: ☐ days By: Mark Delgado

RESPONSE: DATE: 2.22.06
4-inch schedule 40 PVC TC-2 conduit with 4-ft radius bend and (2) 45-degree ells in the horizontal run and 48-inch radius right ells at the entrance to the room as installed is acceptable.

Attachments: By: J. Lambert/tBP

TRANSMITTAL RECORD:

FROM	TO	DATE
S.J. AMOROSO	tBP / ARCHITECTURE	2/9/06
tBP / ARCHITECTURE	ENGINEER/CONSULTANT	2.09.06
ENGINEER/CONSULTANT	tBP / ARCHITECTURE	2.22.06
tBP / ARCHITECTURE	S.J. AMOROSO	2.23.06
S.J. AMOROSO	ORIGINATOR	

RFI # 000
Page 1

SHEET NOTES

1. STUB (3) 4"C UP THROUGH FLOOR INTO FIRST FLOOR DATA ROOM. COORDINATE LOCATION OF STUB-UPS WITH TELCOM.
2. FOR SIZE OF CONDUIT/CONDUCTORS SEE DIAGRAM ON SHEET E3.1.
3. EXTEND EXISTING (3)4"C WITH (3) NEW 4"C NEMA TC-14A HEAVY WALL EPOXY FIBERGLASS CONDUITS FROM THE POINT THAT THE EXISTING CONDUITS ARE INTERCEPTED. THE NEMA TC-14A HEAVY WALL EPOXY FIBERGLASS BUILDING ENTRANCE CONDUITS SHALL TRANSITION TO WRAPPED GALVANIZED RIGID STEEL (WORS) AT THE VERTICAL UPTURNS THROUGH THE SLAB. THE NEMA TC-14A HEAVY WALL EPOXY FIBERGLASS CONDUIT TO WORS TRANSITION SHALL BE SEALED WITH HEAT SHRINK TUBING OR ADHESIVE BACK WRAPPING. JOINT COMPOUND SHALL BE USED ON THE CONDUIT THREADS. EXTEND WORS 3" ABOVE FINISHED FLOOR GRADE AND PROVIDE BUSHING WITH TEMPORARY SEAL TO PROTECT CONDUITS DURING REMAINING CONSTRUCTION. ALL NEMA TC-14A HEAVY WALL EPOXY FIBERGLASS CONDUIT BENDS FOR INTERBUILDING ENTRANCES SHALL BE 11-1/4, 22-1/2, 45 AND 90 DEGREE FACTORY MADE BENDS WITH AN 8'-0" MINIMUM BEND RADIUS.

RFI 137

CAMPUS NORTH

THF #03058.00

tBP architecture planning interiors management
tBP/Architecture
1000 Burnett Avenue, Suite 140
Concord, Ca 94520
p: 925.246.6419 f: 925.246.6495
architect

TOFT WOLFF FARROW Inc. CONSULTING ENGINEERS
283 Second Street, Ste 100
San Francisco, CA 94105
PH (415) 247-8711
FX (415) 247-8711
twfar@twfar.com
consultant

REVIEWED FOR CODE COMPLIANCE
DSA, OFFICE OF REGULATION SERVICES
APP. # 01-106226
DATE 1-31-06
name
address
city, state, zip
ph:
fx:
agency

SCIENCE BUILDING
LOS MEDANOS COLLEGE
Contra Costa Community College District

owner

tBP project number : 20247.00
file name:
drawn by: LLAI checked by: LSAI
date: NOVEMBER 15, 2004

drawing title:
SITE PLAN - ELECTRICAL

LMC SCIENCE 313-023-112.01-0-00.00
drawing no:
E0.2

S. J. AMOROSO
Request For Information/Clarification

DSA FILE NO. 7-C1
DSA APPL. No. 01-106226

To: IBP/Architecture, 1000 Burnett Ave, Suite 140, Concord, CA 94520
Project: LOS MEDANOS COLLEGE SCIENCE BUILDING, Contra Costa Community College District
Attn: Celia Chiang, Tom Beckett
Fax: 925-246-6495
IBP p/n: 20247.00
Subj.: Low Voltage Lighting Switches
RFI No: 334
Reference (dwg, spec.): A2-1,LP2-1b, M1-1, M1.2, 4AA5-1
Subcontractor RFI: EWS 28
Reply Requested By: 9/6/06

INFORMATION REQUESTED: Date: 8/30/06

Please note the attached EWS RFI No. 28 regarding the low voltage lighting switches in rooms 143, 203 and 246. Per a conversation between Larry Lai and Joe Jimenez these switches are to be mounted at 64" AFF to center. Please confirm.

SUGGESTED SOLUTION:
Cost Impact: ☐ Schedule Impact: ☐ days By: Justin Warren

RESPONSE: DATE:

To clarify, the conversation was between Larry Lai of Toft Wolff Farrow and Joe Jimenez of Scott Electric.

Due to limited space for the required number of switch outlet boxes in rooms 143, 203, and 206, the outlet box for the nine control switch is recommended to be installed below the regular room light switches, in order to comply with ADA.

Larry Lai/TWF - 9/8/06

Please note that the reach height limit for ADA front approach is 48" AFF. See attached CBC.

Vanessa Ling/IBP - 9/8/06

RFI # 000
Page 1

EDWARD W. SCOTT ELECTRIC CO., INC.
435 HARRIET STREET
San Francisco, CA 94103-4914
Phone: (415) 626-0701 Fax: (415) 626-2837

REQUEST FOR INFORMATION

PROJECT: LMC SCIENCE BLDG. RFI# 28 R.F.I. Date 8/25/06
JOB: 2451 ACTUAL REPLY DATE

TO: MARK DELGADO
OF: AMOROSO CONST.
REF/DWG: E1.1, E1.4
LOCATION: RM. 143, 206, & 203

POTENTIAL COST IMPACT
___ COST ___ SCHEDULE
___ OTHER ___ LABOR
___ NO IMPACT ___ MATERIAL

INFORMATION REQUESTED: AS PER PHONE CONVERSATION ON 8/30/06 WITH LARRY LAI OF TOFT WOLFF FARROW THE LOW VOLTAGE LTG SWITCHES IN ROOMS 143, 203 & 206 WILL BE MOUNTED @ 64" AFF TO CENTER.

REPLY REQUIRED BY: _____ SIGNED: _____
NOTE: IF NO REPLY IS RECEIVED BY US BY THE ABOVE NOTED DATE, A TIME EXTENSION WILL BE REQUIRED WITH POSSIBLE COST IMPACTS.


RESPONSE:

DATED: _____ SIGNED: _____

EDOC39

INDUSTRIAL, COMMERCIAL WIRING & DESIGN
STATE CONTRACTOR LICENSE NO. 190436

2001 CALIFORNIA BUILDING CODE FIGURE 11B-6D

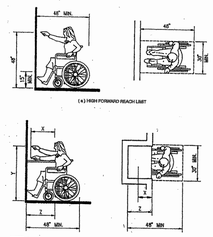

1-134.87

Bulletin No.51

Date: 11/9/2006
To: S.J. Amoroso Construction, 200 Bridge Parkway, Redwood shores CA 94065
Project: LOS MEDANOS COLLEGE SCIENCE BUILDING, Contra Costa Community College District, DSA No. 01-106226; File # 7-C1, IBP ITN 2006T.00
Description:

REFERENCE: Sheet A8-2; A8-3, E-1.1, E-1.2, E-1.3, E-1.4 ; RFI #372, 394
Clarification to lighting fixtures in Stair #1 and 2.

Clarification to lighting at Stair #1:

1. At First Floor:
   (2) ceiling mounted B6 under the intermediate landing are revised to (2) B2.
   (4) wall mounted B6 are deleted as shown on SKE-S1-3.
   (2) B6 adjacent to CWD shown SKE-S1-3 are deleted per RFI 372.
2. At Second Floor: (2) B6 are deleted as shown on SKE-S1-4.
3. At Roof:
   (1) A23 wall mount indirect fixture is added as shown on SKE-S1-5.
   (1) B3 recessed light is revised to a C3 surface mount due to shallow framing depth at exterior canopy.

Provide cost proposal for credit of (10) deleted B6, (1) deleted B3; (2) added B2, (1) added A23, (3) added C3.


Clarification to lighting at Stair #2:

4. At First Floor: (2) B6 surface are revised to (2) B2-recessed. See SKE-S1-1.
5. At Second Floor: See SKE-S1-2
   (3) B6-surface are revised to (3) B2-recessed.
   (6) B6-surface at wall mounted are deleted.
   (1) indirect wall mount shown U/A8-2 is deleted.

Provide cost proposal for credit of (3) deleted B6, (1) deleted indirect, (3) added B2.

Issued By: Architect
Requested By: Architect
Reason: Clarification to lighting at Stair #1 and 2.
Enclosures: SKE-S1-1, SKE-S1-2, SKE-S1-3, SKE-S1-4, SKE-S1-5, SKE-S1-6

IBP/Architecture · 1000 Burnett Ave. Suite 140 · Concord, CA. 94520 · ph: 925.246.6400 · fax: 925.246.6496

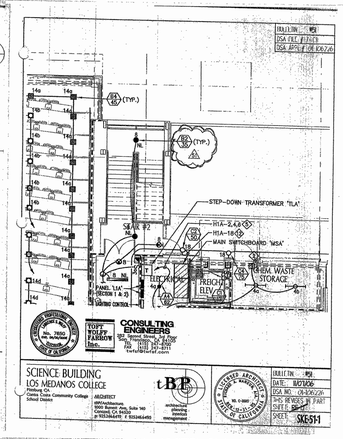

Job 682

From: Jim Weaver [RWeaver@tbparchitecture.com]
Sent: Wednesday, April 26, 2007 5:13 PM
To: Job 682
Cc: Larry Lai
Subject: RE: Sheets RE-1.1 and RE-1.2

Mark:
The answer is that there are no RE-1.1 or RE-1.2 sheets.
Sorry for any confusion but please post references to the E-1.1 and E-1.2 sheets.
Let me know if any question.
Thanks,
Jim

From: Job 682 [mailto:job682@dsjamoroso.com]
Sent: Friday, April 20, 2007 7:54 AM
To: Jim Weaver
Subject: FW: Sheets RE-1.1 and RE-1.2

Jim,

I forgot to nag you about this question when you were on-site yesterday. So, I am re-emailing it today. look into this? Thank you.

Mark Delgado
Project Manager
S.J. Amoroso Construction
Los Medanos College Science Building
phone (925) 427-7567

-----Original Message-----
From: Job 682
Sent: Tuesday, April 10, 2007 3:53 PM
To: Jim Weaver (jsteiner@tbparchitecture.com)
Subject: Sheets RE-1.1 and RE-1.2

Jim,

I am going back and double checking Bulletins since I tend to miss these on my as-builts. In going back to review Bulletin 51, I noticed something odd.

Per sketch SKE-S1-1, this sketch is to modify sheet RE-1.1 while sketch SKE-S1-3 is to modify sheet RE-1.2. The problem is, I don't have either sheet RE-1.1 nor RE-2.2. What I do have is sheets RE-2.1, RE-2.2, RE-2.3 and RE-2.4.

Can you please look into this and clarify?

4/26/2007

S. J. AMOROSO
Request For Information/Clarification

DSA FILE NO. 7-C1
DSA APPL. No. 01-106226

To: IBP/Architecture, 1000 Burnett Ave, Suite 140, Concord, CA 94520
Project: LOS MEDANOS COLLEGE SCIENCE BUILDING, Contra Costa Community College District
Attn: Celia Chiang, Tom Beckett
Fax: 925-246-6495
IBP p/n: 20247.00
Subj.: Type C5 Fixture Installation and weatherproofing
RFI No: 364.1 (Revised 11/3/06)
Reference (dwg, spec.):
Subcontractor RFI:
Reply Requested By: 10/25/06

INFORMATION REQUESTED: Date: 10/19/06

Via response to RFI 364, we have been provided information regarding in-wall backing and attachment of the C5 fixtures to the wall. However, we are unable to locate details regarding the interface between these fixtures and metal panels nor are we able to locate details addressing how to weather seal these fixtures when they are attached to the wall. Please provide the needed details.

SUGGESTED SOLUTION:
Cost Impact: ☐ Schedule Impact: ☐ days By: Mark Delgado

RESPONSE: DATE:


See attached sketch SKA364.2, please note that this detail is original provided by Joe Ramey/Pacific Electric's shop drawing detailer.

Vanessa Ling/IBP - 10/31/06

The (4) C5 wall mount fixtures will be deleted. Provide credit for all the light fixtures, electrical work, mounting, labor, etc.
See future responses to RFI #407 for site fixtures replacement of building mounted lights.

Vanessa Ling/IBP - 11/3/06

RFI # 000
Page 1

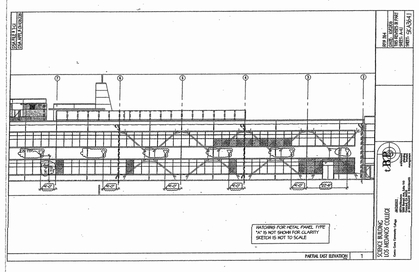

S. J. AMOROSO
Request For Information/Clarification

DSA FILE NO. 7-C1
DSA APPL. No. 01-106226

To: IBP/Architecture, 1000 Burnett Ave, Suite 140, Concord, CA 94520
Project: LOS MEDANOS COLLEGE SCIENCE BUILDING, Contra Costa Community College District
Attn: Celia Chiang, Tom Beckett
Fax: 925-246-6495
IBP p/n: 20247.00
Subj.: Lighting for Display Cases
RFI No: 440
Reference (dwg, spec.): E1.1, 2, 3, 4
Subcontractor RFI: EWS 66
Reply Requested By: 12/19/06

INFORMATION REQUESTED: Date: 12/12/06

Please note the attached Edward Scott RFI No. 66 regarding the lighting controls for the display cases per Bulletin No. 24. Please advise.

SUGGESTED SOLUTION:
Cost Impact: ☐ Schedule Impact: ☐ days By: Mark Delgado

RESPONSE: DATE:

The contractor is correct on the intent of how power is being provided to the display cases. The lights in the display cases will be energized as long as the corridor light (on the same circuit) has been energized during the normal operating hours or when the corridor lights need to be energized during "after-hour" use of the building. This was done so the lighting will comply with Title 24.

LLai / Toft Wolff Farrow

Jim Weaver/ IBP Architecture
1
12/18/06

RFI # 000
Page 1

EDWARD W. SCOTT ELECTRIC CO., INC.
435 HARRIET STREET
San Francisco, CA 94103-4914
Phone: (415) 626-0701 Fax: (415) 626-2837

REQUEST FOR INFORMATION

PROJECT: LMC SCIENCE BLDG. RFI# 66 R.F.I. Date 12/18/06
JOB: 2451 ACTUAL REPLY DATE

TO: MARK DELGADO
OF: AMOROSO CONSTRUCTION
REF/DWG: E1.1, E1.4
LOCATION: DISPLAY CASES 104 & 206

POTENTIAL COST IMPACT
___ COST ___ SCHEDULE
___ OTHER ___ LABOR
___ NO IMPACT ___ MATERIAL

INFORMATION REQUESTED: BULLETIN #24 ADDED A TOGGLE SWITCH AT EACH DISPLAY CASE, WE ALSO CHANGED THE CIRCUIT WHICH WAS UNSWITCHED TO CIRCUITS THAT ARE CONTROLLED BY THE E.T.L. CONTROL PANEL, IS THIS THE INTENT.

REPLY REQUIRED BY: 12/19/06 SIGNED: _____
NOTE: IF NO REPLY IS RECEIVED BY US BY THE ABOVE NOTED DATE, A TIME EXTENSION WILL BE REQUIRED WITH POSSIBLE COST IMPACTS.

RESPONSE:

DATED: _____ SIGNED: _____

EDOC39

INDUSTRIAL, COMMERCIAL WIRING & DESIGN
STATE CONTRACTOR LICENSE NO. 190436

S. J. AMOROSO
Request For Information/Clarification

DSA FILE NO. 7-C1
DSA APPL. No. 01-106226

To: IBP/Architecture, 1000 Burnett Ave, Suite 140, Concord, CA 94520
Project: LOS MEDANOS COLLEGE SCIENCE BUILDING, Contra Costa Community College District
Attn: Celia Chiang, Tom Beckett
Fax: 925-246-6495
IBP p/n: 20247.00
Subj.: Exit Signs Over Doors at Stairs 1 and 2
RFI No: 441
Reference (dwg, spec.): E-1.1, E-1.2
Subcontractor RFI: EWS 63
Reply Requested By: 12/20/06

INFORMATION REQUESTED: Date: 12/13/06

Please note the attached Edward Scott RFI No. 63 regarding the installation of the Exits Signs on the field fixed at Stairs #1 and #2. These signs cannot be installed. Please advise.

SUGGESTED SOLUTION:
Cost Impact: ☐ Schedule Impact: ☐ days By: Mark Delgado

RESPONSE: DATE:

No exception taken to the exit sign being end mounted as long as it is as close to the door as possible.

LLai / Toft Wolff Farrow
Jim Weaver / IBP Architecture

12/15/06

RFI # 000
Page 1

EDWARD W. SCOTT ELECTRIC CO., INC.
435 HARRIET STREET
San Francisco, CA 94103-4914
Phone: (415) 626-0701 Fax: (415) 626-2837

REQUEST FOR INFORMATION

PROJECT: LMC SCIENCE BLDG. RFI# 63 R.F.I. Date 12/13/06
JOB: 2451 ACTUAL REPLY DATE

TO: MARK DELGADO
OF: AMOROSO CONST.
REF/DWG: E-1.1, E-1.2
LOCATION: STAIR #1 & #2 AT 2ND FLOOR

POTENTIAL COST IMPACT
___ COST ___ SCHEDULE
___ OTHER ___ LABOR
___ NO IMPACT ___ MATERIAL

INFORMATION REQUESTED: THE EXIT SIGNS OVER THE EXIT DOORS AT STAIRS #1 & #2 TO THE 1ST FLOOR CANNOT BE INSTALLED AS SHOWN ON CONTRACT DWGS. DUE TO WINDOWS & DOOR LOCATIONS. WE WILL MOUNT THEM ON END OF THE WALLS SHOWN ON ATTACHED SKETCHES.


REPLY REQUIRED BY: ASAP SIGNED: _____
NOTE: IF NO REPLY IS RECEIVED BY US BY THE ABOVE NOTED DATE, A TIME EXTENSION WILL BE REQUIRED WITH POSSIBLE COST IMPACTS.


RESPONSE:

DATED: _____ SIGNED: _____

EDOC39

INDUSTRIAL, COMMERCIAL WIRING & DESIGN
STATE CONTRACTOR LICENSE NO. 190436

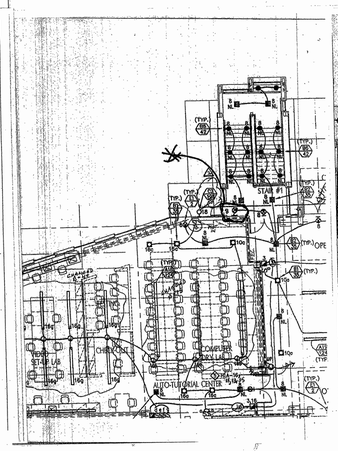

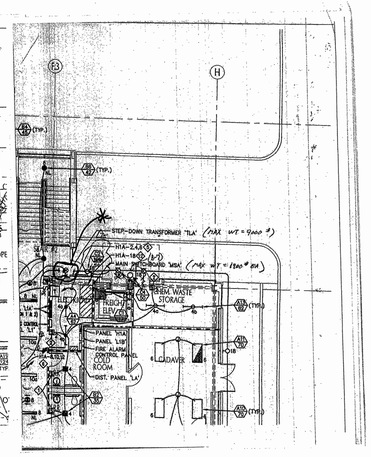

2A-4 EFS and EFD Enclosures with General Use Snap Switches Front Operated

Application:
EFS and EFD enclosures are installed in a rigid metallic conduit or electrical metallic tubing system in or on walls or ceilings. They are intended for use as a means to enclose and support snap switches rated 20 amps, 120/277 volts ac, 1 hp, 120 volts ac, and receptacles of a single-gang width installed in accordance with the NEC.
Recessed areas such as electrical plaster rings are offered for flush mounting applications. Surface mounting plates, gasketed (soft trading) and non-gasketed (hard trading) cover plates, and blank plates are provided as well, for metal handling or finishing areas where only mounting holes are required (plate mounting style).
A no-knockout areas where sturdy, flat surfaces are required.

Features:
• Factory-installed grounding screw
• Lugs for #14 solid wire
• Mounting lugs and taper tapped holes with #6-32 screws
• Large neoprene gaskets for fastening covers to bodies.
• Knockout hole to perform having 1/2" max is available.
• Embossed hole shafts and bushings are provided for #10 screws.

Standard Materials:
• Bodies and covers - Pressed iron alloy
• Plate - stainless steel
• Plate bushings - stainless steel


Standard Finishes:
• Factory-iron alloy - electrodeposited and baked enamel - gray
• Stainless steel - natural

Certifications and Compliances:
• NEMA/UL Class I, Div 1 & 2, Groups B,C,D
• NEMA/UL Class II, Div 1 & 2, Groups E,F,G
• NEMA/UL Class III, Div 1 & 2, Groups F,G
• NEMA 3,7/BCD,BFG,12

Options:


Description	Suffix to be Added to Basic Catalog No.
Non-Knockout Enclosure	-NKO
Inductive Endurance	-IE
Tungsten Filament Lamp Endurance	-TE
Temperature Plus	-T
Outlook Withdrawal	-WO


Dimensions (in inches)

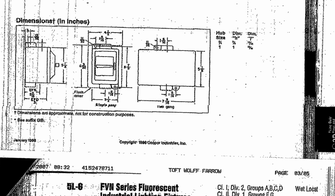

Hub Size
Conn. Dia.
Conn. Dia.
Mounting Holes
Knockout Holes
Knockout Holes
Mounting Holes
Conn. Dia.
Conn. Dia.
Hub Size


SHEET NOTES

1. OCCUPANCY SENSOR, WALL MOUNTED, WATTSTOPPER #WI-200.
2. OCCUPANCY SENSOR, WALL MOUNTED, DUAL LEVEL, WATTSTOPPER #WI-300.
3. OCCUPANCY SENSOR, CEILING MOUNTED WITH POWER PACK, WATTSTOPPER #CI-200.
4. DIMMER SWITCH, LUTRON #NF-103P-277.
5. ROUTE CIRCUITS 'H1A-2,6' TO PANEL 'H1A' VIA LIGHTING CONTROL PANEL 'L1'.
6. ROUTE CIRCUIT 'H1A-10' TO PANEL 'H1A' VIA LIGHTING CONTROL PANEL 'L1'.
7. (4) ZONE LIGHTING CONTROL UNIT, LUTRON #GRX-4104-T-TH, 4-GANG BACKBOX.
8. ROUTE CIRCUIT 'H1A-14' TO PANEL 'H1A' VIA DIMMING CONTROL PANEL 'DP-1'.
9. REMOTE LIGHTING CONTROL SWITCH, LUTRON #SG-4SN-WH-EGN, 1-GANG BACKBOX.
10. TO DIMMING PANEL 'DP-1'. 3/4"C-2#12, 1#18, (1) BELDEN #9461.
11. 277V JUNCTION BOX FOR DISPLAY CASE LIGHT FIXTURE.
12. ROUTE CIRCUIT H1A-18 TO PANEL 'H1A' VIA. TIME CLOCK IN LIGHTING CONTROL PANEL 'L1'.

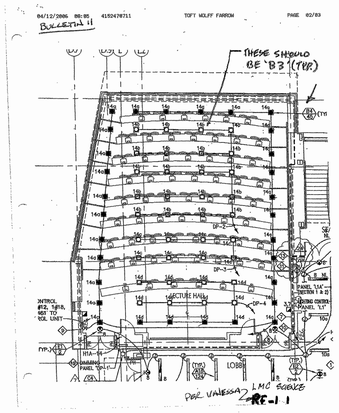

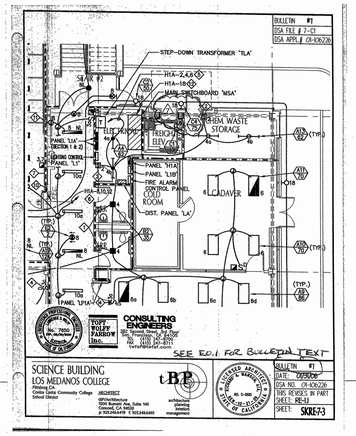

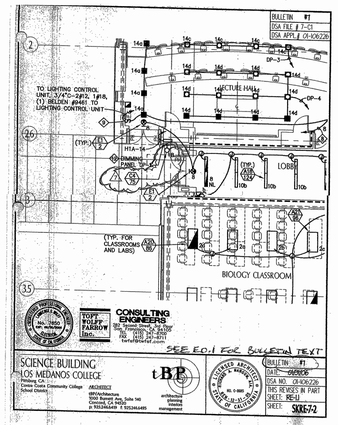

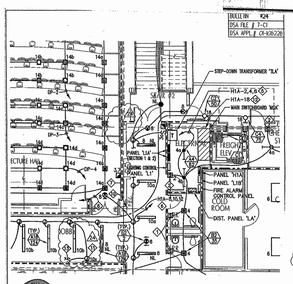


SHEET NOTES

1. OCCUPANCY SENSOR, WALL MOUNTED, WATTSTOPPER #WI-200.
2. OCCUPANCY SENSOR, WALL MOUNTED, DUAL LEVEL, WATTSTOPPER #WI-300.
3. OCCUPANCY SENSOR, CEILING MOUNTED WITH POWER PACK, WATTSTOPPER #CI-200.
4. DIMMER SWITCH, LUTRON #NF-103P-277.
5. ROUTE CIRCUITS 'H1A-2,6' TO PANEL 'H1A' VIA LIGHTING CONTROL PANEL 'L1'.
6. ROUTE CIRCUIT 'H1A-10' TO PANEL 'H1A' VIA LIGHTING CONTROL PANEL 'L1'.
7. (4) ZONE LIGHTING CONTROL UNIT, LUTRON #GRX-4104-T-TH, 4-GANG BACKBOX.
8. ROUTE CIRCUIT 'H1A-14' TO PANEL 'H1A' VIA DIMMING CONTROL PANEL 'DP-1'.
9. REMOTE LIGHTING CONTROL SWITCH, LUTRON #SG-4SN-WH-EGN, 1-GANG BACKBOX.
10. TO DIMMING PANEL 'DP-1'. 3/4"C-2#12, 1#18, (1) BELDEN #9461.
11. 277V JUNCTION BOX FOR DISPLAY CASE LIGHT FIXTURE.
12. ROUTE CIRCUIT H1A-18 TO PANEL 'H1A' VIA. TIME CLOCK IN LIGHTING CONTROL PANEL 'L1'.
13. TOGGLE SWITCH FOR DISPLAY CASE LIGHT FIXTURE, +48" AFF. COORDINATE LOCATION OF SWITCH WITH ARCHITECT.

CONSULTING ENGINEERS
SCIENCE BUILDING
LOS MEDANOS COLLEGE
BULLETIN #24
DSA FILE # 7-C1
DSA APPL # 01-106226
SKR5-F4

1ST FLOOR PLAN PART "A"
SCALE: 1/8"=1'-0"

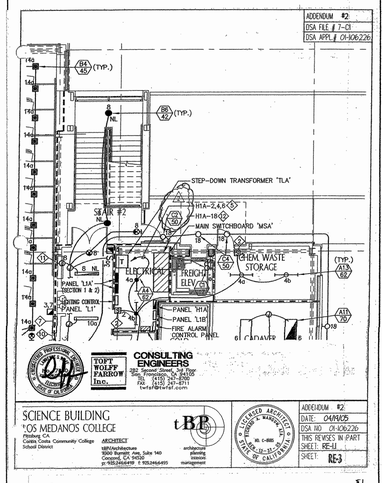

S. J. AMOROSO
Request For Information/Clarification

DSA FILE NO. 7-C1
DSA APPL. No. 01-106226

To: tBP/Architecture, 1000 Burnett Ave, Suite 140, Concord, CA 94520
Attn: Celia Chiang, Tom Beckett
Fax: 925-245-8495
Subj.: Freight Elevator Light Circuit
Reference (dwg, spec): E1.1
Reply Requested By: 2/8/06

Project: LOS MEDANOS COLLEGE SCIENCE BUILDING Contra Costa Community College District
tBP p/n: 20247.00
RFI No: 135
Subcontractor RFI# Scott 1

INFORMATION REQUESTED: Date: 2/8/06

Please note the attached Scott Electric RFI No. 1 regarding the Freight Elevator Pit Light. They are requesting the circuit number for that light. Please advise.

SUGGESTED SOLUTION:

Cost Impact: ☐ Schedule Impact: ☐ days By: Mark Delgado

RESPONSE: DATE:

In response to RFI#135:

The freight elevator pit light shall be connected to 'H1A-4'.

LLai


Attachments: By:

TRANSMITTAL RECORD:

FROM	TO	DATE
S.J. AMOROSO	tBP / ARCHITECTURE	2/8/06
tBP / ARCHITECTURE	ENGINEER/CONSULTANT	
ENGINEER/CONSULTANT	tBP / ARCHITECTURE	
tBP / ARCHITECTURE	S.J. AMOROSO	
S.J. AMOROSO	ORIGINATOR	

RFI # 000
Page 1

KEY PLAN

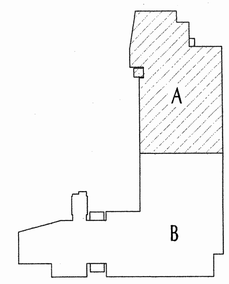

TWF #03058.00

tBP architecture planning interiors management
tBP/Architecture
1000 Burnett Avenue, Suite 140
Concord, CA 94520
p: 925.246.6419 f: 925.246.6495
architect

CONSULTING ENGINEERS
TOFT WOLFF FARROW Inc.
780 Second Street, Suite 300, Oakland, CA 94607
FAX (415) 247-8701
twfarf@twfsf.com
consultant

name
address
city, state, zip
ph fax
agency

SCIENCE BUILDING
LOS MEDANOS COLLEGE

Contra Costa Community College District

owner

tBP project number : 20247.00
file name: 1s-FLR-A
drawn by: LLAI checked by: LSM
date: NOVEMBER 15, 2004

Rev	date	description

drawing title:
1st FLOOR PLAN
PART "A" - LIGHTING

LMC SCIENCE 313-023-112.01-0-00.00
drawing no.:
E-1.1

S. J. AMOROSO
Request For Information/Clarification

DSA FILE NO. 7-C1
DSA APPL. No. 01-106226

To: IBP/Architecture, 1000 Burnett Ave, Suite 140, Concord, CA 94520
Project: LOS MEDANOS COLLEGE SCIENCE BUILDING, Contra Costa Community College District
Attn: Celia Chiang, Tom Beckett
Fax: 925-246-6495
IBP p/n: 20247.00
Subj.: HVAC conflict 7th floor- 40x24 TA duct at F.4 and T.8 fire
RFI No: **75.1**
Reference (dwg, spec): M1.5, E0.5.1
Subcontractor RFI: Monterey 03
Reply Requested By: 12/2/05

INFORMATION REQUESTED: Date: 12/2/05
In the process of starting HVAC for underside of the second floor, we have identified the following conflict between the 7th floor mechanical duct (40x24 TA duct at F.4 and T.8 fire rated) and the 6th floor structural beam above. Therefore, we'll discuss, it will be in conflict with the HVAC120 license at T.8 zone and will also be in conflict with the cable tray. There is also a light in the room and a light in the corridor that are in conflict. Please advise.

We have forwarded the response to RFI no. 75 to our mechanical subcontractor and detailer and they are satisfied with the "sheet" of this RFI response.

However, the electrical portion of the RFI response refers to room 131, but the described conflict is in room 125. Please confirm that response was intended to apply to room 125.

In addition, the response to RFI No. 75 makes reference to needed coordination with the telecom consultant. Please advise us of the results of this coordination effort.

SUGGESTED SOLUTION: None.

Cost Impact: ☐ Schedule Impact: ☐ days By: Mark Dilpolo

RESPONSE: DATE: 1/26/06

SEE ATTACHED RESPONSE & CERTIFY CONSULTANTS FROM ELECTRICAL ENGINEERS, INC. REVISIONS AT ROOM 125.

Attachments: THIS RESPONSE + (5) SKETCHES By: TYPE

RFI # 000
Page 1

Page 1 of 1

Celia Chiang

From: Toft Wolff Farrow Inc. [wtf@pacbell.com]
Sent: Thursday, January 05, 2006 10:05 AM
To: Celia Chiang
Cc: Clare Weiner; John Lambert
Subject: LMC Science Building RFI#75.1
Attachments: RFI 75.1 TWF Response.pdf

Celia,


In response to RFI #75.1:

See attached pages for TWF's recommendations to accommodate duct/pipe locations. Cable tray deletion was coordinated with Norm during a meeting with ISP.

Lisa

Toft Wolff Farrow Inc.
350 Second Street, 4th Floor
San Francisco, CA 94105
415 495 5544 Phone
415 495 5545 Fax
wtf@pacbell.com
www.toftwolff.com

1/26/2006

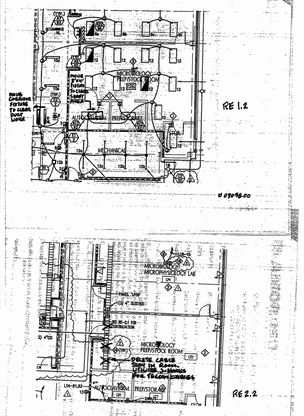

S. J. AMOROSO
Request For Information/Clarification

DSA FILE NO. 7-C1
DSA APPL. No. 01-106226

To: IBP/Architecture, 1000 Burnett Ave, Suite 140, Concord, CA 94520
Project: LOS MEDANOS COLLEGE SCIENCE BUILDING, Contra Costa Community College District
Attn: Celia Chiang, Tom Beckett
Fax: 925-246-6495
IBP p/n: 20247.00
Subj.: Light Fixture at Southeast Corner of Rm. 125
RFI No: **427**
Subcontractor RFI: EWS 60
Reference (dwg, spec.): E-1.2
Reply Requested By: 11/27/06

INFORMATION REQUESTED: Date: 11/20/06
Please note the attached EWS RFI No. 60 regarding the light fixture at the southeast corner of room 125 Microbiology Prep/Stock Room. Please advise.

SUGGESTED SOLUTION:
Cost Impact: ☐ Schedule Impact: ☐ days By: Mark Delgado

RESPONSE: DATE:

See Attached Response

Summary of Comments on To::

Page: 2

Author: tbheard
Subject: Note
Date: 11/20/2006 3:47:28 PM
The light fixture in the southwest corner of this room shall be on the same circuit as the other fixtures in the room (circuit "H1A-12").

Bo Wessel / IBP Architecture
L:\all / T.M.F.
11/20/06

EDWARD W. SCOTT ELECTRIC CO., INC.
435 HARRIET STREET
San Francisco, CA 94103-4914
Phone: (415) 626-0701 Fax: (415) 626-2837

REQUEST FOR INFORMATION

PROJECT: LMC / SCIENCE BLDG. R.F.I.# 60 R.F.I. Date 11
JOB: 2451 ACTUAL REPLY DATE

TO: MARK DELGADO — POTENTIAL COST IMPACT
OF: AMOROSO CONSTR. — ___ COST ___ SCHEDULE
REF.DWG: E-1.2 — ___ OTHER ___ LABOR
LOCATION: RM. 125 — ___ NO IMPACT ___ MATERIA

INFORMATION REQUESTED: THE LIGHTFIXTURE AT THE SOUTH EAST CORNER OF RM 125 (MICROBIOLOGY PREP/STOCK ROOM) IS SHOWN TO BE CONNECTED TO CIRCUIT H1A-12. IS THIS CORRECT?


REPLY REQUIRED BY: 11/27/06 SIGNED:
NOTE: IF NO REPLY IS RECEIVED BY US BY THE ABOVE NOTED DATE, A TIME EXTENSION WILL BE REQUIRED WITH POSSIBLE COST IMPACTS.

RESPONSE:

DATED: SIGNED:

INDUSTRIAL, COMMERCIAL WIRING & DESIGN
STATE CONTRACTOR LICENSE NO. 190426

RFDOC!

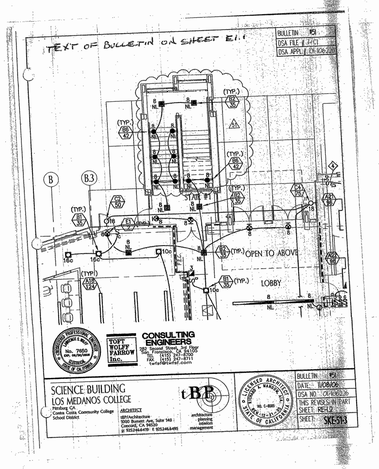

S. J. AMOROSO
Request For Information/Clarification

DSA FILE NO. 7-C1
DSA APPL. No. 01-106226

To: IBP/Architecture, 1000 Burnett Ave, Suite 140, Concord, CA 94520
Project: LOS MEDANOS COLLEGE SCIENCE BUILDING, Contra Costa Community College District
Attn: Celia Chiang, Tom Beckett
Fax: 925-246-6495
IBP p/n: 20247.00
Subj.: Eyewash in Room 129 Interfering with Outlets
RFI No: **398**
Reference (dwg, spec.): E-1.2, LE1-1B
Subcontractor RFI: EWS 52
Reply Requested By: 10/27/06

INFORMATION REQUESTED: Date: 10/20/06
Please note the attached EWS RFI No. 52 regarding the outlets in Room 129 close to the Eyewash Station which is interfering with them being installed in the correct location. Please advise.

SUGGESTED SOLUTION:
Cost Impact: ☐ Schedule Impact: ☐ days By: Mark Delgado

RESPONSE: DATE:

Room 129 (light switches):

TWF has no objection to stacking the toggle switches in two groups as long as the top group of switches is no higher than 48" AFF. Also, TWF has no objection to relocating the nurse control light switch to the contractor's proposed location.

Larry Lai/TWF - 10/23/06

The power and data outlets should be kept together - move them BOTH 14" East. (It is OK to move them both East next to each other, within 5" of each other will work)

NOT - in 2 different directions as notes on the drawing indicate (this would have them 28" apart.)

Please confirm that this can be done.

Kent Knight/Dowtell - 10/23/06

RFI # 000
Page 1

EDWARD W. SCOTT ELECTRIC CO., INC.
435 HARRIET STREET
San Francisco, CA 94103-4914
Phone: (415) 626-0701 Fax: (415) 626-2837

REQUEST FOR INFORMATION

PROJECT: LMC / SCIENCE BLDG. R.F.I.# 52 R.F.I. Date 10/20/06
JOB: 2451 ACTUAL REPLY DATE

TO: MARK DELGADO — POTENTIAL COST IMPACT
OF: AMOROSO CONST. — ___ COST ___ SCHEDULE
REF.DWG: E-1.2 E1E1-1B — ___ OTHER ___ LABOR
LOCATION: BIO CLASS RM 130 — ___ NO IMPACT ___ MATERIAL

INFORMATION REQUESTED: DUE TO THE EYE WASH FRAMING IN RM 129 THE OUTLETS SHOWN ON THE ATTACHED SKETCH WILL NEED TO BE SHIFTED AS SHOWN. THE DATA OUTLET WILL ALSO BE LOWERED TO 18" AFF.

THE EYE WASH FRAMING IS ALSO IMPACTING THE 4 TO 4 LOW VOLTAGE SWITCHES SHOWN ON E-1.2. AND ATTACHED SKETCH. IF IT IS ACCEPTABLE TO STACK THE 4 LTG SW. IN GROUPS OF TWO IN THE LOCATION SHOWN AND RELOCATE THE LOW VOLTAGE BOX NEXT TO THE DOOR AS SHOWN ON THE ATTACHED SKETCH.


REPLY REQUIRED BY: ASAP SIGNED:
NOTE: IF NO REPLY IS RECEIVED BY US BY THE ABOVE NOTED DATE, A TIME EXTENSION WILL BE REQUIRED WITH POSSIBLE COST IMPACTS.

RESPONSE:

DATED: SIGNED:

INDUSTRIAL, COMMERCIAL WIRING & DESIGN
STATE CONTRACTOR LICENSE NO. 190426

RFDOC39

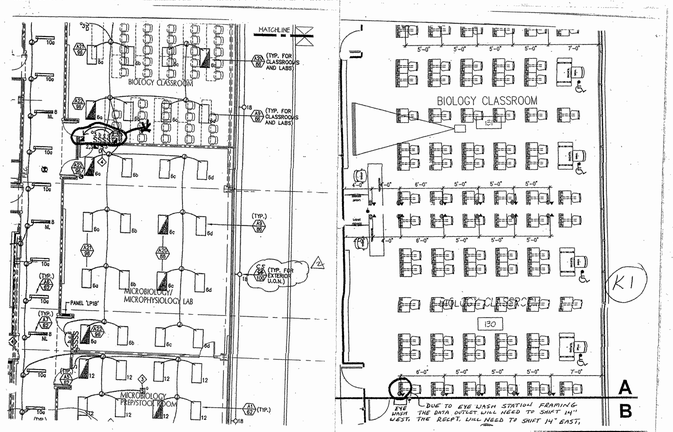

S. J. AMOROSO
Request For Information/Clarification

DSA FILE NO.7-C1
DSA APPL. No. 01-106226

To: IBP/Architecture, 1000 Burnett Ave, Suite 140, Concord, CA 94520
Project: LOS MEDANOS COLLEGE SCIENCE BUILDING, Contra Costa Community College District
Attn: Celia Chiang, Tom Beckett
Fax: 925-246-6495
IBP p/n: 20247.00
Subj.: Light Fixture B2 at Stair No. 1 Lobby
RFI No: **442**
Reference (dwg, spec.): B1.2
Subcontractor RFI: EWS 64
Reply Requested By: 12/20/06

INFORMATION REQUESTED: Date: 12/13/06
Please note the attached Edward Scott RFI No. 64 regarding the Type B2 Light Fixtures shown in Stair No. 1 Lobby which cannot be installed. Please advise.

SUGGESTED SOLUTION:
Cost Impact: ☐ Schedule Impact: ☐ days By: Mark Delgado

RESPONSE: DATE:

1. Type B2 fixtures this location at first floor lobby to be surface mount Peachtree lighting fixture type PCFUS-122.26 in lieu of specified recess type. See attached cut sheets.

2. Please review fixture/sprinkler conflict location with architect in field at 1/9/07 site meeting.

Jim Weaver / IBP Architecture
Larry Lai / T.M.F.
1/5/07

RFI # 000
Page 1

EDWARD W. SCOTT ELECTRIC CO., INC.
435 HARRIET STREET
San Francisco, CA 94103-4914
Phone: (415) 626-0701 Fax: (415) 626-2837

REQUEST FOR INFORMATION

PROJECT: LMC / SCIENCE BLDG. R.F.I.# 64 R.F.I. Date 12/4/06
JOB: 2451 ACTUAL REPLY DATE

TO: MARK DELGADO — POTENTIAL COST IMPACT
OF: AMOROSO CONST. — V COST V SCHEDULE
REF.DWG: E-1.2 — ___ OTHER V LABOR
LOCATION: STAIR#1 — ___ NO IMPACT V MATERIAL

INFORMATION REQUESTED: WE ARE UNABLE TO INSTALL THE 2 TYPE "B2" AT EYE LEVEL AS SHOWN AT THE STAIR #1 ICE FLL LOBBY. THE WELDING FRAMING DOES NOT ALLOW AMPLE CLEARANCE FOR THE 5¾" BOX INSTALLED. PER THE BULLETIN #3 WE CAN CHANGE THE 2 SURFACE MOUNT B2'S AT THE ICE FLL TO RECESS SIMILAR TO TYPE B2.1 AT P1, WHICH HAS CONFLICT WITH A SPRINKLER PIPE. THE PIPE WILL NEED TO BE RELOCATED.

REPLY REQUIRED BY: ASAP SIGNED:
NOTE: IF NO REPLY IS RECEIVED BY US BY THE ABOVE NOTED DATE, A TIME EXTENSION WILL BE REQUIRED WITH POSSIBLE COST IMPACTS.

RESPONSE:

DATED: SIGNED:

INDUSTRIAL, COMMERCIAL WIRING & DESIGN
STATE CONTRACTOR LICENSE NO. 190426

RFDOC19

S. J. AMOROSO
Request For Information/Clarification

DSA FILE NO. 7-C1
DSA APPL. No. 01-106226

To: IBP/Architecture, 1000 Burnett Ave, Suite 140, Concord, CA 94520
Project: LOS MEDANOS COLLEGE SCIENCE BUILDING, Contra Costa Community College District
Attn: Celia Chiang, Tom Beckett
Fax: 925-246-6495
IBP p/n: 20247.00
Subj.: Lighting Fixtures B6
RFI No: **372**
Reference (dwg, spec.): E-1.2, E-1.4, A8-2&3
Subcontractor RFI: EWS 40
Reply Requested By: 10/13/06

INFORMATION REQUESTED: Date: 10/6/06
Please note the attached EWS RFI No. 40 regarding location for the 2 "B6" Light Fixtures at the window alcove on the north wall of stair No. 1 on the first floor. Please advise.

SUGGESTED SOLUTION:
Cost Impact: ☐ Schedule Impact: ☐ days By: Mark Delgado

RESPONSE: DATE:

TWF recommends that the "A25" fixtures remain as 4' fixtures.

Larry Lai/TWF - 10/9/06

The (2) "B6" noted above are deleted. Contractor to provide credit to the fixtures and the labor to the installation to these fixtures.

Vanessa Ling/SJP - 10/16/06

Amended 10/26/06
Centerline of fixtures A25 are to be located at 16'-0" and 34'-0" to first floor finish floor, top and bottom of fixtures A25 are align with the aluminum drywall reveals.

Vanessa Ling/SJP - 10/26/06

EDWARD W. SCOTT ELECTRIC CO., INC.
435 HARRIET STREET
San Francisco, CA 94103-4914
Phone: (415) 626-0701 Fax: (415) 626-2837

REQUEST FOR INFORMATION

PROJECT: LMC / SCIENCE BLDG. R.F.I.# 40 R.F.I. Date 5/8/06
JOB: 2451 ACTUAL REPLY DATE

TO: MARK DELGADO — POTENTIAL COST IMPACT
OF: AMOROSO CONST. — ___ COST V SCHEDULE
REF.DWG: E-1.2 E-1.4 A3-1 & 3 — ___ OTHER ___ LABOR
LOCATION: STAIR #1 — ___ NO IMPACT ___ MATERIAL

INFORMATION REQUESTED: THE LOCATION FOR THE 2 "B6" LTG FIXTURES AT THE WINDOW ALCOVE ON THE NORTH WALL OF STAIR #1 ON THE ICE FL. IS NOT SHOWN ON DWGS. A8-2 & 3. PLEASE CLARIFY.

THE TYPE "A25" LTG FIXTURES ARE LISTED AS "4'x4' PANL FIXTURE" IN THE FIXTURE SCHED. DWGS A3.1 & 3. HOWEVER THEY ARE SHOWN AS "4'x8'" FIXTURES. ON E-1.4, WE ARE NOTED THAT THESE "PANLITE FIXTURES" ARE TO BE ABUSED AT SINGLE "4' FIXTURES. SINCE THE FIXTURE SCHED. SHOWN THESE AS BEING "4' LONG. PLEASE ADVISE.

REPLY REQUIRED BY: 10/13/06 SIGNED:
NOTE: IF NO REPLY IS RECEIVED BY US BY THE ABOVE NOTED DATE, A TIME EXTENSION WILL BE REQUIRED WITH POSSIBLE COST IMPACTS.

RESPONSE:

DATED: SIGNED:

INDUSTRIAL, COMMERCIAL WIRING & DESIGN
STATE CONTRACTOR LICENSE NO. 190426

RFDOC39

S. J. AMOROSO
Request For Information/Clarification

DSA FILE NO. 7-C1
DSA APPL. No. 01-106226

To: IBP/Architecture, 1000 Burnett Ave, Suite 140, Concord, CA 94520
Project: LOS MEDANOS COLLEGE SCIENCE BUILDING, Contra Costa Community College District
Attn: Celia Chiang, Tom Beckett
Fax: 925-246-6495
IBP p/n: 20247.00
Subj.: Lighting Switches in North Wall of Rm. 129
RFI No: **368**
Reference (dwg, spec.): E-1.2, LE1-1a
Subcontractor RFI: EWS 38
Reply Requested By: 10/11/06

INFORMATION REQUESTED: Date: 10/4/06
Please note the attached EW Scott RFI 38 regarding the High and Low Voltage Lighting Switches on the north wall of Room 129. Please advise.

SUGGESTED SOLUTION:
Cost Impact: ☐ Schedule Impact: ☐ days By: Mark Delgado

RESPONSE: DATE:

For relocation of 3-way dimmer switch, lighting zone control switch and audible/visual device please see attached pages.

Regarding relocation of telephone outlet, see Jim Cooley's response as follows.

Larry Lai/TWF - 10/4/06

Regarding what this RFI calls a data outlet at the North entrance (really a telephone jack). I recommend moving to a location adjacent to the South entrance, if feasible, as it does not seem to want to fit in any other location near the North entrance.

Jim Cooley/Michael Wall Engineering, Inc. - 10/6/06

cc: EWS

RFI # 000
Page 1

EDWARD W. SCOTT ELECTRIC CO., INC.
435 HARRIET STREET
San Francisco, CA 94103-4914
Phone: (415) 626-0701 Fax: (415) 626-2837

REQUEST FOR INFORMATION

PROJECT: LMC / SCIENCE BLDG. R.F.I.# 38 R.F.I. Date 10/2/06
JOB: 2451 ACTUAL REPLY DATE

TO: MARK DELGADO — POTENTIAL COST IMPACT
OF: AMOROSO CONST. — ___ COST V SCHEDULE
REF.DWG: E-1.2, LE1-1a — ___ OTHER ___ LABOR
LOCATION: MICRO LABS RM 129 — ___ NO IMPACT ___ MATERIAL

INFORMATION REQUESTED: THE HIGH AND LOW VOLTAGE LTG. SWITCHES ON THE NORTH WALL OF RM. 129 ARE BACK TO BACK WITH THE SWITCHES IN RM. 130. THEY ARE ALSO LOCATED NEXT TO AN EMER. SHOWER STATION AND CANNOT BE SHIFTED EAST, NOR ARE THEY WATER PROOF.

BUT TO THE DOOR FRAMING THERE IS NO ROOM FOR THE DATA OUTLET OR HIGH STAGE AT THE NORTH ENTRANCE TO THE ROOM). WE ARE REQUESTING ALTERNATE MOUNTING LOCATIONS.

PLEASE ADVISE.


REPLY REQUIRED BY: ASAP SIGNED:
NOTE: IF NO REPLY IS RECEIVED BY US BY THE ABOVE NOTED DATE, A TIME EXTENSION WILL BE REQUIRED WITH POSSIBLE COST IMPACTS.


RESPONSE:

DATED: SIGNED:

INDUSTRIAL, COMMERCIAL WIRING & DESIGN
STATE CONTRACTOR LICENSE NO. 190426

RFDOC39

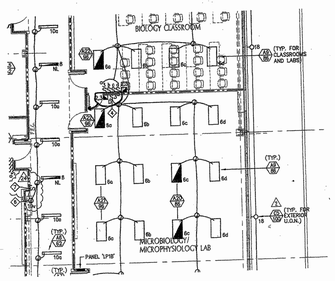

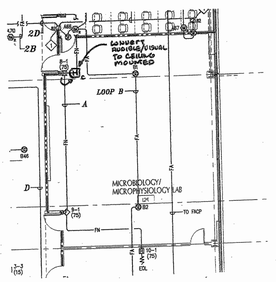

Los Medanos College
4CD Proj.# : L-565-B-23-SC
Science Building

SHEET NOTES

1. OCCUPANCY SENSOR, WALL MOUNTED, WATTSTOPPER #WI-200.
2. OCCUPANCY SENSOR, WALL MOUNTED, DUAL LEVEL, WATTSTOPPER #WI-300.
3. OCCUPANCY SENSOR, CEILING MOUNTED WITH POWER PACK, WATTSTOPPER #CI-200.
4. DIMMER SWITCH, LUTRON #NF-103P-277.
5. ROUTE CIRCUIT H1A-16 TO PANEL 'H1A' VIA LIGHTING CONTROL PANEL 'L1'.
6. 277V JUNCTION BOX FOR DISPLAY CASE LIGHT FIXTURE.

SHEET NOTES

1. OCCUPANCY SENSOR, WALL MOUNTED, WATTSTOPPER #WI-200.
2. OCCUPANCY SENSOR, WALL MOUNTED, DUAL LEVEL, WATTSTOPPER #WI-300.
3. OCCUPANCY SENSOR, CEILING MOUNTED WITH POWER PACK, WATTSTOPPER #CI-200.
4. DIMMER SWITCH, LUTRON #NF-103P-277.
5. ROUTE CIRCUIT H1A-16 TO PANEL 'H1A' VIA LIGHTING CONTROL PANEL 'L1'.
6. 277V JUNCTION BOX FOR DISPLAY CASE LIGHT FIXTURE.
7. TOGGLE SWITCH FOR DISPLAY CASE LIGHT FIXTURE, +48" AFF. COORDINATE LOCATION OF SWITCH WITH ARCHITECT.

S. J. AMOROSO
Request For Information/Clarification

DSA FILE NO. 7-C1
DSA APPL. No. 01-106226

To: tBP/Architecture, 1000 Burnett Ave, Suite 140, Concord, CA 94520
Attn: Celia Oblang, Tom Beckett
Fax: 925-246-6495

Project: LOS MEDANOS COLLEGE SCIENCE BUILDING, Contra Costa Community College District
tBP p/n: 20247.00

Subj.: Circuit for 'B1' Light Fixture in Corridor 107
RFI No: 525
Reference (dwg, spec.): E1.2
Subcontractor RFI: EWS 88
Reply Requested By: 6/14/07

INFORMATION REQUESTED: Date: 5/7/07

Please note the attached EWS RFI No. 88 regarding the type 'B1' Light fixture located in Corridor 107. EWS believes this fixture should be on Circuit 10 not Circuit 12. Please advise.

SUGGESTED SOLUTION:
Cost/Impact: ☐ Schedule Impact: ☐ days By: Justin Warren

RESPONSE: DATE:

Light fixture 'B1' should be on circuit 'H1A-10', not 'H1A-12'.

Jim Weaver / ISP Architecture
L. Lai / TWF
5/9/07

RFI # 000
Page 1

EDWARD W. SCOTT ELECTRIC CO., INC.
435 HARRIET STREET
San Francisco, CA 94103-4514
Phone: (415) 626-0701 Fax: (415) 626-2837

REQUEST FOR INFORMATION

PROJECT: LMC SCIENCE BLDG. RFI# 88 R.F.I. Date 5/4/07
Job: 4254 ACTUAL REPLY DATE:

TO: MARC DELGADO
CC: ARNOLD SO, CHRIST.
EED DWG: E-1.2
LOCATION: CORRIDOR 107

POTENTIAL COST IMPACT
___ COST ___ SCHEDULE
___ OTHER ___ LABOR
___ NO IMPACT ___ MATERIAL

INFORMATION REQUESTED: WE BELIEVE THAT THE TYPE 'B1' FIXTURE LOCATED IN CORRIDOR 107 BETWEEN THE RESOURCE RM. AND THE MECH. RM. ABOVE THE EXIT TO MRP CE1.2 AS SHOWN. THE WALL SWITCHES CAN NOT OPERATE AS SHOWN.

REPLY REQUIRED BY: ASAP SIGNED:
NOTE: IF NO REPLY IS RECEIVED BY US BY THE ABOVE NOTED DATE, A TIME EXTENSION WILL BE REQUIRED WITH POSSIBLE COST IMPACTS.

RESPONSE:

DATED: SIGNED:

INDUSTRIAL, COMMERCIAL WIRING & DESIGN
STATE CONTRACTOR LICENSE NO. 196548 RFDOG#

1ST FLOOR PLAN PART "B" | 1
SCALE: 1/8"=1'-0"

TWF #03058.00

tBP/Architecture
1000 Burnett Avenue, Suite 140
Concord, CA 94520
p: 925.246.6419 f: 925.246.6495

CONSULTING ENGINEERS
282 Second Street, 3rd Floor
San Francisco, CA 94105
TEL: (415) 247-8700
FAX: (415) 247-8711
twf@twfsf.com

TOFT WOLFF FARROW Inc.

architect
consultant

DEMOLITION STAMP
ONLY OF THE STATE ARCHITECT
OFFICE OF REGULATION SERVICES
APP. - 01-106226
DSA

name
address
city, state, zip
ph: fx:

agency

SCIENCE BUILDING
LOS MEDANOS COLLEGE

Contra Costa Community College District

owner

tBP project number : 20247.00
file name: 1s-FLR-A
drawn by: LLAI checked by: LSH
date: NOVEMBER 15, 2004


Rev.	date:	description:

drawing title:
1st FLOOR PLAN
PART "B" - LIGHTING

LMC SCIENCE 313-023-112.01-0-00.00
drawing no.:
E-1.2

TEXT OF BULLETIN on SHEET E1.1

BULLETIN NO. #5
DSA FILE # 7-C1

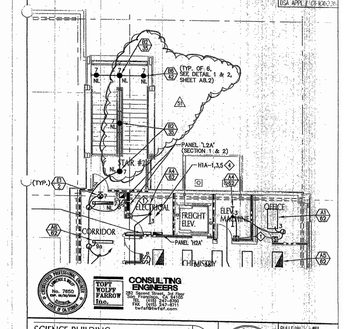









Los Medanos College
4CD Proj.# : L-565-B-23-SC
Science Building

SHEET NOTES

1. OCCUPANCY SENSOR, WALL MOUNTED, WATTSTOPPER #WI-200.
2. OCCUPANCY SENSOR, CEILING MOUNTED WITH POWER PACK, WATTSTOPPER #WI-300.
3. DIMMER SWITCH, LUTRON #NF-103P-277.
4. ROUTE CIRCUITS 'H1A-1,5' TO PANEL 'H1A' VIA LIGHTING CONTROL PANEL 'L1'.
5. ROUTE CIRCUIT 'H1A-9' TO PANEL 'H1A' VIA LIGHTING CONTROL PANEL 'L1'.
6. 277V JUNCTION BOX FOR DISPLAY CASE LIGHT FIXTURE.

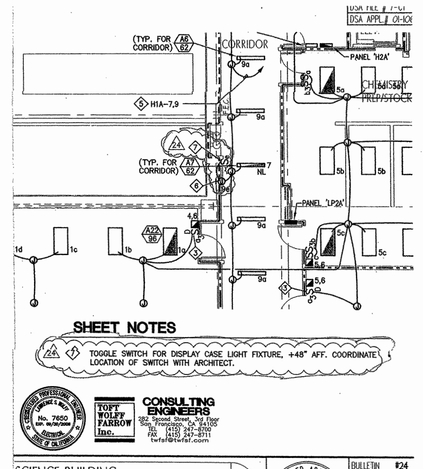


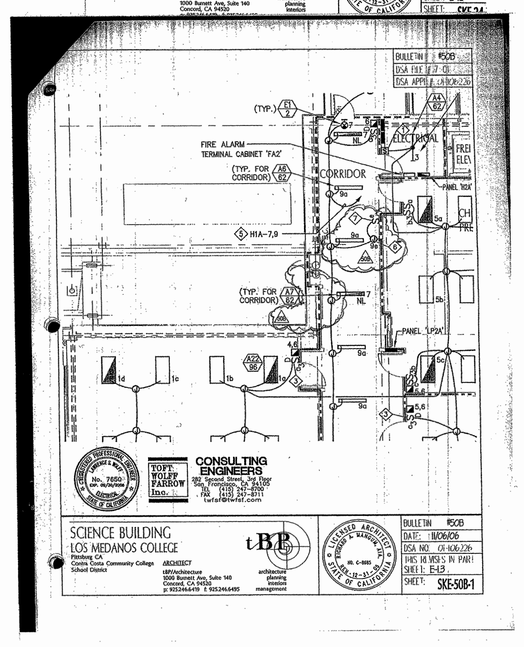

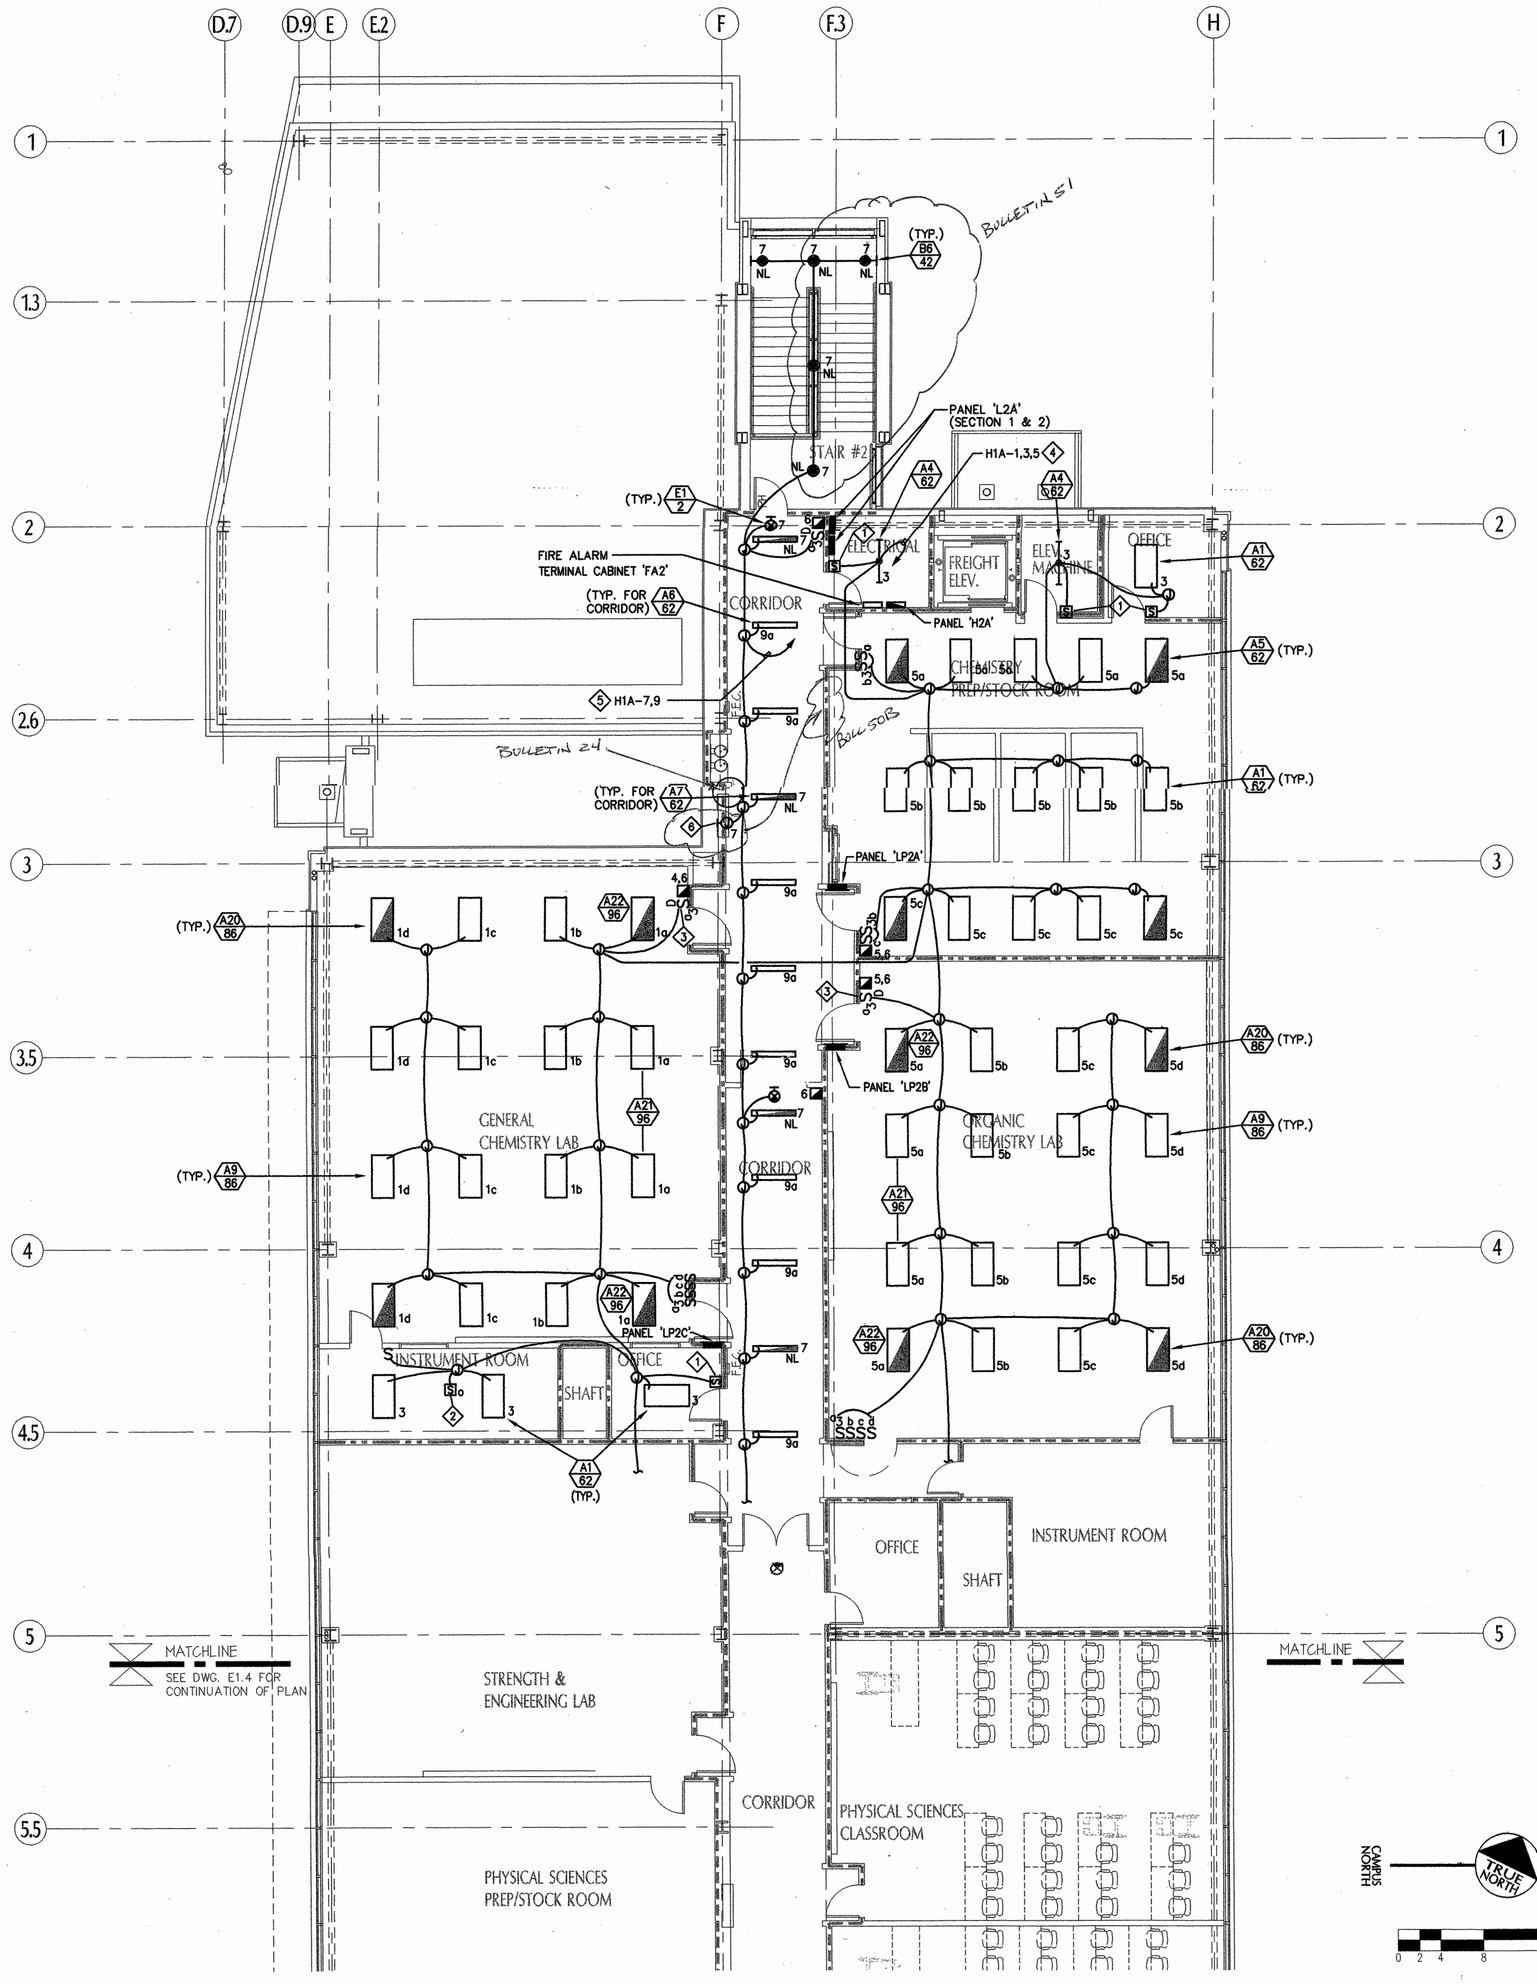

2ND FLOOR PLAN PART "A" SCALE: 1/8"=1'-0" | 1

KEY PLAN

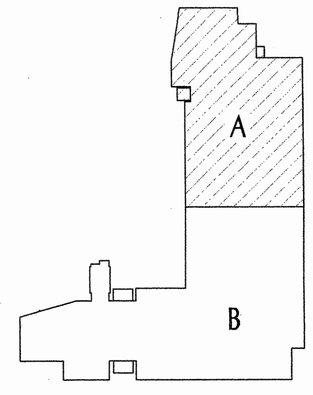

TWF #03058.00

tBP
architecture
planning
interiors
management
tBP/architecture
1000 Burnett Avenue, Suite 140
Concord, CA 94520
p: 925.246.6419 f: 925.246.6495
architect

CONSULTING ENGINEERS
2801 Mariner Square Loop
Suite 100 Alameda, CA 94501
(510) 747-8700
FAX (510) 747-8701
twfa@twfar.com
TOFT WOLFF FARROW Inc.
consultant

name
address
city, state, zip
ph: fx:
agency

SCIENCE BUILDING
LOS MEDANOS COLLEGE

Contra Costa Community College District

owner

tBP project number : 20241.00

file name: 1s-FLR-A

drawn by: LLAI checked by: LSN

date: NOVEMBER 15, 2004

Rev:	date:	description:

drawing title:
2nd FLOOR PLAN
PART "A" - LIGHTING

LMC SCIENCE 313-023-112.01-0-00.00
drawing no:
E-1.3

S. J. AMOROSO
Request For Information/Clarification

DSA FILE NO. 7-C1
DSA APPL. No. 01-106226

To: tBP/Architecture
1000 Burnett Ave, Suite 140
Concord, CA 94520

Attn: Celia Chiang, Tom Beckett
Fax: 925-246-6495

Subj.: Type B3 Lighting Fixture on Stairs No.: 1 Overhang
Reference (dwg, spec.): E-1.4

Project: LOS MEDANOS COLLEGE
SCIENCE BUILDING
Contra Costa Community College District

tBP j/n: 20247.00

RFI No: **424**
Subcontractor RFI: EWS 58

Reply Requested By: 11/15/06

INFORMATION REQUESTED: Date: 11/8/06

Please note the attached EWS RFI No. 58 regarding the Type B3 Lighting Fixture shown on the Overhang of Stair No. 1 at the roof. Is 6-1/2" Deep acc will not fit. A weather proof surface fix ture be an option. Please advise.

SUGGESTED SOLUTION:
Cost Impact: ☐ Schedule Impact: ☐ days By: Mark Delgado

RESPONSE: DATE:

Please see bulletin 51 for revised fixture this location.

Jim Weaver
tBP Archtiecture

11/10/06

RFI # 000
Page 1

EDWARD W. SCOTT ELECTRIC CO., INC.
435 HARRIET STREET
San Francisco, CA. 94103-4914
Phone: (415) 626-9701 Fax: (415) 626-2837

REQUEST FOR INFORMATION

LMC
PROJECT: SCIENCE BLDG. R.F.I. 58 R.F.I. Date: 11/6/06
ACTUAL REPLY DATE:
JOB: 8021

TO: MARC DELGADO
DIV: ARCO CO. CONST.
DEPT:
LOCATION: STAIR #1 ROOF

POTENTIAL COST IMPACT
COST — SCHEDULE
OTHER — LABOR
NO IMPACT — MATERIAL

INFORMATION REQUESTED: THE TYPE "B3" LTG FIX. SHOWN ON THE OVERHANG OF STAIR #1 AT THE ROOF IS 6.5" DEEP AND WILL NOT FIT. A WEATHER PROOF SURFACE FIX MAY BE AN OPTION. PLEASE ADVISE.

REPLY REQUIRED BY: ASAP SIGNED:
NOTE: IF NO REPLY IS RECEIVED BY US BY THE ABOVE NOTED DATE, A TIME EXTENSION WILL BE REQUIRED WITH POSSIBLE COST IMPACTS.

RESPONSE:


DATED: SIGNED:

RFIDOC39

INDUSTRIAL, COMMERCIAL WIRING & DESIGN
STATE CONTRACTOR'S LICENSE NO. 195426


TEXT OF BULLETIN ON SHEET E1.1

BULLETIN #51
DSA FILE # 7-C1
DSA APPL # 01-106226

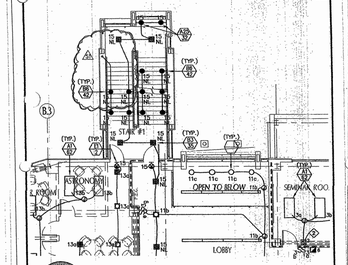

TOFT WOLFF FARROW CONSULTING ENGINEERS
SCIENCE BUILDING
LOS MEDANOS COLLEGE
tBP
BULLETIN #51
DATE: 11/30/06
DSA NO.: 01-106226
THIS SHEET IS IN PART
SHEET: E-0.41
SHEET: E-0.51

BULLETIN #51
DSA FILE # 7-C1
DSA APPL # 01-106226

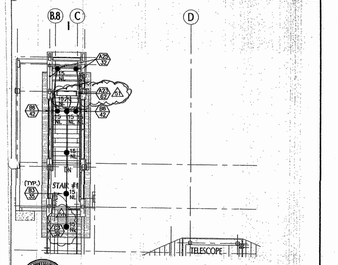

TOFT WOLFF FARROW CONSULTING ENGINEERS
SCIENCE BUILDING
LOS MEDANOS COLLEGE
tBP
BULLETIN #51
DATE: 11/30/06
DSA NO.: 01-106226
THIS SHEET IS IN PART
SHEET: E-0.41
SHEET: E-0.51

S. J. AMOROSO
Request For Information/Clarification

DSA FILE NO. 7-C1
DSA APPL. No. 01-106226

To: tBP/Architecture
1000 Burnett Ave, Suite 140
Concord, CA 94520

Attn: Celia Chiang, Tom Beckett
Fax: 925-246-6495

Subj.: Light Switches In Room 201
Reference (dwg, spec.): E-1.4

Project: LOS MEDANOS COLLEGE
SCIENCE BUILDING
Contra Costa Community College District

tBP j/n: 20247.00

RFI No: **504**
Subcontractor RFI:

Reply Requested By: 3/21/07

INFORMATION REQUESTED: Date: 3/14/07

Please note the attached EWS RFI No. 79 confirming that the two light switches in room 201 mounted on the west wall are to be re-designated. Please advise.

SUGGESTED SOLUTION:
Cost Impact: ☐ Schedule Impact: ☐ days By: Justin Warren

RESPONSE: DATE:

Toft Wolff Farrow confirms that the light switches on the West wall of Lobby 201 should be designated as follows:
Switch designated as 'e' should be 'b';
Switch designated as 'g' should be 'c' and just a single pole switch(no 3-way switch).

Jim Weaver / tBP Architecture
Larry Lai / TWF

3/21/07

RFI # 000
Page 1

SHEET NOTES

1. OCCUPANCY SENSOR, WALL MOUNTED, WATTSTOPPER #WI-200.
2. OCCUPANCY SENSOR, WALL MOUNTED, DUAL LEVEL, WATTSTOPPER #WI-300.
3. OCCUPANCY SENSOR, CEILING MOUNTED WITH POWER PACK, WATTSTOPPER #CI-200.
4. DIMMER SWITCH, LUTRON #NF-103P-277.
5. DIMMER SWITCH, LUTRON #NF-10-277.
6. ROUTE CIRCUITS H1A-11,13 TO PANEL 'H1A' VIA LIGHTING CONTROL PANEL 'L1'.
7. 277V JUNCTION BOX FOR DISPLAY CASE LIGHT FIXTURE.

DSA FIL # 7-C1
DSA APPL # 04-K2

SHEET NOTES

1. OCCUPANCY SENSOR, WALL MOUNTED, WATTSTOPPER #WI-200.
2. OCCUPANCY SENSOR, WALL MOUNTED, DUAL LEVEL, WATTSTOPPER #WI-300.
3. OCCUPANCY SENSOR, CEILING MOUNTED WITH POWER PACK, WATTSTOPPER #CI-200.
4. DIMMER SWITCH, LUTRON #NF-103P-277.
5. DIMMER SWITCH, LUTRON #NF-10-277.
6. ROUTE CIRCUITS H1A-11,13 TO PANEL 'H1A' VIA LIGHTING CONTROL PANEL 'L1'.
7. 277V JUNCTION BOX FOR DISPLAY CASE LIGHT FIXTURE.
8. TOGGLE SWITCH FOR DISPLAY CASE LIGHT FIXTURE, +48" AFF. COORDINATE LOCATION OF SWITCH WITH ARCHITECT.

OBSERVATION DECK ABOVE

SEE E2.5 FOR CONTINUATION

MATCHLINE
SEE DWG. E1.3 FOR CONTINUATION OF PLAN

MATCHLINE

FEC RELOCATED PER RFI 397, SHEET A1-4

Bulletin No.24

t.B.P Architecture Planning Interiors Management

Date: April 13, 2006

To: S.J. Amoroso Construction
390 Bridge Parkway
Redwood shores CA 94065

Project: LOS MEDANOS COLLEGE SCIENCE BUILDING
Contra Costa Community College District
DSA No. 01-106226; File # 7-C1
tBP P/N 20247.00

Description: REFERENCE: Bulletin #8, A1-1 to A1-4, 10/4.04, RE-1.1 to RE-1.2, E-1.3 to E1.4;

Relocated (1) J-box for (1) relocated display case per Bulletin #8. New location of J-box for display case is at south wall of Lobby #140. See SKE-24.1 and Bulletin #8.

Provide (1) switch to each display case. Switches are to be located on wall adjacent to the display cases, see SKE-24.1 to SKE 24.10. See SKA-08.1/Bulletin #8 and sheet A1-1 to A1-4 for total of (8) locations of display cases.

Provide submittal for the display cases.

Issued By: Architect
Requested By: Architect
Reason: Coordination switches for integral lighting in display cases
Enclosures: SKE-24.1 to SKE-24.10

Distribution:

Copies:	Name:	Organization:
1 copy	Mark Delgado	S. J. Amoroso
1 copy	Cam Perrotta	CCCCDistrict
1 copy	Bob Hacke	Inspector of Record
1 copy	Tom Beckett	tBP/Architecture
1 copy	File 20247.00/7.4	tBP/Architecture
1 copy	Larry Lid	TWF


Action:
- ☐ For Information/Clarification only
- ☒ Provide Price/Credit Proposal. (Refer to this Bulletin No. when responding)
- ☐ Requires DSA review and approval.
- ☐ Proceed as authorized by District

tBP/Architecture 1000 Burnett Ave, Suite 140 Concord, CA. 94520 ph: 925.246.6419 fax: 925.246.6495

CAMPUS NORTH / TRUE NORTH

0 2 4 8 16

KEY PLAN

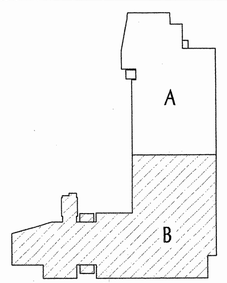

2ND FLOOR PLAN PART "B" — SCALE: 1/8"=1'-0" — 1

TWF #03058.00

tBP architecture planning interiors management
tBP/Architecture
1000 Burnett Avenue, Suite 140
Concord, CA 94520
p: 925.246.6419 f: 925.246.6495
architect

CONSULTING ENGINEERS
282 Second Street, 3rd Floor
San Francisco, CA 94105
TEL (415) 247-8700
FAX (415) 247-8701
twis@tolvsf.com
TOFFT WOLFF FARROW Inc.
consultant

DSA IDENTIFICATION STAMP
DIV. OF THE STATE ARCHITECT
OFFICE OF REGULATION SERVICES
APPL. # 04-K2626
DATE 1-14-05
name
address
city, state, zip
ph:
fax:
agency

SCIENCE BUILDING
LOS MEDANOS COLLEGE
Contra Costa Community College District

owner

tBP project number : 20241.00
file name: 2n-FLR-A
drawn by: LLAI checked by: LSH
date: NOVEMBER 15, 2004

Rev:	date:	description:

drawing title:
2nd FLOOR PLAN
PART "B" - LIGHTING

LMC SCIENCE 313-023-112.01-0-00.00
drawing no:
E-1.4

S. J. AMOROSO
Request For Information/Clarification

DSA FILE NO. 7-C1
DSA APPL. No. 01-106226

To: IBF/Architecture
1000 Burnett Ave, Suite 140
Concord, CA 94520

Attn: Celia Chiang, Tom Beckett
Fax: 925-246-6485

Subj.: VAV Transformer Panels

Reference (dwg, spec.):

Project: LOS MEDANOS COLLEGE SCIENCE BUILDING
Contra Costa Community College District

IBF pln: 20247.00

RFI No: 452
Subcontractor RFI: CommAir 5

Reply Requested By: 12/26/06

Date: 12/18/06

INFORMATION REQUESTED:

Please note the attached CommAir (Monterey Sub) RFI No. 5 regarding additional panels needed for the VAV Transformers. CommAir suggests that these panels be placed on the first and second floor Electrical Rooms. CommAir will be providing the two new panels and Scott Electric has approved the locations of these panels. Please confirm that the location for the new VAV Transformer Panels is acceptable.

SUGGESTED SOLUTION:

Cost Impact: $0 Schedule Impact: ☐ days By: Mark Delgado

RESPONSE: DATE: 12/26/06

IBF has no objection to the proposed location of VAV transformer panels. Provide door stops to prevent doors from swinging into panels.

Larry Lai

RFI # 000
Page 1

CommAir

1321 Story Circle # 10
Concord, California 94518
(510) 772-9340 / fax (925) 356-5209

REQUEST FOR I/NFORMATION

DATE 12/11/2006 RFI# 0005
JOB NO 6871/00018 BY Christ Olivera
PROJECT LMC Solenoid

TO Monterey Mechanical
3065 Vilbour Ave
Antioch, CA 94509
925-757-4040 Fax 757-0574

DIST.

ATTN Dan Riedmiller

Title or Section of Work Lighting

Drawing Location Specification Location

Cost Impact ☐ Yes ☐ No Estimate
Time Impact ☐ Yes ☐ No Estimate

Description of Problem / Attach sketches as required


1. VAV Transformer panels: The length of the unit for the transformer panels are still too long and will require two cuts of a power drop for the VAV cubicles on the fourth and of the building on the first and second floors. Additional panels will need to be installed and a 120V circuit made available for these panels. See Below.

Response Requested By Christopher J. Olvera – (510) 772-9340

Proposed Solution (if applicable)

1. Install two additional panels on the first and second floor (North Side) Electrical Rooms. We understand these rooms are very tight for wall space, so the plan is to install a 24x24 by 4 inch deep panel behind the swing of the doors in these rooms. There is plenty of wall space there and access to these panels will not be required once the system is up and running. We have discussed this issue with the Engineer and he did not have an issue with the second transformer panels in those rooms.

Signed Christopher J. Olvera
Organization CommAir-Carrier
Date 12/11/2006
Distribution ☐ Architect ☐ Super ☐ Mech. Eng ☐ Elec. Eng. ☐ Owner ☐

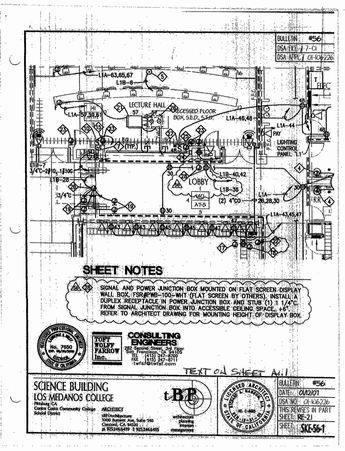

Bulletin No. 10G

Date: 10/24/2006

To: S.J. Amoroso Construction
390 Bridge Parkway
Redwood shores CA 94065

Project: LOS MEDANOS COLLEGE SCIENCE BUILDING
Contra Costa Community College District
DSA No. 01-106226/ File # 7-C1
IBF P/N 20247.00

Description: REFERENCE: RS 2-1, RFI-1

1. Added (1) 20 amp double duplex receptacle in Room 141A – closet for A/V equipment. See attached sketch SKE-10G-1.
2. Revised panel schedule 'L1B' for added circuits. See attached sketch SKE-10G-2.


Issued By: Architect
Requested By: Owner
Reason: AV coordination - Add (1) receptacle in Room 141A – AV closet
Enclosures: SKE-10G.1 and SKE-10G.2

Distribution:

Copies:	Name:	Organization:
1 copy	Mark Delgado	S. J. Amoroso
1 copy	Cam Perrotta	CCCC District
1 copy	Bob Hache	Inspector of Record
1 copy	Tom Beckett	IBF/Architecture
1 copy	File 20247.0007.4	IBF/Architecture
1 copy	Veronica Rosasco	Stamnella Consultant
1 copy	Larry Lai	TWP

Action:
☐ For Information/Clarification only
☒ Provide Price/Credit Proposal. (Refer to this Bulletin No. when responding)
☐ Requires DSA review and approval
☐ Proceed as authorized by District

IBF/Architecture, 1000 Burnett Ave, Suite 140 . Concord, CA. 94520. ph: 925.246.6400. fax: 925.246.6485

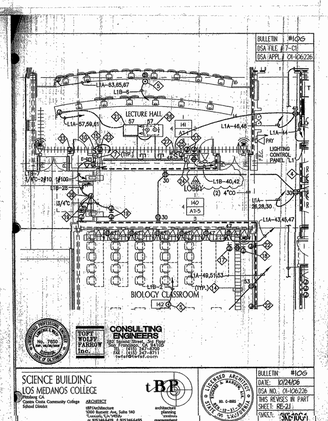

Bulletin No.39

Date: 8/7/2006

To: S.J. Amoroso Construction
390 Bridge Parkway
Redwood shores CA 94065

Project: LOS MEDANOS COLLEGE SCIENCE BUILDING
Contra Costa Community College District
DSA No. 01-106226; File # 7-C1
IBF P/N 20247.00

Description: REFERENCE: sheets M1.1 to M2.4, E-3.1

Provide and install, for each 24 volt VAV transformer that is located in the VAV controller on floors 1 and 2, a toggle type disconnect switch so that each VAV transformer can be isolated without turning power off to the other boxes. Also each disconnect switch shall be labeled/identified by VAV box number.

For the first floor utilize circuit 'L1B-42'

For the second floor utilize circuit 'L2A-36'

SEE RFI-350 for DISCONNECT SWITCHES TO VAV BOXES

Issued By: Architect RFI-376 for VAV location/Switch Clarification?

Requested By: Owner

Reason: Provide disconnect switch to each of the VAV box.

Enclosures: none

Distribution:

Copies:	Name:	Organization:
1 copy	Mark Delgado	S. J. Amoroso
1 copy	Cam Perrotta	CCCC District
1 copy	Bob Hache	Inspector of Record
1 copy	Tom Beckett	IBF/Architecture
1 copy	File 20247.0007.4	IBF/Architecture
1 copy	Larry Lai	TWP
1 copy	Dave Weston	AAME

Action:
☐ For Information/Clarification only
☒ Provide Price/Credit Proposal. (Refer to this Bulletin No. when responding)
☐ Requires DSA review and approval
☐ Proceed as authorized by District

IBF/Architecture, 1000 Burnett Ave, Suite 140 . Concord, CA. 94520. ph: 925.246.6400. fax: 925.246.6485

Bulletin No.40

Date: October 16, 2006

To: S.J. Amoroso Construction
390 Bridge Parkway
Redwood shores CA 94065


Project: LOS MEDANOS COLLEGE SCIENCE BUILDING
Contra Costa Community College District
DSA No. 01-106226; File # 7-C1
IBF P/N 20247.00


Description: REFERENCE: RS 2-1, RS 2-3, RS-3.4, Submittal #82 – Shades:


1. Refer to sketch SKE-40.1: Revised location of shade motor junction boxes. Provide credit to the material and labor of the (2) motor deleted J-box.
2. Refer to sketch SKE-40.2: Revised quantity of motorized shade control boxes and switches. Provide credit to the material and labor of the (3) deleted control box and (3) deleted switches.
3. Refer to sketch SKE-40.3: Revised sheet notes #7, and #14 pertaining to motorized shade requirements. Sheet notes #11 and #16 are deleted. Provide credit to the reduced scope of work in regarding the shade requirments.
4. Refer to sketch SKE-40.4: Revised location of shade motor junction boxes. Provide credit to the material and labor of the (2) deleted motor J-boxes.
5. Refer to sketch SKE-40.5: Revised sheet notes #10 pertaining to motorized shade requirements. Provide credit to reduction of (4) junction box locations down to (2) junction box locations.
6. Refer to sketch SKE-40.6: Revised location of shade motor junction boxes. Provide credit to the material and labor of the (2) deleted motor J-boxes.
7. Refer to sketch SKE-40.7: Revised sheet notes pertaining to motorized shade requirements. Provide credit should be due to reduction of (4) junction box locations down to (2) junction box locations.

Issued By: Architect
Requested By: Architect

IBF/Architecture, 1000 Burnett Ave, Suite 140 . Concord, CA. 94520. ph: 925.246.6400. fax: 925.246.6485

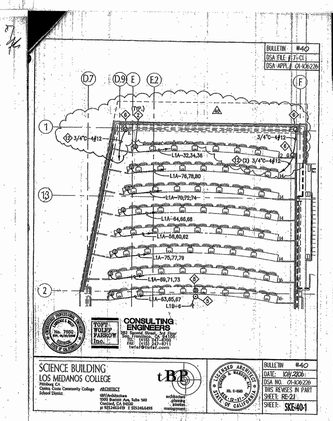

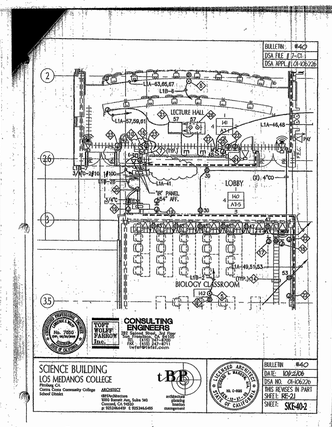

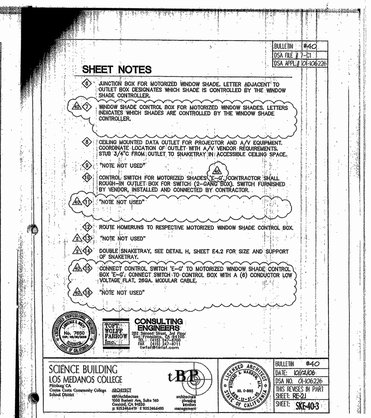

Los Medanos College
4CD Proj.# : L-565-B-23-SC
Science Building

S. J. AMOROSO
Request For Information/Clarification

DSA FILE NO. 7-C1
DSA APPL. No. 01-106226

To: tBP/Architecture, 1000 Bulmett Ave, Suite 140, Concord, CA 94520
Attn: Celia Chiang, Tom Beckett
Fax: 925-246-6495

Project: LOS MEDANOS COLLEGE SCIENCE BUILDING, Contra Costa Community College District
tBP ph: 20247.00

Subj.: Furniture Layout for Electrical Outlets
RFI No: 353
Reference (dwg, spec.): RE-2.1, 2.2, 2.3, 2.4
Subcontractor RFI: EWS 32
Reply Requested By: 9/28/06

Date: 9/21/06

INFORMATION REQUESTED:


Please note the attached EWS RFI No. 32 regarding a furniture layout for rooms 142, 131, 130, 152, 231 and 230. EWS would like to scale the data and receptacle outlets in these rooms. Note the attached dwg for the location of the outlets. Please advise.

SUGGESTED SOLUTION:
Cost Impact: ☐ Schedule Impact: ☐ days By: Mark Delgado

RESPONSE: DATE:
See attached furniture drawings from RI for locations of data and receptacle outlets. Contractor to reference the RI furniture drawings for outlets locations in Rooms #142, 131, 130, 152, 231 and 230 only, except the north wall of Room #152.
See clarification to location of (1) receptacle outlet at the north wall of Room #153 as indicated in the attached mark up.

Vanessa Ling/tBP - 10/3/06

RFI # 000
Page 1

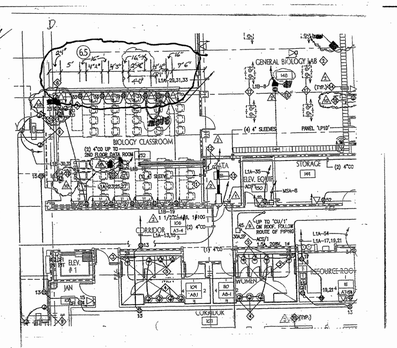

S. J. AMOROSO
Request For Information/Clarification

DSA FILE NO. 7-C1
DSA APPL. No. 01-106228

To: tBP/Architecture, 1000 Bulmett Ave, Suite 140, Concord, CA 94520
Attn: Celia Chiang, Tom Beckett
Fax: 925-246-6495

Project: LOS MEDANOS COLLEGE SCIENCE BUILDING, Contra Costa Community College District
tBP ph: 20247.00

Subj.: Door Switches in Rooms 101 and 140
RFI No: 345
Reference (dwg, spec.): Bulletin No. 44
Subcontractor RFI: EWS 30
Reply Requested By: 9/18/06

Date: 9/11/06

INFORMATION REQUESTED:

Please note the attached Bulletin No. 30 regarding the door Switches at the entrances of Rooms 101 and 140 per Bulletin No. 44. Please advise.

SUGGESTED SOLUTION:
Cost Impact: ☐ Schedule Impact: ☐ days By: Justin Warren

RESPONSE: DATE: 09/11/06

TWF takes no exception to the contractor installing outlet boxes for door switches per contract documents, except additional door switch outlet boxes shall be installed per Bulletin No. 44.

Larry Lai

RFI # 000
Page 1

EDWARD W. SCOTT ELECTRIC CO., INC.
435 HARRIET STREET
San Francisco, CA 94103-4914
Phone: (415) 626-0701 Fax: (415) 626-2837

REQUEST FOR INFORMATION

PROJECT: SCIENCE BLDG. LMC R.F.I.# 30 R.F.I. Date 9/3/06
JOB: 2451 ACTUAL REPLY DATE

TO: MARK DELGADO
OR ANDERSON CONST.
RE: DWG. #RE-2.1/E2
LOCATION: LOBBY/BIO LAB

POTENTIAL COST IMPACT
☐ COST ☐ SCHEDULE
☐ OTHER ☐ LABOR
☐ NO IMPACT ☐ MATERIAL

INFORMATION REQUESTED: THE ATTACHED SKETCH SKA-44 WHICH WAS PART OF BULLETIN #4 DOES NOT APPLY TO THE ENTRANCES TO LOBBY'S 'BIO LAB' INCLUDING PARTIAL WALLS AROUND THE A/C SOUND CONDITIONING AT THESE LOCATIONS AS REQUESTED BY LARRY LAI OF TBP. WE WOULD LIKE TO INSTALL THE DOOR SWITCHES AS SHOWN ON THE CONTRACT DWGS.


REPLY REQUIRED BY: ASAP SIGNED:
NOTE: IF NO REPLY IS RECEIVED BY US BY THE ABOVE NOTED DATE, A TIME EXTENSION WILL BE REQUIRED WITH POSSIBLE COST IMPACTS.

RESPONSE:

DATED: SIGNED:

INDUSTRIAL, COMMERCIAL WIRING & DESIGN
STATE CONTRACTOR LICENSE NO. 190436

ESCOCM

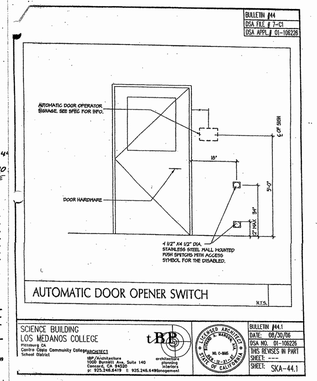

Bulletin No.44 (SEE RFI 345 - FOR DOOR SWITCHES IN ROOMS 101 and 140)

Date: August 30, 2006
To: S.J. Amoroso Construction, 300 Bridge Parkway, Redwood shores CA 94065
Project: LOS MEDANOS COLLEGE SCIENCE BUILDING, Contra Costa Community College District, DSA No. 01-106226, File # 7-C1, tBP 20247.00


Description: REFERENCE: Keynote #21(A)-L, Notes #7&8.


See attached SKA-44.1 for clarification to mounting height of "Automatic Door Opener Switches". In note #7&8, the mounting height is indicated to be between 30" to 44" AFF. For clarification only, mounting height of Opener Switches are to be as shown on SKA-44.1.


Issued By: Architect
Requested By: Architect, Owner
Reason: Clarification of Automatic Door Opener Switches
Enclosures: SKA-44.1


Distribution: Copies: Name: Organization:
1 copy Mark Delgado S. J. Amoroso
1 copy Cian Parmita CCCC/District
1 copy Bob Hanke Inspector of Record
1 copy Tom Beckett tBP/Architecture
1 copy File 20247.00/7-A tBP/Architecture

Action: ☒ For Information/Clarification only
☐ Provide Price/Credit Proposal. (Refer to this Bulletin No. when responding)
☐ Requires DSA review and approval
☐ Proceed as authorized by District

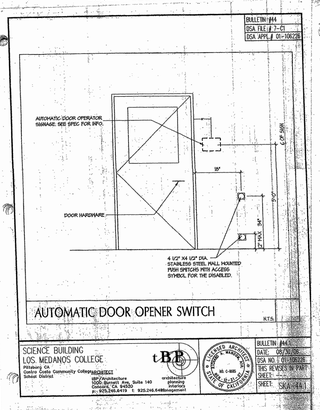

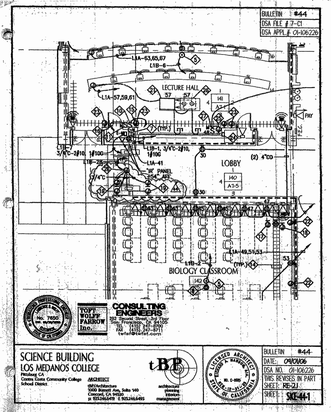

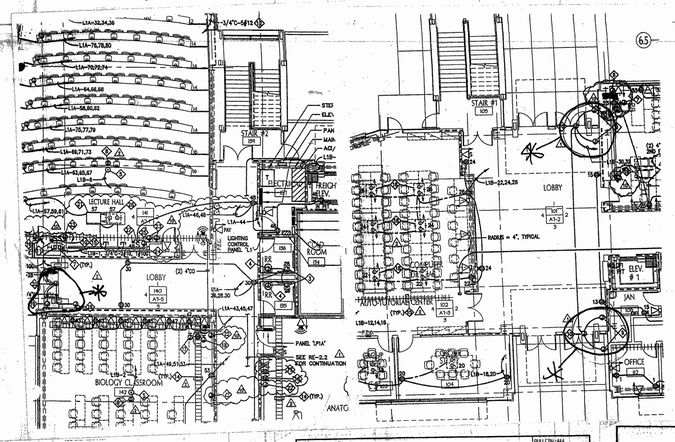

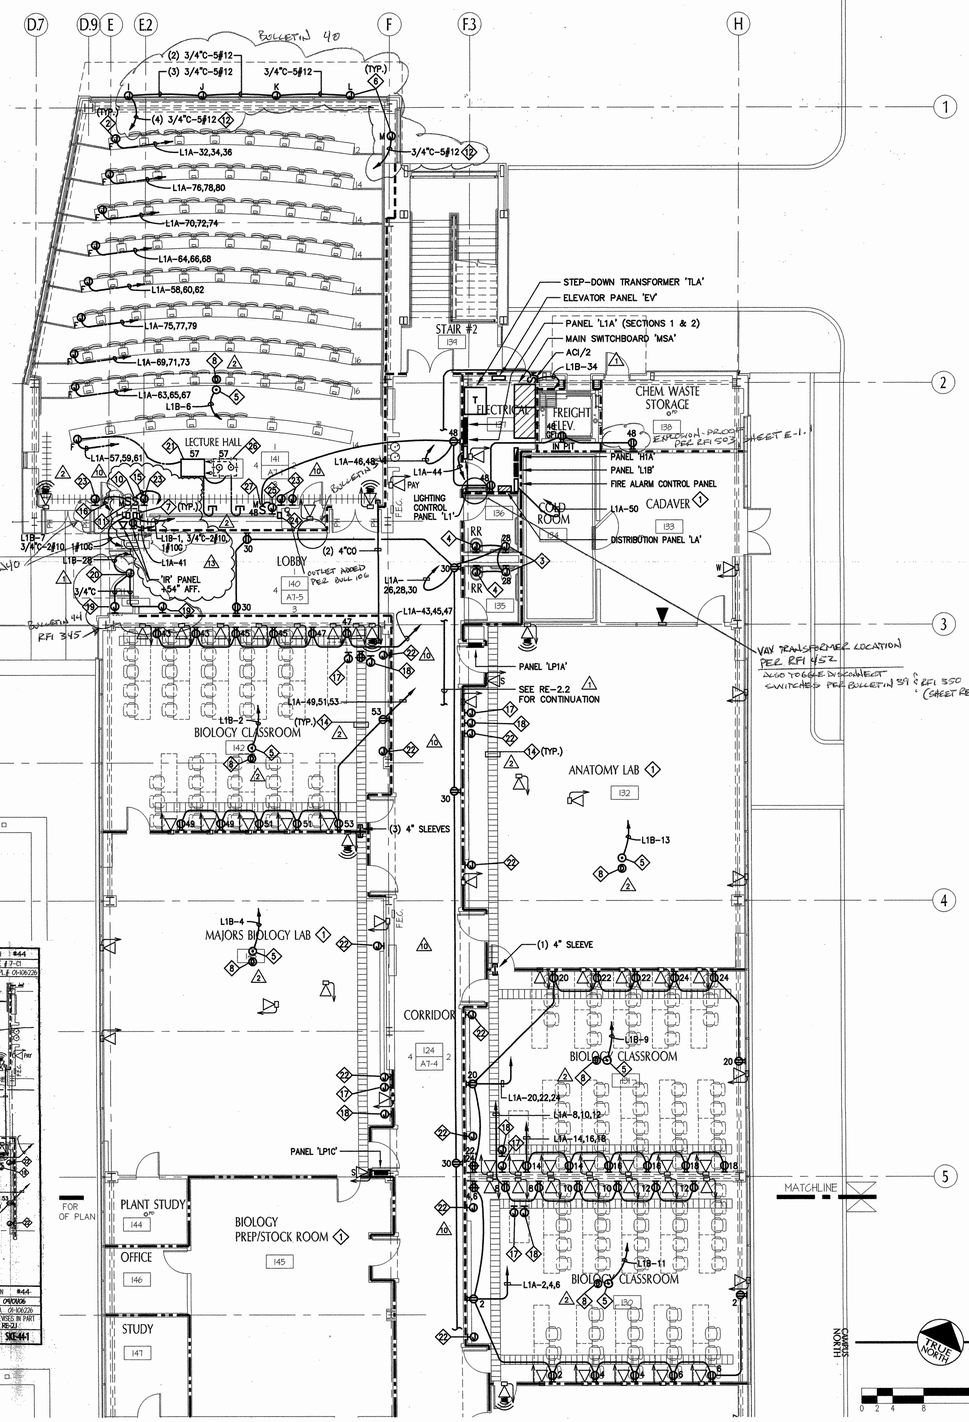


SHEET NOTES

1. REFER TO "ELECTRICAL LABORATORY DRAWING" FOR ADDITIONAL ELECTRICAL REQUIREMENTS IN THIS ROOM.
2. FLOOR MOUNTED JUNCTION BOX FOR POWER FEED TO 'POWER UP MODULES' AT BASE OF CLASS ROOM TABLES.
3. 120V JUNCTION BOX WITH TRANSFORMER (BY OTHERS) FOR FLUSH VALVE SENSOR.
4. 120V JUNCTION BOX FOR FAUCET MOTION SENSOR.
5. CEILING MOUNTED DOUBLE DUPLEX RECEPTACLE FOR PROJECTOR AND A/V EQUIPMENT. COORDINATE LOCATION OF RECEPTACLE WITH A/V VENDOR REQUIREMENTS.
6. JUNCTION BOX FOR MOTORIZED WINDOW SHADE. LETTER ADJACENT TO OUTLET BOX DESIGNATES WHICH SHADE IS CONTROLLED BY THE WINDOW SHADE CONTROLLER.
7. WINDOW SHADE CONTROL BOX FOR MOTORIZED WINDOW SHADES. LETTERS INDICATES WHICH SHADES ARE CONTROLLED BY THE WINDOW SHADE CONTROLLER.
8. CEILING MOUNTED DATA OUTLET FOR PROJECTOR AND A/V EQUIPMENT. COORDINATE LOCATION OF OUTLET WITH A/V VENDOR REQUIREMENTS. STUB 3/4"C FROM OUTLET TO SNAKETRAY IN ACCESSIBLE CEILING SPACE.
9. "NOTE NOT USED"
10. CONTROL SWITCH FOR MOTORIZED SHADES 'I'-'L'. CONTRACTOR SHALL ROUGH-IN OUTLET BOX FOR SWITCH (2-GANG BOX). SWITCH FURNISHED BY VENDOR, INSTALLED AND CONNECTED BY CONTRACTOR.
11. CONTROL SWITCH FOR MOTORIZED SHADE 'M'. CONTRACTOR SHALL ROUGH-IN OUTLET BOX FOR SWITCH (2-GANG BOX). SWITCH FURNISHED BY VENDOR AND CONNECTED BY CONTRACTOR.
12. ROUTE HOMERUNS TO RESPECTIVE MOTORIZED WINDOW SHADE CONTROL BOX.
13. "NOTE NOT USED"
14. DOUBLE SNAKETRAY, SEE DETAIL H, SHEET E4.2 FOR SIZE AND SUPPORT OF SNAKETRAY.
15. CONNECT CONTROL SWITCH 'I'-'L' TO MOTORIZED WINDOW SHADE CONTROL BOX 'I'-'L'
16. CONNECT CONTROL SWITCH 'M' TO MOTORIZED WINDOW SHADE CONTROL BOX 'M'.
17. STUB (2) 1 1/4"C FROM (2) 2-GANG OUTLET BOX INTO ACCESSIBLE CEILING SPACE, +6". OUTLET BOX MOUNTED AT +18" AFF.
18. STUB (1) 3/4"C FROM 1-GANG OUTLET BOX INTO ACCESSIBLE CEILING SPACE, +6". OUTLET BOX MOUNTED AT +48" AFF.
19. 4" SQ. JUNCTION BOX FOR AUTOMATIC DOOR (PUSH PLATE BY OTHERS).
20. SINGLE GANG JUNCTION BOX FOR AUTOMATIC DOOR OPERATOR. COORDINATE LOCATION OF AUTOMATIC DOOR OPERATOR WITH MANUFACTURER REQUIREMENTS.
21. RECESSED FLOOR BOX STUB (2) 1 1/4"C FROM FLOOR BOX INTO ACCESSIBLE CEILING SPACE, +6". (1)DUPLEX RECEPTACLE INSTALLED IN FLOOR BOX. MYSTERY ELECTRONICS #FMCA 3000SERIES/3488-8R, WITH #BB3000D8" BACKBOX (FOR A/V USE).
22. 1-GANG MUD RING FOR A/V SYSTEM WALL SPEAKER (BY OTHERS. MOUNT 1-GANG MUD RING AT +105" AFF. MOUNTING LOCATION SHALL BE COORDINATED WITH A/V CONTRACTOR.
23. STUB (1) 3/4"C FROM 1-GANG OUTLET BOX INTO ACCESSIBLE CEILING SPACE, +6". OUTLET BOX MOUNTED AT +96" AFF.
24. 12"x12"x4" 'DEEP HOFFMAN' BOX, RECESS MOUNTED, +18" AFF. STUB (4) 1 1/4"C FROM HOFFMAN BOX INTO ACOUSTICAL CEILING SPACE, +6". COORDINATE FINAL LOCATION OF BOX WITH A/V CONTRACTOR.
25. 1-GANG OUTLET BOX FOR 'LOW VOLTAGE CONTROL PLATE' AND SWITCH. AT WALL FOR PROJECTION SCREEN. MOUNT BOX AT +48" AFF. STUB (1) 3/4"C FROM OUTLET BOX INTO ACCESSIBLE CEILING SPACE, +6". 'LOW VOLTAGE CONTROL PLATE' AND SWITCH FURNISHED BY OTHERS INSTALLED BY CONTRACTOR.
26. RECESSED FLOOR BOX, WIREMOLD #RFB4 WITH ONE DUPLEX RECEPTACLE. COORDINATE NUMBER OF DATA OUTLETS WITH TELCOM DRAWINGS. STUB (2) 1 1/4"C FROM FLOOR BOX TO SNAKETRAY IN ACCESSIBLE CEILING SPACE, +6".
27. DISCONNECT SWITCH FOR PROJECTION SCREEN COORDINATE LOCATION OF SWITCH WITH PROJECTION SCREEN VENDOR.

ALL OUTLET LOCATIONS PER RFI 353
SEE SHEET 1 OF 2, E.1 FROM KL

KEY PLAN

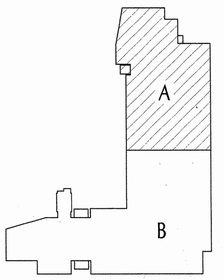

TWF #030508.00

1ST FLOOR PLAN PART "A" — SCALE: 1/8"=1'-0" — 1

tBP/Architecture
1000 Bulmett Avenue, Suite 140
Concord, CA 94520
p. 925.246.6419 f. 925.246.6495

CONSULTING ENGINEERS
TOFT WOLFF FARROW Inc.
282 Second Street, 3rd Floor
San Francisco, CA 94105
PH (415) 247-8711
FAX (415) 247-8771
twfarrow@aol.com

EDW. SCOTT BARTLETT
tBP/Architecture 1000 Bulmett Ave. Suite 140 Concord, CA. 94520 ph/fax 925.246.6419

architecture planning interiors management

architect

consultant

agency

owner

SCIENCE BUILDING
LOS MEDANOS COLLEGE

Contra Costa Community College District

tBP project number : 20247.00
file name: 1s-FLR-A
drawn by: LLAI checked by: LSH
date: NOVEMBER 15, 2004

1	3/18/05	ADDENDUM #1
2	4/19/05	ADDENDUM #2
10		BULLETIN #10
13	03/07/06	BULLETIN #13

drawing title:
1st FLOOR PLAN
PART "A" - POWER/SIGNAL

LMC SCIENCE 313-023-112.01-0-00.00
drawing no:
RE-2.1
SEE ALSO E-2.1 FOR AS-BUILT POSTINGS

NOTE: LEAVE ONE (1) MESSAGE TO ARCHITECT ABOUT THEIR RESPONSE...

S. J. AMOROSO
Request For Information/Clarification

DSA FILE NO. 7-C1
DSA APPL. No. 01-106226

To: IBP/Architecture, 1000 Burnett Ave, Suite 140, Concord, CA 94520
Attn: Celia Chiang, Tom Beckett
Fax: 925-246-6495

Project: LOS MEDANOS COLLEGE SCIENCE BUILDING, Contra Costa Community College District
IBP p/n: 20247.00

Subj.: Layout of equipment in Electrical room 137 — RFI No: **154**
Reference (dwg, spec.) E2.1 — Subcontractor RFI: EWS 12
Reply Requested By: 2/27/06

INFORMATION REQUESTED: Date: 2/23/06

URGENT
See attached form EW Scott addressing urgent concerns about the layout of equipment in the main electrical room, room 137. This is urgent so that underground can be roughed in ahead of our slab concrete placement. Briefly, the layout shown on sheet E2.1 will not work due to conflicts with structural footings, foundations, steel bracing and wall space. EW Scott has provided a possible alternative layout for this room. Please carefully review for feasibility and provide direction on layout for this room.

SUGGESTED SOLUTION:

Cost Impact: ☐ Schedule Impact: ☐ days By: Mark Delgado

RESPONSE: DATE: 2.24.06

IBP has no objection to the proposed layout.

IBP response: Maintain 12" clear at strike side of door.

Attachments: E. 141/197

By:

TRANSMITTAL RECORD: FROM	TO	DATE
S.J. AMOROSO	IBP / ARCHITECTURE	2/24/06
IBP / ARCHITECTURE	ENGINEER/CONSULTANT	2.24.06
ENGINEER/CONSULTANT	IBP / ARCHITECTURE	2.24.06
IBP / ARCHITECTURE	S.J. AMOROSO	2.24.06
S.J. AMOROSO	ORIGINATOR	

RFI # 000
Page 1

EDWARD W. SCOTT ELECTRIC CO., INC.
435 HARRIET STREET
San Francisco, CA 94103-4914
Phone: (415) 626-0701 Fax: (415) 626-2837

RFI 154

REQUEST FOR INFORMATION

LMC
PROJECT: SCIENCE BLDG. R.F.I.# 17 R.F.I. Date 2/23/06
JOB: 2451 ACTUAL REPLY DATE

TO: MARK DELGADO — POTENTIAL COST IMPACT
OF: AMOROSO CONST. — ___ COST ___ SCHEDULE
REF. DWG: E2.1 — ___ OTHER ___ LABOR
LOCATION: ELEC. RM 137 — ___ NO IMPACT ___ MATERIAL

INFORMATION REQUESTED: DUE TO STRUCTURAL FOOTINGS, FOUNDATIONS, STEEL BRACING & WALL SPACE THE ELEC. RM. CANNOT LAYOUT AS SHOWN ON PLAN E2.1. I AM INCLUDING A SKETCH AS A POSSIBLE ALTERNATIVE FOR YOUR REVIEW. I CAN ONLY VERIFY THE SWITCHGEAR DIMENSIONS. ROOM AND WALL DIMENSIONS MAY NOT BE EXACT. PAY PARTICULAR ATTENTION TO PANEL "EY" WHICH MAY NEED TO BE RELOCATED DUE TO THE CROSS BRACE AT GRID LINE 2. PLEASE REVIEW FOR FEASABILITY. WE SHALL WAIT FOR DIRECTION


REPLY REQUIRED BY: ASAP SIGNED:
NOTE: IF NO REPLY IS RECEIVED BY US BY THE ABOVE NOTED DATE, A TIME EXTENSION WILL BE REQUIRED WITH POSSIBLE COST IMPACTS.

RESPONSE:

DATED: SIGNED:

INDUSTRIAL, COMMERCIAL WIRING & DESIGN
STATE CONTRACTOR LICENSE NO. 190426

RFIDOC.99

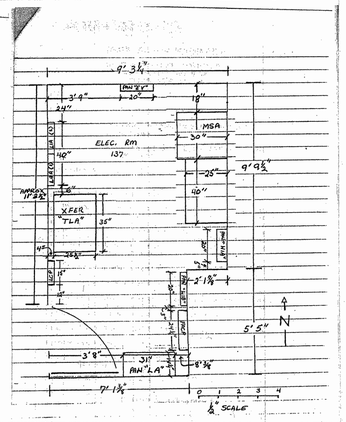

S. J. AMOROSO
Request For Information/Clarification

DSA FILE NO. 7-C1
DSA APPL. No. 01-106226

To: IBP/Architecture, 1000 Burnett Ave, Suite 140, Concord, CA 94520
Attn: Celia Chiang, Tom Beckett
Fax: 925-246-6495

Project: LOS MEDANOS COLLEGE SCIENCE BUILDING, Contra Costa Community College District
IBP p/n: 20247.00

Subj.: Receptacle and Data Outlets in Room 142 — RFI No: **380**
Reference (dwg, spec.): 2.E.1 — Subcontractor RFI: EWS 42
Reply Requested By: 10/17/06

INFORMATION REQUESTED: Date: 10/10/06

Please note the attached EWS RFI No. 42 regarding shifting the Receptacle and Data Outlets as shown on the attached Drawings due to plumbing. Please advise if this is acceptable.

SUGGESTED SOLUTION:

Cost Impact: ☐ Schedule Impact: ☐ days By: Mark Delgado

RESPONSE: DATE:

Moving the outlets 12" will put them at the edge of the table.
Anything Scott Electric could do to make it closer would be better. (like put one below the other)
Make sure the outlets both stay under the table. Please note that the tables are 24" deep. It is OK to have them at the edge - just not past.

Kent Knight/Dovetail - 10/10/06
by Vanessa Ling

RFI # 000
Page 1

EDWARD W. SCOTT ELECTRIC CO., INC.
435 HARRIET STREET
San Francisco, CA 94103-4914
Phone: (415) 626-0701 Fax: (415) 626-2837

REQUEST FOR INFORMATION

LMC
PROJECT: SCIENCE BLDG. R.F.I.# 42 R.F.I. Date 10/10/06
JOB: 2451 ACTUAL REPLY DATE

TO: MARK DELGADO — POTENTIAL COST IMPACT
OF: AMOROSO CONST. — ___ COST ✓ SCHEDULE
REF. DWG: (E 2.E.1 (EX)) — ___ OTHER ___ LABOR
LOCATION: BIO CLASSROOM 142 — ___ NO IMPACT ___ MATERIAL

INFORMATION REQUESTED: IT WILL BE NECESSARY TO SHIFT THE RECEPT. & DATA OUTLETS AS SHOWN ON THE ATTACHED DWG DUE TO PLUMBING


REPLY REQUIRED BY: 10/14/06 SIGNED:
NOTE: IF NO REPLY IS RECEIVED BY US BY THE ABOVE NOTED DATE, A TIME EXTENSION WILL BE REQUIRED WITH POSSIBLE COST IMPACTS.

RESPONSE:

DATED: SIGNED:

INDUSTRIAL, COMMERCIAL WIRING & DESIGN
STATE CONTRACTOR LICENSE NO. 190426

RFIDOC.99

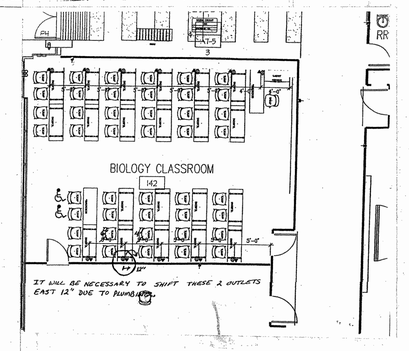

S. J. AMOROSO
Request For Information/Clarification

DSA FILE NO. 7-C1
DSA APPL. No. 01-106226

To: IBP/Architecture, 1000 Burnett Ave, Suite 140, Concord, CA 94520
Attn: Celia Chiang, Tom Beckett
Fax: 925-246-6495

Project: LOS MEDANOS COLLEGE SCIENCE BUILDING, Contra Costa Community College District
IBP p/n: 20247.00

Subj.: Receptacle and Data Outlets in Room 142 — RFI No: **380.1**
Reference (dwg, spec.): 2.E.1 — Subcontractor RFI: EWS 42.1
Reply Requested By: 10/27/06

INFORMATION REQUESTED: Date: 10/20/06

Please note the attached EWS RFI No. 42.1 regarding the installation of both outlets under the table which is not possible. The Receptacle will be located under the table but the Data will be 6" east of the table edge. Also a conflict on the north wall has been discovered, the outlets need to be shifted 24" east due to structural framing. Please advise.

SUGGESTED SOLUTION:

Cost Impact: ☐ Schedule Impact: ☐ days By: Mark Delgado

RESPONSE: DATE:

Moving the outlets 12" will put them at the edge of the table.
Anything Scott Electric could do to make it closer would be better. (like put one below the other)
Make sure the outlets both stay under the table. Please note that the tables are 24" deep. It is OK to have them at the edge - just not past.

Kent Knight/Dovetail - 10/24/06

RFI # 000
Page 1

EDWARD W. SCOTT ELECTRIC CO., INC.
435 HARRIET STREET
San Francisco, CA 94103-4914
Phone: (415) 626-0701 Fax: (415) 626-2837

REQUEST FOR INFORMATION

LMC
PROJECT: SCIENCE BLDG. R.F.I.# 42.1 R.F.I. Date 10/20/06
JOB: 2451 ACTUAL REPLY DATE

TO: MARK DELGADO — POTENTIAL COST IMPACT
OF: AMOROSO CONST. — ___ COST ✓ SCHEDULE
REF. DWG: (E 2.E.1 (EX)) — ___ OTHER ___ LABOR
LOCATION: BIO CLASSROOM 142 — ___ NO IMPACT ___ MATERIAL

INFORMATION REQUESTED: IN REGARDS TO RFI 42 RESPONSE IT IS NOT POSIBLE TO INSTALL BOTH OUTLETS UNDER THE TABLE THE RECEPT. WILL BE UNDER THE TABLE BUT THE DATA WILL BE 6" EAST OF THE TABLE EDGE.
WE HAVE ALSO DISCOVERED A CONFLICT ON THE NORTH WALL, WHERE THE OUTLETS NEED TO BE SHIFTED 24" EAST DUE TO STRUCTURAL FRAMING. SEE ATTACHED SKETCH.


REPLY REQUIRED BY: ASAP SIGNED:
NOTE: IF NO REPLY IS RECEIVED BY US BY THE ABOVE NOTED DATE, A TIME EXTENSION WILL BE REQUIRED WITH POSSIBLE COST IMPACTS.

RESPONSE:


DATED: SIGNED:

INDUSTRIAL, COMMERCIAL WIRING & DESIGN
STATE CONTRACTOR LICENSE NO. 190426

RFIDOC.99

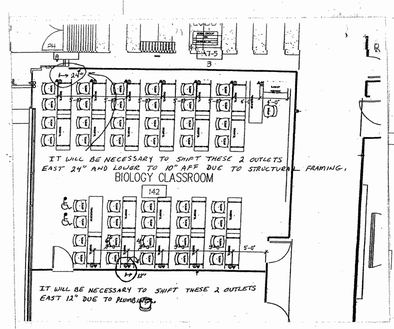

LMC Science Room 142 10-23-06
Kent Knight

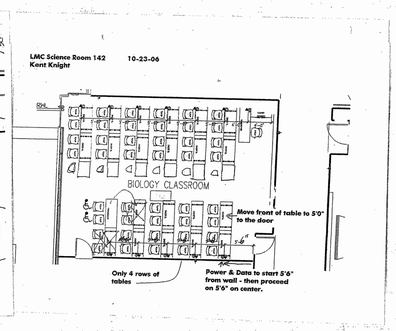

S. J. AMOROSO
Request For Information/Clarification

DSA FILE NO. 7-C1
DSA APPL. No. 01-106226

To: IBP/Architecture, 1000 Burnett Ave, Suite 140, Concord, CA 94520
Attn: Celia Chiang, Tom Beckett
Fax: 925-246-6495

Project: LOS MEDANOS COLLEGE SCIENCE BUILDING, Contra Costa Community College District
IBP p/n: 20247.00

Subj.: Receptacle and Data Outlets in Room 142 — RFI No: **380.1**
Reference (dwg, spec.): 2.E.1 — Subcontractor RFI: EWS 42.1
Reply Requested By: 10/27/06

INFORMATION REQUESTED: Date: 10/20/06

Please note the attached EWS RFI No. 42.1 regarding the installation of both outlets under the table which is not possible. The Receptacle will be located under the table but the Data will be 6" east of the table edge. Also a conflict on the north wall has been discovered, the outlets need to be shifted 24" east due to structural framing. Please advise.

SUGGESTED SOLUTION:

Cost Impact: ☐ Schedule Impact: ☐ days By: Mark Delgado

RESPONSE: DATE:

Moving the p/d on the north wall is OK. Please see the attached sketch for the rest of my response to the RFI #380.1. This will move all of the p/d on the south wall.

Let me know if it takes care of the move needed due to plumbing.
Contact me with any questions.

Kent Knight/Dovetail - 10/24/06

RFI # 000
Page 1

EDWARD W. SCOTT ELECTRIC CO., INC.
435 HARRIET STREET
San Francisco, CA 94103-4914
Phone: (415) 626-0701 Fax: (415) 626-2837

REQUEST FOR INFORMATION

LMC
PROJECT: SCIENCE BLDG. R.F.I.# 42.1 R.F.I. Date 10/20/06
JOB: 2451 ACTUAL REPLY DATE

TO: MARK DELGADO — POTENTIAL COST IMPACT
OF: AMOROSO CONST. — ___ COST ✓ SCHEDULE
REF. DWG: (E 2.E.1 (EX)) — ___ OTHER ___ LABOR
LOCATION: BIO CLASSROOM 142 — ___ NO IMPACT ___ MATERIAL

INFORMATION REQUESTED: IN REGARDS TO RFI 42 RESPONSE IT IS NOT POSIBLE TO INSTALL BOTH OUTLETS UNDER THE TABLE THE RECEPT. WILL BE UNDER THE TABLE BUT THE DATA WILL BE 6" EAST OF THE TABLE EDGE.
WE HAVE ALSO DISCOVERED A CONFLICT ON THE NORTH WALL, WHERE THE OUTLETS NEED TO BE SHIFTED 24" EAST DUE TO STRUCTURAL FRAMING. SEE ATTACHED SKETCH.


REPLY REQUIRED BY: ASAP SIGNED:
NOTE: IF NO REPLY IS RECEIVED BY US BY THE ABOVE NOTED DATE, A TIME EXTENSION WILL BE REQUIRED WITH POSSIBLE COST IMPACTS.

RESPONSE:

DATED: SIGNED:

INDUSTRIAL, COMMERCIAL WIRING & DESIGN
STATE CONTRACTOR LICENSE NO. 190426

RFIDOC.99

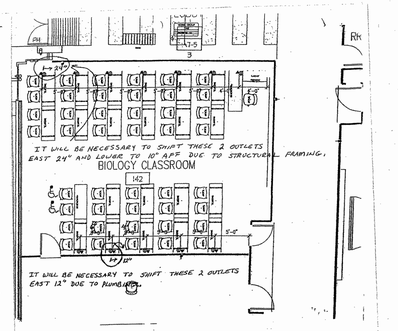

S. J. AMOROSO
Request For Information/Clarification

DSA FILE NO. 7-C1
DSA APPL. No. 01-106226

To: IBP/Architecture, 1000 Burnett Ave, Suite 140, Concord, CA 94520
Attn: Celia Chiang, Tom Beckett
Fax: 925-246-6495

Project: LOS MEDANOS COLLEGE SCIENCE BUILDING, Contra Costa Community College District
IBP p/n: 20247.00

Subj.: Receptacle and Data Outlets in Room 142 — RFI No: **380.2**
Reference (dwg, spec.): 2.E.1 — Subcontractor RFI: EWS 42.2
Reply Requested By: 11/8/06

INFORMATION REQUESTED: Date: 10/30/06

Please note the attached EWS RFI No. 42.2 regarding the response to RFI No. 380.1. The power and data outlets on the south wall or room 142 can be installed within 20" west per the reply from Kent Knight. The data outlets however will need to be raised to 28" A.F.F. The power outlet will need to stay at 18" A.F.F. Please advise.

SUGGESTED SOLUTION:

Cost Impact: ☐ Schedule Impact: ☐ days By: Mark Delgado

RESPONSE: DATE:

See attached sketch from Kent/Dovetail regarding the case out of meeting with Joe on 11/3/06.

Kent Knight/Dovetail - 11/6/06

RFI # 000
Page 1

EDWARD W. SCOTT ELECTRIC CO., INC.
435 HARRIET STREET
San Francisco, CA 94103-4914
Phone: (415) 626-0701 Fax: (415) 626-2837

REQUEST FOR INFORMATION

PROJECT: LMC SCIENCE BLDG R.F.I.# 42.2 R.F.I. Date 10/27/06
JOB: 2451 ACTUAL REPLY DATE

TO: MARK DELGADO — POTENTIAL COST IMPACT
OF: S.J.AMOROSO — ___ COST ✓ SCHEDULE
REF. DWG: (E 2.E.1 (EX)) — ___ OTHER ___ LABOR
LOCATION: BIO CLASSROOM 142 — ___ NO IMPACT ___ MATERIAL

INFORMATION REQUESTED: IN REPLY TO KENT KNIGHT'S REVISED RESPONSE TO THE PWR/DATA OUTLETS ON THE SOUTH WALL OF RM 142 WE CAN INSTALL THE OUTLETS WITHIN 20" WEST. THE DATA OUTLET, HOWEVER WILL NEED TO BE RAISED TO 28" AFF. THE PWR OUTLET WILL NEED TO STAY AT 18" AFF. BE ADVISD THAT SEE THIS DID TAKE PICTURES OF THIS PARTICULAR SITUATION.


REPLY REQUIRED BY: ASAP SIGNED:
NOTE: IF NO REPLY IS RECEIVED BY US BY THE ABOVE NOTED DATE, A TIME EXTENSION WILL BE REQUIRED WITH POSSIBLE COST IMPACTS.

RESPONSE:

DATED: SIGNED:

INDUSTRIAL, COMMERCIAL WIRING & DESIGN
STATE CONTRACTOR LICENSE NO. 190426

RFIDOC.99

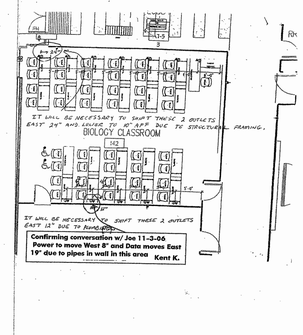

Los Medanos College
4CD Proj.# : L-565-B-23-SC
Science Building

SHEET NOTES

1. REFER TO "ELECTRICAL LABORATORY DRAWING" FOR ADDITIONAL ELECTRICAL REQUIREMENTS IN THIS ROOM.
2. FLOOR MOUNTED JUNCTION BOX FOR POWER FEED TO 'POWER UP MODULES' AT BASE OF CLASS ROOM TABLES.
3. 120V JUNCTION BOX WITH TRANSFORMER (BY OTHERS) FOR FLUSH VALVE SENSOR.
4. 120V JUNCTION BOX FOR FAUCET MOTION SENSOR.
5. DUPLEX RECEPTACLE FOR CEILING MOUNTED PROJECTOR. RECEPTACLE FOR PROJECTOR INSTALLED IN CEILING SPACE. COORDINATE EXACT LOCATION OF PROJECTOR WITH ARCHITECT 'RCP' DRAWINGS.
6. JUNCTION BOX FOR MOTORIZED WINDOW SHADE. LETTER ADJACENT TO OUTLET BOX DESIGNATES WHICH SHADE IS CONTROLLED BY THE WINDOW SHADE CONTROLLER.
7. WINDOW SHADE CONTROL BOX FOR MOTORIZED WINDOW SHADES. LETTERS INDICATES WHICH SHADES ARE CONTROLLED BY THE WINDOW SHADE CONTROLLER.
8. CONTROL SWITCH FOR MOTORIZED SHADES 'A~D'. CONTRACTOR SHALL ROUGH-IN OUTLET BOX FOR SWITCH (2-GANG BOX). SWITCH FURNISHED BY VENDOR, INSTALLED AND CONNECTED BY CONTRACTOR.
9. CONTROL SWITCH FOR MOTORIZED SHADES 'E~H'. CONTRACTOR SHALL ROUGH-IN OUTLET BOX FOR SWITCH (2-GANG BOX). SWITCH FURNISHED BY VENDOR, INSTALLED AND CONNECTED BY CONTRACTOR.
10. CONTROL SWITCH FOR MOTORIZED SHADES 'I~L'. CONTRACTOR SHALL ROUGH-IN OUTLET BOX FOR SWITCH (2-GANG BOX). SWITCH FURNISHED BY VENDOR, INSTALLED AND CONNECTED BY CONTRACTOR.
11. CONTROL SWITCH FOR MOTORIZED SHADE 'M'. CONTRACTOR SHALL ROUGH-IN OUTLET BOX FOR SWITCH (2-GANG BOX). SWITCH FURNISHED BY VENDOR AND CONNECTED BY CONTRACTOR.
12. ROUTE HOMERUNS TO RESPECTIVE MOTORIZED WINDOW SHADE CONTROL BOX.
13. CONNECT CONTROL SWITCH 'A~D' TO MOTORIZED WINDOW SHADE CONTROL BOX 'A~D'.
14. CONNECT CONTROL SWITCH 'E~H' TO MOTORIZED WINDOW SHADE CONTROL BOX 'E~H'.
15. CONNECT CONTROL SWITCH 'I~L' TO MOTORIZED WINDOW SHADE CONTROL BOX 'I~L'
16. CONNECT CONTROL SWITCH 'M' TO MOTORIZED WINDOW SHADE CONTROL BOX 'M'.
17. STUB (2) 1 1/4"C FROM 4-GANG OUTLET BOX INTO ACCESSIBLE CEILING SPACE, +6".
18. STUB (1) 3/4"C FROM 1-GANG OUTLET BOX INTO ACCESSIBLE CEILING SPACE, +6".

SHEET NOTES

1. DUPLEX RECEPTACLE FOR CEILING MOUNTED PROJECTOR. COORDINATE EXACT LOCATION OF RECEPTACLE PROJECTOR REQUIREMENTS.
2. CEILING MOUNTED DATA OUTLET FOR PROJECTOR. COORDINATE LOCATION OF OUTLET WITH PROJECTOR REQUIREMENTS. STUB 3/4"C FROM OUTLET TO SNAKETRAY IN ACCESSIBLE CEILING SPACE.
3. "NOTE NOT USED"
4. "NOTE NOT USED"
5. DOUBLE SNAKETRAY, SEE DETAIL H, SHEET E4.2 FOR SIZE AND SUPPORT OF SNAKETRAY.
6. RECESSED FLOOR BOX STUB (2)1 1/4"C FROM FLOOR BOX TO SNAKETRAY IN ACCESSIBLE CEILING SPACE. (1)DUPLEX RECEPTACLE INSTALLED IN FLOOR BOX. MYSTERY ELECTRONICS #MCA 3000ISERIES/24486~BK.

SCIENCE BUILDING
LOS MEDANOS COLLEGE
Pittsburg CA
Contra Costa Community College School District

ARCHITECT: tBP Architecture, 1000 Burnett Ave, Suite 140, Concord, CA 94520, p: 925.246.6495 f: 925.246.6495

CONSULTING ENGINEERS: TOFT WOLFF FARROW Inc., 582 Second Street, Ste 100, Oakland, CA 94607, (510) 267-0700, FAX (510) 267-0711, twfa@twfaf.com

ADDENDUM #2 | DSA FILE # 7-C1 | DSA APPL # 01-106226 | DATE: 04/19/05 | DSA NO. 01-106226 | THIS REVISES IN PART | SHEET: RE-2.1 | SHEET: RE-6








TOFT WOLFF FARROW Inc.

consultant

DSA IDENTIFICATION STAMP
DIV. OF THE STATE ARCHITECT
OFFICE OF REGULATION SERVICES
APP. 01-106226
DATE 11-10-05

name
address
city, state, zip
ph:
fx:

agency

SCIENCE BUILDING
LOS MEDANOS COLLEGE

Contra Costa Community College District

owner

tBP project number : 20241.00
file name: 1s-FLR-A
drawn by: LLAI checked by: LSH
date: NOVEMBER 15, 2004

Rev:	date:	description:

drawing title:
1st FLOOR PLAN
PART "A" - POWER/SIGNAL

LMC SCIENCE 313-023-112.01-0-00.00
drawing no.:
E-2.1

SEE SHEET RE-2.1

1ST FLOOR PLAN PART "A"
SCALE: 1/8"=1'-0"

1

TWF #030058.00

Bulletin No.18

Date: March 29, 2006

To: S.J. Amoroso Construction
390 Bridge Parkway
Redwood shores CA 94065

Project: LOS MEDANOS COLLEGE SCIENCE BUILDING
Contra Costa Community College District
DSA No. 01-106226; File # 7-C1
tBP JOB# 20247.00

Description: REFERENCE: E-2.2, E2.4, T1-2, T1-6


1. Per sketches attached, locate data wall box shown on perimeter wall at faculty offices 112 - 122 on the first floor and 215 – 224 on the second floor on sheets E-2.2, E2.4, T1-2, T1-4 to the partition walls between offices as shown.
2. Note that conduit stubs at first floor perimeter are to remain. Contractor to provide surface mounted raceway such as Panduit or Wiremold to route from stub to location per attached sketches SKE18.1, SKE18.2, SKT-18.1, SK18.2 and SKT-18.3.
3. Add one duplex receptacle at office 122 first floor east wall location as indicated on SKE-18.2.
4. Revise face plate of wall box as shown in Office 224 on SKT-18.6 to WBFD400.


Issued By: Architect
Requested By: Owner
Reason: Relocation of data wall boxes at faculty offices requested by Owner
Enclosures: SK18.1 – 18.4, SKT-18.1 - 18.6
Distribution:

Copies:	Name:	Organization:
1 copy	Mark Delgado	S. J. Amoroso
1 copy	Cam Perrotta	CCCCDistrict
1 copy	Bob Harke	Inspector of Record
1 copy	Larry Lai	Toft Wolff Farrow
1 copy	John Lambert	Infrastructure Design Associates
1 copy	Tom Beckett	tBP/Architecture
1 copy	File 20247.00/7.4	tBP/Architecture

Action:
- ☐ For Information/Clarification only
- ☒ Provide Price/Credit Proposal. (Refer to this Bulletin No. when responding)
- ☐ Requires DSA review and approval
- ☒ Proceed as authorized by District

tBP/Architecture 1000 Burnett Ave, Suite 140 Concord, CA 94520 ph: 925.246.6419 fax: 925.246.0480

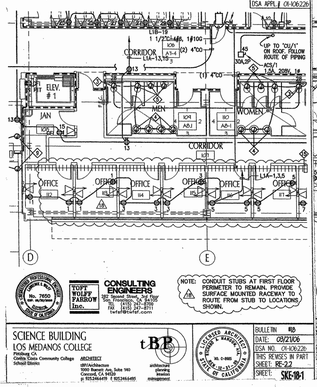

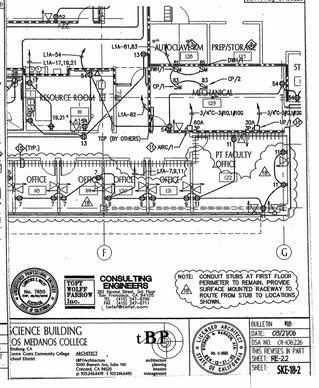

SCIENCE BUILDING
LOS MEDANOS COLLEGE
Pittsburg CA
Contra Costa Community College District
ARCHITECT tBP/Architecture 1000 Burnett Ave, Suite 140 Concord, CA 94520 p: 925.246.6419 f: 925.246.0480
architecture planning interiors management

DSA NO. 01-106226
THIS REVISES IN PART
SHEET: RE-2.2
SHEET: SKE-18.1

DSA NO. 01-106226
THIS REVISES IN PART
SHEET: RE-2.2
SHEET: SKE-18.2

Bulletin No.10C

Date: March 15, 2006

To: S.J. Amoroso Construction
390 Bridge Parkway
Redwood shores CA 94065

Project: LOS MEDANOS COLLEGE SCIENCE BUILDING
Contra Costa Community College District
DSA No. 01-106226; File # 7-C1
tBP JOB# 20247.00

Description: REFERENCE: Submittal #43 - Lab Casework Shop drawings. Submittal #70 – Under Floor Boxes. Ad-3, RFI-2, RFI-3b and LE1-1a for revision to FIRST FLOOR AREA "B":

Laboratory:

1. Delete A/V cabinets in Microbiology/ Microphysiology Lab– Room #129 and General Biology Lab – Room #148, provide credit: (Refer to SKLJ-10C.1 and SKLJ-10C.2)

Electrical:

The following revisions apply to drawing RE2-2:

2. Sheet note #6 is revised to (2) 2-gang outlet box, and J-box to be mounted at +18" AFF.
3. For Microbiology/ Microphysiology Lab– Room #129 and General Biology Lab – Room #148 only: Delete (1) J-box symbol for keynote symbol #6. Provide credit of removed J-box and conduit.
4. Sheet note #7 is revised for J-box to be mounted at +48" AFF.
5. For Microbiology/ Microphysiology Lab– Room #129 and General Biology Lab – Room #148 only: Delete (1) J-box symbol for keynote symbol #7. Provide credit of removed J-box and conduit.
6. Sheet note #8 is revised to Double Duplex at projector, typical.
7. Sheet note #16 is revised to Data Outlet for projector and A/V equipment.
8. Add sheet note #19 for 3-gang Mud Ring for wall mounted speakers (speakers by AV consultant). Final locations to be confirmed with AV contractor. Add (2) 1-gang Mud Ring (shown as J-boxes symbols) and keynote symbol #19 to the following locations:
   - West wall of Microbiology/ Microphysiology Lab– Room #129.
   - East wall of General Biology Lab – Room #148.
   - East wall of Biology Classroom – Room #152

BULLETIN # 10C
LOS MEDANOS COLLEGE SCIENCE BUILDING

9. Add Sheet note #20 for recessed Mystery Electronics Floor Box.
   - Add (1) Mystery Floor Box in General Biology Lab – Room #148. Also see line item 20 in this Bulletin for deletion of (2) floor boxes and (1) Quad Receptacle in this location per LE1-1a.
10. Delete and provide credit for the following item in PT Faculty Office – Room #122:
    - (2) J-Boxes in East Wall and the related conduits
    - (1) Duplex Receptacle for ceiling mount projector
    - (1) Ceiling mounted Data outlet and related conduit
11. Add (1) Quad Receptacle on West wall of Biology Classroom – Room #152.
12. For clarification, add keynote symbol #9 for ceiling mounted Double Duplex Receptacle for Projector and A/V equipments at Biology Classroom – Room #152.

Lab Electrical: (Refer to Drawing LE1-1b, SKLE-10C.1)

13. Revise sheet note 3 to be "NOT USED".
14. Revise note #4, new note #4 is to be: "Faculty input point. Provide junction box and (2) 1-1/2" conduit from Faculty Input point to wall and to 6" above ceiling." Note #4 applies to Microbiology/ Microphysiology Lab– Room #129.
15. For clarification only, revise note #5 to "refer to Electrical Drawing (sheet RE-2.2) for additional information."
16. Revise motorized projection screens for General Biology Lab – Room #148 and Microbiology/ Microphysiology Lab– Room #129 to manual operated screens.
    - J-Boxes and Switches for the motorized projection screens are deleted. Provide credit for deletion of the J-Boxes, Switches, and related wiring to main panel.
    - Revise Sheet note #6 and #7 to be "NOT USED".
    - See future Bulletin 10A for additional information of manual projection screens in three rooms.
17. Refer to note #16 on LE1-1b and note #17 on RE2.2 in Contract Documents. For clarification, at sheet note #16 on LE1-1b, Wiremold Floor Boxes are revised to be RFB4. Also see Bulletin #10B for details of Wiremold Floor Box.
18. Add sheet note #17 for recessed Mystery Electronics Floor Box.
19. Delete (1) J-Box, (1) Quad Receptacle, (1) Data Outlet behind the AV cabinets, for Microbiology/ Microphysiology Lab– Room #129 and General Biology Lab – Room #148. (1) Duplex receptacle is to remain in both Labs. Provide credit for deletion of all above items with related conduits and wiring.
20. For General Biology Lab – Room #148 only, delete (1) Duplex Receptacle, (1) Wiremold Floor Box and (1) J-Box at Faculty Input Point. Provide credit for deletion of all above items with related conduit and wiring. Add (1) Mystery Electronic Floor Box per line item 9 in this Bulletin.
21. Added Mystery Electronics Floor Box symbol in "Signal Symbols and Descriptions" table on sheet LE1-0i. Reference SKLE-10C.1 for revision.

Architectural:

22. For clarification only, see SKA-10C.1 for location of floor boxes in General Biology Lab - Room #148.

Issued By: Architect
Requested By: Architect, Owner
Reason: A/V coordination for First Floor Area "B" only. Addition AV coordination for 2nd Floor to be issued in future Bulletin.
Enclosures: SKA-10C.1, RE2.2, SKLE-10C.1 ,SKLJ-10C.2, SKLE-10C.1 and LE1-1b
Distribution:

Copies:	Name:	Organization:
1 copy	Mark Delgado	S. J. Amoroso
1 copy	Cam Perrotta	CCCCDistrict
1 copy	Bob Harke	Inspector of Record
1 copy	Tom Beckett	tBP/Architecture
1 copy	File 20247.00/7.4	tBP/Architecture
1 copy	Larry Lai	Toft Wolff Farrow, Inc.
1 copy	Cherry Li-Bogg	Los Medanos College
1 copy	Stephanie O'Brien	Dovetail Decision Consultants, Inc.
1 copy	Veronica Rosasel	Stamoulis Consultant
1 copy	John Lambert	Infrastructure Design Associates
1 copy	Richard Cate	SJFD
1 copy	Jim Cooley	Michael Wall Engineering

Action:
- ☐ For Information/Clarification only
- ☒ Provide Price/Credit Proposal. (Refer to this Bulletin No. when responding)
- ☐ Requires DSA review and approval
- ☐ Proceed as authorized by District

BULLETIN #D
DSA FILE # 7-C1
DSA APPL # 01-106226
DATE: 05/21/06
DSA NO. 01-106226
THIS REVISES IN PART
SHEET: RE-2.2
SHEET: SKE-18.3

BULLETIN #D
DSA FILE # 7-C1
DSA APPL # 01-106226
DATE: 05/21/06
DSA NO. 01-106226
THIS REVISES IN PART
SHEET: RE-2.2
SHEET: SKE-18.4

S. J. AMOROSO
Request For Information/Clarification

DSA FILE NO. 7-C1
DSA APPL. No. 01-106226

To: tBP/Architecture, 1000 Burnett Ave, Suite 140, Concord, CA 94520
Project: LOS MEDANOS COLLEGE SCIENCE BUILDING, Contra Costa Community College District
Attn: Celia Chiang, Tom Beckett
Fax: 925-246-6495
tBP job: 20247.00
Subj.: Relocation of Data and Receptacle Outlets in the Video Set-up Lab.
RFI No: 354 (REVISED RESPONSE: 9/27/06)
Reference (dwg, spec.): E2.2
Subcontractor RFI: EWS 33
Reply Requested By: 9/29/06

INFORMATION REQUESTED: Date: 9/22/06

Please note the attached EWS RFI No. 33 requesting a location for the Data and Receptacle Outlets shown on drawing E2.2 on the north, south and west walls of the video set up lab room 102. Please advise.

SUGGESTED SOLUTION:
Cost Impact: ☐ Schedule Impact: ☐ days By: Mark Delgado

RESPONSE: DATE:

TWF recommends that the power/data outlets be located in the back splash counter/cabinet area (along the north, south and west walls). Rotate outlets 90 degrees so that the outlets sit horizontally in the backsplash.

Coordinate location of outlet with the architect.

Larry Lai/TWF - 9/25/06


See attached sketch SKA314.1 for locations.

Vanessa Ling/SJP - 9/25/06

REVISED RESPONSE 9/27/06:
See Future Bulletin #43 for revision to quantity of outlets in this area.

Vanessa Ling/SJP - 9/27/06

RFI # 000
Page 1

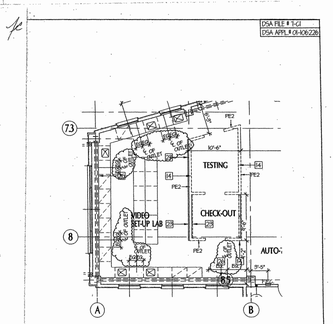

PARTIAL FIRST FLOOR PLAN PART "B" 1

SCIENCE BUILDING
LOS MEDANOS COLLEGE
Pittsburg CA
Contra Costa Community College District
ARCHITECT tBP/Architecture 1000 Burnett Ave, Suite 140 Concord, CA 94520 p: 925.246.6419 f: 925.246.0480
architecture planning interiors management

BFW 354
DATE: 9/25/06
THIS REVISES IN PART
SHEET: A-2
SHEET: SKA354.1

EDWARD W. SCOTT ELECTRIC CO., INC.
435 HARRIET STREET
San Francisco, CA 94103-4914
Phone: (415) 626-0701 Fax: (415) 626-2837

REQUEST FOR INFORMATION

PROJECT: LMC SCIENCE BLDG. R.F.I.# 33 R.F.I. Date 9/21/06
JOB: 2451 ACTUAL REPLY DATE

TO: MARK DELGADO POTENTIAL COST IMPACT
OF: AMOROSO CONST. ___ COST X SCHEDULE
REF DWG: E-2.2, A1.4, A2.4 ___ OTHER ___ LABOR
LOCATION: 102 X NO IMPACT ___ MATERIAL

INFORMATION REQUESTED: WE ARE REQUESTING A LOCATION FOR THE DATA & RECEPT. OUTLETS SHOWN ON DWG. E-2.2 ON THE NORTH, SOUTH & WEST WALLS OF THE VIDEO SET-UP LAB #102. DO THEY MOUNT IN THE CABINETRY THEY WILL NOT FIT IN THE BACK SPLASH. PLEASE ADVISE.

REPLY REQUIRED BY: ASAP SIGNED:
NOTE: IF NO REPLY IS RECEIVED BY US BY THE ABOVE NOTED DATE, A TIME EXTENSION WILL BE REQUIRED WITH POSSIBLE COST IMPACTS.

RESPONSE:

DATED: SIGNED:

INDUSTRIAL, COMMERCIAL WIRING & DESIGN
STATE CONTRACTOR LICENSE NO. 190436
RFIDOC39

S. J. AMOROSO
Request For Information/Clarification

DSA FILE NO. 7-C1
DSA APPL. No. 01-106226

To: tBP/Architecture, 1000 Burnett Ave, Suite 140, Concord, CA 94520
Project: LOS MEDANOS COLLEGE SCIENCE BUILDING, Contra Costa Community College District
Attn: Celia Chiang, Tom Beckett
Fax: 925-246-6495
tBP job: 20247.00
Subj.: Lighting Circuits for Elevators
RFI No: 439
Reference (dwg, spec.): E-2.2 and E-2.3
Subcontractor RFI: EWS 85
Reply Requested By: 12/18/06

INFORMATION REQUESTED: Date: 12/7/06

Please note the attached Edward Scott RFI No. 85 regarding lighting circuits being called out for on the elevator shop drawings but not on the contract drawings. Please advise.

SUGGESTED SOLUTION:
Cost Impact: ☐ Schedule Impact: ☐ days By: Mark Delgado

RESPONSE: DATE:

This is required by code and should be installed.

1. Install in the elevator machine room 239, one (1) junction box with locked switch, for cab lighting/power.
- Coordinate location of junction box with elevator contractor.
- Utilize circuit "L2A/94 in Panel 'L2A', with a 20A, 1P breaker.

2. Install in the elevator machine room 160, one (1) junction box with locked switch for cab lighting/power.
- Coordinate location of junction box with elevator contractor.
- Utilize circuit "L1B-36" in panel "L1B', with a 20A, 1P, breaker.

Llai / Toft Wolff Farrow
Jim Weaver / tBP Architecture

12/15/06

RFI # 000
Page 1

EDWARD W. SCOTT ELECTRIC CO., INC.
435 HARRIET STREET
San Francisco, CA 94103-4914
Phone: (415) 626-0701 Fax: (415) 626-2837

REQUEST FOR INFORMATION

PROJECT: LMC SCIENCE BLDG. R.F.I.# 65 R.F.I. Date 12/1/06
JOB: 2451 ACTUAL REPLY DATE

TO: MARK DELGADO POTENTIAL COST IMPACT
OF: AMOROSO CONSTRUCTION X COST X SCHEDULE
REF DWG: E-2.2 & E-2.3 ___ OTHER ___ LABOR
LOCATION: ELEV. EQUIP. RMS ___ NO IMPACT X MATERIAL


INFORMATION REQUESTED: THE ELEVATOR SHOP DWGS. CALL FOR A TEST DEDICATED ATC KITS FOR EACH ELEV. PER THE CONTRACT DWGS. DO NOT CALL FOR THESE KITS. PLEASE REVIEW & REPLY.

REPLY REQUIRED BY: 12/15/06 SIGNED:
NOTE: IF NO REPLY IS RECEIVED BY US BY THE ABOVE NOTED DATE, A TIME EXTENSION WILL BE REQUIRED WITH POSSIBLE COST IMPACTS.

RESPONSE:

DATED: SIGNED:

INDUSTRIAL, COMMERCIAL WIRING & DESIGN
STATE CONTRACTOR LICENSE NO. 190436
RFIDOC39

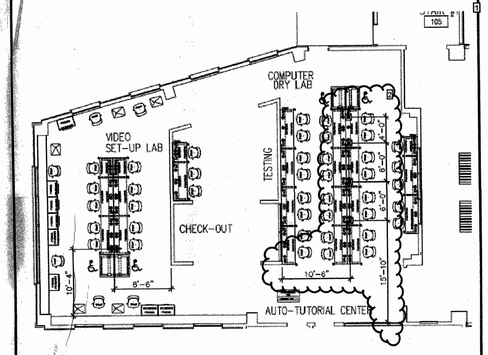

RFI 518

SCIENCE BUILDING
LOS MEDANOS COLLEGE
Pittsburg CA
Contra Costa Community College District
ARCHITECT tBP/Architecture 1000 Burnett Ave, Suite 140 Concord, CA 94520 p: 925.246.6419 f: 925.246.0480
architecture planning interiors management

REF: RFI 518
DATE: 5/31/07
DSA NO. 01-106226
THIS REVISES IN PART
SHEET: RE-2.2
SHEET: SKA-RFI 518.1

S. J. AMOROSO
Request For Information/Clarification

DSA FILE NO. 7-C1
DSA APPL. No. 01-106226

To: tBP/Architecture, 1000 Burnett Ave, Suite 140, Concord, CA 94520
Project: LOS MEDANOS COLLEGE SCIENCE BUILDING, Contra Costa Community College District
Attn: Celia Chiang, Tom Beckett
Fax: 925-246-6495
tBP job: 20247.00
Subj.: Bulletin #39 VAV Locations/Switch Clarification
RFI No: 396
Reference (dwg, spec.): Bulletin #39
Subcontractor RFI: EWS 50
Reply Requested By: 10/27/06

INFORMATION REQUESTED: Date: 10/20/06

Please note the attached EWS RFI No. 50 regarding the location and number of switches for the VAVs which are not shown in Bulletin No. 39. Please advise.

SUGGESTED SOLUTION:
Cost Impact: ☐ Schedule Impact: ☐ days By: Mark Delgado

RESPONSE: DATE:

It is TWF's recommendation that the transformer cabinets be located in mechanical room 123 and storage room 204. Final locations should be confirmed by mechanical.

It is TWF's understanding that each transformer shall be switched and that a transformer can be connected to more than one VAV box. This connection requirement shall be coordinated with mechanical.

Larry Lai/TWF - 10/23/06

Alan notes that I do not have anything to add to RFI 396 - Larry's response looks OK.

Dave Weston/MME - 10/24/06

RFI # 000
Page 1

EDWARD W. SCOTT ELECTRIC CO., INC.
435 HARRIET STREET
San Francisco, CA 94103-4914
Phone: (415) 626-0701 Fax: (415) 626-2837

REQUEST FOR INFORMATION

PROJECT: LMC SCIENCE BLDG. R.F.I.# 50 R.F.I. Date 10/20/06
JOB: 2451 ACTUAL REPLY DATE

TO: MARK DELGADO POTENTIAL COST IMPACT
OF: AMOROSO CONST. X COST ___ SCHEDULE
REF DWG: BULLETIN #39 ___ OTHER ___ LABOR
LOCATION: MDC ___ NO IMPACT ___ MATERIAL

INFORMATION REQUESTED: BULLETIN #39 REQUIRES TOWING TO EACH VAV, PLEASE PROVIDE THE LOCATION FOR THE TRANSFORMER SCHEDULE PANEL AND BREAKER CLOSEST. EDWARD SCOTT WILL PROVIDE THE CONDUIT & WIRING FOR THESE TRANSFORMERS UPON RECEIPT OF LOCATIONS.

ALSO WILL EACH TRANSFORMER BE SWITCHED OR EACH VAV? IT IS OUR UNDERSTANDING THAT ONE TRANSFORMER WILL POWER MORE THAN ONE VAV.

REPLY REQUIRED BY: 11/3/06 SIGNED:
NOTE: IF NO REPLY IS RECEIVED BY US BY THE ABOVE NOTED DATE, A TIME EXTENSION WILL BE REQUIRED WITH POSSIBLE COST IMPACTS.

RESPONSE:

DATED: SIGNED:

INDUSTRIAL, COMMERCIAL WIRING & DESIGN
STATE CONTRACTOR LICENSE NO. 190436
RFIDOC39

TWF RAMS 9/18/06

S. J. AMOROSO
Request For Information/Clarification

DSA FILE NO. 7-C1
DSA APPL. No. 01-106226

To: tBP/Architecture, 1000 Burnett Ave, Suite 140, Concord, CA 94520
Project: LOS MEDANOS COLLEGE SCIENCE BUILDING, Contra Costa Community College District
Attn: Celia Chiang, Tom Beckett
Fax: 925-246-6495
tBP job: 20247.00
Subj.: Disconnect Switches to VAV Boxes
RFI No: 350
Reference (dwg, spec.): Bulletin 39
Subcontractor RFI: Monterey 16
Reply Requested By: 9/25/06

INFORMATION REQUESTED: Date: 9/18/06

Please note the attached Monterey Mechanical RFI No. 16 regarding the disconnect switches, should these be located in the VAV box or the mechanical room. Please advise.

SUGGESTED SOLUTION:
Cost Impact: ☐ Schedule Impact: ☐ days By: Justin Warren

RESPONSE: DATE:

LOCATE TOGGLE SWITCHES ADJACENT TO GANGED 24 VOLT VAV TRANSFORMER WITH IDENTIFICATION LABEL MATCHED TO EACH TRANSFORMER.

Jim Bartlett 9-20-06

RFI # 000
Page 1

09/15/2006 11:12 925-757-8574 MONTEREY MECH ANDIOC PAGE 01/02

MONTEREY MECHANICAL
1620 Willow Ave, Pittsburg, CA 94565 • Phone: (925) 427-3400 • Fax: (925) 513-0529
ENGINEERING CONSTRUCTION

REQUEST FOR INFORMATION

PROJECT: LMC Science Building
MMC RFI #: 016
SUBJECT: Disconnect Switches to VAV Boxes
DATE REQUESTED: 9/15/2006

QUESTION

FROM: Dan Kliedmiller	TO: Mark G. Delgado-SJA	DATE: 9/15/2006

Reference Drawing:
Reference Specification:

RFI#39- Bgt is asking for the disconnect switches to be located at the vav boxes, the vav transformers are located in a transformer panel that is located in a mechanical room? Should the switches be installed at the transformer panel or the vav boxes?

-Question asked by CommAire

RESPONSE

FROM:	TO:	DATE:

PLEASE RESPOND AS SOON AS POSSIBLE

cc:File

09/15/2006 11:12 925-757-8574 MONTEREY MECH ANDIOC PAGE 02/02
PAGE 03/03

#016

Bulletin No.39

Date: 9/7/2006

To: S.J. Amoroso Construction
390 Bridge Parkway
Redwood shores CA 94065

Project: LOS MEDANOS COLLEGE SCIENCE BUILDING
Contra Costa Community College District
DSA No. 01-106226; File # 7-C1
tBP JOB# 20247.00

Description: REFERENCE: sheets M1.1 to M3.4, E2.1

Provide and install, for each 24 volt VAV transformer that is located in the VAV box controller on floors 2 and 3, a toggle type disconnect switch so that each VAV transformer can be isolated without having power all to the other boxes. Also each disconnect switch shall be labeled/identified to VAV box number.

For the *first floor* ceiline circuit "L1B-42"

For the *second floor* ceiline circuit "L2A-06".

Issued By: Architect
Requested By: Owner
Reason: Provide disconnect switch to each of the VAV box.
Enclosures: none

Distribution:

Copies:	Name:	Organization:
1 copy	Mark Delgado	S. J. Amoroso
1 copy	Cam Perrotta	CCCCDistrict
1 copy	Bob Harke	Inspector of Record
1 copy	Tom Beckett	tBP/Architecture
1 copy	File 20247.00/7.4	tBP/Architecture
1 copy	Larry Lai	Toft Wolff Farrow
1 copy	Dave Weston	AAME

Action:
- ☐ For Information/Clarification only
- ☒ Provide Price/Credit Proposal. (Refer to this Bulletin No. when responding)
- ☐ Requires DSA review and approval
- ☐ Proceed as authorized by District

tBP/Architecture 1000 Burnett Ave, Suite 140 Concord, CA 94520 ph: 925.246.6419 fax: 925.246.0480

Los Medanos College
4CD Proj.# : 1-565-B-23-SC
Science Building

SHEET NOTES

1. 8'Hx3/4" THICK PLYWOOD TELEPHONE BACKBOARD, ON (3) WALLS OF ROOM. REFER TO TELCOM DRAWING T3.1.
2. REFER TO "ELECTRICAL LABORATORY DRAWING" FOR ADDITIONAL ELECTRICAL REQUIREMENTS IN THIS ROOM.
3. 120V JUNCTION BOX WITH TRANSFORMER (BY OTHERS) FOR FLUSH VALVE SENSOR.
4. 120V JUNCTION BOX FOR FAUCET MOTION SENSOR.
5. JUNCTION BOX FOR FLUSH VALVE SENSOR.
6. STUB (2)1 1/4"C FROM (2) 2-GANG OUTLET BOX INTO ACCESSIBLE CEILING SPACE, +6". OUTLET BOX MOUNTED AT +18" AFF.
7. STUB (1)3/4"C FROM 1-GANG OUTLET BOX INTO ACCESSIBLE CEILING SPACE, +6". OUTLET BOX MOUNTED AT +48" AFF.
8. CEILING MOUNTED DOUBLE DUPLEX RECEPTACLE FOR PROJECTOR AND A/V EQUIPMENT. COORDINATE LOCATION OF RECEPTACLE WITH A/V VENDOR REQUIREMENTS.
9. 4" SQ. JUNCTION BOX FOR AUTOMATIC DOOR PUSH PLATE (BY OTHERS).
10. SINGLE GANG JUNCTION BOX FOR AUTOMATIC DOOR OPERATOR. COORDINATE LOCATION OF AUTOMATIC DOOR OPERATOR WITH MANUFACTURER REQUIREMENTS.
11. DISCONNECT SWITCH MOUNTED AJACENT TO EQUIPMENT CONTROL PANEL. COORDINATE LOCATION WITH MECHANICAL.
12. 20"x4" COPPER GROUND BUS BAR. MOUNT AT +6"-6" AFF. ROUTE AND CONNECT 1 1/2"C-1#1/0G. FROM BUS BAR TO GROUND BUS OF PANEL 'L1A'. REFER TO TELCOM DRAWING T3.1.
13. 60A, 4 POLE, 300V WITH GROUND, STARLINE BUSWAY SYSTEM WITH 60A 'END' POWER FEED AND THE FOLLOWING:
    a. PLUG-IN BUSWAY STRAIGHT SECTION AT +8'-2" AFF.
    b. BUSWAY SUPPORT ASSEMBLY TO SUSPEND BUSWAY FROM BACK-TO-BACK 'U' CHANNEL OF GRID ABOVE.
    c. BUSWAY END CAP.


    COORDINATE LOCATION AND LENGTH OF STARLINE BUSWAY WITH TELCOM DRAWING T3.1.
14. DOUBLE SNAKETRAY IN CEILING SPACE, SEE DETAIL H, SHEET E4.2 FOR SIZE AND SUPPORT OF SNAKETRAY.
15. SINGLE SNAKETRAY IN CEILING SPACE, SEE DETAIL H, SHEET E4.2 FOR SIZE AND SUPOORT OF SNAKETRAY.
16. CEILING MOUNTED DATA OUTLET FOR PROJECTOR AND A/V EQUIPMENT. COORDINATE LOCATION OF OUTLET WITH A/V VENDOR REQUIREMENTS. STUB (1) 3/4"C FROM OUTLET TO SNAKETRAY IN ACCESSIBLE CEILING SPACE.
17. RECESSED FLOOR BOX, WIREMOLD #RFB4. STUB (2) 1"C FROM FLOOR BOX TO SNAKETRAY IN ACCESSIBLE CEILING SPACE. RECEPTACLE/CIRCUIT IN FLOOR BOX PER 'ELECTRICAL LABORATORY DRAWINGS'.
18. RECESSED FLOOR BOX, WIREMOLD #RFB4. STUB (2) 1"C FROM FLOOR BOX TO SNAKETRAY IN ACCESSIBLE CEILING SPACE. (2) DUPLEX RECEPTACLE INSTALLED IN FLOOR BOX.
19. 1-GANG MUD RING FOR A/V SYSTEM WALL SPEAKER (BY OTHERS) MOUNT 1-GANG MUD RING AT +105" AFF. MOUNTING LOCATION SHALL BE COORDINATED WITH A/V CONTRACTOR.
20. RECESSED FLOOR BOX WITH (1) DUPLEX RECEPTACLE AND (2) DATA OUTLETS. MYSTERY ELECTRONICS #FMCA-3000 SERIES/3488-BR WITH #BB3000D6 BACKBOX (FOR AV USE). REFER TO LABORATORY ELECTRICAL DRAWINGS FOR CIRCUIT NUMBER TO DUPLEX RECEPTACLE IN MYSTERY FLOOR BOX. STUB (2) 1 1/4"C INTO ACCESSIBLE CEILING SPACE +6".
21. RECESSED FLOOR BOX, WIREMOLD #SAF-2 1/2. (DATA ONLY, SEE TELCOM DRAWINGS).
22. RECESSED FLOOR BOX, WIREMOLD #SAF-2 1/2 WITH (2) DUPLEX RECEPTACLES, AND DATA OUTLETS (SEE TELCOM DRAWINGS).
23. DATA MONUMENT (PER TELCOM DRAWINGS) MOUNTED ON WORK SURFACE. ROUTE 1"C FROM DATA MONUMENT INTO FLOOR SLAB, VIA WORK SURFACE CHASE, AND STUB CONDUIT INTO RAISED FLOOR AREA.
24. POWER MONUMENT, WATER SAVER #ES00PB-WS WITH DOUBLE DUPLEX RECEPTACLE AND COVERPLATE. POWER MONUMENT MOUNTED ON WORK SURFACE ADJACENT TO DATA MONUMENT. (SEE SHEET NOTE #23).
25. SEE BULLETIN 49
    DUPLEX RECEPTACLES (FURNISHED BY OTHERS), LEAVE 6' PIGTAIL AT EACH RECEPTACLE LOCATION. FINAL CONNECTION TO RECEPTACLE BY ELECTRICAL CONTRACTOR.
26. SEE EFI 316
    RECESSED WALL DUCT, WIREMOLD #WDOW350 WITH REMOVAL COVERPLATE. WHERE WALL DUCT RISES ABOVE ROOM CEILING GRID, INSTALL ONE ACCESS COVER PLATE #WDOG-ACPS (FOR ACCESS OF TELCOM CABLES FROM FLOOR TO SNAKETRAY IN CEILING SPACE). AT FLOOR LEVEL INSTALL ONE SWEEP TEE (FOR ACCESS OF TELCOM CABLES FROM RAISED FLOOR AREA TO CEILING SPACE).

ALL OUTLET LOCATIONS PER RFI 353, SHEET RE-2.1
SEE SHEET 2 OF 2.E.1 FROM KT.

NOTE: CONDUIT STUBS AT FIRST FLOOR PERIMETER TO REMAIN. PROVIDE SURFACE MOUNTED RACEWAY TO ROUTE FROM STUB TO LOCATIONS SHOWN. SEE BULLETIN 18

18	3/22/06	BULLETIN #18
15	3/20/06	BULLETIN #15
13	3/07/06	BULLETIN #13

PLAN

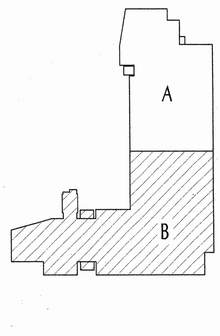

Bulletin No.15A Amended

t-BP architecture planning interiors management

Date: May 1, 2006

To: S.J. Amoroso Construction
260 Bridge Parkway
Redwood shores CA 94065

Project: LOS MEDANOS COLLEGE SCIENCE BUILDING
Contra Costa Community College District
DSA No. 15-106226; File # 7-C1
tBP TPN 20247.00

Description:
REFERENCE: Bulletin #15A, SKE-15.2:

Text of Note 28 is to be deleted and replaced with the following text:

"Backbox and conduit in demountable wall panels provided by manufacturer of demountable wall. Electrical Contractor shall provide and install conduit and wiring to top of the demountable wall above the ceiling and shall provide and install wiring, receptacles and coverplates in the demountable wall."

Issued By: Architect
Requested By: Architect
Reason: Clarification to powerdata requirement at de-mountable walls
Enclosures: none
Distribution:

Copies:	Name:	Organization:
1 copy	Mark Delgado	S. J. Amoroso
1 copy	Cam Pereira	CCCCDistrict
1 copy	Bob Hanke	Inspector of Record
1 copy	Larry Lai	Toll Wolff Farrow
1 copy	John Lambert	Infrastructure Design Associates
1 copy	Tom Beckett	tBP/Architecture
1 copy	File 20247.007.4	tBP/Architecture

Action:
☒ For Information/Clarification only
☐ Provide Price/Credit Proposal. (Refer to this Bulletin No. when responding)
☐ Requires DSA review and approval
☐ Proceed as authorized by District

tBP/Architecture 1000 Burnett Ave. Suite 140 Concord, CA 94520 p. 925.246.6495 f. 925.246.6495

tBP architecture planning interiors management

tBP/Architecture
1000 Burnett Avenue, Suite 140
Concord, CA 94520
p. 925.246.6495 f. 925.246.6495

CONSULTING ENGINEERS
Toff Wolff Farrow Inc.
325 Second Street, Suite 100
San Francisco, CA 94105
(415) 247-8700
FAX (415) 247-8701
twfsf@twfsf.com

DSA DISTRIBUTION STAMP
DIV. OF THE STATE ARCHITECT
OFFICE OF REGULATION SERVICES
APPL. # 05-106226
K. RS SS
DATE

name
address
city, state, zip
ph.
fx

SCIENCE BUILDING
LOS MEDANOS COLLEGE
Contra Costa Community College District

tBP project number: 20247.00
file name: 1s-FLR-A
drawn by: LLAI checked by: LSH
date: NOVEMBER 15, 2004

1	3/18/05	ADDENDUM #1
2	4/19/05	ADDENDUM #2
3	2/10/06	BULLETIN #9
10		BULLETIN #10 D B

drawing title:
1st FLOOR PLAN
PART "B" - POWER/SIGNAL

LMC SCIENCE 313-023-112.01-0-00.00
drawing no.
RE-2.2

SEE ALSO E-2.2 FOR AS-BUILT ADDITIONS

1ST FLOOR PLAN PART "B" SCALE: 1/8"=1'-0" 1

TWF #03058.00

Bulletin No.09

Date: February 24, 2006

To: S.J.Amoroso Construction
390 Bridge Parkway
Redwood shores CA 94065

Project: LOS MEDANOS COLLEGE SCIENCE BUILDING
Contra Costa Community College District
DSA No. 01-106226; File # 7-C1
IBP P/N 20247.00

Description: REFERENCE: Submittal#33, Submittal #38:

1. Due to the basis-of-design chiller being discontinued, and the submittal of the York Millennium Chiller per Submittal #33, the following electrical requirements are revised:

Electrical service revised to 'C1'

2. Due to the basis-of-design ducted split-system air conditioners being discontinued and the submittal of the units per Submittal #38, the following electrical requirements are revised:

Electrical service revised to 'CU1', 'ACU1', 'CU2', and 'ACU2'. See attached sketches SKB-09.1 to SKE-09.5 for details.

Issued By: Architect

Requested By: Design team

Reason: Change in electrical requirements per discontinued basis-of-design equipment


Enclosures: SKE-09.1 to SKB-09.8

Distribution:

Copies:	Name:	Organization:
1 copy	Mark Delgado	S. J. Amoroso
1 copy	Cass Parrotta	S.C.C.C.D.
1 copy	Bob Harke	Inspector of Record
1 copy	Tom Beckett	tBPArchitecture
1 copy	File 20247.007.4	tBPArchitecture
1 copy	Larry Lai	Toft Wolff Farrow, Inc.
1 copy	Dave Western	Allsworth Associates

Action:
- ☐ For Information/Clarification only
- ☒ Provide Price/Credit Proposal. (Refer to this Bulletin No. when responding)
- ☐ Requires DSA review and approval
- ☐ Proceed as authorized by District

tBPArchitecture, 1000 Burnett Ave, Suite 140 , Concord, CA 94520

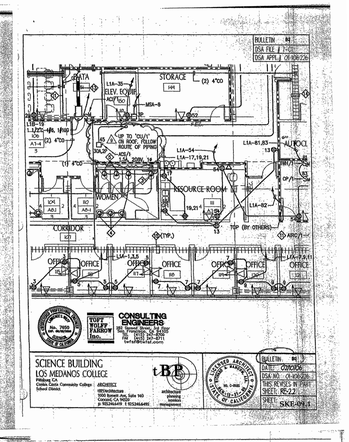

S. J. AMOROSO
Request For Information/Clarification

DSA FILE NO. 7-C1
DSA APPL. No. 01-106226

To: tBPArchitecture, 1000 Burnett Ave, Suite 140, Concord, CA 94520
Attn: Celia Chiang, Tori Beckett
Fax: 925-246-6496

Project: LOS MEDANOS COLLEGE SCIENCE BUILDING, Contra Costa Community College District
tBP p/n: 20247.00

Subj.: Wall Mounted Data vs. Floor Boxes in Room 102
Reference (dwg, spec.) E-2.2, T1-2
Reply Requested By: 3/3/06

RFI No: 158
Subcontractor RFI: EWS 9

Date: 2/23/06

INFORMATION REQUESTED:

Please note the attached Scott Electric RFI No. 9 regarding Drawing E-2.2 depicting 9 wall mounted data outlets in the testing checkout section of Room 102. Drawings T1-2 shows 9 floor boxes with #15 and #19 located in the walk way between the chairs. Which is correct. Please advise.

SUGGESTED SOLUTION:

Cost Impact: ☐ Schedule Impact: ☐ days By: Mark Delgado

RESPONSE: DATE: 3-3-06

'15' floor boxes as shown on T1-2 are correct.
Provide credit for (6) wall-mounted data outlets shown on E2.2 not required.
Future Bulletin issued on Access floor submittal will show exact location of floor boxes with floor grid.

Attachments:

By: C. Chiang/tBP

TRANSMITTAL RECORD:

FROM	TO	DATE
S.J.AMOROSO	tBP / ARCHITECTURE	2/23/06
tBP / ARCHITECTURE	ENGINEER/CONSULTANT TWP/SSA	2.23.06
ENGINEER/CONSULTANT	tBP / ARCHITECTURE	2.27.06
tBP / ARCHITECTURE	S.J. AMOROSO	3.3.06
S.J. AMOROSO	ORIGINATOR	

RFI # 000
Page 1

EDWARD W. SCOTT ELECTRIC CO., INC.
435 HARRIET STREET
San Francisco, CA 94103-4914
Phone: (415) 626-0701 Fax: (415) 626-2837

REQUEST FOR INFORMATION

LMC
PROJECT: SCIENCE BLDG. R.F.I.# 9 R.F.I. Date 2/21/06
JOB: 2451 ACTUAL REPLY DATE

TO: MARK DELGADO
OF: AMOROSO CONST.
REF DWG: E-2.2 T1-2
LOCATION: RM 102 TESTING CHECK-OUT

POTENTIAL COST IMPACT
___ COST ___ SCHEDULE
___ OTHER ___ LABOR
NO IMPACT ___ MATERIAL

INFORMATION REQUESTED: DWG. E-2.2 DEPICTS 9 WALL MTD. DATA OUTLETS IN THE TESTING SUBSECTION OF RM. 102. ALSO THE DRAWING'S FLOOR BOXES WITH #15 & #19 LOCATED IN THE WALK WAY BETWEEN THE CHAIRS. WHICH IS CORRECT?

REPLY REQUIRED BY: 2/27/06 SIGNED: MC
NOTE: IF NO REPLY IS RECEIVED BY US BY THE ABOVE NOTED DATE, A TIME EXTENSION WILL BE REQUIRED WITH POSSIBLE COST IMPACTS.

RESPONSE:

DATED: SIGNED:

INDUSTRIAL, COMMERCIAL WIRING & DESIGN
STATE CONTRACTOR LICENSE NO. 190426

SHEET NOTES

1. 8'H x 3/4" THICK PLYWOOD TELEPHONE BACKBOARD, ON (3) WALLS OF ROOM.
2. REFER TO "ELECTRICAL LABORATORY DRAWING" FOR ADDITIONAL ELECTRICAL REQUIREMENTS IN THIS ROOM.
3. 120V JUNCTION BOX WITH TRANSFORMER (BY OTHERS) FOR FLUSH VALVE SENSOR.
4. 120V JUNCTION BOX FOR FAUCET MOTION SENSOR.
5. JUNCTION BOX FOR FLUSH VALVE SENSOR.
6. STUB (2)1 1/4"C FROM 4-GANG OUTLET BOX INTO ACCESSIBLE CEILING SPACE, +6".
7. STUB (1)3/4"C FROM 1-GANG OUTLET BOX INTO ACCESSIBLE CEILING SPACE, +6".
8. DUPLEX RECEPTACLE FOR CEILING MOUNTED PROJECTOR. RECEPTACLE FOR PROJECTOR INSTALLED IN CEILING SPACE. COORDINATE EXACT LOCATION OF PROJECTOR WITH ARCHITECT 'RCP' DRAWINGS.

SHEET NOTES

1. 4" SQ. JUNCTION BOX FOR AUTOMATIC DOOR PUSH PLATE (BY OTHERS).
2. SINGLE GANG JUNCTION BOX FOR AUTOMATIC DOOR OPERATOR. COORDINATE LOCATION OF AUTOMATIC DOOR OPERATOR WITH MANUFACTURER REQUIREMENTS.
3. DISCONNECT SWITCH MOUNTED AJACENT TO EQUIPMENT CONTROL PANEL. COORDINATE LOCATION WITH MECHANICAL.

SHEET NOTES

1. 87Hx3/4" THICK PLYWOOD TELEPHONE BACKBOARD, ON (3) WALLS OF ROOM. REFER TO TELCOM DRAWING T3.1.
2. DUPLEX RECEPTACLE FOR CEILING MOUNTED PROJECTOR. COORDINATE EXACT LOCATION OF RECEPTACLE WITH PROJECTOR REQUIREMENTS.
3. 20"x4" COPPER GROUND BUS BAR. MOUNT AT +6'-6" AFF. ROUTE AND CONNECT 1 1/2"C-1#1/0G. FROM BUS BAR TO GROUND BUS OF PANEL 'L1A'. REFER TO TELCOM DRAWING T3.1.
4. 60A, 4 POLE, 300V WITH GROUND, STARLINE BUSWAY SYSTEM WITH 60A 'END' POWER FEED AND THE FOLLOWING:
   a. PLUG-IN BUSWAY STRAIGHT SECTION AT +8'-3" AFF.
   b. BUSWAY SUPPORT ASSEMBLY TO SUSPEND BUSWAY FROM BACK-TO-BACK 'U' CHANNEL OF GRID ABOVE.
   c. BUSWAY END CAP.

   COORDINATE LOCATION AND LENGTH OF STARLINE BUSWAY WITH TELCOM DRAWING T3.1.
5. DOUBLE SNAKETRAY IN CEILING SPACE, SEE DETAIL H, SHEET E4.2 FOR SIZE AND SUPPORT OF SNAKETRAY.
6. SINGLE SNAKETRAY IN CEILING SPACE, SEE DETAIL H, SHEET E4.2 FOR SIZE AND SUPPORT OF SNAKETRAY.
7. CEILING MOUNTED DATA OUTLET FOR PROJECTOR. COORDINATE LOCATION OF OUTLET WITH PROJECTOR REQUIREMENTS. STUB (1) 3/4"C FROM OUTLET TO SNAKETRAY IN ACCESSIBLE CEILING SPACE.
8. RECESSED FLOOR BOX, WIREMOLD #RFB4. STUB (2) 1"C FROM FLOOR BOX TO SNAKETRAY IN ACCESSIBLE CEILING SPACE. RECEPTACLE/CIRCUIT IN FLOOR BOX PER 'ELECTRICAL LABORATORY DRAWINGS'.
9. RECESSED FLOOR BOX, WIREMOLD #RFB4. STUB (2) 1"C FROM FLOOR BOX TO SNAKETRAY IN ACCESSIBLE CEILING SPACE. (1) DUPLEX RECEPTACLE INSTALLED IN FLOOR BOX.

ADDENDUM #1
DSA FILE # 7-C1
DSA APPL # 01-106226

ADDENDUM #2
DSA FILE # 7-C1
DSA APPL # 01-106226

CONSULTING ENGINEERS
TOFT WOLFF FARROW Inc.
925 Tyrrell Street, 1st Floor
San Francisco, CA 94129
TEL (415) 241-8700
FAX (415) 241-8711
twfsf@twfsf.com

SCIENCE BUILDING
LOS MEDANOS COLLEGE
Pittsburg CA
Contra Costa Community College School District
ARCHITECT
tBP Architecture
1500 Bunsen Ave, Suite 140
Concord, CA 94520
p 925.246.6499 f 925.246.6495
architecture planning interiors management

ADDENDUM #1
DATE: 05/06/05
DSA NO. 01-106226
THIS REVISES IN PART
SHEET: RE-2.2
SHEET: RE-3

ADDENDUM #1
DATE: 05/06/05
DSA NO. 01-106226
THIS REVISES IN PART
SHEET: RE-2.2
SHEET: RE-2

ADDENDUM #1
DATE: 05/06/05
DSA NO. 01-106226
THIS REVISES IN PART
SHEET: RE-2.2
SHEET: RE-4

ADDENDUM #2
DATE: 06/06/05
DSA NO. 01-106226
THIS REVISES IN PART
SHEET: RE-2.2
SHEET: RE-11

ADDENDUM #2
DATE: 06/06/05
DSA NO. 01-106226
THIS REVISES IN PART
SHEET: RE-2.2
SHEET: RE-13

ADDENDUM #2
DATE: 06/06/05
DSA NO. 01-106226
THIS REVISES IN PART
SHEET: RE-2.2
SHEET: RE-12

ADDENDUM #1
DATE: 05/06/05
DSA NO. 01-106226
THIS REVISES IN PART
SHEET: RE-2.2
SHEET: RE-5

DIV. OF THE STATE ARCHITECT
APP. - 01-106226
DATE 4/6/05

name
address
city, state, zip
ph:
fx:
agency

SCIENCE BUILDING
LOS MEDANOS COLLEGE
Contra Costa Community College District
owner

tBP project number : 20241.00
file name: 1s-FLR-A
drawn by: LLAI checked by: LSW
date: NOVEMBER 15, 2004

Rev	date:	description

drawing title:
1st FLOOR PLAN
PART "B" - POWER/SIGNAL

LMC SCIENCE 313-023-112.01-0-00.00
drawing no:
E-2.2
SEE SHEET RE-2.2

1ST FLOOR PLAN PART "B" 1
SCALE: 1/8"=1'-0"

TWF #03058.00

Bulletin No.36

IBP Architecture Planning Interior Graphics Management

Date: June 8, 2006

To: S.J. Amoroso Construction
390 Bridge Parkway
Redwood shores CA 94065

Project: LOS MEDANOS COLLEGE SCIENCE BUILDING
Contra Costa Community College District
DSA No. 01-106226; File # 7-C1
IBP PIN 20247.00

Description: REFERENCE: Drawing A0-2, Spec Section 07840 – Firestopping, Bulletin #36D, Submittal #70 – Under Floor Boxes.

1-hour firestopping floorjoint assemblies apply to all floor boxes in or penetrating 1-hour rated Second Floor Slab including the followings.

1. For 1-hour rated floorjoint assemblies at poke thru and Wiremold RFP4 floor boxes, refer to engineering Judgments from Hilti 65475a and 65471a for details. Refer to Bulletin #36D for locations of poke thru and Wiremold RFP4 boxes.

   Per spec section 07840, no addition cost to owner for firestopping at poke thru and Wiremold RFP4 boxes in this line item shall apply.

2. For 1-hour rated assemblies at Mystery Electronics Floor Boxes, refer to engineering Judgments from Hilti 65472a for details. Refer to Bulletin #35D for locations of (4) total Mystery Electronic Floor Boxes.

Refer to A0-2 in Contract Document for detail "Area Required for 1-hour Occupancy Separation" for 1-hour rated Second Floor slab area. Contractor to coordinate where 1-hour rated floorjoint assemblies at poke thru and floor boxes are required. Provide submittal to firestopping assemblies listed above.

cc: BW Scott
Y.L.

Issued By: Architect

Requested By: Architect, Owner

Reason: A/V coordination

Enclosures: Hilti Engineering Judgments Firestop details drawings no. 65470a, 65471a and 65472a.

Distribution:

Copies:	Name:	Organization:
1 copy	Mark Delgado	S. J. Amoroso
1 copy	Cam Pezzotta	CCCCCDistrict
1 copy	Bob Harke	Inspector of Record
1 copy	Tom Beckett	IBPArchitecture


BULLETIN # 36
LOS MEDANOS COLLEGE SCIENCE BUILDING

1 copy	File 20247.00/7.4	IBP/Architecture
1 copy	Larry Lai	TWF
1 copy	John Lambert	IDA
1 copy	Richard Cate	RJFD
1 copy	Jim Cooley	Michael Wall Engineering
1 copy	Veronica Roussel	Stamsellis

Action:
- ☒ For Information/Clarification only
- ☒ Provide Price/Credit Proposal to line item #2 only (Refer to this Bulletin No. when responding)
- ☐ Requires DSA review and approval .
- ☐ Proceed as authorized by District

GB

ENGINEERING JUDGMENT FIRESTOP DETAIL
PROJECT : LMC SCIENCE BUILDING
ARCHITECT : TBP ARCHITECTURE
F-RATING = 1-HR.

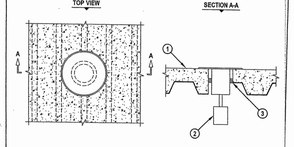

1. CONCRETE (MINIMUM 3-1/4" THICK) OVER METAL DECK ASSEMBLY (1-HR. FIRE-RATING).
2. MAXIMUM 4 NOMINAL DIAMETER POKE THRU DEVICE SECURELY ATTACHED TO CONCRETE FLOOR
3. MINIMUM 1" DEPTH HILTI FS-ONE INTUMESCENT FIRESTOP SEALANT INSTALLED WITHIN PLANE OF FLOOR.

NOTE : ANNULAR SPACE = MINIMUM 1/4", MAXIMUM 1/2".

THIS ENGINEERING JUDGMENT REPRESENTS A FIRESTOP SYSTEM THAT WOULD BE EXPECTED TO PASS THE STATED RATINGS IF TESTED [REFERENCE : UL/cUL SYSTEM NO. CAJ-1154]

HILTI, Inc. Tulsa, Oklahoma USA (918) 252-6000

Designed by: Jonathan D. Mathew, CFPS


Sheet 1 of 1 | Scale 7/64" = 1" | Date June 2, 2006 | Drawing 6547

Hilti Firestop Systems

Saving Lives through Innovation and Education

GB

ENGINEERING JUDGMENT FIRESTOP DETAIL
PROJECT : LMC SCIENCE BUILDING
ARCHITECT : TBP ARCHITECTURE
F-RATING = 1-HR. (SEE NOTE NO. 2 BELOW)

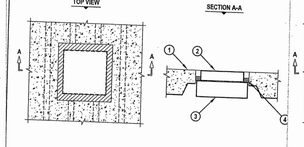

1. CONCRETE (MINIMUM 3-1/4" THICK) OVER METAL DECK ASSEMBLY (1-HR. FIRE-RATING).
2. STEEL FLOOR BOX (MAXIMUM SIZE: 19-1/2" x 19-3/4" x 2-1/2" DEEP). (MYSTERY ELECTRONICS)
3. STEEL BACK BOX (MAXIMUM SIZE: 12-1/2" x 12" x 4").
4. MINIMUM 1" DEPTH HILTI FS-ONE INTUMESCENT FIRESTOP SEALANT INSTALLED WITHIN PLANE OF FLOOR.

NOTES : 1. ANNULAR SPACE = MINIMUM 1/4", MAXIMUM 1/2".
2. FIRE-RATING IS ONLY AS GOOD AS PERFORMANCE OF STEEL FLOOR BOX UNDER FIRE CONDITIONS.

THIS ENGINEERING JUDGMENT REPRESENTS A FIRESTOP SYSTEM THAT WOULD BE EXPECTED TO PASS THE STATED RATINGS IF TESTED [REFERENCE : UL/cUL SYSTEM NO. CAJ-1154]

HILTI, Inc. Tulsa, Oklahoma USA (918) 252-6000

Designed by: Jonathan D. Mathew, CFPS


Sheet 1 of 1 | Scale 7/64" = 1" | Date June 2, 2006 | Drawing 6547

Hilti Firestop Systems

Saving Lives through Innovation and Education

GB

ENGINEERING JUDGMENT FIRESTOP DETAIL
PROJECT : LMC SCIENCE BUILDING
ARCHITECT : TBP ARCHITECTURE
F-RATING = 1-HR. (SEE NOTE NO. 2 BELOW)

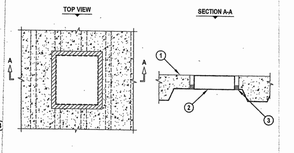

1. CONCRETE (MINIMUM 3-1/4" THICK) OVER METAL DECK ASSEMBLY (1-HR. FIRE-RATING).
2. STEEL FLOOR BOX (MAXIMUM SIZE: 10" x 12" x 3-7/16" DEEP). (RFP4-A)
3. MINIMUM 1" DEPTH HILTI FS-ONE INTUMESCENT FIRESTOP SEALANT INSTALLED WITHIN PLANE OF FLOOR.

NOTES : 1. ANNULAR SPACE = MINIMUM 1/4", MAXIMUM 1/2".
2. FIRE-RATING IS ONLY AS GOOD AS PERFORMANCE OF STEEL FLOOR BOX UNDER FIRE CONDITIONS.

THIS ENGINEERING JUDGMENT REPRESENTS A FIRESTOP SYSTEM THAT WOULD BE EXPECTED TO PASS THE STATED RATINGS IF TESTED [REFERENCE : UL/cUL SYSTEM NO. CAJ-1154]

HILTI, Inc. Tulsa, Oklahoma USA (918) 252-6000

Designed by: Jonathan D. Mathew, CFPS

Sheet 1 of 1 | Scale 7/64" = 1" | Date June 2, 2006 | Drawing 6547

Hilti Firestop Systems

Saving Lives through Innovation and Education

S. J. AMOROSO
Request For Information/Clarification

DSA FILE NO. 7-C1
DSA APPL. No. 01-106226

To: IBP/Architecture
1000 Burnett Ave, Suite 140
Concord, CA 94520

Attn: Celia Chiang, Tom Beckett
Fax: 925-246-6495

Project: LOS MEDANOS COLLEGE SCIENCE BUILDING
Contra Costa Community College District

IBP pin: 20247.00

Subj.: Bulletin 10D Box Location Clarification — **RFI No:** 248 — Subcontractor RFI: EWS 21

Reference (dwg, spec.) : Bulletin 10D

Reply Requested By: 6/21/06

INFORMATION REQUESTED: Date: 6/14/06

Please note the attachd Edward W. Scott RFI regarding the RFB4 Box location next to the Mystery Electric Box in Room 245 which has been deleted per EWS's conversation with TPB. Please confirm.

SUGGESTED SOLUTION:

Cost Impact: ☐ **Schedule Impact:** ☐ days **By:** Mark Delgado

RESPONSE: **DATE:** 6/14/06
IBP recommends that the subject 'RFB4' box be deleted, due to not being required.
Larry Lai/TWF
Provide credit to the (1) deleted RFB4 box, conduit and all the related service to this box.
Veronica Lind
Attachments:

By:

TRANSMITTAL RECORD:

FROM	TO	DATE
S.J. AMOROSO	IBP / ARCHITECTURE	6/14/06
IBP / ARCHITECTURE	ENGINEER/CONSULTANT	6/14/06
ENGINEER/CONSULTANT	IBP / ARCHITECTURE	6/14/06
IBP / ARCHITECTURE	S.J. AMOROSO	6/14/06
S.J. AMOROSO	ORIGINATOR	

S. J. AMOROSO
Request For Information/Clarification

DSA FILE NO. 7-C1
DSA APPL. No. 01-106226

To: IBP/Architecture
1000 Burnett Ave, Suite 140
Concord, CA 94520

Attn: Celia Chiang, Tom Beckett
Fax: 925-246-6495

Project: LOS MEDANOS COLLEGE SCIENCE BUILDING
Contra Costa Community College District

IBP pin: 20247.00

Subj.: Location of VFD's for EF 1 and EF 2 — **RFI No:** 523 — Subcontractor RFI: :

Reference (dwg, spec.): M3.1, E2-6, RE2-3

Reply Requested By: 6/11/07

INFORMATION REQUESTED: Date: 6/4/07

Per response to RFI 396, the VFD's for EF 1 and EF 2 are to be located on the roof adjacent to the exhaust fans. However, this would require an expensive NEMA 3R enclosure. A more cost efficient solution would be to locate these VFD's on the west wall of electrical room 239. The much more modest costs associated with this would for some conduit/wiring and disconnect switches added at the two exhaust fans. We understand from consultation with the mechanical engineer (who in turn consulted the electrical engineer) that this is an agreeable solution. Please confirm.

SUGGESTED SOLUTION:

Cost Impact: ☐ **Schedule Impact:** ☐ days **By:** Justin Warren

RESPONSE: **DATE:**

No exception taken to mount EF-1 & EF-2 VFD's in electrical room 239 at location that provides proper clearances.

EF's still require local disconnect swithces (NEMA 3R enclosures) at the unit.

All costs and credits should be reviewed with owners representative at next site meeting if CPE has not yet been issued.

Jim Weaver / IBP Architecture
D. Weston / Ainsworth Associates
L. Lai / TWF

5/7/07

SEE SHEET RE2.1 FOR TEXT OF BULLETIN

BULLETIN #40
DSA FILE # 7-C1
DSA APPL # 01-106226

SHEET NOTES

1. REFER TO "ELECTRICAL LABORATORY DRAWING" FOR ADDITIONAL ELECTRICAL REQUIREMENTS IN THIS ROOM.
2. RECESSED FLOOR BOX, WIREMOLD #RFB4 WITH LPB OPEN SYSTEMS BEZEL FOR TELCOM JACKS. STUB (2)1"C FROM FLOOR INTO CEILING SPACE OF THE FIRST FLOOR. RECEPTACLE/CIRCUIT IN FLOOR BOX PER "ELECTRICAL LABORATORY DRAWING.
3. CEILING MOUNTED DOUBLE DUPLEX RECEPTACLE FOR PROJECTOR AND A/V EQUIPMENT. COORDINATE LOCATION OF RECEPTACLE WITH A/V VENDOR REQUIREMENTS.
4. JUNCTION BOX FOR MOTORIZED WINDOW SHADE. LETTER ADJACENT TO OUTLET BOX DESIGNATES WHICH SHADES ARE CONTROLLED BY THE WINDOW SHADE CONTROLLER.
5. WINDOW SHADE CONTROL BOX FOR MOTORIZED WINDOW SHADES. LETTER INDICATES WHICH SHADES ARE CONTROLLED BY THE WINDOW SHADE CONTROLLER.
6. CONTROL SWITCH FOR MOTORIZED SHADES. (A) CONTRACTOR SHALL ROUGH-IN OUTLET BOX FOR SWITCH (2-GANG BOX). SWITCH FURNISHED BY VENDOR, INSTALLED AND CONNECTED BY CONTRACTOR.
7. STUB (2) 1 1/4"C FROM (2) 3-GANG OUTLET BOX INTO ACCESSIBLE CEILING SPACE, +8'. OUTLET BOX MOUNTED AT +18" AFF.
8. STUB (1) 3/4"C FROM 1-GANG OUTLET BOX INTO ACCESSIBLE CEILING SPACE, +8'. OUTLET BOX MOUNTED AT +48" AFF.
9. ROUTE HOMERUN TO RESPECTIVE MOTORIZED WINDOW SHADE CONTROL BOX.
10. (A) CONNECT CONTROL SWITCH "A-2" TO MOTORIZED WINDOW SHADE CONTROL BOX "F-0" WITH A (6) CONDUCTOR LOW VOLTAGE FLAT 28GA. MODULAR CABLE.

VOIT BUILDING SCIENCE CONSULTING ENGINEERS
VOIT, BUILTZ, PARSONS
1901 Harrison St., Suite 1100, Oakland, CA 94612
TEL: (510) 267-3000 FAX: (510) 267-3011
VoitEngineering.com


SCIENCE BUILDING
LOS MEDANOS COLLEGE
Pittsburg, CA
Contra Costa Community College District (District)


tBP ARCHITECTURE
1000 Burnett Ave, Suite 140
Concord, CA 94520
p 925/246-6495 f 925/246-6495
architecture planning interior design management

REGISTERED ARCHITECT No. C-19861 STATE OF CALIFORNIA

BULLETIN #40
DATE: 05/24/06
DSA NO. 01-106226
THIS REVISED IN PART
SHEET: RE-2.2
SHEET: SKE-40.5

BULLETIN #40
DSA FILE # 7-C1
DSA APPL # 01-106226

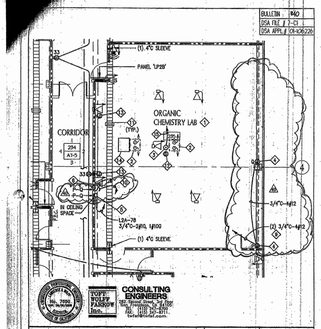
(1) 4"C SLEEVE
PANEL 'LP3B'
CORRIDOR
ORGANIC CHEMISTRY LAB
(TYP.)
2RFB4
2RFB4
2RFB4

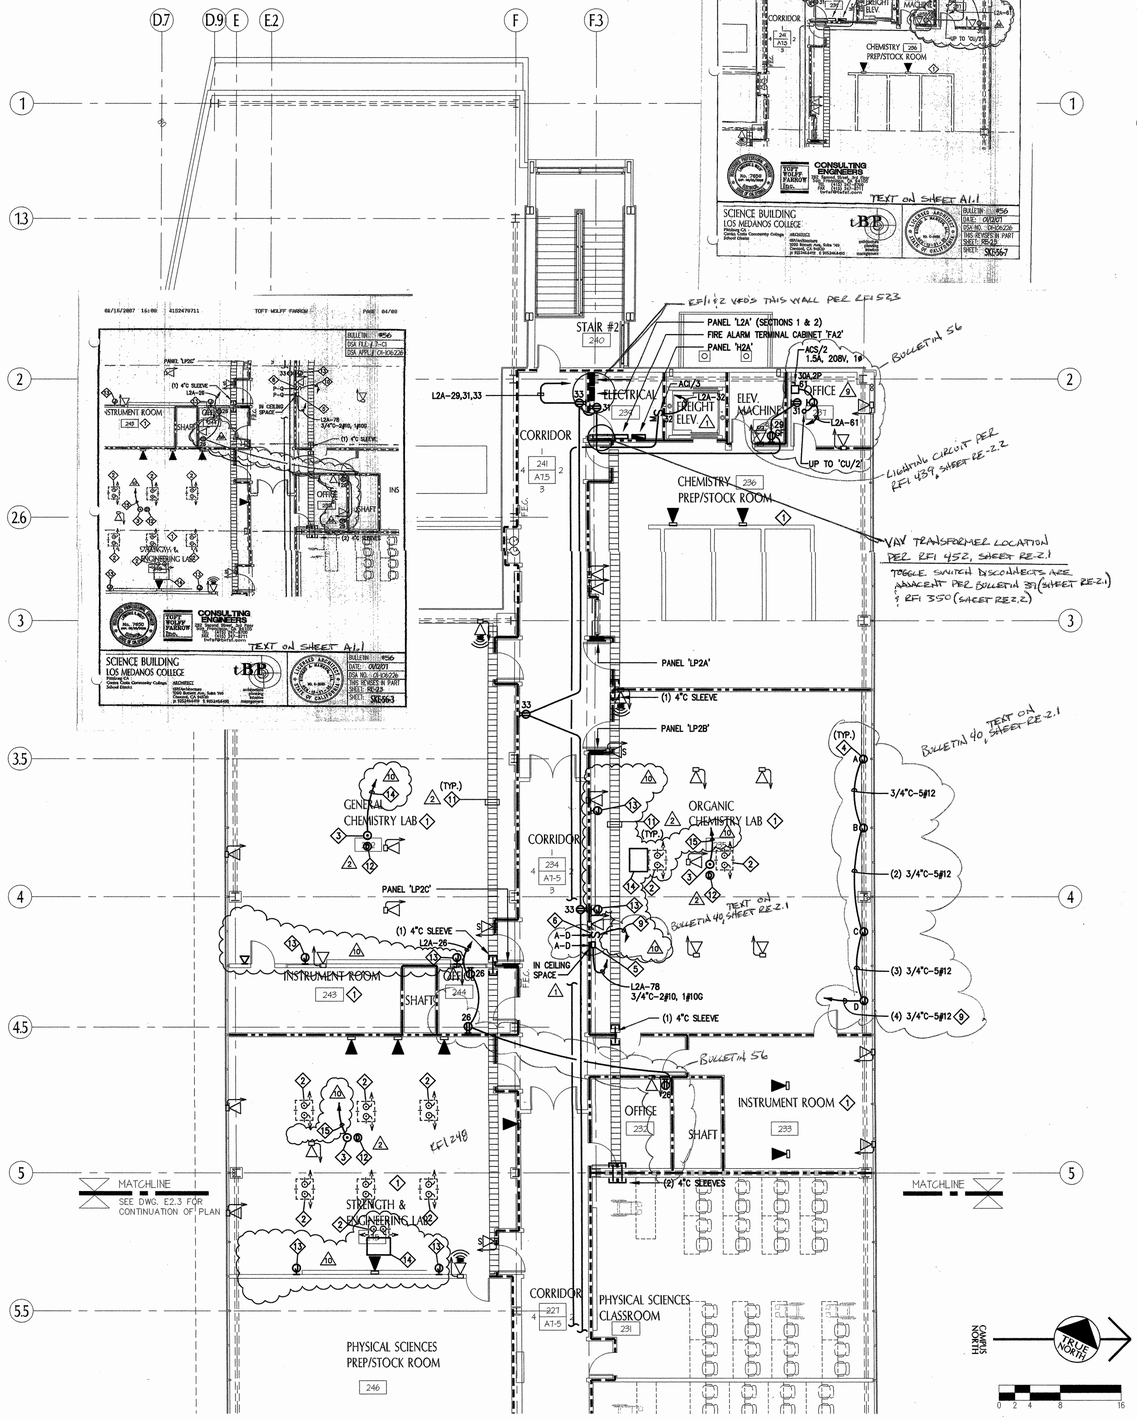


SHEET NOTES

1. REFER TO "ELECTRICAL LABORATORY DRAWING" FOR ADDITIONAL ELECTRICAL REQUIREMENTS IN THIS ROOM.
2. RECESSED FLOOR BOX, WIREMOLD #RFB4 WITH LPB OPEN SYSTEMS BEZEL FOR TELCOM JACKS. STUB (2)1"C FROM FLOOR INTO CEILING SPACE OF THE FIRST FLOOR. RECEPTACLE/CIRCUIT IN FLOOR BOX PER 'ELECTRICAL LABORATORY DRAWING.
3. CEILING MOUNTED DOUBLE DUPLEX RECEPTACLE FOR PROJECTOR AND A/V EQUIPMENT. COORDINATE LOCATION OF RECEPTACLE WITH A/V VENDOR REQUIREMENTS.
4. JUNCTION BOX FOR MOTORIZED WINDOW SHADE. LETTER ADJACENT TO OUTLET BOX DESIGNATES WHICH SHADES ARE CONTROLLED BY THE WINDOW SHADE CONTROLLER.
5. WINDOW SHADE CONTROL BOX FOR MOTORIZED WINDOW SHADES. LETTER INDICATES WHICH SHADES ARE CONTROLLED BY THE WINDOW SHADE CONTROLLER.
6. CONTROL SWITCH FOR MOTORIZED SHADES 'A–D'. CONTRACTOR SHALL ROUGH–IN OUTLET BOX FOR SWITCH (2–GANG BOX). SWITCH FURNISHED BY VENDOR, INSTALLED AND CONNECTED BY CONTRACTOR.
7. STUB (2) 1 1/4"C FROM (2) 2–GANG OUTLET BOX INTO ACCESSIBLE CEILING SPACE, +6". OUTLET BOX MOUNTED AT +18" AFF.
8. STUB (1) 3/4"C FROM 1–GANG OUTLET BOX INTO ACCESSIBLE CEILING SPACE, +6". OUTLET BOX MOUNTED AT +48" AFF.
9. ROUTE HOMERUN TO RESPECTIVE MOTORIZED WINDOW SHADE CONTROL BOX.
10. CONNECT CONTROL SWITCH 'A–D' TO MOTORIZED WINDOW SHADE CONTROL BOX 'A–D'.
11. DOUBLE SNAKETRAY IN CEILING SPACE. SEE DETAIL H, SHEET E4.2 FOR SIZE AND SUPPORT OF SNAKETRAY.
12. CEILING MOUNTED DATA OUTLET FOR PROJECTOR AND A/V EQUIPMENT. COORDINATE LOCATION OF OUTLET WITH A/V VENDOR REQUIREMENTS. STUB (1) 3/4"C FROM OUTLET TO SNAKETRAY IN ACCESSIBLE CEILING SPACE.
13. FOR ALL A/V SYSTEM WALL SPEAKER (SPEAKER BY OTHERS) LOCATIONS IN 'NON–RATED' WALLS, INSTALL A 1–GANG MUD RING FOR WALL SPEAKERS BELOW THE ROOM CEILING AND A 1–GANG OUTLET BOX ABOVE THE ROOM CEILING. IN LOCATION OF 'RATED' WALLS INSTALL A 1–GANG OUTLET BOX FOR A/V SYSTEM WALL SPEAKER. STUB (1) 3/4"C FROM OUTLET BOX INTO ROOM CEILING SPACE +6". TERMINATE CONDUIT WITH BUSHING. MOUNTING HEIGHT OF 1–GANG MUD RING AND 1–GANG OUTLET BOX IS 105" AFF. MOUNTING LOCATIONS SHALL BE COORDINATED WITH A/V CONTRACTOR.
14. RECESSED FLOOR BOX WITH (1) DUPLEX RECEPTACLE AND (2) DATA OUTLETS. MYSTERY ELECTRONICS #FMCA–3000 SERIES/3488–BR WITH #BB3000D6. BACKBOX (FOR AV USE). REFER TO LABORATORY 'ELECTRICAL' DRAWINGS FOR CIRCUIT UTILIZED BY BACKBOX. STUB (2) 1 1/4"C INTO ACCESSIBLE CEILING SPACE +6" (SEE BULLETIN 34)
15. REFER TO 'ELECTRICAL LABORATORY DRAWINGS' FOR CIRCUIT UTILIZED BY PROJECTOR DOUBLE DUPLEX RECEPTACLE.

ALL OUTLET LOCATIONS PER RFI 393, SHEET RE-2.1
SEE SHEET 1 OF 2.E.1 FROM KI

10 04/03/06 BULLETIN #10

KEY PLAN

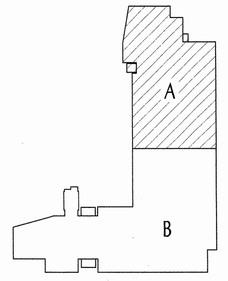

TWF #030358.00

2ND FLOOR PLAN PART "A" SCALE: 1/8"=1'-0" | 1

tBP
architecture
planning
interiors
management
tBP/Architecture
1000 Burnett Avenue, Suite 140
Concord, CA 94520
p. 925.246.6419 f. 925.246.6495
LICENSED ARCHITECT REGISTERED PROFESSIONAL ENGINEER STATE OF CALIFORNIA
CONSULTING ENGINEERS
282 Second Street, 3rd Floor
San Francisco, CA 94105
FAX (415) 247-8711
twf@tbwsf.com
TOFT WOLFF FARROW Inc.

ERRATA STAMP
DIVISION OF THE STATE ARCHITECT
OFFICE OF REGIONAL ARCHITECTS
APP. - 09/18/06
AC. RS SS
DATE
name
address
city, state, zip
ph. fx

SCIENCE BUILDING
LOS MEDANOS COLLEGE

Contra Costa Community College District


CONFORMED

tBP project number : 20241.00
file name: 1s-FLR-A
drawn by: LLAI checked by: LSH
date: NOVEMBER 15, 2004

1 3/18/05 ADDENDUM #1
2 4/19/05 ADDENDUM #2
9 2/10/06 BULLETIN #9
10 BULLETIN #10 D B

drawing title:
2nd FLOOR PLAN
PART "A" - POWER/SIGNAL
LMC SCIENCE 313-023-112.01-0-00.00
drawing no:
RE-2.3

SEE ALSO E-2.3 FOR AS-BUILT PATHWAYS

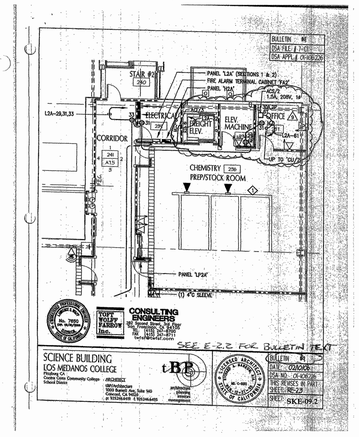
STAIR #29
29C1
PANEL 'L2A' (SECTIONS 1 & 2)
FIRE ALARM TERMINAL CABINET 'FATC'
PANEL 'HDA'
ELECTRICAL
ELEV. MACHINERY
ELEV. HYDRAULIC
OFFICE
CORRIDOR
CHEMISTRY 126
PREP/STOCK ROOM
PANEL 'LP3A'
(1) 4"C SLEEVE
SEE E-2.2 FOR BULLETIN TEXT
SCIENCE BUILDING
LOS MEDANOS COLLEGE
THIS REVISES IN PART
SHEETS E2.2
SHEET SKE-09.2

SHEET NOTES

1. REFER TO "ELECTRICAL LABORATORY DRAWING" FOR ADDITIONAL ELECTRICAL REQUIREMENTS IN THIS ROOM.
2. RECESSED FLOOR BOX, WIREMOLD #RFB4-SS WITH INTERNAL BRACKET, #RFB-2AB-SS. STUB (2)1"C FROM FLOOR INTO CEILING SPACE OF THE FIRST FLOOR. RECEPTACLE/CIRCUIT IN FLOOR BOX PER 'ELECTRICAL LABORATORY DRAWING.
3. DUPLEX RECEPTACLE FOR CEILING MOUNTED PROJECTOR. COORDINATE EXACT LOCATION OF RECEPTACLE WITH PROJECTOR REQUIREMENTS.
4. JUNCTION BOX FOR MOTORIZED WINDOW SHADE. LETTER ADJACENT TO OUTLET BOX DESIGNATES WHICH SHADES ARE CONTROLLED BY THE WINDOW SHADE CONTROLLER.
5. WINDOW SHADE CONTROL BOX FOR MOTORIZED WINDOW SHADES. LETTER INDICATES WHICH SHADES ARE CONTROLLED BY THE WINDOW SHADE CONTROLLER.
6. CONTROL SWITCH FOR MOTORIZED SHADES 'A-D'. CONTRACTOR SHALL ROUGH-IN OUTLET BOX FOR SWITCH (2-GANG BOX). SWITCH FURNISHED BY VENDOR, INSTALLED AND CONNECTED BY CONTRACTOR.
7. STUB (2) 1 1/4"C FROM 4-GANG OUTLET BOX INTO ACCESSIBLE CEILING SPACE, +6".
8. STUB (1) 3/4"C FROM 1-GANG OUTLET BOX INTO ACCESSIBLE CEILING SPACE, +6".
9. ROUTE HOMERUN TO RESPECTIVE MOTORIZED WINDOW SHADE CONTROL BOX.
10. CONNECT CONTROL SWITCH 'A-D' TO MOTORIZED WINDOW SHADE CONTROL BOX 'A-D'.
11. DOUBLE SNAKETRAY IN CEILING SPACE. SEE DETAIL H, SHEET EA.2 FOR SIZE AND SUPPORT OF SNAKETRAY.
12. CEILING MOUNTED DATA OUTLET FOR PROJECTOR. COORDINATE LOCATION OF OUTLET WITH PROJECTOR REQUIREMENTS. STUB (1)3/4"C FROM OUTLET TO SNAKETRAY IN ACCESSIBLE CEILING SPACE.

OUTLET BOXES ON OPPOSITE SIDES OF WALLS OR PR PARTITION SHALL BE SEPARATED BY HORIZONTAL DISTANCE OF AT LEAST 24 INCHES.


ADDENDUM #2
DSA FILE # 7-C1
DSA APPL # 01-106226

CONSULTING ENGINEERS
TOFT WOLFF FARROW Inc.
582 Second Street, SF, CA 7105
Phone (415) 247-8700
FAX (415) 247-8711
TwfaF@twfsf.com

SCIENCE BUILDING
LOS MEDANOS COLLEGE
Pittsburg CA
Contra Costa Community College School District
ARCHITECT
tBP/Architecture
1000 Burnett Ave, Suite 140
Concord, CA 94520
p: 925.246.6419 f: 925.246.6495

tBP architecture planning interiors management

ADDENDUM #2
DATE: 05/18/05
DSA NO. 01-106226
THIS REVISES IN PART
SHEET: RE-2.3
SHEET: RE-16

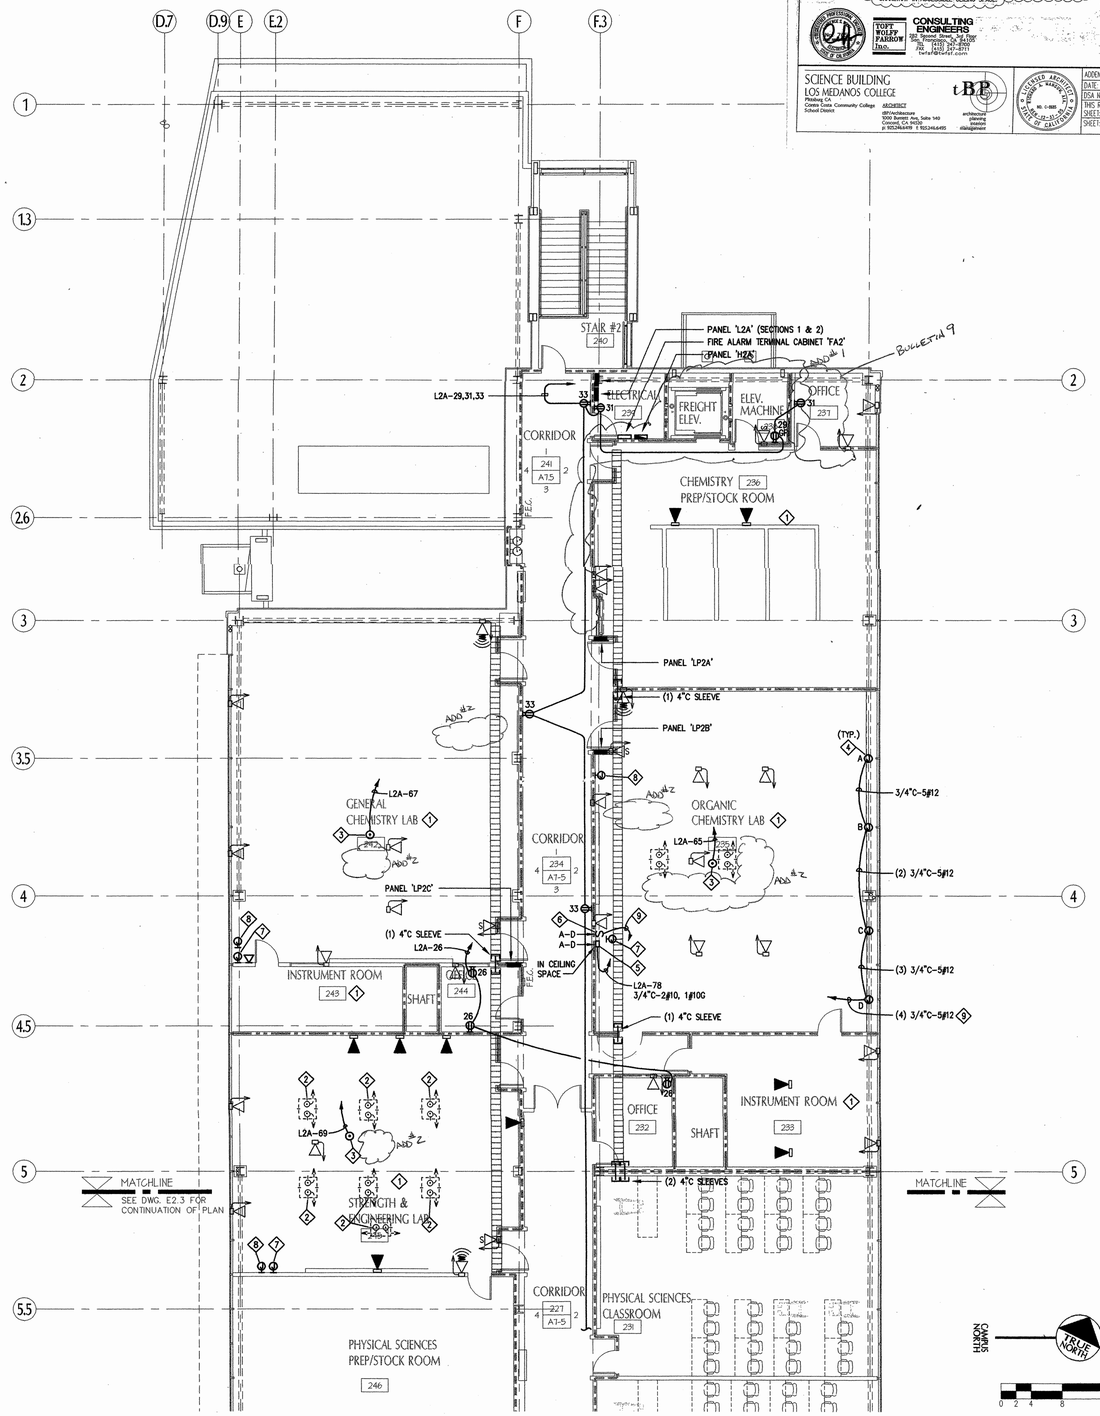


2ND FLOOR PLAN PART "A" | 1
SCALE: 1/8"=1'-0"

TWF #03058.00

SHEET NOTES

1. REFER TO "ELECTRICAL LABORATORY DRAWING" FOR ADDITIONAL ELECTRICAL REQUIREMENTS IN THIS ROOM.
2. RECESSED FLOOR BOX, WIREMOLD #RFB4-SS WITH INTERNAL BRACKET, #RFB-2AB-SS. STUB (2)1"C FROM FLOOR INTO CEILING SPACE OF THE FIRST FLOOR.
3. DUPLEX RECEPTACLE FOR CEILING MOUNTED PROJECTOR. RECEPTACLE FOR PROJECTOR INSTALLED IN CEILING SPACE. COORDINATE EXACT LOCATION OF PROJECTOR WITH ARCHITECT 'RCP' DRAWINGS.
4. JUNCTION BOX FOR MOTORIZED WINDOW SHADE. LETTER ADJACENT TO OUTLET BOX DESIGNATES WHICH SHADES ARE CONTROLLED BY THE WINDOW SHADE CONTROLLER.
5. WINDOW SHADE CONTROL BOX FOR MOTORIZED WINDOW SHADES. LETTER INDICATES WHICH SHADES ARE CONTROLLED BY THE WINDOW SHADE CONTROLLER.
6. CONTROL SWITCH FOR MOTORIZED SHADES 'A-D'. CONTRACTOR SHALL ROUGH-IN OUTLET BOX FOR SWITCH (2-GANG BOX). SWITCH FURNISHED BY VENDOR, INSTALLED AND CONNECTED BY CONTRACTOR.
7. STUB (2) 1 1/4"C FROM 4-GANG OUTLET BOX INTO ACCESSIBLE CEILING SPACE, +6".
8. STUB (1) 3/4"C FROM 1-GANG OUTLET BOX INTO ACCESSIBLE CEILING SPACE, +6".
9. ROUTE HOMERUN TO RESPECTIVE MOTORIZED WINDOW SHADE CONTROL BOX.
10. CONNECT CONTROL SWITCH 'A-D' TO MOTORIZED WINDOW SHADE CONTROL BOX 'A-D'.
11. OUTLET BOXES ON OPPOSITE SIDES OF WALLS OR PR PARTITION SHALL BE SEPARATED BY HORIZONTAL DISTANCE OF AT LEAST 24 INCHES.

ADDENDUM #1
DSA FILE # 7-C1
DSA APPL # 01-106226

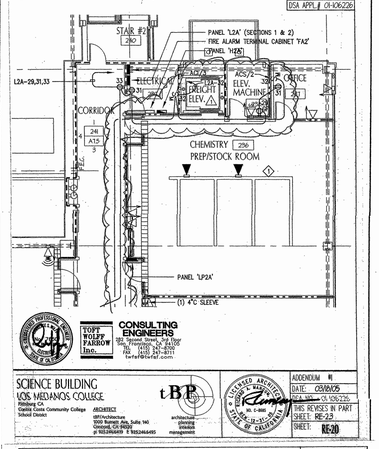


CONSULTING ENGINEERS
TOFT WOLFF FARROW Inc.
582 Second Street, SF, CA 7105
Phone (415) 247-8700
FAX (415) 247-8711
TwfaF@twfsf.com

SCIENCE BUILDING
LOS MEDANOS COLLEGE
Pittsburg CA
Contra Costa Community College School District
ARCHITECT
tBP/Architecture
1000 Burnett Ave, Suite 140
Concord, CA 94520
p: 925.246.6419 f: 925.246.6495

tBP architecture planning interiors management

ADDENDUM #1
DATE: 05/18/05
DSA NO. 01-106226
THIS REVISES IN PART
SHEET: RE-2.3
SHEET: RE-20

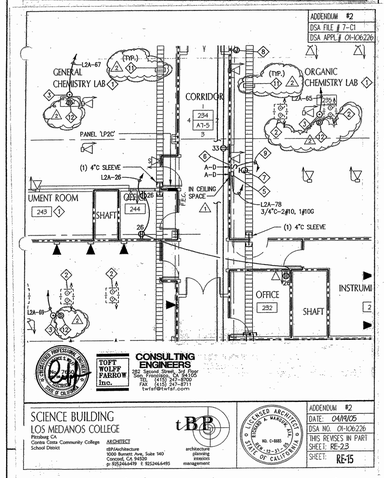


CONSULTING ENGINEERS
TOFT WOLFF FARROW Inc.
582 Second Street, SF, CA 7105
Phone (415) 247-8700
FAX (415) 247-8711
TwfaF@twfsf.com

SCIENCE BUILDING
LOS MEDANOS COLLEGE
Pittsburg CA
Contra Costa Community College School District
ARCHITECT
tBP/Architecture
1000 Burnett Ave, Suite 140
Concord, CA 94520
p: 925.246.6419 f: 925.246.6495

tBP architecture planning interiors management

ADDENDUM #2
DATE: 04/18/05
DSA NO. 01-106226
THIS REVISES IN PART
SHEET: RE-2.2
SHEET: RE-15

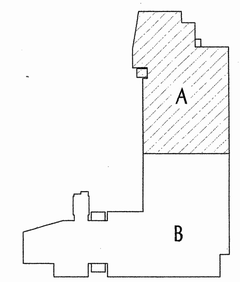

DSA/SS/CC 01-106226
DIV. OF THE STATE ARCHITECT
OFFICE OF REGULATION SERVICES
APPL. 01-106226
DATE 11-17-04

architect
name
address
city, state, zip
ph: fx:

consultant

agency

owner


SCIENCE BUILDING
LOS MEDANOS COLLEGE
Contra Costa Community College District


tBP project number : 2024T.00
file name: 1s-FLR-A
drawn by: LLAI checked by: LSH
date: NOVEMBER 15, 2004


Rev	date	description


drawing title:
2nd FLOOR PLAN
PART "A" - POWER/SIGNAL


LMC SCIENCE 313-023-T12.01-0-00.00
drawing no.:
E-2.3
SEE SHEET RE-2.3

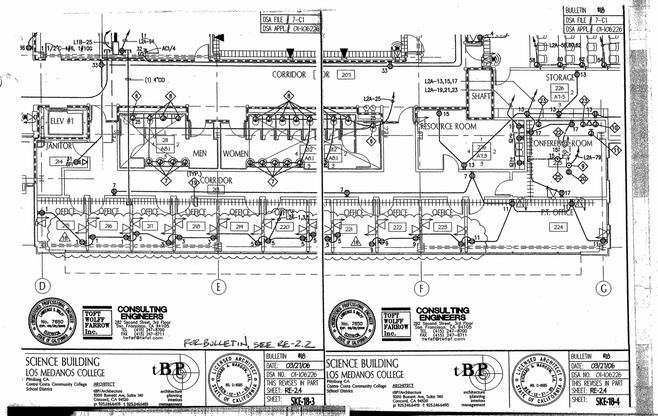


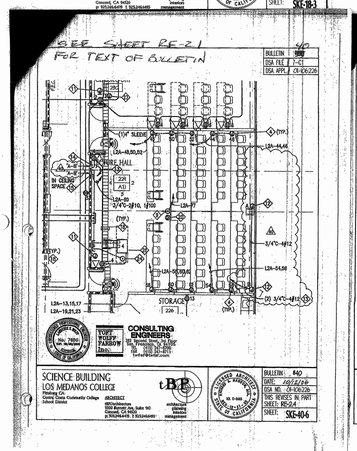


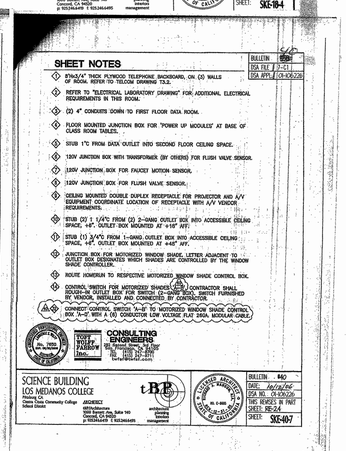

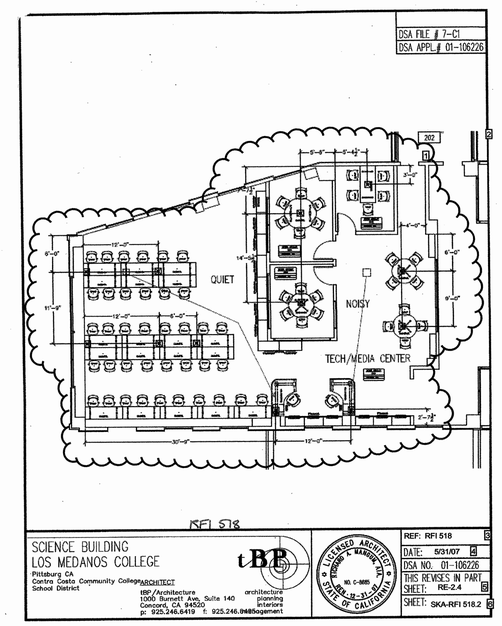

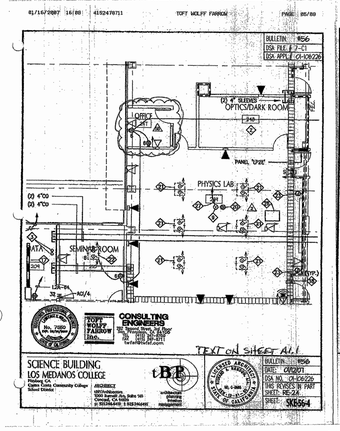

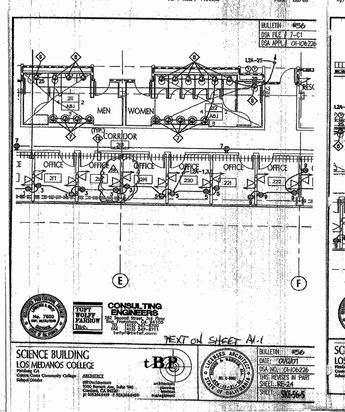

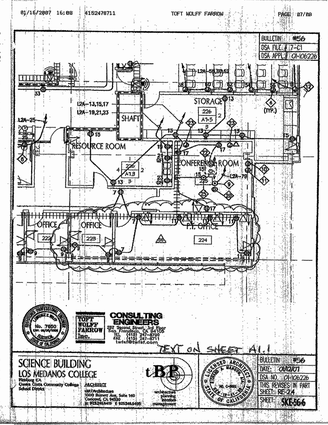

S. J. AMOROSO
Request For Information/Clarification

DSA FILE NO. 7-C1
DBA APPL. No. 01-106226

To: tBP/Architecture, 1000 Burnett Ave, Suite 140, Concord, CA 94520
Project: LOS MEDANOS COLLEGE, SCIENCE BUILDING, Contra Costa Community College District
Attn: Celia Chiang, Tom Beckett
Fax: 925-246-6490
tBP job: 20247.00
Subj.: Motorized Window Shades in Room 249
RFI No: 444
Reference (dwg, spec.): Window Shade Shop Drawings
Subcontractor RFI: EWS 67
Reply Requested By: 12/21/06

INFORMATION REQUESTED: Date: 12/14/06

Please note the attached Edward Scott Electric RFI No. 67 regarding the motorized window shade for room 249 which is shown in the Window Shade Shop drawings but not on the electrical plans. Please advise.

SUGGESTED SOLUTION:
Cost Impact: ☐ Schedule Impact: ☐ Days By: Mark Delgado

RESPONSE: DATE: 12/26/06

See attached markup sketch for motorized window shades in Room 249.

Larry Lai

RFI # 000
Page 1

EDWARD W. SCOTT ELECTRIC CO., INC.
450 HARRIET STREET
San Francisco, CA 94103-4914
Phone: (415) 626-0701 / Fax: (415) 626-2837

REQUEST FOR INFORMATION

LPIC
PROJECT: SCIENCE BLDG. R.F.I. # 67 R.F.I. Date 12/14/06
JOB: 0407 ACTUAL REPLY DATE

TO: MARK DELGADO
OF: MADDOCK CONSTRUCTION
REF: DWG. SHADE SHOP DWGS.
LOCATION: ROOMS 249 AND 247

POTENTIAL COST IMPACT
___ COST: ___ SCHEDULE:
___ OTHER ___ LABOR:
___ NO IMPACT ___ MATERIAL


INFORMATION REQUESTED: THE WINDOW SHADE SHOP DWGS CALL FOR MOTORIZED WINDOW SHADES IN THE PHYSICS LAB, RM 249. THE ELECTRICAL DWGS. HAVE NO PROVISIONS FOR THESE SHADES. PLEASE REVIEW AND RESPOND.


REPLY REQUIRED BY: 12/21/06 SIGNED:
NOTE: IF NO REPLY IS RECEIVED BY US BY THE ABOVE NOTED DATE, A TIME EXTENSION WILL BE REQUIRED WITH POSSIBLE COST IMPACTS.

RESPONSE:

DATED: SIGNED:

INDUSTRIAL, COMMERCIAL WIRING & DESIGN
STATE CONTRACTOR LICENSE NO. 590G6

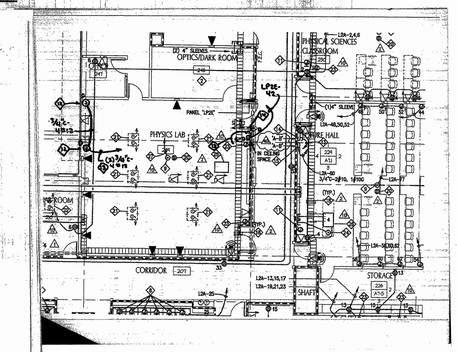

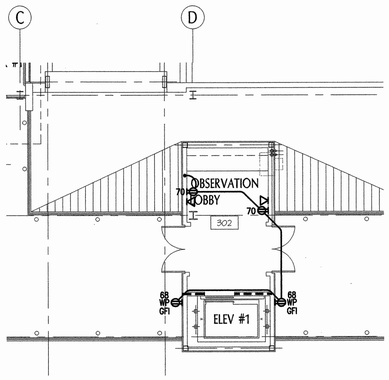

north

PARTIAL ROOF PLAN
SCALE: 1/8"=1'-0" | 2


SHEET NOTES

1. 8'Hx3/4" THICK PLYWOOD TELEPHONE BACKBOARD, ON (3) WALLS OF ROOM. REFER TO TELCOM DRAWING T3.2.
2. REFER TO "ELECTRICAL LABORATORY DRAWING" FOR ADDITIONAL ELECTRICAL REQUIREMENTS IN THIS ROOM.
3. (2) 4" CONDUITS DOWN TO FIRST FLOOR DATA ROOM.
4. FLOOR MOUNTED JUNCTION BOX FOR 'POWER UP MODULES' AT BASE OF CLASS ROOM TABLES.
5. STUB 1"C FROM DATA OUTLET INTO SECOND FLOOR CEILING SPACE.
6. 120V JUNCTION BOX WITH TRANSFORMER (BY OTHERS) FOR FLUSH VALVE SENSOR.
7. 120V JUNCTION BOX FOR FAUCET MOTION SENSOR.
8. 120V JUNCTION BOX FOR FLUSH VALVE SENSOR.
9. CEILING MOUNTED DOUBLE DUPLEX RECEPTACLE FOR PROJECTOR AND A/V EQUIPMENT COORDINATE LOCATION OF RECEPTACLE WITH A/V VENDOR REQUIREMENTS.
10. STUB (2) 1 1/4"C FROM (2) 2-GANG OUTLET BOX INTO ACCESSIBLE CEILING SPACE, +6". OUTLET BOX MOUNTED AT +18" AFF.
11. STUB (1) 3/4"C FROM 1-GANG OUTLET BOX INTO ACCESSIBLE CEILING SPACE, +6". OUTLET BOX MOUNTED AT +48" AFF.
12. JUNCTION BOX FOR MOTORIZED WINDOW SHADE. LETTER ADJACENT TO OUTLET BOX DESIGNATES WHICH SHADES ARE CONTROLLED BY THE WINDOW SHADE CONTROLLER.
13. ROUTE HOMERUN TO RESPECTIVE MOTORIZED WINDOW SHADE CONTROL BOX.
14. CONTROL SWITCH FOR MOTORIZED SHADES 'A-D'. CONTRACTOR SHALL ROUGH-IN OUTLET BOX FOR SWITCH (2-GANG BOX). SWITCH FURNISHED BY VENDOR, INSTALLED AND CONNECTED BY CONTRACTOR.
15. WINDOW SHADE CONTROL BOX FOR MOTORIZED WINDOW SHADES. LETTER INDICATES WHICH SHADES ARE CONTROLLED BY THE WINDOW SHADE CONTROLLER.
16. 20"x4" COPPER GROUND BUS BAR. MOUNT AT +6'-6" AFF. ROUTE AND CONNECT 1 1/2"C-1#1/0G. FROM BUS BAR TO GROUND BUS OF PANEL 'L2A'. REFER TO TELCOM DRAWING T3.2.
17. 60A, 4 POLE, 300V WITH GROUND, STARLINE BUSWAY SYSTEM WITH 60A 'END' POWER FEED AND THE FOLLOWING:
    a. PLUG-IN BUSWAY STRAIGHT SECTION AT +8'-2" AFF.
    b. BUSWAY SUPPORT ASSEMBLY TO SUSPEND BUSWAY FROM BACK-TO-BACK 'U' CHANNEL OF GRID ABOVE.
    c. BUSWAY END CAP.
    COORDINATE LOCATION AND LENGTH OF STARLINE BUSWAY WITH TELCOM DRAWING T3.2.
18. DOUBLE SNAKETRAY IN CEILING SPACE, SEE DETAIL H, SHEET E4.2 FOR SIZE AND SUPPORT OF SNAKETRAY.
19. SINGLE SNAKETRAY IN CEILING SPACE, SEE DETAIL H, SHEET E4.2 FOR SIZE AND SUPOORT OF SNAKETRAY.
20. CEILING MOUNTED DATA OUTLET FOR PROJECTOR AND A/V EQUIPMENT. COORDINATE LOCATION OF OUTLET WITH A/V VENDOR REQUIREMENTS. STUB (1) 3/4"C FROM OUTLET TO SNAKETRAY IN ACCESSIBLE CEILING SPACE.
21. RECESSED FLOOR BOX, WIREMOLD #RFB4 WITH LPB OPEN SYSTEMS BEZEL FOR TELCOM JACKS. STUB (2)1"C FROM FLOOR BOX INTO CEILING SPACE OF THE FIRST FLOOR. RECEPTACLE/CIRCUIT IN FLOOR BOX PER 'ELECTRICAL LABORATORY DRAWINGS.
22. RECESSED FLOOR BOX, WIREMOLD #RFB4 WITH LPB OPEN SYSTEMS BEZEL FOR TELCOM JACKS. STUB (2)1"C FROM FLOOR BOX INTO CEILING OF THE FIRST FLOOR. (1) DUPLEX RECEPTACLE INSTALLED IN FLOOR BOX.
23. FOR ALL A/V SYSTEM WALL SPEAKER (SPEAKER BY OTHERS) LOCATIONS IN 'NON-RATED' WALLS, INSTALL A 1-GANG MUD RING FOR WALL SPEAKERS BELOW THE ROOM CEILING AND A 1-GANG OUTLET BOX ABOVE THE ROOM CEILING. IN LOCATION OF 'RATED' WALLS INSTALL A 1-GANG OUTLET BOX FOR A/V SYSTEM WALL SPEAKER. STUB (1) 3/4"C FROM OUTLET BOX INTO ROOM CEILING SPACE +6". TERMINATE CONDUIT WITH BUSHING. MOUNTING HEIGHT OF 1-GANG MUD RING AND 1-GANG OUTLET BOX IS 105" AFF. MOUNTING LOCATIONS SHALL BE COORDINATED WITH A/V CONTRACTOR.
24. RECESSED POKE-THRU; WIREMOLD #AM3 STYLE, WITH INSERTS FOR PASS-SEYMOUR OPEN SYSTEM BEZELS. STUB (1) 1 1/4"C FROM POKE-THRU INTO SECOND FLOOR ACCESSABLE CEILING SPACE NEAR SNAKETRAY.
25. RECESSED POKE-THRU; WIREMOLD #AV3 STYLE, WITH (1) DUPLEX RECEPTACLE AND BEZELS FOR EXTRON "MAAP" MODULES FOR AV USE. STUB (1) 1 1/4"C FROM POKE-THRU INTO SECOND FLOOR ACCESSIBLE CEILING SPACE NEAR SNAKETRAY.
26. RECESSED FLOOR BOX; STUB (2) 1 1/4"C FROM FLOOR BOX INTO SECOND FLOOR ACCESSIBLE CEILING SPACE TO +6". (1) DUPLEX RECEPTACLE WITH (2) DATA OUTLETS INSTALLED IN FLOOR BOX. MYSTERY ELECTRONICS #FMCA 3000 SERIES/3488-BR WITH #BB3000DB BACKBOX (FOR AV USE). FOR AREAS WHERE 'MYSTERY' ELECTRONICS BACKBOX IS INSTALLED IN LABORATORY ROOMS, REFER TO 'LABORATORY ELECTRICAL' DRAWINGS FOR CIRCUIT UTILIZED BY BACKBOX. (SEE BULLETIN 34, SHEET RE2.1)
27. REFER TO 'ELECTRICAL LABORATORY DRAWINGS' FOR CIRCUIT UTILIZED BY PROJECTOR DOUBLE DUPLEX RECEPTACLE.
28A. RECESSED FLOOR BOX, WIREMOLD #SAF-2 1/2 (DATA ONLY, SEE TELCOM DRAWINGS).
28B. RECESSED FLOOR BOX, WIREMOLD #SAF-2 1/2 WITH (2) DUPLEX RECEPTACLES AND DATA OUTLETS (SEE TELCOM DRAWINGS).
29A. BACKBOX AND CONDUIT IN DEMOUNTABLE WALL PANELS PROVIDED BY MANUFACTURER OF DEMOUNTABLE WALL. ELECTRICAL CONTRACTOR SHALL PROVIDE AND INSTALL CONDUIT AND WIRING TO TOP OF THE DEMOUNTABLE WALL ABOVE THE CEILING AND SHALL PROVIDE AND INSTALL WIRING, RECEPTACLES AND COVERPLATES IN THE DEMOUNTABLE WALL.
29B. RECESSED WALL DUCT, WIREMOLD #WDCW350 WITH REMOVAL COVERPLATE. WHERE WALL DUCT RISES ABOVE ROOM CEILING GRID, INSTALL ONE ACCESS COVERPLATE #WDOG-ACPS (FOR ACCESS OF TELCOM CABLES FROM FLOOR TO SNAKETRAY IN CEILING SPACE). AT FLOOR LEVEL INSTALL ONE SWEEP TEE (FOR ACCESS OF TELCOM CABLES FROM RAISED FLOOR TO CEILING SPACE.
30. SEE EFI 318, SHEET RE-2.2.
31. RECESSED WALL DUCT, WIREMOLD #WDCW350 WITH REMOVAL COVERPLATE. WHERE WALL DUCT RISES ABOVE ROOM CEILING GRID, INSTALL ONE ACCESS COVERPLATE #WDOG-ACPS (FOR ACCESS OF TELCOM CABLES FROM FLOOR TO SNAKETRAY IN CEILING SPACE). AT FLOOR LEVEL INSTALL ONE SWEEP TEE (FOR ACCESS OF TELCOM CABLES FROM RAISED FLOOR TO CEILING SPACE.

15A 04/10/06 BULLETIN #15B
15 04/03/06 BULLETIN #10

A/V OUTLET LOCATIONS PER EFI 353, SHEET RE-2.1 SEE SHEET 2.0.2E.1 FROM K.E.

KEY PLAN

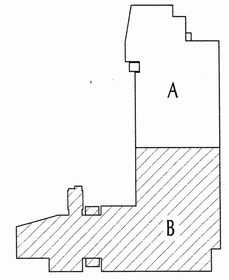

north

2ND FLOOR PLAN PART "B"
SCALE: 1/8"=1'-0" | 1

TWF #03058.00

Bulletin No.15B

tBP architecture planning interiors management

Date: May 4, 2006

To: S.J. Amoroso Construction
390 Bridge Parkway
Redwood shores CA 94065

Project: LOS MEDANOS COLLEGE SCIENCE BUILDING
Contra Costa Community College District
DSA No. 01-109236; File # 7-C1
tBP 1751.20247.00

Description: REFERENCE: E2.4, T1.4:

Revisions to Electrical and Telecom for coordination of power and data requirements for furniture at second floor area 'B' raised floor:

Refer to SKE-15B.1 and SKE-15B.2 for revisions to Electrical devices at raised floor area as follows:

1. Add one floor box in room 203 between gridlines B.3 and B.8/7.4 and 8.
2. Specification for floor boxes in this area (except for (2) tagged with note 28) is revised per note 26.
3. Specification for (2) floor boxes in "Quiet" area is revised per note 28.
4. Add power/data receptacles at two locations at demountable walls (west walls of room 205 and 206). Power and data at demountable walls is clarified per note 30.
5. Refer to note 31 for steel wall duct to be installed in fire-rated partition adjacent to door 206. Details for this wall are similar to those issued per Bulletin #15A (see SKA-15A.4 and 15A.5).
   Contractor to advise if location of wall duct will affect fire-rating of wall adjacent to door 206.

Refer to SKT-15B.1 and SKT-15B.2 for revisions to Telecom devices at raised floor area as follows:

6. Add one floor box in room 203 (refer to note 1 above).
7. Add data receptacles at two locations at demountable walls (refer to note 4 above). Details for these wall plates are similar to those issued in Bulletin #15A (see SKT-15A.6).

Issued By: Architect
Requested By: Architect, Owner

tBPArchitecture. 1000 Burnett Ave. Suite 140 . Concord, CA. 94520. ph: 925.246-6419. fax: 925.246.6495

Page 2


BULLETIN # 00
LOS MEDANOS COLLEGE SCIENCE BUILDING

Reason: Coordination of power and data requirements for furniture at second floor area 'B'

Enclosures: SKE-15B.1, SKE-15B.2, SKT-15B.1, SKT-15B.2

Distribution:	Copies:	Name:	Organization:
	1 copy	Mark Delgado	S. J. Amoroso
	1 copy	Cam Perrotta	OCCCD/District
	1 copy	Bob Hacke	Inspector of Record
	1 copy	Tom Beckett	tBP/Architecture
	1 copy	File 20247.0017.4	tBP/Architecture

Action:
- ☐ For Information/Clarification only
- ☒ Provide Price/Credit Proposal. (Refer to this Bulletin No. when responding)
- ☐ Requires DSA review and approval
- ☐ Proceed as authorized by District

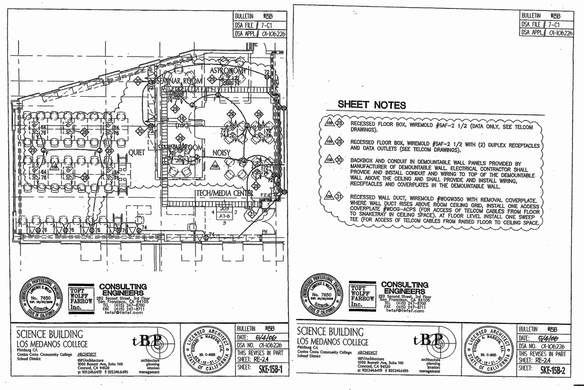

tBP
architecture
planning
interiors
management

tBP/Architecture
1000 Burnett Avenue, Suite 140
Concord, CA 94520
p: 925.246.6419 f: 925.246.6495

CONSULTING ENGINEERS
285 Second Street, 4th Floor
San Francisco, CA 94105
FAX (415) 247-8711
twfes@twfes.com

TOFT WOLFF FARROW Inc.

IDENTIFICATION STAMP
DEPT. OF THE STATE ARCHITECT
OFFICE OF REGULATION SERVICES
APP. # 01-109236
AC RS SS
DATE

name
address
city, state, zip
ph#
fax

SCIENCE BUILDING
LOS MEDANOS COLLEGE

Contra Costa Community College District

tBP project number : 20247.00
file name: 2n-FLR-A
drawn by: LLM checked by: LSM
date: NOVEMBER 15, 2004

3/18/05 ADDENDUM #1
4/19/05 ADDENDUM #2
03/06/06 BULLETIN #10 D, B
03/22/06 BULLETIN #18

drawing title:
2nd FLOOR PLAN
PART "B" - POWER/SIGNAL

LMC SCIENCE 313-023-112.01-0-00.00
drawing no:
RE-2.4
SEE ALSO E-2.4 FOR AS-BUILT REVISIONS

S. J. AMOROSO
Request For Information/Clarification

DSA FILE NO. 7-C1
DSA APPL. No. 01-106226

To: tBPOArchitecture
1000 Burnett Ave, Suite 140
Concord, CA 94520

Attn: Celia Chiang, Tom Beckett
Fax: 925-246-6485

Subj.: Wall Mount Boxes Vs. Floor Mount In Rm. 229
Reference (dwg, spec.) / Bulletin 10D

Reply Requested By: 6/21/06

Project: LOS MEDANOS COLLEGE SCIENCE BUILDING
Contra Costa Community College District

tBP plh: 20247.00

RFI No: **249**

Subcontractor RFI: EWS 22

INFORMATION REQUESTED: Date: 6/14/06

Please note the attachd Edward W. Scott RFI No. 22 regarding dimensions for the Floor Boxes in room 229. Also due to possible damage EWS would like to wall mount these boxes in lieu of floor mounting. Please advise.

SUGGESTED SOLUTION:

Cost Impact ☐ Schedule Impact ☐ days By: Mark Delgado

RESPONSE: DATE:
TBP recommends that the subject junction boxes be wall mounted in lieu of floor mounted.
Due to junction boxes being wall mounted, there should be a credit for not core drilling the floor.

Larry Lei
TBP/ 6.15.06

Attachments:


By:

TRANSMITTAL RECORD:

FROM	TO	DATE
S.J. AMOROSO	tBP / ARCHITECTURE	6/14/06
tBP / ARCHITECTURE	ENGINEER/CONSULTANT	TBP - 6/14/06, Dovetail - 6/15/06
ENGINEER/CONSULTANT	tBP / ARCHITECTURE	TBP - 6/15/06, Dovetail - 6/20/06
tBP / ARCHITECTURE	S.J. AMOROSO	6/20/06
S.J. AMOROSO	ORIGINATOR	

After coordinate with District furniture consultant, location of the wall mounted junction boxs are to be 3" to corner of the table as shown as follows, typical.

Vanessa Ling/tBP
6/20/06

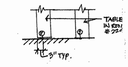

RFI # 000
Page 1

S. J. AMOROSO
Request For Information/Clarification

DSA FILE NO. 7-C1
DSA APPL. No. 01-106226

To: tBPOArchitecture
1000 Burnett Ave, Suite 140
Concord, CA 94520

Attn: Celia Chiang, Tom Beckett
Fax: 925-246-6485

Subj.: Wall Mount Boxes Vs. Floor Mount In Rm. 229
Reference (dwg, spec.) / Bulletin 10D

Reply Requested By: 6/21/06

Project: LOS MEDANOS COLLEGE SCIENCE BUILDING
Contra Costa Community College District

tBP plh: 20247.00

RFI No: **249** (REVISED RESPONSE 6/21/06)

Subcontractor RFI: EWS 22

INFORMATION REQUESTED: Date: 6/14/06

Please note the attachd Edward W. Scott RFI No. 22 regarding dimensions for the Floor Boxes in room 229. Also due to possible damage EWS would like to wall mount these boxes in lieu of floor mounting. Please advise.

SUGGESTED SOLUTION:

Cost Impact ☐ Schedule Impact ☐ days By: Mark Delgado

RESPONSE: DATE:
TBP recommends that the subject junction boxes be wall mounted in lieu of floor mounted.
Due to junction boxes being wall mounted, there should be a credit for not core drilling the floor.

Larry Lei
TBP/ 6.15.06

Attachments:


By:

TRANSMITTAL RECORD:

FROM	TO	DATE
S.J. AMOROSO	tBP / ARCHITECTURE	6/14/06
tBP / ARCHITECTURE	ENGINEER/CONSULTANT	TBP - 6/14/06, Dovetail - 6/15/06
ENGINEER/CONSULTANT	tBP / ARCHITECTURE	TBP - 6/15/06, Dovetail - 6/20/06
tBP / ARCHITECTURE	S.J. AMOROSO	6/20/06
S.J. AMOROSO	ORIGINATOR	


After coordinate with District furniture consultant, location of the wall mounted junction boxs are to be 3" to corner of the table as shown as follows, typical.

Vanessa Ling/tBP
6/20/06

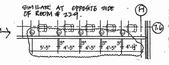


SHEET NOTES


1. 8'Hx3/4" THICK PLYWOOD TELEPHONE BACKBOARD, ON (3) WALLS OF ROOM.
2. REFER TO "ELECTRICAL LABORATORY DRAWING" FOR ADDITIONAL ELECTRICAL REQUIREMENTS IN THIS ROOM.
3. (2) 4" CONDUITS DOWN TO FIRST FLOOR DATA ROOM.
4. FLOOR MOUNTED JUNCTION BOX FOR 'POWER UP MODULES' AT BASE OF CLASS ROOM TABLES.
5. STUB 1"C FROM DATA OUTLET INTO SECOND FLOOR CEILING SPACE.
6. 120V JUNCTION BOX WITH TRANSFORMER (BY OTHERS) FOR FLUSH VALVE SENSOR.
7. 120V JUNCTION BOX FOR FAUCET MOTION SENSOR.
8. 120V JUNCTION BOX FOR FLUSH VALVE SENSOR.
9. DUPLEX RECEPTACLE FOR CEILING MOUNTED PROJECTOR. RECEPTACLE FOR PROJECTOR INSTALLED IN CEILING SPACE. COORDINATE EXACT LOCATION OF PROJECTOR WITH ARCHITECT 'RCP' DRAWINGS.
10. STUB (2) 1 1/4"C FROM 4-GANG OUTLET BOX INTO ACCESSIBLE CEILING SPACE, +6".
11. STUB (1) 3/4"C FROM 1-GANG OUTLET BOX INTO ACCESSIBLE CEILING SPACE, +6".
12. JUNCTION BOX FOR MOTORIZED WINDOW SHADE. LETTER ADJACENT TO OUTLET BOX DESIGNATES WHICH SHADES ARE CONTROLLED BY THE WINDOW SHADE CONTROLLER.
13. ROUTE HOMERUN TO RESPECTIVE MOTORIZED WINDOW SHADE CONTROL BOX.
14. CONTROL SWITCH FOR MOTORIZED SHADES 'A-D'. CONTRACTOR SHALL ROUGH-IN OUTLET BOX FOR SWITCH (2-GANG BOX). SWITCH FURNISHED BY VENDOR, INSTALLED AND CONNECTED BY CONTRACTOR.
15. WINDOW SHADE CONTROL BOX FOR MOTORIZED WINDOW SHADES. LETTER INDICATES WHICH SHADES ARE CONTROLLED BY THE WINDOW SHADE CONTROLLER.

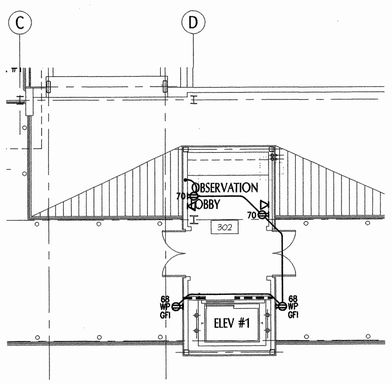



PARTIAL ROOF PLAN 2
SCALE: 1/8"=1'-0"

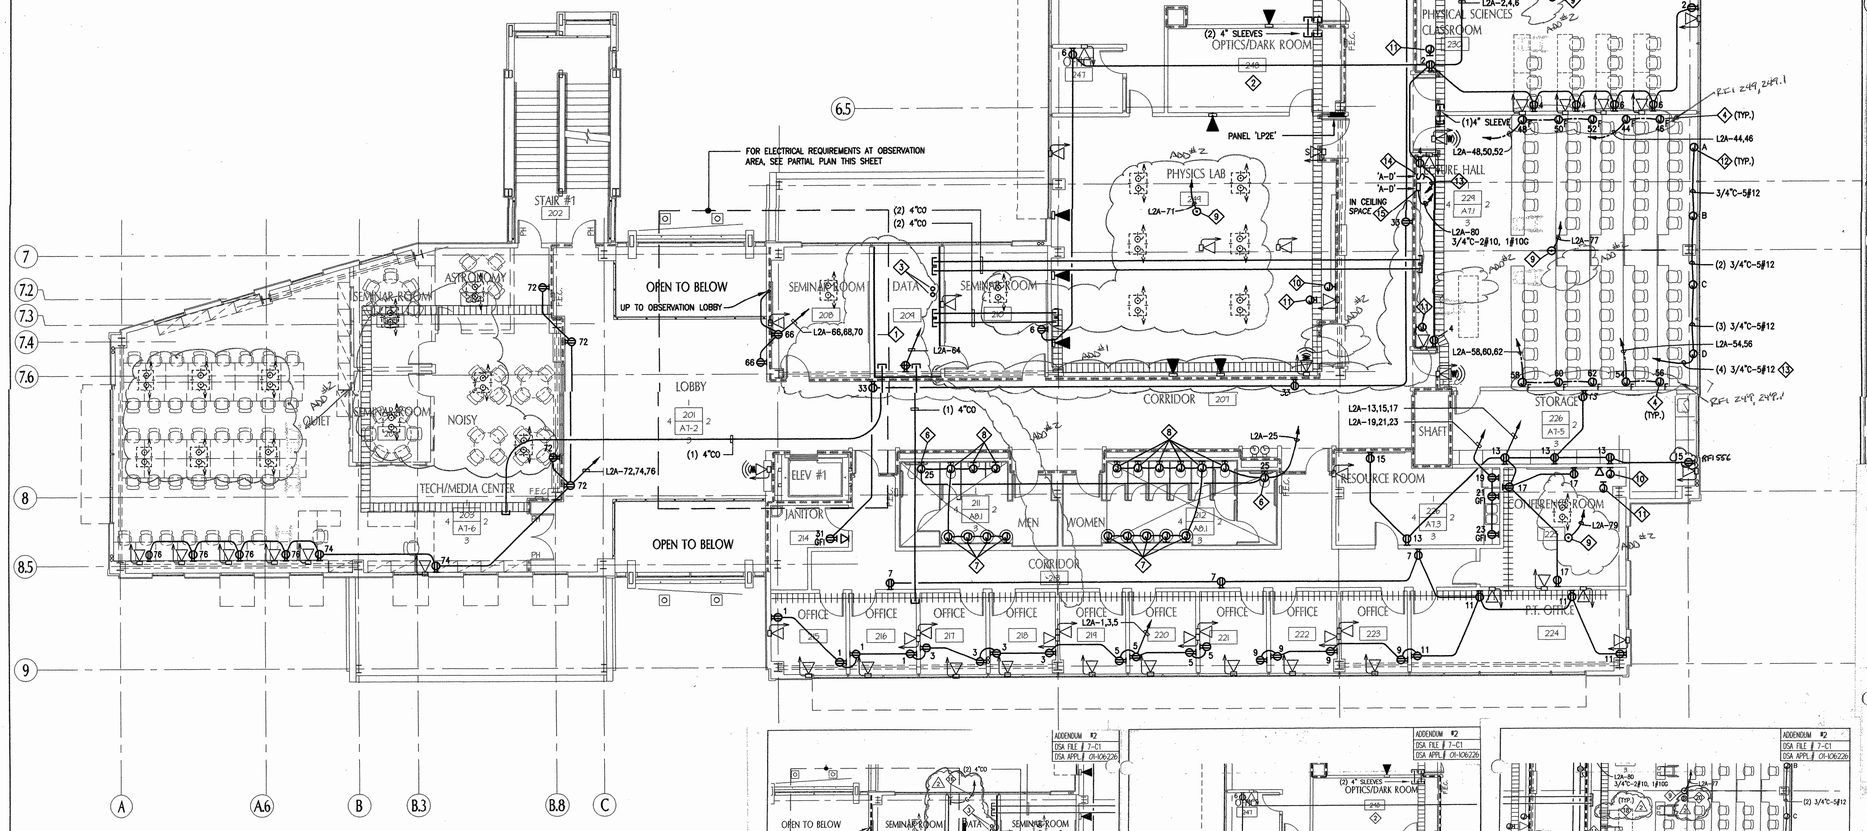



2ND FLOOR PLAN PART "B" 1
SCALE: 1/8"=1'-0"

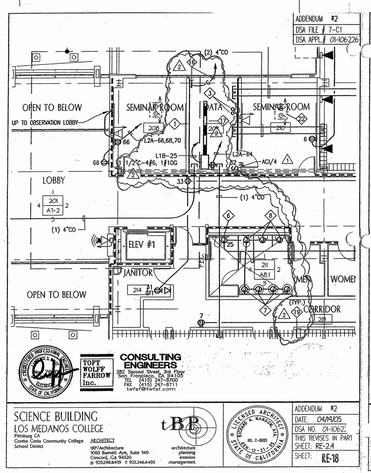

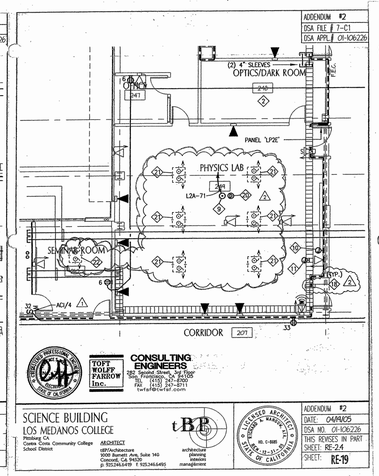

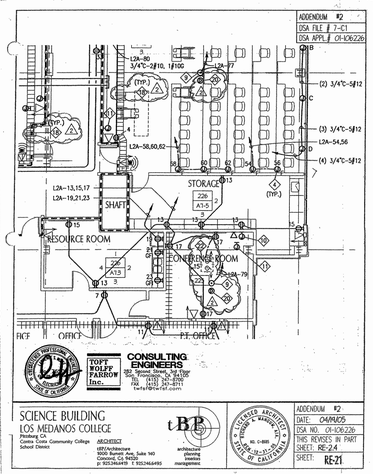

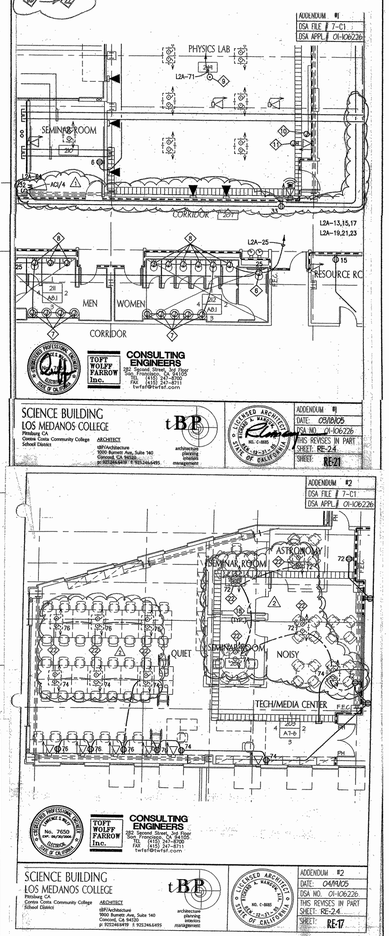

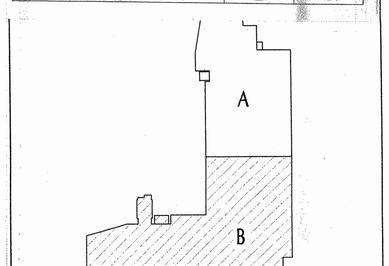

TWF #030358.00

SHEET NOTES

1. 8'Hx3/4" THICK PLYWOOD TELEPHONE BACKBOARD, ON (3) WALLS OF ROOM. REFER TO TELCOM DRAWING T3.2.
2. DUPLEX RECEPTACLE FOR CEILING MOUNTED PROJECTOR. COORDINATE EXACT LOCATION OF RECEPTACLE WITH PROJECTOR REQUIREMENTS.
3. 20"x4" COPPER GROUND BUS BAR. MOUNT AT +6'-6" AFF. ROUTE AND CONNECT 1 1/2"C-#1/0G. FROM BUS BAR TO GROUND BUS OF PANEL 'L2A', REFER TO TELCOM DRAWING T3.2.
4. 60A, 4 POLE, 300V WITH GROUND, STARLINE BUSWAY SYSTEM WITH 60A 'DNT' POWER FEED AND THE FOLLOWING:
   a. PLUG-IN BUSWAY STRAIGHT SECTION AT +8'-2" AFF.
   b. BUSWAY SUPPORT ASSEMBLY TO SUSPEND BUSWAY FROM BACK-TO-BACK 'U' CHANNEL OF GRID ABOVE.
   c. BUSWAY END CAP.
   COORDINATE LOCATION AND LENGTH OF STARLINE BUSWAY WITH TELCOM DRAWING T3.2.
5. DOUBLE SNAKETRAY IN CEILING SPACE, SEE DETAIL H, SHEET E4.2 FOR SIZE AND SUPPORT OF SNAKETRAY.
6. SINGLE SNAKETRAY IN CEILING SPACE, SEE DETAIL H, SHEET E4.2 FOR SIZE AND SUPPORT OF SNAKETRAY.
7. CEILING MOUNTED DATA OUTLET FOR PROJECTOR. COORDINATE EXACT LOCATION OF OUTLET WITH PROJECTOR REQUIREMENTS. STUB (1) 3/4"C FROM OUTLET TO SNAKETRAY IN ACCESSIBLE CEILING SPACE.
8. RECESSED FLOOR BOX, WIREMOLD #RFBB-SS WITH INTERNAL BRACKET #RFB-2AB-SS. STUB (2)1"C FROM FLOOR BOX INTO CEILING SPACE OF THE FIRST FLOOR. RECEPTACLE/CIRCUIT IN FLOOR BOX PER 'ELECTRICAL LABORATORY DRAWINGS.
9. RECESSED FLOOR BOX, WIREMOLD #RFBB-SS WITH INTERNAL BRACKET #RFB-2AB-SS. STUB (2) 1"C FROM FLOOR BOX INTO CEILING OF THE FIRST FLOOR. (1) DUPLEX RECEPTACLE INSTALLED IN FLOOR BOX.

CONSULTING ENGINEERS
TOFT WOLFF FARROW Inc.
consultant

DSA CERTIFICATION STAMP
DIV. OF THE STATE ARCHITECT
OFFICE OF REGULATION SERVICES
APP. - 01-106226
name
address
city, state, zip
pht fx
agency


SCIENCE BUILDING
LOS MEDANOS COLLEGE
Contra Costa Community College District
owner


tBP project number : 20241.00
file name: 2n-FLR-A
drawn by: LLAI checked by: LSM
date: NOVEMBER 15, 2004

Rev	date	description

drawing title:
2nd FLOOR PLAN
PART "B" - POWER/SIGNAL

LMC SCIENCE 313-023-112.01-0-00.00
drawing no.: E-2.4
SEE SHEET RE-2.4

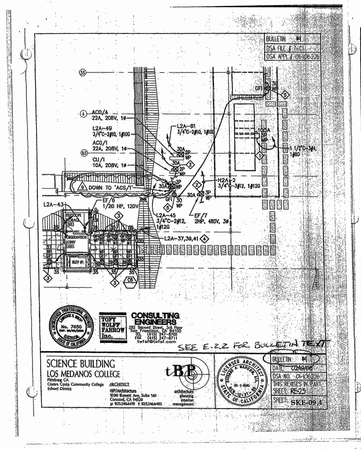

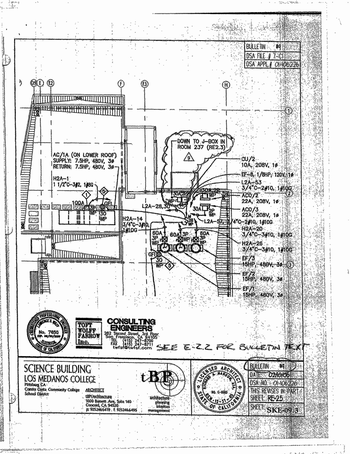

Bulletin No.54

Date: 11/8/2006

To: S.J. Amoroso Construction
390 Bridge Parkway
Redwood shores CA 94065

Project: **LOS MEDANOS COLLEGE SCIENCE BUILDING**
Contra Costa Community College District
DSA No.01-106226, File #7-C1
IBP P/N 20247.00

Description:

REFERENCE: Submittal No. 112

Provide and install a 120V circuit going to the smoke containment system. Tie this system into the fire alarm system via a local smoke detector.

1.) Utilize circuit 1,2A-31 in room 214 for required 120V power to Smoke Guard system (dedicated circuit not required).

2.) Fire alarm tie-in for elevator Smoke Guard system shall occur at corridor smoke detector "C03" (sheet FA-1.4).

The elevator smoke door has no relation to the elevator recall programming at the subject smoke detector. Connection to the smoke detector shall be per instructions indicated in the overhead elevator door smoke containment submittal #112.

Issued by: Architect
Requested By: Electrical
Reason: No Circuit Going to Elevator Smoke Containment System
Enclosures: No Attachments
Distribution:

Copies:	Name:	Organization:
1 copy	Mark Delgado	S. J. Amoroso
1 copy	Cam Perrotta	CCCC District
1 copy	Bob Hicks	Inspector of Record
1 copy	Tom Beckett	IBP/Architecture
1 copy	File 20247.007.4	IBP/Architecture
1 copy	Larry Lai	TWF

Action:
- ☐ For Information/Clarification only
- ☒ Provide Price/Credit Proposal. (Refer to this Bulletin No. when responding)
- ☐ Requires DSA review and approval
- ☐ Proceed as authorized by District

IBP/Architecture 1000 Burnett Ave. Suite 140 - Concord, CA. 94520 ph: 925.246.6419 - fax: 925.246.6495

S. J. AMOROSO
Request For Information/Clarification

DSA FILE NO. 7-C1
DSA APPL. No. 01-106226

To: IBP/Architecture
1000 Burnett Ave. Suite 140
Concord, CA 94520

Project: LOS MEDANOS COLLEGE
SCIENCE BUILDING
Contra Costa Community College District

Attn: Celia Chiang, Tom Beckett
Fax: 925.246.6495

IBP p/n: 20247.00

Subj.: Overhead smoke door memorandum

RFI No: **422**
Subcontractor RFI:

Reference (dwg, spec.): none

Reply Requested By: 11/8/06

INFORMATION REQUESTED: Date: 11/2/06

We have received the attached IBP memo titled "Additional Review of Submittal No. 112" which states:
"We will need to show a 120V circuit going to the smoke containment system and we will need to tie the system into the fire alarm system via a local smoke detector. Provide a PCO accordingly"

However, the IBP memo offers no information regarding which panel/ circuit the 120V power is to be taken from or if this needs to be a dedicated line. Also, no information is given regarding how this is to tie into the fire alarm system such as which smoke detector to tie to or the relationship of this overhead smoke door to elevator/recall programming.

Please provide a Bulletin with the needed design information so that we can proceed with this issue.

SUGGESTED SOLUTION:
Cost Impact: ☐ Schedule Impact: ☐ days By: Mark Delgado

RESPONSE: DATE: 11/08/06

Please refer to future Bulletin No. 54.

Thank you,
Jeff Mills

RFI # 000
Page 1

S. J. AMOROSO
Request For Information/Clarification

DSA FILE NO. 7-C1
DSA APPL. No. 01-106226

To: IBP/Architecture
1000 Burnett Ave. Suite 140
Concord, CA 94520

Project: LOS MEDANOS COLLEGE
SCIENCE BUILDING
Contra Costa Community College District

Attn: Celia Chiang, Tom Beckett
Fax: 925.246.6495

IBP p/n: 20247.00

Subj.: Location of combination motor starters/ disconnects
Reference (dwg, spec.): E2.5

RFI No: **508**
Subcontractor RFI:

Reply Requested By: 4/4/07

INFORMATION REQUESTED: Date: 3/29/07

Sheet E2.5 shows the power to roof top units. Sheet note 2 calls for combination motor/starters and this note is applied twice on the sheet, at ACO/1 and at EF/7 (should be labeled EF/5 since EF/7 is at the chiller building.
We understand that in fact, EF/ 3 and EF/4 need combination motor starters/disconnects.
Please confirm. We suggest "moving" the motor starters/disconnects from the two locations shown to the two locations needed.
Also, please confirm that ACO/1, ACO/4, EF/5 and CU/1 require disconnects.

SUGGESTED SOLUTION:
Cost Impact: ☐ Schedule Impact: ☐ days By: Justin Vitrano

RESPONSE: DATE:

Acknowledged EF/7 at sheet E2.5 should be labeled EF/5. EF/7 occurs at chiller building. ☒

To Clarify:
1. EF/1, 2, 7 require VFD's per fan schedule.
2. EF/3, 4, 5, 6 require disconnect switches (furnished and installed by electrical and shown per E2.5) and starters (furnished by mechanical and installed by electrical. See spec 15050, 3.01D).
3. ACO/AC/Fs and ACS/CUs require only disconnects. (See symbol indications shown E2.5).


Jim Weaver / IBP Architecture
L. Lai / TWF
D. Weston / Ainsworth Associates

4/6/07
* EF/6 does not need a motor starter per electrical as equipment by electrical

RFI # 000
Page 1

SHEET NOTES


1. CONNECT DISCONNECT SWITCH TO VARIABLE FREQUENCY DRIVE (BY OTHERS).
2. COMBINATION STARTER/DISCONNECT SWITCH, HORSEPOWER RATED.
3. RECEPTACLE MOUNTED ON POST FOR TELESCOPE.
4. RUN CIRCUIT HOMERUN TO PANEL 'L2A' VIA. SECOND FLOOR CEILING SPACE.
5. CONVENIENCE RECEPTACLE MOUNTED ON HVAC UNIT.

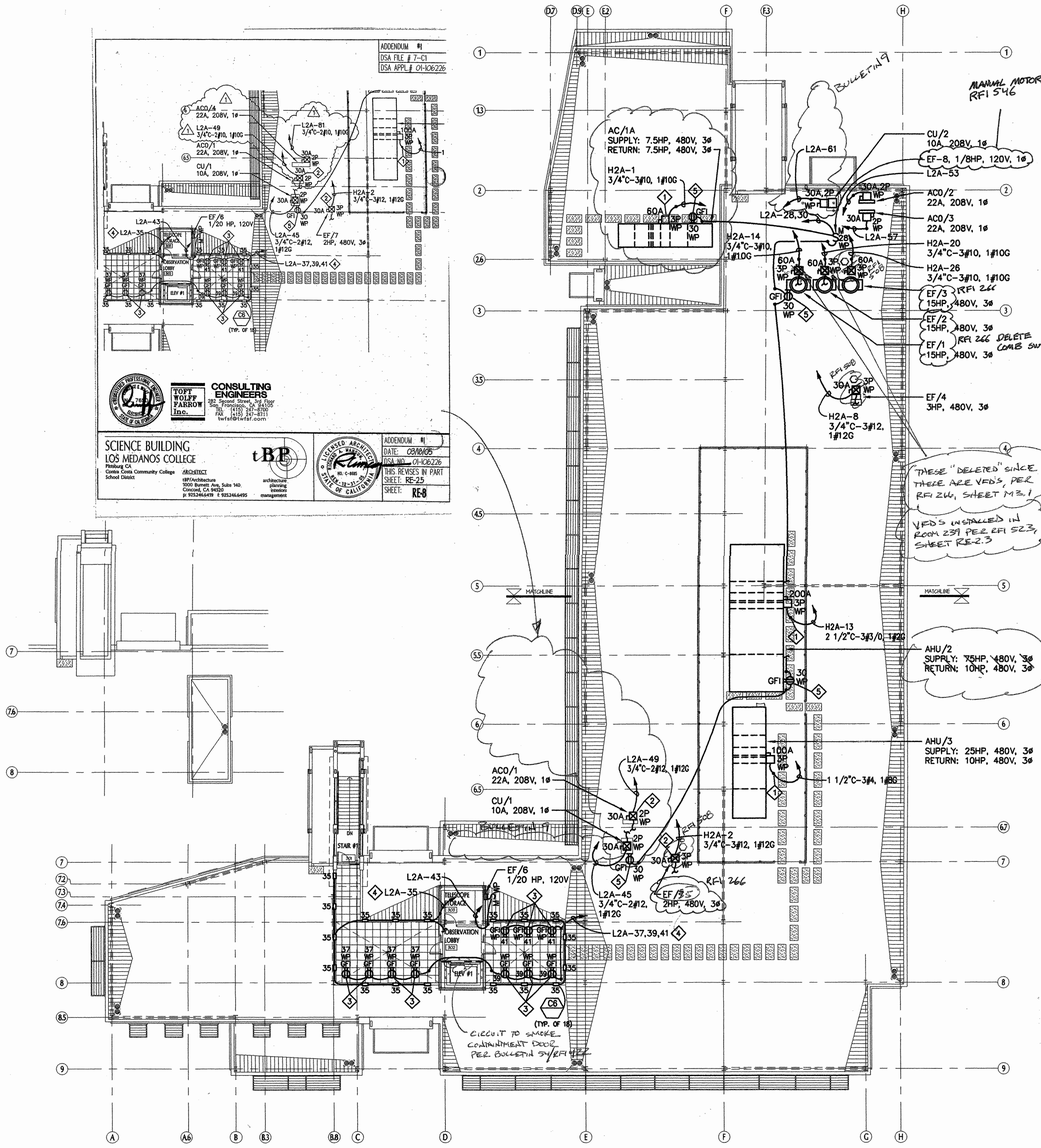

ROOF PLAN
SCALE: 1/16"=1'-0"

1

KEY PLAN

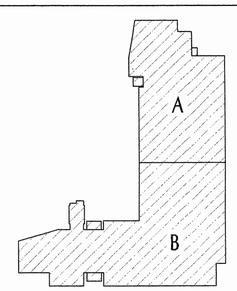

TWF #03058.00

tBP architecture planning interiors management
tBP/Architecture
1000 Burnett Avenue, Suite 140
Concord, CA 94520
p: 9252466499 f: 9252466495
architect

CONSULTING ENGINEERS
TOPP WOLFF PARROW Inc.
383 Second Street, Ste 1000
San Francisco, CA 94105
TEL (415) 247-8700
FAX (415) 247-8711
twfsf@twfsf.com
consultant

name
address
city, state, zip
ph:
fx:
agency

SCIENCE BUILDING
LOS MEDANOS COLLEGE
Contra Costa Community College District
owner

tBP project number : 20247.00
file name: 1s-FLR-A
drawn by: LLAI checked by: LSN
date: NOVEMBER 15, 2004

Rev	date	description

drawing title:
ROOF PLAN

LMC SCIENCE 313-023-112.01-0-00.00
drawing no.:
E-2.5

S. J. AMOROSO
Request For Information/Clarification

DSA FILE NO. 7-C1
DSA APPL. No. 01-106226

To: IBP/Architecture
1000 Burnett Ave, Suite 140
Concord, CA 94520

Attn.: Celia Chiang, Tom Beckett
Fax: 925-246-6486

Subj.: Cooling Tower Disconnect Switch

Reference (dwg, spec.): E2.6

Reply Requested By: 5/14/07

Project: LOS MEDANOS COLLEGE
SCIENCE BUILDING
Contra Costa Community College District

IBP p/n: 20247.00

RFI No: **524**

Subcontractor RFI: EWS 87

INFORMATION REQUESTED: Date: 5/7/07

Please note the attached EWS RFI No. 87 regarding the disconnect switch on the cooling tower raised platform which does not have the proper clearance to be installed. Please advise.

SUGGESTED SOLUTION:

Cost Impact: ☐ Schedule Impact: ☐ days By: Justin Warren

RESPONSE: DATE:

No exception taken to installing disconnect at concrete support adjacent to ladder to be located with Joe from Scott Elect at 5/8/07 jobwalk. Maintain 36" clearance as required.

Tom Beckett / IBP Architecture

5/9/07

RFI # 000
Page 1

EDWARD W. SCOTT ELECTRIC CO., INC.
426 HARRIET STREET
San Francisco, CA 94103-4914
Phone: (415) 626-0701 Fax: (415) 626-3837

REQUEST FOR INFORMATION

PROJECT: LMC SCIENCE BLDG. R.F.I.# 87 R.F.I. Date 5/4/07
JOB: 2451 ACTUAL REPLY DATE:

TO: MARK DELGADO
GB: REDDICK PAINT
BRANCH: E-26
LOCATION: COOLING TOWER

POTENTIAL COST IMPACT
___ COST ___ SCHEDULE
___ OTHER ___ LABOR
___ NO IMPACT ___ MATERIAL

INFORMATION REQUESTED: WE ARE UNABLE TO INSTALL THE DISCONNECT SWITCH ON THE COOLING TOWER RAISED PLATFORM DUE TO LACK OF PROPER CLEARANCE. THE ALTERNATIVE IS TO INSTALL IT ON THE GROUND LEVEL NEXT TO THE LADDER.

REPLY REQUIRED BY: ASAP SIGNED:
NOTE: IF NO REPLY IS RECEIVED BY US BY THE ABOVE NOTED DATE, A TIME EXTENSION WILL BE REQUIRED WITH POSSIBLE COST IMPACTS.

RESPONSE:

DATED: SIGNED:

INDUSTRIAL, COMMERCIAL WIRING & DESIGN
STATE CONTRACTOR LICENSE NO. 190435

EDDOCH

PANEL 'CH'


VOLTS: 120/208V — PHASE: 3 — MAIN: 30A 3P BREAKER
MOUNTING: (LOCATED IN 'MCC-CH') — WIRE: 4 — BUSSING: 100A


LOAD	*	A-VA	B-VA	C-VA	BKR	CT	CT	BKR	A-VA	B-VA	C-VA	*	LOAD
RECEPTACLES	R	1080			20/1	1	2						SPACE
RECEPTACLES	R		180		20/1	3	4						SPACE
LIGHTS	L			700	20/1	5	6						SPACE
REFRIGERANT MONITOR	C	100			20/1	7	8						SPACE
SPACE						9	10						SPACE
SPACE						11	12						SPACE
SPACE						13	14						SPACE
SPACE						15	16						SPACE
SPACE						17	18						SPACE
SPACE						19	20						SPACE
SPACE						21	22						SPACE
SPACE						23	24						SPACE
PHASE TOTALS:		1180	180	700	2060 =TOTAL CONNECTED LOAD,VA (FOR DEMAND LOAD SEE BELOW)								
PHASE AMPERES:		9.8	1.5	5.8									

*DEMAND LOAD CALCULATION:

L=LIGHTING LOADS:	1.25	X	700	=	875	VA
C=CONTINUOUS LOADS, OTHER:	1.25	X	100	=	125	VA
M=MOTOR LOADS (INCL LOST):	1.00	X	0	=	0	VA
LARGEST, VA:	0.25	X	0	=	0	VA
R=RECEPTACLES: 1ST 10K:	1.00	X	1260	=	1260	VA
BALANCE:	0.50	X	0	=	0	VA
K=KITCHEN LOADS: QTY: 0	1.00	X	0	=	0	VA
N=NONCONTINUOUS LOADS, OTHER:	1.00	X	0	=	0	VA
(N=PANEL, INCL. IN ABOVE)						
NEW DEMAND LOAD				=	2280	VA = 6.3 AMPERES
EXISTING LOAD VA		X	1.25	=	0	VA = 0.0 AMPERES
TOTAL LOAD				=	2280	VA = 6.3 AMPERES

NOTES:

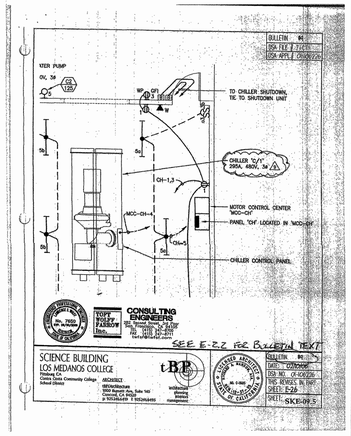

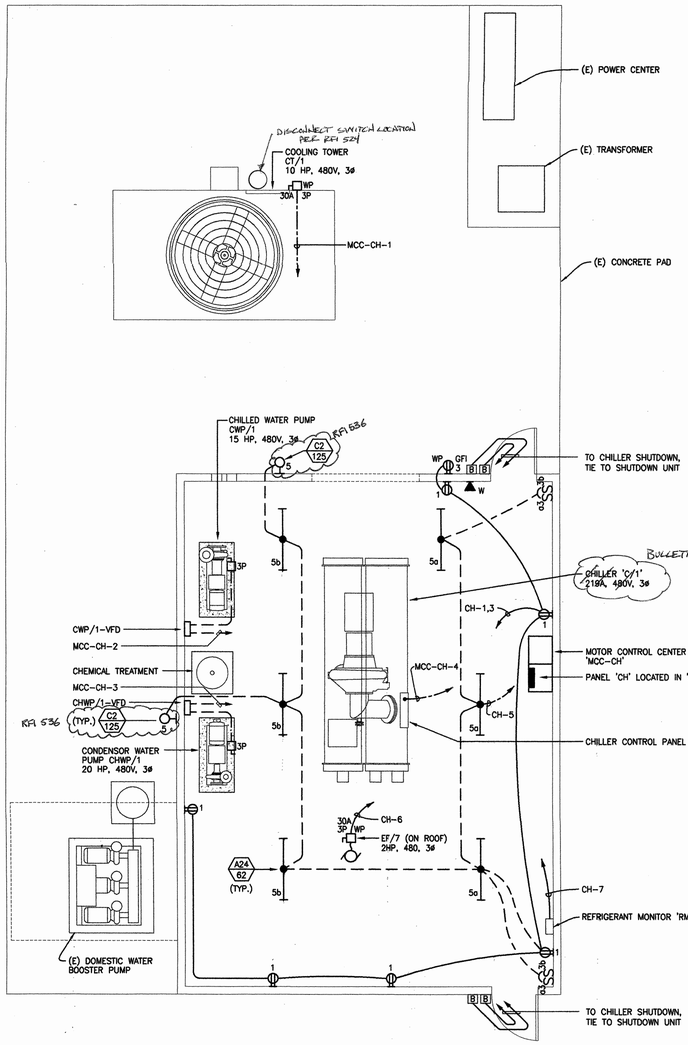

MECHANICAL/CHILLER/PUMP BUILDING

SCALE: 1/4"=1'-0"

1 / E2.6

TWF #03058.00

tBP architecture planning interiors management
tBP/Architecture
1000 Burnett Avenue, Suite 140
Concord, CA 94520
p: 925.246.6419 | f: 925.246.6495
architect

CONSULTING ENGINEERS
TOFF WOLFF FARROW Inc.
282 Second Street, 3rd Floor
San Francisco, CA 94105
PH (415) 247-8711
FAX (415) 247-8711
twfsf@twfsf.com
consultant

name
address
city, state, zip
ph:
fx:
agency

SCIENCE BUILDING
LOS MEDANOS COLLEGE

Contra Costa Community College District


owner

tBP project number : 20241.00
file name: DETAIL
drawn by: LLAI checked by: LSM
date: NOVEMBER 15, 2004

Rev's	date	description

drawing title:
PARTIAL PLAN

LMC SCIENCE 313-023-112.01-0-00.00
drawing no:
E-2.6

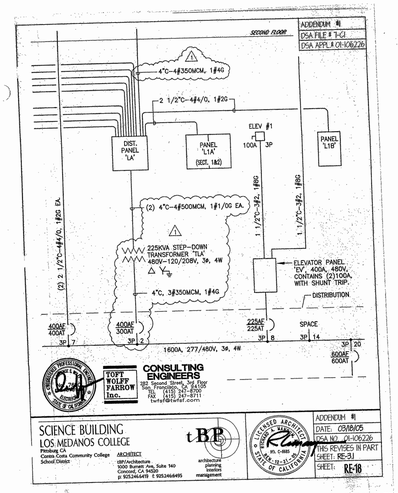

S. J. AMOROSO
Request For Information/Clarification

DSA FILE NO. 7-C1
DSA APPL. No. 01-106226

To: tBP/Architecture, 1000 Burnett Ave, Suite 140, Concord, CA 94520
Attn: Celia Chiang, Tom Beckett
Fax: 925-246-6495

Project: LOS MEDANOS COLLEGE SCIENCE BUILDING, Contra Costa Community College District
tBP proj: 20247.00

Subj.: Power to drinking fountains

RFI No: 351
Subcontractor RFI:

Reference (dwg, spec.): E-3.1, RE-2.1 thru 2.4, PS.1

Reply Requested By: 9/28/06

INFORMATION REQUESTED: Date: 9/21/06

Per panel schedule on sheet E-3.1, panel L2A has two breakers for drinking fountains. However, the powerlignal drawings on sheets RE-2.1 thru RE-2.4 do not show distribution to the drinking fountain locations nor do the drinking fountain fixtures contain water chillers (i.e. they do not need power). Please advise what is desired in this situation.


SUGGESTED SOLUTION:
Cost impact: ☐ Schedule impact: ☐ days By: Mark Delgado


RESPONSE: DATE:


Allow the drinking fountains do not require power. TMP recommends that the circuits indicated for drinking fountains become spares.


Larry Lei/TMP
9/21/06


RFI # 000
Page 1

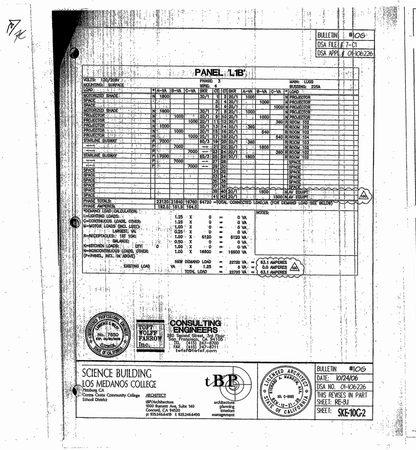

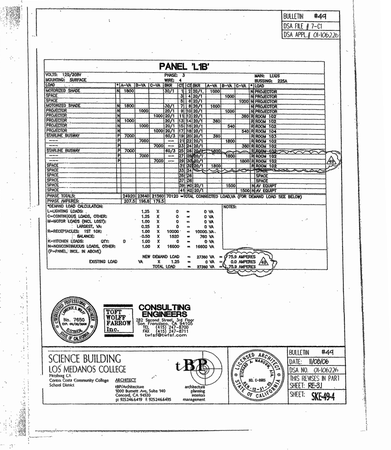

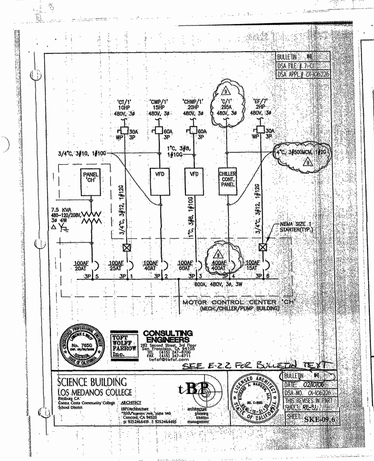

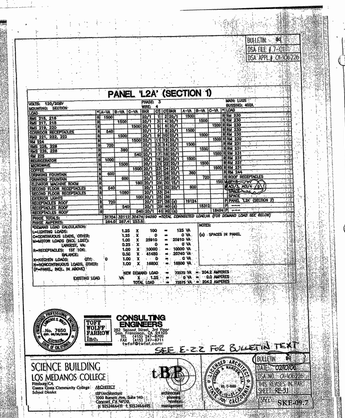

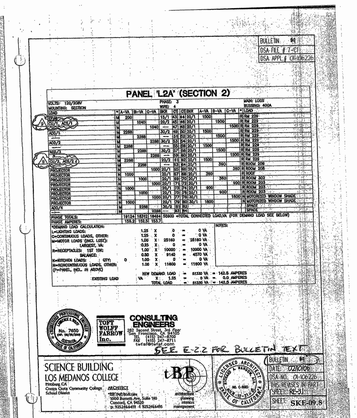

S. J. AMOROSO
Request For Information/Clarification

DSA FILE NO. 7-C1
DSA APPL. No. 01-106226

To: tBP/Architecture, 1000 Burnett Ave, Suite 140, Concord, CA 94520
Attn: Celia Chiang, Tom Beckett
Fax: 925-246-6495

Project: LOS MEDANOS COLLEGE SCIENCE BUILDING, Contra Costa Community College District
tBP proj: 20247.00

Subj.: Size of Conduit/Wire Feeding Elev. Panel "EV"

RFI No: 159
Subcontractor RFI: EWS 10

Reference (dwg, spec.): E-3.1

Reply Requested By: 3/2/06

INFORMATION REQUESTED: Date: 3/23/06

Please note the attached Scott Electric RFI No. 10 regarding the one line diagram on Drawing E-3.1 which does not specify the size of conduit or wire feeding elevator panel "EV". Please advise.

SUGGESTED SOLUTION:
Cost impact: ☐ Schedule impact: ☐ days By: Mark Delgado

RESPONSE: DATE:

In response to RFI#159:

Feeder to Panel 'EV' shall be 2-1/2" C- 3 #4/0, 1 #2G.

LLH


Tutt Wolff Farrow Inc.

By:

TRANSMITTAL RECORD:

FROM	TO	DATE
S.J. AMOROSO	tBP / ARCHITECTURE	3/23/06
tBP / ARCHITECTURE	ENGINEER/CONSULTANT TWF	3-24-06
ENGINEER/CONSULTANT	tBP / ARCHITECTURE	3-24-06
tBP / ARCHITECTURE	S.J. AMOROSO	3-27-06
S.J. AMOROSO	ORIGINATOR	

RFI # 000
Page 1

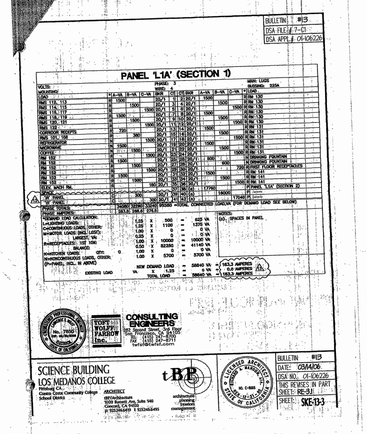

S. J. AMOROSO
Request For Information/Clarification

DSA FILE NO. 7-C1
DSA APPL. No. 01-106226

To: tBP/Architecture, 1000 Burnett Ave, Suite 140, Concord, CA 94520
Attn: Celia Chiang, Tom Beckett
Fax: 925-246-6495

Project: LOS MEDANOS COLLEGE SCIENCE BUILDING, Contra Costa Community College District
tBP proj: 20247.00

Subj.: Panel LP1B

RFI No: 393
Subcontractor RFI: EWS 48

Reference (dwg, spec.): ES.1/LE3-1

Reply Requested By: 10/26/06

INFORMATION REQUESTED: Date: 10/18/06

Please note the attached Edward Scott RFI No. 48 regarding Panel LP1B which is a 400amp Panel. It is being fed from Panel LA from a 400amp breaker. Please advise.

SUGGESTED SOLUTION:
Cost Impact: ☐ Schedule Impact: ☐ days By: Mark Delgado

RESPONSE: DATE:

Panel 'LP1B' requires a feeder rated at (2) 3-1/3"C - 4 #3/0, 1 #3G each, in lieu of (1) 2-1/2"C - 4 #1/0, 1 #6G.

If the original 2-1/2"C has not been installed yet, then a feeder rated at 3"C - 4 #500MCM, 1 #3G is recommended for panel 'LP1B'.

Larry Lei/TWF - 10/20/06

RFI # 000
Page 1

EDWARD W. SCOTT ELECTRIC CO., INC.
435 HARRIET STREET
San Francisco, CA 94103-4914
Phone: (415) 626-0701 Fax: (415) 626-2837

REQUEST FOR INFORMATION

PROJECT: SCIENCE BLDG. R.F.I.# 48 R.F.I. Date 10/18/06
JOB: 2451 ACTUAL REPLY DATE:

TO: MARK DELGADO
OF: AMOROSO CONST.
REF.DWG: E-3.1/LE3-1
LOCATION: SCIENCE BLDG

POTENTIAL COST IMPACT
X COST
OTHER
NO IMPACT
SCHEDULE
LABOR
MATERIAL

INFORMATION REQUESTED: PANEL LP1B (LE3-1) IS A 400AMP PANEL AS WAS FED FROM PANEL LA (2-1) FEMALE LUG WITH BREAKER WITH A 4/0 CONDUIT WITH 4-1/0 + #6 GROUND IS THIS CORRECT ? PLEASE ADVISE.


REPLY REQUIRED BY: 10/26/06 SIGNED:
NOTE: IF NO REPLY IS RECEIVED BY US BY THE ABOVE NOTED DATE, A TIME EXTENSION WILL BE REQUIRED WITH POSSIBLE COST IMPACTS.

RESPONSE:

DATED: SIGNED:

INDUSTRIAL, COMMERCIAL WIRING & DESIGN
STATE CONTRACTOR LICENSE NO. 190436

Los Medanos College
4CD Proj.# : L-565-B-23-SC
Science Building

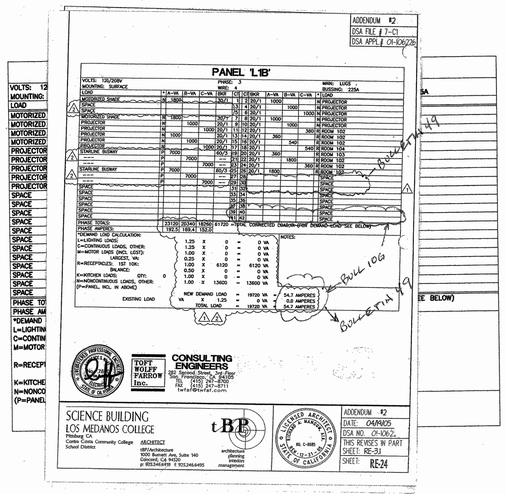
ADDENDUM #2
DSA FILE # 7-C1
DSA APPL # 01-106226
PANEL 'L1B'
VOLTS: 120/208V
MOUNTING: SURFACE
PHASE: 3
WIRE: 4
MAIN: LUGS ONLY 225A
LOAD
MOTORIZED SHADE
SPACE
PROJECTOR
PROJECTOR
PROJECTOR

CERTIFICATE OF COMPLIANCE (Part 1 of 3) LTG-1

PROJECT NAME: LOS MEDANOS COLLEGE – Contra Costa Community College District		DATE: 2/27/04
PROJECT ADDRESS: 2700 E. Leland Road – Pittsburg, CA 94565		Building Permit #
PRINCIPAL DESIGNER–LIGHTING: TOFT WOLFF FARROW INC.	TELEPHONE: (415) 247–8700	
DOCUMENTATION AUTHOR: TOFT WOLFF FARROW INC.	TELEPHONE: (415) 247–8700	Checked by/Date / Enforcement Agency Use

GENERAL INFORMATION

DATE OF PLANS	BUILDING CONDITION FLOOR AREA	CLIMATE ZONE
2/27/04	34,677	

BUILDING TYPE: [X] NONRESIDENTIAL [ ] HIGH RISE RESIDENTIAL [ ] HOTEL/MOTEL GUEST ROOM

PHASE OF CONSTRUCTION: [X] NEW CONSTRUCTION [ ] ADDITION [ ] ALTERATION [ ] UNCONDITIONED (FILE AFFIDAVIT)

METHOD OF ENVELOPE: [X] COMPLETE BLDG. [ ] AREA CATEGORY [ ] TAILORED [ ] PERFORMANCE

STATEMENT OF COMPLIANCE

This Certificate of Compliance lists the building features and performance specifications need to comply with Title 24, Parts 1 and 6 of the California Code of Regulations. This certificate applies only to building lighting requirements.

The documentation preparer hereby certifies that the documentation is accurate and complete.

DOCUMENTATION AUTHOR	SIGNATURE	DATE
LAWRENCE LAI		2/27/04

The Principal Lighting Designer hereby certifies that the proposed building design represented in this set of construction documents is consistent with the other compliance forms and worksheets, with the specifications, and with any other calculations submitted with this permit application. The proposed building has been designed to meet the envelope requirements contained in the applicable parts of Section 110, 119, 130 through 132, 146 and 149 of Title 24, Part 6.

Please check one:

[X] I hereby affirm that I am eligible under the provisions of Division 3 of the Business and Professions Code to sign this document as the person responsible for its preparation; and that I am licensed in the State of California as a Civil Engineer, Electrical Engineer, or I am a licensed architect.

[ ] I affirm that I am eligible under the provisions of Division 3 of the Business and Professions Code by section 5537.2 or 8737.3 to sign this document as the person responsible for its preparation; and that I am a licensed contractor performing this work.

[ ] I affirm that I am eligible under Division 3 of the Business and Professions Code to sign this document because it pertains to a structure or type of work described as exempt pursuant to Business and Professions Code Sections 5537, 5538 and 6737.1.

(These sections of the Business and Professions Code are printed in full in the Nonresidential Manual.)

PRINCIPAL LIGHTING DESIGNER–NAME	SIGNATURE	LIC.#	DATE
Lawrence S. Wolff, P.E.		E–7650	9/30/06

LIGHTING MANDATORY MEASURES

Indicate location on plans of Note Block for Mandatory Measures: E4.1

INSTRUCTION TO APPLICANT

For detailed instructions on the use of this and all Energy Efficiency Standards compliance forms, please refer to the Nonresidential Manual published by the California Energy Commission.

LTG–1: Required on plans for all submittals. Part 2 and 3 may be incorporated in schedules on plans.

LTG–2: Required for all submittals.

LTG–3: Optional. Use only if lighting control credits are taken.

LTG–4: Optional. Parts 2 and 3 and LTG–5 are optional if Tailored Method is used.

Nonresidential Compliance Form — January 2001

LIGHTING COMPLIANCE SUMMARY LTG-2

PROJECT NAME: LOS MEDANOS COLLEGE – Contra Costa Community College District — DATE: 2/27/04

ACTUAL LIGHTING POWER

LUMINAIRE NAME	Type DESCRIPTION	NUMBER OF LUMINAIRES	WATTS PER LUMINAIRE (Including Ballast)	CEC DEFAULT? Y	N	TOTAL WATTS
A1	2'x4' Fluor., Parabolic Louver	80	62	X		4960
A2	2'x4' Fluor., Parabolic Louver	5	70	X		350
A3	2'x4' Fluor., Parabolic Louver	2	70	X		140
A4	4' Fluor.	8	62	X		496
A5	2'x4' Fluor., Parabolic Louver	10	62	X		620
A6	9"x4' Fluor., Parabolic Louver	84	62	X		5208
A7	9"x4' Fluor., Parabolic Louver	50	62	X		3100
A8	8' Industrial Fluor.	6	62	X		372
A9	2'x4' Industrial Fluor., Parabolic Louver	132	86	X		11352
A10	2'x4' Fluor., Prismatic lens	3	62	X		186
A11	2'x4' Fluor., Prismatic lens	1	64	X		64
A12	2'x4' Fluor., Prismatic lens	2	64	X		128
A13	4' Industrial Fluor. Fixture	2	62	X		124
A14	4' Cove Fluor. Fixture	1	32	X		32
A15	8' Cove Fluor. Fixture	3	62	X		186
A16	12' Cove Fluor. Fixture	4	94	X		376
A17	20' Cove Fluor. Fixture	1	156	X		156
A18	8' Fluor., Indirect/direct	15	124	X		1860
A19	8' Fluor., Indirect/direct	6	124	X		744
A20	2'x4' Fluor. Parabolic Louver	31	86	X		2666
A21	2'x4' Fluor. Parabolic Louver	22	96	X		2112
A22	2'x4' Fluor. Parabolic Louver	28	96	X		2688
A24	4' Industrial Fluor.	6	64	X		384
A25	4' Fluor. Prismatic Lens	4	32	X		128
B1	8" Dia. Compact Fluor.	20	35	X		700
B2	8" Dia. Compact Fluor.	25	35	X		875
B3	8" Dia. Compact Fluor.	36	45	X		1620
B4	8" Dia. Compact Fluor.	30	45	X		1350
B5	8" Dia. Compact Fluor.	2	35	X		70
B6	14" Dia. Fluor.	40	42	X		1680
C1	Wall Mtd. Compact Fluor.	2	17	X		34

SUBTOTAL FROM THIS PAGE: 44761

PLUS SUBTOTAL FROM CONTINUATION PAGE:

PORTABLE LIGHTING (From LTG–1 Part 3 of 3): 0

LESS CONTROL CREDIT WATTS (From LTG–3):

ADJUSTED ACTUAL WATTS: 44761

ALLOWED LIGHTING POWER (Choose One Method)

COMPLETE BUILDING METHOD

BUILDING CATEGORY (From 146(b) Table 1–M)	WATTS PER SF	COMPLETE BLDG. AREA	ALLOWED WATTS
SCHOOLS	1.4	61,332	85864.8

AREA CATEGORY METHOD

AREA CATEGORY (From 146(b) Table 1–N)	WATTS PER SF	AREA (SF)	ALLOWED WATTS
TOTALS		0 AREA	0 WATTS

TAILORED METHOD

TOTAL ALLOWED WATTS (From LTG–4):

Nonresidential Compliance Form — January 2001

CERTIFICATE OF COMPLIANCE (PART 2 of 3) LTG-1

PROJECT NAME: LOS MEDANOS COLLEGE – Contra Costa Community College District — Date: 2/27/04

INSTALLED LIGHTING SCHEDULE

Name	LUMINAIRE DESCRIPTION	LAMPS Type DESCRIPTION	LAMPS No. Of Lamps	LAMPS Per Lamp	BALLASTS Type DESCRIPTION	BALLASTS No. Of Ballast	Lumindire No. Of Lumin.	Lumindire Watts/ Lumin.	TOTAL WATTS
A1	2'x4' Fluor., Parabolic Louver	Fluor 32W T8	2	32	Electronic	1	80	62	4960
A2	2'x4' Fluor., Parabolic Louver	Fluor 32W T8	2	32	Electronic	1	5	70	350
A3	2'x4' Fluor., Parabolic Louver	Fluor 32W T8	2	32	Electronic	1	2	70	140
A4	4' Fluor.	Fluor 32W T8	2	31	Electronic	1	8	62	496
A5	2'x4' Fluor., Parabolic Louver	Fluor 32W T8	2	32	Electronic	1	10	62	620
A6	9"x4' Fluor., Parabolic Louver	Fluor 32W T8	2	32	Electronic	1	84	62	5208
A7	9"x4' Fluor., Parabolic Louver	Fluor 32W T8	2	32	Electronic	1	50	62	3100
A8	8' Industrial Fluor.	Fluor 32W T8	2	32	Electronic	1	6	62	372
A9	2'x4' Industrial Fluor., Parabolic Louver	Fluor 32W T8	3	32	Electronic	2	132	86	11352
A10	2'x4' Fluor., Prismatic lens	Fluor 32W T8	2	32	Electronic	1	3	62	186
A11	2'x4' Fluor., Prismatic lens	Fluor 32W T8	2	32	Electronic	1	1	64	64
A12	2'x4' Fluor., Prismatic lens	Fluor 32W T8	2	32	Electronic	1	2	64	128
A13	4' Industrial Fluor. Fixture	Fluor 32W T8	2	32	Electronic	1	2	62	124
A14	4' Cove Fluor. Fixture	Fluor 32W T8	1	32	Electronic	1	1	32	32
A15	8' Cove Fluor. Fixture	Fluor 32W T8	2	32	Electronic	1	3	62	186
A16	12' Cove Fluor. Fixture	Fluor 32W T8	3	32	Electronic	2	4	94	376
A17	20' Cove Fluor. Fixture	Fluor 32W T8	5	32	Electronic	3	1	156	156
A18	8' Fluor., Indirect/direct	Fluor 32W T8	4	32	Electronic	2	15	124	1860
A19	8' Fluor., Indirect/direct	Fluor 32W T8	4	32	Electronic	2	6	124	744
A20	2'x4' Fluor. Parabolic Louver	Fluor 32W T8	3	32	Electronic	2	31	86	2666
A21	2'x4' Fluor. Parabolic Louver	Fluor 32W T8	3	32	Electronic	1	22	96	2112
A22	2'x4' Fluor. Parabolic Louver	Fluor 32W T8	3	32	Electronic	1	28	96	2688
A24	4' Industrial Fluor.	Fluor 32W T8	2	32	Electronic	1	6	64	384
A25	4' Fluor. Prismatic Lens	Fluor 32W T8	1	32	Electronic	1	4	32	128
									0
									0
									0
B1	8" Dia. Compact Fluor.	Fluor 32W TRT	4	32	Electronic	1	20	35	700
B2	8" Dia. Compact Fluor.	Fluor 32W TRT	1	32	Electronic	1	25	35	875
B3	8" Dia. Compact Fluor.	Fluor 32W TRT	1	32	Electronic	1	36	45	1620
B4	8" Dia. Compact Fluor.	Fluor 32W TRT	1	32	Electronic	1	30	45	1350
B5	8" Dia. Compact Fluor.	Fluor 32W TRT	1	32	Electronic	1	2	35	70
B6	14" Dia. Fluor.	Fluor 40W	1	42	Electronic	1	40	42	1680
C1	Wall Mtd. Compact Fluor.	Fluor 13WQuad	1	13	Electronic	1	2	17	34
									0
									0
									0
									0
									0

SUBTOTAL FROM THIS PAGE: 44761

Efficacy and Control Requirement of 130(c)

Control Requirements of 131(f)

PLUS SUBTOTAL FROM CONTINUATION PAGE:

PORTABLE LIGHTING (From LTG–1 Part 3 of 3): 0

LESS CONTROL CREDIT WATTS (From LTG–3):

ADJUSTED ACTUAL WATTS: 44761

MANDATORY AUTOMATIC CONTROLS

CONTROL LOCATION (Room #)	CONTROL IDENTIFICATION	CONTROL TYPE (Auto Time Switch, Exterior, etc.)	SPACE CONTROLLED	NOTE TO FIELD

CONTROLS FOR CREDIT

CONTROL LOCATION (Room # or Dwg. #)	CONTROL IDENTIFICATION	CONTROL TYPE (Occupant, Daylight, Dimming, etc.)	LUMINARIES CONTROLLED TYPE	LUMINARIES CONTROLLED # OF LUMIN.	NOTE TO FIELD

NOTES TO FIELD – For Building Department Use Only

Nonresidential Compliance Form — January 2001

PORTABLE LIGHTING WORKSHEET (Part 3 of 3) LTG-1

PROJECT NAME: LOS MEDANOS COLLEGE – Contra Costa Community College District — DATE: 2/27/04

TABLE 1A – PORTABLE LIGHTING NOT SHOWN ON PLANS FOR OFFICE AREA > 250 SQUARE FEET

A ROOM# OR ZONE ID	B DEFAULT	C AREA (SF)	D TOTAL WATTS (B X C)
	0.2		0
	0.2		0
	0.2		0
	0.2		0
	0.2		0
	0.2		0
		0	0

TABLE 1B – PORTABLE LIGHTING SHOWN ON PLANS FOR OFFICE AREA > 250 SQUARE FEET

A ROOM# OR ZONE ID	B PORTABLE LIGHTING DESCRIPTION(S) PER TASK AREA	C LUMINAIRE(S) WATTS PER TASK AREA	D TASK AREA (SF)	E NUMBER OF TASK AREAS	F TOTAL AREA (SF) (D X E)	G TOTAL WATTS (C X E)
					0	0
					0	0
					0	0
					0	0
					0	0
					0	0
				TOTAL	0	0

TABLE 1C – PLANS SHOW PORTABLE LIGHTING IS NOT REQUIRED FOR OFFICE AREA > 250 SQUARE FEET


ROOM# OR ZONE ID	TOTAL AREA (SF)	
		Designer needs to provide detailed documentation that the lighting level provided by the overhead lighting meets the needs of the space. The details include luminaire types, CU, and mounting locations relative to work areas.
TOTAL	0	

BUILDING SUMMARY – PORTABLE LIGHTING

BUILDING SUMMARY	TOTAL AREA (SF) (FROM TABLES 1A+1B+1C)	TOTAL WATTS (FROM TABLES 1A+1B)
BUILDING TOTAL	0	0

Enter on LTG–1 and 2: Portable Lighting

Nonresidential Compliance Form — January 2001

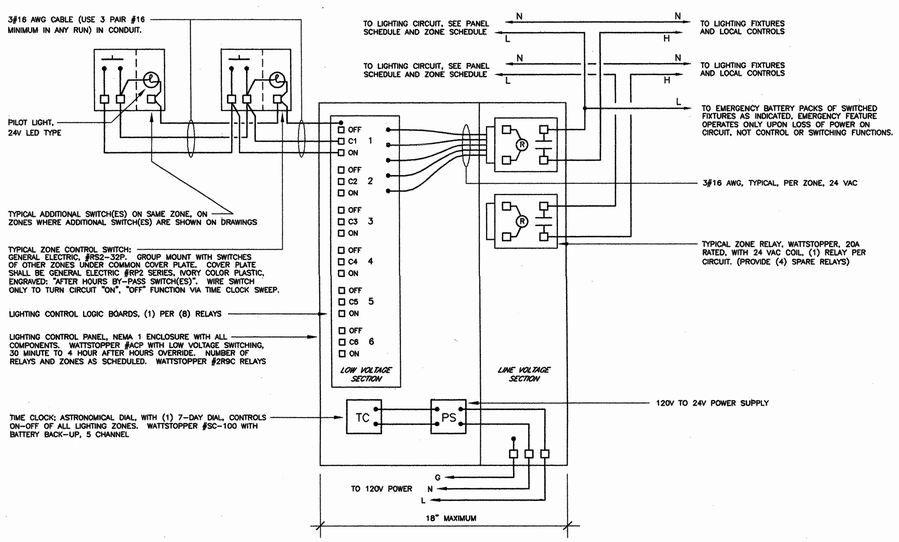

LIGHTING CONTROL DIAGRAM

NOT TO SCALE

LIGHTING ZONE SCHEDULE

ZONE NUMBER	CIRCUIT NUMBER	VOLTAGE	RELAY NUMBER
1	H1A–2	277	
2	H1A–6	277	
3	H1A–10	277	
4	H1A–1	277	
5	H1A–5	277	
6	H1A–9	277	
7	H1A–14	277	
8	H1A–16	277	
9	H1A–11	277	
10	H1A–13	277	

NOTE BLOCK FOR MANDATORY MEASURES

Building Lighting Shut–Off
The building lighting shut–off system consists of an automatic time switch, with a zone for each floor.

Override for Building Lighting Shut–off
The automatic building shut–off system is provided with a manual, accessible override switch in sight of the lights. The area of override does not exceed 5,000 square feet.

Automatic Control Devices Certified
All automatic control devices specified are certified, all alternate equipment shall be certified and installed as directed by the manufacturer.

Fluorescent Ballast and Luminaries Certified
All fluorescent fixtures specified for the project are certified and listed in the Directory, All installed fixtures shall be certified.

Tandem Wiring for Two–Lamp Ballasts
Not applicable (no one or three lamp fluorescents specified).

Individual Room/Area Controls
Each room and area in the building is equipped with a separate switch or occupancy sensor device for each area with floor–to–ceiling walls.

Uniform Reduction for Individual Rooms
Each room or enclosed space 100 square feet or larger in which the connected lighting load exceeds 0.8 watts per square foot for the space as a whole, and that has more than one lighting fixture, is controlled with bi–level switching for uniform reduction of lighting within the space.

Day Lit Area Control
All rooms with window and skylights, that are greater than 250 square feet, and that allow for the effective use of daylight in the area have 50% of the lamps in each day lit area controlled by a separate switch.

Control of Exterior Lights
Exterior mounted fixtures which are served from the electrical panel inside the building are controlled by a time clock.

TWF #03058.00

tBP architecture planning interiors management
1000 Burnett Avenue, Suite 140
Concord, CA 94520
p: 925.246.6419 f: 925.246.6495
architect

CONSULTING ENGINEERS
282 Second Street, 3rd Floor
San Francisco, CA 94105
PH (415) 247–8711
FAX (415) 247–8711
twf@twfsf.com
TOFT WOLFF FARROW Inc.
consultant

name
address
city, state, zip
ph:
agency

SCIENCE BUILDING
LOS MEDANOS COLLEGE
Contra Costa Community College District
owner

tBP project number : 20241.00
file name: PANELS
drawn by: LLAI checked by: LSW
date: NOVEMBER 15, 2004

Rev	date	description

drawing title:
TITLE 24 NOTES AND CALCULATIONS

LMC SCIENCE 313-023-112.01-0-00.00
drawing no: E-4.1

S. J. AMOROSO
Request For Information/Clarification

DSA FILE NO. 7-C1
DSA APPL. No. 01-106226

To: IBP/Architecture
1000 Burnett Ave, Suite 140
Concord, CA 94520

Attn: Celia Chiang; Tom Beckett
Fax: 925-246-0499

Project: LOS MEDANOS COLLEGE SCIENCE BUILDING
Contra Costa Community College District

IBP job: 2024/7.00

Subj.: Light attachments in drop ceiling areas

RFI No: **507**

Reference (dwg, spec.): Details E & F/ sheet E-4.2

Subcontractor RFI:

Reply Requested By: 4/4/07

INFORMATION REQUESTED: Date: 3/28/07

See attached from Performance Contracting regarding the installation of wires for ceiling grid. Please advise.

SUGGESTED SOLUTION:
Cost Impact: ☐ Schedule Impact: ☐ days By: Justin Warren

RESPONSE: DATE:

No exception taken to anchor (2) slack wires from diagonal corners of the fixtures to deck above with shot in anchor per figure no.6/5.01 (DSA IR-25) in lieu of expansion anchor per detail F/E-4.2.

This applies to fixtures less than 56 lbs.

Jim Weaver / IBP Architecture
Chiang Ng / Dasse
L. Lai / TWP.

4/4/07

RFI # 000
Page 1

04/02/2007 15:38 #459 P.001/001

PCI PERFORMANCE CONTRACTING INC

REQUEST FOR INFORMATION

Date: April 2, 2007
To: Mark Delongo
Company: DPR
From: John Frankstad

PCI RFI#: 1
Fax: (650) 327-7976
Job Name: Los Medanos Science Bldg.
Job Number: 3328
SJA Job #: 662

Reference: Steel Ceiling at areas T's

MESSAGE: Mark please confirm that shooting 2 safety wires per recessed light fixtures is acceptable. This application is in conformance with DSA IR 08-5 CEILING NOTES 1.11 Flush or recessed lignth fixtures and all terminals weighing less than 56 lbs., may be supported directly on the Main Runners of a heavy duty grid system but, in addition they must have a minimum of (2) #12 ga wires as safety wires attached to the fixture at diagonal corners and supported directly above the fixture.
Please see page A2.07 Figure 9 "3" and note 11 Metal Suspention Sys. for the Science BLDG drawings.

Also please note the most recent DSA PROJECTS in which PCI has worked with this construction detail are: SCIENCE BLDG 17 (DSA APPL 01 #107811).
GOLDORADO SCIENCE BLDG (DSA APPL #7-040 91106502).
LOS MENDANOS MATH BLDG. DSA APPL 01-106224. I am fet more projects but more these three will suffice.


Thank you for your attention to this matter.

Reply Needed by: asap
Cost Impact: Possible Schedule Impact: Possible

REPLY:


Answered by:
Date:

Performance Contracting Inc.
23466 Connecticut Street Hayward, CA 94545
Phone:(510) 266-7434 Fax:(510) 264-4205

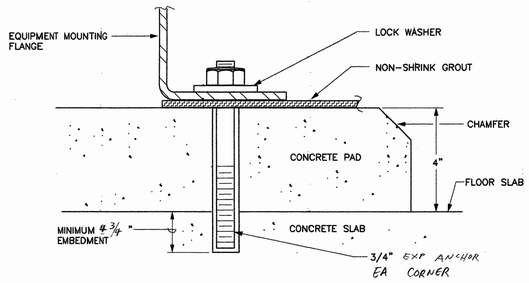


A E4.2 SWITCHBOARD MOUNTING DETAIL

NOT TO SCALE

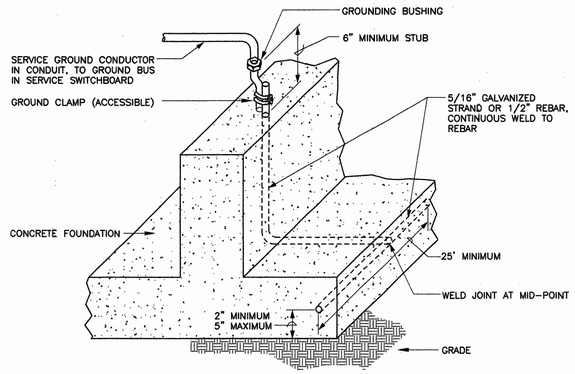


B E4.2 UFER GROUNDING DETAIL

NOT TO SCALE

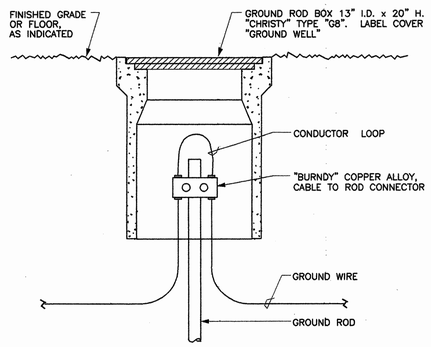


C E4.2 GROUND WELL DETAIL

NOT TO SCALE

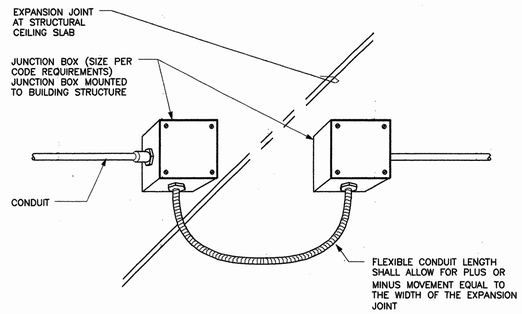

D E4.2 DETAIL OF CONDUIT CROSSING AT EXPANSION JOINT


NOT TO SCALE

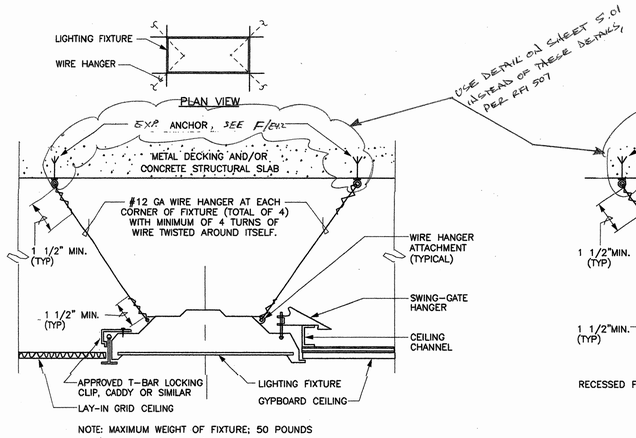

NOTE: MAXIMUM WEIGHT OF FIXTURE; 50 POUNDS

E E4.2 TYPICAL RECESSED FLUORESCENT FIXTURE MOUNTING DETAIL


NOT TO SCALE

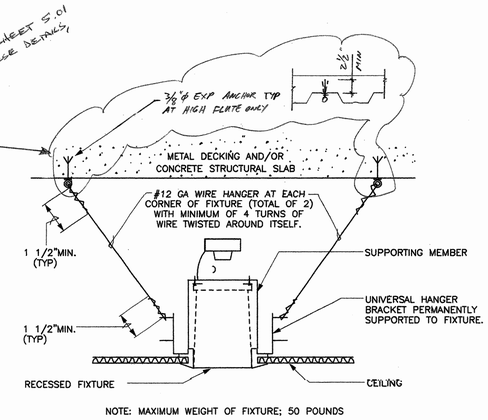

NOTE: MAXIMUM WEIGHT OF FIXTURE; 50 POUNDS

F E4.2 TYPICAL RECESSED INCANDESCENT, H.I.D. OR COMPACT FLUORESCENT MOUNTING DETAIL


NOT TO SCALE

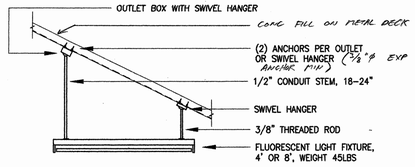

DETAIL SHOWN FOR SLOPED APPLICATION, SIMILAR FOR NON-SLOPED.

G E4.2 PENDANT OR STEM MOUNT LIGHTING FIXTURE DETAIL

NOT TO SCALE

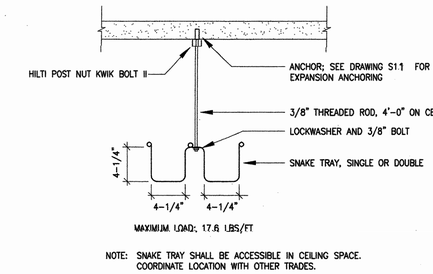


MAXIMUM LOAD: 17.6 LBS/FT

NOTE: SNAKE TRAY SHALL BE ACCESSIBLE IN CEILING SPACE. COORDINATE LOCATION WITH OTHER TRADES.

H E4.2 SNAKE TRAY SUPPORT

NOT TO SCALE

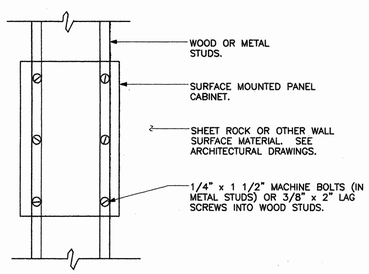

NOTES:

1. USE COMPRESSION WASHERS ON ALL BOLTS.
2. MAXIMUM PANELBOARD WEIGHT; 150 POUNDS .

I E4.2 SURFACE MOUNTED PANELBOARD INSTALLATION DETAIL

NOT TO SCALE

SEE RFI 339, SHEET E-0.1, FOR OVERHEAD CONDUIT FASTENERS

S. J. AMOROSO
Request For Information/Clarification

DSA FILE NO. 7-C1
DSA APPL. No. 01-106228

To: tBP/Architecture, 1000 Burnett Ave, Suite 140, Concord, CA 94520
Project: LOS MEDANOS COLLEGE SCIENCE BUILDING, Contra Costa Community College District
Attn: Celia Chiang, Tom Beckett
Fax: 925-246-6495
tBP job: 202471.00
Subj: Snake Tray Seismic Bracing
RFI No: 500
Reference (dwg, spec.): Various
Subcontractor RFI: EWS 78
Reply Requested By: 3/14/07
Date: 3/7/07 Received tBP 3/12/07

INFORMATION REQUESTED:
Please note the attached EWS RFI No. 78 regarding snake tray seismic bracing in relation to the walls, ductwork and plumbing. The Cable System will not work in most of these locations. EWS would like to use the attached bracing system at locations where the snake tray runs along the wall. Please advise.

SUGGESTED SOLUTION:
Cost Impact: ☐ Schedule Impact: ☐ days By: Justin Warren

RESPONSE: DATE:

No exception taken to use of attached snake tray bracing where necessary to avoid obstructions.

Jim Weaver / tBP Architecture
D. Buza / IDA
3/13/07

RFI # 000
Page 1

EDWARD W. SCOTT ELECTRIC CO., INC.
435 HARRIET STREET
San Francisco, CA 94103-4914
Phone: (415) 626-0701 Fax: (415) 626-2837

REQUEST FOR INFORMATION

PROJECT: LMC SCIENCE BLDG. R.F.I. # 78 R.F.I. Date: 3/8/07
JOB: 2451 ACTUAL REPLY DATE:

TO: MARK DELGADO
OF: AMOROSO CONST.
KEEP INFO:
LOCATION: VARIOUS

POTENTIAL COST IMPACT
— COST — SCHEDULE
— OTHER — LABOR
— NO IMPACT — MATERIAL

INFORMATION REQUESTED: DUE TO THE PROXIMATY OF THE SNAKE TRAY IN RELATION TO THE WALLS, DUCT WORK AND PLUMBING THE CABLE SYSTEM SEISMIC BRACING IS NOT FEASABLE AT MANY LOCATIONS. WE ARE PROPOSING THE USE OF THE ATTACHED BRACING SYSTEM AT LOCATIONS WHERE THE SNAKE TRAY RUNS ALONG THE WALL.


REPLY REQUIRED BY: ASAP SIGNED:
NOTE: IF NO REPLY IS RECEIVED BY US BY THE ABOVE NOTED DATE, A TIME EXTENSION WILL BE REQUIRED WITH POSSIBLE COST IMPACTS.

RESPONSE:

DATED: SIGNED:

INDUSTRIAL, COMMERCIAL WIRING & DESIGN
STATE CONTRACTOR LICENSE NO. 190416

RFI#078

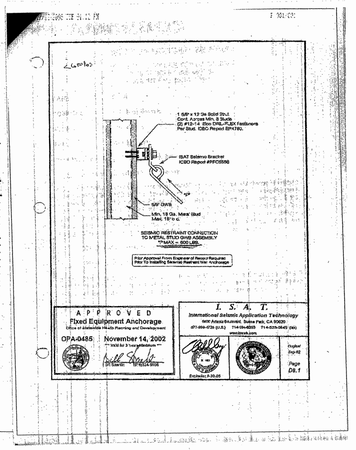

tBP
architecture
planning
interiors
management

tBP/Architecture
1000 Burnett Avenue, Suite 140
Concord, CA 94520
p: 925.246.6419 f: 925.246.6495

architect

CONSULTING ENGINEERS
TOPP WOLFF FARROW Inc.
385 Second Street, 3rd Floor
San Francisco, CA 94105
TEL (415) 247-8700
FAX (415) 247-8701
twfsf@twfsf.com

consultant

name
address
city, state, zip
ph:
fx:

agency

SCIENCE BUILDING
LOS MEDANOS COLLEGE

Contra Costa Community College District

owner

tBP project number : 202471.00
file name: DETAILS
drawn by: CLAI checked by: LSN
date: NOVEMBER 15, 2004

Rev	date	description

drawing title:
DETAILS

LMC SCIENCE 313-023-112.01-0-00.00
drawing no.:
E-4.2

TWF #03058.00

S. J. AMOROSO
Request For Information/Clarification

DSA FILE NO. 7-C1
DSA APPL. No. 01-106226

To:	tBP/Architecture 1000 Burnett Ave, Suite 140 Concord, CA 94520	Project:	LOS MEDANOS COLLEGE SCIENCE BUILDING Contra Costa Community College District tBP p/n: 20247.00
Attn:	Celia Chiang, Tom Beckett		
Fax:	925-246-8466		
Subj.:	FA sequence of operations as relates to fume hoods **Reference (dwg, spec.): FA0.1**	RFI No:	**464** Subcontractor RFI:

Reply Requested By: 1/26/07

INFORMATION REQUESTED: **Date:** 1/18/07

Per the fire alarm sequence of operations matrix on sheet FA0.1, if a smoke detector, heat detector or smoke duct detector is triggered, the AHU's will shut down, thus stopping flow of supply air. Also, CF107's will close, including those on transfer air ducts.

There are 3 exhaust fans on this building to the numerous fume hoods on the project. These will NOT be shut down by the FA alarm system in the event of a fire anywhere in the building. Therefore, particularly in room 235 which will contain 17 fume hoods, there will still be exhaust from the fume hoods leaving the room, but no supply to the room.

It would seem that this negative pressure situation would hinder or even prevent egress from the room as people may not be able to open the doors to exit. We understand from another Science Building under construction by Amoroso that this will pose a huge issue of competing jurisdictions between the Fire Marshall who wants egress from the room and Dept. of Health that wants the chemical fumes exhausted from the room.

Please advise if any changes to the design are needed to address this situation.

SUGGESTED SOLUTION:

Cost Impact: ☐ Schedule Impact: ☐ days **By:** Bryan Newman

RESPONSE: **DATE:**

This (3) fume hood exhaust fans for room #235 needs to be tied into the fire alarm system via Siemens interface modules (TRI-R) and programmed to shut-off when the supply fan and fire smoke dampers for room #235 close during a fire alarm situation.

Jim Weaver / tBP Architecture
LLai / TWF

2/8/07

RFI # 000
Page 1

FIRE ALARM EQUIPMENT LIST

QTY.	MODEL NUMBER	MAKE	DESCRIPTION	CA STATE FIRE MARSHAL (CSFM) NUMBER	EXPIRATION DATE
1	5000-NXL	SIEMENS	MAIN FIRE ALARM CONTROL PANEL (FACP) ANALOG/ADDRESSABLE, WITH THE FOLLOWING:	7165-0067:144	06-30-05
	MMB-2	SIEMENS	MAIN CONTROL BOARD	7165-0067:144	06-30-05
	MPS-12 AMP	SIEMENS	POWER SUPPLY, 12 AMP	7165-0067:144	06-30-05
	MKB-2	SIEMENS	DISPLAY AND KEYBOARD	7165-0067:144	06-30-05
	MOM-4	SIEMENS	INTERFACE MODULE	7300-0067:172	06-30-05
	ALD-2I	SIEMENS	LOOP DRIVER	7300-0067:172	06-30-05
	NET-7	SIEMENS	STYLE 7 NETWORK INTERFACE CARD	7300-0067:172	06-30-05
	SERIAL DACT	SIEMENS	SILENT KNIGHT 5128/5129	7300-0559:120	06-30-05
	BTK-1	SIEMENS	36 AMP HOUR BATTERIES	7165-0067:144	06-30-05
	MSE-MME-3	SIEMENS	ENCLOSURE FOR ALL ABOVE, AS REQUIRED	7165-0067:144	06-30-05
2	TRI-M	SIEMENS	INTERFACE MODULE, MONITORING	7300-0067:146	06-30-05
54	TRI-R	SIEMENS	INTERFACE MODULE RELAY	7300-0067:146	06-30-05
–	TRI-S	SIEMENS	INTERFACE MODULE SIGNAL	7300-0067:146	06-30-05
19	MSI-10B	SIEMENS	ADDRESSABLE MANUAL PULL STATION	7150-0067:036	06-30-05
3	AD11P-FP11	SIEMENS	PHOTO-ELECTRIC DUCT DETECTOR WITH PHASE AND SAMPLING TUBE AND BASE	3240-0067:116	06-30-05
141	FP11	SIEMENS	ADDRESSABLE PHOTO-ELECTRIC SMOKE DETECTOR	7272-0067:203	06-30-05
141	DB11	SIEMENS	SMOKE DETECTOR BASE	7300-0067:134	06-30-05
1	RCC-1	SIEMENS	REMOTE ANNUNCIATOR	7120-0067:152	06-30-05
13	FPT-11	SIEMENS	ADDRESSABLE HEAT DETECTOR	7272-0067:202	06-30-05
13	DB11	SIEMENS	HEAT DETECTOR BASE	7300-0067:134	06-30-05
4	PAD-3	SIEMENS	AUXILIARY POWER SUPPLY (NAP)	7300-0067:218	06-30-05
6	DSM	WHEELOCK	SYNCHRONIZATION MODULE	7300-0785:132	06-30-05
52	NS-24MCW-FW	WHEELOCK	HORN/STROBE (15, 30, 75 OR 110 CD RATING)	7125-0785:142	06-30-05
26	RSS-24MCW-FW	WHEELOCK	STROBE (15, 30, 75 OR 110 CD RATING)	7125-0785:141	06-30-05

FIRE ALARM SYSTEM NOTES

SYSTEM DESCRIPTION:
Automatic fire alarm system utilizing addressable devices including smoke detectors, heat detectors, smoke duct detectors, manual pull stations and sprinkler system monitoring of flow and tamper devices. Notification appliances strobes and horns, with synchronization of strobes. Remote fire alarm annunciator at reception area. Connection to central station. Initiation devices shall be class A, addressable, notification appliances class B.

GENERAL NOTES:
1 Final Fire Alarm test will be witnessed by Local Fire Authority with the DSA Inspector of Record (IOR).
2 Underground and exterior conduits will have water-tight fittings.
3 Fire alarm Device Mounting Heights:
Pull station: 48" to center line of device above finished floor.
Horn interior: 90" to top of device above finished floor, not less than 6" from ceiling.
Wall mounted Strobe or Horn/Strobe: 80" to bottom of device and not greater than 96" above finished floor not less than 6" from ceiling.
4 Audible device(s) shall be at least 15dBA above average ambient sound level but not less than 75dBA at 10' or more than 120dBA in total, throughout!
5 Audible devices shall sound the California Uniform Fire Alarm Signal in Temporal–Three mode.
6 Visual devices shall not exceed 2 flashes per second and shall not be less than 1 flash every second.
7 All visual devices shall be synchronized.
8 Provide at least one exterior horn for buildings of E occupancies.
9 Horns shall be silenced with strobes capable of operating continuously after horns are silenced.

APPLICABLE CODES:
1 CBC 2002: CEC 2002; CMC 2002; CFC 2002
2 State Fire Marshal Title 19, Public Safety
3 NFPA 72, 2002 Edition w/CA Amendments, Fire Alarm Code

SEQUENCE OF OPERATION:
Upon activation of any alarm initiation device, (i.e. smoke detector, manual pull station, sprinkler flow device or duct smoke detector) building notification appliances shall activate, alarm signals shall be sent to the Central Station Monitoring Co., and a signal sent to shut down building ventilation equipment. Upon any trouble or abnormal condition the panel shall display the location, type of device and point status. See matrix.

SCOPE OF FIRE ALARM WORK:
The fire alarm system for the Science building will be a new system. The system will be addressable with the following components:
1 Fire alarm control panel with battery back up
2 Remote annunciator
3 Connection for central station.
4 Smoke detectors and duct smoke detectors
5 Monitor of sprinkler flow and tamper
6 Manual pull stations
7 Notification appliances, horns, strobes and horn/strobes
8 Shut down of ventilation equipment
9 Provisions for future networking.

FIRE ALARM GENERAL NOTES

1. MOUNT ALL VISUAL SIGNALING APPLIANCES AT 80" ABOVE FINISH FLOOR OR 6" BELOW FINISH CEILING WHICHEVER IS LOWER, PER "ADA" REQUIREMENTS.
2. ALL EQUIPMENT SHALL BE UL AND CALIFORNIA STATE FIRE MARSHAL (CSFM) LISTED
3. ALL WIRING SHALL BE IN ACCORDANCE WITH THE NATIONAL ELECTRICAL CODE (NEC) AND AUTHORITIES HAVING JURISDICTION.
4. ALL JUNCTION BOXES SHALL BE SIZED IN ACCORDANCE WITH THE NATIONAL ELECTRICAL CODE (NEC).
5. CONTRACTOR SHALL FURNISH ACCESS PANELS TO AREAS THAT REQUIRE SERVICING, TROUBLE SHOOTING, ETC..
6. DO NOT DEVIATE FROM CONDUIT RUNS AS SHOWN ON FLOOR PLANS WITHOUT PRIOR APPROVAL FROM SYSTEM SUPPLIER (SIMPLEX), FACTOR SUCH AS EXCESSIVE VOLTAGE DROP, ADDITIONAL PARTS, ENGINEERING, ETC.. THAT ARE A RESULT OF CONDUIT RUN DEVIATIONS SHALL BE THE SOLE RESPONSIBILITY OF THE CONTRACTOR.
7. ALL 120VAC POWER REQUIREMENTS FOR THE FIRE ALARM SYSTEM SHALL BE FURNISHED BY THE CONTRACTOR AND SHALL MEET ALL REQUIREMENTS OF THE CEC AND NFPA 72.
8. ALL FIRE ALARM DEVICE BACKBOXES, FIRE ALARM TERMINAL CABINETS, GUTTERS, JUNCTION BOXES, AND ASSOCIATED CONDUITS SHALL BE FURNISHED AND INSTALLED BY CONTRACTOR UNLESS OTHERWISE NOTED. REFER TO FIRE ALARM SYMBOL LIST AND/OR MOUNTING DETAILS FOR ADDITIONAL INFORMATION. SYSTEM SUPPLIER PROVIDED BACKBOX SHALL BE INSTALLED BY ELECTRICAL CONTRACTOR UNLESS OTHERWISE NOTED.
9. SMOKE DETECTOR TESTING SHALL BE ACCOMPLISHED WITH TEST SMOKE FOR ACCEPTANCE TEST AS PER THE MANUFACTURER'S INSTRUCTIONS.
10. ALL WIRING, ANNUNCIATING DEVICES AND ANNUNCIATOR PANEL SHALL BE SUPERVISED TO THE PRINCIPAL POINT OF ANNUNCIATION. THE FIRE ALARM CONTROL PANEL TO SUPERVISE THE ANNUNCIATOR PANEL, ALL INITIATING AND INDICATING DEVICE CIRCUITS.
11. ALL WIRING SHALL BE CUT FOR IN AND OUT. WIRING SHALL NOT BE LOOPED THROUGH DEVICES.
12. POINT AND COMMON ANNUNCIATION AND T-TAPPING ARE PROHIBITED.
13. PROVIDE 3/4" CONDUIT FROM FIRE ALARM CONTROL PANEL TO TELEPHONE BACKBOARD.
14. FIRE ALARM SYSTEM INSTALLATION COMPANY SHALL BE UL LISTED.
15. FIRE ALARM AS-BUILT SHOP DRAWINGS SHALL BE SIGNED BY A NICET CERTIFIED TECHNOLOGIST TO ENSURE PROPER SPECIFICATION COMPLIANCE.
16. ALL CONDUITS ARE 3/4" MINIMUM.
17. FIRE ALARM SYSTEM WERE SHOWN DIAGRAMATICALLY TO MEET REQUIRED CODES. EXACT LOCATION OF FIXTURES SHALL BE DETERMINED AND VERIFIED BY THE FIRE ALARM CONTRACTOR AND SHALL INSPECT AND PERFORMED ALL TEST FOR PROPER OPERATION OF THE SYSTEM.
18. ALL FIRE ALARM WIRING SHALL BE IN METAL RACEWAYS.
19. COORDINATE INSTALLATION OF DUCT SMOKE DETECTORS AND RELAY SHUTDOWN WITH THE MECHANICAL CONTRACTOR.
20. ALL FIRE ALARM JUNCTION BOX COVERS TO BE PAINTED RED AND MARKED WITH ADDRESS AND FUNCTION.

REQUIRED NOTES:
* THE SYSTEM SHALL CONFORM TO CALIFORNIA CODE OF REGULATIONS (CCR) TITLES 19 AND 24 AS APPLICABLE TO THIS PROJECT.
* UPON COMPLETION OF SYSTEM INSTALLATION, THE SYSTEM SHALL BE TESTED IN THE PRESENCE OF AND IN A MANNER ACCEPTABLE TO DSA/IOR. THE CONTRACTOR WILL SUPPLY NECESSARY TESTING EQUIPMENT INCLUDING A "DECIMETER" TO CHECK ACCEPTABLE NOISE LEVELS OF AUDIBLE DEVICES. TEST RESULTS WILL BE PROVIDED PER NFPA 72 TO ARCHITECT, DSA INSPECTOR OF RECORD, OWNER AND TO THE LOCAL FIRE AUTHORITY.
* PENETRATIONS OF ALL FIRE-RATED WALLS SHALL BE PROTECTED IN ACCORDANCE WITH CALIFORNIA BUILDING CODE, PART 2. DETAILS AND DESIGN NUMBERS WILL BE PROVIDED.

FIRE ALARM DEVICE ADDRESSES

		ADDRESS	DEVICES
LOOP A	1ST FLOOR PART 'A'	A1 THRU AX	1st FLOOR PART A INITIATION DEVICES
		A61 THRU AXX	1st FLOOR PART A CONTROL DEVICES
LOOP B	1ST FLOOR PART 'B'	B1 THRU BX	1st FLOOR PART B INITIATION DEVICES
		B61 THRU BXX	1st FLOOR PART B CONTROL DEVICES
LOOP C	2ND FLOOR PART 'A'	C1 THRU CX	2nd FLOOR PART A INITIATION DEVICES
		C61 THRU CXX	2nd FLOOR PART A CONTROL DEVICES
LOOP D	2ND FLOOR PART 'B'	D1 THRU DX	2nd FLOOR PART B INITIATION DEVICES
		D61 THRU DXX	2nd FLOOR PART B CONTROL DEVICES

CONNECT TO LOOP 1 AND 2, MAXIMUM 60 INITIATION AND 60 CONTROL DEVICES PER LOOP. ACTUAL ADDRESS NUMBERS TO BE INDICATED IN SHOP DRAWINGS


FIRE ALARM SYMBOL LIST

SYMBOL	DESCRIPTION
FACP	MAIN FIRE ALARM CONTROL PANEL, ANALOG/ADDRESSABLE
FATC	FIRE ALARM TERMINAL CABINET
NAP	NOTIFICATION APPLIANCE POWER SUPPLY
ANN	REMOTE FIRE ALARM ANNUNCIATOR PANEL
F	ADDRESSABLE MANUAL PULL STATION
SD	ADDRESSABLE PHOTO–ELECTRIC SMOKE DETECTOR
MR	MULTI–VOLTAGE CONTROL RELAY
(15) 1–1	STROBE (15) = 15 CANDELLA TYP. – 1–1 INDICATES APPLIANCE #1 ON CIRCUIT #1
(75) H 1–2	HORN/STROBE (75) = 75 CANDELLA TYP. – 1–2 INDICATES APPLIANCE #1 ON CIRCUIT #2
(75) 1–3	STROBE (110) = 110 CANDELLA TYP. – 1–3 INDICATES APPLIANCE #1 ON CIRCUIT #3
FA	FIRE ALARM WIRING IN CONDUIT
FN	FIRE ALARM NOTIFICATION WIRING IN CONDUIT
WP 2–1	WEATHERPROOF HORN 2–1 INDICATES APPLIANCE #2 ON CIRCUIT #1
SF ST	SPRINKLER FLOW AND SPRINKLER TAMPER SWITCH
TS	TAMPER SWITCH AT FIRE DEPT. CONN. DETECTOR CHECK
DD	ADDRESSABLE DUCT SMOKE DETECTOR WITH SAMPLING TUBES
DD LV	ADDRESSABLE DUCT SMOKE DETECTOR – LOW VELOCITY DUCT MOUNTED
	REMOTE INDICATOR LIGHT FOR DUCT DETECTOR
SF	FIRE SMOKE DAMPER – 120 VOLT
HD	ADDRESSABLE HEAT DETECTOR
IM S	INTERFACE MODULE; SIGNAL
IM M	INTERFACE MODULE; MONITOR
IM R	INTERFACE MODULE; RELAY
EOL	END OF LINE RESISTOR
1A1, ETC.	ADDRESS NUMBER,–LOOP 1A, DEVICE #1
A, B, C ETC.	WIRING TYPE; SEE FIRE ALARM WIRING LEGEND

FOR ADDITIONAL SYMBOLS SEE DWG. E0–1.

SHEET NOTES

1 EXTEND EXISTING 1"C TO (N) FACP AND CONNECT FLOW AND TAMPER SWITCHES OF POST INDICATOR VALVE TO BUILDING FIRE ALARM CONTROL PANEL.

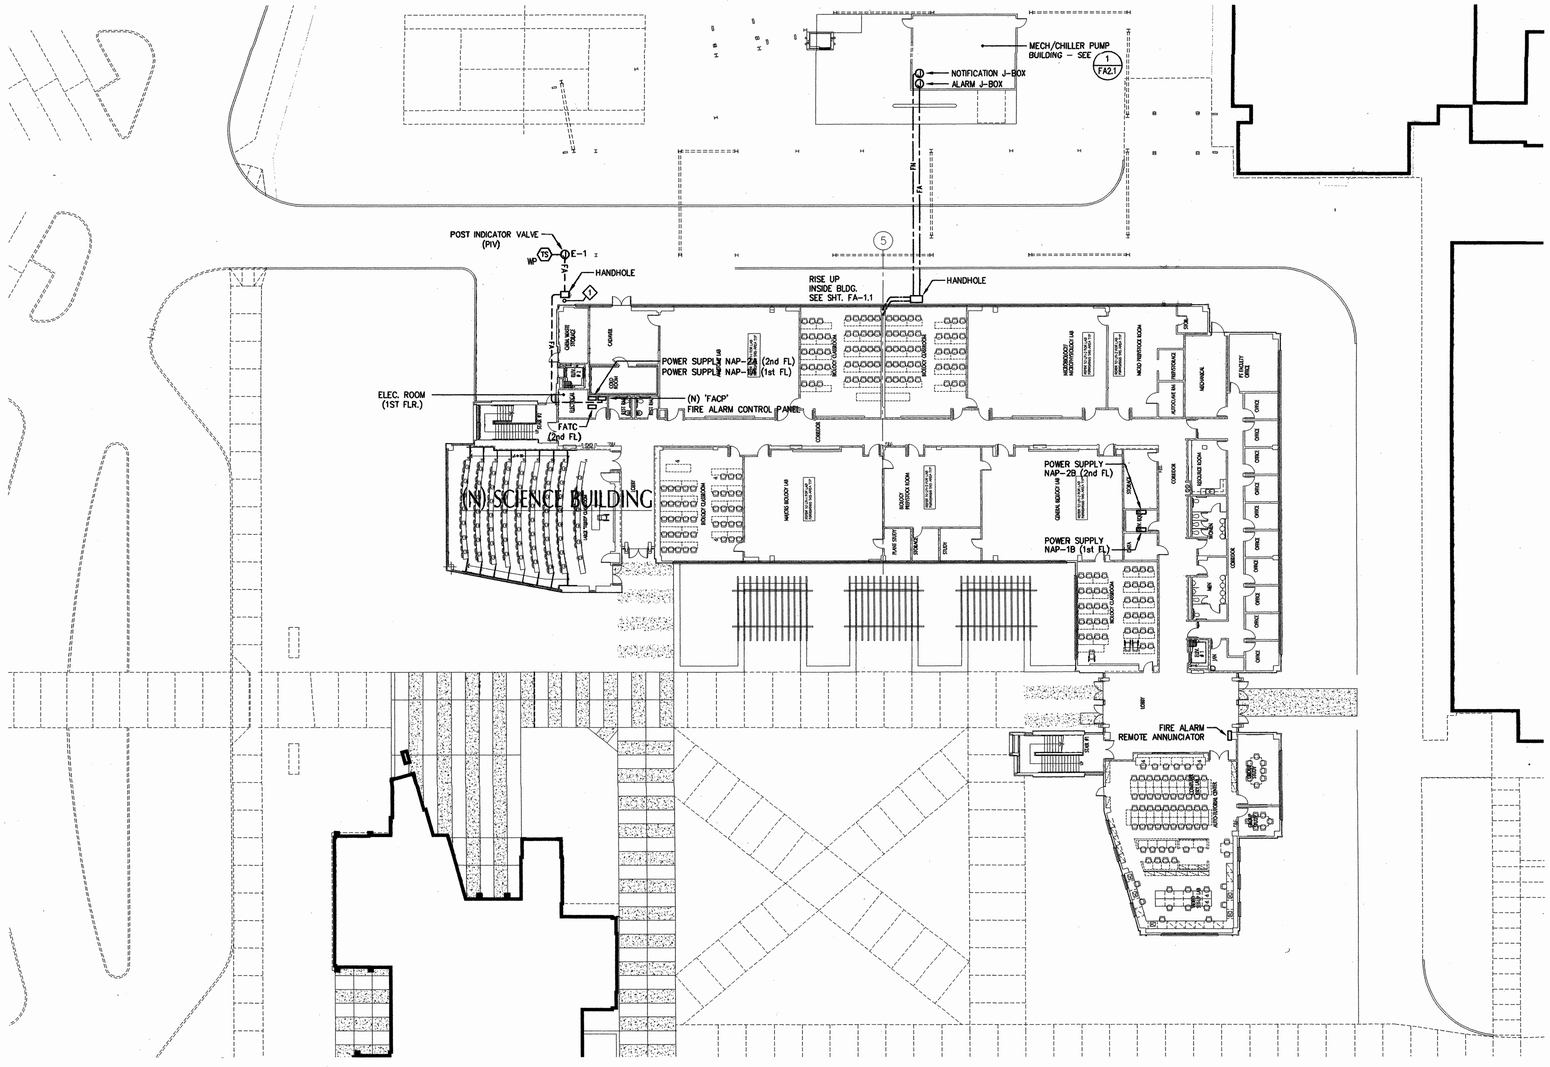

SITE PLAN
SCALE: 1" = 20'–0"

FIRE ALARM SEQUENCE OF OPERATIONS MATRIX

DEVICE ACTION	INITIATION DEVICES: MANUAL PULL STATION	SMOKE DETECTOR HEAT DETECTOR #	SMOKE DUCT DETECTOR	SPRINKLER WATER FLOW	SPRINKLER WATER TAMPER
SOUND CONTROL PANEL TROUBLE BUZZER	ON WIRING FAULT	ON WIRING FAULT	ON WIRING FAULT	ON WIRING FAULT	ON WIRING FAULT
ACTIVATE RELAY FOR MONITORING (ALARM OR TROUBLE)	YES	YES	YES	YES	YES
ANNUNCIATE AT FIRE ALARM CONTROL PANEL (ALARM OR TROUBLE)	YES	YES	YES	YES	TROUBLE ONLY
ANNUNCIATE AT REMOTE FIRE ALARM ANNUNCIATOR (ALARM OR TROUBLE)	YES	YES	YES	YES	TROUBLE ONLY
SEND SIGNAL TO CENTRAL STATION SERVICE CO.	YES	YES	YES	YES	YES
ACTIVATE AUDIBLE / VISUAL ALARM SIGNAL THROUGHOUT BUILDING	YES	YES	YES	YES	NO
SHUTDOWN AIR HANDLING UNITS (HVAC SEE FA4.01)	NO	YES	YES	NO	NO
SHUTDOWN FIRE/SMOKE DAMPERS	YES	YES	YES	YES	NO
NOTIFY CAMPUS SECURITY VIA CENTRAL STATION	YES	YES	YES	YES	YES
* ELEVATOR POWER SHUNT TRIP		YES			

WIRING SCHEDULE

SYMBOL	FOR	NUMBER OF CONDUCTORS
A	(NOTIFICATION DEVICES) STROBES, HORN STROBES, HORNS	2 #12
B	(ADDRESSABLE DEVICE INITIATION) SMOKE OR DUCT DETECTORS, PULL STATIONS	1 #16 TSP
C	120 VOLT POWER	2 #12, 1#12G
D	120V SMOKE DAMPER POWER	2 #12, 1#12G
E	120V SMOKE DAMPER POWER & INDICATOR	3 #12, 1#12G
F	DEVICE POWER – 24V	2 # 14
G	DATA LINE – SERIAL COMMUNICATIONS	1 # 18 TSP

NOTE: *2A = TWO CABLES, 3A = THREE CABLES, ETC.*

WIRING NOTES:
1. MINIMUM CONDUIT SIZE: 3/4".
2. CONDUIT TO BE SIZED FOR 40% FILL PER N.E.C.
3. ALL 120 VOLT WIRING SHALL RUN IN SEPARATE CONDUDIT.
4. TWISTED SHIELDED CABLE SHALL BE WEST PENN 1991 NPLF (A), EXTERIOR SHALL BE WEST PENN A0293 FPL/PLTC (B).

FIRE ALARM FACP BATTERY CALCULATIONS

BASED ON Siemens MXL PANEL

Siemens #	QTY	Standby Current	Alarm Current	Standby Total	% in Alarm	Alarm Total	Project: Contra Costa Community College, San Ramon, CA
MMB–2 Main Board	1	0.1750	0.1750	0.175	100%	0.175	
ALD–2I Loop (1.1mA per device)	2	0.1050	0.2400	0.210	100%	0.480	
MOM–4	1	0.0000	0.0000	0.000	100%	0.000	
MKB–2 Control Keypad Annunciator	1	0.0050	0.0050	0.005	100%	0.005	
RCC–1F Remote command center	1	0.0750	0.0750	0.075	100%	0.075	
5128 Digital Fire Communicator	1	0.0840	0.1540	0.084	100%	0.154	
TRI – Devices (Interface Modules)	53	0.0016	0.0016	0.085	100%	0.085	
		TOTAL STANDBY		0.884			
		TOTAL ALARM				0.874	

HOURS OF STAND–BY	24	0.6338		15.2112	TOTAL STANDBY
MINUTES IN ALARM (5)	5	0.9738	0.0833	0.0812	ALARM A.H.
				15.2924	SUB–TOTAL
				X 1.25	
				19.1154	TOTAL A.H. NEEDED

Note: ALD–2I calculated at max number of devices/loop

Provide 36 amp hour batteries

TWF #03058.00

tBP
architecture planning interiors management
tBP/Architecture
1000 Burnett Avenue, Suite 140
Concord, CA 94520
p: 925.246.6419 f: 925.246.6495
architect

CONSULTING ENGINEERS
282 Second Street, 2nd Floor
San Francisco, CA 94105
(415) 543–9703
(415) 247–3711
FAX
twfsf@twfsf.com
TOFT WOLFF FARROW Inc.
consultant

name
address
city, state, zip
ph:
fx:
agency

SCIENCE BUILDING
LOS MEDANOS COLLEGE
Contra Costa Community College District
owner

tBP project number : 20241.00
file name:
drawn by: LLAI checked by: LSM
date: NOVEMBER 15, 2004

Rev.	date	description

drawing title:
SITE PLAN - SCHEDULES, FIRE ALARM
LMC SCIENCE 313-023-T12.01-0-00.00
drawing no:
FA0.1

S. J. AMOROSO
Request For Information/Clarification

DSA FILE NO. 7-C1
DSA APPL. No. 01-106226

To: IBI/Architecture
1000 Burnett Ave, Suite 140
Concord, CA 94520

Attn: Celia Chiang, Tom Beckett
Fax: 925-246-6495

Project: LOS MEDANOS COLLEGE
SCIENCE BUILDING
Contra Costa Community College District

IBI/ phi: 20247.00

Subj.: Fire Alarm Devices In Rooms 130, 131, 132 RFI No: **369**

Reference (dwg, spec.): FA-1.1, FA-1.2

Subcontractor RFI: EWS 39

Reply Requested By: 10/11/06

INFORMATION REQUESTED: Date: 10/4/06

Please note the attached EW Scott RFI 39 regarding the door framing in rooms 130, 131 and 132 which are impacting the installation of the Fire Alarm Devices as shown. A sketch is attached for possible alternate locations.

SUGGESTED SOLUTION:
Cost Impact: ☐ Schedule Impact: ☐ days By: Mark Delgado

RESPONSE: DATE:

IWP has no objection to devices 'A1-6' and 'A1-7' being relocated to the proposed locations (indicated in RFI#369), but recomends that device 'A1-5' be relocated to a ceiling mounted type of device due to possible view obstruction from the cabinet along the south wall.

Larry Lal/IWP - 10/9/06

RFI # 000
Page 1

EDWARD W. SCOTT ELECTRIC CO., INC.
435 HARRIET STREET
San Francisco, CA 94103-4914
Phone: (415) 626-0701 Fax: (415) 626-2837

REQUEST FOR INFORMATION

PROJECT: LMC / SCIENCE BLDG. RFI # 39 R.F.I. Date 10-2-06
JOB: 2421 ACTUAL REPLY DATE

TO: MARK DELGADO
OF: AMOROSO CONST.
REF. DWG: FA-1.1 & FA-1.2
LOCATION: RMS. 130, 131 & 132

POTENTIAL COST IMPACT
___ COST ✓ SCHEDULE
___ OTHER ___ LABOR
___ NO IMPACT ___ MATERIAL

INFORMATION REQUESTED: DUE TO THE DOOR FRAMING IN RMS. 130, 131 & 132 WE ARE UNABLE TO INSTALL THE FIRE ALARM DEVICES AS SHOWN. PLEASE SEE ATTACHED SKETCH FOR POSSIBLE ALTERNATE LOCATIONS.


REPLY REQUIRED BY: ASAP SIGNED:
NOTE: IF NO REPLY IS RECEIVED BY US BY THE ABOVE NOTED DATE, A TIME EXTENSION WILL BE REQUIRED WITH POSSIBLE COST IMPACTS.

RESPONSE:

DATED: SIGNED:

RFIDOC39

INDUSTRIAL, COMMERCIAL WIRING & DESIGN
STATE CONTRACTOR LICENSE NO. 190426

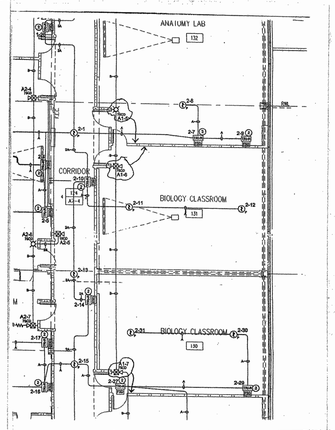

S. J. AMOROSO
Request For Information/Clarification

DSA FILE NO. 7-C1
DSA APPL. No. 01-106226

To: IBI/Architecture
1000 Burnett Ave, Suite 140
Concord, CA 94520

Attn: Celia Chiang, Tom Beckett
Fax: 925-246-6495

Project: LOS MEDANOS COLLEGE
SCIENCE BUILDING
Contra Costa Community College District

IBI/ phi: 20247.00

Subj.: Fire Alarm Pull Station in Lecture Hall RFI No: **431**

Reference (dwg, spec.): FA-1.1

Subcontractor RFI: EWS 62

Reply Requested By: 12/7/06

INFORMATION REQUESTED: Date: 11/30/06

Please note the attached EWS RFI No. 62 regarding the Fire Alarm Pull Station in the Lecture Hall that needs to be relocated due to wall framing. Please advise.

SUGGESTED SOLUTION:
Cost Impact: ☐ Schedule Impact: ☐ days By: Mark Delgado

RESPONSE: DATE:

No exception taken to the revised location indicated.
Please coordinate with other devices along the wall such as zone switch and zone lighting control unit.

Jim Weaver/IBI Architecture
cc:Lal/ IW.P.

12/6/06

RFI # 000
Page 1

EDWARD W. SCOTT ELECTRIC CO., INC.
435 HARRIET STREET
San Francisco, CA 94103-4914
Phone: (415) 626-0701 Fax: (415) 626-2837

REQUEST FOR INFORMATION

PROJECT: LMC / SCIENCE BLDG. RFI # 62 R.F.I. Date 11/28/06
JOB: 2421 ACTUAL REPLY DATE

TO: MARK DELGADO
OF: AMOROSO CONSTRUCTION
REF. DWG: FA-1.1
LOCATION: LECTURE HALL (H)

POTENTIAL COST IMPACT
___ COST ✓ SCHEDULE
___ OTHER ___ LABOR
___ NO IMPACT ___ MATERIAL

INFORMATION REQUESTED: WE ARE UNABLE TO INSTALL THE F.A. PULL STATION AS SHOWN DUE TO WALL FRAMING. WE ARE PROPOSING TO RELOCATE THE PULL STATION AS SHOWN ON THE ATTACHED SKETCH.


REPLY REQUIRED BY: 12/7/06 SIGNED:
NOTE: IF NO REPLY IS RECEIVED BY US BY THE ABOVE NOTED DATE, A TIME EXTENSION WILL BE REQUIRED WITH POSSIBLE COST IMPACTS.

RESPONSE:

DATED: SIGNED:

RFIDOC39

INDUSTRIAL, COMMERCIAL WIRING & DESIGN
STATE CONTRACTOR LICENSE NO. 190426

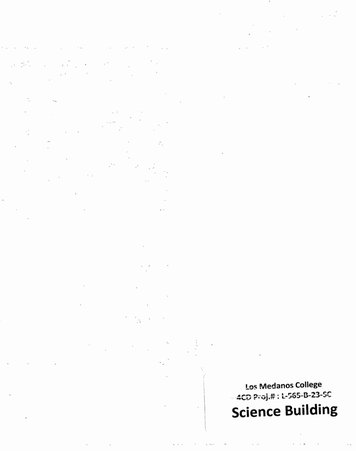








Los Medanos College
4CD Proj.# : L-565-B-23-SC
Science Building

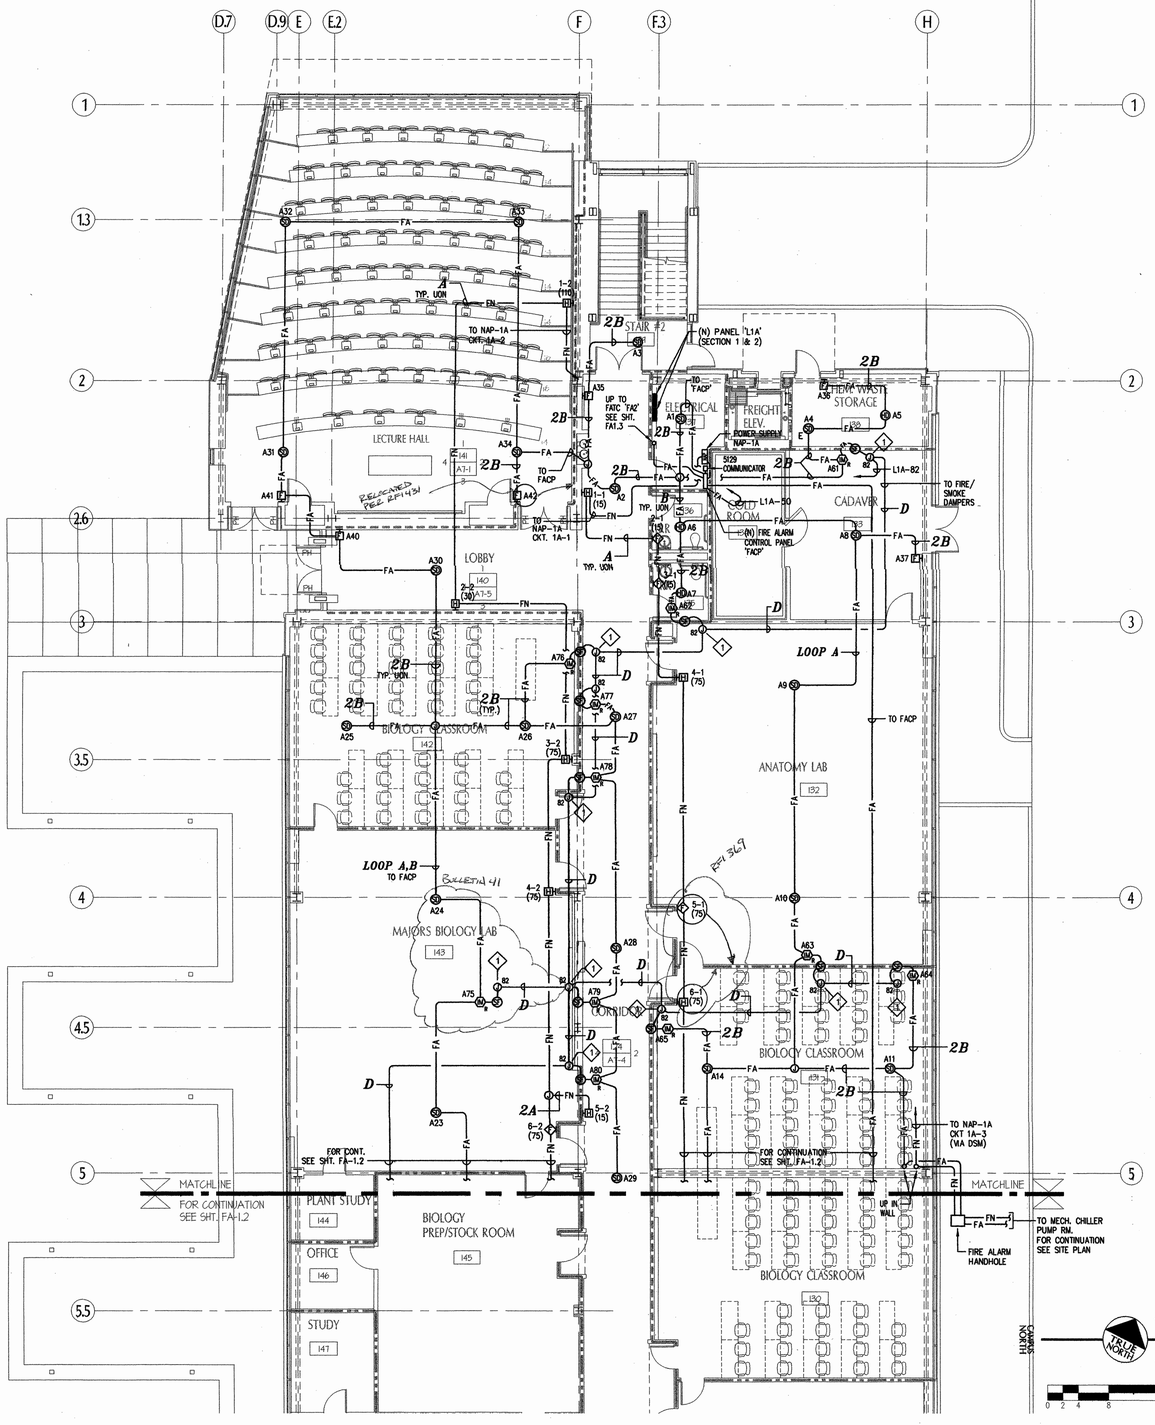

SHEET NOTES:

1. 120V JUNCTION BOX FOR FIRE SMOKE DAMPER. DAMPER INSTALLED UNDER MECHANICAL SECTION, WIRED COMPLETE UNDER ELECTRICAL SECTION. VERIFY LOCATION WITH MECHANICAL.
2. FP-11 FIRE DETECTORS CAN BE APPLIED WITHIN THE MAXIMUM 30 FOOT CENTER SPACING (900 sq. ft. area) AS REFERENCED IN NFPA 72.


WALL TYPES

1-HR FIRE RATED ASSEMBLY

1-HR FIRE RATED ASSEMBLY
(OCCUPANCY SEPARATION)

2-HR FIRE RATED ASSEMBLY
(AT CHEMICAL WASTE STORAGE ONLY)

KEY PLAN

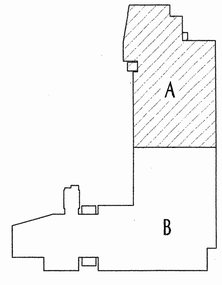

1ST FLOOR PLAN PART "A"
SCALE: 1/8"=1'-0" | 1

TWF #03058.00

tBP
architecture
planning
interiors
management
tBP/Architecture
1000 Burnett Avenue, Suite 140
Concord, CA 94520
p: 925.246.6419 f: 925.246.6495
architect

CONSULTING ENGINEERS
TOFT WOLFF FARROW Inc.
2977 Prune Street, Suite 100
San Francisco, CA 94115
TEL (415) 247-8700
FAX (415) 247-8711
twfs@twfsf.com
consultant

name
address
city, state, zip
ph:
fax
agency

owner

SCIENCE BUILDING
LOS MEDANOS COLLEGE

Contra Costa Community College District

tBP project number : 20241.00

file name: 1s-FLR-A


drawn by: LLAI checked by: LSH

date: NOVEMBER 15, 2004

Rev	date	description

drawing title:
1st FLOOR PLAN
PART "A" - FIRE ALARM

LMC SCIENCE 313-023-112.01-0-00.00
drawing no.:
FA-1.1

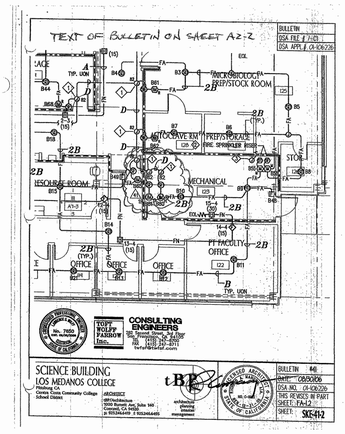
TEXT OF BULLETIN ON SHEET A2.2
BULLETIN
DSA FILE # (-/-/-)
DSA APP. # 01-106726
RECEIVING/STOCK ROOM
AUTOCLAVE RM
PREP/STORAGE
FIRE SPRINKLER RISER
MECHANICAL
RESOURCE ROOM
OFFICE
OFFICE
OFFICE
FT FACULTY OFFICE
STOR
TYP. UON
2B
2B (TYP.)
CONSULTING ENGINEERS
SCIENCE BUILDING
LOS MEDANOS COLLEGE
Contra Costa Community College District
ARCHITECT
tBP Architecture
1000 Burnett Ave, Suite 160
Concord, CA 94520
p: 925.825.6400 f: 925.246.6405
BULLETIN #6
DSA NO. 01-106726
THIS REVISED SHEET
SHEET: A2.2
SCS-A12

SHEET NOTES:

1. 120V JUNCTION BOX FOR FIRE SMOKE DAMPER. DAMPER INSTALLED UNDER MECHANICAL SECTION, WIRED COMPLETE UNDER ELECTRICAL SECTION. VERIFY LOCATION WITH MECHANICAL.
2. VERIFY LOCATION AND CONNECTIONS WITH SPRINKLER CONTRACTOR.
3. JUNCTION BOX FOR 120V ALARM GONG (BY OTHERS). GONG LOCATED EXTERIOR TO RISER ROOM (SEE MECHANICAL DRAWINGS) LEAVE 6" PIGTAIL AT JUNCTION BOX.
4. FP-11 FIRE DETECTORS CAN BE APPLIED WITHIN THE MAXIMUM 30 FOOT CENTER SPACING (900 sq. ft. area) AS REFERENCED IN NFPA 72.


WALL TYPES

1-HR FIRE RATED ASSEMBLY

1-HR FIRE RATED ASSEMBLY (OCCUPANCY SEPARATION)

2-HR FIRE RATED ASSEMBLY (AT CHEMICAL WASTE STORAGE ONLY)

KEY PLAN

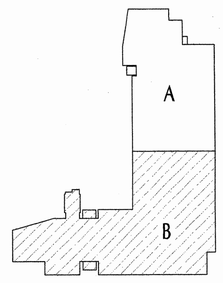

1ST FLOOR PLAN PART "B" | 1

SCALE: 1/8"=1'-0"

TWF #0.3058.00

tBP
architecture
planning
interiors
management

tBP/Architecture
1000 Burnett Avenue, Suite 140
Concord, CA 94520
p: 925.246.6419 f: 925.246.6495

architect

CONSULTING ENGINEERS
285 Hamilton Avenue, 3rd Floor
Palo Alto, CA 94301
(415) 247-8711
FAX (415) 247-8711
twfsf@twfsf.com

TOFT WOLFF FARROW Inc.

consultant

name
address
city, state, zip
ph: fx:

agency

SCIENCE BUILDING
LOS MEDANOS COLLEGE

Contra Costa Community College District

owner

tBP project number : 20241.00

file name: 1s-FLR-A

drawn by: LLAI checked by: LSH

date: NOVEMBER 15, 2004

Rev.	date	description

drawing title:
1st FLOOR PLAN
PART "B" - FIRE ALARM

LMC SCIENCE 313-023-112.01-0-00.00

drawing no:
FA-1.2

S. J. AMOROSO
Request For Information/Clarification

DSA FILE NO. 7-C1
DSA APPL. No. 01-106226

To: BBPArchitecture
1000 Burnett Ave, Suite 140
Concord, CA 94520

Attn: Celia Chiang, Tom Beckett
Fax: 925-246-6495

Subj.: Fire Shutter Door

Reference (dwg, spec.): FA-1.3

Project: LOS MEDANOS COLLEGE SCIENCE BUILDING
Contra Costa Community College District

ISP p/n: 20247.00

RFI No: **419**
Subcontractor RFI: EWS 57

Reply Requested By: 11/6/06

INFORMATION REQUESTED: **Date:** 10/31/06

Please note the attached EWS RFI No. 57 regarding the Fire Shutter Door which is referred to E2.3 from FA-1.3 but is not indicated anywhere on E2.3. Please advise.

SUGGESTED SOLUTION:
Cost Impact: ☐ Schedule Impact: ☐ days By: Mark Delgado

RESPONSE: **DATE:**

Per phone conservation with Jon/BBE, he is not aware of Bulletin #23(Revised 8/16/06), that the Fire shutter door is manual operated per the Bulletin, see attached for reference.

Vanessa Ling/KBP - 11/3/06

RFI # 000
Page 1

EDWARD W. SCOTT ELECTRIC CO., INC.
425 HARRIET STREET
San Francisco, CA 94103-4914
Phone: (415) 626-9701 Fax: (415) 626-2837

REQUEST FOR INFORMATION

PROJECT: LMC SCIENCE BLDG. S.F.I.# 57 R.F.I. Date 10/30/06
JOB: 2951 ACTUAL REPLY DATE _____

TO: MARK DELGADO
OF: AMOROSO CONST.
REF DWG: FA-1.3
LOCATION: Em 236

POTENTIAL COST IMPACT
___ COST ___ SCHEDULE
___ OTHER ___ LABOR
___ NO IMPACT ___ MATERIAL

INFORMATION REQUESTED: FIRE ALARM DWG. FA-13. REFERS TO ELEC. DWG E2.3 IN REGARDS TO THE F.S.P. SHUTTER DOOR. WE WERE UNABLE TO FIND ANYTHING RELATIVE TO THE FAS SHUTTER NOTES ON E2.3. PLEASE REVIEW AND ADVISE.

REPLY REQUIRED BY: 11/7/06 SIGNED: _____
NOTE: IF NO REPLY IS RECEIVED BY US BY THE ABOVE NOTED DATE, A TIME EXTENSION WILL BE REQUIRED WITH POSSIBLE COST IMPACTS.

RESPONSE:

DATED: _____ SIGNED: _____

INDUSTRIAL, COMMERCIAL WIRING & DESIGN
STATE CONTRACTOR LICENSE NO. 190436

RFIDOC59

10/30/06 11:25 DSA P.02/03

E-MAILED 8/16/06

Bulletin No.23 (Revised 8/01/06)

Date: 8/1/2006

To: S.J. Amoroso Construction
390 Bridge Parkway
Redwood shores CA 94065

Project: LOS MEDANOS COLLEGE SCIENCE BUILDING
Contra Costa Community College District
DSA No. 01-106226/ File # 7-C1
ISP P/N 20247.00

Description: REFERENCE: RFI #339, Submittal #43, 4b, Specification Section 08331, Sheets A04.05, 7A.10, 15A235.83

The Ceiling Counter Door and 1Hr25 between Chemistry Prep/Stock Room #236 and Corridor #234 are revised as followings.

1. 1Hr 25 lnsfoadling sliding by pass window are deleted, provide credit. Reference to 10A518.85.
2. 1-hour rated motor door in Contract Documents in this location is replaced and swings by normal coiling door by Cornell Iron Work. Provide credit to the deleted 1 hour rated motor door in Contract Documents. Reference to Spec section 08331.
3. New 1-hour rated Coiling Door is to be by Cornell Iron Work: "Built-in Counter Fire Door with Frame" ULF EDWTR20845 with Automatic Activation (ULF SZNTR5980), 16 GA with #4 stainless steel finish push up door with built-in counter.
4. Partial epoxy counter in front of 1Hr25 in Prep/Stock Room #236 is deleted. See attached revised sheet 7A/Submittal #43 for details. Provide credit for the deleted epoxy counter.
5. 1-hour rated plastic laminate counter per 2/A4.05 in Contract Documents is replaced with 1-hour rated 20 GA - #1 finish stainless steel counter by Cornell Iron Work. New counter is integrated with coiling door. Provide credit to the deleted 1-hour plastic laminate counter.


See the attached SKA-23.1S SKA-23.2 and SKA-23.3 for detells. Provide submittal for 1-hour rolling door with integrated counter and Automatic Activation.


APPROVED
DSA OFFICE OF THE STATE ARCHITECT
NO EXCEPTIONS TAKEN
APPLICABLE RULES ONLY
8/16/06


Issued By: Architect
Requested By: Architect, Owner
Reason: Coordination to Ceiling Counter Door
Enclosures: SKA-23.1S, SKA-23.2 and SKA-23.3, sheet S3/Submittal #43

BBPArchitecture 3000 Bunnell Ave, Suite 140 Concord, CA. 94520 ph:925.246.6570 fax: 925.246.6495

Los Medanos College
4CD Proj.# : L-565-B-23-SC
Science Building

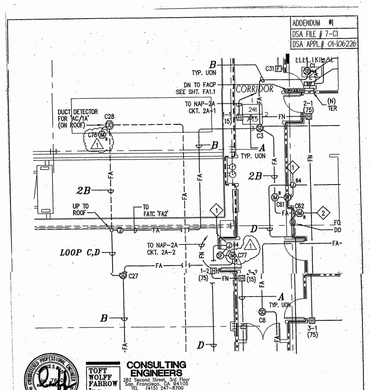

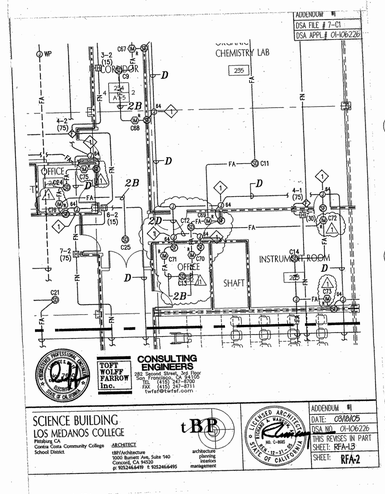

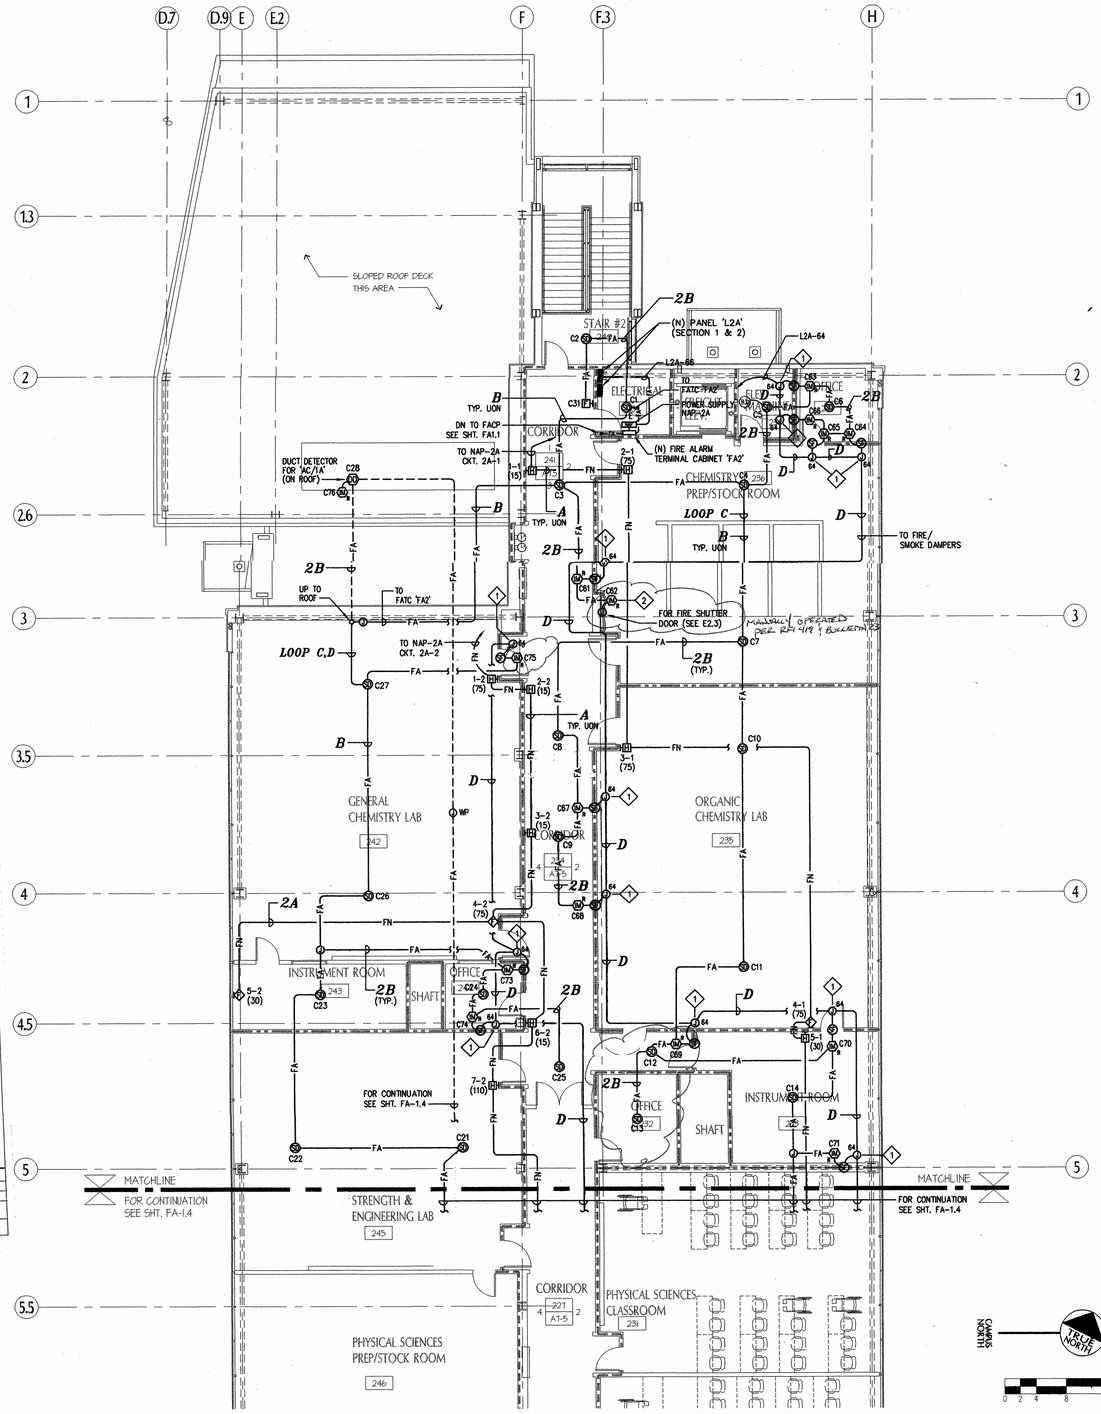

2ND FLOOR PLAN PART "A" SCALE: 1/8"=1'-0" | 1

SHEET NOTES:

1. 120V JUNCTION BOX FOR FIRE SMOKE DAMPER. DAMPER INSTALLED UNDER MECHANICAL SECTION, WIRED COMPLETE UNDER ELECTRICAL SECTION. VERIFY DAMPER LOCATION WITH MECHANICAL DWG'S.
2. MODULE TO TIE INTO ROLL-UP FIRE SHUTTER DOOR. DOOR TO UNDER ANY FIRE ALARM CONDITION.
3. FP-11 FIRE DETECTORS CAN BE APPLIED WITHIN THE MAXIMUM 30 FOOT CENTER SPACING (900 sq. ft. area) AS REFERENCED IN NFPA 72.


WALL TYPES

1-HR FIRE RATED ASSEMBLY

1-HR FIRE RATED ASSEMBLY (OCCUPANCY SEPARATION)

2-HR FIRE RATED ASSEMBLY (AT CHEMICAL WASTE STORAGE ONLY)

KEY PLAN

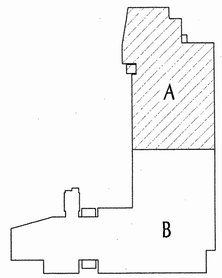

TWF #03058.00

tBP
architecture
planning
interiors
management
tBP/Architecture
1000 Burnett Avenue, Suite 140
Concord, CA 94520
p: 925.246.6419 f: 925.246.6495
architect

CONSULTING ENGINEERS
282 Second Street, 3rd Floor
San Francisco, CA 94105
FAX: (415) 247-8711
twfsf@twfse.com
TOFT WOLFF FARROW Inc.
consultant

name
address
city, state, zip
ph: fx:
agency

SCIENCE BUILDING
LOS MEDANOS COLLEGE
Contra Costa Community College District


owner

tBP project number : 20241.00
file name: 1s-FLR-A
drawn by: LLAI checked by: LSM
date: NOVEMBER 15, 2004

Rev	date	description

drawing title:
2nd FLOOR PLAN
PART "A" - FIRE ALARM


LMC SCIENCE 313-023-T12.01-0-00.00
drawing no:
FA-1.3

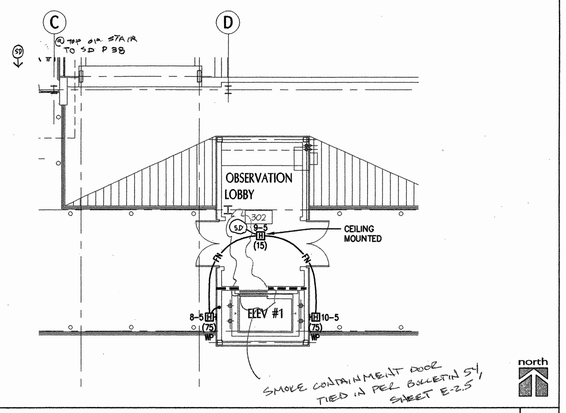


PARTIAL ROOF PLAN
SCALE: 1/8"=1'-0"

2

INSTRUMENT ROOM 243
SHAFT
OFFICE 244
OFFICE 232
SHAFT
INSTRUMENT ROOM 233
FOR CONTINUATION SEE SHT. FA-1.3
MATCHLINE
FOR CONTINUATION SEE SHT. FA-1.3
STRENGTH & ENGINEERING LAB 245
LOOP C
LOOP C,D
2B TYP.
PHYSICAL SCIENCES PREP/STOCK ROOM 246
CORRIDOR 227
PHYSICAL SCIENCES CLASSROOM 235
LOOP D
OPTICS/DARK ROOM 248
PHYSICAL SCIENCES CLASSROOM 230
OFFICE 241
PHYSICS LAB 249
LECTURE HALL 229
STAIR #1 202
ASTRONOMY 237
SEMINAR ROOM 236
OPEN TO BELOW
SEMINAR ROOM 240
DATA 239
SEMINAR ROOM 238
TO FATC-T2A SEE SHT. FA-1.3
QUIET 205
NOISY 206
TECH/MEDIA CENTER 208
LOBBY 201
CORRIDOR 201
STORAGE 226
SHAFT
RESOURCE ROOM 209
CONFERENCE ROOM 225
ELEV #1
JANITOR 224
MEN 211
WOMEN 212
CORRIDOR 213
OFFICE 251
OFFICE 252
OFFICE 253
OFFICE 254
OFFICE 255
OFFICE 256
OFFICE 257
OFFICE 258
OFFICE 259
P.T. OFFICE 224
OPEN TO BELOW
TO NAP-2B CKT. 2B-5
TO NAP-2B CKT. 2B-4
TO NAP-2B CKT. 2B-3
POWER SUPPLY NAP-2B
TYP. UON A
TYP. UON B
TYP. UON D
TYP. UON E
DUCT DETECTOR FOR 'AHU/2' (ON ROOF)
DUCT DETECTOR FOR 'AHU/3' (ON ROOF)
DUCT DETECTOR FOR 'AHU/1' (ON ROOF)
EOL
A1.1
A1.5
A1-2
A1-6
A6.1
A1.3
A1.4
A1.6
A62.6

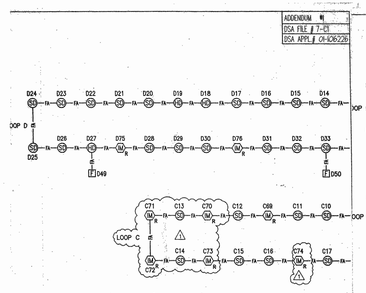

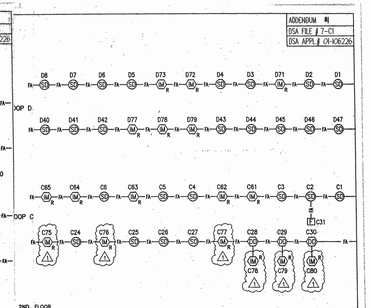

TOFT WOLFF FARROW Inc. CONSULTING ENGINEERS
501 Second Street, Ste 102 San Francisco, CA 94107
PH: (415) 541-9300 FAX: (415) 541-9311 twfa@tfwfar.com

SCIENCE BUILDING
LOS MEDANOS COLLEGE
Pittsburg, CA
Contra Costa Community College District

ARCHITECT
tBP/Architecture
1000 Burnett Ave, Suite 140
Concord, CA 94520
p: 925.246.6490 f: 925.246.6495

tBP architecture planning interiors management

ADDENDUM	#1
DSA FILE	7-C1
DSA APPL.	01-106226
DATE:	03/06/06
DSA NO.	01-106226
THIS REVISES IN PART	
SHEET:	RFA-2.1
SHEET:	RFA-5

RFI # 000
Page 1

S. J. AMOROSO
Request For Information/Clarification

DSA FILE NO. 7-C1
DSA APPL. No. 01-106226

To: tBP/Architecture, 1000 Burnett Ave, Suite 140, Concord, CA 94520
Attn: Celia Chiang, Tom Beckett
Fax: 925-246-6495

Project: LOS MEDANOS COLLEGE SCIENCE BUILDING, Contra Costa Community College District
tBP p/n: 20247.00

Subj.: Dedicated Phone Line at the Fire Alarm Control Panel
Reference (dwg, spec.): FA2.1/T2.0

RFI No: 389
Subcontractor RFI: EWS 44

Reply Requested By: 10/26/06

INFORMATION REQUESTED: Date: 10/19/06

Please note the attached Edward Scott RFI No. 44 regarding the Fire Alarm Control Panel requiring a dedicated phone line from the data closet room 151. How will this line be routed back to the Administration complex? Please advise.

SUGGESTED SOLUTION:
Cost Impact: ☐ Schedule Impact: ☐ days By: Mark Delgado

RESPONSE: DATE:
THE COLLEGE WILL BE INSTALLING A NEW "NODE" FOR THE TELEPHONE SYSTEM IN THE IRC BUILDING. THERE WILL ALSO BE TELEPHONE CONDUCTOR PAIRS TO THE IRC FROM THE MDF "NODE" WITHIN THE MAIN COMPUTER (ADMIN). TELEPHONE CONDUCTOR WILL ALSO BE RUN FROM THE SCIENCE BLD MDF TO THE MDF (NODE/CONDUCTORS) WITHIN THE IRC BUILDING. THIS WIRING SCHEME WILL PROVIDE A CONDUCTOR PATH FOR THE DEDICATED PHONE LINE REQUIREMENTS FOR FA & ELEVATOR TELEPHONES/DIALERS.

11-15-06

EDWARD W. SCOTT ELECTRIC CO., INC.
435 HARRET STREET
San Francisco, CA 94103-4914
Phone: (415) 626-0701 Fax: (415) 626-2837

REQUEST FOR INFORMATION

PROJECT: LMC SCIENCE BLDG. R.F.I.# 44 R.F.I. Date 10/18/06
JOB: 2451 ACTUAL REPLY DATE

TO: MARK DELGADO
OF: ARNOLD & ONEIL
REF: DWG. FA2.1/T2.0
LOCATION: DATA ROOM-151

POTENTIAL COST IMPACT
___ COST X SCHEDULE
___ OTHER LABOR
___ NO IMPACT ___ MATERIAL

INFORMATION REQUESTED: THE FACP REQUIRES A DEDICATED TELEPHONE LINE FROM THE DATA CLOSET ROOM 151. HOW WILL THIS LINE BE ROUTED BACK TO THE ADMINISTRATION COMPLEX?

REPLY REQUIRED BY: 10/31/06 SIGNED:
NOTE: IF NO REPLY IS RECEIVED BY US BY THE ABOVE NOTED DATE, A TIME EXTENSION WILL BE REQUIRED WITH POSSIBLE COST IMPACTS.

RESPONSE:


DATED: SIGNED:

EDSOC39

INDUSTRIAL, COMMERCIAL WIRING & DESIGN
STATE CONTRACTOR'S LICENSE NO. 190436


FIRE ALARM RISER NOTES

1. ALL WIRING TO RUN IN CONDUIT. CONDUIT FILL NOT TO EXCEED 40%.
2. REFER TO FLOOR PLANS FOR LOCATION AND CIRCUIT ROUTING FOR ALL DEVICES.
3. FIRE ALARM CONTRACTOR TO UPDATE GRAPHICS PANELS AT THE FIRE STATION AND CAMPUS POLICE STATION. INCLUDE ALL MATERIALS AND LABOR FOR MODIFICATIONS OF EXISTING CAMPUS FIRE ALARM EQUIPMENT.

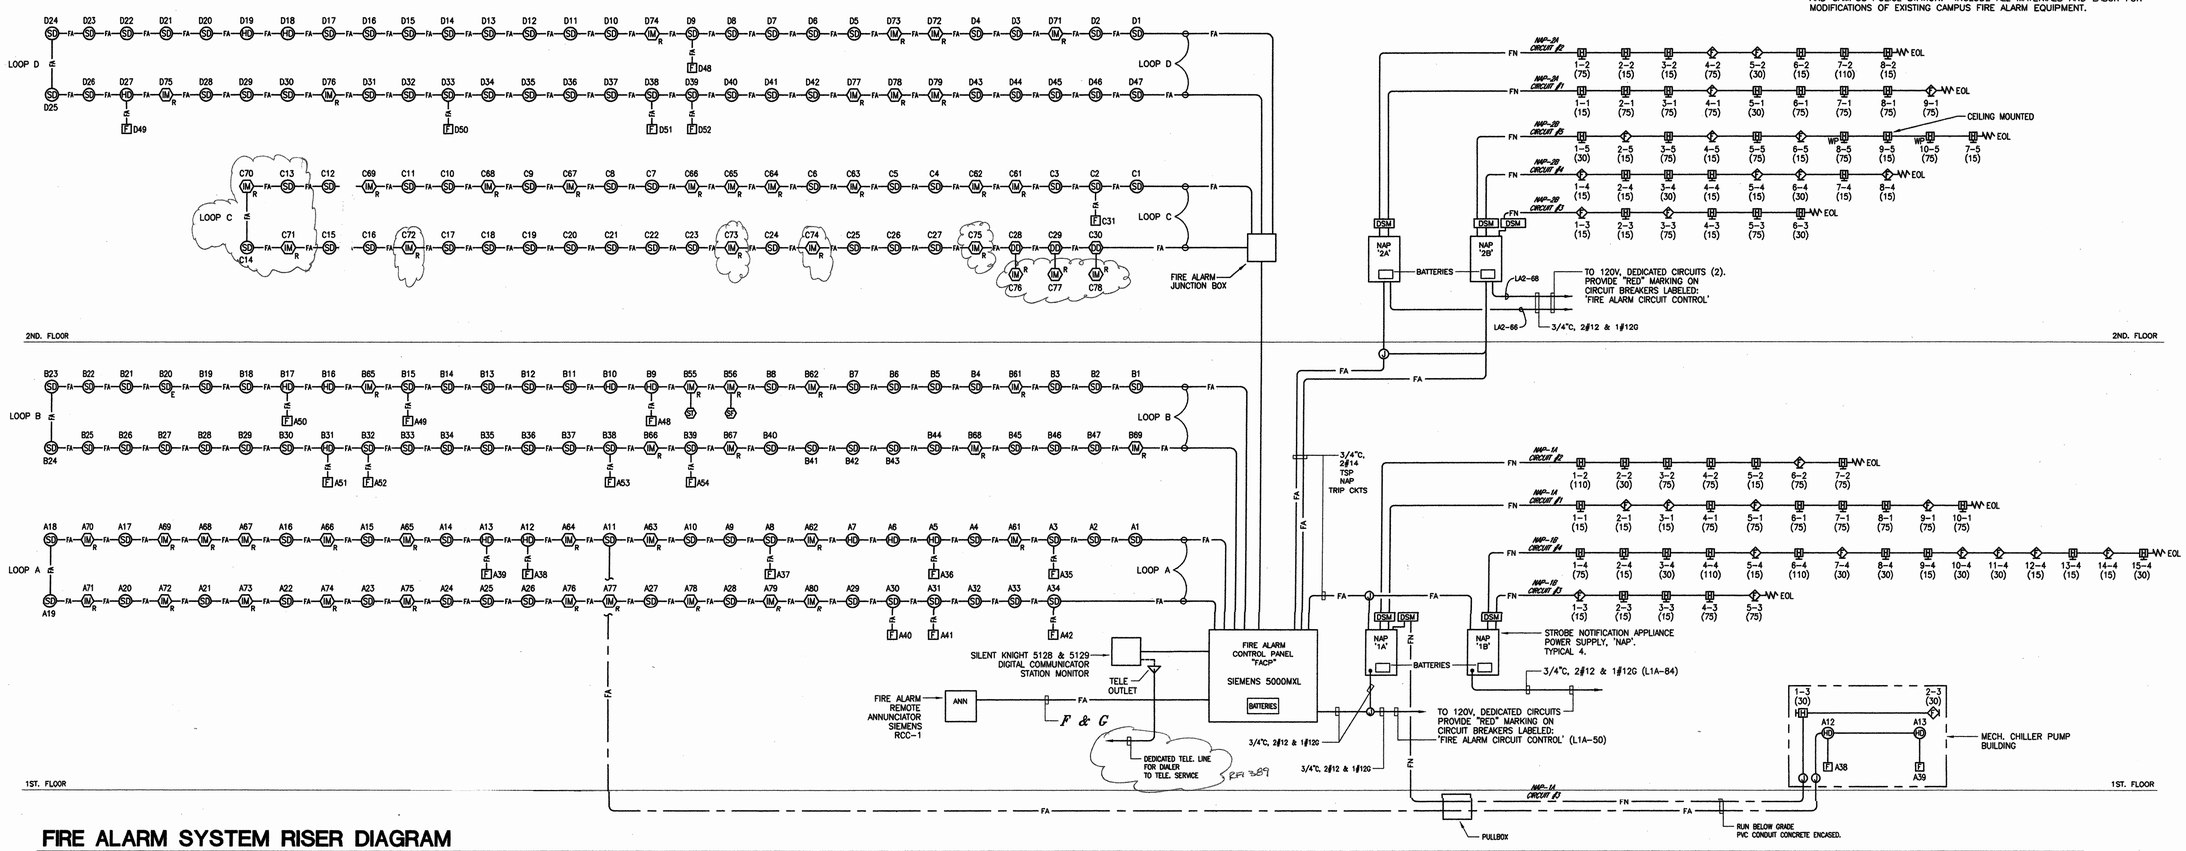


FIRE ALARM SYSTEM RISER DIAGRAM

NOT TO SCALE

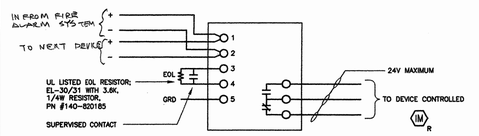


TYPICAL INTERFACE MODULE WIRING DIAGRAM

N.T.S.

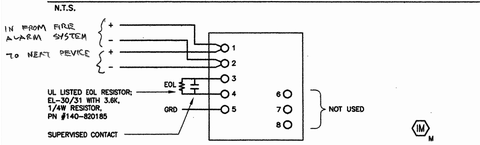


TYPICAL INTERFACE MODULE WIRING DIAGRAM

N.T.S.

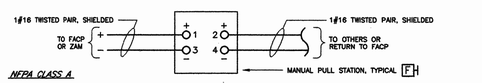


TYPICAL MANUAL PULL STATION WIRING DIAGRAM

N.T.S.

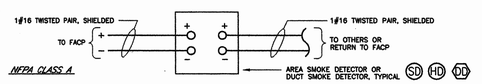


TYPICAL SMOKE, HEAT OR DUCT DETECTOR WIRING DIAGRAM

N.T.S.

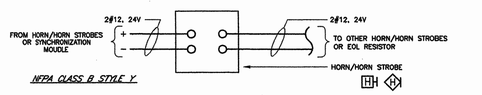


TYPICAL HORN OR HORN/STROBE WIRING DIAGRAM

N.T.S.

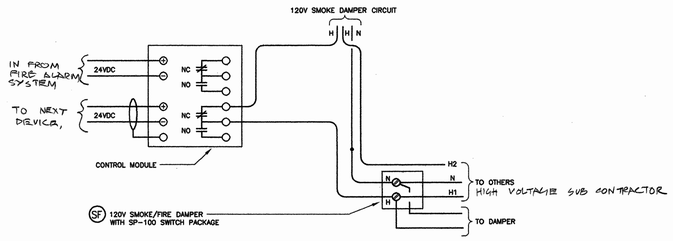

TYPICAL SMOKE/FIRE DAMPER SHUTDOWN WIRING DIAGRAM


N.T.S.

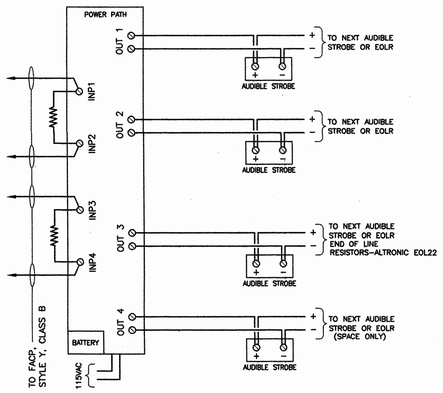

STROBE NOTIFICATION APPLIANCE POWER SUPPLY "NAP" WIRING DIAGRAM


NOT TO SCALE

PROVIDE (2) SIGNAL CIRCUITS TO THE NAP FROM THE FACP FOR SILENCING HORNS AND STROBES SEPARATELY. STROBES SHALL CONTINUE AFTER HORNS ARE SILENCED. OSA INSPECTOR TO VERIFY OPERATION.

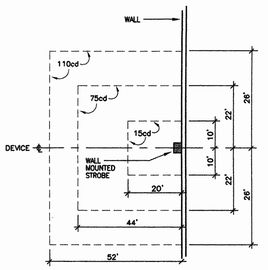

STROBE COVERAGE - OPEN AREAS

NOT TO SCALE — PER NFPA 72A-6-4.4.1.1(a) 0.0375 LUMENS PER SQUARE FOOT

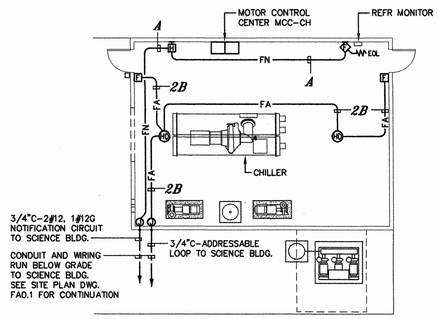

1 FA2.1 — MECHANICAL/CHILLER/PUMP BUILDING

SCALE: 1/8"=1'-0"

TWF #030358.00

tBP
architecture planning interiors management
tBP/Architecture
1000 Burnett Avenue, Suite 140
Concord, CA 94520
p: 925.246.6419 f: 925.246.6495
architect

CONSULTING ENGINEERS
TOFT WOLFF FARROW Inc.
consultant

name
address
city, state, zip
ph:
fx:
agency

SCIENCE BUILDING
LOS MEDANOS COLLEGE
Contra Costa Community College District

owner

tBP project number : 2024.00
file name: FLR-PLAN
drawn by: LLAI checked by: LSM
date: NOVEMBER 15, 2004

rev.	date:	description:

drawing title:
DETAILS & DIAGRAMS
FIRE ALARM

LMC SCIENCE 313-023-112.01-0-00.00
drawing no:
FA-2.1

Battery Calculations for External Device Power

FOR : NAP/1A – 1st FL

LOAD IN STANDBY AT 24 VOLTS DC

Device Type	Number of Devices		Current (amps)		Total Current (AMPS)
Main PC Board with AC fail	1	X	0.035	=	0.035
Report Delay Enabled EOL Resistors	4	X	0.011	=	0.044
TOTAL STANDBY LOAD =					0.079

LOAD IN ALARM AT 24 VOLTS DC

Device Type	Number of Devices		Current (amps)		Total Current (AMPS)
Main PC Board with AC fail	1	X	0.140	=	0.140
Report Delay Enabled EOL Resistors	4	X	0.011	=	0.044
DSM	2	X	0.035	=	0.070
Strobe Light (15cd)	2	X	0.041	=	0.082
Strobe Light (30cd)	0	X	0.065	=	0.000
Strobe Light (75cd)	3	X	0.116	=	0.348
Strobe Light (110cd)	0	X	0.155	=	0.000
Horn Strobes (15cd)	2	X	0.065	=	0.130
Horn Strobes (30cd)	1	X	0.087	=	0.087
Horn Strobes (75cd)	8	X	0.134	=	1.072
Horn Storbes (110cd)	1	X	0.174	=	0.174
Weatherproof Horns	0	X	0.04	=	0.000
TOTAL ALARM LOAD =					2.147

Secondary Power Source Battery Calculations

FOR : NAP/1A – 1st FL

Standby Load Current (Amps)		Required Standby Time in Hours (24 or 60 Hours).	Ampere Hours
0.079	X	24	= 1.90
Alarm Load Current (Amps)		Required Alarm Time in Hours (5 Min.) (i.e. 5 Min. = .084 Hrs.)	
2.147	X	0.084	= 0.18
Total Standby and Alarm Load in Ampere Hours =			2.08
Ampere Hour Load times 1.2 (Rating Factor) =			2.49
Total Ampere Hour Battery Required =			2.49

NOTE:
USE (2) 7.0 AMPERE HOUR BATTERIES

VOLTAGE DROP CALCULATION - NOTIFICATION CIRCUIT - NAP-1A

CKT. # 1A-1

BASED ON POINT TO POINT OHMS CALCULATION – ACCEPTABLE LIMIT 10% @ 24 VOLTS = 2.4 VOLTS MAX.
LINE TO LINE VOLTAGE= 24

FROM START POINT OF RUN	TO END POINT OF RUN	CKT. NO.	RUN LENGTH FEET	DEVICE AMP LOAD	ACCUM. AMP LOAD OF CKT.	AMP. FEET	VOLTS DROP THIS SEGMENT	VOLTAGE AT END OF RUN	ACCUM. VOLT DROP	WIRE SIZE
NAP-1A	DSM	1	2	0.035	1.084	2.17	0.007	23.99	0.007	12
DSM	1-1	1	28	0.065	1.049	29.37	0.100	23.89	0.107	12
1-1	2-1	1	23	0.041	0.984	22.63	0.077	23.82	0.184	12
2-1	3-1	1	14	0.041	0.943	13.20	0.045	23.77	0.229	12
3-1	4-1	1	23	0.134	0.902	20.75	0.071	23.70	0.300	12
4-1	5-1	1	38	0.116	0.768	29.18	0.099	23.60	0.399	12
5-1	6-1	1	21	0.134	0.652	13.69	0.047	23.55	0.446	12
6-1	7-1	1	53	0.134	0.518	27.45	0.093	23.46	0.539	12
7-1	8-1	1	27	0.134	0.384	10.37	0.035	23.43	0.574	12
8-1	9-1	1	38	0.116	0.250	9.50	0.032	23.39	0.606	12
9-1	10-1	1	32	0.134	0.134	4.29	0.015	23.38	0.621	12

MAX. VOLTAGE DROP ON CIRCUIT = MAX ACCUM. VOLT DROP/24 X 100= 2.59%

VOLTAGE DROP CALCULATION - NOTIFICATION CIRCUIT - NAP-2A

CKT. # 2A-1

BASED ON POINT TO POINT OHMS CALCULATION – ACCEPTABLE LIMIT 10% @ 24 VOLTS = 2.4 VOLTS MAX.
LINE TO LINE VOLTAGE= 24

FROM START POINT OF RUN	TO END POINT OF RUN	CKT. NO.	RUN LENGTH FEET	DEVICE AMP LOAD	ACCUM. AMP LOAD OF CKT.	AMP. FEET	VOLTS DROP THIS SEGMENT	VOLTAGE AT END OF RUN	ACCUM. VOLT DROP	WIRE SIZE
NAP-2A	DSM	1	2	0.035	1.067	2.13	0.007	23.99	0.007	12
DSM	1-1	1	26	0.065	1.032	26.83	0.091	23.90	0.099	12
1-1	2-1	1	20	0.134	0.967	19.34	0.066	23.84	0.164	12
2-1	3-1	1	44	0.134	0.833	36.65	0.125	23.71	0.289	12
3-1	4-1	1	69	0.116	0.699	48.23	0.164	23.55	0.453	12
4-1	5-1	1	10	0.065	0.583	5.83	0.020	23.53	0.473	12
5-1	6-1	1	72	0.134	0.518	37.30	0.127	23.40	0.600	12
6-1	7-1	1	35	0.134	0.384	13.44	0.046	23.35	0.645	12
7-1	8-1	1	19	0.134	0.250	4.75	0.016	23.34	0.661	12
8-1	9-1	1	34	0.116	0.116	3.94	0.013	23.33	0.675	12

MAX. VOLTAGE DROP ON CIRCUIT = MAX ACCUM. VOLT DROP/24 X 100= 2.81%

Battery Calculations for External Device Power

FOR : NAP/1B – 1st FL

LOAD IN STANDBY AT 24 VOLTS DC

Device Type	Number of Devices		Current (amps)		Total Current (AMPS)
Main PC Board with AC fail	1	X	0.035	=	0.035
Report Delay Enabled EOL Resistors	4	X	0.011	=	0.044
TOTAL STANDBY LOAD =					0.079

LOAD IN ALARM AT 24 VOLTS DC

Device Type	Number of Devices		Current (amps)		Total Current (AMPS)
Main PC Board with AC fail	1	X	0.140	=	0.140
Report Delay Enabled EOL Resistors	4	X	0.011	=	0.044
DSM	1	X	0.035	=	0.035
Strobe Light (15cd)	4	X	0.041	=	0.164
Strobe Light (30cd)	3	X	0.065	=	0.195
Strobe Light (75cd)	1	X	0.116	=	0.116
Strobe Light (110cd)	0	X	0.155	=	0.000
Horn Strobes (15cd)	5	X	0.065	=	0.325
Horn Strobes (30cd)	3	X	0.087	=	0.261
Horn Strobes (75cd)	2	X	0.134	=	0.268
Horn Storbes (110cd)	2	X	0.174	=	0.348
Weatherproof Horns	0	X	0.04	=	0.000
TOTAL ALARM LOAD =					1.896

Secondary Power Source Battery Calculations

FOR : NAP/1B – 1st FL

Standby Load Current (Amps)		Required Standby Time in Hours (24 or 60 Hours).	Ampere Hours
0.079	X	24	= 1.90
Alarm Load Current (Amps)		Required Alarm Time in Hours (5 Min.) (i.e. 5 Min. = .084 Hrs.)	
1.896	X	0.084	= 0.16
Total Standby and Alarm Load in Ampere Hours =			2.06
Ampere Hour Load times 1.2 (Rating Factor) =			2.47
Total Ampere Hour Battery Required =			2.47

NOTE:
USE (2) 7.0 AMPERE HOUR BATTERIES

VOLTAGE DROP CALCULATION - NOTIFICATION CIRCUIT - NAP-1B

CKT. # 1B-2

BASED ON POINT TO POINT OHMS CALCULATION – ACCEPTABLE LIMIT 10% @ 24 VOLTS = 2.4 VOLTS MAX.
LINE TO LINE VOLTAGE= 24

FROM START POINT OF RUN	TO END POINT OF RUN	CKT. NO.	RUN LENGTH FEET	DEVICE AMP LOAD	ACCUM. AMP LOAD OF CKT.	AMP. FEET	VOLTS DROP THIS SEGMENT	VOLTAGE AT END OF RUN	ACCUM. VOLT DROP	WIRE SIZE
NAP-1B	DSM	2	2	0.035	0.879	1.76	0.006	23.99	0.006	12
DSM	1-2	2	48	0.174	0.844	40.51	0.138	23.86	0.144	12
1-2	2-2	2	63	0.087	0.670	42.21	0.144	23.71	0.287	12
2-2	3-2	2	42	0.134	0.583	24.49	0.083	23.63	0.371	12
3-2	4-2	2	28	0.134	0.449	12.57	0.043	23.59	0.413	12
4-2	5-2	2	42	0.065	0.315	13.23	0.045	23.54	0.458	12
5-2	6-2	2	20	0.116	0.250	5.00	0.017	23.52	0.475	12
6-2	7-2	2	26	0.134	0.134	3.48	0.012	23.51	0.487	12

MAX. VOLTAGE DROP ON CIRCUIT = MAX ACCUM. VOLT DROP/24 X 100= 2.03%

VOLTAGE DROP CALCULATION - NOTIFICATION CIRCUIT - NAP-2A

CKT. # 2A-2

BASED ON POINT TO POINT OHMS CALCULATION – ACCEPTABLE LIMIT 10% @ 24 VOLTS = 2.4 VOLTS MAX.
LINE TO LINE VOLTAGE= 24

FROM START POINT OF RUN	TO END POINT OF RUN	CKT. NO.	RUN LENGTH FEET	DEVICE AMP LOAD	ACCUM. AMP LOAD OF CKT.	AMP. FEET	VOLTS DROP THIS SEGMENT	VOLTAGE AT END OF RUN	ACCUM. VOLT DROP	WIRE SIZE
NAP-2A	DSM	2	2	0.035	0.784	1.57	0.005	23.99	0.005	12
DSM	1-2	2	59	0.134	0.749	44.19	0.150	23.84	0.156	12
1-2	2-2	2	13	0.065	0.615	8.00	0.027	23.82	0.183	12
2-2	3-2	2	27	0.065	0.550	14.85	0.051	23.77	0.233	12
3-2	4-2	2	24	0.116	0.485	11.64	0.040	23.73	0.273	12
4-2	5-2	2	50	0.065	0.369	18.45	0.063	23.66	0.336	12
5-2	6-2	2	67	0.065	0.304	20.37	0.069	23.60	0.405	12
6-2	7-2	2	20	0.174	0.239	4.78	0.016	23.58	0.421	12
7-2	8-2	2	32	0.065	0.065	2.08	0.007	23.57	0.428	12

MAX. VOLTAGE DROP ON CIRCUIT = MAX ACCUM. VOLT DROP/24 X 100= 1.78%

Battery Calculations for External Device Power

FOR : NAP/2A – 2nd FL

LOAD IN STANDBY AT 24 VOLTS DC

Device Type	Number of Devices		Current (amps)		Total Current (AMPS)
Main PC Board with AC fail	1	X	0.035	=	0.035
Report Delay Enabled EOL Resistors	4	X	0.011	=	0.044
TOTAL STANDBY LOAD =					0.079

LOAD IN ALARM AT 24 VOLTS DC

Device Type	Number of Devices		Current (amps)		Total Current (AMPS)
Main PC Board with AC fail	1	X	0.14	=	0.140
Report Delay Enabled EOL Resistors	4	X	0.011	=	0.044
DSM	1	X	0.035	=	0.035
Strobe Light (15cd)	0	X	0.041	=	0.000
Strobe Light (30cd)	1	X	0.065	=	0.065
Strobe Light (75cd)	3	X	0.116	=	0.348
Strobe Light (110cd)	0	X	0.155	=	0.000
Horn Strobes (15cd)	5	X	0.065	=	0.325
Horn Strobes (30cd)	1	X	0.087	=	0.087
Horn Strobes (75cd)	6	X	0.134	=	0.804
Horn Storbes (110cd)	1	X	0.174	=	0.174
Weatherproof Horns	0	X	0.04	=	0.000
TOTAL ALARM LOAD =					2.022

Secondary Power Source Battery Calculations

FOR : NAP/2A – 2nd FL

Standby Load Current (Amps)		Required Standby Time in Hours (24 or 60 Hours).	Ampere Hours
0.079	X	24	= 1.90
Alarm Load Current (Amps)		Required Alarm Time in Hours (5 Min.) (i.e. 5 Min. = .084 Hrs.)	
2.022	X	0.084	= 0.17
Total Standby and Alarm Load in Ampere Hours =			2.07
Ampere Hour Load times 1.2 (Rating Factor) =			2.48
Total Ampere Hour Battery Required =			2.48

NOTE:
USE (2) 7.0 AMPERE HOUR BATTERIES

VOLTAGE DROP CALCULATION - NOTIFICATION CIRCUIT - NAP-1B

CKT. # 1B-3

BASED ON POINT TO POINT OHMS CALCULATION – ACCEPTABLE LIMIT 10% @ 24 VOLTS = 2.4 VOLTS MAX.
LINE TO LINE VOLTAGE= 24

FROM START POINT OF RUN	TO END POINT OF RUN	CKT. NO.	RUN LENGTH FEET	DEVICE AMP LOAD	ACCUM. AMP LOAD OF CKT.	AMP. FEET	VOLTS DROP THIS SEGMENT	VOLTAGE AT END OF RUN	ACCUM. VOLT DROP	WIRE SIZE
NAP-1B	DSM	3	2	0.035	0.456	0.91	0.003	24.00	0.003	12
DSM	1-3	3	15	0.041	0.421	6.32	0.021	23.98	0.025	12
1-3	2-3	3	33	0.065	0.380	12.54	0.043	23.93	0.067	12
2-3	3-3	3	30	0.065	0.315	9.45	0.032	23.90	0.099	12
3-3	4-3	3	19	0.134	0.250	4.75	0.016	23.88	0.116	12
4-3	5-3	3	36	0.116	0.116	4.18	0.014	23.87	0.130	12

MAX. VOLTAGE DROP ON CIRCUIT = MAX ACCUM. VOLT DROP/24 X 100= 0.81%

VOLTAGE DROP CALCULATION - NOTIFICATION CIRCUIT - NAP-2B

CKT. # 2B-3

BASED ON POINT TO POINT OHMS CALCULATION – ACCEPTABLE LIMIT 10% @ 24 VOLTS = 2.4 VOLTS MAX.
LINE TO LINE VOLTAGE= 24

FROM START POINT OF RUN	TO END POINT OF RUN	CKT. NO.	RUN LENGTH FEET	DEVICE AMP LOAD	ACCUM. AMP LOAD OF CKT.	AMP. FEET	VOLTS DROP THIS SEGMENT	VOLTAGE AT END OF RUN	ACCUM. VOLT DROP	WIRE SIZE
NAP-2B	DSM	3	2	0.035	0.521	1.04	0.004	24.00	0.004	12
DSM	1-3	3	23	0.041	0.486	11.18	0.038	23.96	0.042	12
1-3	2-3	3	48	0.065	0.445	21.36	0.073	23.89	0.114	12
2-3	3-3	3	17	0.116	0.380	6.46	0.022	23.86	0.136	12
3-3	4-3	3	20	0.065	0.264	5.28	0.018	23.85	0.154	12
4-3	5-3	3	28	0.134	0.199	5.57	0.019	23.83	0.173	12
5-3	6-3	3	18	0.065	0.065	1.17	0.004	23.82	0.177	12

MAX. VOLTAGE DROP ON CIRCUIT = MAX ACCUM. VOLT DROP/24 X 100= 0.74%

Battery Calculations for External Device Power

FOR : NAP/2B – 2nd FL

LOAD IN STANDBY AT 24 VOLTS DC

Device Type	Number of Devices		Current (amps)		Total Current (AMPS)
Main PC Board with AC fail	1	X	0.035	=	0.035
Report Delay Enabled EOL Resistors	4	X	0.011	=	0.044
TOTAL STANDBY LOAD =					0.079

LOAD IN ALARM AT 24 VOLTS DC

Device Type	Number of Devices		Current (amps)		Total Current (AMPS)
Main PC Board with AC fail	1	X	0.140	=	0.140
Report Delay Enabled EOL Resistors	4	X	0.011	=	0.044
DSM	2	X	0.035	=	0.070
Strobe Light (15cd)	7	X	0.041	=	0.287
Strobe Light (30cd)	1	X	0.065	=	0.065
Strobe Light (75cd)	1	X	0.116	=	0.116
Strobe Light (110cd)	0	X	0.155	=	0.000
Horn Strobes (15cd)	5	X	0.065	=	0.325
Horn Strobes (30cd)	3	X	0.087	=	0.261
Horn Strobes (75cd)	4	X	0.134	=	0.536
Horn Storbes (110cd)	0	X	0.174	=	0.000
Weatherproof Horns	0	X	0.04	=	0.000
TOTAL ALARM LOAD =					1.844

Secondary Power Source Battery Calculations

FOR : NAP/2B – 2nd FL

Standby Load Current (Amps)		Required Standby Time in Hours (24 or 60 Hours).	Ampere Hours
0.079	X	24	= 1.90
Alarm Load Current (Amps)		Required Alarm Time in Hours (5 Min.) (i.e. 5 Min. = .084 Hrs.)	
1.844	X	0.084	= 0.15
Total Standby and Alarm Load in Ampere Hours =			2.05
Ampere Hour Load times 1.2 (Rating Factor) =			2.46
Total Ampere Hour Battery Required =			2.46

NOTE:
USE (2) 7.0 AMPERE HOUR BATTERIES

VOLTAGE DROP CALCULATION - NOTIFICATION CIRCUIT - NAP-1B

CKT. # 1B-4

BASED ON POINT TO POINT OHMS CALCULATION – ACCEPTABLE LIMIT 10% @ 24 VOLTS = 2.4 VOLTS MAX.
LINE TO LINE VOLTAGE= 24

FROM START POINT OF RUN	TO END POINT OF RUN	CKT. NO.	RUN LENGTH FEET	DEVICE AMP LOAD	ACCUM. AMP LOAD OF CKT.	AMP. FEET	VOLTS DROP THIS SEGMENT	VOLTAGE AT END OF RUN	ACCUM. VOLT DROP	WIRE SIZE
NAP-1B	DSM	4	2	0.035	1.291	2.58	0.009	23.99	0.009	12
DSM	1-4	4	21	0.134	1.256	26.38	0.090	23.90	0.098	12
1-4	2-4	4	46	0.065	1.122	51.61	0.178	23.73	0.274	12
2-4	3-4	4	56	0.087	1.057	59.19	0.201	23.52	0.475	12
3-4	4-4	4	50	0.174	0.970	48.50	0.165	23.36	0.640	12
4-4	5-4	4	58	0.041	0.796	46.17	0.157	23.20	0.797	12
5-4	6-4	4	16	0.174	0.755	12.08	0.041	23.16	0.838	12
6-4	7-4	4	21	0.065	0.581	12.20	0.041	23.12	0.880	12
7-4	8-4	4	54	0.087	0.516	27.86	0.095	23.03	0.975	12
8-4	9-4	4	36	0.065	0.429	15.44	0.053	22.97	1.027	12
9-4	10-4	4	37	0.065	0.364	13.47	0.046	22.93	1.073	12
10-4	11-4	4	10	0.065	0.299	2.99	0.010	22.92	1.083	12
11-4	12-4	4	46	0.041	0.234	10.76	0.037	22.88	1.120	12
12-4	13-4	4	20	0.065	0.193	3.86	0.013	22.87	1.133	12
13-4	14-4	4	35	0.041	0.128	4.48	0.015	22.85	1.148	12
14-4	15-4	4	14	0.087	0.087	1.22	0.004	22.85	1.152	12

MAX. VOLTAGE DROP ON CIRCUIT = MAX ACCUM. VOLT DROP/24 X 100= 4.80%

VOLTAGE DROP CALCULATION - NOTIFICATION CIRCUIT - NAP-2B

CKT. # 2B-5

BASED ON POINT TO POINT OHMS CALCULATION – ACCEPTABLE LIMIT 10% @ 24 VOLTS = 2.4 VOLTS MAX.
LINE TO LINE VOLTAGE= 24

FROM START POINT OF RUN	TO END POINT OF RUN	CKT. NO.	RUN LENGTH FEET	DEVICE AMP LOAD	ACCUM. AMP LOAD OF CKT.	AMP. FEET	VOLTS DROP THIS SEGMENT	VOLTAGE AT END OF RUN	ACCUM. VOLT DROP	WIRE SIZE
NAP-2B	DSM	5	2	0.035	0.647	1.29	0.004	24.00	0.004	12
DSM	1-5	5	55	0.087	0.612	33.66	0.114	23.88	0.119	12
1-5	2-5	5	16	0.041	0.525	8.40	0.029	23.85	0.147	12
2-5	3-5	5	13	0.134	0.484	6.29	0.021	23.83	0.169	12
3-5	4-5	5	25	0.041	0.350	8.75	0.030	23.80	0.199	12
4-5	5-5	5	44	0.134	0.309	13.60	0.046	23.76	0.245	12
5-5	6-5	5	46	0.041	0.175	8.05	0.027	23.73	0.272	12
6-5	7-5	5	37	0.134	0.134	4.96	0.017	23.71	0.289	12

MAX. VOLTAGE DROP ON CIRCUIT = MAX ACCUM. VOLT DROP/24 X 100= 1.20%

TWF #0.3058.00

tBP
architecture planning interiors management
tBP/Architecture
1000 Burnett Avenue, Suite 140
Concord, CA 94520
p: 925.246.6419 f: 925.246.6495
architect

CONSULTING ENGINEERS
TOFT WOLFF FARROW Inc.
782 Sutter Street, Suite 200
San Francisco, CA 94109
TEL (415) 241-8700
FAX (415) 241-8711
twfi@twfsf.com
consultant

DSA IDENTIFICATION STAMP
DIV. OF THE STATE ARCHITECT
OFFICE OF REGULATION SERVICES
APP. # 01-105205
DATE 1-13-05

agency

SCIENCE BUILDING
LOS MEDANOS COLLEGE
Contra Costa Community College District
owner





tBP project number : 20241.00
file name: FLR-PLAN
drawn by: LLM checked by: LSH
date: NOVEMBER 15, 2004

Rev	date	description

drawing title:
VOLTAGE DROP AND BATTERY CALCULATIONS - FIRE ALARM

LMC SCIENCE 313-023-112.01-0-00.00
drawing no:
FA-3.1


LEGEND OF SYMBOLS TELECOMMUNICATIONS BOXES

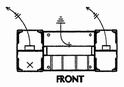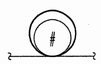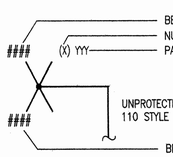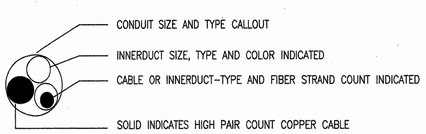SYMBOLS	DESCRIPTIONS
 FRONT	19" x 84" STEEL RACK WITH CABLE MANAGEMENT AND AC POWER DISTRIBUTION. SEE DRAWING T6-4.
	STEEL WIRE CABLE TRAY, VERTICALLY MOUNTED AT LOCATION AND OF SIZE SHOWN.
	20" x 4" x ¼" COPPER GROUND BAR, PROVIDED AND INSTALLED BY ELECTRICAL.
	APC POWER DISTRIBUTION UNIT (PDU) WITH L5-20P PLUG/CORD ASSEMBLY. CONNECT L5-20P PLUG TO OVERHEAD POWER BUSWAY SYSTEM. ATTACH PDU TO BACK OF CHATSWORTH MASTER CABLING SECTION, SECURE WITH CARRIAGE BOLTS. SEE DRAWING T6-4.
 OR GND	DIRECT CONNECTION TO TELECOM GROUNDING BAR REQUIRED. SEE SPECIFICATION SECTION 16803 AND GROUNDING DIAGRAMS.
	KEY NOTE INDICATOR. SEE CORRESPONDING SHEET NOTE ON SAME SHEET.
	DETAIL KEY NOTE INDICATOR. SEE CORRESPONDING DETAIL NOTE ON SAME DETAIL.
	TELECOM BACKBOARDS (E) ¾" A-C GRADE FIRE RESISTANT TREATED PLYWOOD. PLYWOOD SHALL HAVE STAMP THAT INDICATES TREATED FIRE RESISTANCE. MASK STAMP AND PAINT PLYWOOD WITH A LOW SMOKE SEMI-GLOSS WHITE PAINT.
	DETAIL INDICATOR/LOCATOR. SEE ASSOCIATED DETAIL. UPPER # INDICATES DETAIL NUMBER. LOWER # INDICATES SHEET. "___" IN UPPER HALF INDICATES MULTIPLE DETAILS FROM INDICATED SHEET APPLY. "___" IN LOWER HALF INDICATES DETAIL IS ON SAME SHEET AS INDICATOR.
	ELEVATION INDICATOR/LOCATOR. SEE ASSOCIATED ELEVATION. UPPER # INDICATES DETAIL NUMBER. LOWER # INDICATES SHEET. "___" IN UPPER HALF INDICATES MULTIPLE DETAILS FROM INDICATED SHEET APPLY. "___" IN LOWER HALF INDICATES DETAIL IS ON SAME SHEET AS INDICATOR.
	SECTION INDICATOR/LOCATOR. SEE ASSOCIATED SECTION. UPPER # INDICATES DETAIL NUMBER. LOWER # INDICATES SHEET. "___" IN UPPER HALF INDICATES MULTIPLE DETAILS FROM INDICATED SHEET APPLY. "___" IN LOWER HALF INDICATES DETAIL IS ON SAME SHEET AS INDICATOR.
	RISER CONDUITS UP
	RISER CONDUITS DOWN
	RISER CONDUITS THROUGH
	ROUTE CONDUIT TO CABLETRAY
	FIBER OPTIC SERVICE LOOP, # INDICATES LOOP LENGTH IN FEET.
	FIBER OPTIC CABLE
	FIBER OPTIC SPLICE
	BEGINNING PAIR COUNT NUMBER OF TERMINAL BLOCK(S) PAIR CAPACITY OF TERMINAL BLOCK UNPROTECTED COPPER BACKBONE CABLE TERMINAL BLOCK, 110 STYLE BEGINNING PAIR COUNT
	CONDUIT SIZE AND TYPE CALLOUT INNERDUCT SIZE, TYPE AND COLOR INDICATED CABLE OR INNERDUCT-TYPE AND FIBER STRAND COUNT INDICATED SOLID INDICATES HIGH PAIR COUNT COPPER CABLE


COMMUNICATIONS OUTLETS

OUTLET NAMING CONVENTION


OUTLET DIAGRAM BREAKDOWN

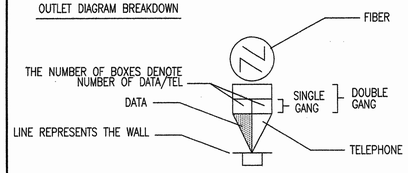

OUTLET NUMBERING CONVENTION

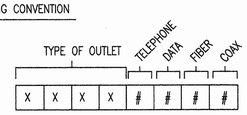

EXAMPLE: WALL BOX FLUSH DOUBLE GANG

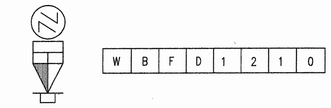

SYMBOLS	DESCRIPTIONS
A ELEV1000 IDF# / ROOM# # — E	ELEVATOR TELEPHONE INTERFACE TERMINATION HARDWARE: (1) 4-PAIR CATEGORY 6 NETWORK STATION CABLE (1) 8 PIN, 8 POSITION TERMINAL BLOCK
A FBSD0400 IDF# / ROOM# STA#	FLOOR BOX SHALLOW DUPLEX TERMINATION HARDWARE: (4) 4-PAIR NETWORK STATION CABLES (4) 8 PIN 8 POSITION NETWORK JACKS
A FBSD0600 IDF# / ROOM# STA#	FLOOR BOX SHALLOW DUPLEX TERMINATION HARDWARE: (6) 4-PAIR NETWORK STATION CABLES (6) 8 PIN 8 POSITION NETWORK JACKS
A FFPD0200 IDF# / ROOM# STA#	FLOOR POKE-THRU FLUSH DOUBLE TERMINATION HARDWARE: (2) 4-PAIR NETWORK STATION CABLES (2) 8 PIN 8 POSITION NETWORK JACKS
A PAY1000 IDF# / ROOM# # — PAY	PAY PHONE FACE PLATE TERMINATION HARDWARE: (1) 4-PAIR TELEPHONE STATION CABLE
A RALD0200 IDF# / ROOM# #	RACEWAY ALUMINUM DUAL CHANNEL TERMINATION HARDWARE: (2) 4-PAIR NETWORK STATION CABLES (2) 8 PIN 8 POSITION NETWORK JACKS
A WALL1000 IDF# / ROOM# # — W	WALL TELEPHONE FACE PLATE TERMINATION HARDWARE: (1) 4-PAIR TELEPHONE STATION CABLE (1) 8 PIN 8 POSITION TELEPHONE JACK
A WAPS0200 IDF# / ROOM# #	WIRELESS ACCESS POINT TERMINATION HARDWARE: (2) 4-PAIR NETWORK STATION CABLES (2) 8 PIN 8 POSITION NETWORK JACKS
A WBFD0200 IDF# / ROOM# # — W	WALL BOX FLUSH DOUBLE GANG TERMINATION HARDWARE: (2) 4-PAIR NETWORK STATION CABLES (2) 8 PIN 8 POSITION NETWORK JACKS
A WBFD0600 IDF# / ROOM# #	WALL BOX FLUSH DOUBLE GANG TERMINATION HARDWARE: (6) 4-PAIR NETWORK STATION CABLES (6) 8 PIN 8 POSITION NETWORK JACKS
A WBFD1200 IDF# / ROOM# # — TEL	WALL BOX FLUSH DOUBLE GANG TERMINATION HARDWARE: (1) 4-PAIR TELEPHONE STATION CABLE (1) 8 PIN 8 POSITION TELEPHONE JACK (2) 4-PAIR NETWORK STATION CABLES (2) 8 PIN 8 POSITION NETWORK JACKS
A WBFD2400 IDF# / ROOM# #	WALL BOX FLUSH DOUBLE GANG TERMINATION HARDWARE: (2) 4-PAIR TELEPHONE STATION CABLES (2) 8 PIN 8 POSITION TELEPHONE JACKS (4) 4-PAIR NETWORK STATION CABLES (4) 8 PIN 8 POSITION NETWORK JACKS

ABBREVIATIONS

ABBREVIATION / DESCRIPTION

GENERAL

(e) OR (E)	EXISTING
(n) OR (N)	NEW
(f) OR (F)	FUTURE
ABV	ABOVE
ACH	ABOVE COUNTER HEIGHT
ACT	ACOUSTICAL CEILING TILE
ADJ	ADJUST(ABLE)
AFC	ABOVE FINISHED CEILING
AFF	ABOVE FINISHED FLOOR
AFG	ABOVE FINISHED GRADE
ALT	ALTERNATE
ANSI	AMERICAN NATIONAL STANDARDS INSTITUTE
APPROX	APPROXIMATE
ARCH	ARCHITECT(URAL)
ASA	AMERICAN STANDARDS ASSOCIATION
BET	BETWEEN
BFC	BELOW FINISHED CEILING
BLDG	BUILDING
BLW	BELOW
C-C	CENTER TO CENTER
CL	CENTER LINE
CLG	CEILING
CLR	CLEAR(ANCE)
CMU	CONCRETE MASON UNIT
COL	COLUMN
CONC.	CONCRETE
CONT	CONTINUOUS
COORD	COORDINATE, COORDINATION
CORR	CORRIDOR
DED	DEDICATE, DEDICATED
DEMO	DEMOLISH
DEPT	DEPT DEPARTMENT
DET	DETAIL
DIM	DIMENSION
DIST	DISTANCE
DWG(S)	DRAWING(S)
EA	EACH
EC	ELECTRICAL CONTRACTOR
ELEV.	ELEVATION
EMERG	EMERGENCY
EQ.	EQUAL
EQPMT	EQUIPMENT
EQUIP	EQUIPMENT
EQUIV	EQUIVALENT
EXIST	EXISTING
EXT	EXTERIOR
FCC	FEDERAL COMMUNICATIONS COMMISSION
FIN	FINISH
FLEX	FLEXIBLE
FLR	FLOOR
FLUOR	FLUORESCENT
FUT	FUTURE
GA	GAUGE
GALV	GALVANIZED
GC	GENERAL CONTRACTOR
GWB	GYPSUM WALL BOARD
INCAND	INCANDESCENT
INCL	INCLUDE, INCLUDING
INFO	INFORMATION
INT	INTERIOR
MAX	MAXIMUM
MECH	MECHANICAL
MFG	MANUFACTURER
MIN	MINIMUM
MISC	MISCELLANEOUS
NA	NOT APPLICABLE
NEC	NATIONAL ELECTRICAL CODE
NEMA	NATIONAL ELECTRICAL MANUFACTURER'S ASSOCIATION
NFPA	NATIONAL FIRE PROTECTION ASSOCIATION
NIC	NOT IN CONTRACT
No.	NUMBER
NOM	NOMINAL
NTS	NOT TO SCALE
OC	ON CENTER
OFCI	OWNER FURNISHED CONTRACTOR INSTALLED
OFE	OWNER FURNISHED EQUIPMENT
OFOI	OWNER FURNISHED, OWNER INSTALLED
OPP	OPPOSITE
OSHA	OCCUPATIONAL SAFETY AND HEALTH ADMINISTRATION
OVHD	OVERHEAD
PAV	PAVEMENT
PLY	PLYWOOD
PLYWD	PLYWOOD
PRI	PRIMARY
PROP	PROPOSED
QTY	QUANTITY
RCP	REFLECTED CEILING PLAN
REF	REFERENCE
REM	REMOVE
REPL	REPLACE
REQ'D	REQUIRED
REQD	REQUIRED
RM	ROOM
SCHD	SCHEDULE
SECT.	SECTION
SHT	DRAWING SHEET NUMBER OR SERIES
SIM	SIMILAR
SPEC	SPECIFICATION
SQ	SQUARE
STD	STANDARD
STL	STEEL
SUSP	SUSPEND(ED)
SYM	SYMMETRICAL
SYST	SYSTEM
TELC	TELECOMMUNICATIONS CONTRACTOR
TEMP	TEMPORARY
THK	THICK(NESS)
TIA/EIA	TELECOMMUNICATIONS INDUSTRIES ASSOCIATION/ELECTRONIC INDUSTRY ALLIANCE
TME	TO MATCH EXISTING
TYP	TYPICAL
UBC	UNIFORM BUILDING CODE
UC	UNDERCOUNTER
UL	UNDERWRITERS LABORATORY
UON	UNLESS OTHERWISE NOTED
VIF	VERIFY IN FIELD
W/	WITH
W/O	WITHOUT
WD	WOOD
WO	WHERE OCCURS

SYMBOLS AS ABBREVIATIONS

#	POUND
&	AND
@	AT
'	FOOT OR FEET
"	INCH OR INCHES
+/- OR ±	PLUS OR MINUS
<	LESS THAN
=	EQUAL
>	GREATER THAN
°	DEGREES, ANGULAR MEASURE
Ω	OHM
∥	PARALLEL
ø	DIAMETER
∠	ANGLE

NOTE

WHERE AN ABBREVIATION HAS MORE THAN ONE DESCRIPTION ABBREVIATIONS ARE CONTEXT SENSITIVE.

WIRE & CABLE ABBREVIATIONS

ANMW	24 AWG BONDED FILL FLOODED TWISTED CABLE
ARMM	24 AWG RISER ARMORED BONDED MULTIPAIR CABLE
AWG	AMERICAN WIRE GAGE
CAT3	CATEGORY 3 TWISTED PAIR COPPER CABLE
CAT6	CATEGORY 6 TWISTED PAIR COPPER CABLE
CM	NEC, COMMUNICATIONS CABLE
CMP	NEC, COMMUNICATIONS PLENUM CABLE
CMR	NEC, COMMUNICATIONS RISER CABLE
COAX	COAXIAL CABLE
FO	FIBER OPTIC
HDPE	HIGH DENSITY POLYETHYLENE
LTFF	LOOSE TUBE FILLED & FLOODED
MDPE	MEDIUM DENSITY POLYETHYLENE
MM	MULTIMODE FIBER OPTIC CABLE
MPP	NEC, MULTIPURPOSE PLENUM CABLE
OFC	NEC, OPTICAL FIBER CONDUCTIVE CABLE
OFCP	NEC, OPTICAL FIBER CONDUCTIVE PLENUM CABLE
OFCR	NEC, OPTICAL FIBER CONDUCTIVE RISER CABLE
OFNR	NEC, OPTICAL FIBER NON-CONDUCTIVE RISER CABLE
OFN	NEC, OPTICAL FIBER NON-CONDUCTIVE CABLE
OFNP	NEC, OPTICAL FIBER NON-CONDUCTIVE PLENUM CABLE
SM	SINGLE MODE FIBER OPTIC CABLE
STP	SHIELDED TWISTED PAIR
TB	TIGHT BUFFERED
UTP	UNSHIELDED TWISTED PAIR

ELECTRICAL ABBREVIATIONS

A OR AMP	AMPERE
BND	BOND(ING)
C	CONDUIT
C.O.	CONDUIT ONLY
COND.	CONDUIT
ELEC	ELECTRIC(AL)
EMT	ELECTRICAL METALLIC TUBING
ENT	ELECTRICAL NON-METALLIC TUBING
GRC	GALVANIZED RIGID CONDUIT
GRD	GROUND
GRND	GROUND
Hz	HERTZ
IG	ISOLATED GROUND
IMC	INTERMEDIATE METALLIC CONDUIT
PB	PULL BOX
PLN	PANEL
PWR	POWER
UPS	UNINTERRUPTABLE POWER SUPPLY
V	VOLT
VAC	VOLTS, ALTERNATING CURRENT
VDC	VOLTS, DIRECT CURRENT
W	WATT
XFMR	TRANSFORMER

MEASURMENTS ABBREVIATIONS

BTU	BRITISH THERMAL UNIT
D or Dp	DEEP
DIA	DIAMETER
FT	FOOT OR FEET
H or HGT	HEIGHT OR HIGH
ID	INSIDE DIAMETER
In	INCH
L	LENGTH OR LONG
Lb	POUND
LIN	LINEAR
M	METER
mm	MILIMETER
OD	OUTSIDE DIAMETER
R	RADIUS
RAD	RADIANS
um	MICRON
W	WIDE
WT	WEIGHT
YD	YARD

TELECOMMUNICATIONS ABBREVIATIONS

110	TWISTED PAIR TERMINATION BLOCK
ADF	AREA DISTRIBUTION FACILITY
BDF	BUILDING DISTRIBUTION FRAME OR FACILITY
BEF	BUILDING ENTRANCE FRAME OR FACILITY
CAB	TELECOM CABINET OR ENCLOSURE
CONN	CONNECTOR
CSC	COPPER SPLICE CLOSURE
CEV	CONTROLLED ENVIRONMENTAL VAULT
FDF	FIBER DISTRIBUTION FACILITY
FF	FRONT FACING
FS	FIBER SHELF/FIBER TERMINATION PANEL
FSC	FIBER OPTIC SPLICE CLOSURE
HH	HANDHOLE
IDF	INTERMEDIATE DISTRIBUTION FRAME OR FACILITY
MDF	MAIN DISTRIBUTION FRAME
MH	MANHOLE, MAINTENANCE HOLE
MPOE	MINIMUM POINT OF ENTRY, MAIN POINT OF ENTRY
OCEF	OPTICAL CABLE ENTRANCE FACILITY
PC	PLASTIC CONDUIT
PG	PAIR GROUP
POP	POINT OF PRESENCE
PR	PAIR
PVC	POLYVINYL CHLORIDE
R/W	RIGHT-OF-WAY
SC	SPLICE CLOSURE
SCS	STRUCTURED CABLING SYSTEM
SER	SERIAL
SMR	SURFACE MOUNTED RACEWAY
SS	FIBER SPLICE SHELF
TC	TELECOM CLOSET
TCC	TELECOM CONDUIT
TCH	TELECOM CONDUIT SLEEVE, HORIZONTAL
TCR	TELECOM HORIZONTAL & VERTICAL RISER CONDUIT
TCT	TELECOM CABLE TRAY
TEC	TELECOM ENTRANCE CONDUIT
TEL	TELEPHONE
TELECOM	TELECOMMUNICATIONS
TERM	TERMINAL
TP	TWISTED PAIR
TPB	TELECOM PULL BOX
TSL	TELECOM WALL OR FLOOR SLOT
TSV	TELECOM CONDUIT SLEEVE, VERTICAL

COLOR CODE

AQ	AQUA
BK	BLACK
BL	BLUE
BR	BROWN
G	GREEN
GR	GREY
OR	ORANGE
R	RED
RS	ROSE
SL	SLATE
V	VIOLET
W	WHITE
YL	YELLOW

DIRECTIONAL ABBREVIATIONS

DN	DOWN
E	EAST
HORIZ	HORIZONTAL
L	LEFT
LH	LEFT HAND
N	NORTH
PERP	PERPENDICULAR
R	RIGHT
RH	RIGHT HAND
S	SOUTH
VERT	VERTICAL


TELECOMMUNICATIONS DRAWING LIST

#	SHT.#	DESCRIPTION
01	T0-1	LEGEND, SYMBOLS, ABBREVIATIONS & DRAWING INDEX
02	T1-0	TELECOMMUNICATIONS FIBER OPTIC OSP CABLE
03	T1-1	FIRST FLOOR PLAN, PART "A" TELECOM OUTLETS
04	T1-2	FIRST FLOOR PLAN, PART "B" TELECOM OUTLETS
05	T1-3	SECOND FLOOR PLAN, PART "A" TELECOM OUTLETS
06	T1-4	SECOND FLOOR PLAN, PART "B" TELECOM OUTLETS
07	T1-5	ROOF PLAN, PART "B" TELECOM OUTLETS
08	T3-1	ENLARGED PLANS - BDF/IDF 1.0 (ROOM 151)
09	T3-2	ENLARGED PLANS - IDF 2.0 (ROOM 209)
10	T4-1	ELEVATIONS - WALL & RACK - BDF/IDF 1.0 (ROOM 151)
11	T4-2	ELEVATIONS - WALL & RACK - IDF 2.0 (ROOM 209)
12	T4-3	ELEVATIONS - FIBER OPTIC TERMINATION SHELVES
13	T4-4	ELEVATIONS - FIBER OPTIC TERMINATION SHELVES
14	T5-1	RISER DIAGRAM - FIBER OPTIC AND COPPER BACKBONE
15	T6-0	DETAILS - TELECOM OUTLETS
16	T6-1	DETAILS - TELECOM OUTLETS
17	T6-2	DETAILS - STEEL WIRE CABLE TRAY
18	T6-3	DETAILS - FIBER OPTIC TROUGH AND "U"-CHANNEL
19	T6-4	DETAILS - EQUIPMENT RACK
20	T6-5	DETAILS - IDENTIFICATION & LABELING
21	T6-6	DETAILS - FIRESTOPPING

TELECOM TERMINATION DEVICE IDENTIFIER LEGEND

SYMBOLS	DESCRIPTION

FIBER TERMINATION SHELF LEGEND

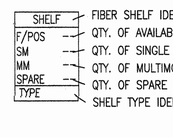

AUDIO/VIDEO SYMBOLS LIST

TERMINAL, PULL BOXES AND BACKCANS FOR LOW VOLTAGE CIRCUITS AND WIRING

SYMBOL	DESCRIPTION	DEVICE	MOUNTING	REMARKS
S	SPEAKER BACKCAN/BAFFLE ASSEMBLY, FOR 4" LOUDSPEAKER CEILING-MOUNT	ATLAS SOUND, BMT95-4 BACKCAN WITH TS1-84 BAFFLE.	FLUSH-MOUNT IN FINISHED CEILING. CENTER IN BOTH DIRECTIONS IN ACOUSTICAL TILE.	PROVIDE ATLAS SOUND MOUNTING RAIL WHEN USED IN ACOUSTICAL TILE TYPE CEILINGS. FOR FUTURE CEILING-MOUNT SPEAKERS (SUPPLIED AND INSTALLED BY OWNER). SEE DETAILS.
FB	FLOOR BOX, HINGED DIVIDED WITH (1) 4 GANG, (1) 2 GANG OPENING, & (1) SINGLE GANG OPENING	FSR FL-500P	CAST-IN-PLACE	

tBP
architecture
planning
interiors
management
tBP/Architecture
1000 Burnett Avenue, Suite 140
Concord, CA 94520
p: 9252466419 f: 9252466495

LICENSED ARCHITECT · REGISTERED CALIFORNIA · STATE OF CALIFORNIA · EXP. 6-30-06

INFRASTRUCTURE DESIGN ASSOCIATES
1440 Broadway
Suite 304
Oakland, CA. 94612

EXPIRES 12/31/06
Regis. No. 06606
SIGNATURE

consultant

DSA DESCRIPTION STAMP
DIV. OF THE STATE ARCHITECT
OFFICE OF REGULATION SERVICES
APP. 01/05/2005
DATE 1-10-05

name
address
city, state, zip
ph: fx:

SCIENCE BUILDING
LOS MEDANOS COLLEGE

Contra Costa Community College District


owner

tBP project number : 20247.00
file name:
drawn by: checked by:
date: NOVEMBER 15, 2004

drawing title: LEGEND, SYMBOLS, ABBREVIATIONS, & DRAWING INDEX
building no:
LMC SCIENCE 313-023-112.01-0-00.00
drawing no: T0-1
drawing of

\Los Medanos College\Science Building\Final DSA\acad\T0-1.dwg 12-13-04 08:52:24 AM cmendoza

ADDENDUM #2
DSA FILE # 7-C1
DSA APPL.# 01-106226

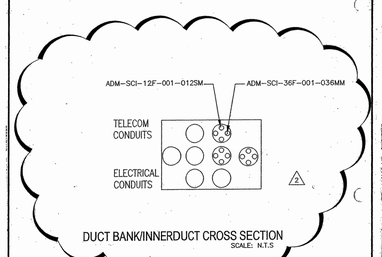

DUCT BANK/INNERDUCT CROSS SECTION
SCALE: N.T.S

INFRASTRUCTURE DESIGN ASSOCIATES
1440 Broadway
Suite 304
Oakland, CA 94612
Ph: (510) 238-8000
Fax: (510) 238-8009


EXPIRES 12/31/05
Regis. No. 05229
SIGNATURE

TELECOMMUNICATIONS FIBER OPTIC OSP CABLES

SCIENCE BUILDING
LOS MEDANOS COLLEGE
Pittsburg, CA
Contra Costa Community College District

ADDENDUM #2
DATE: 05/11/05
DSA NO.: 01-106226
THIS REVISES IN PART
SHEET: T1.0
SHEET: SKT-1

ADDENDUM #2
DSA FILE # 7-C1
DSA APPL.# 01-106226

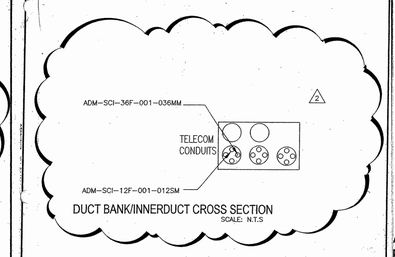

DUCT BANK/INNERDUCT CROSS SECTION
SCALE: N.T.S

INFRASTRUCTURE DESIGN ASSOCIATES
1440 Broadway
Suite 304
Oakland, CA 94612
Ph: (510) 238-8000
Fax: (510) 238-8009


EXPIRES 12/31/05
Regis. No. 05229
SIGNATURE

TELECOMMUNICATIONS FIBER OPTIC OSP CABLES

SCIENCE BUILDING
LOS MEDANOS COLLEGE
Pittsburg, CA
Contra Costa Community College District

ADDENDUM #2
DATE: 05/11/05
DSA NO.: 01-106226
THIS REVISES IN PART
SHEET: T1.0
SHEET: SKT-2

ADDENDUM #2
DSA FILE # 7-C1
DSA APPL.# 01-106226

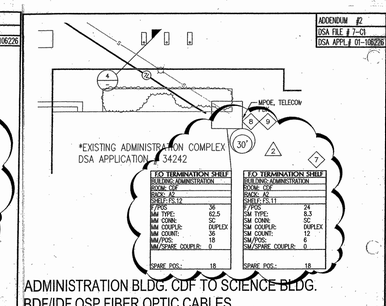

ADMINISTRATION BLDG. CDF TO SCIENCE BLDG.
BDF/IDF OSP FIBER OPTIC CABLES
SCALE: 1"=30'

N

INFRASTRUCTURE DESIGN ASSOCIATES
1440 Broadway
Suite 304
Oakland, CA 94612
Ph: (510) 238-8000
Fax: (510) 238-8009


EXPIRES 12/31/05
Regis. No. 05229
SIGNATURE

TELECOMMUNICATIONS FIBER OPTIC OSP CABLES

SCIENCE BUILDING
LOS MEDANOS COLLEGE
Pittsburg, CA
Contra Costa Community College District

ADDENDUM #2
DATE: 05/11/05
DSA NO.: 01-106226
THIS REVISES IN PART
SHEET: T1.0
SHEET: SKT-3

ADDENDUM #2
DSA FILE # 7-C1
DSA APPL.# 01-106204

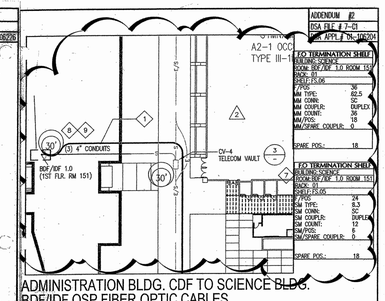

ADMINISTRATION BLDG. CDF TO SCIENCE BLDG.
BDF/IDF OSP FIBER OPTIC CABLES
SCALE: 1"=30'

INFRASTRUCTURE DESIGN ASSOCIATES
1440 Broadway
Suite 304
Oakland, CA 94612
Ph: (510) 238-8000
Fax: (510) 238-8009

EXPIRES 12/31/05
Regis. No. 05229
SIGNATURE

TELECOMMUNICATIONS FIBER OPTIC OSP CABLES

LOS MEDANOS COLLEGE
Pittsburg, CA
Contra Costa Community College District

ADDENDUM #2
DATE: 05/11/05
DSA NO.: 01-106204
THIS REVISES IN PART
SHEET: T1.0
SHEET: SKT-4

S. J. AMOROSO
Request For Information/Clarification

DSA FILE NO. 7-C1
DSA APPL. No. 01-106226

To: IBI/Architecture
1000 Burnett Ave, Suite 140
Concord, CA 94520

Project: LOS MEDANOS COLLEGE
SCIENCE BUILDING
Contra Costa Community College District

Attn: Celia Chiang, Tom Beckett
Fax: 925-246-6465

IBP p/n: 20247.00

Subj.: Campus Network Issues with BMS System

RFI No: 488

Reference (dwg, spec.):

Subcontractor RFI: CommAir 10

Reply Requested By: 2/22/07

INFORMATION REQUESTED: Date: 2/15/07

Please note the attached CommAir RFI No.10 regarding the BMS System support from the Campus Network. Please advise.

SUGGESTED SOLUTION:
Cost Impact: ☐ Schedule Impact: ☐ days By: Justin Warren

RESPONSE: DATE:

Please provide IDA with the 3 locations for the proposed network connection need for the BMS System to IDA can confirm that there are drops in each location. The cable work provides connection to the campus network is being installed by another contractor, however there are a series of events which must take place prior to the district installing any network equipment to connect the BMS system. First all the telecom rooms must be built out according to the design documents; all cables must be pulled, tested, labeled and reviewed by IDA prior to installing any network equipment such as routers switches etc.

Jim Weaver / IBP Architecture, David Buza / IDA 2/14/07

The following locations were provided by SJA. Please see response with each.
1. One location is in the chiller building so that the BAS can "reach" the chiller itself.
2. A second location is in the mechanical controls shop. Coordinate location with mechanical controls.
3. The third location is really at the discretion of the end user as this location is wherever they choose to have the PC located that will be associated with the Tridelt fume hood valves.
Responses: Refer to RFI 493 for locating the Tridelt in data room 209. Data is available.

Jim Weaver / IBP Architecture, David Buza / IDA Supplemental Response 3/8/07

RFI # 000
Page 1

CC: Mowrey
EWS

CommAir

REQUEST FOR INFORMATION

DATE: 02/15/2007 RFI# 0010
JOB NO.: 607200010 BY: Chris Olivera
PROJECT: LMC Science

TO: Monterey Mechanical
3685 Willow Ave
Antioch, CA 94509
925-757-4640 Fax 757-0674
ATTN: Dan Riedmiller

DIST

Title or Section of Work: Network issue

Drawing Location: Specification Location:

Cost Impact: ☐ Yes ☐ No Estimate:

Time Impact: ☐ Yes ☐ No Estimate:

Description of Problem / Attach sketches as required
1) I have some concerns regarding the network connectivity for this building in the near future. The BMS computer will need to be placed on the campus network with access back to the Maintenance Shop BMS computer. They seem to be up on 3 other jobs with the College District recently. Not only do we need a physical network drops (1) for the BMS computer, but (2) for the Trane controller, (3) for Tridelt controller, but we also need the "switches/routers" or whatever devices the District is planning to install to this building to allow this building to communicate on the Campus network. These network devices will need to be installed prior to the BMS being connected to them. We have had issues recently where we have wasted multiple days working on the District network issues and we just do not have manpower at this time for work that is not our responsibility.

Response Requested By: Christopher J. Olivera – (510) 772-9340

Proposed Solution:

Signed: Christopher J. Olivera
Organization: Carrier
Date: 02/15/2007
Distribution: ☐ Architect ☐ Super ☐ Mech. Eng. ☐ Elec. Eng. ☐ Owner ☐

S. J. AMOROSO
Request For Information/Clarification

DSA FILE NO. 7-C1
DSA APPL. No. 01-106226

To: IBI/Architecture
1000 Burnett Ave, Suite 140
Concord, CA 94520

Project: LOS MEDANOS COLLEGE
SCIENCE BUILDING
Contra Costa Community College District

Attn: Celia Chiang, Tom Beckett
Fax: 925-246-6465

IBP p/n: 20247.00

Subj.: Network drop at chiller building

RFI No: 494

Reference (dwg, spec.):

Subcontractor RFI:

Reply Requested By: 3/9/07

INFORMATION REQUESTED: Date: 3/2/07

As discussed during our Feb 28 site meeting addressing telecom subjects, a network drop will be required at the chiller building in order to allow the Science Building BAS system to communicate with the chiller building. Mention was made of a nearby manhole that may be of use in facilitating this connection. Please review and advise.

SUGGESTED SOLUTION:
Cost Impact: ☐ Schedule Impact: ☐ days By: Justin Warren

RESPONSE: DATE:

Contractor to utilize the womens locker building telecommunications room located to the south of the chiller building to run the outside plant 4 pair category 6 cable.
Pathway to be from chiller building to CV-6 to womens locker building.

The Category 6 cabling is to match the existing campus standards and meet the standards for use in an outdoor environment. Cable must meet or exceed all testing per the specifications and is to be placed in an innerduct. Contractor to coordinate the placement of the new 4 pair category 6 copper cable with the owner.


Jim Weaver / IBP Architecture
Dave Buza / IDA

3/19/07

RFI # 000
Page 1

1

ADDENDUM #2
DSA FILE # 7-C1
DSA APPL.# 01-106226

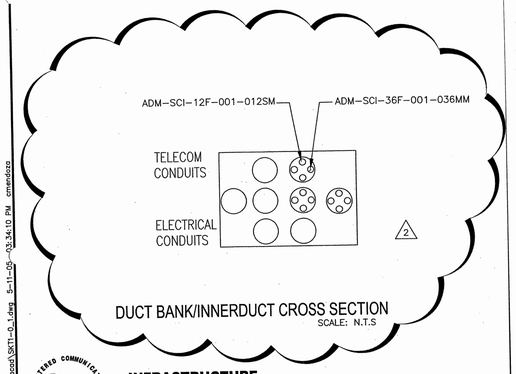

DUCT BANK/INNERDUCT CROSS SECTION
SCALE: N.T.S

REGISTERED COMMUNICATIONS DISTRIBUTION DESIGNER BICSI
EXPIRES 12/31/05
Regis. No. 05229
SIGNATURE

INFRASTRUCTURE DESIGN ASSOCIATES
1440 Broadway
Suite 304
Oakland, CA. 94612
Ph: (510) 238-8000
Fax: (510) 238-8009

TELECOMMUNICATIONS
FIBER OPTIC OSP CABLES

SCIENCE BUILDING
LOS MEDANOS COLLEGE
Pittsburg, CA
Contra Costa Community College District

ARCHITECT
tBP/Architecture
1000 Burnett Ave, Suite 140
Concord, CA 94520
p: 925.246.6419 f: 925.246.6495

tBP architecture planning interiors management


LICENSED ARCHITECT RICHARD P. MARQUIS, A.I.A. NO. C-9685 REN. 12-31-05 STATE OF CALIFORNIA

ADDENDUM #2
DATE: 05/11/05
DSA NO. 01-106226
THIS REVISES IN PART
SHEET: T1.0
SHEET: SKT-1

G:\Los Medanos College\Science Building\ADDENDUM#2\acad\SKT1-0_1.dwg 5-11-05 03:34:10 PM cmendoza

2

ADDENDUM #2
DSA FILE # 7-C1
DSA APPL.# 01-106226

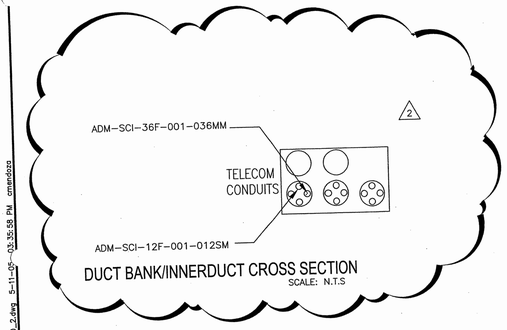

DUCT BANK/INNERDUCT CROSS SECTION
SCALE: N.T.S

REGISTERED COMMUNICATIONS DISTRIBUTION DESIGNER BICSI
EXPIRES 12/31/05
Regis. No. 05229
SIGNATURE

INFRASTRUCTURE DESIGN ASSOCIATES
1440 Broadway
Suite 304
Oakland, CA. 94612
Ph: (510) 238-8000
Fax: (510) 238-8009

TELECOMMUNICATIONS
FIBER OPTIC OSP CABLES

SCIENCE BUILDING
LOS MEDANOS COLLEGE
Pittsburg, CA
Contra Costa Community College District

ARCHITECT
tBP/Architecture
1000 Burnett Ave, Suite 140
Concord, CA 94520
p: 925.246.6419 f: 925.246.6495

tBP architecture planning interiors management


LICENSED ARCHITECT RICHARD P. MARQUIS, A.I.A. NO. C-9685 REN. 12-31-05 STATE OF CALIFORNIA

ADDENDUM #2
DATE: 05/11/05
DSA NO. 01-106226
THIS REVISES IN PART
SHEET: T1.0
SHEET: SKT-2

G:\Los Medanos College\Science Building\ADDENDUM#2\acad\SKT1-0_2.dwg 5-11-05 03:35:58 PM cmendoza

3

ADDENDUM #2
DSA FILE # 7-C1
DSA APPL.# 01-106226

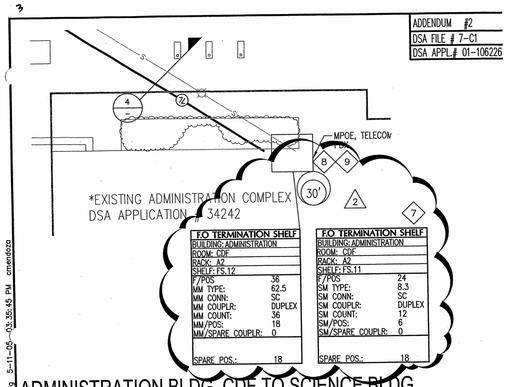

F.O TERMINATION SHELF	
BUILDING: ADMINISTRATION	
ROOM: CDF	
RACK: A2	
SHELF: FS.12	
F/POS	36
MM TYPE:	62.5
MM CONN:	SC
MM COUPLR:	DUPLEX
MM COUNT:	36
MM/POS:	18
MM/SPARE COUPLR:	0
SPARE POS.:	18

F.O TERMINATION SHELF	
BUILDING: ADMINISTRATION	
ROOM: CDF	
RACK: A2	
SHELF: FS.11	
F/POS	24
SM TYPE:	8.3
SM CONN:	SC
SM COUPLR:	DUPLEX
SM COUNT:	12
SM/POS:	6
SM/SPARE COUPLR:	0
SPARE POS.:	18

ADMINISTRATION BLDG. CDF TO SCIENCE BLDG.
BDF/IDF OSP FIBER OPTIC CABLES
SCALE: 1"=30'

N

REGISTERED COMMUNICATIONS DISTRIBUTION DESIGNER BICSI
EXPIRES 12/31/05
Regis. No. 05229
SIGNATURE

INFRASTRUCTURE DESIGN ASSOCIATES
1440 Broadway
Suite 304
Oakland, CA. 94612
Ph: (510) 238-8000
Fax: (510) 238-8009

TELECOMMUNICATIONS
FIBER OPTIC OSP CABLES

SCIENCE BUILDING
LOS MEDANOS COLLEGE
Pittsburg, CA
Contra Costa Community College District

ARCHITECT
tBP/Architecture
1000 Burnett Ave, Suite 140
Concord, CA 94520
p: 925.246.6419 f: 925.246.6495

tBP architecture planning interiors management


LICENSED ARCHITECT RICHARD P. MARQUIS, A.I.A. NO. C-9685 REN. 12-31-05 STATE OF CALIFORNIA

ADDENDUM #2
DATE: 05/11/05
DSA NO. 01-106226
THIS REVISES IN PART
SHEET: T1.0
SHEET: SKT-3

2:\Los Medanos College\Science Building\ADDENDUM#2\acad\SKT1-0_3.dwg 5-11-05 03:35:45 PM cmendoza

4

ADDENDUM #2
DSA FILE # 7-C1
DSA APPL.# 01-106204

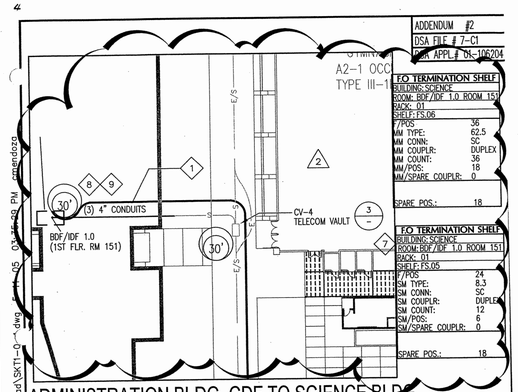

F.O TERMINATION SHELF	
BUILDING: SCIENCE	
ROOM: BDF/IDF 1.0 ROOM 151	
RACK: 01	
SHELF: FS.06	
F/POS	36
MM TYPE:	62.5
MM CONN:	SC
MM COUPLR:	DUPLEX
MM COUNT:	36
MM/POS:	18
MM/SPARE COUPLR:	0
SPARE POS.:	18

F.O TERMINATION SHELF	
BUILDING: SCIENCE	
ROOM: BDF/IDF 1.0 ROOM 151	
RACK: 01	
SHELF: FS.05	
F/POS	24
SM TYPE:	8.3
SM CONN:	SC
SM COUPLR:	DUPLEX
SM COUNT:	12
SM/POS:	6
SM/SPARE COUPLR:	0
SPARE POS.:	18

ADMINISTRATION BLDG. CDF TO SCIENCE BLDG.
BDF/IDF OSP FIBER OPTIC CABLES
SCALE: 1"=30'

REGISTERED COMMUNICATIONS DISTRIBUTION DESIGNER BICSI
EXPIRES 12/31/05
Regis. No. 05229
SIGNATURE

INFRASTRUCTURE DESIGN ASSOCIATES
1440 Broadway
Suite 304
Oakland, CA. 94612
Ph: (510) 238-8000
Fax: (510) 238-8009

TELECOMMUNICATIONS
FIBER OPTIC OSP CABLES

LOS MEDANOS COLLEGE
Pittsburg, CA
Contra Costa Community College District

ARCHITECT
tBP/Architecture
1000 Burnett Ave, Suite 140
Concord, CA 94520
p: 925.246.6419 f: 925.246.6495

tBP architecture planning interiors management

LICENSED ARCHITECT RICHARD P. MARQUIS, A.I.A. NO. C-9685 REN. 12-31-05 STATE OF CALIFORNIA

ADDENDUM #2
DATE: 05/11/05
DSA NO. 01-106204
THIS REVISES IN PART
SHEET: T1.0
SHEET: SKT-4

C:\Los Medanos College\Science Building\ADDENDUM#2\acad\SKT1-0_4.dwg 5-11-05 03:36:29 PM cmendoza

architect

consultant

IDENTIFICATION STAMP
DIVISION OF THE STATE ARCHITECT
OFFICE OF REGIONAL SERVICES
APPL. NO: 01-106226
AC. FLS SS
DATE

agency
Division of the State Architect
Regional Office
1515 Clay St., Suite 1201
Oakland, CA 94612
p: 415-396-9500 f:

SCIENCE BUILDING
LOS MEDANOS COLLEGE

owner
Contra Costa Community College District

tBP project number : 20241.00
file name:
drawn by: checked by:
date: NOVEMBER 15, 2004

Rev:	date:	description:

drawing title:
ADDENDUM # 2
DRAWINGS

LMC SCIENCE 313-023-T12.01-0-00.00
drawing no.:
ATTACHMENT FOR T1-0

SHEET NOTES

1. 3–4" CONDUITS (PROVIDED AND INSTALLED BY ELECTRICAL CONTRACTOR) FROM BDF/IDF 1.0 (ROOM 151) TO COMMUNICATIONS VAULT CV–4. REFER TO DRAWING T3–1 FOR LOCATIONS OF CONDUITS IN ROOM 151.
2. COORDINATE LOCATION OF TELECOMMUNICATION OUTLET IN MECHANICAL CHILLER PUMP BUILDING WITH MECHANICAL.
3. PROVIDE AND INSTALL FIBER OPTIC CABLING BETWEEN CDF IN ADMINISTRATION BUILDING AND BDF/IDF 1.0 (ROOM 151) IN SCIENCE BUILDING.
4. PROVIDE AND INSTALL (12) 1" INNERDUCTS IN DUCTS 16–18 FROM SCIENCE BUILDING TO CV–4. REFER TO SPECIFICATION SECTION 16745.
5. PROVIDE AND INSTALL THREE 4" QUADPLEX DUCT PLUGS IN DUCTS 16–18. REFER TO SPECIFICATION SECTION 16705.
6. REFER TO DRAWING T4–3 FOR FIBER OPTIC SHELF AND RACK ELEVATIONS.
7. REFER TO DRAWING T4–4 FOR FIBER OPTIC SHELF AND RACK ELEVATIONS.
8. PROVIDE A 30 FOOT SERVICE LOOP (MINIMUM) OF EACH FIBER OPTIC CABLE SHEATH, TYPICAL. IN BDF AND IDF ROOMS, THE SERVICE LOOP SHALL BE WALL MOUNTED BELOW THE LOWER LEVEL OF STEEL WIRE CABLE TRAY USING 'D'–RINGS.
9. THE FIBER OPTIC CABLE SHEATH(S) SHALL BE LABELED WITHIN 12 INCHES OF THE FIBER TERMINATION SHELF. FIBER OPTIC CABLE LABELS SHALL CONSIST OF STAINLESS STEEL TAG TIE WRAPPED AT BOTH ENDS TO THE CABLE SHEATH AND STAMPED WITH THE FIBER OPTIC CABLE ID NUMBER AS SHOWN IN THE DRAWINGS AND SPECIFICATION SECTION 16735.
10. PLACE CABLE RACKING TO SECURE CABLES AND SERVICE LOOPS.
11. PLACE CABLE RACK HOOKS AND SECURE EACH CABLE USING TIE WRAPS.

NOTE: RFI 494 PROVIDED DIRECTION ON TELECOM CONNECTION FROM CHILLER BUILDING TO WOMEN'S LOCKER ROOM


GENERAL NOTES

A. REFER TO 'SITE PREPARATION' DRAWING SET (DSA #01–105751) FOR VAULT AND DUCT BANK DETAILS.

B. EXISTING DUCT BANK SECTIONS SHOWN FOR REFERENCE ONLY.


C. ALL MULTIMODE FIBER OPTIC CABLE STRANDS SHALL BE TESTED IN TWO DIRECTIONS AT 850 nm AND 1300 nm WITH AN ATTENUATION METER, LIGHT SOURCE AND AN OTDR. SEE SPECIFICATION SECTION 16742 FOR LOSS BUDGET CALCULATIONS AND TESTING REQUIREMENTS.

D. ALL SINGLE MODE FIBER OPTIC CABLE STRANDS SHALL BE TESTED IN TWO DIRECTIONS AT 1310 nm AND 1550 nm WITH AN ATTENUATION METER, LIGHT SOURCE AND AN OTDR. SEE SPECIFICATION SECTION 16742 FOR LOSS BUDGET CALCULATIONS AND TESTING REQUIREMENTS.

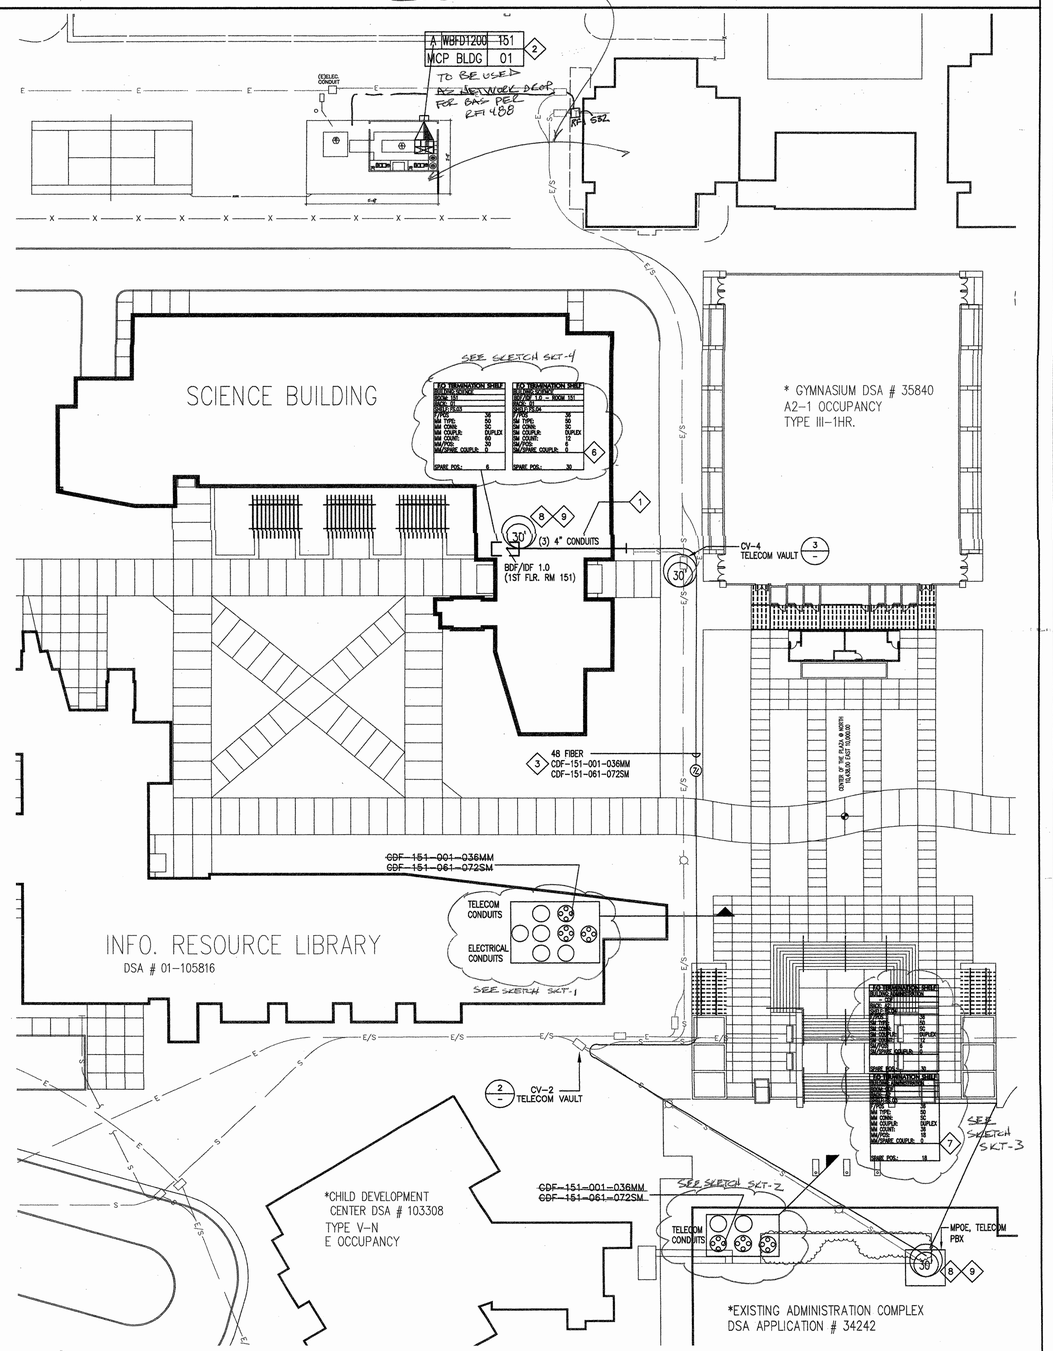


ADMINISTRATION BLDG. CDF TO SCIENCE BLDG. BDF/IDF OSP FIBER OPTIC CABLES | 1
SCALE: 1"=30'
0 15' 30' 60'
GRAPHIC SCALE: 1" = 30'

N
PROJECT NORTH

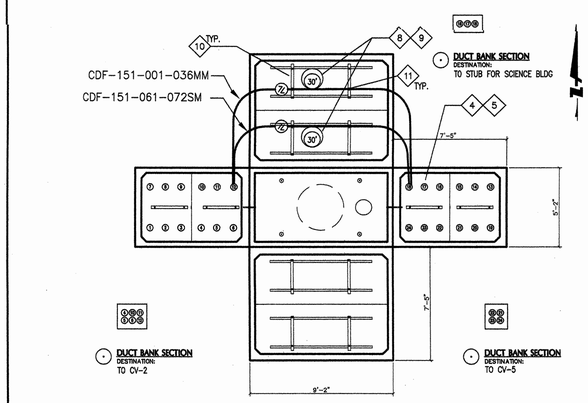

CV-4 BUTTERFLY DIAGRAM | 3
SCALE: 1/4"=1'-0"

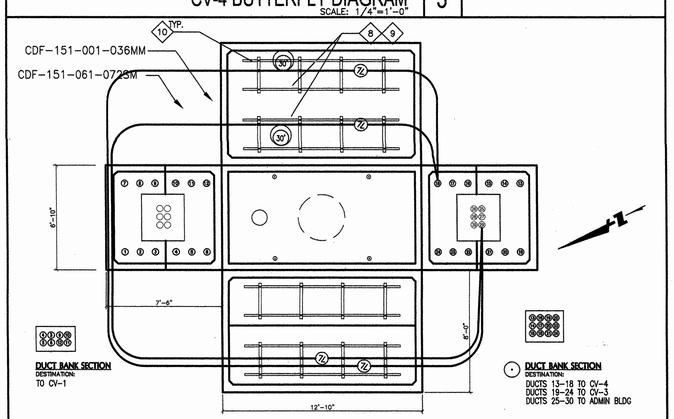

CV-2 BUTTERFLY DIAGRAM | 2
SCALE: 1/4"=1'-0"

tBP
architecture
planning
interiors
management
LICENSED ARCHITECT ROBERT A. STEIN No. C-9885 STATE OF CALIFORNIA
tBP/Architecture
1000 Burnett Avenue, Suite 140
Concord, CA 94520
p. 925.246.6419 f. 925.246.6495

INFRASTRUCTURE DESIGN ASSOCIATES
1440 Broadway
Suite 304
Oakland, CA. 94612
EXPIRES 12/31/06
Regis. No. 06606
SIGNATURE
consultant

name
address
city, state, zip
ph: fx:


CERTIFICATION STAMP
DIV. OF THE STATE ARCHITECT
OFFICE OF REGULATION SERVICES
APP. NO. 01-105751
DATE 11-15-05


SCIENCE BUILDING
LOS MEDANOS COLLEGE
Contra Costa Community College District
owner


tBP project number: 20247.00
file name:
drawn by: checked by:
date: NOVEMBER 15, 2004


drawing title: TELECOMMUNICATIONS FIBER OPTIC OSP CABLES
building no:
LMC SCIENCE 313-023-T12.01-0-00.00
drawing no: T1-0
drawing of


Z:\Los Medanos College\Science Building\VBD Set\Vacad\T1-0.dwg 11-08-04 1P:37:20 AM cmendoza

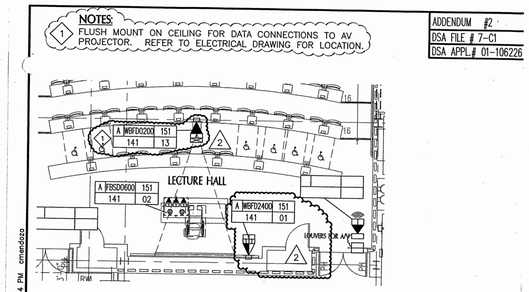

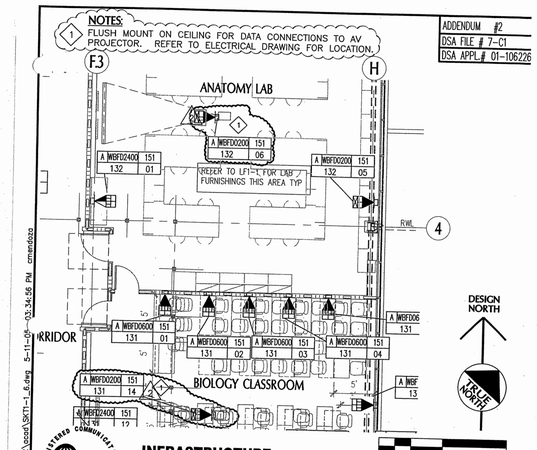

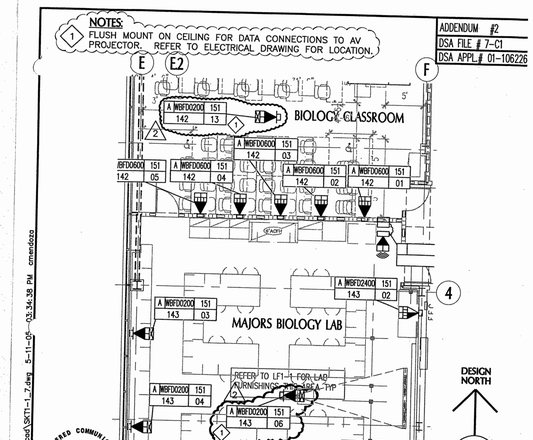

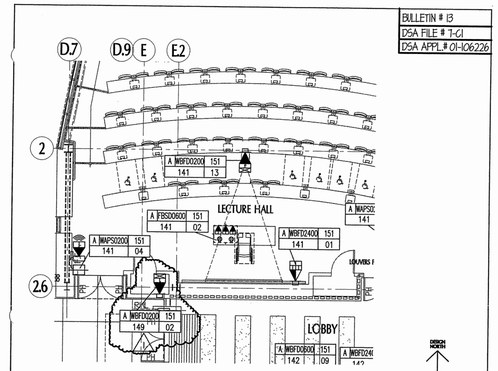

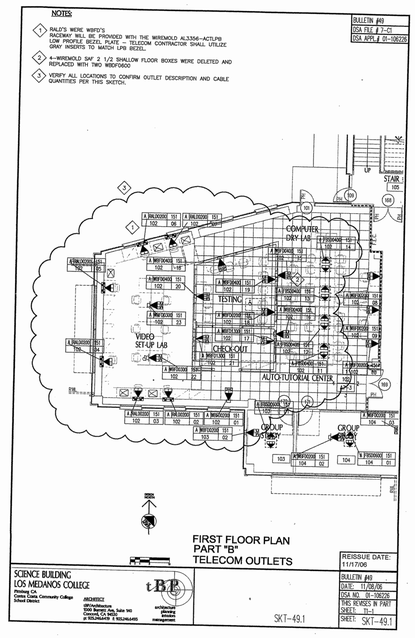

tBP
architecture
planning
interiors
management
tBP/Architecture
1000 Burnett Avenue, Suite 140
Concord, CA 94520
p: 925.246.6419 f: 925.246.6495
architect
consultant
IDENTIFICATION STAMP
DIV. OF THE STATE ARCHITECT
OFFICE OF REGULATION SERVICES
APP. NO. 01-106226
AC. FLS SS
DATE
FILE No. 7-C1
Division of the State Architect
Regional Office
1515 Clay St., Suite 1201
Oakland, CA 94612
p: 415-396-9500 f:
agency

SCIENCE BUILDING
LOS MEDANOS COLLEGE

Contra Costa Community College District

owner

tBP project number : 20241.00

file name:


drawn by: checked by:


date: NOVEMBER 15, 2004

Rev:	date:	description:

drawing title:
ADDENDUM #2 DRAWINGS
BULLETIN 13 & 49 DRAWINGS

LMC SCIENCE 313-023-112.01-0-00.00
drawing no:
ATTACHMENT FOR T1-1

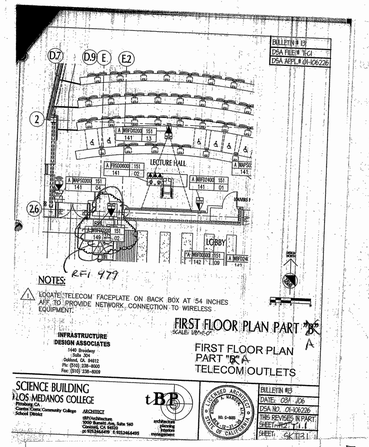

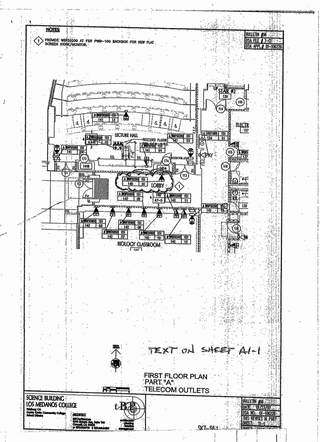

S. J. AMOROSO
Request For Information/Clarification

DSA FILE NO. 7-C1
DSA APPL. No. 01-106226

To: IBP/Infrastructure, 1000 Burnett Ave, Suite 140, Concord, CA 94520
Attn: Celia Chiang, Tom Beckett
Fax: 925-246-6495
Subj.: Data Outlet Added by Bulletin 13

Project: LOS MEDANOS COLLEGE SCIENCE BUILDING, Contra Costa Community College District
tBP p/n: 20247.00

RFI No: **479**
Subcontractor RFI: EWS 69

Reference (dwg, spec.): SK13.1

Reply Requested By: 2/12/07

INFORMATION REQUESTED: Date: 2/5/07

Please note the attached Edward Scott Electric RFI No.69 regarding the data outlet added by Bulletin No. 13 in the Lecture Hall Closet. Please advise.

SUGGESTED SOLUTION:
Cost Impact: ☐ Schedule Impact: ☐ days By: Justin Warren

RESPONSE: DATE:

The outlet should be labeled as room #141 rather than 149.
Outlet # should be the last # in room 141.

Jim Weaver / tBP Architecture
David Buza / I.D.A.

2/21/07

RFI # 000
Page 1

EDWARD W. SCOTT ELECTRIC CO., INC.
435 HARRIET STREET
San Francisco, CA 94103-4914
Phone: (415) 626-0701 Fax: (415) 626-2837

REQUEST FOR INFORMATION

LMC
PROJECT: SCIENCE BLDG. R.F.I.# 69 R.F.I. Date 2/16/07
JOB: 2421 ACTUAL REPLY DATE

TO: MARK DELGADO
DEPT: EMOROSO CONST.
REF.DWG: SK13.1
LOCATION: LECTURE HALL RM 141

POTENTIAL COST IMPACT
___ COST ___ SCHEDULE
___ OTHER ___ LABOR
___ NO IMPACT ___ MATERIAL

INFORMATION REQUESTED: THE DATA OUTLET ADDED BY BULL. 13 IN THE LECTURE HALL RM 141. CLOSET IS LABELED AS RM 149. IS THIS THE INTENT.


REPLY REQUIRED BY: ASAP SIGNED:
NOTE: IF NO REPLY IS RECEIVED BY US BY THE ABOVE NOTED DATE, A TIME EXTENSION WILL BE REQUIRED WITH POSSIBLE COST IMPACTS.


RESPONSE:


DATED: SIGNED:


INDUSTRIAL, COMMERCIAL WIRING & DESIGN
STATE CONTRACTOR LICENSE NO. 190426


COORDINATE LOCATION WITH OWNERS REPRESENTATIVE IN CEILING.

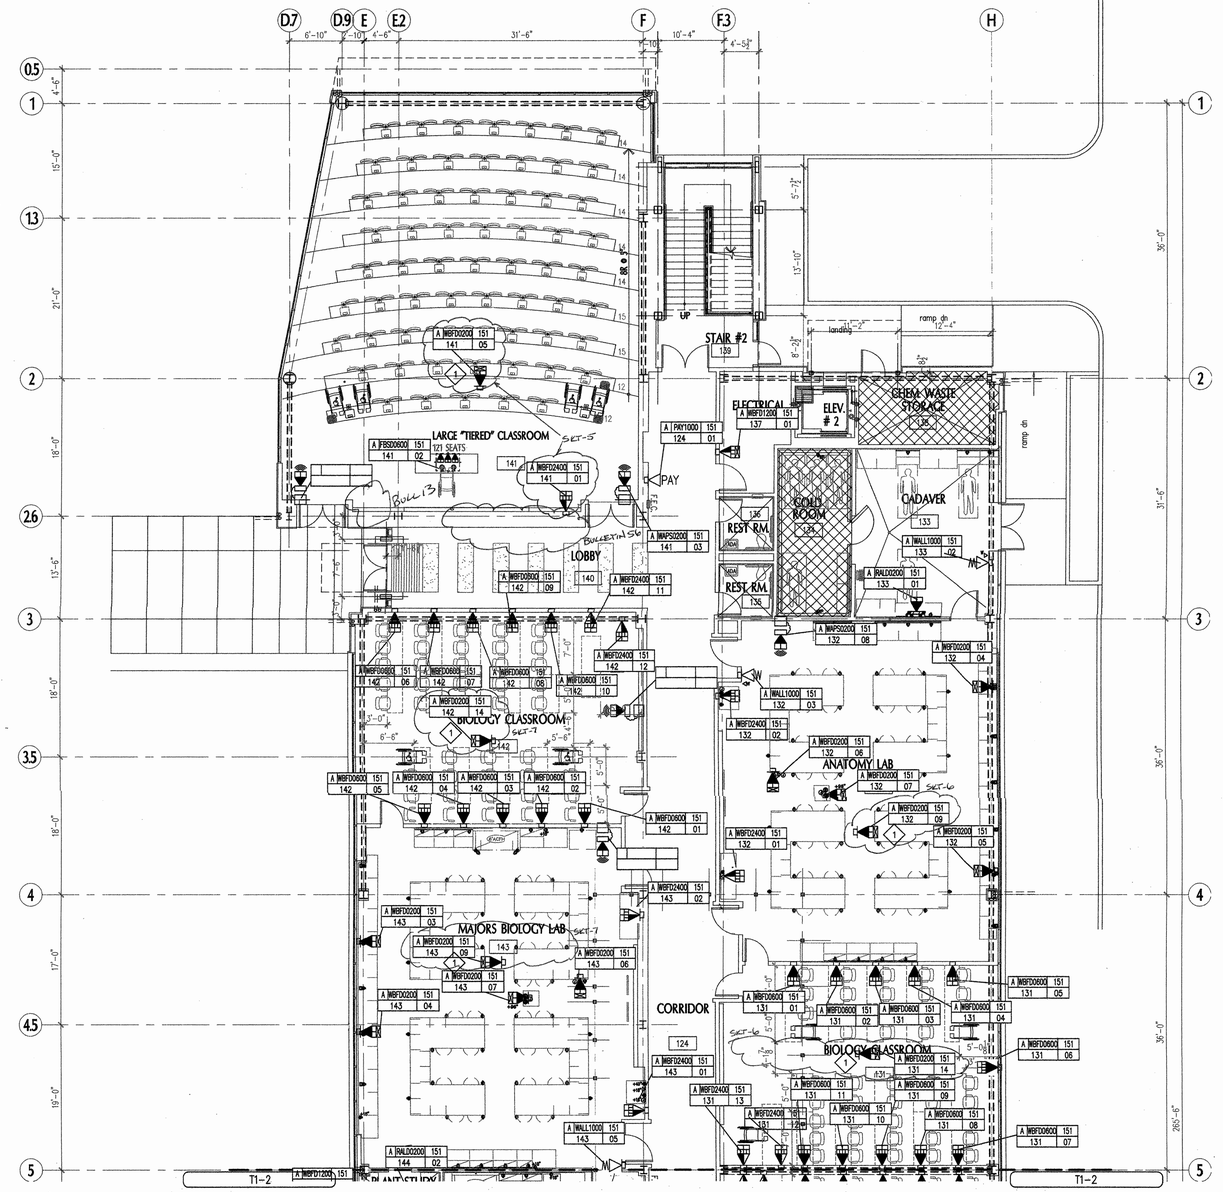

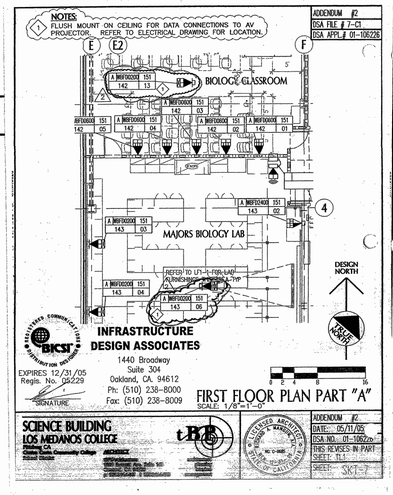

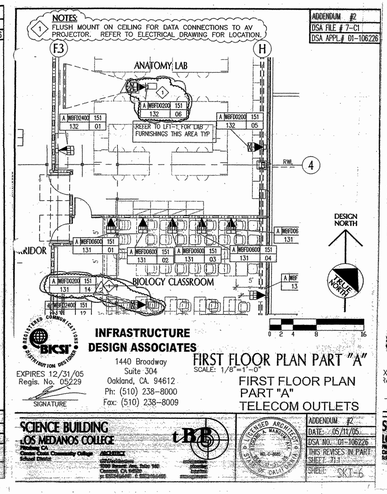


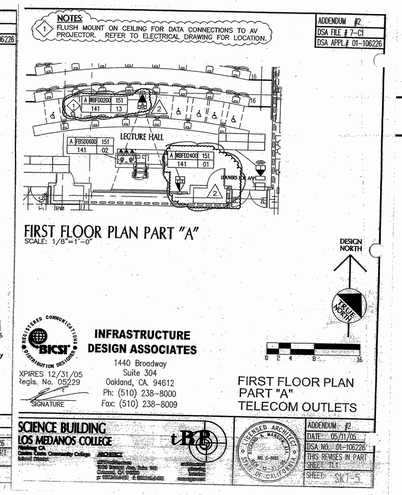

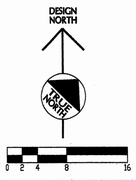

FIRST FLOOR PLAN PART "A" SCALE: 1/8"=1'-0"

1 KEY PLAN

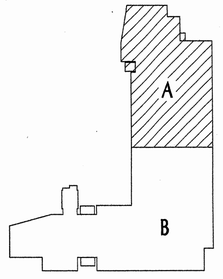

tBP
architecture
planning
interiors
management

tBP/Architecture
1000 Burnett Avenue, Suite 140
Concord, CA 94520
p: 925.246.6419 f: 925.246.6495

LICENSED ARCHITECT ROBERT W. KENNEDY R.A. No. C-9888 STATE OF CALIFORNIA

INFRASTRUCTURE DESIGN ASSOCIATES
1440 Broadway
Suite 304
Oakland, CA 94612
EXPIRES: 12/31/06
Regis. No.: 08606
SIGNATURE
consultant

name
address
city, state, zip
ph: fx:

CERTIFICATION STAMP
DIV. OF THE STATE ARCHITECT
OFFICE OF REGULATION SERVICES
DATE 11-15-05

SCIENCE BUILDING
LOS MEDANOS COLLEGE

Contra Costa Community College District

owner


tBP project number : 20247.00
file name:
drawn by: checked by:
date: NOVEMBER 15, 2004

1/8"=1'-0"

drawing title: building no:
FIRST FLOOR PLAN
PART "A"
TELECOM OUTLETS

LMC SCIENCE 313-023-112.01-0-00.00
drawing no:
T1-1
drawing of

S:\Los Medanos College\Science Building\Final DSA\acad\T1-1.dwg 12-13-04 09:09:55 AM cmendoza

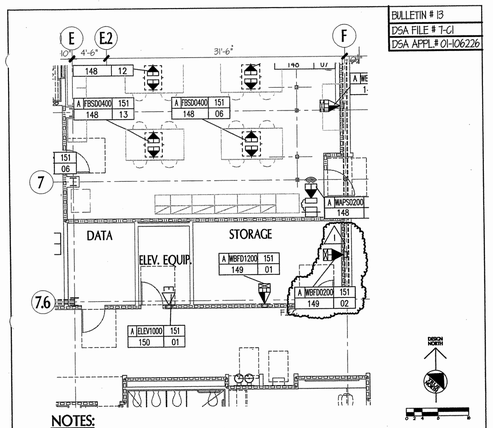

BULLETIN # 13
DSA FILE # 7-C1
DSA APPL # 01-106226

NOTES:

1. LOCATE TELECOM FACEPLATE ON BACK BOX AT 54 INCHES AFF TO PROVIDE NETWORK CONNECTION TO WIRELESS EQUIPMENT.

FIRST FLOOR PLAN PART "B"
SCALE: 1/8"=1'-0"

FIRST FLOOR PLAN
PART "B"
TELECOM OUTLETS

INFRASTRUCTURE DESIGN ASSOCIATES
1440 Broadway
Suite 304
Oakland, CA. 94612
Ph: (510) 238-8000
Fax: (510) 238-8009


SCIENCE BUILDING
LOS MEDANOS COLLEGE
Pittsburg CA
Contra Costa Community College
School District

ARCHITECT
tBP/Architecture
1000 Burnett Ave, Suite 140
Concord, CA 94520
p: 925.246.6419 f: 925.246.6495

architecture planning interiors management

LICENSED ARCHITECT RICHARD A. MANSON NO. C-8685 STATE OF CALIFORNIA

BULLETIN #13	
DATE:	03/06
DSA NO.	01-106226
THIS REVISES IN PART	
SHEET:	T1.2
SHEET:	SKT13.2

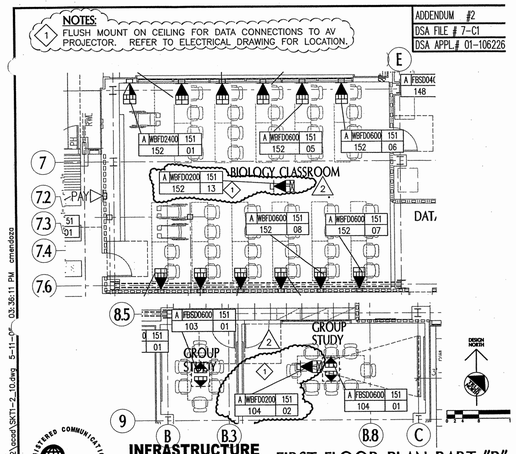

ADDENDUM #2
DSA FILE # 7-C1
DSA APPL # 01-106226

NOTES:

1. FLUSH MOUNT ON CEILING FOR DATA CONNECTIONS TO AV PROJECTOR. REFER TO ELECTRICAL DRAWING FOR LOCATION.

INFRASTRUCTURE DESIGN ASSOCIATES
1440 Broadway
Suite 304
Oakland, CA. 94612
Ph: (510) 238-8000
Fax: (510) 238-8009

FIRST FLOOR PLAN PART "B"
SCALE: 1/8"=1'-0"

FIRST FLOOR PLAN
PART "B"
TELECOM OUTLETS

EXPIRES 12/31/05
Regis. No. 05229
SIGNATURE


SCIENCE BUILDING
LOS MEDANOS COLLEGE
Pittsburg CA
Contra Costa Community College
School District

ARCHITECT
tBP/Architecture
1000 Burnett Ave, Suite 140
Concord, CA 94520
p: 925.246.6419 f: 925.246.6495

architecture planning interiors management

LICENSED ARCHITECT RICHARD A. MANSON NO. C-8685 STATE OF CALIFORNIA

ADDENDUM	#2
DATE:	05/11/05
DSA NO.	01-106226
THIS REVISES IN PART	
SHEET:	T1.2
SHEET:	SKT-10

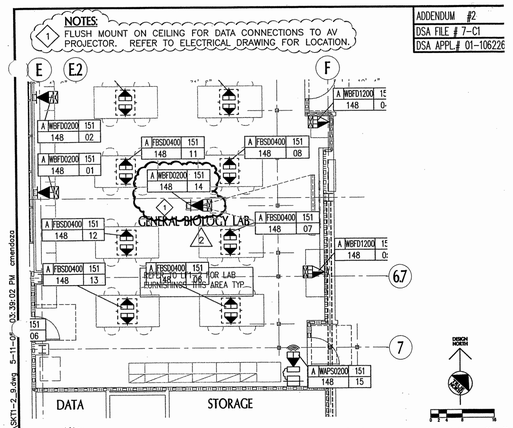

ADDENDUM #2
DSA FILE # 7-C1
DSA APPL # 01-106226

NOTES:

1. FLUSH MOUNT ON CEILING FOR DATA CONNECTIONS TO AV PROJECTOR. REFER TO ELECTRICAL DRAWING FOR LOCATION.

INFRASTRUCTURE DESIGN ASSOCIATES
1440 Broadway
Suite 304
Oakland, CA. 94612
Ph: (510) 238-8000
Fax: (510) 238-8009

FIRST FLOOR PLAN PART "B"
SCALE: 1/8"=1'-0"

FIRST FLOOR PLAN
PART "B"
TELECOM OUTLETS

EXPIRES 12/31/05
Regis. No. 05229
SIGNATURE


SCIENCE BUILDING
LOS MEDANOS COLLEGE
Pittsburg CA
Contra Costa Community College
School District

ARCHITECT
tBP/Architecture
1000 Burnett Ave, Suite 140
Concord, CA 94520
p: 925.246.6419 f: 925.246.6495

architecture planning interiors management

LICENSED ARCHITECT RICHARD A. MANSON NO. C-8685 STATE OF CALIFORNIA

ADDENDUM	#2
DATE:	05/11/05
DSA NO.	01-106226
THIS REVISES IN PART	
SHEET:	T1.2
SHEET:	SKT-9

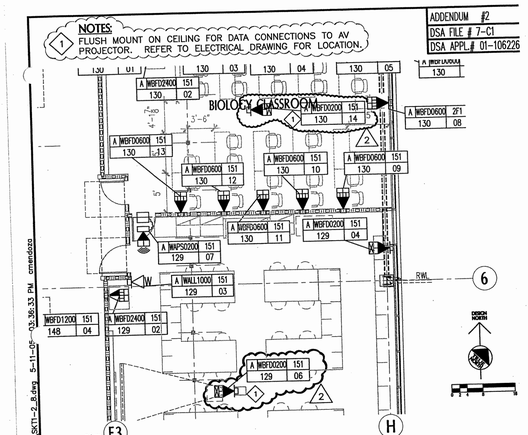

ADDENDUM #2
DSA FILE # 7-C1
DSA APPL # 01-106226

NOTES:

1. FLUSH MOUNT ON CEILING FOR DATA CONNECTIONS TO AV PROJECTOR. REFER TO ELECTRICAL DRAWING FOR LOCATION.

INFRASTRUCTURE DESIGN ASSOCIATES
1440 Broadway
Suite 304
Oakland, CA. 94612
Ph: (510) 238-8000
Fax: (510) 238-8009

FIRST FLOOR PLAN PART "B"
SCALE: 1/8"=1'-0"

FIRST FLOOR PLAN
PART "B"
TELECOM OUTLETS

EXPIRES 12/31/05
Regis. No. 05229
SIGNATURE

SCIENCE BUILDING
LOS MEDANOS COLLEGE
Pittsburg CA
Contra Costa Community College
School District

ARCHITECT
tBP/Architecture
1000 Burnett Ave, Suite 140
Concord, CA 94520
p: 925.246.6419 f: 925.246.6495

architecture planning interiors management

LICENSED ARCHITECT RICHARD A. MANSON NO. C-8685 STATE OF CALIFORNIA

ADDENDUM	#2
DATE:	05/11/05
DSA NO.	01-106226
THIS REVISES IN PART	
SHEET:	T1.2
SHEET:	SKT-8

BULLETIN #15A
DSA FILE # 7-C1
DSA APPL # 01-106226

NOTES:

GENERAL THIS BULLETIN RELOCATES CABLES AND RECONFIGURES TERMINATION COVERPLATES AND FACEPLATES IN ROOM 102 COMPUTER DRY LAB, TESTING, CHECK OUT AND THE VIDEO SET UP LAB BUT DOES NOT ADD ANY CABLES. TWO FLOOR WIREMOLD SAF 2-1/2 FLOOR BOX ENCLOSURES ARE DELETED AND THE CABLES REDISTRIBUTED TO OTHER FACEPLATES IN ROOM 102.

1. RELOCATE THE TWO FBSD0600 WIREMOLD SAF 2-1/2 FLOOR BOXES AND TERMINATIONS FROM THE TESTING AREA TO COMPUTER DRY LAB AREA AND CONFIGURE AS FBSD0300 WITH (3) DATA CABLES TERMINATED IN EACH FLOOR BOX COVER PLATE NUMBERS 9 AND 16 ON SKT-15A.1.

2. IN TESTING PLACE (4) WBFS0200 WITH (2) DATA CABLES AT EACH SINGLE GANG WALL PLATE. THE OWNER IS PROVIDING KI GENIUS WALL PANELS AROUND THE TESTING AREA. THE WALL PANELS WILL BE PROVIDED WITH SINGLE GANG BACK BOXES FOR THESE FOUR FACEPLATES. CABLES SHALL BE ROUTED INTO THE BASE OF THE WALL PANELS FROM THE ACCESS FLOOR. CABLES SHALL ROUTE HORIZONTALLY IN THE BASE OF THE WALL PANELS AND ROUTE VERTICALLY UP TO EACH BACK BOX. FACEPLATES 20, 21, 22, AND 23 ON SKT-15A.1.

3. IN CHECK OUT PLACE (1) WBFS0400 WITH (1) TEL CABLE (3) DATA CABLES AT ONE SINGLE GANG WALL PLATE. THE OWNER IS PROVIDING KI GENIUS WALL PANELS AROUND THE CHECK OUT AREA. THE WALL PANEL WILL BE PROVIDED WITH SINGLE GANG BACK BOX FOR THIS FACEPLATE. CABLES SHALL BE ROUTED INTO THE BASE OF THE WALL PANEL FROM THE ACCESS FLOOR. CABLES SHALL ROUTE HORIZONTALLY IN THE BASE OF THE WALL PANEL AND ROUTE VERTICALLY UP TO THE BACK BOX. FACEPLATE 19 ON SKT-15A.1.

4. IN VIDEO SET UP CHANGE THE FBSD0600 TO (2) WBFD0300 FACEPLATES. THESES DOUBLE GANG FACPELATES WIL BE LOCATED IN MONUMENTS ON THE WORK SURFACE. CABLE WILL ROUTE INTO A 12 INCH WIDE CHASE IN THE CASEWORK AT THIS LOCATION FROM CONDUIT STUBS IN THE FLOOR AND ROUTE INTO THE TWO DOUBLE GANG MONUMENTS THAT WIL BE MOUNTED ON THE WORK SURACE. TELECOM CONTRACTOR TO PROVIDE AND INSTALL THE MONUMENT. MONUMENT SHALL BE A WATERSAVER FAUCET COMPANY WITH POLISHED ALUMINUM FINISH E600WS-PB. PLACE A BLANK POLISHED ALUMINUM FACEPLATE ON THE BACK DOUBLE GANG OPENING. FACEPLATE 24 AND 25 ON SKT-15A.1.

INFRASTRUCTURE DESIGN ASSOCIATES
1440 Broadway
Suite 304
Oakland, CA. 94612
Ph: (510) 238-8000
Fax: (510) 238-8009


SCIENCE BUILDING
LOS MEDANOS COLLEGE
Pittsburg CA
Contra Costa Community College
School District

ARCHITECT
tBP/Architecture
1000 Burnett Ave, Suite 140
Concord, CA 94520
p: 925.246.6419 f: 925.246.6495

architecture planning interiors management

LICENSED ARCHITECT RICHARD A. MANSON NO. C-8685 STATE OF CALIFORNIA

BULLETIN #15A	
DATE:	03/15/06
DSA NO.	01-106226
THIS REVISES IN PART	
SHEET:	T1-2
SHEET:	SKT15A.2

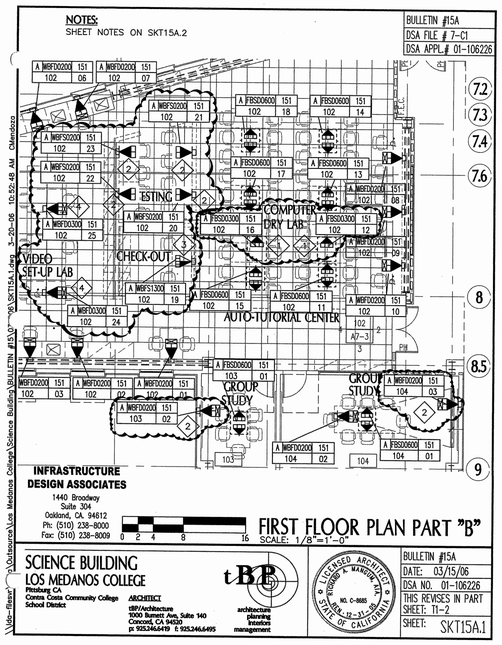

BULLETIN #15A
DSA FILE # 7-C1
DSA APPL # 01-106226

NOTES:

SHEET NOTES ON SKT15A.2

INFRASTRUCTURE DESIGN ASSOCIATES
1440 Broadway
Suite 304
Oakland, CA. 94612
Ph: (510) 238-8000
Fax: (510) 238-8009

FIRST FLOOR PLAN PART "B"
SCALE: 1/8"=1'-0"

SCIENCE BUILDING
LOS MEDANOS COLLEGE
Pittsburg CA
Contra Costa Community College
School District

ARCHITECT
tBP/Architecture
1000 Burnett Ave, Suite 140
Concord, CA 94520
p: 925.246.6419 f: 925.246.6495

architecture planning interiors management

LICENSED ARCHITECT RICHARD A. MANSON NO. C-8685 STATE OF CALIFORNIA

BULLETIN #15A	
DATE:	03/15/06
DSA NO.	01-106226
THIS REVISES IN PART	
SHEET:	T1-2
SHEET:	SKT15A.1

tBP
architecture
planning
interiors
management

LICENSED ARCHITECT RICHARD A. MANSON NO. C-8685 STATE OF CALIFORNIA

tBP/Architecture
1000 Burnett Avenue, Suite 140
Concord, CA 94520
p: 925.246.6419 f: 925.246.6495

architect

consultant

IDENTIFICATION STAMP
DIVISION OF THE STATE ARCHITECT
OFFICE OF REGULATION SERVICES
APP. NO. 01-106226
AC. ___ FLS. ___ SS. ___
DATE ___
REE No. 7-C1

Division of the State Architect
Regional Office
1515 Clay St., Suite 1201
Oakland, CA 94612
p. 415-396-9500 f.

agency

SCIENCE BUILDING
LOS MEDANOS COLLEGE

Contra Costa Community College District

owner

tBP project number : 20241.00

file name:

drawn by: checked by:

date: NOVEMBER 15, 2004

Rev:	date:	description:

drawing title:
ADDENDUM #2 DRAWINGS
BULLETIN #13 & 15A


LMC SCIENCE 313-023-112.01-0-00.00

drawing no:
ATTACHMENT TO T1-2

NOTES:

1. RELOCATE WBFD1200 FACEPLATE FROM SOUTH SIDE OF OFFICES TO FRAMED PARTITIONS BETWEEN OFFICES.

BULLETIN # 18
DSA FILE # 7-C1
DSA APPL.# 01-106226

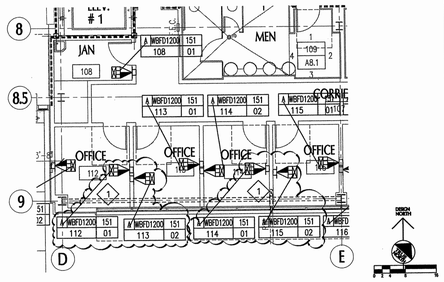

INFRASTRUCTURE DESIGN ASSOCIATES
1440 Broadway
Suite 304
Oakland, CA 94612
Ph: (510) 238-8000
Fax: (510) 238-8009

FIRST FLOOR PLAN
PART "B"
TELECOM OUTLETS

SCIENCE BUILDING
LOS MEDANOS COLLEGE
Pittsburg CA
Contra Costa Community College School District

ARCHITECT
tBP/Architecture
1000 Burnett Ave, Suite 140
Concord, CA 94520
p: 925.246.6419 f: 925.246.6495

architecture planning interiors management

LICENSED ARCHITECT RICHARD A. MANDIN JR. NO. C-8685 REN. 12-31-07 STATE OF CALIFORNIA

BULLETIN #18
DATE: 03/23/06
DSA NO. 01-106226
THIS REVISES IN PART
SHEET: T1-1
SHEET: SKT-18.1


\\Vdc-files\Outsource\Los Medanos College\Science Building\BULLETIN #18\A-SKT18.1.dwg 3-29-06 09:35:03 AM Olendosco

---

NOTES:

1. RELOCATE WBFD1200 FACEPLATE FROM SOUTH SIDE OF OFFICES TO FRAMED PARTITIONS BETWEEN OFFICES.

BULLETIN # 18
DSA FILE # 7-C1
DSA APPL.# 01-106226

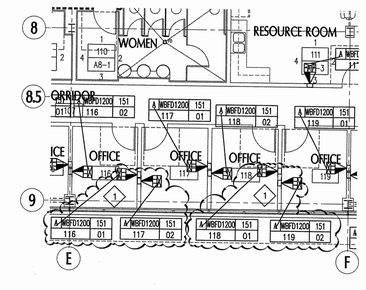

INFRASTRUCTURE DESIGN ASSOCIATES
1440 Broadway
Suite 304
Oakland, CA 94612
Ph: (510) 238-8000
Fax: (510) 238-8009

FIRST FLOOR PLAN
PART "B"
TELECOM OUTLETS

SCIENCE BUILDING
LOS MEDANOS COLLEGE
Pittsburg CA
Contra Costa Community College School District

ARCHITECT
tBP/Architecture
1000 Burnett Ave, Suite 140
Concord, CA 94520
p: 925.246.6419 f: 925.246.6495

architecture planning interiors management

LICENSED ARCHITECT RICHARD A. MANDIN JR. NO. C-8685 REN. 12-31-07 STATE OF CALIFORNIA

BULLETIN #18
DATE: 03/23/06
DSA NO. 01-106226
THIS REVISES IN PART
SHEET: T1-1
SHEET: SKT-18.2


\\Vdc-files\Outsource\Los Medanos College\Science Building\BULLETIN #18\A-SKT18.2.dwg 3-29-06 09:34:41 AM Olendosco

---

NOTES:

1. RELOCATE WBFD1200 FACEPLATE FROM SOUTH SIDE OF OFFICES TO FRAMED PARTITIONS BETWEEN OFFICES.

BULLETIN # 18
DSA FILE # 7-C1
DSA APPL.# 01-106226

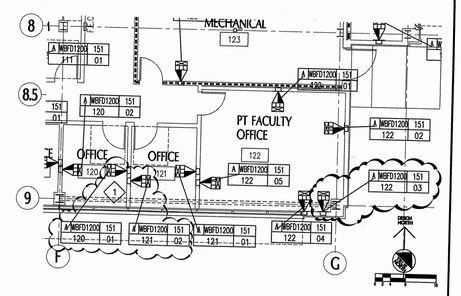

INFRASTRUCTURE DESIGN ASSOCIATES
1440 Broadway
Suite 304
Oakland, CA 94612
Ph: (510) 238-8000
Fax: (510) 238-8009

FIRST FLOOR PLAN
PART "B"
TELECOM OUTLETS

SCIENCE BUILDING
LOS MEDANOS COLLEGE
Pittsburg CA
Contra Costa Community College School District

ARCHITECT
tBP/Architecture
1000 Burnett Ave, Suite 140
Concord, CA 94520
p: 925.246.6419 f: 925.246.6495

architecture planning interiors management

LICENSED ARCHITECT RICHARD A. MANDIN JR. NO. C-8685 REN. 12-31-07 STATE OF CALIFORNIA

BULLETIN #18
DATE: 03/23/06
DSA NO. 01-106226
THIS REVISES IN PART
SHEET: T1-1
SHEET: SKT-18.3


\\Vdc-files\Outsource\Los Medanos College\Science Building\BULLETIN #18\A-SKT18.3.dwg 3-29-06 11:25:59 AM Olendosco

---

NOTES:

1. RELOCATE WBFD1200 FACEPLATE FROM SOUTH SIDE OF OFFICES TO FRAMED PARTITIONS BETWEEN OFFICES.

BULLETIN # 18
DSA FILE # 7-C1
DSA APPL.# 01-106226

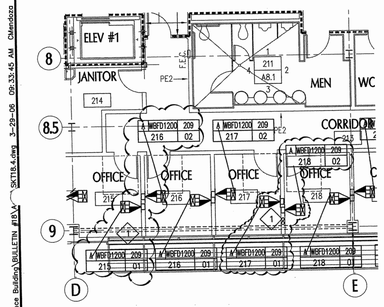

INFRASTRUCTURE DESIGN ASSOCIATES
1440 Broadway
Suite 304
Oakland, CA 94612
Ph: (510) 238-8000
Fax: (510) 238-8009

SECOND FLOOR PLAN
PART "B"
TELECOM OUTLETS

SCIENCE BUILDING
LOS MEDANOS COLLEGE
Pittsburg CA
Contra Costa Community College School District

ARCHITECT
tBP/Architecture
1000 Burnett Ave, Suite 140
Concord, CA 94520
p: 925.246.6419 f: 925.246.6495

architecture planning interiors management

LICENSED ARCHITECT RICHARD A. MANDIN JR. NO. C-8685 REN. 12-31-07 STATE OF CALIFORNIA

BULLETIN #18
DATE: 03/23/06
DSA NO. 01-106226
THIS REVISES IN PART
SHEET: T1-4
SHEET: SKT-18.4


\\Vdc-files\Outsource\Los Medanos College\Science Building\BULLETIN #18\A-SKT18.4.dwg 3-29-06 09:33:45 AM Olendosco

---

NOTES:

1. RELOCATE WBFD1200 FACEPLATE FROM SOUTH SIDE OF OFFICES TO FRAMED PARTITIONS BETWEEN OFFICES.

BULLETIN # 18
DSA FILE # 7-C1
DSA APPL.# 01-106226

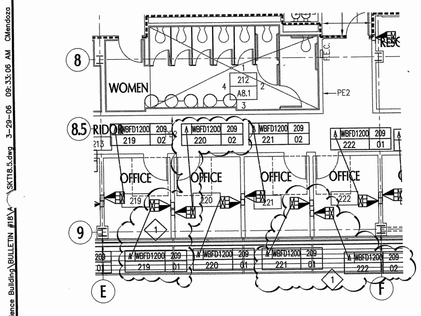

INFRASTRUCTURE DESIGN ASSOCIATES
1440 Broadway
Suite 304
Oakland, CA 94612
Ph: (510) 238-8000
Fax: (510) 238-8009

SECOND FLOOR PLAN
PART "B"
TELECOM OUTLETS

SCIENCE BUILDING
LOS MEDANOS COLLEGE
Pittsburg CA
Contra Costa Community College School District

ARCHITECT
tBP/Architecture
1000 Burnett Ave, Suite 140
Concord, CA 94520
p: 925.246.6419 f: 925.246.6495

architecture planning interiors management

LICENSED ARCHITECT RICHARD A. MANDIN JR. NO. C-8685 REN. 12-31-07 STATE OF CALIFORNIA

BULLETIN #18
DATE: 03/23/06
DSA NO. 01-106226
THIS REVISES IN PART
SHEET: T1-4
SHEET: SKT-18.5


\\Vdc-files\Outsource\Los Medanos College\Science Building\BULLETIN #18\A-SKT18.5.dwg 3-29-06 09:33:06 AM Olendosco

---

NOTES:

1. RELOCATE WBFD1200 FACEPLATE FROM SOUTH SIDE OF OFFICES TO FRAMED PARTITIONS BETWEEN OFFICES.
2. REVISE FACEPLATE TO WBFD2400

BULLETIN # 18
DSA FILE # 7-C1
DSA APPL.# 01-106226

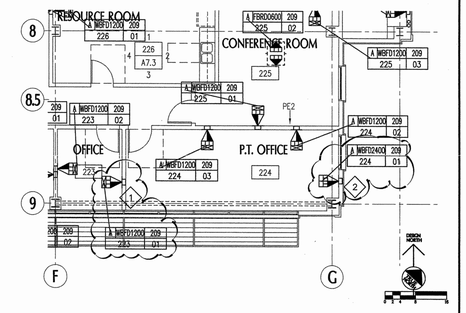

INFRASTRUCTURE DESIGN ASSOCIATES
1440 Broadway
Suite 304
Oakland, CA 94612
Ph: (510) 238-8000
Fax: (510) 238-8009

SECOND FLOOR PLAN
PART "A"
TELECOM OUTLETS

SCIENCE BUILDING
LOS MEDANOS COLLEGE
Pittsburg CA
Contra Costa Community College School District

ARCHITECT
tBP/Architecture
1000 Burnett Ave, Suite 140
Concord, CA 94520
p: 925.246.6419 f: 925.246.6495

architecture planning interiors management

LICENSED ARCHITECT RICHARD A. MANDIN JR. NO. C-8685 REN. 12-31-07 STATE OF CALIFORNIA

BULLETIN #18
DATE: 03/23/06
DSA NO. 01-106226
THIS REVISES IN PART
SHEET: T1-4
SHEET: SKT-18.6

\\Vdc-files\Outsource\Los Medanos College\Science Building\BULLETIN #18\A-SKT18.6.dwg 3-29-06 11:30:11 AM Olendosco

---

tBP
architecture
planning
interiors
management

LICENSED ARCHITECT RICHARD A. MANDIN JR. NO. C-8685 REN. 12-31-07 STATE OF CALIFORNIA

tBP/Architecture
1000 Burnett Avenue, Suite 140
Concord, CA 94520
p: 925.246.6419 f: 925.246.6495

architect

consultant

IDENTIFICATION STAMP
DIV. OF THE STATE ARCHITECT
OFFICE OF REGULATION SERVICES
APP. NO. 01-106226
AC. FLS. SS
DATE
FEE No. 7C1

Division of the State Architect
Regional Office
1515 Clay St., Suite 1201
Oakland, CA 94612
p: 415-396-9500 f:

agency

SCIENCE BUILDING
LOS MEDANOS COLLEGE

Contra Costa Community College District

owner

tBP project number : 20241.00

file name:


drawn by: checked by:

date: NOVEMBER 15, 2004


Rev:	date:	description:

drawing title:
BULLETIN # 18 DRAWINGS


LMC SCIENCE 313-023-T12.01-0-00.00
drawing no.:
ATTACHMENT TO T1-2

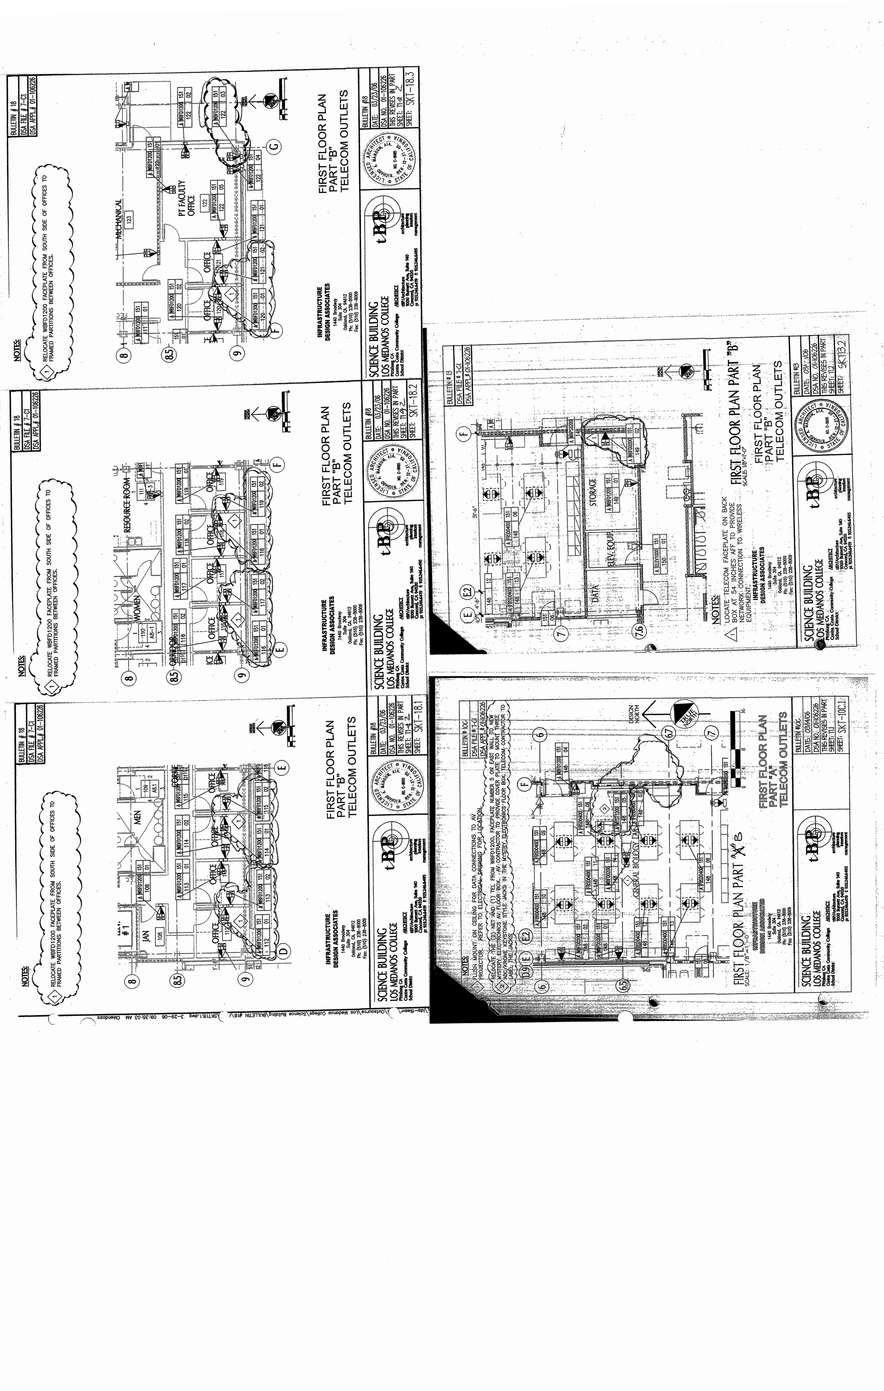

NOTES
RELOCATE WIRELESS FACEPLATE FROM SOUTH SIDE OF OFFICES TO FRAMED PARTITIONS BETWEEN OFFICES.
FIRST FLOOR PLAN PART "B" TELECOM OUTLETS
SCIENCE BUILDING
LOS MEDANOS COLLEGE
INFRASTRUCTURE DESIGN ASSOCIATES
tBP
BULLETIN #8
DATE: 6/14/06
DSA SBN: 106626
DSA APPL: 01-106626
SHEET: SKT-18.2
FIRST FLOOR PLAN PART "A"
TELECOM OUTLETS
FIRST FLOOR PLAN PART "B"
TELECOM OUTLETS
TEXT of SHEET A1.1
ARCHITECT
ARCHITECTURAL CONSULTING & DESIGN
STATE CONTRACTOR LICENSE NO. 510422
DSA FILE NO. 7-C1
DSA APPL. No. 01-106626
S.J. AMOROSO
Request For
Information Clarification
To: tBP/Architecture
1203 Kamel Ave, Suite 140
Alamo, CA 94507
Attn: Chris Chang, Tom Beckett
Fax: 932-346-8486
Date: 4/13/07
Project: LOS MEDANOS COLLEGE
SCIENCE BUILDING
2700 East Leland Road
Pittsburg, California
BP Job: 2004T.00
Subject: Telecom Outlet Label Numbers in Classroom 201
RFI No: 516
Reply Requested By: 4/20/07
INFORMATION REQUESTED:
Please note the attached SW Detail RFI No. 84 regarding duplicate data outlet label numbers in room 104, Tomas Martinez.
SUGGESTED SOLUTION:
Architect's Supplemental Instruction ☐ Bulletin Impact ☐ days By: Justin Hansen
RESPONSE:
Yes, Please change the referenced data outlet number to 2A.
Jim Weaver / tBP Architecture
Date: 4/16/07
4/16/07
RFI # 0090
Page 1
EDWARD W. SCOTT ELECTRIC CO., INC.
3347 Investment Blvd.
Hayward, CA 94545-3837
Phone: 510-785-4141 Fax: 510-785-3837
REQUEST FOR INFORMATION
PROJECT: SCIENCE BLDG. R.F.I. #84
TO: tBP/Architecture
SUBMITTED: 4/11/2007
INFORMATION REQUESTED:
SUGGESTED SOLUTION:
RESPONSE:
DATED: SIGNED:
RFI # 84
Los Medanos College
4CD Proj.# : L-565-B-23-SC
Science Building


◇1 COORDINATE LOCATION WITH OWNERS REPRESENTATIVE IN CEILING

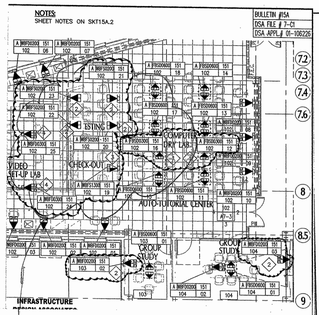



FIRST FLOOR PLAN PART "B"
SCALE: 1/8"=1'-0"

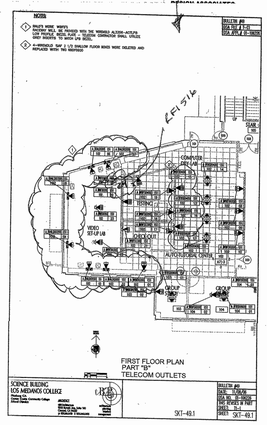

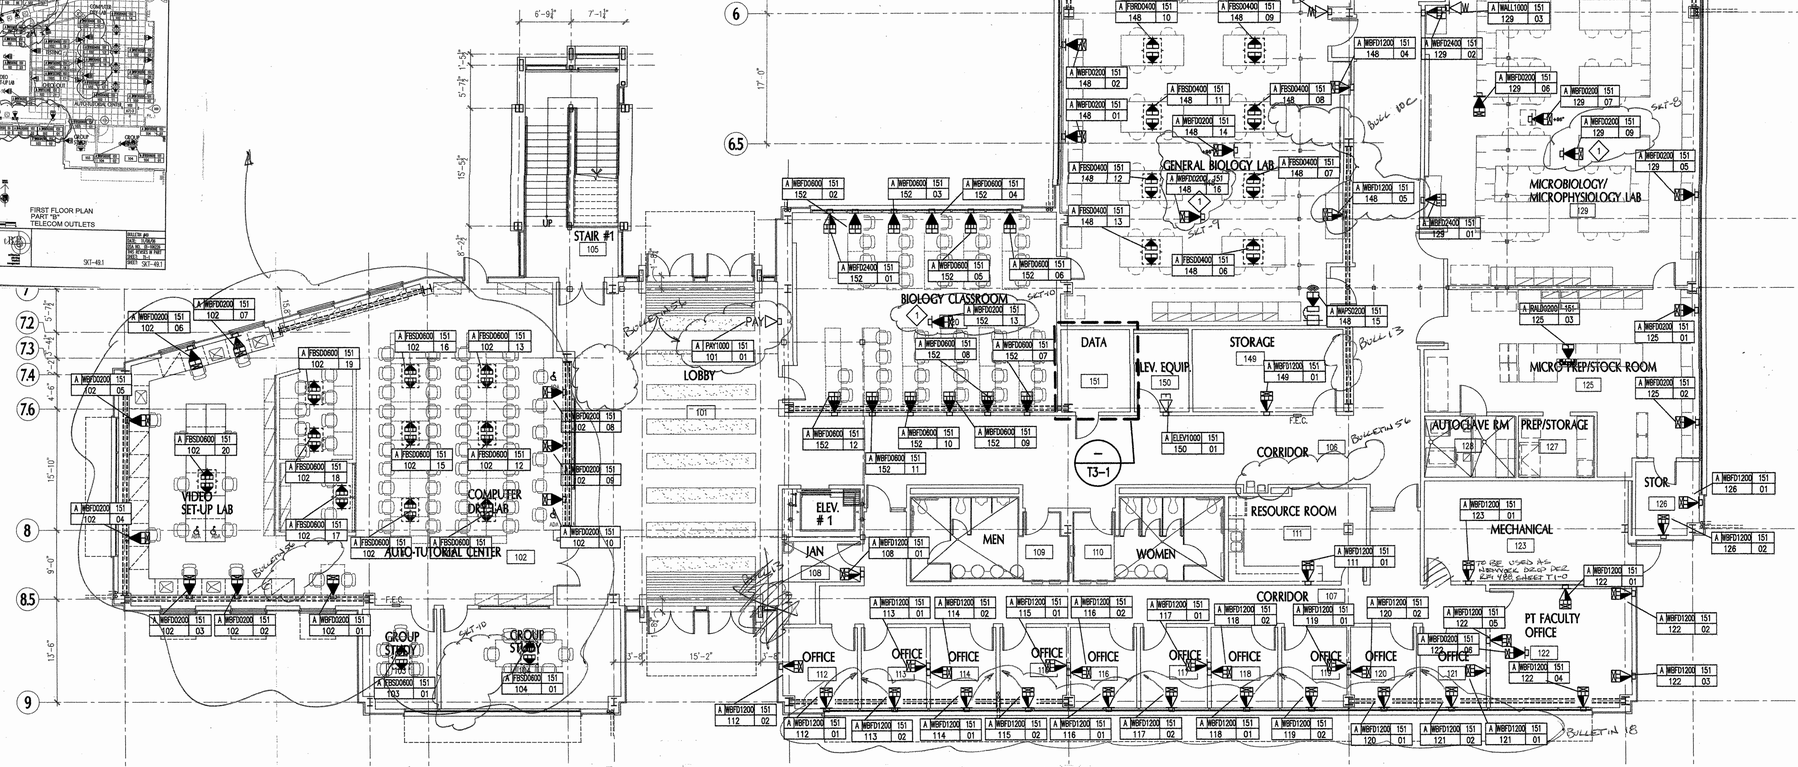

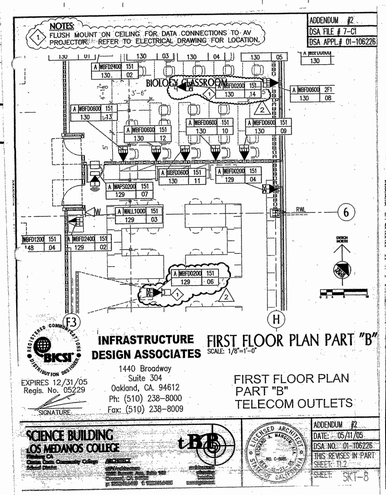


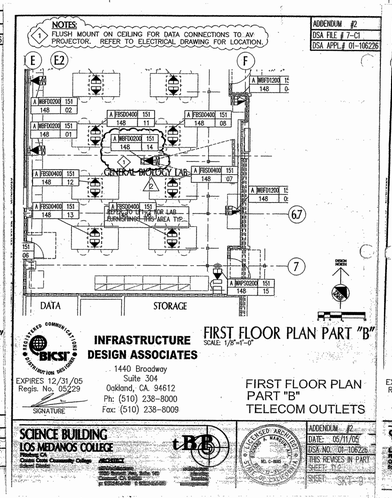

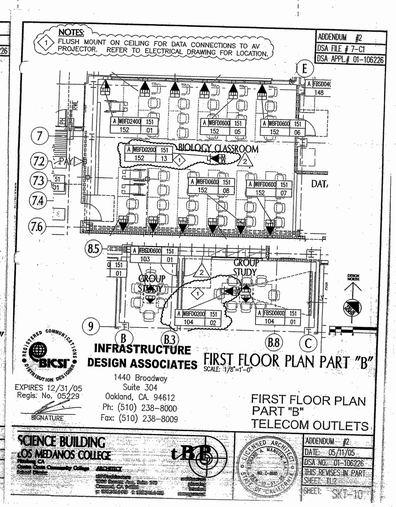

FIRST FLOOR PLAN PART "B"
SCALE: 1/8"=1'-0"

1 KEY PLAN

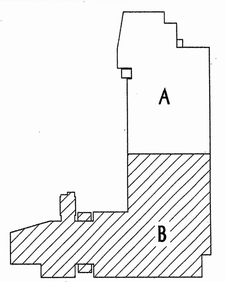

tBP architecture planning interiors management
tBP/Architecture
1000 Burnett Avenue, Suite 140
Concord, CA 94520
p: 925.246.6419 f: 925.246.6495
LICENSED ARCHITECT STATE OF CALIFORNIA
INFRASTRUCTURE DESIGN ASSOCIATES
1440 Broadway Suite 304 Oakland, CA. 94612
BICSI COMMUNICATIONS INFRASTRUCTURE DESIGNERS
EXPIRES 12/31/06
Regis. No. 06606
SIGNATURE
consultant
EXAMINATION STAMP
DSA-SS/CC OFFICE OF REGULATION SERVICES
APP. NO. 01-106226
DATE 1-13-05
name
address
city, state, zip
ph: fx:


SCIENCE BUILDING
LOS MEDANOS COLLEGE
Contra Costa Community College District


owner


tBP project number : 20247.00
file name:
drawn by: checked by:
date: NOVEMBER 15, 2004

drawing title: FIRST FLOOR PLAN PART "B" TELECOM OUTLETS
building no: LMC SCIENCE 313-023-T12.01-0-00.00
drawing no: T1-2
drawing of

C:\Los Medanos College\Science Building\Final DSA\acad\T1-2.dwg 12-13-04 09:10:37 AM cmendoza

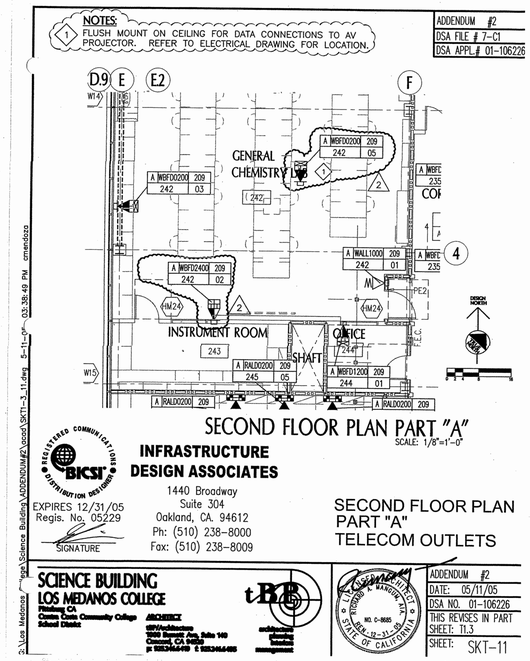

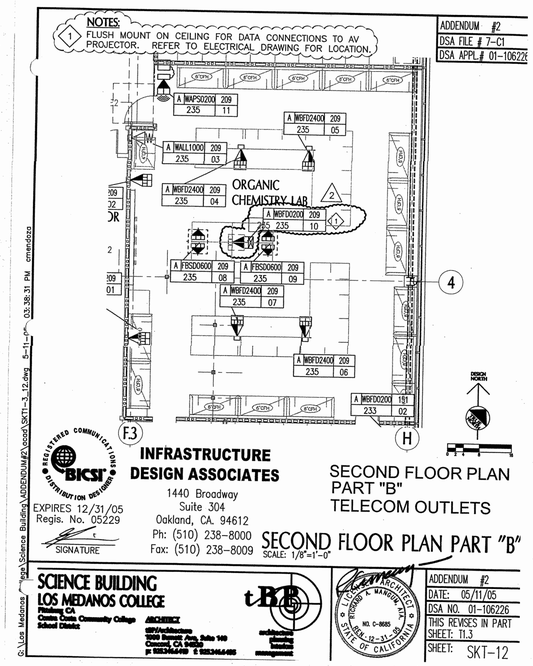

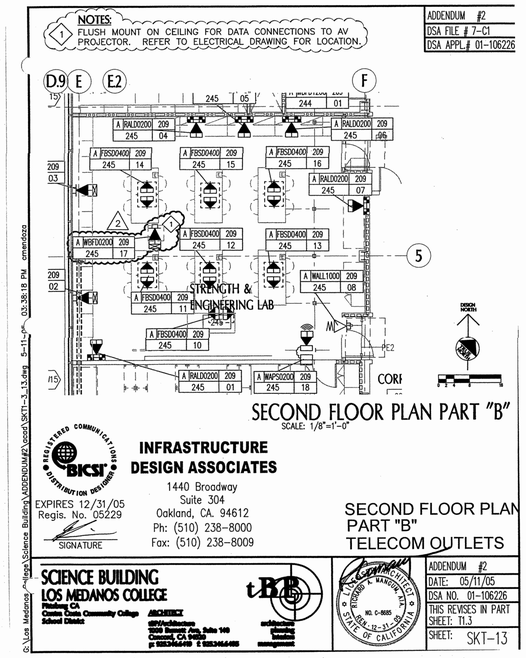

tBP
architecture
planning
interiors
management

tBP/Architecture
1000 Burnett Avenue, Suite 140
Concord, CA 94520
p. 925.246.6419 f. 925.246.6495

architect

consultant

IDENTIFICATION STAMP
DIV. OF THE STATE ARCHITECT
OFFICE OF REGULATION SERVICES
APP. NO. 01-106226
AC. FLS. SS
DATE
FILE No. 7-C1

Division of the State Architect
Regional Office
1515 Clay St., Suite 1201
Oakland, CA 94612
p. 415-396-9500 f.

agency

SCIENCE BUILDING
LOS MEDANOS COLLEGE
Contra Costa Community College District

owner

tBP project number : 20241.00

file name:


drawn by: checked by:


date: NOVEMBER 15, 2004

Rev.	date:	description:

drawing title:
ADDENDUM #2 DRAWINGS


LMC SCIENCE 313-023-T12.01-0-00.00
drawing no.:
ATTACHMENT TO T1-3

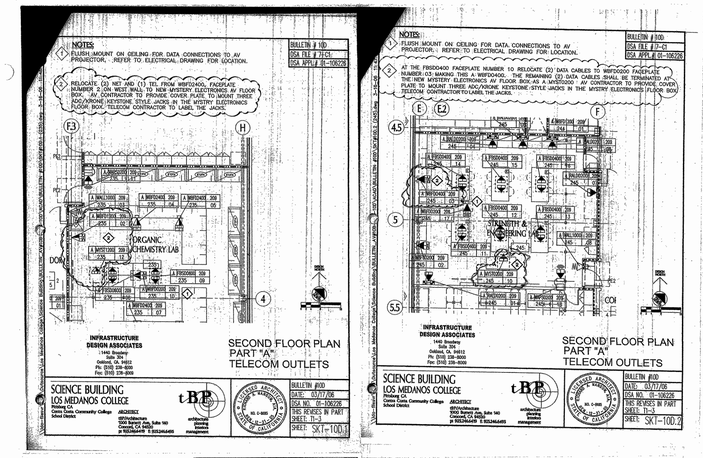

NOTES:
1 FLUSH MOUNT ON CEILING FOR DATA CONNECTIONS TO AV PROJECTOR. - REFER TO ELECTRICAL DRAWING FOR LOCATION.
2 RELOCATE (2) NEW JAKS (1) TEL FROM WSFD2400, FACEPLATE NUMBER 5 ON WEST WALL TO NEW MYSTERY ELECTRONICS AV FLOOR BOX. - AV CONTRACTOR TO PROVIDE COVER PLATE TO MOUNT THREE ADD'L/SPARE KEYSTONE STYLE JACKS IN THE MYSTRY ELECTRONICS FLOOR BOX. TELECOM CONTRACTOR TO LABEL THE JACKS.
BULLETIN # 10D
DSA FILE # 71-C1
DSA APP'L # 01-106226
ORGANIC CHEMISTRY LAB
INFRASTRUCTURE DESIGN ASSOCIATES
1440 Broadway Suite 304 Oakland, CA 94612 Ph: (510) 238-9000 Fax: (510) 238-9000
SECOND FLOOR PLAN PART "A" TELECOM OUTLETS
SCIENCE BUILDING
LOS MEDANOS COLLEGE
Contra Costa Community College District
tBP
architecture interior design management
BULLETIN #0D
DATE: 05/17/06
DSA NO. 01-106226
THIS REVISED IN PART
SHEET: TI-3
SHEET: SKT-100.1
NOTES:
1 FLUSH MOUNT ON CEILING FOR DATA CONNECTIONS TO AV PROJECTOR. - REFER TO ELECTRICAL DRAWING FOR LOCATION.
2 AT THE FBSD0400 FACEPLATE NUMBER 10 RELOCATE (2) DATA CABLES TO WSFD0500 FACEPLATE NUMBER (3) MARKED THIS A WSFD0400. THE REMAINING (2) DATA CABLES SHALL BE TERMINATED AT THE NEW MYSTERY ELECTRONICS AV FLOOR BOX AS A WSTD3000 . AV CONTRACTOR TO PROVIDE COVER PLATE TO MOUNT THREE ADD'L/SPARE KEYSTONE STYLE JACKS IN THE MYSTERY ELECTRONICS FLOOR BOX. TELECOM CONTRACTOR TO LABEL THE JACKS.
BULLETIN # 00D
DSA FILE # 71-C1
DSA APP'L # 01-106226
STRENGTH & CONDITIONING
INFRASTRUCTURE DESIGN ASSOCIATES
1440 Broadway Suite 304 Oakland, CA 94612 Ph: (510) 238-9000 Fax: (510) 238-9000
SECOND FLOOR PLAN PART "A" TELECOM OUTLETS
SCIENCE BUILDING
LOS MEDANOS COLLEGE
Contra Costa Community College District
tBP
architecture interior design management
BULLETIN #0D
DATE: 05/17/06
DSA NO. 01-106226
THIS REVISED IN PART
SHEET: TI-3
SHEET: SKT-100.2

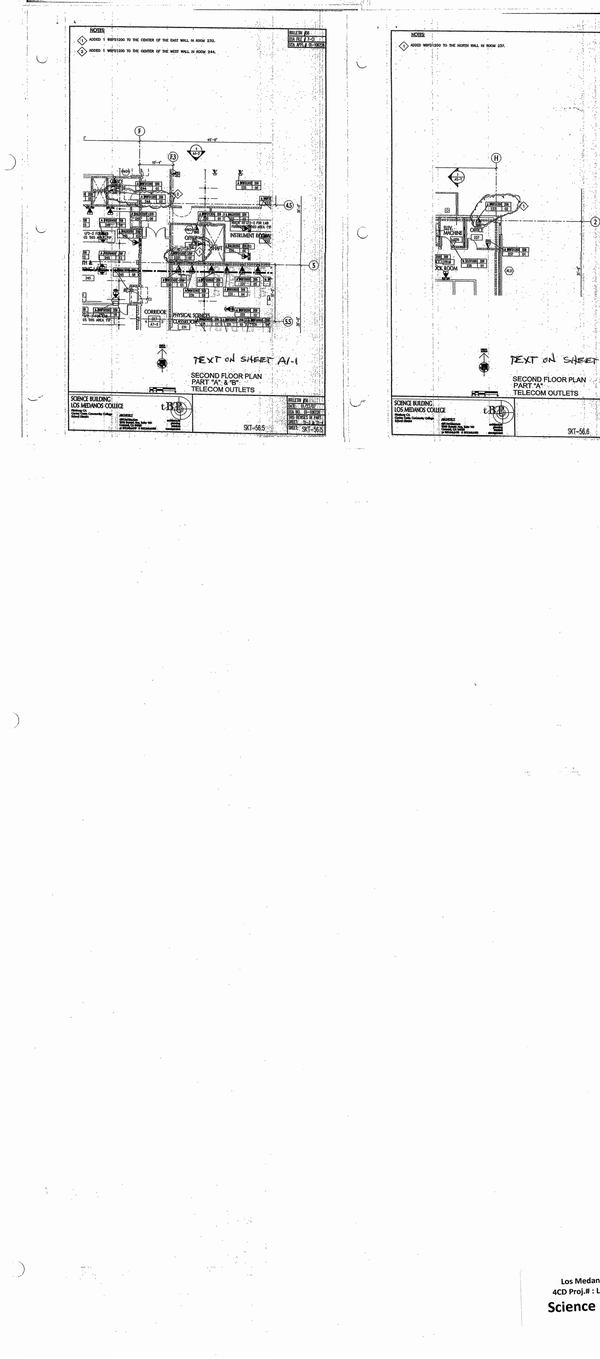

NOTES:
1 ADDED 1 WSFD1200 TO THE CENTER OF THE EAST WALL IN ROOM 330.
2 ADDED 1 WSFD1200 TO THE CENTER OF THE WEST WALL IN ROOM 344.
TEXT ON SHEET A1-1
SECOND FLOOR PLAN PART "A" & "B" TELECOM OUTLETS
SCIENCE BUILDING
LOS MEDANOS COLLEGE
SKT-56.5
NOTES:
1 ADDED WSFD1200 TO THE NORTH WALL IN ROOM 337.
TEXT ON SHEET A1-1
SECOND FLOOR PLAN PART "A" TELECOM OUTLETS
SCIENCE BUILDING
LOS MEDANOS COLLEGE
SKT-56.6


KEY NOTES:


1. COORDINATE LOCATION WITH APPROVED ELEVATOR EQUIPMENT ROOM SUBMITTALS.
2. COORDINATE LOCATION WITH OWNERS REPRESENTATIVE IN CEILING.

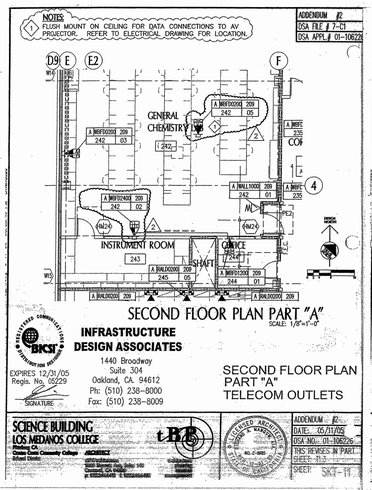

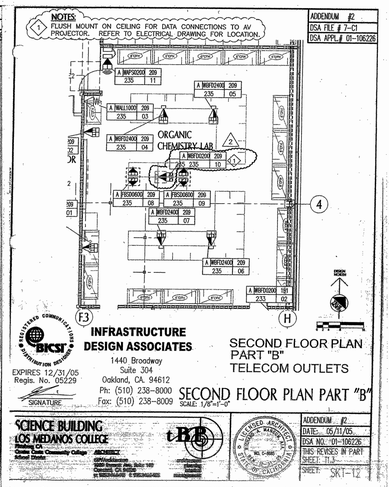

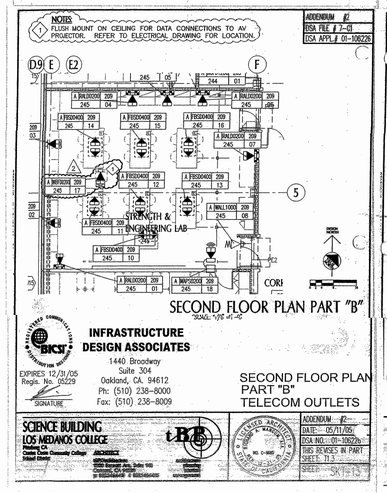


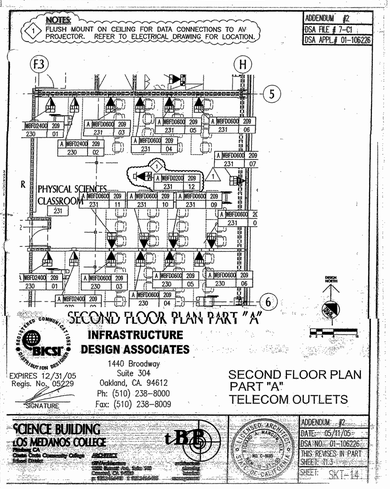

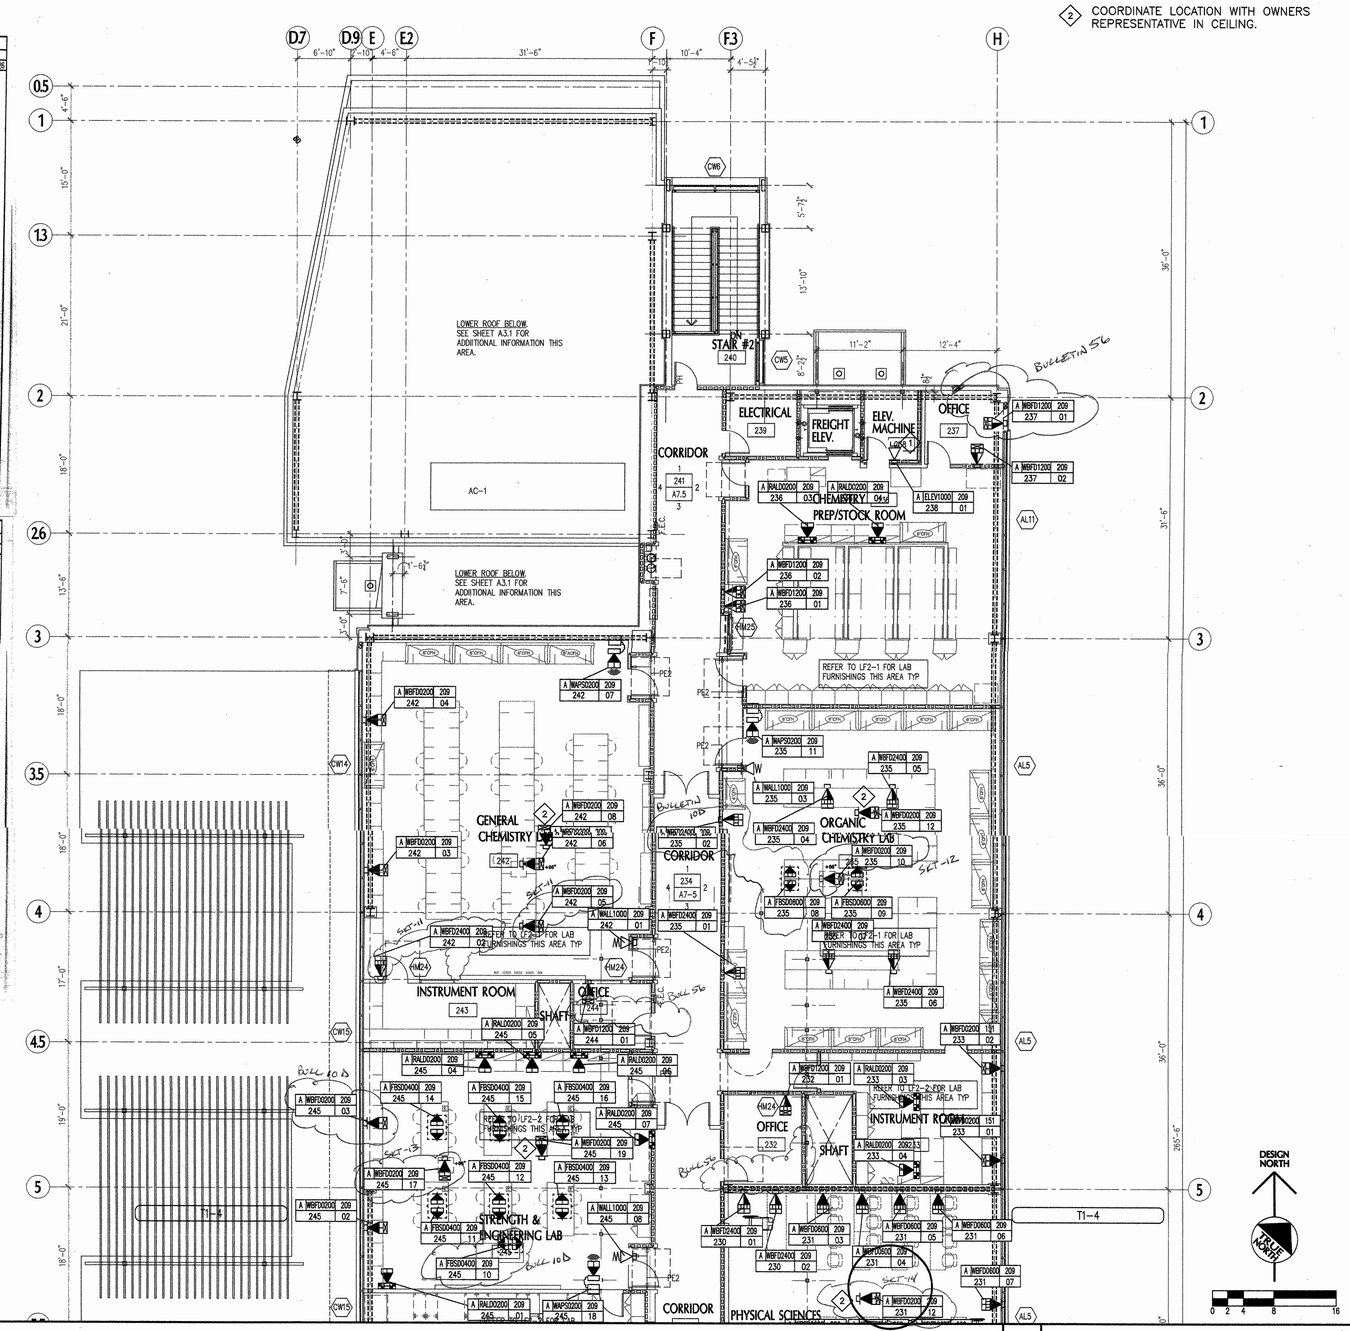

SECOND FLOOR PLAN PART "A"
SCALE: 1/8"=1'-0"

1 KEY PLAN

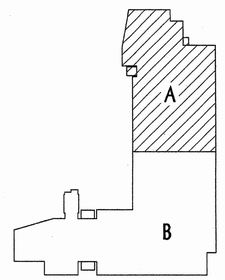

tBP
architecture
planning
interiors
management

LICENSED ARCHITECT
CHRISTOPHER A. EMMONS
No. C-9605
STATE OF CALIFORNIA

tBP/Architecture
1000 Burnett Avenue, Suite 140
Concord, CA 94520
p: 925.246.6419 f: 925.246.6495

INFRASTRUCTURE DESIGN ASSOCIATES
1440 Broadway
Suite 304
Oakland, CA 94612
EXPIRES 12/31/06
Regis. No. 06606
SIGNATURE
consultant

name
address
city, state, zip
ph: fx:

DRAWING REVIEW STAMP
DIV. OF THE STATE ARCHITECT
OFFICE OF REGULATION SERVICES
APP. # 01-106226
DATE 11-1-05

SCIENCE BUILDING
LOS MEDANOS COLLEGE
Contra Costa Community College District


owner


tBP project number : 20247.00
file name:
drawn by: checked by:
date: NOVEMBER 15, 2004


1/8"=1'-0"


drawing title: SECOND FLOOR PLAN PART "A" TELECOM OUTLETS
building no:
LMC SCIENCE 313-023-112.01-0-00.00
drawing no: T1-3
drawing of


G:\Los Medanos College\Science Building\Final DSA\acad\T1-3.dwg 12-13-04 | 09:13:35 AM cmendoza

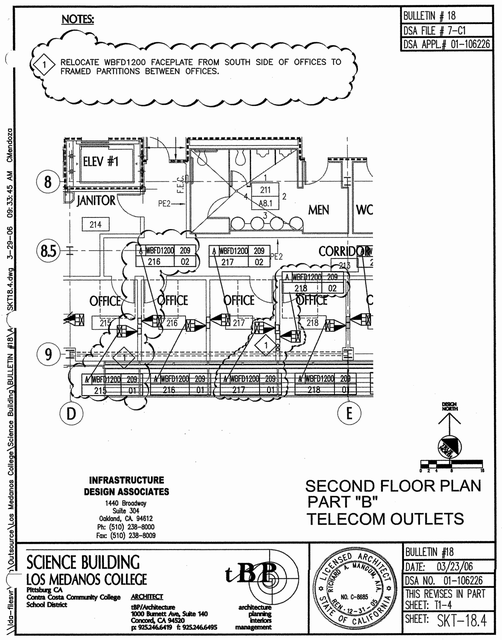


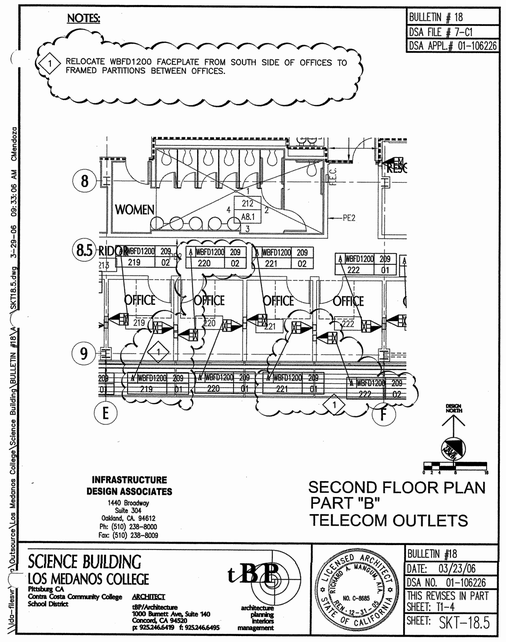

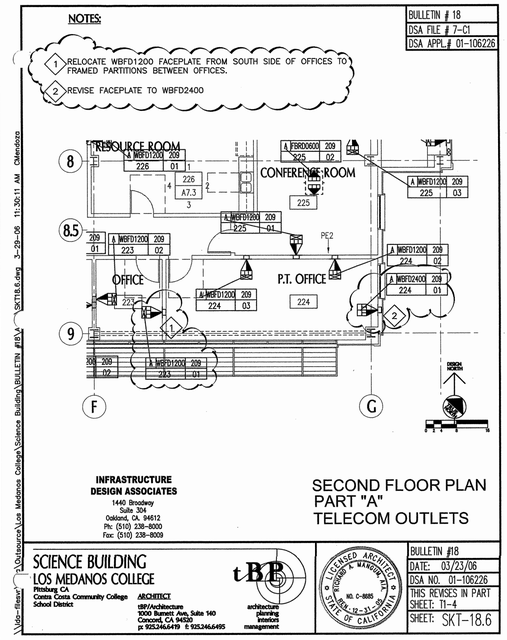

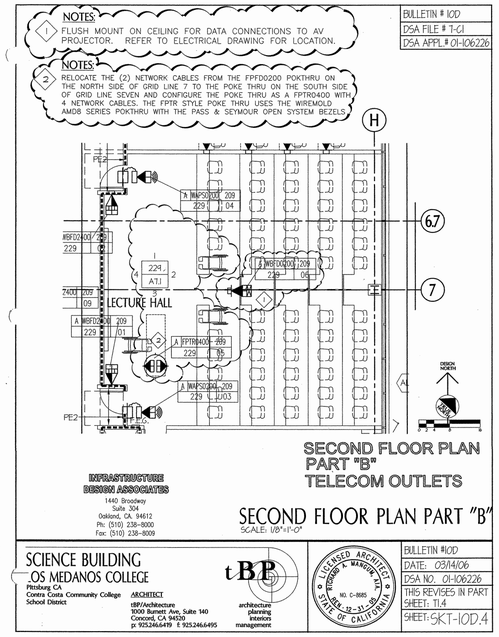

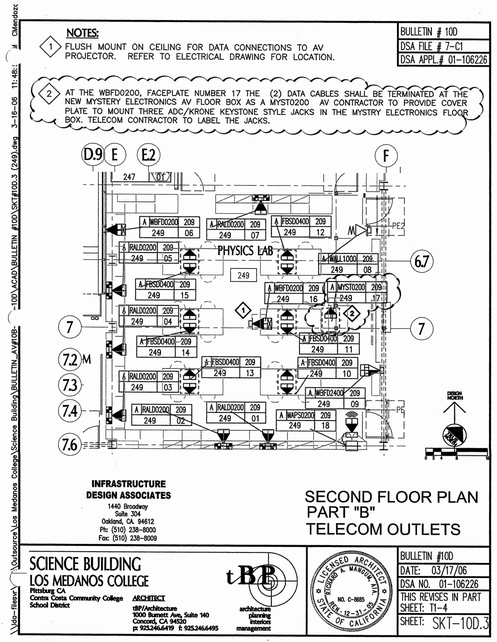

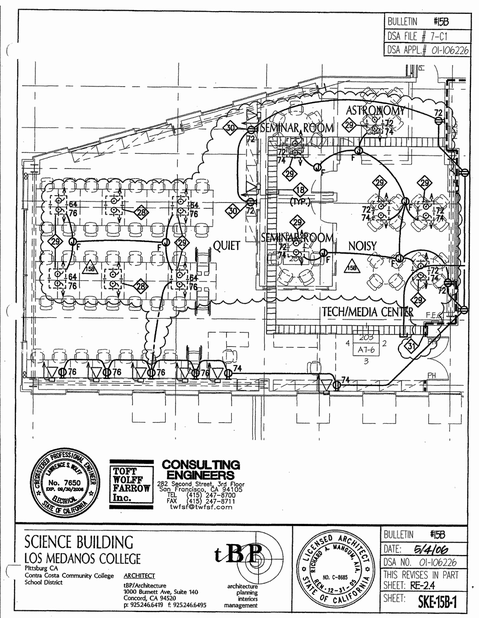

tBP/Arclitecture
1000 Burnett Avenue, Suite 140
Concord, CA 94520
p. 925.246.6419 f. 925.246.6495

architect

consultant

IDENTIFICATION STAMP
DEPT. OF THE STATE ARCHITECT
FOR DSA-SS/CC PROJECTS
APP. NO. 01-106226
AC. ____ FIS ____ SS ____
DATE ____
FILE No. 7-C1

Division of the State Architect
Regional Office
1515 Clay St, Suite 1201
Oakland, CA 94612
p. 415-396-9500 F

agency

SCIENCE BUILDING
LOS MEDANOS COLLEGE
Contra Costa Community College District


owner


tBP project number : 202417.00
file name:
drawn by: checked by:
date: NOVEMBER 15, 2004


Rev: date: description:


BULLETIN 18, 10D & 15B DRAWINGS


ATTACHMENT TO T1-4

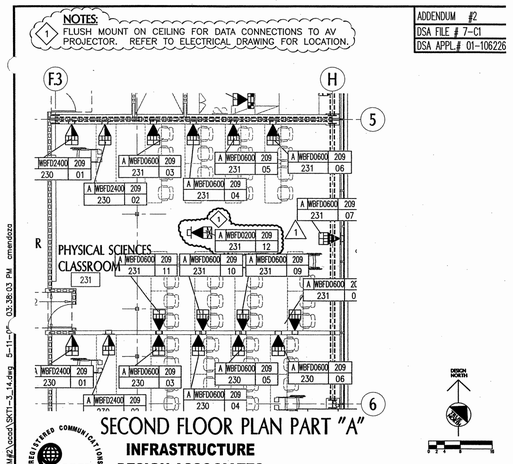


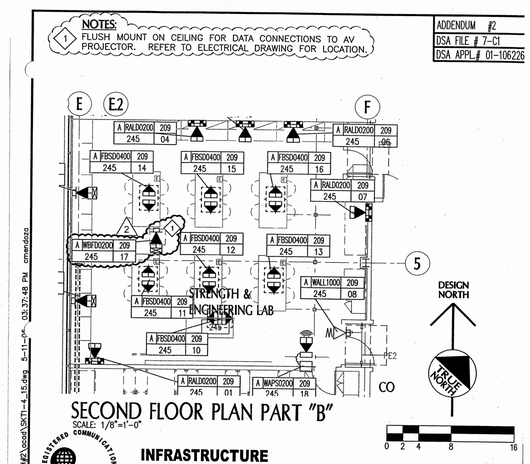

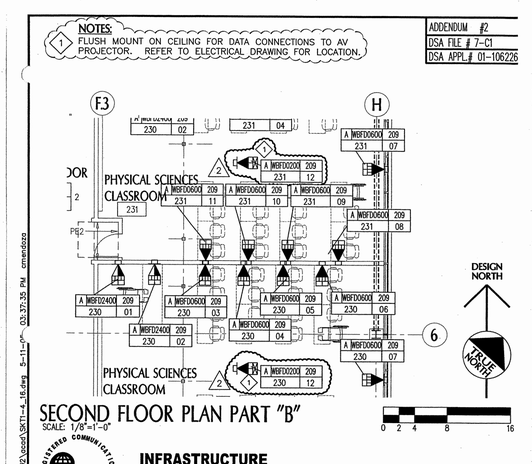

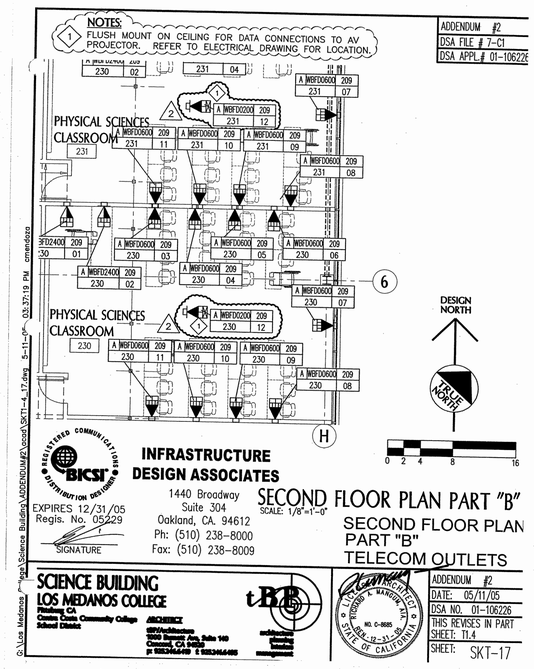

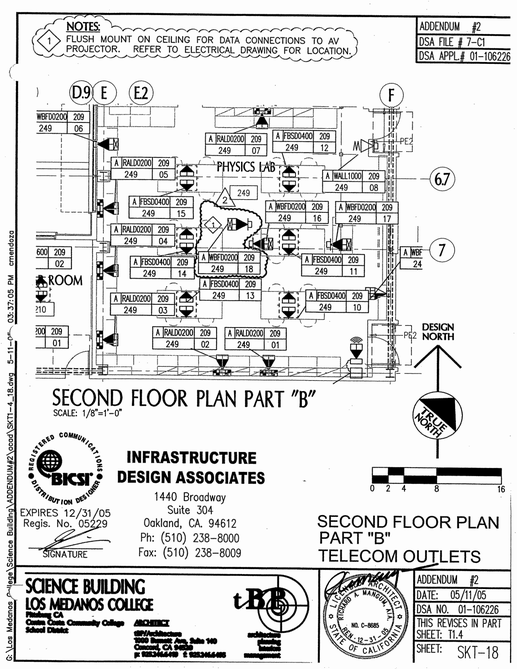

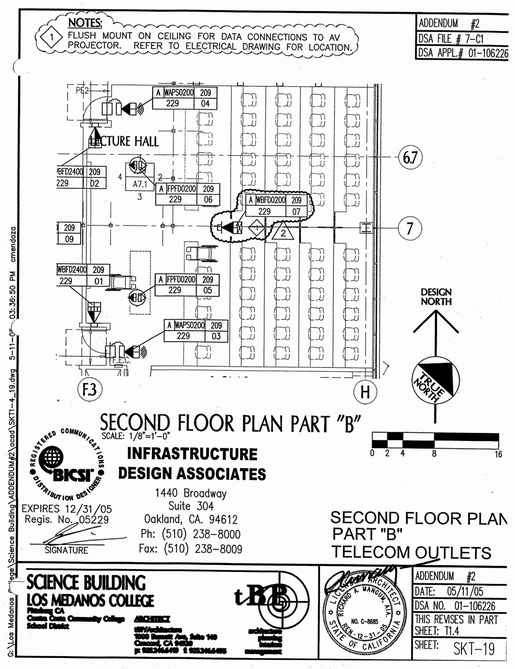

tBP
architecture
planning
interiors
management

tBP/Architecture
1000 Burnett Avenue, Suite 140
Concord, CA 94520
p. 925.246.6419 f. 925.246.6495

architect

consultant

IDENTIFICATION STAMP
DIV. OF THE STATE ARCHITECT
OFFICE OF REGULATORY SERVICES
APP. NO. 01-106226
AC. FLS SS
DATE
RE File 7C1

Division of the State Architect
Regional Office
1515 Clay St., Suite 1201
Oakland, CA 94612
p. 415-396-9500 f.

agency

SCIENCE BUILDING
LOS MEDANOS COLLEGE

Contra Costa Community College District

owner

tBP project number : 20241.00

file name:

drawn by: checked by:

date: NOVEMBER 15, 2004

Rev:	date:	description:


drawing title:
ADDENDUM # 2 DRAWINGS

LMC SCIENCE 313-023-112.01-0-00.00
drawing no.:
ATTACHMENT TO T1-4

NOTES:

1. RELOCATE WBFD1200 FACEPLATE FROM SOUTH SIDE OF OFFICES TO FRAMED PARTITIONS BETWEEN OFFICES.

BULLETIN # 18
DSA FILE # 7-C1
DSA APPL # 01-106226

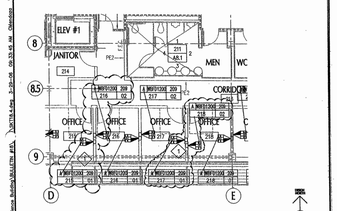

INFRASTRUCTURE DESIGN ASSOCIATES
1440 Broadway
Suite 304
Oakland, CA. 94612

SECOND FLOOR PLAN
PART "B"
TELECOM OUTLETS

SCIENCE BUILDING
LOS MEDANOS COLLEGE
Pittsburg, Ca
Contra Costa Community College District

ARCHITECT
tBP/Architecture
1000 Burnett Ave, Suite 140
Concord, CA 94520
p: 925.246.6400 f: 925.246.6495

tBP architecture planning interiors management


LICENSED ARCHITECT
STATE OF CALIFORNIA

DATE: 03/23/06
DSA NO. 01-106226
THIS REVISES IN PART
SHEET: TI-4
SHEET: SKT-18.4

NOTES:

1. RELOCATE WBFD1200 FACEPLATE FROM SOUTH SIDE OF OFFICES TO FRAMED PARTITIONS BETWEEN OFFICES.

BULLETIN # 18
DSA FILE # 7-C1
DSA APPL # 01-106226

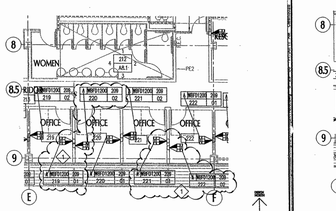

INFRASTRUCTURE DESIGN ASSOCIATES
1440 Broadway
Suite 304
Oakland, CA. 94612

SECOND FLOOR PLAN
PART "B"
TELECOM OUTLETS

SCIENCE BUILDING
LOS MEDANOS COLLEGE
Pittsburg, Ca
Contra Costa Community College District

ARCHITECT
tBP/Architecture
1000 Burnett Ave, Suite 140
Concord, CA 94520
p: 925.246.6400 f: 925.246.6495

tBP architecture planning interiors management


LICENSED ARCHITECT
STATE OF CALIFORNIA

DATE: 03/23/06
DSA NO. 01-106226
THIS REVISES IN PART
SHEET: TI-4
SHEET: SKT-18.5

NOTES:

1. RELOCATE WBFD1200 FACEPLATE FROM SOUTH SIDE OF OFFICES TO FRAMED PARTITIONS BETWEEN OFFICES.
2. REVISE FACEPLATE TO WBFD2400

BULLETIN # 18
DSA FILE # 7-C1
DSA APPL # 01-106226

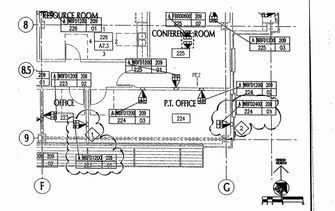

INFRASTRUCTURE DESIGN ASSOCIATES
1440 Broadway
Suite 304
Oakland, CA. 94612

SECOND FLOOR PLAN
PART "A"
TELECOM OUTLETS

SCIENCE BUILDING
LOS MEDANOS COLLEGE
Pittsburg, Ca
Contra Costa Community College District

ARCHITECT
tBP/Architecture
1000 Burnett Ave, Suite 140
Concord, CA 94520
p: 925.246.6400 f: 925.246.6495

tBP architecture planning interiors management


LICENSED ARCHITECT
STATE OF CALIFORNIA

DATE: 03/23/06
DSA NO. 01-106226
THIS REVISES IN PART
SHEET: TI-4
SHEET: SKT-18.6

NOTES:

1. FLUSH MOUNT ON CEILING FOR DATA CONNECTIONS TO AV PROJECTOR. REFER TO ELECTRICAL DRAWING FOR LOCATION.

DSA FILE #7-C1
DSA APPL # 01-106226

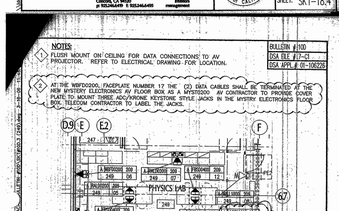

INFRASTRUCTURE DESIGN ASSOCIATES
1440 Broadway
Suite 304
Oakland, CA. 94612

SECOND FLOOR PLAN
PART "B"
TELECOM OUTLETS

SCIENCE BUILDING
LOS MEDANOS COLLEGE
Pittsburg, Ca
Contra Costa Community College District

ARCHITECT
tBP/Architecture
1000 Burnett Ave, Suite 140
Concord, CA 94520
p: 925.246.6400 f: 925.246.6495

tBP architecture planning interiors management


LICENSED ARCHITECT
STATE OF CALIFORNIA

DSA NO. 01-106226
THIS REVISES IN PART
SHEET: TI-4

NOTES:

1. FLUSH MOUNT ON CEILING FOR DATA CONNECTIONS TO AV PROJECTOR. REFER TO ELECTRICAL DRAWING FOR LOCATION.

DSA FILE # 7-C1
DSA APPL #01-106226

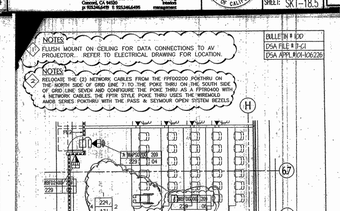

INFRASTRUCTURE DESIGN ASSOCIATES
1440 Broadway
Suite 304
Oakland, CA. 94612

SECOND FLOOR PLAN PART "B"
SCALE: 1/8"=1'-0"

SECOND FLOOR PLAN
PART "B"
TELECOM OUTLETS

SCIENCE BUILDING
LOS MEDANOS COLLEGE
Pittsburg, Ca
Contra Costa Community College District

ARCHITECT
tBP/Architecture
1000 Burnett Ave, Suite 140
Concord, CA 94520
p: 925.246.6400 f: 925.246.6495

tBP architecture planning interiors management

LICENSED ARCHITECT
STATE OF CALIFORNIA

DSA FILE # 7-C1
DSA APPL #01-106226

DSA NO. 01-106226
THIS REVISES IN PART
SHEET: TI-4

PPSN2400 FLUSH POKE-THRU DEVICE
(CONNECTION SHOWN/NOT)

(4) 4-PAIR NETWORK STATION CABLES
(4) 8 PIN 8 POSITION NETWORK JACKS
(2) 4-PAIR SUSPENSE SIGNS ONLY
(2) 8 PIN 8 POSITION SUSPENSE JACK

1. 4-INCH QUADLOP CONNECTION STUBBED TO CLOSEST TELECOM PATHWAY FOR TELECOM CABLES.

OUTLET DESIGNATION SHALL BE ADHERED TO THE FACEPLATE WITH A WHITE MYLAR POLYESTER LABEL LABEL SHALL BE LASER PRINTED. PROVIDE LABELING & SCHEDULE FOR APPROVAL BY ARCHITECT OR TELECOM IDENTIFICATION AND NUMBERING SPEC SECTION.


BLANK JACKET INSERT.

2-UNIT DUAL OPENING FLUSHMOUNT FAUCEPLATE MODULE FOR MOUNTING TWO JACKS.

2-UNIT BLANK MODULE TO FILL UNUSED OPENING.

8 PIN 8 POSITION JACK FOR NETWORK STATION CABLE TERMINATION.

1. FLUSH POKE-THRU RECESSED MIRRORHOLD AMCIS STYLE - PPSN2400 OR APPROVED EQUAL

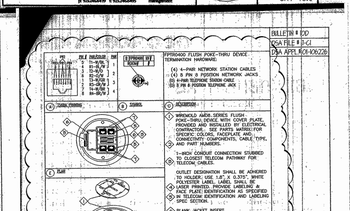

INFRASTRUCTURE DESIGN ASSOCIATES
1440 Broadway
Suite 304
Oakland, CA. 94612
Ph: (510) 236-9000
Fax: (510) 236-9009

SECOND FLOOR PLAN
PART "B"
TELECOM OUTLETS

SECOND FLOOR PLAN PART "B"
SCALE: 1/8"=1'-0"

SCIENCE BUILDING
LOS MEDANOS COLLEGE
Pittsburg, Ca
Contra Costa Community College District

ARCHITECT
tBP/Architecture
1000 Burnett Ave, Suite 140
Concord, CA 94520
p: 925.246.6400 f: 925.246.6495

tBP architecture planning interiors management


LICENSED ARCHITECT
JUSTIN M. WARREN
RENEWAL 08-31-2007
C-31-19660
STATE OF CALIFORNIA

BULLETIN # 100
DSA FILE # 7-C1
DSA APPL #01-106226

BULLETIN #100
DATE: 03/07/06
DSA NO. 01-106226
THIS REVISES IN PART
SHEET: -
SHEET: SKT-100.5

NOTES:

1. MOVED RECEIVER FROM THE MOVED WALL TO THE WEST WALL AND ADDED 2 RECEIVERS TO THE SOUTH WALL IN ROOM 242.

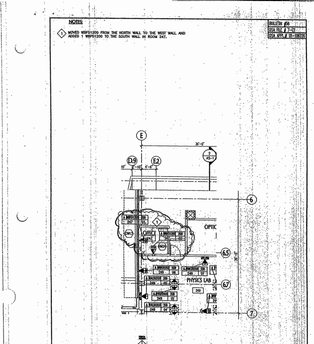

SECOND FLOOR PLAN
PART "B"
TELECOM OUTLETS


SCIENCE BUILDING
LOS MEDANOS COLLEGE

SKT-56.7

BULLETIN #9
DATE: 3/14/07
DSA NO. 01-106226
THIS REVISES IN PART
SHEET: SKT-56.7

NOTES:

1. PROVIDE 2 ADDITIONAL TRIPTS200 TO BE COORDINATED WITH PURCHASE PLACEMENT.

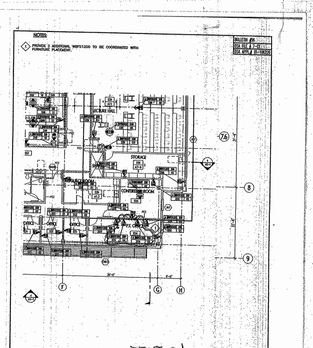

SECOND FLOOR PLAN
PART "B"
TELECOM OUTLETS

SCIENCE BUILDING
LOS MEDANOS COLLEGE

SKT-56.4

BULLETIN #9
DATE: 3/14/07
DSA NO. 01-106226
THIS REVISES IN PART
SHEET: SKT-56.4

S. J. AMOROSO
Request For Information/Clarification

DSA FILE NO. 7-C1
DSA APPL. No. 01-106226

To: tBP/Architecture, 1000 Burnett Ave, Suite 140, Concord, CA 94520
Project: LOS MEDANOS COLLEGE SCIENCE BUILDING, Contra Costa Community College District
Attn: Celia Chiang, Tom Beckett
Fax: 925-246-6495
tBP p/n: 20247.00
Subj.: Data/Telephone Outlets Questions
RFI No: 505
Reference (dwg, spec.): E-1.4
Subcontractor RFI: EWS 80
Reply Requested By: 3/21/07

INFORMATION REQUESTED: Date: 3/14/07

Please note the attached EWS RFI No. 80 regarding Data and Telephone Outlets questions for rooms 203, 214 and 229. Please advise.

SUGGESTED SOLUTION:
Cost Impact: ☐ Schedule Impact: ☐ days By: Justin Warren

RESPONSE: DATE:

Item #1 - No cables need to be provided to the backbox in the Janitors closet.

Item #2 - It is acceptable to change the outlet designation to 16 & 17.

Item #3 - The outlets type is found on SKT-10D. 1 and requires the AV contractor to provide a cover plate to mount three ADC/Krone style jacks in the Mystery Electronics floor box.

Jim Weaver / tBP Architecture
D. Buza / IDA.

4/4/07

RFI # 000
Page 1

EDWARD W. SCOTT ELECTRIC CO., INC.
435 HARRIET STREET
San Francisco, CA 94103-4914
Phone: (415) 626-0701 Fax: (415) 626-2837

REQUEST FOR INFORMATION

PROJECT: LMC SCIENCE BLDG. R.F.I.# 80 R.F.I. Date 3/14/07
JOB: 2451 ACTUAL REPLY DATE

TO: MARK DELGADO
OF: ARAMARK-LMC PROJECT
REF.DWG: E2.1, T1.4, SD-150
LOCATION: ROOMS 203 & 229

POTENTIAL COST IMPACT
___ COST X SCHEDULE
___ OTHER ___ LABOR
___ NO IMPACT ___ MATERIAL

DET. E2.1

INFORMATION REQUESTED: ELEC. DWG. DET. E2.1 SHOWS A TEL/DATA OUTLET IN JAN. CLOSET 214. THIS OUTLET IS NOT SHOWN ON DWG. T1.4 WE NEED AN ADDRESS AND THE NUMBER OF CABLES NEEDED.
ADDITIONALLY ROOMS 2 DATA OUTLETS ON THE DEMONSTRATION WALLS IN RM 203. THESE OUTLETS HAVE NOT BEEN LABELED IS # IN WHICH ARE ALREADY INSTALLED. CAN WE CHANGE THESE TO 16 & 17 ?
LIKEWISE IN RM 229 WE NEED A MYST. ELEC. BOX IN RM 227 WITH 4 DATA OUTLETS. WE ARE UNABLE TO FIND A DESIGNATION FOR THESE OUTLETS.
PLEASE ADVISE.

REPLY REQUIRED BY: SIGNED:
NOTE: IF NO REPLY IS RECEIVED BY US BY THE ABOVE NOTED DATE, A TIME EXTENSION WILL BE REQUIRED WITH POSSIBLE COST IMPACTS.

RESPONSE:

DATED: SIGNED:

INDUSTRIAL, COMMERCIAL WIRING & DESIGN
STATE CONTRACTOR LICENSE NO. 190438

EDSCO39

S. J. AMOROSO
Request For Information/Clarification

DSA FILE NO. 7-C1
DSA APPL. No. 01-106226

To: tBP/Architecture, 1000 Burnett Ave, Suite 140, Concord, CA 94520
Project: LOS MEDANOS COLLEGE SCIENCE BUILDING, Contra Costa Community College District
Attn: Celia Chiang, Tom Beckett
Fax: 925-246-6495
tBP p/n: 20247.00
Subj.: Projector Label Number
RFI No: 513
Reference (dwg, spec.):
Subcontractor RFI: EWS 82
Reply Requested By: 4/16/07

INFORMATION REQUESTED: Date: 4/9/07

Please note the attached EW Scott RFI No. 82 regarding the added data outlet for the projector. The outlet is labeled #18 which is already used, should the projector be labeled #19. Please advise.

SUGGESTED SOLUTION:
Cost Impact: ☐ Schedule Impact: ☐ days By: Justin Warren

RESPONSE: DATE:

No exception taken to labeling the above mentioned data outlet as #19.

Jim Weaver / tBP Architecture
Dave Buza / IDA

4/11/07

RFI # 000
Page 1

cc: EW Scott

EDWARD W. SCOTT ELECTRIC CO., INC.
435 HARRIET STREET
San Francisco, CA 94103-4914
Phone: (415) 626-0701 Fax: (415) 626-2837

REQUEST FOR INFORMATION

PROJECT: LMC SITE IMPROVEMENT R.F.I.# 82 R.F.I. Date 4/4/07
JOB: 2462 ACTUAL REPLY DATE

TO: JUSTIN WARREN
OF: AMOROSO CONST.
REF.DWG: T1.4 & ADD #2
LOCATION: RM. 214

POTENTIAL COST IMPACT
___ COST X SCHEDULE
___ OTHER ___ LABOR
___ NO IMPACT ___ MATERIAL

INFORMATION REQUESTED: ADDENDUM 2 ADDED A DATA OUTLET AT THE PROJECTOR T1.4 LABELED #18. THERE IS ALREADY AN OUTLET IN THE ROOM LABELED #18 & WE WOULD LIKE TO LABEL THE ADDED PROJECTOR OUTLET #19.

REPLY REQUIRED BY: ASAP SIGNED:
NOTE: IF NO REPLY IS RECEIVED BY US BY THE ABOVE NOTED DATE, A TIME EXTENSION WILL BE REQUIRED WITH POSSIBLE COST IMPACTS.

RESPONSE:

DATED: SIGNED:

INDUSTRIAL, COMMERCIAL WIRING & DESIGN
STATE CONTRACTOR LICENSE NO. 190438

EDSCO39

Los Medanos College
4CD Proj.# : 1-565-B-23-SC
Science Building

1 COORDINATE LOCATION WITH OWNERS REPRESENTATIVE IN CEILING.

NOTES:
GENERAL
THIS BULLETIN ADDS NETWORK CABLES TERMINATION COVERPLATES AND FACEPLATES IN ROOM 203 TECH MEDIA CENTER. ONE WIREMOLD 5AF 2-1/2 FLOOR BOX ENCLOSURES IS ADDED.
IN THE NOISY AREA OF ROOM 203 PLACE ONE NEW FBS00600 WIREMOLD 5AF 2-1/2 FLOOR BOXES AND TERMINATIONS.
2. IN QUIET PLACE (2) WMFD2003 WITH (3) DATA CABLES AT EACH SINGLE GANG WALL PLATE. THE OWNER IS PROVIDING 12 GENIUS WALL PANELS ON THE WEST WALL OF THE QUITE AREA. THE WALL PANELS WILL BE PROVIDED WITH SINGLE GANG BACK BOXES FOR THESE TWO FACEPLATES. CABLES SHALL BE ROUTED INTO THE BASE OF THE WALL PANELS FROM THE ACCESS FLOOR. CABLES SHALL ROUTE HORIZONTALLY IN THE BASE OF THE WALL PANELS AND ROUTE VERTICALLY UP TO EACH BACK BOX.

BULLETIN #59
DSA FILE # 7-C1
DSA APPL.# 01-106226
DATE: 6/4/05
DSA NO.: 01-106226
THIS REVISES IN PART
SHEET: T1-4
SHEET: SKT15R2


INFRASTRUCTURE DESIGN ASSOCIATES
1440 Broadway
Suite 304
Oakland, CA. 94612
Ph: (510) 238-8000
Fax: (510) 238-8009


SCIENCE BUILDING
LOS MEDANOS COLLEGE
Contra Costa Community College District
ARCHITECT
tBP Architecture
2000 Powell St. Suite 920
Emeryville, CA 94608
p: 510.652.4500 f: 510.652.4501


SECOND FLOOR PLAN PART "B"
SCALE: 1/8"=1'-0"


SECOND FLOOR PLAN PART "B"
TELECOM OUTLETS


SHEET: SKT15R1

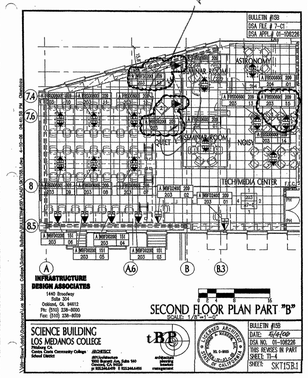

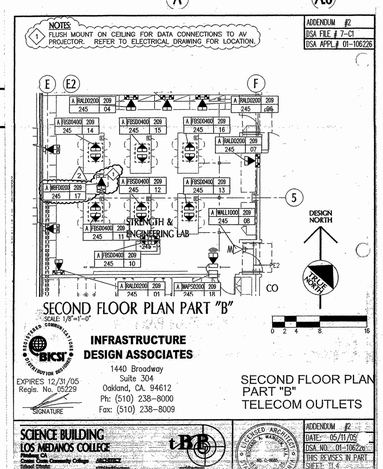


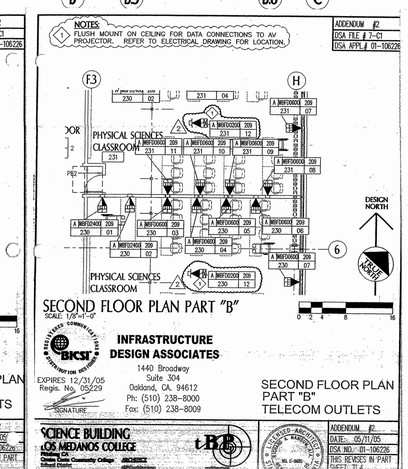

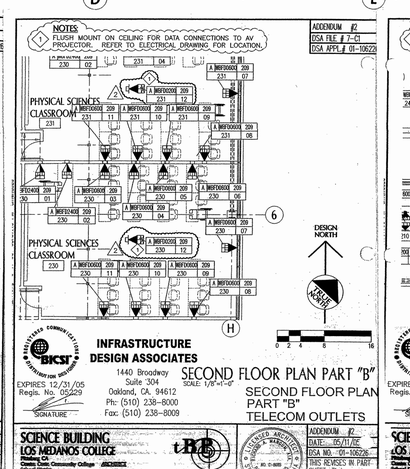

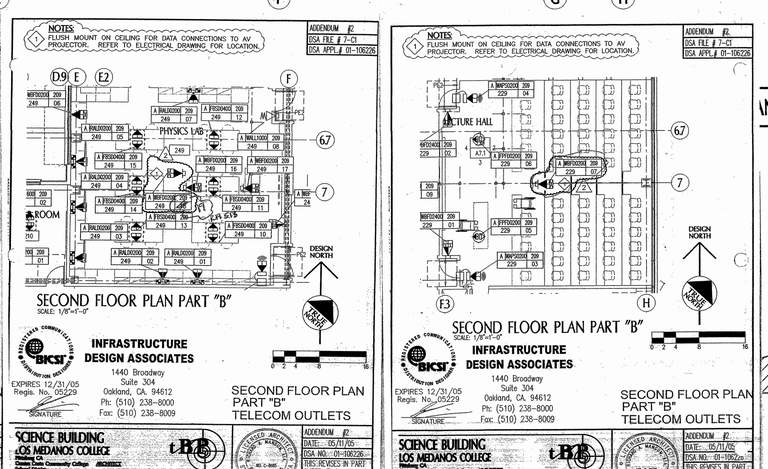

DESIGN NORTH
TRUE NORTH
0 2 4 8 16

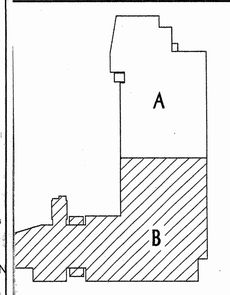

1/8"=1'-0"

drawing title: SECOND FLOOR PLAN PART "B" TELECOM OUTLETS
building no:
LMC SCIENCE 313-023-T12.01-0-00.00
drawing no: T1-4
drawing of

tBP
architecture
planning
interiors
management

tBP/Architecture
1000 Burnett Avenue, Suite 140
Concord, CA 94520
p. 9252466419 f. 9252466495

LICENSED ARCHITECT
ROBERT KEN LEUNG
No. C-26855
REGISTERED PROFESSIONAL ENGINEER
STATE OF CALIFORNIA

INFRASTRUCTURE DESIGN ASSOCIATES
1440 Broadway
Suite 304
Oakland, CA. 94612
EXPIRES 12/31/06
Regis. No. 06606
SIGNATURE
consultant

BKSI COMMUNICATIONS
ARCHITECTURE
ENGINEERING
CONSTRUCTION MANAGEMENT

EDUCATION STAMP
DIV. OF THE STATE ARCHITECT
OFFICE OF REGULATION SERVICES
APP. - 01-106226
DATE 11-15-05

name
address
city, state, zip
ph: fx:

SCIENCE BUILDING
LOS MEDANOS COLLEGE
Contra Costa Community College District
owner


tBP project number: 20247.00
file name:
drawn by: checked by:
date: NOVEMBER 15, 2004

\Los Medanos College\Science Building\Final DSA\acad\T1-4.dwg 12-13-04 | 09:16:11 AM cmendoza

ROOF FLOOR PLAN PART "B"

SCALE: 1/8"=1'-0"

1 KEY PLAN

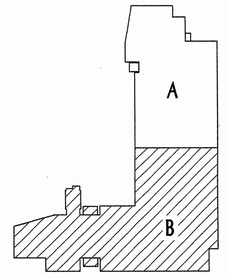

tBP/Architecture
1000 Burnett Avenue, Suite 140
Concord, CA 94520
p: 925.246.6419 f: 925.246.6495

INFRASTRUCTURE DESIGN ASSOCIATES
1440 Broadway
Suite 304
Oakland, CA 94612
EXPIRES: 12/31/06
Regis. No.: 06606
SIGNATURE

name
address
city, state, zip
ph: fx:

consultant

owner

SCIENCE BUILDING
LOS MEDANOS COLLEGE

Contra Costa Community College District

tBP project number : 20247.00

file name:

drawn by: checked by:

date: NOVEMBER 15, 2004

1/8"=1'-0"

drawing title: ROOF PLAN PART "B" TELECOM OUTLETS

building no:

LMC SCIENCE 313-023-112.01-0-00.00

drawing no: T1-5

drawing of

G:\Los Medanos College\Science Building\BID Set\vacad\T1-5.dwg 11-08-04 10:36:40 AM cmendoza

S. J. AMOROSO
Request For Information/Clarification

DSA FILE NO. 7-C1
DSA APPL. No. 01-106228

To: ISP/Architecture
1000 Burnett Ave, Suite 140
Concord, CA 94520

Project: LOS MEDANOS COLLEGE
SCIENCE BUILDING
Contra Costa Community College District

Attn: Celia Chiang, Tom Beckett
Fax: 925-246-6499

ISP p/n: 20247.00

Subj.: Telecom GRD BUS Grounding

RFI No: **156**

Reference (dwg, spec.) T3-1 & T3-2

Subcontractor RFI: EWS 7

Reply Requested By: 2/27/06

Date: 2/23/06

INFORMATION REQUESTED:

Please note the attached Scott Electric RFI No. 7 regarding a GRD BUS in rooms 151 and 209 with no grounding information. Please advise.

SUGGESTED SOLUTION:

Cost Impact: ☐ Schedule Impact: ☐ days By: Mark Delgado

DATE 2/16/06

RESPONSE:
Electrical contractor must bond the ground bus bar in telecom room 151 and 209 to the electrical ground system in the building and to building steel with an exothermic weld to the closest building structural steel member. In addition the Telecom contractor must bond the equipment racks, cable ladders, cable trays and terminal block back boards to the telecom ground bus bar. For room 151, see symbols and sheet notes on T3-1 and also sheet note E12 on E2.2. For room 209, see symbols and sheet notes on T3-2 and also sheet note E14 on E5.4.

Attachments:

By: DWP/DSA

TRANSMITTAL RECORD:

FROM	TO	DATE
S.J.AMOROSO	ISP / ARCHITECTURE	2/23/06
ISP / ARCHITECTURE	ENGINEER/CONSULTANT	2.23.06
ENGINEER/CONSULTANT	ISP / ARCHITECTURE	2.27.06
ISP / ARCHITECTURE	S.J. AMOROSO	3/06.06
S.J. AMOROSO	ORIGINATOR	

RFI # 000
Page 1

EDWARD W. SCOTT ELECTRIC CO., INC.
435 HARRIET STREET
San Francisco, CA 94103-4914
Phone: (415) 626-0701 Fax: (415) 626-2837

REQUEST FOR INFORMATION

LMC

PROJECT: SCIENCE BLDG. R.F.I.# 7 R.F.I. Date 2/21/06
JOB: 2451 ACTUAL REPLY DATE

TO: MARK DELGADO POTENTIAL COST IMPACT
OF: ANDERSON CONST. ___ COST ___ SCHEDULE
REF. DWG: T3-1, T3-2 & E2.2 ___ OTHER ___ LABOR
LOCATION: DATA ROOMS ___ NO IMPACT ___ MATERIAL

INFORMATION REQUESTED: TELE COM DWGS T3-1 & T3-2 DETAIL 7 SHALL A #6 BUS IN RMS 151 & 209. NEITHER THE ELEC. OR TELECOM DWGS. SEEM TO SHOW HOW THE #6 BUSES THEMSELVES GET GROUNDED. THE GND. SYMBOL ON DWG. T3-2 MAKES REFERENCE TO SPEC. SECTION 16563 WHICH DOES NOT SEEM TO EXIST. PLEASE ADVISE

REPLY REQUIRED BY: 2/27/06 SIGNED:
NOTE: IF NO REPLY IS RECEIVED BY US BY THE ABOVE NOTED DATE A TIME EXTENSION WILL BE REQUIRED WITH POSSIBLE COST IMPACTS.

RESPONSE:


DATED: SIGNED:

EWSDOC#9

INDUSTRIAL, COMMERCIAL WIRING & DESIGN
STATE CONTRACTOR LICENSE NO. 150426

KEY NOTES:

1. END POWER FEED UNIT – 60 AMP, 4 POLE WITH GROUND. (PROVIDED AND INSTALLED BY ELECTRICAL, SHOWN FOR CLARIFICATION)
2. PLUG-IN BUSWAY STRAIGHT SECTION AT +8'-2" A.F.F. 50 LB TOTAL OPERATING WEIGHT. (PROVIDED AND INSTALLED BY ELECTRICAL, SHOWN FOR CLARIFICATION)
3. SUPPORT ASSEMBLY TO SUSPEND BUSWAY FROM BACK-TO-BACK "U" CHANNEL GRID ABOVE. (PROVIDED AND INSTALLED BY ELECTRICAL, SHOWN FOR CLARIFICATION)
4. BUSWAY END CAP. (PROVIDED AND INSTALLED BY ELECTRICAL, SHOWN FOR CLARIFICATION)

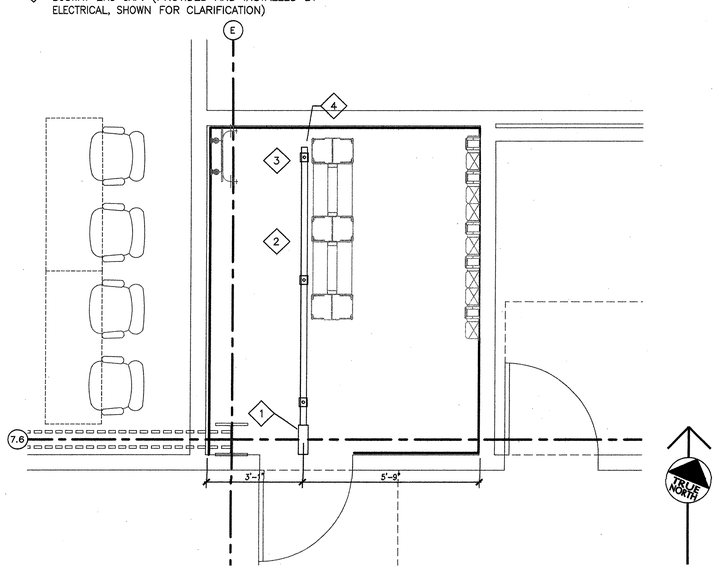


6 STARLINE BUSWAY @ +8'-2" A.F.F. (PROVIDED BY ELECTRICAL)

GRAPHIC SCALE: 1/2" = 1'-0"

KEY NOTES:

1. 15" STEEL CABLE RUNWAY AT +8'-9" A.F.F.
2. RUNWAY WALL SUPPORT KIT WITH "J" BOLTS TO ATTACH 15" CABLE RUNWAY STRINGERS.
3. SLOTTED RUNWAY SUPPORT KIT USED TO SUSPEND CABLE RUNWAY FROM $\frac{3}{8}$" THREADED ROD.
4. DIAGONAL BRACES AND ROD STIFFENER ASSEMBLY TO SUSPEND CABLE RUNWAY FROM SLAB ABOVE.
5. DROP-OUT FITTING.
6. PROVIDE 4" OF CLEARANCE BETWEEN CABLE RUNWAY AND WALLS WHERE INDICATED.
7. #6 AWG STRANDED COPPER WITH GREEN SHEATH INSULATION FROM ONE SEGMENT OF THE +8'-9" CABLE RUNWAY TO THE GROUND BAR IN THE ROOM. TERMINATE THE #6 AWG CABLE IN A TWO-BOLT COMPRESSION LUG CONNECTOR ON THE COPPER GROUND BAR AND IN AN APPROVED GROUND WIRE TERMINAL ON THE CABLE RUNWAY.
8. LOADING CAPACITY FOR CABLE TRAY IS 26 LBS PER LINEAL FOOT. CONTRACTOR SHALL PROVIDE SIGNAGE AT 4' INTERVALS TO INDICATE LOADING CAPACITY.
9. ARROW ⟶ INDICATES LOCATION AND DIRECTION OF STRUCTURAL BRACING. REFER TO SHEET T6-3 FOR TRAPEZE ASSEMBLY BRACING DETAILS.

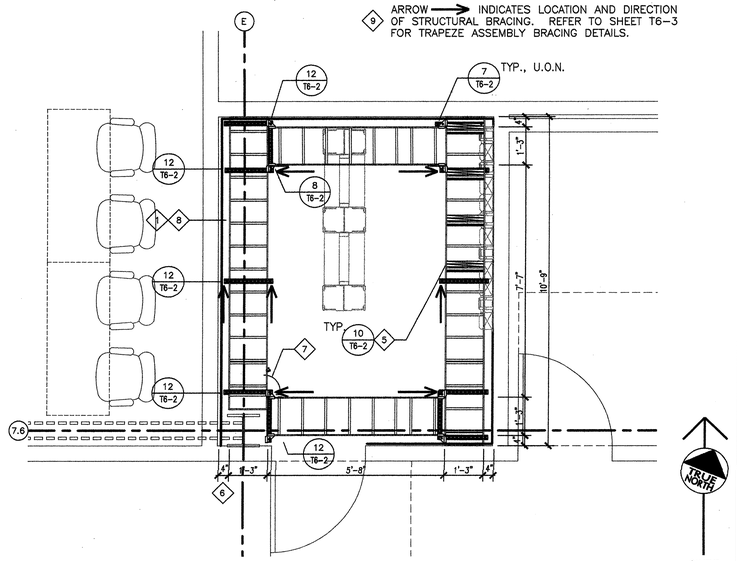


4 15" CABLE RUNWAY @ +8'-9" A.F.F.

GRAPHIC SCALE: 1/2" = 1'-0"

KEY NOTES:

1. 12" X 2" STEEL WIRE CABLE TRAY, ELECTRO-PLATED ZINC GALVANIZING, MOUNTED HORIZONTALLY AT +7'-2" A.F.F.
2. PROVIDE 4" OF CLEARANCE BETWEEN CABLE TRAYS AND WALLS WHERE INDICATED.
3. #6 AWG STRANDED COPPER WITH GREEN SHEATH INSULATION FROM ONE SEGMENT OF THE +7'-2" STEEL WIRE CABLE TRAY TO THE GROUND BAR IN THE ROOM. TERMINATE THE #6 AWG CABLE IN A TWO-BOLT COMPRESSION LUG CONNECTOR ON THE COPPER GROUND BAR AND IN AN APPROVED GROUND WIRE TERMINAL ON THE STEEL WIRE CABLE TRAY.
4. PROVIDE CUTOUTS AND DROPOUT FITTINGS IN LOWER LEVEL OF STEEL WIRE CABLE TRAY ABOVE THE WALL MOUNTED BACKBOARDS AND ABOVE THE DOUBLE SIDED VERTICAL CABLE MANAGERS.
5. ATTACH THE STEEL WIRE CABLE TRAY TO EACH "U" CHANNEL TRAPEZE ASSEMBLY AT LOCATIONS INDICATED WITH TWO SPRING NUTS $\frac{1}{4}$"-20, TWO HOLD DOWN BEAM CLAMPS $1\frac{5}{8}$" AND TWO $\frac{1}{4}$"-20 HEX HEAD BOLTS.
6. LOADING CAPACITY FOR CABLE TRAY IS 26 LBS PER LINEAL FOOT. CONTRACTOR SHALL PROVIDE SIGNAGE AT 4' INTERVALS TO INDICATE LOADING CAPACITY.
7. ARROW ⟶ INDICATES LOCATION AND DIRECTION OF STRUCTURAL BRACING. REFER TO SHEET T6-3 FOR TRAPEZE ASSEMBLY BRACING DETAILS.

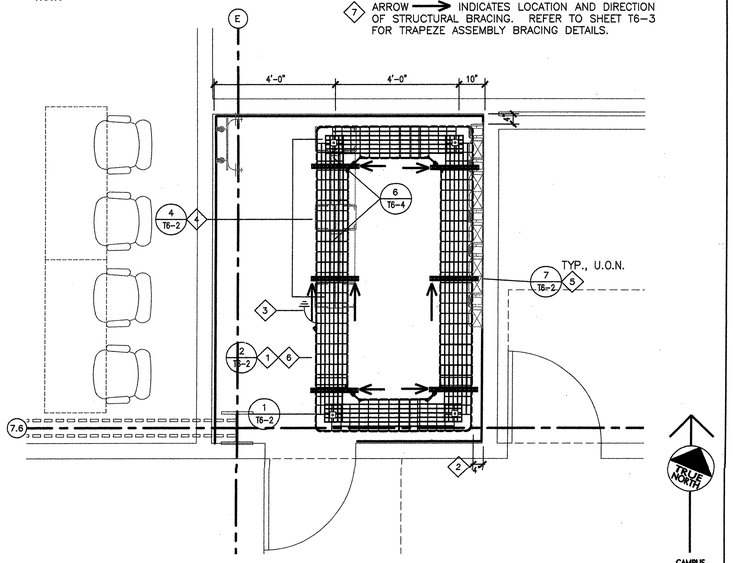


2 12" STEEL WIRE CABLE TRAY @ +7'-2" A.F.F

GRAPHIC SCALE: 1/2" = 1'-0"

KEY NOTES:

1. BACK-TO-BACK "U" CHANNEL SUPPORT GRID INSTALLED AT INDICATED SPACING. REFER TO DRAWING T6.3, DETAIL 4.
2. "U" CHANNEL 7 HOLE CROSS GUSSET PLATE. REFER TO DRAWING T6.3, DETAIL 6.
3. POST BASE MOUNTED TO WALL FOR BACK-TO-BACK "U" CHANNEL SUPPORT. REFER TO DRAWING T6.3, DETAIL 5.
4. RUNS OF "U" CHANNEL ACROSS THE NARROW WIDTH OF THE ROOM SHALL BE CONTINUOUS.
5. RUNS OF "U" CHANNEL ACROSS THE LENGTH OF THE ROOM SHALL BE FILLER SEGMENTS BETWEEN THE CONTINUOUS RUNS.

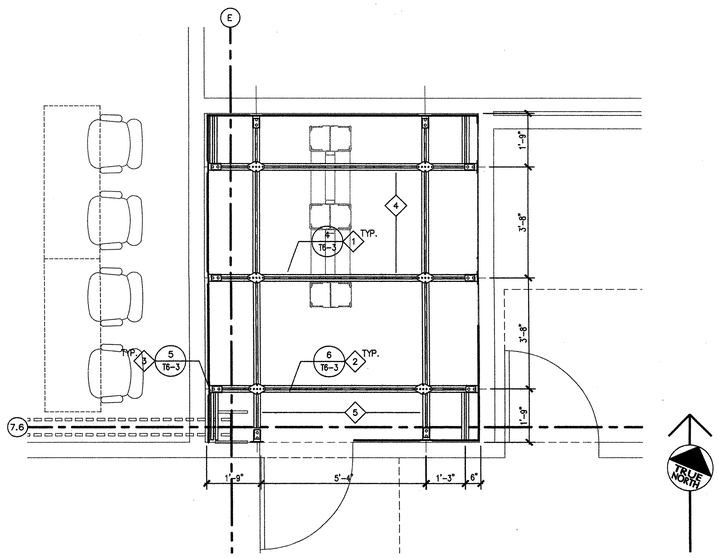


5 DOUBLE "U" FRAMING CHANNEL GRID @ +10'-0" A.F.F.

GRAPHIC SCALE: 1/2" = 1'-0"

KEY NOTES:

1. FIBER OPTIC PATCH CABLE TROUGH 4" STRAIGHT SECTION.
2. FIBER OPTIC PATCH CABLE TROUGH 4" END CAP.
3. FIBER OPTIC PATCH CABLE TROUGH 4" DOWNSPOUT.
4. FIBER OPTIC PATCH CABLE TROUGH 2" DOWNSPOUT INSERT INSIDE 4" DOWNSPOUT.
5. CONNECT DOWNSPOUT INSIDE OF 2" VERTICAL SLOTTED DUCT KIT ATTACHED TO RACK VERTICAL CABLE MANAGER BELOW.
6. POSITION THE 2" VERTICAL SLOTTED DUCT IN THE FORWARD RIGHT CORNER OF THE VERTICAL CABLE MANAGER AND SECURE ON 18" CENTERS WITH MOUNTING BRACKETS. DUCT MUST RUN ENTIRE LENGTH OF THE VERTICAL CABLE MANAGER.
7. USE THREADED ROD ATTACHMENT BRACKETS TO SUPPORT 4" FIBER GUIDE AT +7'-6" FROM "U" CHANNEL ABOVE. USE WHERE INDICATION ARROW IS SHOWN.

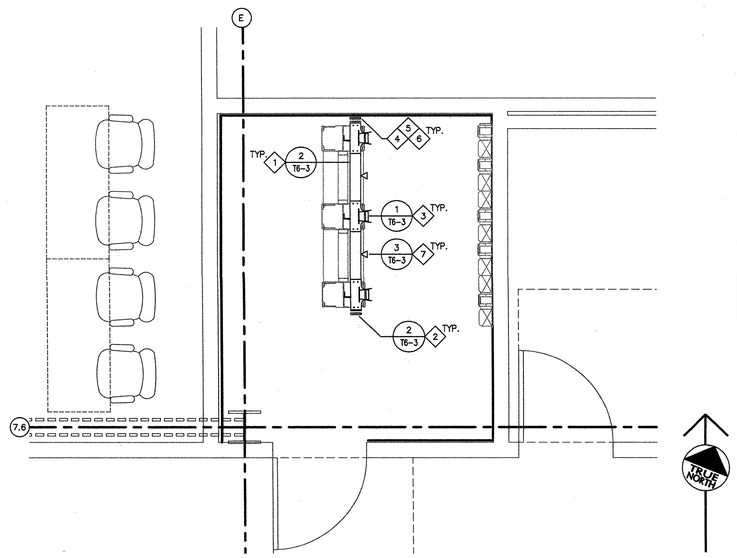


3 FIBER GUIDE @ +7'-6" A.F.F.

GRAPHIC SCALE: 1/2" = 1'-0"

KEY NOTES:

1. 19" X 84" SELF-SUPPORTING ALUMINUM, UL LISTED EQUIPMENT RACK WITH DOUBLE SIDED VERTICAL CABLE MANAGER ON BOTH SIDES AND 6" HORIZONTAL RING PANELS.
2. $\frac{3}{4}$" TREATED FIRE RESISTANT PLYWOOD FROM +0'-6" A.F.F. TO +10'-6" A.F.F. PROVIDED AND INSTALLED BY ELECTRICAL.
3. 20" X 4" COPPER GROUND BUS BAR, PROVIDED AND INSTALLED BY ELECTRICAL.
4. KRONE TRUENET TERMINATION BLOCKS, WALL-MOUNTED FOR TELEPHONE BACKBONE, TELEPHONE STATION AND NETWORK STATION CABLING. REFER TO T4-1 FOR WALL ELEVATION.
5. 3-4" ENTRANCE CONDUITS, PROVIDED AND INSTALLED BY ELECTRICAL. DIMENSIONS SHOWN FOR COORDINATION.

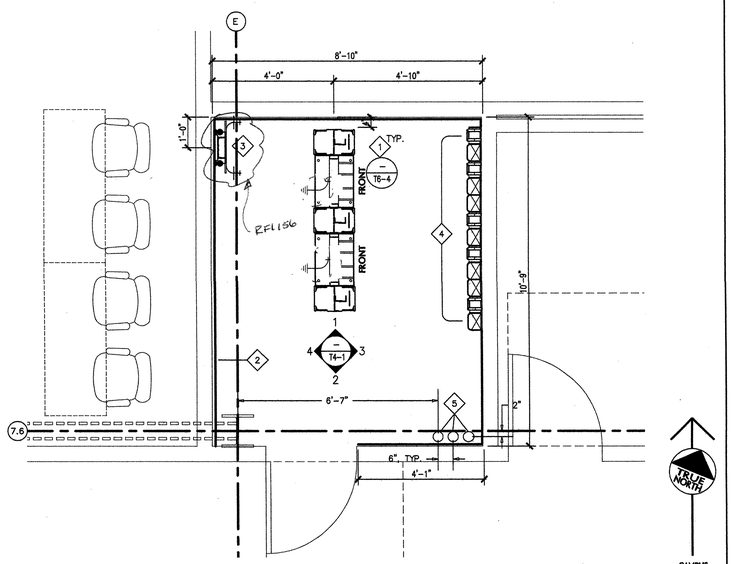

1 BDF/IDF 1.0 FLOOR PLAN

GRAPHIC SCALE: 1/2" = 1'-0"

tBP architecture planning interiors management

tBP/Architecture
1000 Burnett Avenue, Suite 140
Concord, CA 94520
p: 925/246-6419 f: 925/246-6495

LICENSED ARCHITECT STATE OF CALIFORNIA RENEE M. TRIMBLE No. C-24885

INFRASTRUCTURE DESIGN ASSOCIATES
1440 Broadway
Suite 304
Oakland, CA 94612

COMMUNICATIONS NETWORKING INSTALLATION BICSI

EXPIRES 12/31/06
Regis. No. 06606
SIGNATURE

consultant

name
address
city, state, zip
ph: fx:

DERIVATION STAMP
DIV. OF THE STATE ARCHITECT
OFFICE OF REGULATION SERVICES
APP. 01/14/2004
BY
DATE 1-13-05

SCIENCE BUILDING
LOS MEDANOS COLLEGE

Contra Costa Community College District

owner

tBP project number : 20247.00
file name:
drawn by: checked by:
date: NOVEMBER 15, 2004

1/2" = 1'-0"

drawing title: ENLARGED PLANS BDF/IDF 1.0 (ROOM 151)
building no:
LMC SCIENCE 313-023-112.01-0-00.00
drawing no: T3-1
drawing of

G:\Los Medanos College\Science Building\BID Set\vicad\T3-1.dwg 11-08-04 10:14:59 AM cmendoza

S. J. AMOROSO
Request For Information/Clarification

DSA FILE NO. 7-C1
DSA APPL. No. 01-106226

To: IBI/Architecture
1000 Burnett Ave, Suite 140
Concord, CA 94520

Attn: Celia Chiang, Tom Beckett
Fax: 925-246-6485

Project: LOS MEDANOS COLLEGE
SCIENCE BUILDING
Contra Costa Community College District

IBI ph: 20247.00

Subj.: Plywood Mounted to Room 209 North Wall

RFI No: **405**
Subcontractor RFI: EWS 53

Reference (dwg, spec.): T3-2, T4-2

Reply Requested By: 10/30/06

INFORMATION REQUESTED: Date: 10/23/06

Please note the attached EWS RFI No. 53 regarding Mounted Plywood on the North wall of the Data Room 209. Please advise.

SUGGESTED SOLUTION:
Cost Impact: ☐ Schedule Impact: ☐ days By: Mark Delgado

RESPONSE: DATE:

See attached IDA memo for response of this RFI.

Vanessa Ling/IBP - 10/26/06

RFI # 000
Page 1

EDWARD W. SCOTT ELECTRIC CO., INC.
435 HARRIET STREET
San Francisco, CA 94103-4914
Phone: (415) 626-0701 Fax: (415) 626-2837

REQUEST FOR INFORMATION

PROJECT: LMC SITE IMPROVEMENT R.F.I.# 53 R.F.I. Date 10/13/06
JOB: 2468 ACTUAL REPLY DATE

TO: MARK DEGGARO
OF: AMOROSO CHRIST
REF.DWG: T3-2, T4-2
LOCATION: 2nd FL DATA RM. 209

POTENTIAL COST IMPACT:
___ COST ___ SCHEDULE
___ OTHER ___ LABOR
___ NO IMPACT ___ MATERIAL

INFORMATION REQUESTED: THE NORTH WALL OF DATA RM. 209 IS A PLYWOOD WALL SET BACK 7'-3" FROM A SMALL PLYWOOD MOUNTED TO IT WHAT IS THE PLYWOOD ATTACHED TO? NOTE THAT METAL X-ON T3-2 BRACE THE PLYWOOD WALL CHANNEL SUPPORT GRID RACKS IS TAGGED ON T4-2 WALL PLEASE REVIEW AND REPLY

REPLY REQUIRED BY: 10/31/06 SIGNED: [signature]
NOTE: IF NO REPLY IS RECEIVED BY US BY THE ABOVE NOTED DATE, A TIME EXTENSION WILL BE REQUIRED WITHOUT ANY COST IMPACTS.

RESPONSE:

DATED: SIGNED:

INDUSTRIAL, COMMERCIAL WIRING & DESIGN
STATE CONTRACTOR'S LICENSE NO. 190426

M500019

INFRASTRUCTURE DESIGN ASSOCIATES, Inc.

Date: 25 October 2006

To: Vanessa Ling
IBI Architecture
1000 Burnett Avenue, Suite 140
Concord, CA 94520
925-246-6419

From: David Buza
Infrastructure Design Associates
1440 Broadway, Suite 304
Oakland, CA 94612
510.238.8002

Project Name: Los Medanos College – Science Building
Regarding: RFI 405 – T3-2 Room 209.

Total Pgs Transmitted: 1 ☐ Federal Express ☐ Fax ☐ Mail ☐ Hand Deliver ☐ UPS ☒ Email
We are sending the enclosed: ☒ By your request ☐ For your use ☐ For your review ☐ For your records

Vanessa Ling,

IDA has resolved the issue by adding an additional piece of "Double U Channel" right before the window, and mounting that to the West and East walls. This removes the need to mount to the north wall, instead the "filler" relieves the need to mount the plywood backboard to the north wall of room 209. Please see the attached sketch for further clarification.

If you have any questions, please call me at 510.238.8002 or e-mail at dbuza@infrastruct.com.


Sincerely,

David L. Buza
Office : 510.238.8002
Cell : 510.755.5425

IDA • 1440 Broadway, Suite 304 • Oakland, California 94612 • T: 510.238.8000 • F: 510.238.8009

KEY NOTES

6. FIVE HOLE TEE GUSSET PLATE FITTING OF QUARTER-INCH STEEL PLATE WITH FIVE 9/16-INCH DIAMETER HOLES FOR CONNECTING TWO RUNS OF "U" CHANNEL WITH FIVE 3/4-1/2 HEX HEAD BOLTS, LOCK WASHERS AND FIVE 9/-13 SPRING NUTS. (TYPICAL)

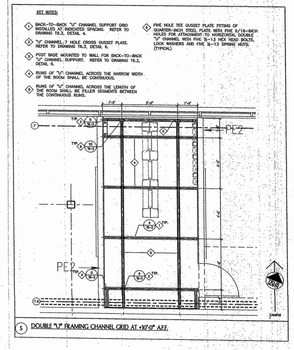

PE2
PE2
PE2

6 STARLINE BUSWAY AT +8'-2" A.F.F. (PROVIDED BY ELECTRICAL)

GRAPHIC SCALE: 1/2" = 1'-0"

KEY NOTES:

1. END POWER FEED UNIT – 60 AMP, 4 POLE WITH GROUND. (PROVIDED AND INSTALLED BY ELECTRICAL, SHOWN FOR CLARIFICATION)
2. PLUG-IN BUSWAY STRAIGHT SECTION AT +8'-2" A.F.F. 50 LB TOTAL OPERATING WEIGHT. (PROVIDED AND INSTALLED BY ELECTRICAL, SHOWN FOR CLARIFICATION).
3. SUPPORT ASSEMBLY TO SUSPEND BUSWAY FROM BACK-TO-BACK "U" CHANNEL GRID ABOVE. (PROVIDED AND INSTALLED BY ELECTRICAL, SHOWN FOR CLARIFICATION)
4. BUSWAY END CAP. (PROVIDED AND INSTALLED BY ELECTRICAL, SHOWN FOR CLARIFICATION)

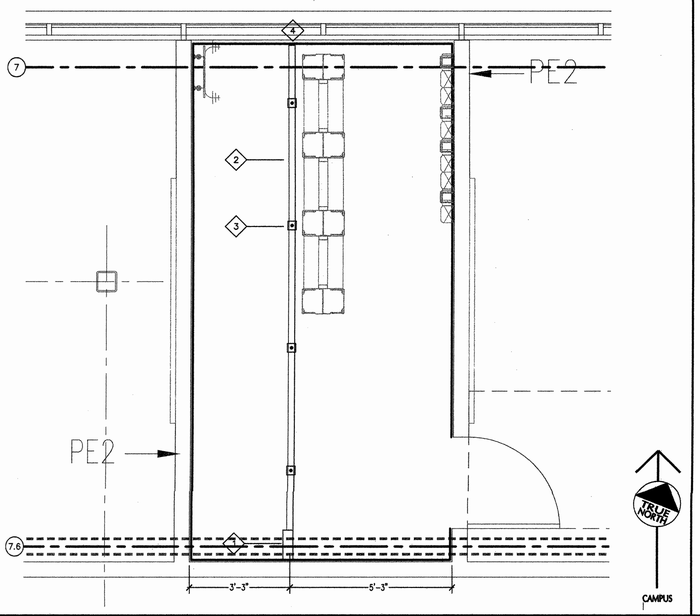


4 15" CABLE RUNWAY AT +8'-9" A.F.F.

GRAPHIC SCALE: 1/2" = 1'-0"

KEY NOTES:

1. 15" STEEL CABLE RUNWAY AT +8'-9" A.F.F.
2. RUNWAY WALL SUPPORT KIT WITH "J" BOLTS TO ATTACH 15" CABLE RUNWAY STRINGERS.
3. SLOTTED RUNWAY SUPPORT KIT USED TO SUSPEND CABLE RUNWAY FROM $\frac{5}{8}$" THREADED ROD.
4. DIAGONAL BRACES AND ROD STIFFENER ASSEMBLY TO SUSPEND CABLE RUNWAY FROM SLAB ABOVE.
5. DROP-OUT FITTING.
6. PROVIDE 4" OF CLEARANCE BETWEEN CABLE RUNWAY AND WALLS WHERE INDICATED.
7. #6 AWG STRANDED COPPER WITH GREEN SHEATH INSULATION FROM ONE SEGMENT OF THE +8'-9" CABLE RUNWAY TO THE GROUND BAR IN THE ROOM. TERMINATE THE #6 AWG CABLE IN A TWO-BOLT COMPRESSION LUG CONNECTOR ON THE COPPER GROUND BAR AND IN AN APPROVED GROUND WIRE TERMINAL ON THE CABLE RUNWAY.
8. LOADING CAPACITY FOR CABLE TRAY IS 26 LBS PER LINEAL FOOT. CONTRACTOR SHALL PROVIDE SIGNAGE AT 4' INTERVALS TO INDICATE LOADING CAPACITY.
9. ARROW ⟶ INDICATES LOCATION AND DIRECTION OF STRUCTURAL BRACING. REFER TO SHEET T6-3 FOR TRAPEZE ASSEMBLY BRACING DETAILS.

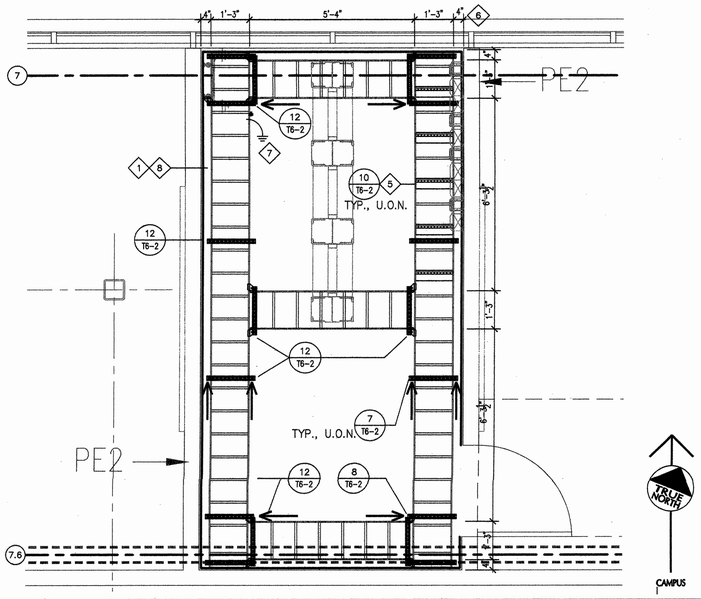


2 12" STEEL WIRE CABLE TRAY AT +7'-2" A.F.F

GRAPHIC SCALE: 1/2" = 1'-0"

KEY NOTES:

1. 12" X 2" STEEL WIRE CABLE TRAY, ELECTRO-PLATED ZINC GALVANIZING, MOUNTED HORIZONTALLY AT +7'-2" A.F.F.
2. PROVIDE 4" OF CLEARANCE BETWEEN CABLE TRAYS AND WALLS WHERE INDICATED.
3. #6 AWG STRANDED COPPER WITH GREEN SHEATH INSULATION FROM ONE SEGMENT OF THE +7'-2" STEEL WIRE CABLE TRAY TO THE GROUND BAR IN THE ROOM. TERMINATE THE #6 AWG CABLE IN A TWO-BOLT COMPRESSION LUG CONNECTOR ON THE COPPER GROUND BAR AND IN AN APPROVED GROUND WIRE TERMINAL ON THE STEEL WIRE CABLE TRAY.
4. PROVIDE CUTOUTS AND DROPOUT FITTINGS IN LOWER LEVEL OF STEEL WIRE CABLE TRAY ABOVE THE WALL MOUNTED BACKBOARDS AND ABOVE THE DOUBLE SIDED VERTICAL CABLE MANAGERS.
5. ATTACH THE STEEL WIRE CABLE TRAY TO EACH "U" CHANNEL TRAPEZE ASSEMBLY AT LOCATIONS INDICATED WITH TWO SPRING NUTS $\frac{3}{4}$"-20, TWO HOLD DOWN BEAM CLAMPS $1\frac{3}{8}$" AND TWO $\frac{3}{4}$"-20 HEX HEAD BOLTS.
6. LOADING CAPACITY FOR CABLE TRAY IS 26 LBS PER LINEAL FOOT. CONTRACTOR SHALL PROVIDE SIGNAGE AT 4' INTERVALS TO INDICATE LOADING CAPACITY.
7. ARROW ⟶ INDICATES LOCATION AND DIRECTION OF STRUCTURAL BRACING. REFER TO SHEET T6-3 FOR TRAPEZE ASSEMBLY BRACING DETAILS.

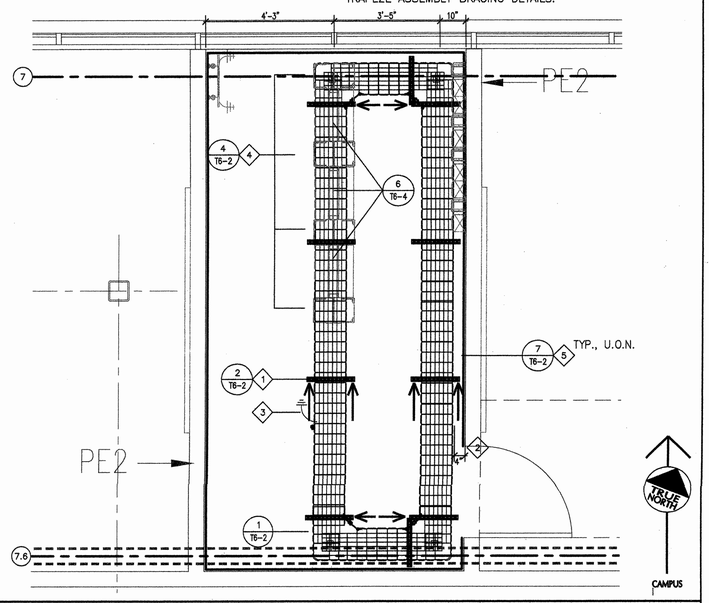


5 DOUBLE "U" FRAMING CHANNEL GRID AT +10'-0" A.F.F.

GRAPHIC SCALE: 1/2" = 1'-0"

KEY NOTES:

1. BACK-TO-BACK "U" CHANNEL SUPPORT GRID INSTALLED AT INDICATED SPACING. REFER TO DRAWING T6.3, DETAIL 4.
2. "U" CHANNEL 7 HOLE CROSS GUSSET PLATE. REFER TO DRAWING T6.3, DETAIL 6.
3. POST BASE MOUNTED TO WALL FOR BACK-TO-BACK "U" CHANNEL SUPPORT. REFER TO DRAWING T6.3, DETAIL 5.
4. RUNS OF "U" CHANNEL ACROSS THE NARROW WIDTH OF THE ROOM SHALL BE CONTINUOUS.
5. RUNS OF "U" CHANNEL ACROSS THE LENGTH OF THE ROOM SHALL BE FILLER SEGMENTS BETWEEN THE CONTINUOUS RUNS.

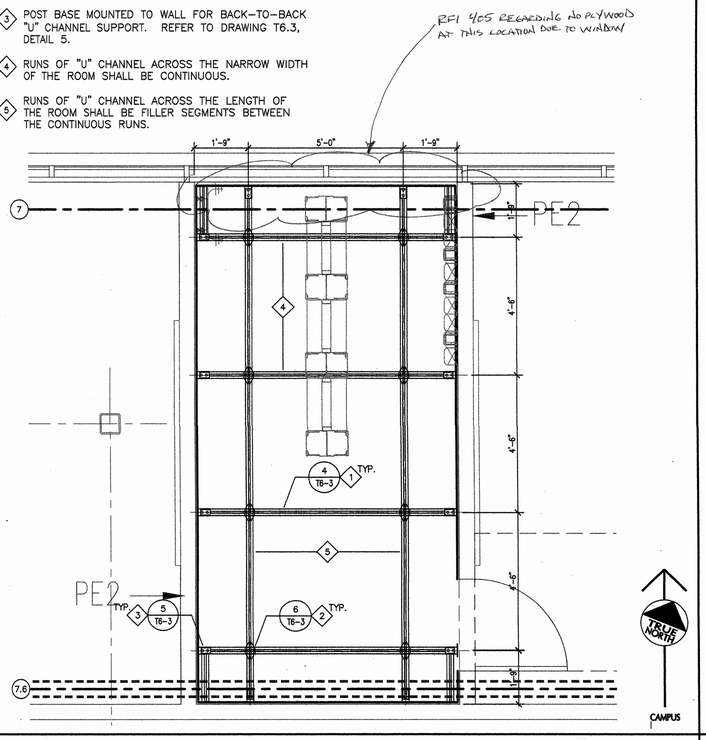


3 FIBER GUIDE AT +7'-6" A.F.F.

GRAPHIC SCALE: 1/2" = 1'-0"

KEY NOTES:

1. FIBER OPTIC PATCH CABLE TROUGH 4" STRAIGHT SECTION.
2. FIBER OPTIC PATCH CABLE TROUGH 4" END CAP.
3. FIBER OPTIC PATCH CABLE TROUGH 4" DOWNSPOUT.
4. FIBER OPTIC PATCH CABLE TROUGH 2" DOWNSPOUT INSERT INSIDE 4" DOWNSPOUT.
5. CONNECT DOWNSPOUT INSIDE OF 2" VERTICAL SLOTTED DUCT KIT ATTACHED TO RACK VERTICAL CABLE MANAGER BELOW.
6. POSITION THE 2" VERTICAL SLOTTED DUCT IN THE FORWARD RIGHT CORNER OF THE VERTICAL CABLE MANAGER AND SECURE ON 18" CENTERS WITH MOUNTING BRACKETS. DUCT MUST RUN ENTIRE LENGTH OF THE VERTICAL CABLE MANAGER.
7. USE THREADED ROD ATTACHMENT BRACKETS TO SUPPORT 4" FIBER GUIDE AT +7'-6" FROM "U" CHANNEL ABOVE. USE WHERE INDICATION ARROW IS SHOWN.

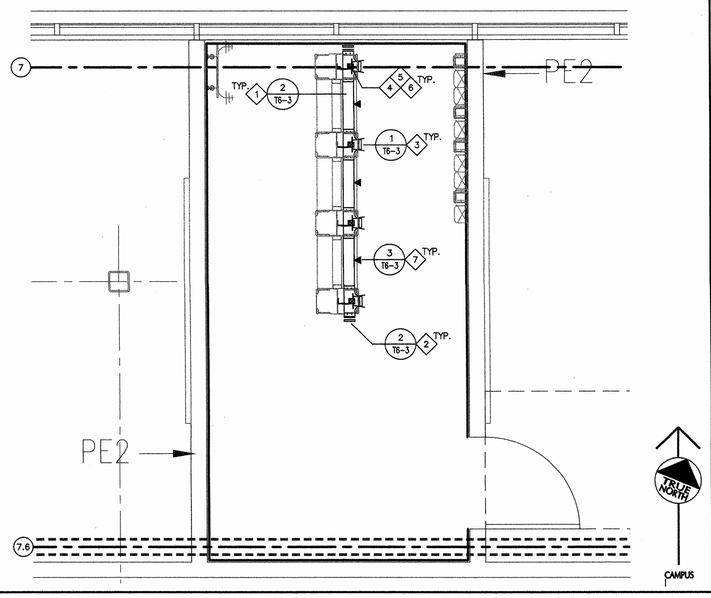


1 IDF 2.0 FLOOR PLAN

GRAPHIC SCALE: 1/2" = 1'-0"

KEY NOTES:

1. 19" X 84" SELF-SUPPORTING ALUMINUM, UL LISTED EQUIPMENT RACK WITH DOUBLE SIDED VERTICAL CABLE MANAGER ON BOTH SIDES AND 6" HORIZONTAL RING PANELS.
2. $\frac{3}{4}$" TREATED FIRE RESISTANT PLYWOOD FROM +0'-6" A.F.F. TO +10'-6" A.F.F., PROVIDED AND INSTALLED BY ELECTRICAL.
3. 20" X 4" COPPER GROUND BUS BAR, PROVIDED AND INSTALLED BY ELECTRICAL.
4. KRONE TRUENET TERMINATION BLOCKS, WALL-MOUNTED FOR TELEPHONE AND DATA STATION CABLING. REFER TO T4-2 FOR WALL ELEVATION.
5. 2-4" CONDUITS FROM FIRST FLOOR DATA ROOM, PROVIDED AND INSTALLED BY ELECTRICAL. DIMENSIONS SHOWN FOR COORDINATION.

NOTE: TRIATEK COMPUTER IN THIS ROOM PER RFI 493

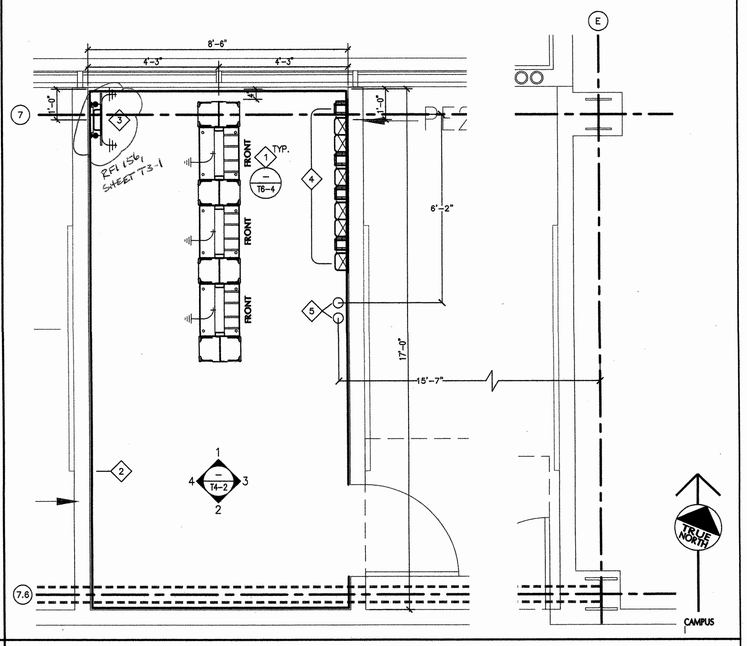

tBP
architecture
planning
interiors
management

tBP/architecture
1000 Burnett Avenue, Suite 140
Concord, CA 94520
p: 925.466.6419 f: 925.466.6495

INFRASTRUCTURE DESIGN ASSOCIATES
1440 Broadway
Suite 304
Oakland, CA 94612

consultant

name
address
city, state, zip
ph: fx:

IDENTIFICATION STAMP
OFFICE OF REGIONAL SERVICES
APP. • 01/06/06
RC
DATE

SCIENCE BUILDING
LOS MEDANOS COLLEGE

Contra Costa Community College District

owner

tBP project number :	20247.00
file name:	
drawn by:	checked by:
date:	NOVEMBER 15, 2004

1/2" = 1'-0"


drawing title: IDF 2.0 (ROOM 209)

building no: LMC SCIENCE 313-023-T12.01-0-00.00

drawing no: T3-2

drawing of

C:\Los Medanos College\Science Building\BID Set\acad\T3-2.dwg 11-08-04 10:10:50 AM cmendoza

 

1 BACK OF RACKS

INFRASTRUCTURE DESIGN ASSOCIATES
1440 Broadway
Suite 304
Oakland, CA. 94612
Ph: (510) 238-8000
Fax: (510) 238-8009

EXPIRES 12/31/05
Regis. No. 05229
SIGNATURE

ELEVATIONS - WALL & RACK - BDF/IDF 1.0 (ROOM 151)

SCIENCE BUILDING
LOS MEDANOS COLLEGE
Pittsburg, CA
Contra Costa Community College District
ARCHITECT
tBP/Architecture
1000 Bunnett Ave, Suite 140
Concord, CA 94520
p: 925.246.6419 f: 925.246.6495

tBP

LICENSED ARCHITECT RICHARD E. MARDIAN R.A. NO. C-8685 REN. 12-31-05 STATE OF CALIFORNIA

ADDENDUM	#2
DATE:	05/11/05
DSA NO.	01-106226
THIS REVISES IN PART	
SHEET:	T4.1
SHEET:	SKT-20

1 FRONT OF RACKS

INFRASTRUCTURE DESIGN ASSOCIATES
1440 Broadway
Suite 304
Oakland, CA. 94612
Ph: (510) 238-8000
Fax: (510) 238-8009

EXPIRES 12/31/05
Regis. No. 05229
SIGNATURE


ELEVATIONS - WALL & RACK - BDF/IDF 1.0 (ROOM 151)

SCIENCE BUILDING
LOS MEDANOS COLLEGE
Pittsburg, CA
Contra Costa Community College District
ARCHITECT
tBP/Architecture
1000 Bunnett Ave, Suite 140
Concord, CA 94520
p: 925.246.6419 f: 925.246.6495

tBP

LICENSED ARCHITECT RICHARD E. MARDIAN R.A. NO. C-8685 REN. 12-31-05 STATE OF CALIFORNIA

ADDENDUM	#2
DATE:	05/11/05
DSA NO.	01-106226
THIS REVISES IN PART	
SHEET:	T4.1
SHEET:	SKT-21

 

1 WEST WALL

INFRASTRUCTURE DESIGN ASSOCIATES
1440 Broadway
Suite 304
Oakland, CA. 94612
Ph: (510) 238-8000
Fax: (510) 238-8009

EXPIRES 12/31/05
Regis. No. 05229
SIGNATURE

ELEVATIONS - WALL & RACK - BDF/IDF 1.0 (ROOM 151)

SCIENCE BUILDING
LOS MEDANOS COLLEGE
Pittsburg, CA
Contra Costa Community College District
ARCHITECT
tBP/Architecture
1000 Bunnett Ave, Suite 140
Concord, CA 94520
p: 925.246.6419 f: 925.246.6495

tBP

LICENSED ARCHITECT RICHARD E. MARDIAN R.A. NO. C-8685 REN. 12-31-05 STATE OF CALIFORNIA

ADDENDUM	#2
DATE:	05/11/05
DSA NO.	01-106226
THIS REVISES IN PART	
SHEET:	T4.1
SHEET:	SKT-22

IDENTIFICATION STAMP
DIV. OF THE STATE ARCHITECT
OFFICE OF REGULATORY SERVICES
APP'L NO. 01-106226
AC. ____ FLS ____ SS ____
DATE ____
R&E No 7/01

Division of the State Architect
Regional Office
1515 Clay St, Suite 1201
Oakland, CA 94612
p: 415-396-9500 f:

agency

consultant

tBP/Architecture
1000 Bunnett Avenue, Suite 140
Concord, CA 94520
p: 925.246.6419 f: 925.246.6495

architect

LICENSED ARCHITECT RICHARD E. MARDIAN R.A. NO. C-8685 REN. 12-31-05 STATE OF CALIFORNIA

SCIENCE BUILDING
LOS MEDANOS COLLEGE
Contra Costa Community College District

owner


tBP project number : 20241.00
file name:
drawn by: checked by:
date: NOVEMBER 15, 2004

Rev:	date:	description:

ADDENDUM #2 DRAWINGS

ATTACHMENT TO T4-1

Los Medanos College
4CD Proj.# : L-565-B-23-SC
Science Building

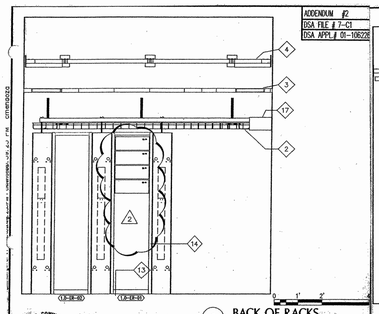

1 BACK OF RACKS

INFRASTRUCTURE DESIGN ASSOCIATES
1440 Broadway
Suite 304
Oakland, CA 94612
Ph: (510) 238-8000
Fax: (510) 238-8009


EXPIRES 12/31/05
Regis. No. 05229
SIGNATURE

ELEVATIONS - WALL & RACK - BDF/IDF 1.0 (ROOM 151)

ADDENDUM #2
DSA FILE # 7-C1
DSA APPL.# 01-106226

SCIENCE BUILDING
LOS MEDANOS COLLEGE
Pittsburg CA
Contra Costa Community College District

ADDENDUM #2
DATE: 05/11/05
DSA NO.: 01-106226
THIS REVISES IN PART
SHEET: TA1
SHEET: SKT-20

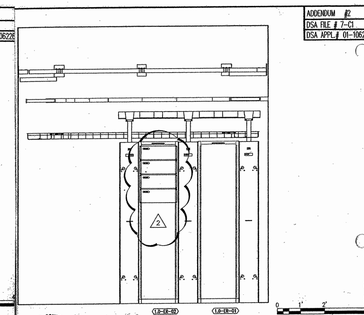

1 FRONT OF RACKS

INFRASTRUCTURE DESIGN ASSOCIATES
1440 Broadway
Suite 304
Oakland, CA 94612
Ph: (510) 238-8000
Fax: (510) 238-8009


EXPIRES 12/31/05
Regis. No. 05229
SIGNATURE

ELEVATIONS - WALL & RACK - BDF/IDF 1.0 (ROOM 151)

ADDENDUM #2
DSA FILE # 7-C1
DSA APPL.# 01-106226

SCIENCE BUILDING
LOS MEDANOS COLLEGE
Pittsburg CA
Contra Costa Community College District

ADDENDUM #2
DATE: 05/11/05
DSA NO.: 01-106226
THIS REVISES IN PART
SHEET: TA1
SHEET: SKT-21

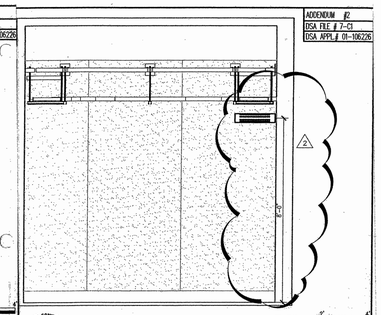

1 WEST WALL

INFRASTRUCTURE DESIGN ASSOCIATES
1440 Broadway
Suite 304
Oakland, CA 94612
Ph: (510) 238-8000
Fax: (510) 238-8009

EXPIRES 12/31/05
Regis. No. 05229
SIGNATURE


ELEVATIONS - WALL & RACK - BDF/IDF 1.0 (ROOM 151)

ADDENDUM #2
DSA FILE # 7-C1
DSA APPL.# 01-106226

SCIENCE BUILDING
LOS MEDANOS COLLEGE
Pittsburg CA
Contra Costa Community College District

ADDENDUM #2
DATE: 05/11/05
DSA NO.: 01-106226
THIS REVISES IN PART
SHEET: TA1
SHEET: SKT-22


Los Medanos College
4CD Proj.# : L-565-B-23-SC
Science Building

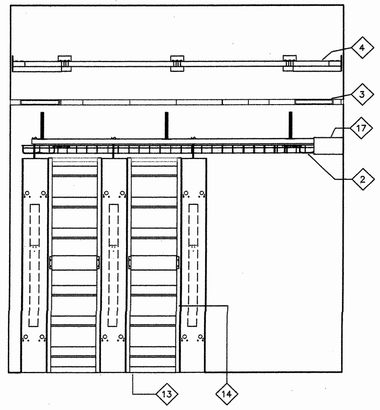

SEE SKETCH SKT-20

6 BACK OF RACKS


GRAPHIC SCALE: 1/2" = 1'-0"

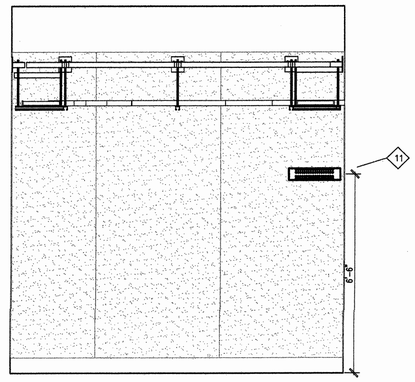

SEE SKETCH SKT-22


4 WEST WALL

GRAPHIC SCALE: 1/2" = 1'-0"

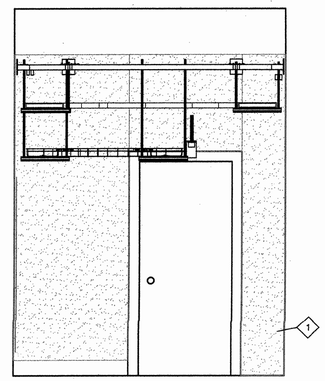

2 SOUTH WALL


GRAPHIC SCALE: 1/2" = 1'-0"

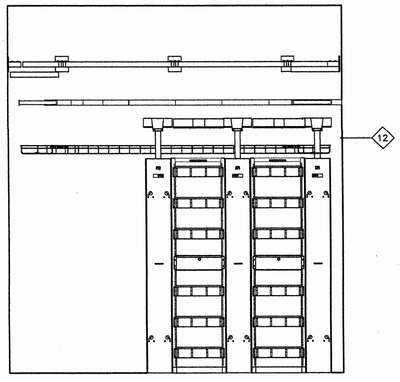

SEE SKETCH SKT-21


5 FRONT OF RACKS

GRAPHIC SCALE: 1/2" = 1'-0"

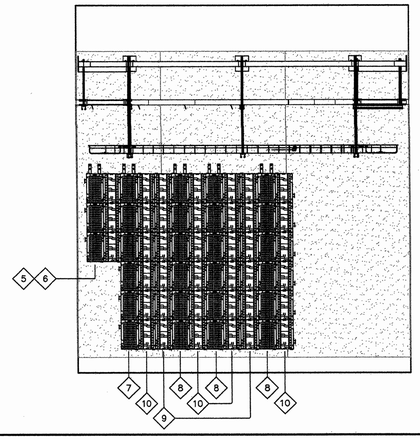

3 EAST WALL

GRAPHIC SCALE: 1/2" = 1'-0"

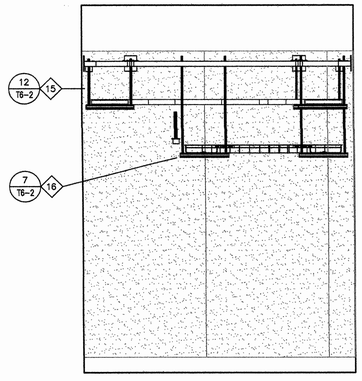

1 NORTH WALL

GRAPHIC SCALE: 1/2" = 1'-0"

KEY NOTES

1. ¾" TREATED FIRE RESISTANT PLYWOOD (PROVIDED AND INSTALLED BY ELECTRICAL) FROM +0'-6" A.F.F. TO +10'-6" A.F.F. (TYPICAL)
2. 12" X 2" STEEL WIRE CABLE TRAY AT +7'-2" A.F.F. (TYPICAL)
3. 15" CABLE LADDER AT +8'-9" A.F.F. (TYPICAL)
4. "U" CHANNEL SUPPORT GRID @ +10'-0" A.F.F. (TYPICAL)
5. KRONE TERMINAL BLOCKS AND VERTICAL CABLE MANAGERS SHALL BE MOUNTED TO PLYWOOD BACKBOARDS WITH ⅜" X 1¼" HEX HEAD BOLTS. DRYWALL SCREWS NOT PERMITTED. (TYPICAL)
6. KRONE TERMINAL BLOCKS. (36) 8-PAIR ULTIM8 BLOCKS STACKED VERTICALLY FOR TERMINATION OF TELEPHONE BACKBONE CABLE.
7. KRONE TERMINAL BLOCKS. (72) 8-PAIR ULTIM8 BLOCKS STACKED VERTICALLY FOR TERMINATION OF UP TO 144 TELEPHONE STATION CABLES PER COLUMN.
8. KRONE TERMINAL BLOCKS. (72) 8-PAIR ULTIM8 BLOCKS STACKED VERTICALLY IN ONE COLUMN. FOR TERMINATION OF UP TO 144 NETWORK STATION CABLES PER COLUMN.
9. KRONE VERTICAL WIRE MANAGER TO BE USED TO ROUTE (2) BUNDLES OF 72 STATION CABLES TO ADJACENT COLUMNS ON RIGHT.
10. KRONE VERTICAL WIRE MANAGERS. HOLD CLEAR. TO BE USED FOR INNERCONNECT CABLES PROVIDED AND INSTALLED BY OTHERS.
11. 20" X 4" COPPER GROUND BUS BAR PROVIDED AND INSTALLED BY ELECTRICAL. MOUNT AT +6'-6" A.F.F.
12. FIBER OPTIC SLOTTED DUCT KIT, 8' LONG WITH COVER. CONNECT 2" VERTICAL DUCT TO DOWNSPOUT INSERT FITTING AND LOCATE IN CENTER FRONT OF VERTICAL RACK CABLING SECTION.
13. 19" X 84" EQUIPMENT RACK. REFER TO DETAIL SHEET T6-4.
14. APC POWER DISTRIBUTION UNIT, WHITE, 4'-0", 3 WIRE 1 CIRCUIT STRIP WITH 24 SINGLE OUTLETS. MOUNTED TO BACK SIDE OF VERTICAL RACK CABLING SECTION. PLUG STRIP SHALL HAVE A POWER CORD WITH A NEMA L5-20 PLUG FOR CONNECTION TO OVERHEAD ELECTRICAL BUSWAY SYSTEM INSTALLED BY OTHERS. APC POWER DISTRIBUTION UNIT – AP7620.
15. "U" FRAMING CHANNEL SINGLE TRAPEZE ASSEMBLY, TYPICAL. REFER TO DETAIL SHEET T6-2.
16. "U" FRAMING CHANNEL DOUBLE TRAPEZE ASSEMBLY, TYPICAL. REFER TO DETAIL SHEET T6-2.
17. STARLINE BUSWAY SYSTEM, TYPICAL, PROVIDED AND INSTALLED BY ELECTRICAL. SHOWN FOR REFERENCE ONLY.

tBP
architecture
planning
interiors
management

LICENSED ARCHITECT RICHARD A. SCHWARZ No. C-14600 STATE OF CALIFORNIA

tBP/Architecture
1000 Bunett Avenue, Suite 140
Concord, CA 94520
p: 925.246.6449 f: 925.246.6495

INFRASTRUCTURE DESIGN ASSOCIATES
1440 Broadway
Suite 304
Oakland, CA 94612

BKSF ARCHITECTURE COMMUNICATIONS ENGINEERING

EXPIRES 12/31/06
Regis. No. 08606
SIGNATURE

consultant

IDENTIFICATION STAMP OF THE STATE ARCHITECT OR ENGINEER-IN-RESPONSIBLE CHARGE
APR. - 6 '06
DATE 1-15-05

name
address
city, state, zip
ph:
fx:

SCIENCE BUILDING
LOS MEDANOS COLLEGE

Contra Costa Community College District


owner


tBP project number : 20247.00
file name:
drawn by: checked by:
date: NOVEMBER 15, 2004

1/2"=1'-0"

drawing title: ELEVATIONS - WALL & RACK - BDF/IDF 1.0 (ROOM 151)
building no:
LMC SCIENCE 313-023-T12.01-0-00.00
drawing no: T4-1
drawing of

\Los Medanos College\Science Building\BID Set\acad\T4-1.dwg 11-08-04 JP 08:26 AM cmendoza

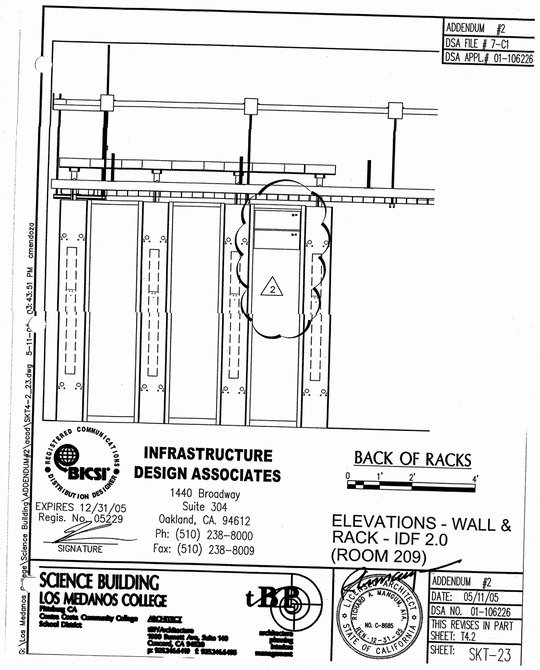

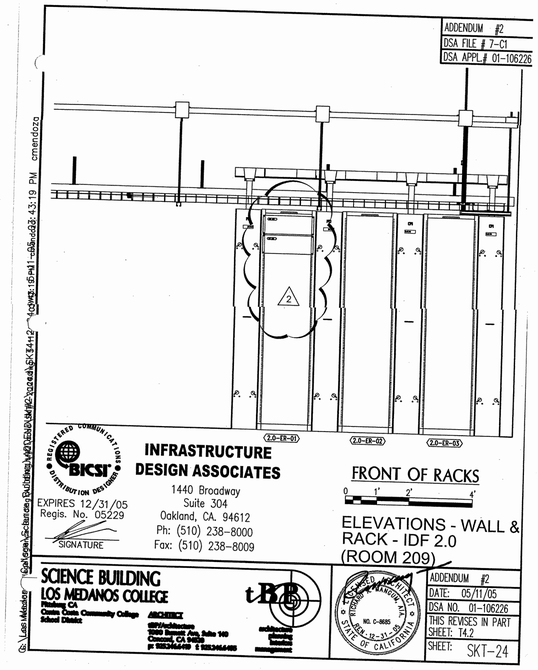

tBP/Architecture
1000 Bunnett Avenue, Suite 140
Concord, CA 94520
p: 925.246.6419 f: 925.246.6495

architecture
planning
interiors
management

architect

consultant

REVIEWED FOR CODE COMPLIANCE
DIV. OF THE STATE ARCHITECT
OFFICE OF REGULATORY SERVICES
APP. NO. 01-106226
AC. FLS. SS.
DATE

Division of the State Architect
Regional Office
1515 Clay St., Suite 1201
Oakland, CA 94612
p: 415.396.9500 f:

agency

SCIENCE BUILDING
LOS MEDANOS COLLEGE

Contra Costa Community College District

owner

tBP project number : 20241.00

file name:


drawn by: checked by:

date: NOVEMBER 15, 2004

Rev:	date:	description:

drawing title:
ADDENDUM # 2 DRAWINGS

LMC SCIENCE 313-023-T12.01-0-00.00
drawing no.:
ATTACHMENT TO T4-2

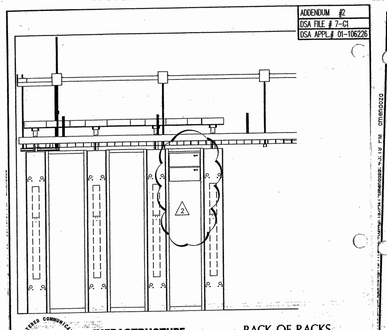

BACK OF RACKS

0 1' 2' 4'

INFRASTRUCTURE DESIGN ASSOCIATES
1440 Broadway
Suite 304
Oakland, CA 94612
Ph: (510) 238-8000
Fax: (510) 238-8009

EXPIRES 12/31/05
Regis. No. 05229
SIGNATURE


ELEVATIONS - WALL & RACK - IDF 2.0 (ROOM 209)

ADDENDUM #2
DSA FILE # 7-C1
DSA APPL.# 01-106226

SCIENCE BUILDING
LOS MEDANOS COLLEGE
Pittsburg, CA
Contra Costa Community College District

ARCHITECT
tBP

ADDENDUM #2
DATE: 05/11/05
DSA NO.: 01-106226
THIS REVISES IN PART
SHEET: TA.2
SHEET: SKT-23

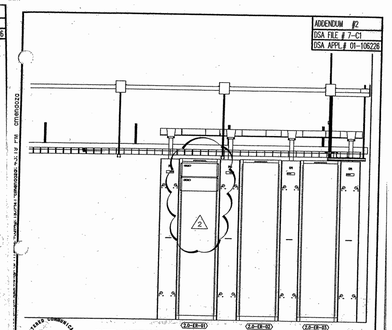

FRONT OF RACKS

0 1' 2' 4'

INFRASTRUCTURE DESIGN ASSOCIATES
1440 Broadway
Suite 304
Oakland, CA 94612
Ph: (510) 238-8000
Fax: (510) 238-8009

EXPIRES 12/31/05
Regis. No. 05229
SIGNATURE


ELEVATIONS - WALL & RACK - IDF 2.0 (ROOM 209)

ADDENDUM #2
DSA FILE # 7-C1
DSA APPL.# 01-106226

SCIENCE BUILDING
LOS MEDANOS COLLEGE
Pittsburg, CA
Contra Costa Community College District

ARCHITECT
tBP


ADDENDUM #2
DATE: 05/11/05
DSA NO.: 01-106226
THIS REVISES IN PART
SHEET: TA.2
SHEET: SKT-24

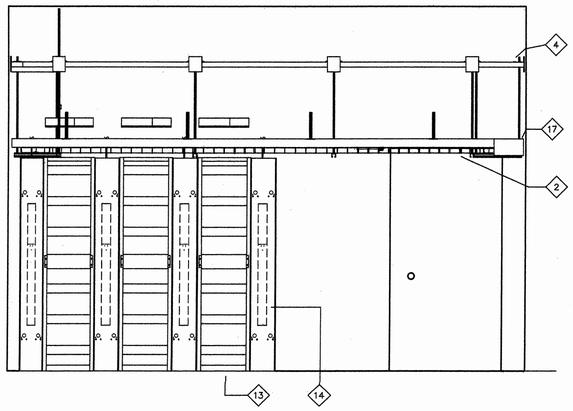

SEE SKETCH SKT-23


6 BACK OF RACKS

GRAPHIC SCALE: 1/2" = 1'-0"

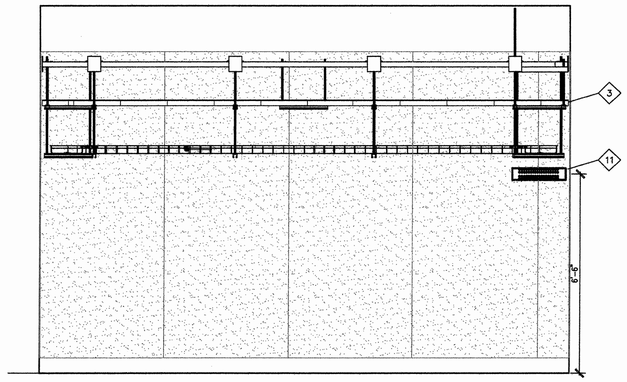


4 WEST WALL

GRAPHIC SCALE: 1/2" = 1'-0"

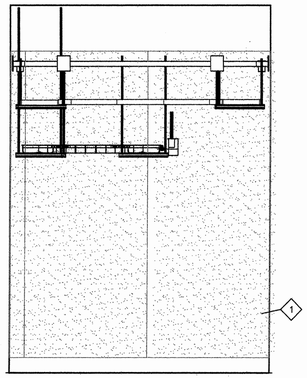

2 SOUTH WALL


GRAPHIC SCALE: 1/2" = 1'-0"

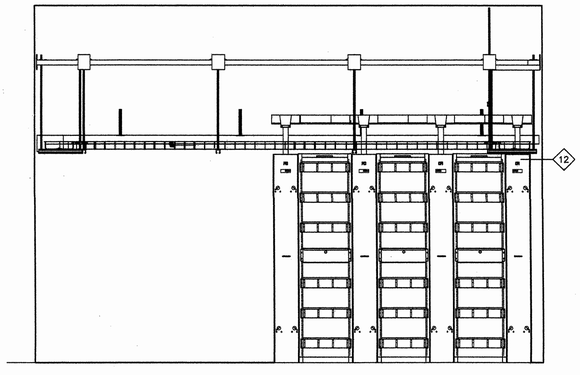

SEE SKETCH SKT-24


5 FRONT OF RACKS

GRAPHIC SCALE: 1/2" = 1'-0"

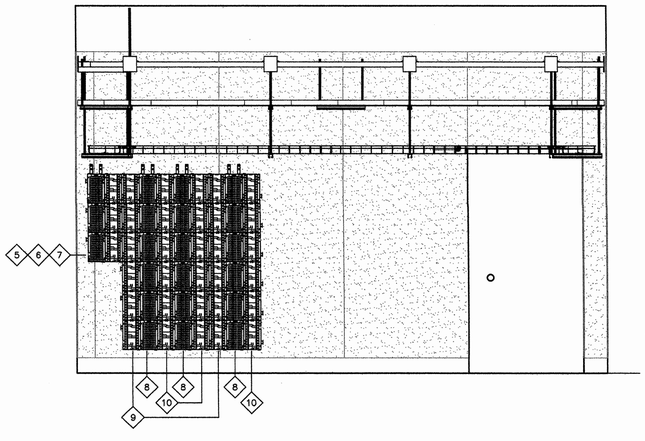

3 EAST WALL

GRAPHIC SCALE: 1/2" = 1'-0"

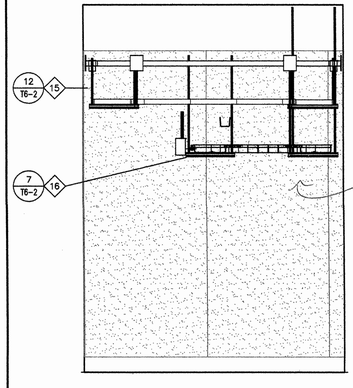

SEE EF1405, SHEET T3-2
(ALSO DTL 5/T3-2)

1 NORTH WALL

GRAPHIC SCALE: 1/2" = 1'-0"

KEY NOTES

1. ¾" TREATED FIRE RESISTANT PLYWOOD (PROVIDED AND INSTALLED BY ELECTRICAL)FROM +0'-6" A.F.F. TO +10'-6" A.F.F. (TYPICAL)
2. 12" X 2" STEEL WIRE CABLE TRAY AT +7'-2" A.F.F. (TYPICAL)
3. 15" CABLE LADDER AT +8'-9" A.F.F. (TYPICAL)
4. "U" CHANNEL SUPPORT GRID @ +10'-0" A.F.F. (TYPICAL)
5. KRONE TERMINAL BLOCKS AND VERTICAL CABLE MANAGERS SHALL BE MOUNTED TO PLYWOOD BACKBOARDS WITH ⅜" X 1½" HEX HEAD BOLTS. DRYWALL SCREWS NOT PERMITTED. (TYPICAL)
6. KRONE TERMINAL BLOCKS. (36) 8-PAIR ULTIM8 BLOCKS STACKED VERTICALLY FOR TERMINATION OF TELEPHONE BACKBONE CABLE. TERMINATE TELEPHONE BACKBONE CABLE ON ROWS 1-13.
7. KRONE TERMINAL BLOCKS. (36) 8-PAIR ULTIM8 BLOCKS STACKED VERTICALLY FOR TERMINATION OF TELEPHONE STATION CABLES. TERMINATE TELEPHONE STATION CABLES ON ROWS 14-36.
8. KRONE TERMINAL BLOCKS. (72) 8-PAIR ULTIM8 BLOCKS STACKED VERTICALLY IN ONE COLUMN. FOR TERMINATION OF UP TO 144 NETWORK STATION CABLES PER COLUMN.
9. KRONE VERTICAL WIRE MANAGER TO BE USED TO ROUTE (2) BUNDLES OF 72 STATION CABLES TO ADJACENT COLUMNS RIGHT.
10. KRONE VERTICAL WIRE MANAGERS. HOLD CLEAR. TO BE USED FOR INNERCONNECT CABLES PROVIDED AND INSTALLED BY OTHERS.
11. 20" X 4" COPPER GROUND BUS BAR, PROVIDED AND INSTALLED BY ELECTRICAL.
12. FIBER OPTIC SLOTTED DUCT KIT, 8' LONG WITH COVER. CONNECT 2" VERTICAL DUCT TO DOWNSPOUT INSERT FITTING AND LOCATE IN CENTER FRONT OF VERTICAL RACK CABLING SECTION.
13. 19" X 84" EQUIPMENT RACK. REFER TO DETAIL SHEET T6-4.
14. APC POWER DISTRIBUTION UNIT, WHITE, 4'-0", 3 WIRE 1 CIRCUIT STRIP WITH 24 SINGLE OUTLETS. MOUNTED TO BACK SIDE OF VERTICAL RACK CABLING SECTION. PLUG STRIP SHALL HAVE A POWER CORD WITH A NEMA L5-20 PLUG FOR CONNECTION TO OVERHEAD ELECTRICAL BUSWAY SYSTEM INSTALLED BY OTHERS. APC POWER DISTRIBUTION UNIT – AP7620.
15. "U" FRAMING CHANNEL SINGLE TRAPEZE ASSEMBLY, TYPICAL. REFER TO DETAIL SHEET T6-2.
16. "U" FRAMING CHANNEL DOUBLE TRAPEZE ASSEMBLY, TYPICAL. REFER TO DETAIL SHEET T6-2.
17. STARLINE BUSWAY SYSTEM, TYPICAL, PROVIDED AND INSTALLED BY ELECTRICAL. SHOWN FOR REFERENCE ONLY.

tBP
architecture
planning
interiors
management

tBP/Architecture
1000 Burnett Avenue, Suite 140
Concord, CA 94520
p: 925.246.6419 f: 925.246.6495

INFRASTRUCTURE DESIGN ASSOCIATES
1440 Broadway
Suite 304
Oakland, CA 94612
EXPIRES: 12/31/06
Regis. No. 08608
SIGNATURE
consultant

DEPARTMENTAL STAMP
DIV. OF THE STATE ARCHITECT
OFFICE OF REGULATION SERVICES
APP. # 01-119114
DATE 11-05

name
address
city, state, zip
ph# fx

SCIENCE BUILDING
LOS MEDANOS COLLEGE

Contra Costa Community College District

owner

tBP project number : 20247.00
file name:
drawn by: checked by:
date: NOVEMBER 15, 2004

1/2"=1'-0"

drawing title: building no:
ELEVATIONS - WALL & RACK - IDF 2.0 (ROOM 209)

LMC SCIENCE 313-023-T12.01-0-00.00
drawing no:
T4-2
drawing of

G:\Los Medanos College\Science Building\BID Set\cad\T4-2.dwg 11-08-04 10:06:15 AM cmendoza

KEY NOTES

1. TERMINATE 36-STRAND MM CABLE FROM CDF IN (E) ADMINISTRATION BUILDING TO BDF/IDF 1.0 (ROOM 151) IN SCIENCE BUILDING (CDF-151-001-036MM) AT DUPLEX SC ADAPTER/RETAINER POSITIONS 01-18.

   TERMINATE 24-STRAND MM CABLE FROM IDF 2.0 (ROOM 209) TO BDF/IDF 1.0 (ROOM 151) IN SCIENCE BUILDING (151-209-037-060MM) AT DUPLEX SC ADAPTER/RETAINER POSITIONS 19-30.

   ALL MULTIMODE FIBER OPTIC CABLE STRANDS SHALL BE TESTED IN TWO DIRECTIONS AT 850 nm AND 1300 nm WITH AN ATTENUATION METER, LIGHT SOURCE AND AN OTDR. SEE SPECIFICATION SECTION 16742 FOR LOSS BUDGET CALCULATIONS AND TESTING REQUIREMENTS.

   RACK MOUNT SHELF FS.03 IN EQUIPMENT RACK IN BDF/IDF 1.0.

2. FULLY ENCLOSED 36-POSITION (FOR UP TO 72 FIBERS) FIBER OPTIC TERMINATION SHELF FOR MOUNTING IN 19" EIA/TIA DRILLED EQUIPMENT RACK. FRONT AND REAR ACCESSIBLE. COMPLETE WITH OSP CABLE CLAMP, CLOSET CONNECTOR HOUSINGS AND CONNECTOR PANELS FOR COUPLING UP TO 36 MULTIMODE DUPLEX SC CONNECTORS. FIBER OPTIC SHELVES SHALL BE CORNING PART NUMBER CCH-02U.

3. LABELING FONT SHALL BE HELVETICA, 10 POINT.


4. PROVIDE A 30 FOOT SERVICE LOOP (MINIMUM) OF EACH FIBER OPTIC CABLE SHEATH. THE SERVICE LOOP SHALL BE WALL MOUNTED BELOW THE LOWER LEVEL OF STEEL WIRE CABLE TRAY USING 'D'-RINGS.

5. FIBER OPTIC ADAPTER IDENTIFICATION CARDS SHALL BE PROVIDED WITH THE PANEL FOR THE FRONT AND REAR LABELING OF THE ADAPTERS AND THE PANEL. CARDS SHALL BE OVERLAID WITH SELF-ADHESIVE, FULL-SIZE LASER PRINTER GENERATED CLEAR LABEL SHEETS ADHERED TO THE MANUFACTURES LABEL CARDS. ONE SINGLE LABEL SHALL BE USED. USE OF MULTIPLE LABELS IS NOT ACCEPTABLE. AN IDENTICAL LABEL SHALL BE ADHERED ON THE INSIDE OF THE REAR DOOR OF THE FIBER OPTIC TERMINATION PANEL. THE BACKGROUND COLOR OF THE MULTIMODE LABEL SHALL BE ORANGE.


6. THE FIBER OPTIC CABLE SHEATH(S) SHALL BE LABELED WITHIN 12 INCHES OF THE FIBER TERMINATION SHELF. FIBER OPTIC CABLE LABELS SHALL CONSIST OF STAINLESS STEEL TAG TIE WRAPPED AT BOTH ENDS TO THE CABLE SHEATH AND STAMPED WITH THE FIBER OPTIC CABLE ID NUMBER AS SHOWN IN THE DRAWINGS AND SPECIFICATION SECTION 16735.

7. THE FIBER OPTIC CABLE SHEATH SHALL BE SECURED TO THE FIBER OPTIC TERMINATION SHELF WITH A CLAMP FROM THE MANUFACTURER OF THE FIBER OPTIC TERMINATION SHELF. THE CABLE SHEATH CLAMP SHALL BE CORNING PART NO. CCH-UCC-KIT. THE CLAMP KIT IS PROVIDED WITH BUSHINGS TO INSURE THE CABLE SHEATH IS PROPERLY SECURED IN THE CLAMP.


8. PROVIDE AND INSTALL IN POSITIONS 01-30, (5) CLOSET CONNECTOR HOUSING MODULES FOR COUPLING MULTI-MODE FIBER OPTIC CONNECTIONS IN 30 DUPLEX SC ADAPTERS, CORNING PART NUMBER CCH-CP12-91.

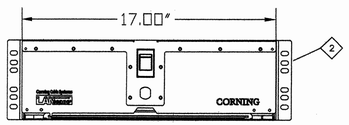


FRONT

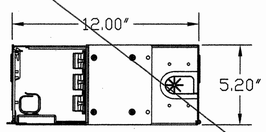

RIGHT SIDE

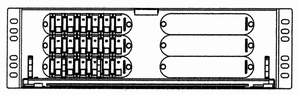

FRONT WITHOUT DOOR

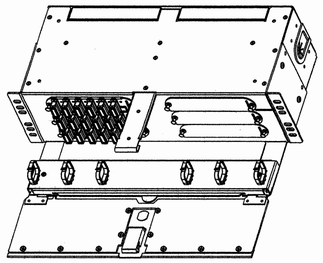

6 FS.03 MULTIMODE CONNECTOR HOUSING W/ DUPLEX SC PANELS

KEY NOTES

1. TERMINATE 12-STRAND SM CABLE FROM CDF IN (E) ADMINISTRATION BLDG. TO BDF/IDF 1.0 (ROOM 151) IN SCIENCE BUILDING (CDF-151-061-072SM) AT DUPLEX SC ADAPTER/RETAINER POSITIONS 01-06.

   TERMINATE 12-STRAND SM CABLE FROM IDF 2.0 (ROOM 209) TO BDF/IDF 1.0 (ROOM 151) IN SCIENCE BUILDING (151-209-073-084SM) AT DUPLEX SC ADAPTER/RETAINER POSITIONS 07-12.

   ALL SINGLE MODE FIBER OPTIC CABLE STRANDS SHALL BE TESTED IN TWO DIRECTIONS AT 1310 nm AND 1550 nm WITH AN ATTENUATION METER, LIGHT SOURCE AND AN OTDR. SEE SPECIFICATION SECTION 16742 FOR LOSS BUDGET CALCULATIONS AND TESTING REQUIREMENTS.

   RACK MOUNT SHELF FS.04 IN EQUIPMENT RACK IN BDF/IDF 1.0.

2. FULLY ENCLOSED 24-POSITION (FOR UP TO 48 FIBERS) FIBER OPTIC TERMINATION SHELF FOR MOUNTING IN 19" EIA/TIA DRILLED EQUIPMENT RACK. FRONT AND REAR ACCESSIBLE. COMPLETE WITH OSP CABLE CLAMP, CLOSET CONNECTOR HOUSINGS AND CONNECTOR PANELS FOR COUPLING UP TO 24 SINGLE MODE DUPLEX SC CONNECTORS. FIBER OPTIC SHELF SHALL BE CORNING PART NUMBER CCH-02U.

3. LABELING FONT SHALL BE HELVETICA, 10 POINT.


4. PROVIDE A 30 FOOT SERVICE LOOP (MINIMUM) OF EACH FIBER OPTIC CABLE SHEATH. THE SERVICE LOOP SHALL BE WALL MOUNTED BELOW THE LOWER LEVEL OF STEEL WIRE CABLE TRAY USING 'D'-RINGS.

5. FIBER OPTIC ADAPTER IDENTIFICATION CARDS SHALL BE PROVIDED WITH THE PANEL FOR THE FRONT AND REAR LABELING OF THE ADAPTERS AND THE PANEL. CARDS SHALL BE OVERLAID WITH SELF-ADHESIVE, FULL-SIZE LASER PRINTER GENERATED CLEAR LABEL SHEETS ADHERED TO THE MANUFACTURES LABEL CARDS. ONE SINGLE LABEL SHALL BE USED. USE OF MULTIPLE LABELS IS NOT ACCEPTABLE. AN IDENTICAL LABEL SHALL BE ADHERED ON THE INSIDE OF THE REAR DOOR OF THE FIBER OPTIC TERMINATION PANEL. THE BACKGROUND COLOR OF THE SINGLE MODE LABEL SHALL BE YELLOW.


6. THE FIBER OPTIC CABLE SHEATH(S) SHALL BE LABELED WITHIN 12 INCHES OF THE FIBER TERMINATION SHELF. FIBER OPTIC CABLE LABELS SHALL CONSIST OF STAINLESS STEEL TAG TIE WRAPPED AT BOTH ENDS TO THE CABLE SHEATH AND STAMPED WITH THE FIBER OPTIC CABLE ID NUMBER AS SHOWN IN THE DRAWINGS AND SPECIFICATION SECTION 16735.

7. THE FIBER OPTIC CABLE SHEATH SHALL BE SECURED TO THE FIBER OPTIC TERMINATION SHELF WITH A CLAMP FROM THE MANUFACTURER OF THE FIBER OPTIC TERMINATION SHELF. THE CABLE SHEATH CLAMP SHALL BE CORNING PART NO. CCH-UCC-KIT. THE CLAMP KIT IS PROVIDED WITH BUSHINGS TO INSURE THE CABLE SHEATH IS PROPERLY SECURED IN THE CLAMP.


8. PROVIDE AND INSTALL IN POSITIONS 01-06, (1) CLOSET CONNECTOR HOUSING PIGTAIL MODULE FOR COUPLING SINGLE MODE FIBER OPTIC CONNECTIONS IN 12 DUPLEX SC ADAPTERS, CORNING PART NUMBER CCH-CM12-72-P03-RH.

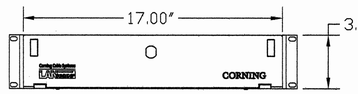


FRONT

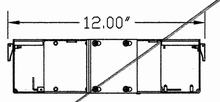

RIGHT SIDE

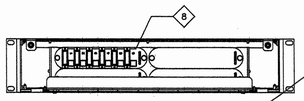

FRONT WITHOUT DOOR

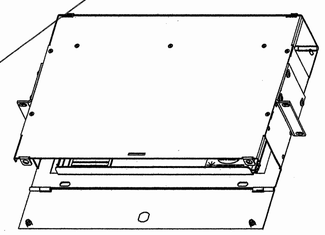

5 FS.04 SINGLE MODE CONNECTOR HOUSING W/ DUPLEX SC PANELS


KEY NOTES

1. 12-STRAND SM CABLE FROM CDF IN (E) ADMINISTRATION BLDG. SHALL BE FUSION SPLICED TO PIGTAIL ASSEMBLIES IN BDF/IDF 1.0 (ROOM 151) IN SCIENCE BUILDING. FUSION SPLICES SHALL BE LOCATED IN SPLICE TRAYS WHICH SHALL BE POSITIONED IN A REAR-MOUNTED SPLICE HOUSING DESIGNED TO UTILIZE THE OPEN SPACE BEHIND THE 2U JUMPER MANAGEMENT PANEL.


   REAR-MOUNTED CLOSET SPLICE HOUSING SHALL BE CORNING PART NO. CJH-02U.

   THE METAL SPLICE TRAYS WITH STRAIN-RELIEF POINTS FOR SECURING PIGTAILS TO THE TRAYS SHALL HOLD TWELVE (12) HEAT-SHRINK FUSION SPLICES. FOUR (4) REQUIRED. CORNING PART NO. M67-048.

2. 2U JUMPER MANAGEMENT PANEL SHALL MOUNT ON THE FRONT OF EQUIPMENT RACK, WITH THE SPLICE HOUSING MOUNTED IN THE SAME LOCATION, BUT ACCESSIBLE FROM THE REAR. CORNING PART NO. CJP-02U.

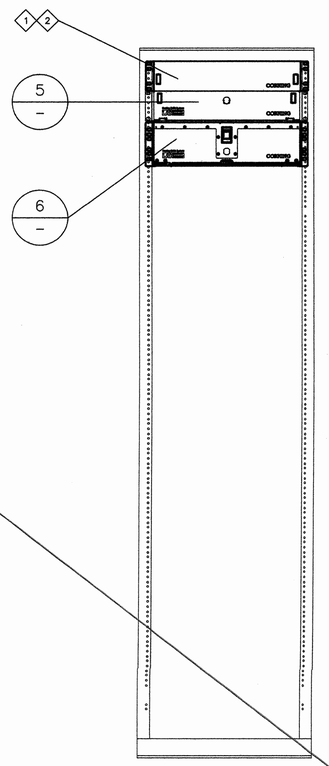

4 BDF/IDF 1.0 (ROOM 151) EQUIPMENT RACK ELEVATION

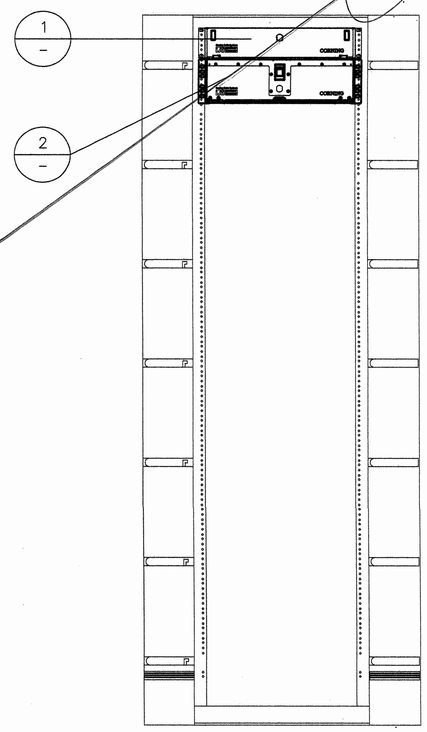

3 IDF 2.0 (ROOM 209) EQUIPMENT RACK ELEVATION

KEY NOTES

1. TERMINATE 36-STRAND MM CABLE FROM BDF/IDF 1.0 (ROOM 151) TO IDF 2.0 (ROOM 209) IN SCIENCE BUILDING (151-209-037-060MM) AT DUPLEX SC ADAPTER/RETAINER POSITIONS 01-18.

   ALL MULTIMODE FIBER OPTIC CABLE STRANDS SHALL BE TESTED IN TWO DIRECTIONS AT 850 nm AND 1300 nm WITH AN ATTENUATION METER, LIGHT SOURCE AND AN OTDR. SEE SPECIFICATION SECTION 16742 FOR LOSS BUDGET CALCULATIONS AND TESTING REQUIREMENTS.

   RACK MOUNT SHELF FS.01 IN EQUIPMENT RACK IN IDF 2.0.

2. FULLY ENCLOSED 24-POSITION (FOR UP TO 48 FIBERS) FIBER OPTIC TERMINATION SHELF FOR MOUNTING IN 19" EIA/TIA DRILLED EQUIPMENT RACK. FRONT AND REAR ACCESSIBLE. COMPLETE WITH OSP CABLE CLAMP, CLOSET CONNECTOR HOUSINGS AND CONNECTOR PANELS FOR COUPLING UP TO 24 MULTIMODE DUPLEX SC CONNECTORS. FIBER OPTIC SHELVES SHALL BE CORNING PART NUMBER CCH-02U.

3. LABELING FONT SHALL BE HELVETICA, 10 POINT.


4. PROVIDE A 30 FOOT SERVICE LOOP (MINIMUM) OF EACH FIBER OPTIC CABLE SHEATH. THE SERVICE LOOP SHALL BE WALL MOUNTED BELOW THE LOWER LEVEL OF STEEL WIRE CABLE TRAY USING 'D'-RINGS.

5. FIBER OPTIC ADAPTER IDENTIFICATION CARDS SHALL BE PROVIDED WITH THE PANEL FOR THE FRONT AND REAR LABELING OF THE ADAPTERS AND THE PANEL. CARDS SHALL BE OVERLAID WITH SELF-ADHESIVE, FULL-SIZE LASER PRINTER GENERATED CLEAR LABEL SHEETS ADHERED TO THE MANUFACTURES LABEL CARDS. ONE SINGLE LABEL SHALL BE USED. USE OF MULTIPLE LABELS IS NOT ACCEPTABLE. AN IDENTICAL LABEL SHALL BE ADHERED ON THE INSIDE OF THE REAR DOOR OF THE FIBER OPTIC TERMINATION PANEL. THE BACKGROUND COLOR OF THE MULTIMODE LABEL SHALL BE ORANGE AND THE SINGLE MODE LABEL SHALL BE YELLOW.


6. THE FIBER OPTIC CABLE SHEATH(S) SHALL BE LABELED WITHIN 12 INCHES OF THE FIBER TERMINATION SHELF. FIBER OPTIC CABLE LABELS SHALL CONSIST OF STAINLESS STEEL TAG TIE WRAPPED AT BOTH ENDS TO THE CABLE SHEATH AND STAMPED WITH THE FIBER OPTIC CABLE ID NUMBER AS SHOWN IN THE DRAWINGS AND SPECIFICATION SECTION 16735.

7. CONTRACTOR SHALL SECURE THE FIBER OPTIC CABLE SHEATH SHALL BE SECURED TO THE FIBER OPTIC TERMINATION SHELF WITH A CLAMP FROM THE MANUFACTURER OF THE FIBER OPTIC TERMINATION SHELF. THE CABLE SHEATH CLAMP SHALL BE CORNING PART NO. CCH-UCC-KIT. THE CLAMP KIT IS PROVIDED WITH BUSHINGS TO INSURE THE CABLE SHEATH IS PROPERLY SECURED IN THE CLAMP.


8. PROVIDE AND INSTALL IN POSITIONS 01-06, (1) CLOSET CONNECTOR HOUSING PIGTAIL MODULE FOR COUPLING SINGLE MODE FIBER OPTIC CONNECTIONS IN 6 DUPLEX SC ADAPTERS, CORNING PART NUMBER CCH-CM12-72-P03-RH.

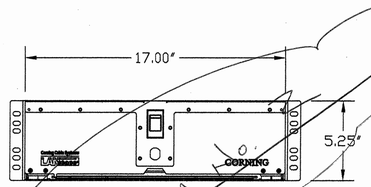


FRONT

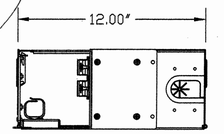

RIGHT SIDE

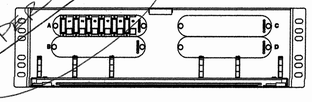

FRONT WITHOUT DOOR

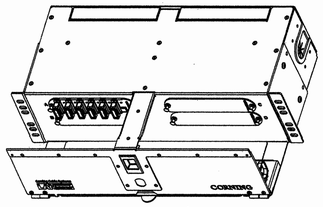

2 FS.02 SINGLE MODE CONNECTOR AND SPLICE HOUSING

KEY NOTES

1. TERMINATE 36-STRAND MM CABLE FROM BDF/IDF 1.0 (ROOM 151) TO IDF 2.0 (ROOM 209) IN SCIENCE BUILDING (151-209-037-060MM) AT DUPLEX SC ADAPTER/RETAINER POSITIONS 01-18.

   ALL MULTIMODE FIBER OPTIC CABLE STRANDS SHALL BE TESTED IN TWO DIRECTIONS AT 850 nm AND 1300 nm WITH AN ATTENUATION METER, LIGHT SOURCE AND AN OTDR. SEE SPECIFICATION SECTION 16742 FOR LOSS BUDGET CALCULATIONS AND TESTING REQUIREMENTS.

   RACK MOUNT SHELF FS.01 IN EQUIPMENT RACK IN IDF 2.0.

2. FULLY ENCLOSED 24-POSITION (FOR UP TO 48 FIBERS) FIBER OPTIC TERMINATION SHELF FOR MOUNTING IN 19" EIA/TIA DRILLED EQUIPMENT RACK. FRONT AND REAR ACCESSIBLE. COMPLETE WITH OSP CABLE CLAMP, CLOSET CONNECTOR HOUSINGS AND CONNECTOR PANELS FOR COUPLING UP TO 24 MULTIMODE DUPLEX SC CONNECTORS. FIBER OPTIC SHELVES SHALL BE CORNING PART NUMBER CCH-02U.

3. LABELING FONT SHALL BE HELVETICA, 10 POINT.


4. PROVIDE A 30 FOOT SERVICE LOOP (MINIMUM) OF EACH FIBER OPTIC CABLE SHEATH. THE SERVICE LOOP SHALL BE WALL MOUNTED BELOW THE LOWER LEVEL OF STEEL WIRE CABLE TRAY USING 'D'-RINGS.

5. FIBER OPTIC ADAPTER IDENTIFICATION CARDS SHALL BE PROVIDED WITH THE PANEL FOR THE FRONT AND REAR LABELING OF THE ADAPTERS AND THE PANEL. CARDS SHALL BE OVERLAID WITH SELF-ADHESIVE, FULL-SIZE LASER PRINTER GENERATED CLEAR LABEL SHEETS ADHERED TO THE MANUFACTURES LABEL CARDS. ONE SINGLE LABEL SHALL BE USED. USE OF MULTIPLE LABELS IS NOT ACCEPTABLE. AN IDENTICAL LABEL SHALL BE ADHERED ON THE INSIDE OF THE REAR DOOR OF THE FIBER OPTIC TERMINATION PANEL. THE BACKGROUND COLOR OF THE MULTIMODE LABEL SHALL BE ORANGE AND THE SINGLE MODE LABEL SHALL BE YELLOW.


6. THE FIBER OPTIC CABLE SHEATH(S) SHALL BE LABELED WITHIN 12 INCHES OF THE FIBER TERMINATION SHELF. FIBER OPTIC CABLE LABELS SHALL CONSIST OF STAINLESS STEEL TAG TIE WRAPPED AT BOTH ENDS TO THE CABLE SHEATH AND STAMPED WITH THE FIBER OPTIC CABLE ID NUMBER AS SHOWN IN THE DRAWINGS AND SPECIFICATION SECTION 16735.

7. THE FIBER OPTIC CABLE SHEATH SHALL BE SECURED TO THE FIBER OPTIC TERMINATION SHELF WITH A CLAMP FROM THE MANUFACTURER OF THE FIBER OPTIC TERMINATION SHELF. THE CABLE SHEATH CLAMP SHALL BE CORNING PART NO. CCH-UCC-KIT. THE CLAMP KIT IS PROVIDED WITH BUSHINGS TO INSURE THE CABLE SHEATH IS PROPERLY SECURED IN THE CLAMP.


8. PROVIDE AND INSTALL IN POSITIONS 01-18, (3) CLOSET CONNECTOR HOUSING MODULES FOR COUPLING MULTIMODE FIBER OPTIC CONNECTIONS IN 18 DUPLEX SC ADAPTERS, CORNING PART NUMBER CCH-CP12-91.

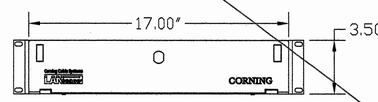


FRONT

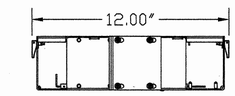

RIGHT SIDE

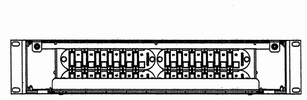

FRONT WITHOUT DOOR

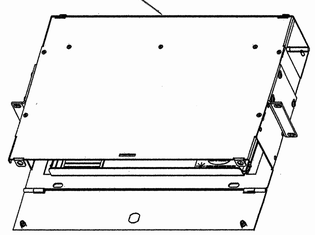

1 FS.01 MULTIMODE CONNECTOR HOUSING W/ DUPLEX SC PANELS

EMPTY SHEET DELETED PER ADDENDUM

tBP
architecture
planning
interiors
management

tBP/architecture
1000 Burnett Avenue, Suite 140
Concord, CA 94520
p. 925.246.6419 f. 925.246.6495

INFRASTRUCTURE DESIGN ASSOCIATES
1440 Broadway
Suite 304
Oakland, CA 94612

LICENSED ARCHITECT STATE OF CALIFORNIA

EXPIRES: 12/31/06
Regis. No. 06606
SIGNATURE

consultant

RENOVATION STAMP
DIV. OF THE STATE ARCHITECT
OFFICE OF REGULATION SERVICES
APPL. # 04-109536
DATE 11-15-04

name
address
city, state, zip
ph fx

SCIENCE BUILDING
LOS MEDANOS COLLEGE

Contra Costa Community College District

owner

tBP project number : 20247.00

file name:

drawn by: checked by:

date: NOVEMBER 15, 2004

drawing title: ELEVATIONS FIBER OPTIC TERMINATION SHELVES

building no:

LMC SCIENCE 313-023-T12.01-0-00.00

drawing no: T4-3

drawing of

G:\Los Medanos College\Science Building\BID Set\Local\T4-3.dwg 11-08-04 09:57:37 AM cmendoza

GENERAL NOTES

THE FIBER OPTIC CABLE SHEATH AND STRENGTH MEMBER SHALL STOP AT THE CABLE SHEATH CLAMP OUTSIDE OF THE FIBER TERMINATION SHELF PER THE MANUFACTURERS SRP.

THE FIBER OPTIC CABLE SHEATH AND STRENGTH MEMBER SHALL BE SECURED TO THE OUTSIDE OF THE FIBER TERMINATION SHELF WITH A CABLE SHEATH CLAMP AND BUSHING FROM THE MANUFACTURER OF THE FIBER TERMINATION SHELF CORNING CABLE SYSTEMS CCH-UCC-KIT.

THE COUPLER IDENTIFICATION CARD SHALL BE LABELED WITH HELVETICA BOLD 14 POINT FONT.

KEY NOTES

1. FULLY ENCLOSED DUPLEX 36-POSITION (FOR UP TO 72 FIBERS) FIBER OPTIC TERMINATION SHELF FOR MOUNTING IN 19" EIA/TIA DRILLED EQUIPMENT RACK. FRONT AND REAR ACCESSIBLE. COMPLETE WITH CSP CABLE CLAMP, CLOSET CONNECTOR HOUSINGS AND CONNECTOR PANELS FOR COUPLING UP TO 36 MULTIMODE DUPLEX SC CONNECTORS. FIBER OPTIC SHELVES SHALL BE CORNING PART NUMBER CCH-02U, TO MATCH EXISTING.
2. FIBER OPTIC ADAPTER IDENTIFICATION CARDS SHALL BE PROVIDED WITH THE PANEL FOR THE FRONT AND REAR LABELING OF THE ADAPTERS AND THE PANEL. CARDS SHALL BE OVERLAID WITH SELF-ADHESIVE, FULL-SIZE LASER PRINTER GENERATED CLEAR LABEL SHEETS ADHERED TO MANUFACTURERS LABEL CARDS. ONE SINGLE LABEL SHALL BE USED. USE OF MULTIPLE LABELS IS NOT ACCEPTABLE. AN IDENTICAL LABEL SHALL BE ADHERED ON THE INSIDE OF THE REAR DOOR OF THE FIBER OPTIC TERMINATION PANEL. THE BACKGROUND COLOR OF THE MULTIMODE LABEL SHALL BE ORANGE.

CABLE TERMINATION NOTES


ADMINISTRATIVE BUILDING CDF TERMINATE 36 STRAND MULTIMODE FIBER OPTIC CABLE ADM-SCI-36F-001-035MM IN EXISTING EQUIPMENT RACK A2 IN FIBER TERMINATION SHELF ADM-SCI-FS.02 ON DUPLEX SC COUPLERS IN POSITIONS 1–18.

SCIENCE BUILDING BDF (ROOM 151) TERMINATE 36 STRAND MULTIMODE FIBER OPTIC CABLE BDF1-DF2-36F-001-035MM IN EQUIPMENT RACK 1.0-ER-01 IN FIBER TERMINATION SHELF ADM-SCI-FS.06 ON DUPLEX SC COUPLERS IN POSITIONS 1–18.

SCIENCE BUILDING BDF (ROOM 151) TERMINATE 36 STRAND MULTIMODE FIBER OPTIC CABLE BDF1-DF2-36F-001-035MM IN EQUIPMENT RACK 1.0-ER-01 IN FIBER TERMINATION SHELF SCI-FS.04 ON DUPLEX SC COUPLERS IN POSITIONS 1–18.

SCIENCE BUILDING IDF (ROOM 209) TERMINATE 36 STRAND MULTIMODE FIBER OPTIC CABLE IDF1-DF2-36F-001-035MM IN EQUIPMENT RACK 1.0-ER-01 IN FIBER TERMINATION SHELF SCI-FS.02 ON DUPLEX SC COUPLERS IN POSITIONS 1–18.

ADDENDUM #2
DSA FILE # 7-C1
DSA APPL # 01-106226

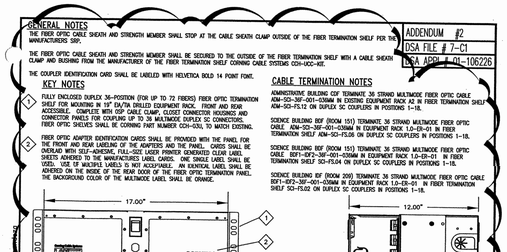

1 MULTIMODE TERMINATION SHELF, 36 DUPLEX SC, 72 FIBER CAPACITY

ELEVATIONS
FIBER OPTIC
TERMINATION SHELVES

BICSI REGISTERED COMMUNICATIONS DISTRIBUTION DESIGNER

EXPIRES 12/31/05
Regis. No. 05229
SIGNATURE

INFRASTRUCTURE DESIGN ASSOCIATES
1440 Broadway
Suite 304
Oakland, CA. 94612
Ph: (510) 238-8000
Fax: (510) 238-8009

SCIENCE BUILDING
LOS MEDANOS COLLEGE
Pittsburg CA
Contra Costa Community College School District

ARCHITECT
tBP/Architecture
1000 Burnett Ave, Suite 140
Concord, CA 94520
p: 925.246.6419 f: 925.246.6495

tBP architecture planning interior management

LICENSED ARCHITECT EDWARD C. MARTINEZ NO. C-8685 STATE OF CALIFORNIA

ADDENDUM #2
DATE: 05/11/05
DSA NO. 01-106226
THIS REVISES IN PART
SHEET: T4.4
SHEET: SKT-29

Jean\Science Building\ADDENDUM#2\xsect\SKT4-4_29.dwg 5-11-05 8:46:18 PM
G:\Los Medanos

GENERAL NOTES

THE FIBER OPTIC CABLE SHEATH AND STRENGTH MEMBER SHALL STOP AT THE CABLE SHEATH CLAMP OUTSIDE OF THE FIBER TERMINATION SHELF PER THE MANUFACTURERS SRP.

THE FIBER OPTIC CABLE SHEATH AND STRENGTH MEMBER SHALL BE SECURED TO THE OUTSIDE OF THE FIBER TERMINATION SHELF WITH A CABLE SHEATH CLAMP AND BUSHING FROM THE MANUFACTURER OF THE FIBER TERMINATION SHELF CORNING CABLE SYSTEMS CCH-UCC-KIT.

THE COUPLER IDENTIFICATION CARD SHALL BE LABELED WITH HELVETICA BOLD 14 POINT FONT.

KEY NOTES

1. FULLY ENCLOSED DUPLEX 24-POSITION (FOR UP TO 48 FIBERS) FIBER OPTIC TERMINATION AND SPLICE SHELF FOR MOUNTING IN 19" EIA/TIA DRILLED EQUIPMENT RACK. FRONT AND REAR ACCESSIBLE. COMPLETE WITH CSP CABLE CLAMP, CLOSET CONNECTOR HOUSINGS AND CONNECTOR PANELS FOR COUPLING UP TO 24 SINGLE MODE DUPLEX SC CONNECTORS. FIBER OPTIC SHELVES SHALL BE CORNING PART NUMBER CCS-02U, TO MATCH EXISTING.
2. FIBER OPTIC ADAPTER IDENTIFICATION CARDS SHALL BE PROVIDED WITH THE PANEL FOR THE FRONT AND REAR LABELING OF THE ADAPTERS AND THE PANEL. CARDS SHALL BE OVERLAID WITH SELF-ADHESIVE, FULL-SIZE LASER PRINTER GENERATED CLEAR LABEL SHEETS ADHERED TO MANUFACTURERS LABEL CARDS. ONE SINGLE LABEL SHALL BE USED. USE OF MULTIPLE LABELS IS NOT ACCEPTABLE. AN IDENTICAL LABEL SHALL BE ADHERED ON THE INSIDE OF THE REAR DOOR OF THE FIBER OPTIC TERMINATION PANEL. THE BACKGROUND COLOR OF THE MULTIMODE LABEL SHALL BE ORANGE AND THE SINGLE MODE LABEL SHALL BE YELLOW.

CABLE TERMINATION NOTES


ADMINISTRATIVE BUILDING CDF TERMINATE 12 STRAND SINGLE MODE FIBER OPTIC CABLE ADM-SCI-12F-001-012SM IN EXISTING EQUIPMENT RACK A2 IN FIBER TERMINATION SHELF ADM-SCI-FS.11 ON DUPLEX SC COUPLERS IN POSITIONS 1–12.

SCIENCE BUILDING BDF (ROOM 151) TERMINATE 12 STRAND SINGLE MODE FIBER OPTIC CABLE ADM-SCI-12F-001-012SM IN EQUIPMENT RACK 1.0-ER-01 IN FIBER TERMINATION SHELF ADM-SCI-FS.05 ON DUPLEX SC COUPLERS IN POSITIONS 1–12.

SCIENCE BUILDING IDF (ROOM 151) TERMINATE 12 STRAND SINGLE MODE FIBER OPTIC CABLE BDF1-IDF2-12F-001-012SM IN EQUIPMENT RACK 1.0-ER-01 IN FIBER TERMINATION SHELF SCI-FS.03 ON DUPLEX SC COUPLERS IN POSITIONS 1–12.

SCIENCE BUILDING IDF (ROOM 209) TERMINATE 12 STRAND SINGLE MODE FIBER OPTIC CABLE BDF1-IDF2-12F-001-012SM IN EQUIPMENT RACK 2.0-ER-01 IN FIBER TERMINATION SHELF SCI-FS.01 ON DUPLEX SC COUPLERS IN POSITIONS 1–12.

ADDENDUM #2
DSA FILE # 7-C1
DSA APPL # 01-106226

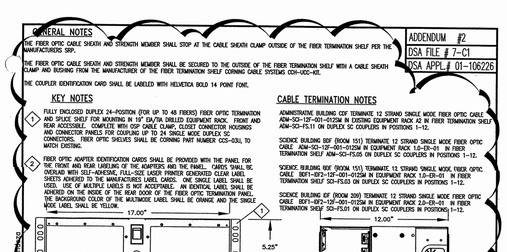

1 SINGLE MODE TERMNATION SHELF, 24 DUPLEX SC,48 FUSION SPLICE, 48 FIBER CAPACITY

ELEVATIONS
FIBER OPTIC
TERMINATION SHELVES

BICSI REGISTERED COMMUNICATIONS DISTRIBUTION DESIGNER

EXPIRES 12/31/05
Regis. No. 05229
SIGNATURE

INFRASTRUCTURE DESIGN ASSOCIATES
1440 Broadway
Suite 304
Oakland, CA. 94612
Ph: (510) 238-8000
Fax: (510) 238-8009

SCIENCE BUILDING
LOS MEDANOS COLLEGE
Pittsburg CA
Contra Costa Community College School District

ARCHITECT
tBP/Architecture
1000 Burnett Ave, Suite 140
Concord, CA 94520
p: 925.246.6419 f: 925.246.6495

tBP architecture planning interior management

LICENSED ARCHITECT EDWARD C. MARTINEZ NO. C-8685 STATE OF CALIFORNIA

ADDENDUM #2
DATE: 05/11/05
DSA NO. 01-106226
THIS REVISES IN PART
SHEET: T4.4
SHEET: SKT-30

Jean\Science Building\ADDENDUM#2\xsect\SKT4-4_30.dwg 5-11-05 8:46:43 PM
G:\Los Medanos

GENERAL NOTES

(1) 12 STRAND SINGLE MODE AND (1) 36 STRAND MULTIMODE CABLES WILL ROUTE FROM THE ADMIN BUILDING CDF OUT TO THE INFORMATION RESOURCE CENTER (IRC), SCIENCE (SCI), AND MATH (MATH).


KEY NOTES

1. INFORMATION RESOURCE CENTER (IRC), JUMPER STORAGE UNIT, CORNING CABLE SYSTEMS CJP-02U, 36 DUPLEX SC POSITION 72 FIBER MULTIMODE SHELF, 24 DUPLEX SC POSITION 48 SPLICE FIBER TERMINATION SHELF, PROVIDED BY OTHERS.

   MATH BUILDING (MATH), JUMPER STORAGE UNIT, CORNING CABLE SYSTEMS CJP-02U, 36 DUPLEX SC POSITION 72 FIBER MULTIMODE SHELF, 24 DUPLEX SC POSITION 48 SPLICE FIBER TERMINATION SHELF, PROVIDED BY OTHERS.

   SCIENCE BUILDING (SCI), JUMPER STORAGE UNIT, CORNING CABLE SYSTEMS CJP-02U, 36 DUPLEX SC POSITION 72 FIBER MULTIMODE SHELF, 24 DUPLEX SC POSITION 48 SPLICE FIBER TERMINATION SHELF, PROVIDED BY OTHERS.

ADDENDUM #2
DSA FILE # 7-C1
DSA APPL # 01-106226

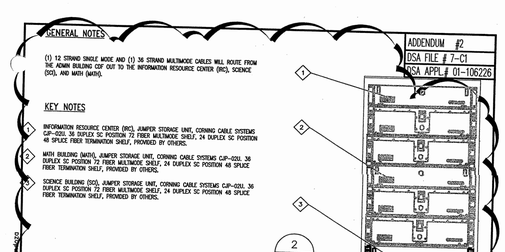

1 ADMIN BUILDING CDF A2 EQUIPMENT RACK

ELEVATIONS
FIBER OPTIC
TERMINATION SHELVES

BICSI REGISTERED COMMUNICATIONS DISTRIBUTION DESIGNER

EXPIRES 12/31/05
Regis. No. 05229
SIGNATURE

INFRASTRUCTURE DESIGN ASSOCIATES
1440 Broadway
Suite 304
Oakland, CA. 94612
Ph: (510) 238-8000
Fax: (510) 238-8009

SCIENCE BUILDING
LOS MEDANOS COLLEGE
Pittsburg CA
Contra Costa Community College School District

ARCHITECT
tBP/Architecture
1000 Burnett Ave, Suite 140
Concord, CA 94520
p: 925.246.6419 f: 925.246.6495

tBP architecture planning interior management

LICENSED ARCHITECT EDWARD C. MARTINEZ NO. C-8685 STATE OF CALIFORNIA

ADDENDUM #2
DATE: 05/11/05
DSA NO. 01-106226
THIS REVISES IN PART
SHEET: T4.4
SHEET: SKT-31

Jean\Science Building\ADDENDUM#2\xsect\SKT4-4_31.dwg 5-11-05 8:46:54 PM
G:\Los Medanos

tBP/Architecture
1000 Burnett Avenue, Suite 140
Concord, CA 94520
p. 925.246.6419 f. 925.246.6495

architecture
planning
interiors
management

LICENSED ARCHITECT EDWARD C. MARTINEZ NO. C-8685 STATE OF CALIFORNIA

architect

consultant

IDENTIFICATION STAMP
DIV. OF THE STATE ARCHITECT
OFFICE OF REGULATION SERVICES
APP. NO. 01-106226
AC. ____ FLS ____ SS. ____
DATE ____ INIT. ____

Division of the State Architect
Regional Office
1515 Clay St., Suite 1201
Oakland, CA 94612
p. 415-396-9500 f.

agency

SCIENCE BUILDING
LOS MEDANOS COLLEGE

Contra Costa Community College District

owner

tBP project number : 20247.00

file name:

drawn by: checked by:

date: NOVEMBER 15, 2004


Rev:	date:	description:


drawing title:


ADDENDUM # 2 DRAWINGS

LMC SCIENCE 313-023-T12.01-0-00.00
drawing no.:

ATTACHMENT TO T4-4

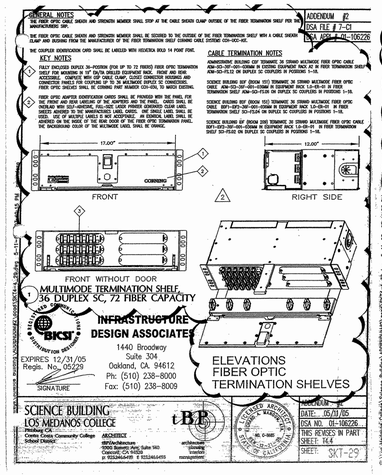

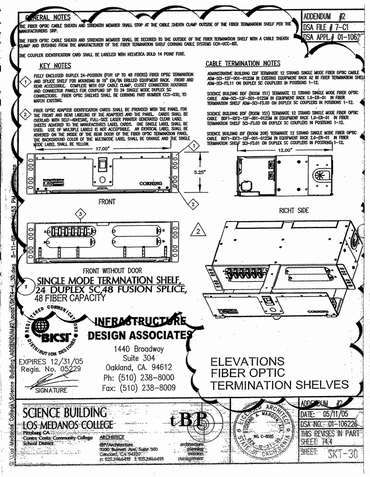

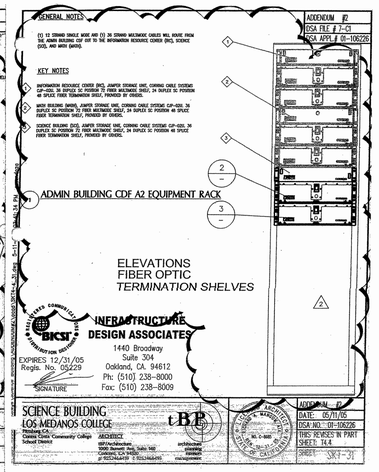

KEY NOTES

1. TERMINATE 12-STRAND SM CABLE FROM BDF/DF 1.0 (ROOM 151) IN SCIENCE BUILDING (CDF-151-061-072MM) TO CDF IN (E) ADMINISTRATION BLDG. AT DUPLEX SC ADAPTER/RETAINER POSITIONS 01-06.


   RACK MOUNT SHELF FS.04 IN EQUIPMENT RACK NUMBER A2 IN CDF.

2. FULLY ENCLOSED 24-POSITION (FOR UP TO 48 FIBERS) FIBER OPTIC TERMINATION SHELF FOR MOUNTING IN 19" EIA/TIA DRILLED EQUIPMENT RACK. FRONT AND REAR ACCESSIBLE. COMPLETE WITH OSP CABLE CLAMP, CLOSET CONNECTOR HOUSINGS AND CONNECTOR PANELS FOR COUPLING UP TO 24 SINGLE MODE DUPLEX SC CONNECTORS. FIBER OPTIC SHELF SHALL BE CORNING PART NUMBER CCH-02U, TO MATCH EXISTING. PROVIDE AND INSTALL IN POSITIONS 01-06, (1) CLOSET CONNECTOR HOUSING PIGTAIL MODULE FOR COUPLING SINGLE MODE FIBER OPTIC CONNECTIONS IN 12 DUPLEX SC ADAPTERS, CORNING PART NUMBER CCH-CM12-72-P03-RH, TO MATCH EXISTING.

3. LABELING FONT SHALL BE HELVETICA, 10 POINT.

4. FIBER OPTIC ADAPTER IDENTIFICATION CARDS SHALL BE PROVIDED WITH THE PANEL FOR THE FRONT AND REAR LABELING OF THE ADAPTERS AND THE PANEL. CARDS SHALL BE OVERLAID WITH SELF-ADHESIVE, FULL-SIZE LASER PRINTER GENERATED CLEAR LABEL SHEETS ADHERED TO THE MANUFACTURES LABEL CARDS. ONE SINGLE LABEL SHALL BE USED. USE OF MULTIPLE LABELS IS NOT ACCEPTABLE. AN IDENTICAL LABEL SHALL BE ADHERED ON THE INSIDE OF THE REAR DOOR OF THE FIBER OPTIC TERMINATION PANEL. THE BACKGROUND COLOR OF THE SINGLE MODE LABEL SHALL BE YELLOW.

5. THE FIBER OPTIC CABLE SHEATH SHALL BE SECURED TO THE FIBER OPTIC TERMINATION SHELF WITH A CLAMP FROM THE MANUFACTURER OF THE FIBER OPTIC TERMINATION SHELF. THE CABLE SHEATH CLAMP SHALL BE CORNING PART NO. CCH-UCC-KIT, TO MATCH EXISTING. THE CLAMP KIT IS PROVIDED WITH BUSHINGS TO INSURE THE CABLE SHEATH IS PROPERLY SECURED IN THE CLAMP.

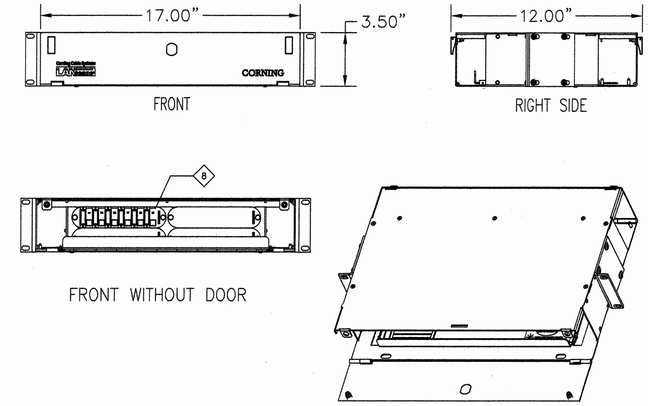

(2) FS.04 SINGLE MODE CONNECTOR HOUSING W/ DUPLEX SC PANELS

KEY NOTES

1. TERMINATE 36-STRAND MM CABLE FROM BDF/DF 1.0 (ROOM 151) IN SCIENCE BUILDING TO CDF IN (E) ADMINISTRATION BUILDING (CDF-151-001-036MM) AT DUPLEX SC ADAPTER/RETAINER POSITIONS 01-18.


   RACK MOUNT SHELF FS.03 IN EQUIPMENT RACK NUMBER A2 IN CDF.

2. FULLY ENCLOSED 24-POSITION (FOR UP TO 48 FIBERS) FIBER OPTIC TERMINATION SHELF FOR MOUNTING IN 19" EIA/TIA DRILLED EQUIPMENT RACK. FRONT AND REAR ACCESSIBLE. COMPLETE WITH OSP CABLE CLAMP, CLOSET CONNECTOR HOUSINGS AND CONNECTOR PANELS FOR COUPLING UP TO 24 MULTIMODE DUPLEX SC CONNECTORS. FIBER OPTIC SHELVES SHALL BE CORNING PART NUMBER CCH-02U, TO MATCH EXISTING. PROVIDE AND INSTALL IN POSITIONS 01-18, (3) CLOSET CONNECTOR HOUSING MODULES FOR COUPLING MULTI-MODE FIBER OPTIC CONNECTIONS IN 18 DUPLEX SC ADAPTERS, CORNING PART NUMBER CCH-CP12-91, TO MATCH EXISTING.

3. LABELING FONT SHALL BE HELVETICA, 10 POINT.

4. FIBER OPTIC ADAPTER IDENTIFICATION CARDS SHALL BE PROVIDED WITH THE PANEL FOR THE FRONT AND REAR LABELING OF THE ADAPTERS AND THE PANEL. CARDS SHALL BE OVERLAID WITH SELF-ADHESIVE, FULL-SIZE LASER PRINTER GENERATED CLEAR LABEL SHEETS ADHERED TO THE MANUFACTURES LABEL CARDS. ONE SINGLE LABEL SHALL BE USED. USE OF MULTIPLE LABELS IS NOT ACCEPTABLE. AN IDENTICAL LABEL SHALL BE ADHERED ON THE INSIDE OF THE REAR DOOR OF THE FIBER OPTIC TERMINATION PANEL. THE BACKGROUND COLOR OF THE MULTIMODE LABEL SHALL BE ORANGE.

5. THE FIBER OPTIC CABLE SHEATH SHALL BE SECURED TO THE FIBER OPTIC TERMINATION SHELF WITH A CLAMP FROM THE MANUFACTURER OF THE FIBER OPTIC TERMINATION SHELF. THE CABLE SHEATH CLAMP SHALL BE CORNING PART NO. CCH-UCC-KIT, TO MATCH EXISTING. THE CLAMP KIT IS PROVIDED WITH BUSHINGS TO INSURE THE CABLE SHEATH IS PROPERLY SECURED IN THE CLAMP.

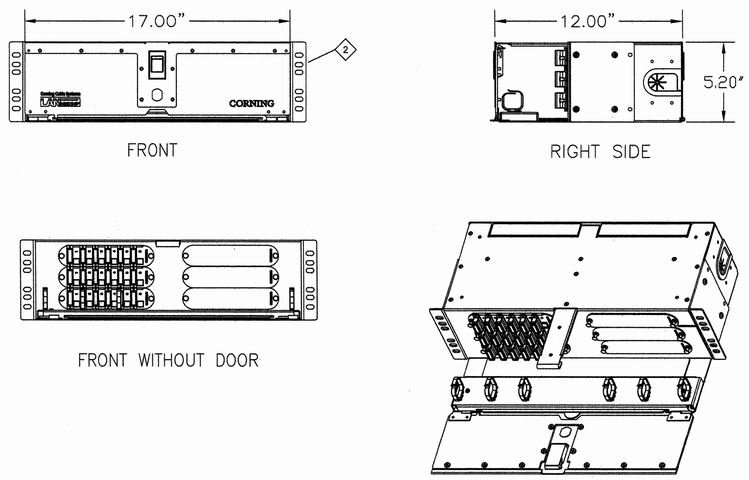

(3) FS.03 MULTIMODE CONNECTOR HOUSING W/ DUPLEX SC PANELS

KEY NOTES


1. 12-STRAND SM CABLE FROM BDF/DF 1.0 (ROOM 151) IN SCIENCE BUILDING SHALL BE FUSION SPLICED TO PIGTAIL ASSEMBLIES IN CDF IN (E) ADMINISTRATION BLDG. FUSION SPLICES SHALL BE LOCATED IN SPLICE TRAYS WHICH SHALL BE POSITIONED IN A REAR-MOUNTED SPLICE HOUSING DESIGNED TO UTILIZE THE OPEN SPACE BEHIND THE 2U JUMPER MANAGEMENT PANEL.

   REAR-MOUNTED CLOSET SPLICE HOUSING SHALL BE CORNING PART NO. CJH-02U, TO MATCH EXISTING.

   THE METAL SPLICE TRAYS WITH STRAIN-RELIEF POINTS FOR SECURING PIGTAILS TO THE TRAYS SHALL HOLD TWELVE (12) HEAT-SHRINK FUSION SPLICES. FOUR (4) REQUIRED. CORNING PART NO. M67-048, TO MATCH EXISTING,

2. 2U JUMPER MANAGEMENT PANEL SHALL MOUNT ON THE FRONT OF EQUIPMENT RACK, WITH THE SPLICE HOUSING MOUNTED IN THE SAME LOCATION, BUT ACCESSIBLE FROM THE REAR. CORNING PART NO. CJP-02U, TO MATCH EXISTING.

3. (E) FIBER OPTIC HOUSINGS.

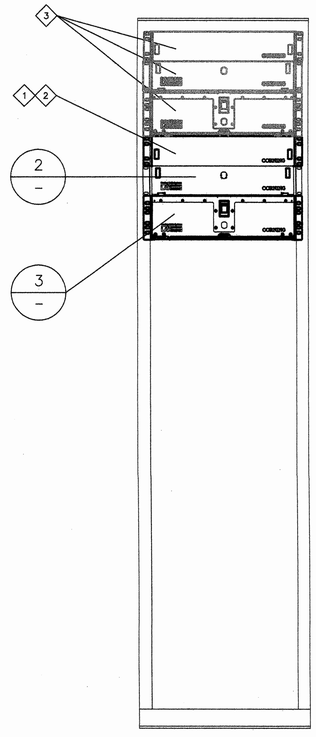

(1) CDF (ADMIN. BLDG.) A2 EQUIPMENT RACK ELEVATION

tBP
architecture
planning
interiors
management
tBP/Architecture
1000 Burnett Avenue, Suite 140
Concord, CA 94520
p: 9252466495 f: 9252466495

LICENSED ARCHITECT — STATE OF CALIFORNIA — KENNETH W. LING — No. C-9885 — REGISTRATION EXPIRES: 08-31-05

INFRASTRUCTURE DESIGN ASSOCIATES
1440 Broadway
Suite 304
Oakland, CA 94612

COMMISSIONING CONSULTANTS — BICSI REGISTERED COMMUNICATIONS DISTRIBUTION DESIGNER

EXPIRES 12/31/05
Regis. No. 06606
SIGNATURE

consultant

DSA IDENTIFICATION STAMP
DIV. OF THE STATE ARCHITECT
OFFICE OF REGULATION SERVICES
APP. 01-106226
NO. 4
DATE 11-3-05

name
address
city, state, zip
ph:
fx:

SCIENCE BUILDING
LOS MEDANOS COLLEGE


Contra Costa Community College District

owner

tBP project number : 20247.00
file name:
drawn by: checked by:
date: NOVEMBER 15, 2004

drawing title: ELEVATIONS FIBER OPTIC TERMINATION SHELVES
building no: LMC SCIENCE 313-023-T12.01-0-00.00
drawing no: T4-4
drawing of

G:\Los Medanos College\Science Building\BID Set\vcad\T4-4.dwg 11-08-04 08:53:29|AM cmendoza

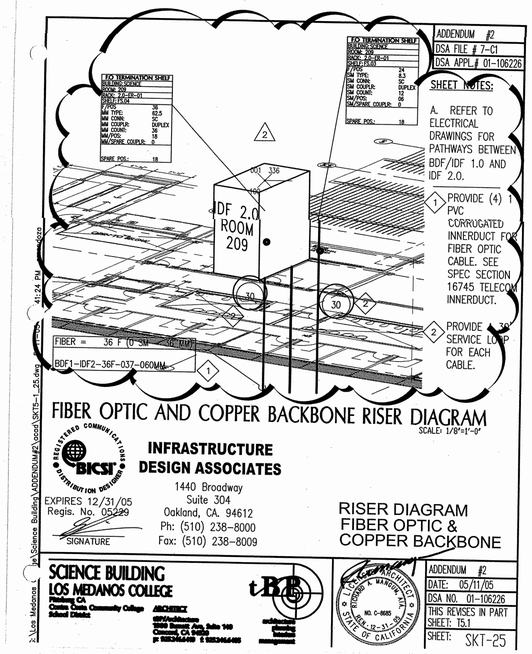

ADDENDUM #2
DSA FILE # 7-C1
DSA APPL # 01-106226

SHEET NOTES:

A. REFER TO ELECTRICAL DRAWINGS FOR PATHWAYS BETWEEN BDF/IDF 1.0 AND IDF 2.0.

1. PROVIDE (4) 1" PVC CORRUGATED INNERDUCT FOR FIBER OPTIC CABLE. SEE SPEC SECTION 16745 TELECOM INNERDUCT.
2. PROVIDE A 30' SERVICE LOOP FOR EACH CABLE.

FIBER OPTIC AND COPPER BACKBONE RISER DIAGRAM
SCALE: 1/8"=1'-0"

INFRASTRUCTURE DESIGN ASSOCIATES
1440 Broadway
Suite 304
Oakland, CA. 94612
Ph: (510) 238-8000
Fax: (510) 238-8009


EXPIRES 12/31/05
Regis. No. 05229
SIGNATURE

RISER DIAGRAM
FIBER OPTIC &
COPPER BACKBONE

SCIENCE BUILDING
LOS MEDANOS COLLEGE
Pittsburg CA
Contra Costa Community College District

ARCHITECT
tBP/Architecture
1000 Bunnett Avenue, Suite 140
Concord, CA 94520
p: 925.246.6419 f: 925.246.6495

ADDENDUM	#2
DATE:	05/11/05
DSA NO.	01-106226
THIS REVISES IN PART	
SHEET:	T5.1
SHEET:	SKT-25

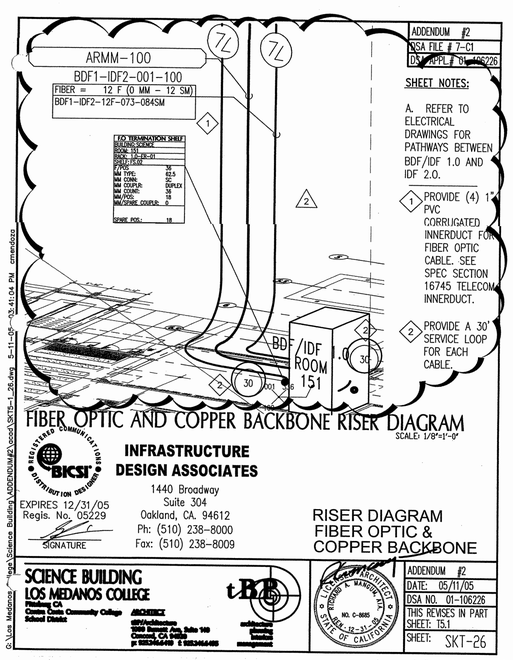

ADDENDUM #2
DSA FILE # 7-C1
DSA APPL # 01-106226

SHEET NOTES:

A. REFER TO ELECTRICAL DRAWINGS FOR PATHWAYS BETWEEN BDF/IDF 1.0 AND IDF 2.0.

1. PROVIDE (4) 1" PVC CORRUGATED INNERDUCT FOR FIBER OPTIC CABLE. SEE SPEC SECTION 16745 TELECOM INNERDUCT.
2. PROVIDE A 30' SERVICE LOOP FOR EACH CABLE.

FIBER OPTIC AND COPPER BACKBONE RISER DIAGRAM
SCALE: 1/8"=1'-0"

INFRASTRUCTURE DESIGN ASSOCIATES
1440 Broadway
Suite 304
Oakland, CA. 94612
Ph: (510) 238-8000
Fax: (510) 238-8009


EXPIRES 12/31/05
Regis. No. 05229
SIGNATURE

RISER DIAGRAM
FIBER OPTIC &
COPPER BACKBONE

SCIENCE BUILDING
LOS MEDANOS COLLEGE
Pittsburg CA
Contra Costa Community College District

ARCHITECT
tBP/Architecture
1000 Bunnett Avenue, Suite 140
Concord, CA 94520
p: 925.246.6419 f: 925.246.6495

ADDENDUM	#2
DATE:	05/11/05
DSA NO.	01-106226
THIS REVISES IN PART	
SHEET:	T5.1
SHEET:	SKT-26

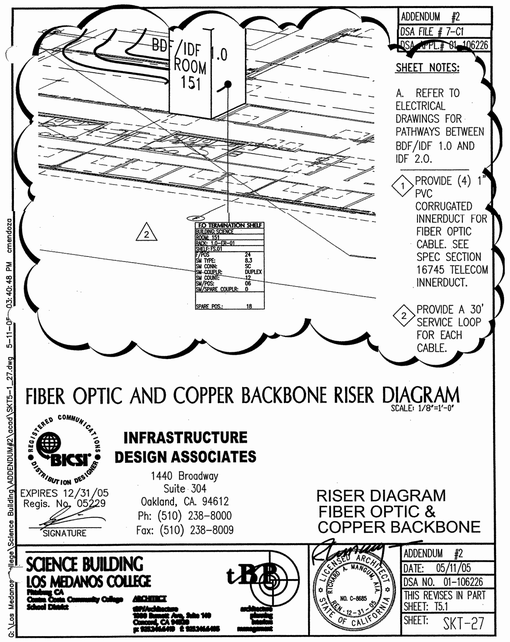

ADDENDUM #2
DSA FILE # 7-C1
DSA APPL # 01-106226

SHEET NOTES:

A. REFER TO ELECTRICAL DRAWINGS FOR PATHWAYS BETWEEN BDF/IDF 1.0 AND IDF 2.0.

1. PROVIDE (4) 1" PVC CORRUGATED INNERDUCT FOR FIBER OPTIC CABLE. SEE SPEC SECTION 16745 TELECOM INNERDUCT.
2. PROVIDE A 30' SERVICE LOOP FOR EACH CABLE.

FIBER OPTIC AND COPPER BACKBONE RISER DIAGRAM
SCALE: 1/8"=1'-0"

INFRASTRUCTURE DESIGN ASSOCIATES
1440 Broadway
Suite 304
Oakland, CA. 94612
Ph: (510) 238-8000
Fax: (510) 238-8009

EXPIRES 12/31/05
Regis. No. 05229
SIGNATURE

RISER DIAGRAM
FIBER OPTIC &
COPPER BACKBONE

SCIENCE BUILDING
LOS MEDANOS COLLEGE
Pittsburg CA
Contra Costa Community College District

ARCHITECT
tBP/Architecture
1000 Bunnett Avenue, Suite 140
Concord, CA 94520
p: 925.246.6419 f: 925.246.6495

ADDENDUM	#2
DATE:	05/11/05
DSA NO.	01-106226
THIS REVISES IN PART	
SHEET:	T5.1
SHEET:	SKT-27

architect

consultant

DSA IDENTIFICATION STAMP
DIV. OF THE STATE ARCHITECT
OFFICE OF REGULATION SERVICES
APP. NO. 01-106226
AC. FLS. SS.
DATE
RETAIN 7(C)

Division of the State Architect
Regional Office
1515 Clay St., Suite 1101
Oakland, CA 94612
p: 415-396-9500 f:

agency

SCIENCE BUILDING
LOS MEDANOS COLLEGE
Contra Costa Community College District

owner

tBP project number: 20241.00

file name:


drawn by: checked by:

date: NOVEMBER 15, 2004

Rev:	date:	description:

drawing title:
ADDENDUM # 2 DRAWINGS

LMC SCIENCE 313-023-T12.01-0-00.00
drawing no:
ATTACHMENT TO T5-1

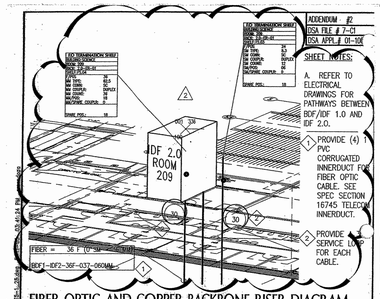

FIBER OPTIC AND COPPER BACKBONE RISER DIAGRAM
SCALE: 1/8"=1'-0"


INFRASTRUCTURE DESIGN ASSOCIATES
1440 Broadway
Suite 304
Oakland, CA 94612
Ph: (510) 238-8000
Fax: (510) 238-8009

EXPIRES 12/31/05
Regis. No. 05229
SIGNATURE

RISER DIAGRAM
FIBER OPTIC &
COPPER BACKBONE

SCIENCE BUILDING
LOS MEDANOS COLLEGE
Pittsburg, CA
Contra Costa Community College District

ADDENDUM #2
DATE: 05/11/05
DSA NO. 01-106226
THIS REVISES IN PART
SHEET: TS.1
SHEET: SKT-25

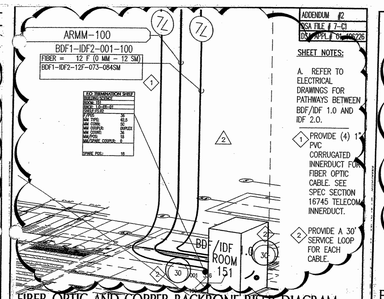

FIBER OPTIC AND COPPER BACKBONE RISER DIAGRAM
SCALE: 1/8"=1'-0"


INFRASTRUCTURE DESIGN ASSOCIATES
1440 Broadway
Suite 304
Oakland, CA 94612
Ph: (510) 238-8000
Fax: (510) 238-8009

EXPIRES 12/31/05
Regis. No. 05229
SIGNATURE

RISER DIAGRAM
FIBER OPTIC &
COPPER BACKBONE

SCIENCE BUILDING
LOS MEDANOS COLLEGE
Pittsburg, CA
Contra Costa Community College District

ADDENDUM #2
DATE: 05/11/05
DSA NO. 01-106226
THIS REVISES IN PART
SHEET: TS.1
SHEET: SKT-26

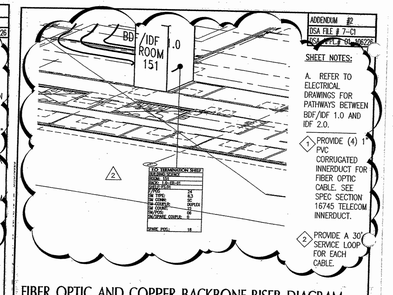

FIBER OPTIC AND COPPER BACKBONE RISER DIAGRAM
SCALE: 1/8"=1'-0"

INFRASTRUCTURE DESIGN ASSOCIATES
1440 Broadway
Suite 304
Oakland, CA 94612
Ph: (510) 238-8000
Fax: (510) 238-8009

EXPIRES 12/31/05
Regis. No. 05229
SIGNATURE

RISER DIAGRAM
FIBER OPTIC &
COPPER BACKBONE

SCIENCE BUILDING
LOS MEDANOS COLLEGE
Pittsburg, CA
Contra Costa Community College District

ADDENDUM #2
DATE: 05/11/05
DSA NO. 01-106226
THIS REVISES IN PART
SHEET: TS.1
SHEET: SKT-27

MATED-PAIR CONNECTOR RETURN LOSS	
TYPE	dB (max)
MULTIMODE	0.4
SINGLE MODE	0.4

FUSION SPLICE ATTENUATION	
TYPE	dB (max)
SINGLE MODE	0.1

MAXIMUM CABLE LOSS				
	WAVE LENGTH			
TYPE	850 nm	1300 nm	1310 nm	1550 nm
MULTIMODE	3.5 dB/km	1.0 dB/km		
SINGLE MODE			0.4 dB/km	0.3 dB/km

2 ATTENUATION BUDGET LOSS SCHEDULES


SHEET NOTES:

A. ALL EQUIPMENT SHOWN IS WORK OF THIS PHASE, UNLESS OTHERWISE NOTED.

B. ALL SINGLE MODE OPTICAL FIBER IS 50/125 MICRON, OFNP RATED, UNLESS OTHERWISE NOTED.

C. REFER TO ELECTRICAL DRAWINGS FOR PATHWAYS BETWEEN BDF/IDF 1.0 AND IDF 2.0.

1. PROVIDE 1" PLENUM-RATED INNERDUCT FOR FIBER OPTIC CABLE.
2. PROVIDE A 30' SERVICE LOOP FOR EACH CABLE.

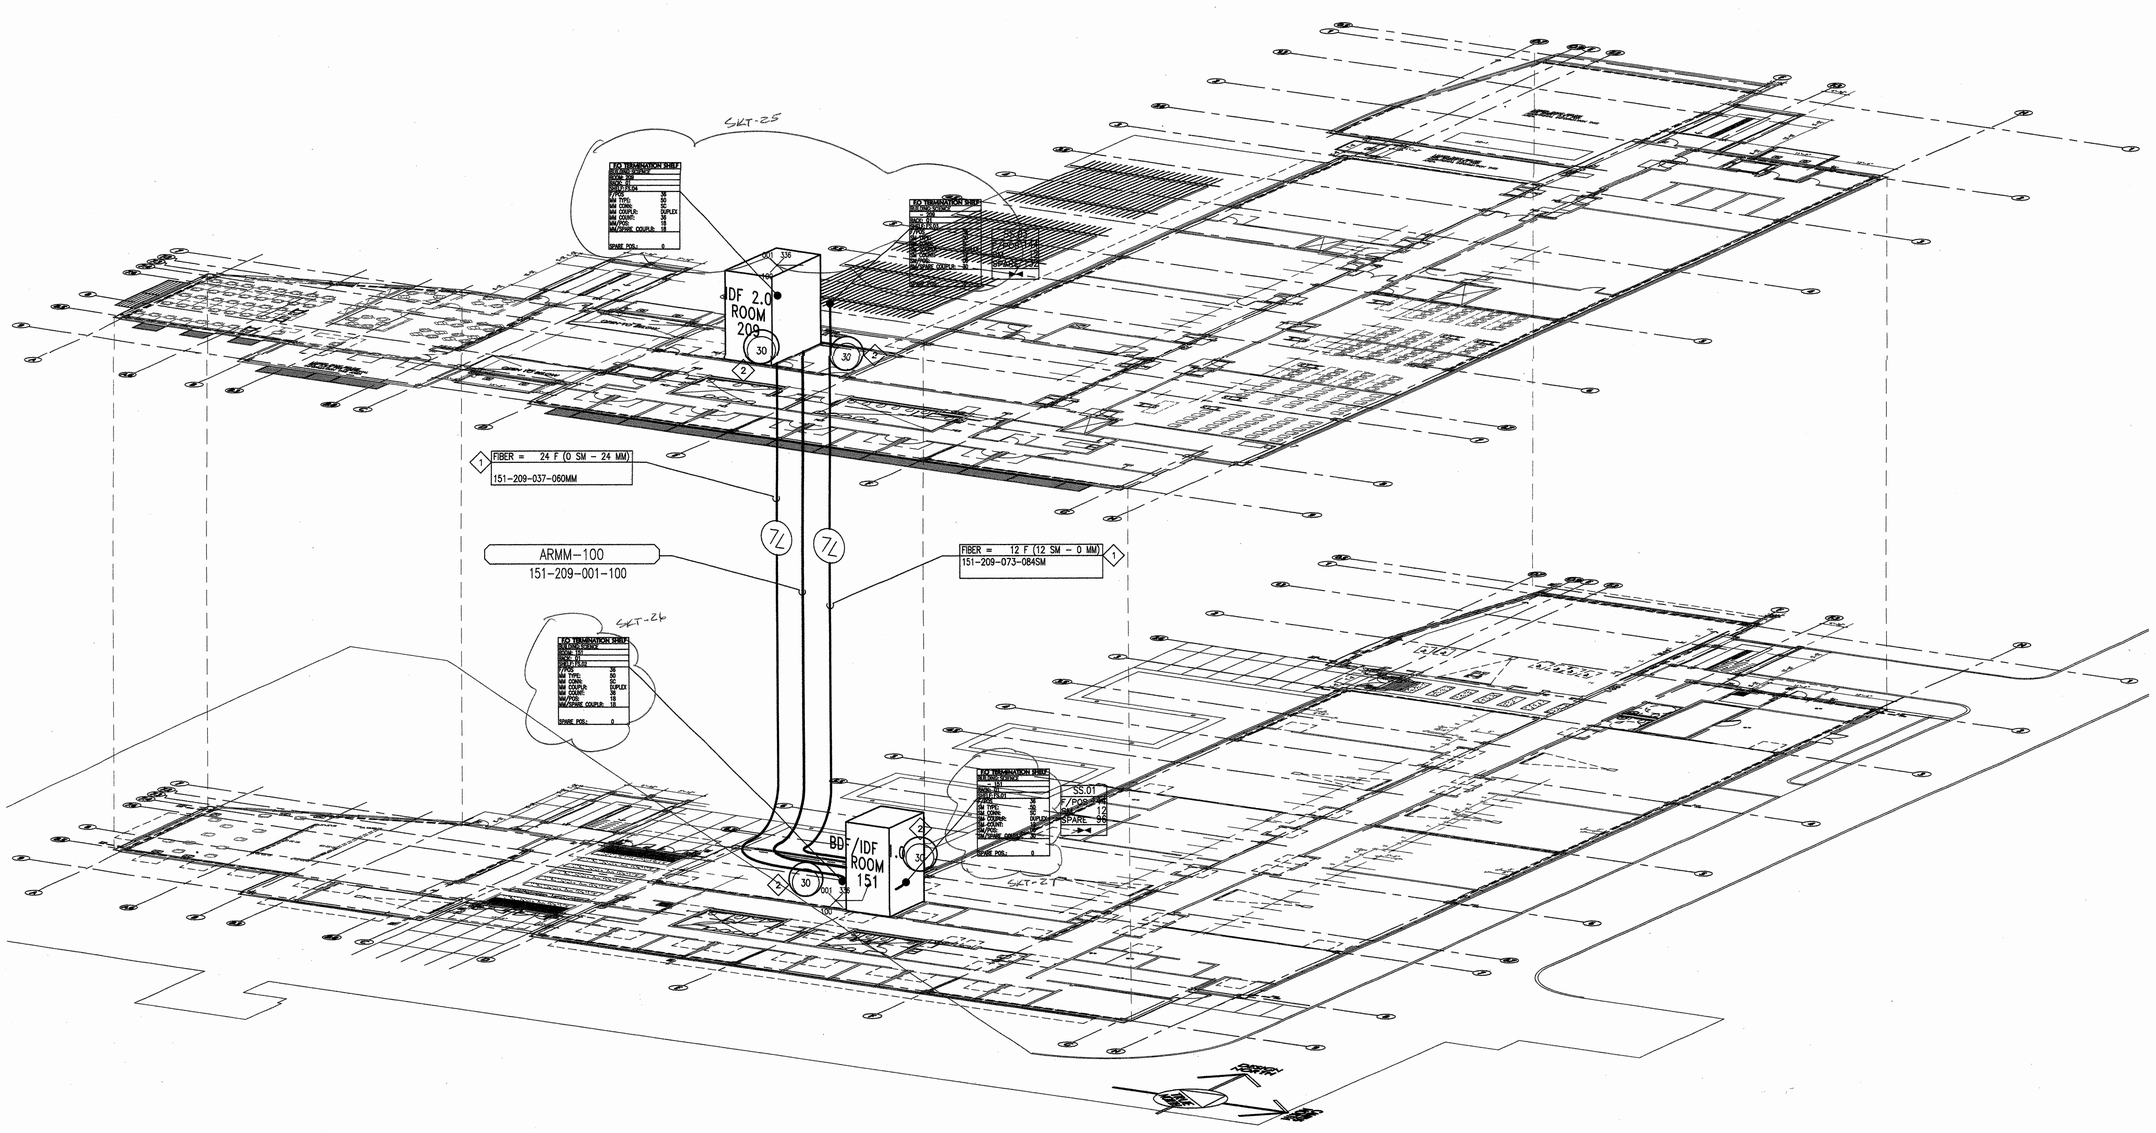

FIBER OPTIC AND COPPER BACKBONE RISER DIAGRAM 1

SCALE: 1/8"=1'-0"

tBP
architecture
planning
interiors
management

tBP/Architecture
1000 Burnett Avenue, Suite 140
Concord, CA 94520
p: 9252466419 f: 9252466495

INFRASTRUCTURE DESIGN ASSOCIATES
1440 Broadway
Suite 304
Oakland, CA 94612

EXPIRES 12/31/06
Regis. No. 06606
SIGNATURE

consultant

name
address
city, state, zip
ph: fx

SCIENCE BUILDING
LOS MEDANOS COLLEGE

Contra Costa Community College District

owner

tBP project number : 20247.00
file name:
drawn by: checked by:
date: NOVEMBER 15, 2004


1/8"=1'-0"

drawing title: building no:
RISER DIAGRAM
FIBER OPTIC &
COPPER BACKBONE

LMC SCIENCE 313-023-112.01-0-00.00
drawing no:
T5-1
drawing of

G:\Los Medanos College\Science Building\BID Set\ocad\T5-1.dwg 11-08-04 08:52:30 AM cmendoza

11 WALL BOX FLUSH DOUBLE GANG ANGLED FACEPLATE - WBFD1200
(1) TELEPHONE, (2) NETWORK

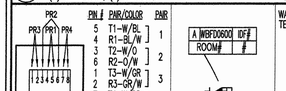


PIN #	PAIR/COLOR	PAIR
5	T1–W/BL	1
4	R1–BL/W	
3	T2–W/O	2
6	R2–O/W	
1	T3–W/GR	3
2	R3–GR/W	
7	T4–W/BR	4
8	R4–BR/W	

A WBFD1200 IDF# | ROOM# | #

WALL BOX FLUSH DOUBLE GANG
TERMINATION HARDWARE:
(1) 4–PAIR TELEPHONE STATION CABLE
(1) 8 PIN 8 POSITION TELEPHONE JACK
(2) 4–PAIR NETWORK STATION CABLES
(2) 8 PIN 8 POSITION NETWORK JACKS


A T568A PINNING | B SYMBOL | C DESCRIPTION

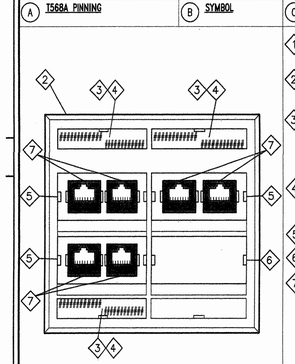

1. SEE PARTS MATRIX FOR SPECIFIC COLORS, FACEPLATE AND FIBER CONNECTIVITY COMPONENTS, CABLE TYPE, AND PART NUMBERS.
2. DOUBLE GANG FACEPLATE WITH FOUR OUTLET IDENTIFICATION LABELS WITH CLEAR COVERS, TWO MATCHING SCREW COVERS AND MOUNTING SCREWS.
3. CLEAR DESIGNATION STRIP HOLDER. OUTLET DESIGNATION SHALL BE PLACED BEHIND HOLDER AND SHALL NOT BE ADHERED TO HOLDER. USE 1.8" X 0.375", WHITE POLYESTER LABEL. LABEL SHALL BE LASER PRINTED. USE HELVETICA 10 AS LABELING FONT.
4. PROVIDE LABELING & FACE PLATE IDENTIFICATION AS SPECIFIED IN TELECOM IDENTIFICATION AND LABELING SPEC SECTION.
5. 2 UNIT DUAL OPENING FLUSHMOUNT UNLOADED MODULE FOR MOUNTING TWO JACKS.
6. 2 UNIT BLANK MODULE, TO FILL UNUSED OPENINGS.
7. 8 PIN 8 POS JACK FOR NETWORK STATION CABLE TERMINATION.
9. BLANK JACK TO FILL UNUSED OPENING.

D FACEPLATE | E NOTES

10 WALL BOX FLUSH DOUBLE GANG ANGLED FACEPLATE - WBFD0600
(6) NETWORK

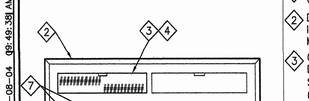

PIN #	PAIR/COLOR	PAIR
5	T1–W/BL	1
4	R1–BL/W	
3	T2–W/O	2
6	R2–O/W	
1	T3–W/GR	3
2	R3–GR/W	
7	T4–W/BR	4
8	R4–BR/W	

A WBFD0200 IDF# | ROOM# | #

WALL BOX FLUSH DOUBLE GANG
TERMINATION HARDWARE:
(2) 4–PAIR NETWORK STATION CABLES
(2) 8 PIN 8 POSITION NETWORK JACKS


A T568A PINNING | B SYMBOL | C DESCRIPTION

1. SEE PARTS MATRIX FOR SPECIFIC COLORS, FACEPLATE COMPONENTS, CABLE TYPE AND PART NUMBERS.
2. DOUBLE GANG FACEPLATE WITH FOUR OUTLET IDENTIFICATION LABELS WITH CLEAR COVERS, TWO MATCHING SCREW COVERS AND MOUNTING SCREWS.
3. CLEAR DESIGNATION STRIP HOLDER. OUTLET DESIGNATION SHALL BE PLACED BEHIND HOLDER AND SHALL NOT BE ADHERED TO HOLDER. USE 1.8" X 0.375", WHITE POLYESTER LABEL. LABEL SHALL BE LASER PRINTED. USE HELVETICA 10 AS LABELING FONT.
4. PROVIDE LABELING & FACE PLATE IDENTIFICATION AS SPECIFIED IN TELECOM IDENTIFICATION AND LABELING SPECIFICATION SECTION.
5. 2 UNIT DUAL OPENING FLUSHMOUNT UNLOADED MODULE FOR MOUNTING TWO JACKS.
6. 2 UNIT BLANK MODULE, TO FILL UNUSED OPENINGS.
7. 8 PIN 8 POS JACK FOR NETWORK STATION CABLE TERMINATION.

D FACEPLATE | E NOTES

9 WALL BOX FLUSH DOUBLE GANG ANGLED FACEPLATE - WBFD0200
(2) NETWORK

8 WALL TELEPHONE FACE PLATE - WALL1000
(1) TELEPHONE

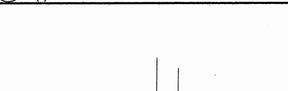


PIN #	PAIR/COLOR	PAIR
5	T1–W/BL	1
4	R1–BL/W	
3	T2–W/O	2
6	R2–O/W	
1	T3–W/GR	3
2	R3–GR/W	
7	T4–W/BR	4
8	R4–BR/W	

A WALL1000 IDF# | ROOM# | STA#

WALL TELEPHONE FACE PLATE
TERMINATION HARDWARE:
(1) 4 PAIR CATEGORY 6 CABLE
(1) 8 PIN 8 POSITION TELEPHONE JACK

A T568A PINNING | B OUTLET SYMBOL | C OUTLET DESCRIPTION

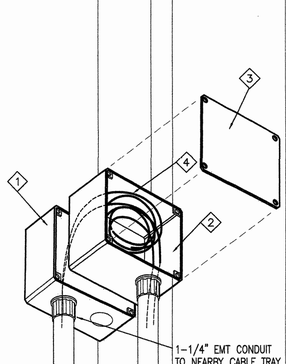

1. WALL PHONE PLATE WITH MOUNTING STUDS
2. PROVIDE LASER PRINTED LABELING AS SPECIFIED IN 16806 & 16812.
3. 8 PIN 8 POS JACK FOR TELEPHONE STATION CABLE TERMINATION.

D OUTLET FACEPLATE | E FACEPLATE NOTES

7 WIRELESS ACCESS POINT INTERFACE

PIN #	PAIR/COLOR	PAIR
5	T1–W/BL	1
4	R1–BL/W	
3	T2–W/O	2
6	R2–O/W	
1	T3–W/GR	3
2	R3–GR/W	
7	T4–W/BR	4
8	R4–BR/W	

A WAPS0200 IDF# | ROOM# | STA#

WIRELESS ACCESS POINT
TERMINATION HARDWARE:
(2) 4–PAIR NETWORK STATION CABLES.
(2) 8 PIN 8 POSITION NETWORK JACKS


(2) WIRELESS NETWORK ACCESS POINTS

A T568A PINNING | E OUTLET SYMBOL

F OUTLET DESCRIPTION

1. 4–11/16" DEEP ELECTRICAL BOX, MOUNTED FLUSH TO WALL, 12" ABOVE THE FACE OF THE FINISHED CEILING TO THE BOTTOM OF THE BOX.
2. 2–1/8" EXTENSION RING WITH 3/4" KNOCKOUT. MOUNT ON BACKBOX TO EXTEND BEYOND WALL SURFACE.
3. COVER FOR EXTENSION RING.
4. PROVIDE 12" LOOP OF CABLE INSIDE OF WALL BOX. LABEL CABLE INSIDE WALL BOX WITHIN SIX INCHES OF POINT OF ENTRY INTO BOX.
5. 3/4" FLEXIBLE METAL CONDUIT, CONNECTED TO WALL MOUNT BOX THROUGH KNOCK–OUT AT EXTENSION RING. PROVIDE 30" COIL, HELD TOGETHER BY CABLE TIES AND TEMPORARILY MOUNTED ADJACENT TO THE WALL BOX IN SECOND 4–11/16" DEEP ELECTRICAL BOX WITH COVER.
6. MOVABLE 4–11/16" DEEP ELECTRICAL BOX WITH COVER FOR HOLDING MULTIMEDIA BOX. THIS BOX WILL BE RELOCATED BY OTHERS FOR FUTURE CONNECTION TO WIRELESS ACCESS POINT.
7. SINGLE INSERT MULTIMEDIA BOX.
8. 2 UNIT DUAL OPENING FLUSHMOUNT UNLOADED MODULE FOR MOUNTING
9. 8 PIN 8 POS, T568A CATEGORY 6 JACK. FOR DATA STATION CABLE TERMINATION.
10. WIREMOLD LABELING INSERT, ACEP. OUTLET DESIGNATION SHALL BE PLACED BEHIND CLEAR PLASTIC PROTECTOR AND SHALL NOT BE ADHERED TO SURFACE. USE PANDUIT EFPL–1 DESIGNATION STRIP LABEL. TYPICAL FOR ALL LABELING.
11. LABELING PER SPECIFICATIONS AND THE STATION CABLE SCHEDULES. LABELING SHALL BE LASER PRINTED. USE HELVETICA 10 POINT FONT.

A MOVABLE INTERFACE BOX | G FACEPLATE NOTES

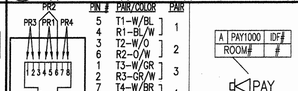


PIN #	PAIR/COLOR	PAIR
5	T1–W/BL	1
4	R1–BL/W	
3	T2–W/O	2
6	R2–O/W	
1	T3–W/GR	3
2	R3–GR/W	
7	T4–W/BR	4
8	R4–BR/W	

A RALD0200 IDF# | ROOM# | #

RACEWAY ALUMINUM DUAL CHANNEL
TERMINATION HARDWARE:
(2) 4–PAIR NETWORK STATION CABLES
(2) 8 PIN 8 POSITION NETWORK JACKS

A T568A PINNING | B SYMBOL | C DESCRIPTION

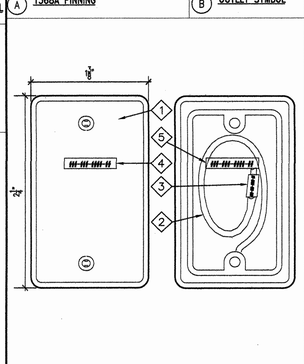

1. SEE PARTS MATRIX FOR SPECIFIC COLORS, FACEPLATE COMPONENTS, CABLE TYPE, AND PART NUMBERS.
2. LOW PROFILE BEZEL IN ALUMINUM RACEWAY COVER WITH TWO OUTLET IDENTIFICATION LABELS WITH CLEAR COVERS.
3. CLEAR DESIGNATION STRIP HOLDER. OUTLET DESIGNATION SHALL BE PLACED BEHIND HOLDER AND SHALL NOT BE ADHERED TO HOLDER. USE 1.8" X 0.375", WHITE POLYESTER LABEL. LABEL SHALL BE LASER PRINTED. USE HELVETICA 10 AS LABELING FONT.
4. PROVIDE LABELING & FACE PLATE IDENTIFICATION AS SPECIFIED IN TELECOM IDENTIFICATION AND LABELING SPEC SECTION.
5. 2 UNIT DUAL OPENING FLUSHMOUNT UNLOADED MODULE FOR MOUNTING TWO JACKS.
6. 2 UNIT BLANK MODULE, TO FILL UNUSED OPENINGS.
7. JACK FOR NETWORK STATION CABLE TERMINATION.

D FACEPLATE | E NOTES

6 RACEWAY ALUMINUM DUAL CHANNEL - RALD0200
(0) TELEPHONE, (2) NETWORK, (0) MM OPTICAL FIBER, (0) BROADBAND

PIN #	PAIR/COLOR	PAIR
5	T1–W/BL	1
4	R1–BL/W	
3	T2–W/O	2
6	R2–O/W	
1	T3–W/GR	3
2	R3–GR/W	
7	T4–W/BR	4
8	R4–BR/W	

A PAY1000 IDF# | ROOM# | #


PAY TELEPHONE FACE PLATE
TERMINATION HARDWARE:
(1) 4–PAIR TELEPHONE STATION CABLE

A T568A PINNING | B OUTLET SYMBOL | C OUTLET DESCRIPTION

1. STAINLESS STEEL COVER PLATE.
2. COIL 12" OF 4 PAIR CABLE IN ENCLOSURE.
3. LABEL CABLE WITHIN 6" OF TERMINATED END.
4. PANDUIT, EFPL–1, 1.80" x 0.375", WHITE, POLYESTER LABEL. USE HELVETICA 10, AS THE LABELING FONT.
5. PANDUIT, EFPL–1, 1.80" x 0.375", WHITE, POLYESTER LABEL. USE HELVETICA 10, AS THE LABELING FONT. AFFIX TO REAR OF ELECTRICAL BOX.

D OUTLET FACEPLATE | E FACEPLATE NOTES

5 PAY TELEPHONE FACE PLATE - PAY1000

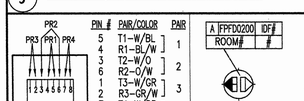


PIN #	PAIR/COLOR	PAIR
5	T1–W/BL	1
4	R1–BL/W	
3	T2–W/O	2
6	R2–O/W	
1	T3–W/GR	3
2	R3–GR/W	
7	T4–W/BR	4
8	R4–BR/W	

A FPFD0200 IDF# | ROOM# | #

FLOOR POKE–THRU FLUSH DOUBLE
TERMINATION HARDWARE:
(2) 4–PAIR NETWORK STATION CABLES
(2) 8 PIN 8 POSITION NETWORK JACKS

A T568A PINNING | B SYMBOL | C DESCRIPTION

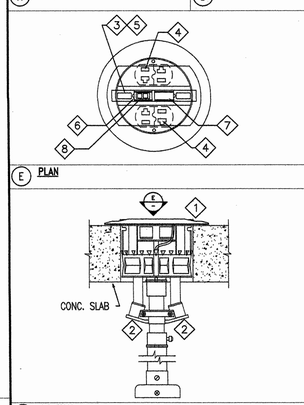

E PLAN

1. WIREMOLD RC4 SERIES FLOOR POKE–THRU, FLUSH, PROVIDED AND INSTALLED BY ELECTRICAL CONTRACTOR. SEE PARTS MATRIX FOR SPECIFIC COLORS, FACEPLATE AND CONNECTIVITY COMPONENTS, CABLE TYPE, AND PART NUMBERS.
2. 1" CONDUIT CONNECTION FOR DATA CABLES.
3. LABEL LOCATIONS. PROVIDE LABELING & FACE PLATE IDENTIFICATION AS SPECIFIED IN TELECOM IDENTIFICATION AND LABELING SPEC SECTION.
4. ELECTRICAL RECEPTACLE.
5. CLEAR DESIGNATION STRIP HOLDER. OUTLET DESIGNATION SHALL BE PLACED BEHIND HOLDER AND SHALL NOT BE ADHERED TO HOLDER. USE 1.8" X 0.375", WHITE POLYESTER LABEL. LABEL SHALL BE LASER PRINTED. USE HELVETICA 10 AS LABELING FONT.
6. 2–UNIT DUAL OPENING FLUSHMOUNT UNLOADED MODULE FOR MOUNTING TWO JACKS.
7. 2–UNIT BLANK MODULE, TO FILL UNUSED OPENING.
8. 8 PIN 8 POSITION JACK FOR NETWORK STATION CABLE TERMINATION.

D SECTION | F NOTES

4 FLOOR POKE-THRU FLUSH DOUBLE - FPFD0200
(2) NETWORK

3 FLOOR BOX SHALLOW DUPLEX - FBSD0600
(6) NETWORK




PIN #	PAIR/COLOR	PAIR
5	T1–W/BL	1
4	R1–BL/W	
3	T2–W/O	2
6	R2–O/W	
1	T3–W/GR	3
2	R3–GR/W	
7	T4–W/BR	4
8	R4–BR/W	

A FBSD0600 IDF# | ROOM# | STA#

FLOOR BOX SHALLOW DUPLEX
TERMINATION HARDWARE:
(6) 4–PAIR NETWORK STATION CABLES
(6) 8 PIN 8 POSITION NETWORK JACKS

A T568A PINNING | B SYMBOL | C DESCRIPTION

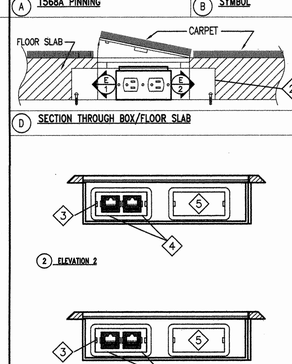


D SECTION THROUGH BOX/FLOOR SLAB | E ELEVATIONS

1. SEE PARTS MATRIX FOR SPECIFIC COLORS, FACEPLATE AND CONNECTIVITY COMPONENTS, CABLE TYPE AND PART NUMBERS.
2. RECESSED FLOOR BOX HOUSING ELECTRICAL AND COMMUNICATION DEVICES.
3. 2–UNIT DUAL OPENING FLUSHMOUNT UNLOADED MODULE FOR MOUNTING TWO JACKS.
4. 8 PIN 8 POS JACK FOR NETWORK STATION CABLE TERMINATION.
5. BLANK COVER TO FILL EMPTY JACK OPENING. FINISH TO MATCH THE INSERT.

F NOTES

2 FLOOR BOX SHALLOW DUPLEX - FBSD0400
(4) NETWORK

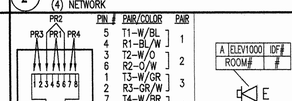


PIN #	PAIR/COLOR	PAIR
5	T1–W/BL	1
4	R1–BL/W	
3	T2–W/O	2
6	R2–O/W	
1	T3–W/GR	3
2	R3–GR/W	
7	T4–W/BR	4
8	R4–BR/W	

A FBSD0400 IDF# | ROOM# | STA#

FLOOR BOX SHALLOW DUPLEX
TERMINATION HARDWARE:
(4) 4–PAIR NETWORK STATION CABLES
(4) 8 PIN 8 POSITION NETWORK JACKS

A T568A PINNING | B SYMBOL | C DESCRIPTION

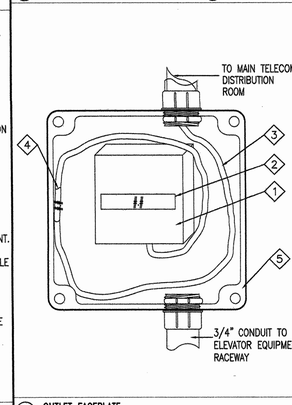

D SECTION THROUGH BOX/FLOOR SLAB | E ELEVATIONS

1. SEE PARTS MATRIX FOR SPECIFIC COLORS, FACEPLATE AND CONNECTIVITY COMPONENTS, CABLE TYPE AND PART NUMBERS.
2. RECESSED FLOOR BOX HOUSING ELECTRICAL AND COMMUNICATION DEVICES.
3. 2–UNIT DUAL OPENING FLUSHMOUNT UNLOADED MODULE FOR MOUNTING TWO JACKS.
4. 8 PIN 8 POS JACK FOR NETWORK STATION CABLE TERMINATION.
5. 2 UNIT BLANK MODULE, TO FILL UNUSED OPENINGS.

F NOTES

2 FLOOR BOX SHALLOW DUPLEX - FBSD0400
(4) NETWORK

PIN #	PAIR/COLOR	PAIR
5	T1–W/BL	1
4	R1–BL/W	
3	T2–W/O	2
6	R2–O/W	
1	T3–W/GR	3
2	R3–GR/W	
7	T4–W/BR	4
8	R4–BR/W	

A ELEV1000 IDF# | ROOM# | #

ELEVATOR TELEPHONE INTERFACE
TERMINATION HARDWARE:
(1) 4–PAIR CATEGORY 6 NETWORK STATION CABLE.
(1) 8 PIN, 8 POSITION TERMINAL BLOCK.

(1) TELEPHONE

A T568A PINNING | A OUTLET SYMBOL | B OUTLET DESCRIPTION

C OUTLET FACEPLATE | D FACEPLATE NOTES

1. 8 POSITION, SCREW TERMINAL BLOCK.
2. PANDUIT, PLL–5–Y2–10 , 0.80 X 0.25 INCH, WHITE, POLYESTER LABEL. LABELS COME 312 PER SHEET ARRAYED IN 8 COLUMNS FOR LASER PRINTERS. USE HELVETICA 9 AS THE LABELING FONT.
3. 4 PAIR STATION CABLE TERMINATED ON 8 POSITION TERMINAL BLOCK FOR ELEVATOR PHONE INTERFACE.
4. LABEL CABLE WITHIN 6 INCHES OF SCREW TERMINAL BLOCK.
5. 4S DEEP ELECTRICAL BOX, PROVIDE WITH COVER.

1 ELEVATOR TELEPHONE INTERFACE - ELEV1000A

tBP
architecture
planning
interiors
management

LICENSED ARCHITECT © CALIFORNIA 25732 REGISTERED © STATE OF CALIFORNIA

tBP/architecture
1000 Bunnett Avenue, Suite 140
Concord, CA 94520
p. 925.246.6419 f. 925.246.6495

INFRASTRUCTURE DESIGN ASSOCIATES
1440 Broadway
Suite 304
Oakland, CA. 94612

COMMUNICATIONS INFRASTRUCTURE DESIGN CONSULTANTS
EXPIRES: 12/31/06
Regis. No. 06606
SIGNATURE

consultant

DSA IDENTIFICATION STAMP
DIV. OF THE STATE ARCHITECT
OFFICE OF REGULATION SERVICES
APP. 10/19/04
INCREMENT NO.
DATE 1-19-05

name
address
city, state, zip
ph: fx:

SCIENCE BUILDING
LOS MEDANOS COLLEGE
Contra Costa Community College District

owner

tBP project number : 20247.00
file name:
drawn by: checked by:
date: NOVEMBER 15, 2004


NTS

drawing title: DETAILS TELECOM OUTLETS
building no:

LMC SCIENCE 313-023-T12.01-0-00.00
drawing no: T6-0
drawing of

J:\Los Medanos College\Science Building\SB0_Set Vocad\T6-0.dwg, 11-08-04 09:49:38 AM, cmendoza

BULLETIN #15A
DSA FILE # 7-C1
DSA APPL.# 01-106226

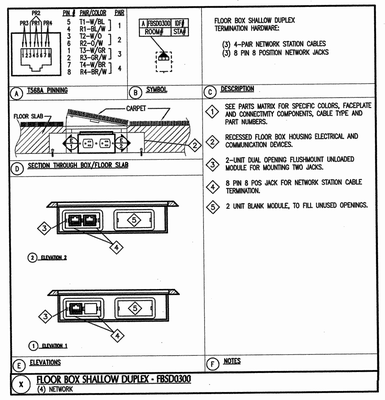

INFRASTRUCTURE DESIGN ASSOCIATES
1440 Broadway
Suite 304
Oakland, CA. 94612
Ph: (510) 238-8000
Fax: (510) 238-8009

SCIENCE BUILDING
LOS MEDANOS COLLEGE
Pittsburg CA
Contra Costa Community College
School District

ARCHITECT
tBP/Architecture
1000 Burnett Ave, Suite 140
Concord, CA 94520
p: 925.246.6419 f: 925.246.6495


tBP architecture planning interiors management

LICENSED ARCHITECT RICHARD K. MARKHAM NO. C-8685 REN. 12-31-07 STATE OF CALIFORNIA

BULLETIN #15A
DATE: 03/15/06
DSA NO. 01-106226
THIS REVISES IN PART
SHEET: T6-1
SHEET: SKT15A.3

\\do-files\...\Outsource\Los Medanos College\Science Building\BULLETIN #15\T...\text\SKT15A.3.dwg 3-17-06 10:52:42 AM CMendoza

BULLETIN #15A
DSA FILE # 7-C1
DSA APPL.# 01-106226

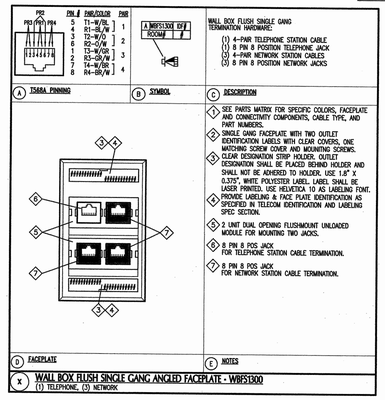

INFRASTRUCTURE DESIGN ASSOCIATES
1440 Broadway
Suite 304
Oakland, CA. 94612
Ph: (510) 238-8000
Fax: (510) 238-8009

SCIENCE BUILDING
LOS MEDANOS COLLEGE
Pittsburg CA
Contra Costa Community College
School District

ARCHITECT
tBP/Architecture
1000 Burnett Ave, Suite 140
Concord, CA 94520
p: 925.246.6419 f: 925.246.6495


tBP architecture planning interiors management

LICENSED ARCHITECT RICHARD K. MARKHAM NO. C-8685 REN. 12-31-07 STATE OF CALIFORNIA

BULLETIN #15A
DATE: 03/15/06
DSA NO. 01-106226
THIS REVISES IN PART
SHEET: T6-1
SHEET: SKT15A.4

\\do-files\...\Outsource\Los Medanos College\Science Building\BULLETIN #15\T...\text\SKT15A.4.dwg 3-17-06 10:51:27 AM CMendoza

BULLETIN # 10B
DSA FILE # 7-C1
DSA APPL.# 01-106226

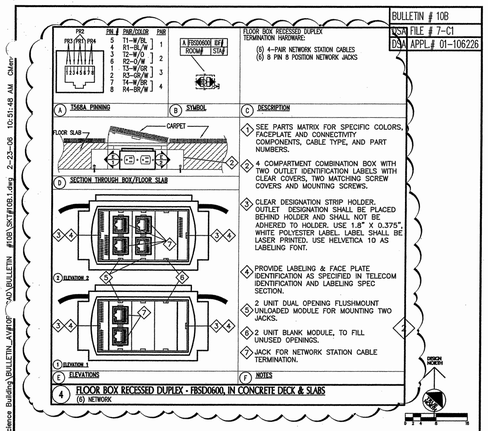

INFRASTRUCTURE DESIGN ASSOCIATES
1440 Broadway
Suite 304
Oakland, CA. 94612
Ph: (510) 238-8000
Fax: (510) 238-8009

SCIENCE BUILDING
LOS MEDANOS COLLEGE
Pittsburg CA
Contra Costa Community College
School District

ARCHITECT
tBP/Architecture
1000 Burnett Ave, Suite 140
Concord, CA 94520
p: 925.246.6419 f: 925.246.6495

tBP architecture planning interiors management


LICENSED ARCHITECT RICHARD K. MARKHAM NO. C-8685 REN. 12-31-07 STATE OF CALIFORNIA

BULLETIN #10B
DATE: 02/23/06
DSA NO. 01-106226
THIS REVISES IN PART
SHEET: T6.1
SHEET: SKT-10B.1

\\do-files\...\Outsource\Los Medanos College\Science Building\BULLETIN_AV#08\CAD\BULLETIN #10B\SKT#08.2.dwg 2-23-06 10:51:48 AM CMendoza

T6.1
OUTLET AND
FACEPLATE DETAILS

BULLETIN #15A
DSA FILE # 7-C1
DSA APPL.# 01-106226

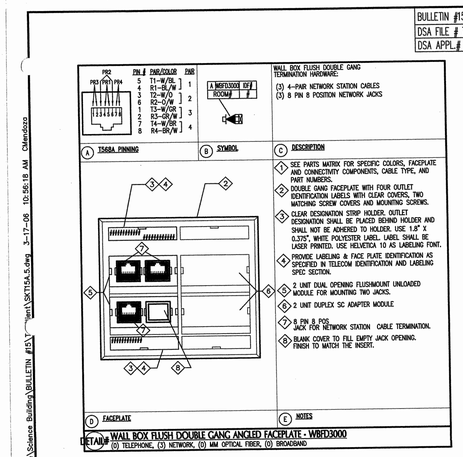

INFRASTRUCTURE DESIGN ASSOCIATES
1440 Broadway
Suite 304
Oakland, CA. 94612
Ph: (510) 238-8000
Fax: (510) 238-8009

SCIENCE BUILDING
LOS MEDANOS COLLEGE
Pittsburg CA
Contra Costa Community College
School District

ARCHITECT
tBP/Architecture
1000 Burnett Ave, Suite 140
Concord, CA 94520
p: 925.246.6419 f: 925.246.6495


tBP architecture planning interiors management

LICENSED ARCHITECT RICHARD K. MARKHAM NO. C-8685 REN. 12-31-07 STATE OF CALIFORNIA

BULLETIN #15A
DATE: 03/15/06
DSA NO. 01-106226
THIS REVISES IN PART
SHEET: T6-1
SHEET: SKT15A.5

\\do-files\...\Outsource\Los Medanos College\Science Building\BULLETIN #15\T...\text\SKT15A.5.dwg 3-17-06 10:56:18 AM CMendoza

BULLETIN #15A
DSA FILE # 7-C1
DSA APPL.# 01-106226

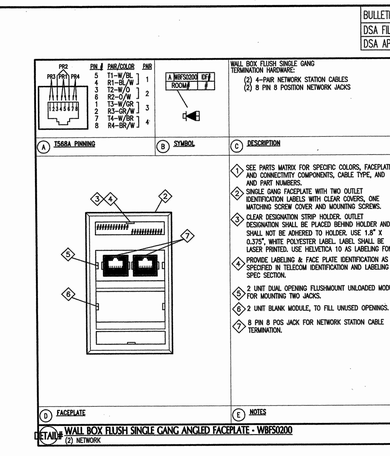

INFRASTRUCTURE DESIGN ASSOCIATES
1440 Broadway
Suite 304
Oakland, CA. 94612
Ph: (510) 238-8000
Fax: (510) 238-8009

SCIENCE BUILDING
LOS MEDANOS COLLEGE
Pittsburg CA
Contra Costa Community College
School District

ARCHITECT
tBP/Architecture
1000 Burnett Ave, Suite 140
Concord, CA 94520
p: 925.246.6419 f: 925.246.6495

tBP architecture planning interiors management


LICENSED ARCHITECT RICHARD K. MARKHAM NO. C-8685 REN. 12-31-07 STATE OF CALIFORNIA

BULLETIN #15A
DATE: 03/15/06
DSA NO. 01-106226
THIS REVISES IN PART
SHEET: T6-1
SHEET: SKT15A.6

\\do-files\...\Outsource\Los Medanos College\Science Building\BULLETIN #15\T...\text\SKT15A.6.dwg 3-17-06 10:49:51 AM CMendoza

Sent By: INFRASTRUCTURE DESIGN ASSOCIATES; 15102388009; Feb-23-06 3:09PM; Page 1/1

BULLETIN # 10B
DSA FILE # 7-C1
DSA APPL.# 01-106226

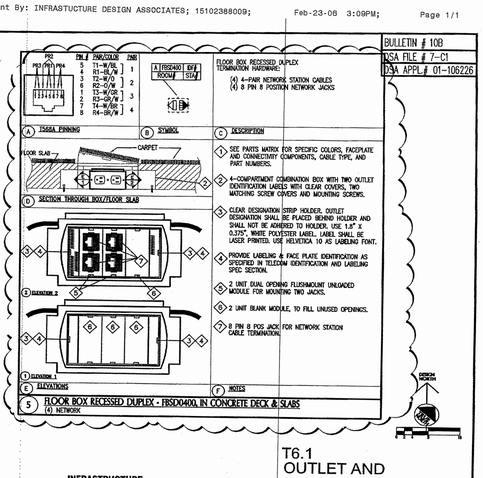

T6.1
OUTLET AND
FACEPLATE DETAILS

INFRASTRUCTURE DESIGN ASSOCIATES
1440 Broadway
Suite 304
Oakland, CA. 94612
Ph: (510) 238-8000
Fax: (510) 238-8009

SCIENCE BUILDING
LOS MEDANOS COLLEGE
Pittsburg CA
Contra Costa Community College
School District

ARCHITECT
tBP/Architecture
1000 Burnett Ave, Suite 140
Concord, CA 94520
p: 925.246.6419 f: 925.246.6495

tBP architecture planning interiors management

LICENSED ARCHITECT RICHARD K. MARKHAM NO. C-8685 REN. 12-31-07 STATE OF CALIFORNIA

BULLETIN #10B
DATE: 02/23/06
DSA NO. 01-106226
THIS REVISES IN PART
SHEET: T6.1
SHEET: SKT-10B.2

\\do-files\...\Outsource\Los Medanos College\Science Building\BULLETIN #10B\SKT#08.2.dwg 2-23-06 12:50:18 PM CMendoza

tBP
architecture
planning
interiors
management

tBP/Architecture
1000 Burnett Avenue, Suite 140
Concord, CA 94520
p: 925.246.6419 f: 925.246.6495

architect

consultant

DSA IDENTIFICATION STAMP
BY DIVISION OF THE STATE ARCHITECT
OFFICE OF REGIONAL PROJECTS
APPL. NO. 01-106226
ACC. FLS SS
DATE

Division of the State Architect
Regional Office
1515 Clay St., Suite 1201
Oakland, CA 94612
p: 415-396-9500 f:

agency

SCIENCE BUILDING
LOS MEDANOS COLLEGE
Contra Costa Community College District


owner


tBP project number : 20241.00
file name:
drawn by: checked by:
date: NOVEMBER 15, 2004

Rev:	date:	description:

drawing title:
BULLETIN 10B & 15A DRAWINGS

LMC SCIENCE 313-023-112.01-0-00.00
drawing no:
ATTACHMENT TO T6-1

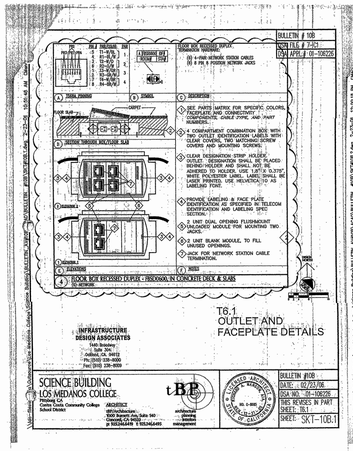

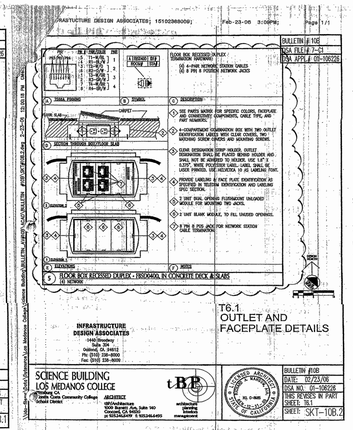

S. J. AMOROSO
Request For Information/Clarification

DSA FILE NO. 7-C1
DSA APPL. No. 01-106226

To: tBP/Architecture
1000 Burnett Ave, Suite 140
Concord, CA 94520

Project: LOS MEDANOS COLLEGE SCIENCE BUILDING
Contra Costa Community College District
tBP pjtc 20247.00

Attn: Celia Chiang, Tom Beckett
Fax: 925-246-0495

Subj.: Rigid PVC In Lieu of EMT Conduit

RFI No: 157

Reference (dwg, spec.) T6-1

Subcontractor RFI: EWS-8

Reply Requested By: 3/2/06

INFORMATION REQUESTED: Date: 2/23/06

Please note the attached Scott Electric RFI No. 8 regarding the use of Rigid PVC Conduit in lieu of EMT running to the first floor, floor boxes. Please advise.

SUGGESTED SOLUTION:

Cost Impact: ☐ Schedule Impact: ☐ days By: Mark Delgado

RESPONSE: DATE: 2.3.06

Not! NAIF Review has no objection to the use of PVC rigid conduit, in lieu of EMT, but at no additional cost to Owner.

Attachments:

By: Lisa/PMP

TRANSMITTAL RECORD:

FROM	TO	DATE
S.J. AMOROSO	tBP / ARCHITECTURE	2/23/06
tBP / ARCHITECTURE	ENGINEER/CONSULTANT	2.23.06
ENGINEER/CONSULTANT	tBP / ARCHITECTURE	3.3.06
tBP / ARCHITECTURE	S.J. AMOROSO	3.3.06
S.J. AMOROSO	ORIGINATOR	3.3.06

RFI # 000
Page 1

EDWARD W. SCOTT ELECTRIC CO., INC.
435 BARRETT STREET
San Francisco, Ca 94103-4914
Phone: (415) 626-0701 Fax: (415) 626-2837

REQUEST FOR INFORMATION

PROJECT: SCIENCE BLDG. R.F.I.# 8 R.F.I. Date: 2/21/06
JOB: 2451 ACTUAL REPLY DATE:

TO: MARK DELGADO
OF: AMOROSO CONST.
REF: DWG: T6-1
LOCATION: RE: FL. VARIOUS

POTENTIAL COST IMPACT
___ COST ___ SCHEDULE
___ OTHER ___ LABOR
___ NO IMPACT ___ MATERIAL


INFORMATION REQUESTED: DETAIL "A" ON DWG. T6-1
DEFECTS: RUNNING EMT TO THE SHARED FLOOR BOXES. WE WOULD LIKE TO RECOMMEND THE USE OF RIGID PVC CONDUIT ON THE 1ST FL. DUE TO THE FACT THAT IT IS MORE DURABLE DURING BACKFILL AND IT WILL NOT DETERIORATE IN DIRECT CONTACT TO EARTH OR MOISTURE.


REPLY REQUIRED BY: ASAP SIGNED:
NOTE: IF NO REPLY IS RECEIVED BY US BY/THE ABOVE NOTED DATE, A TIME EXTENSION WILL BE REQUIRED WITH POSSIBLE COST IMPACTS.


RESPONSE:


DATED: SIGNED:

INDUSTRIAL, COMMERCIAL WIRING & REPAIR
STATE CONTRACTOR LICENSE NO. 190426

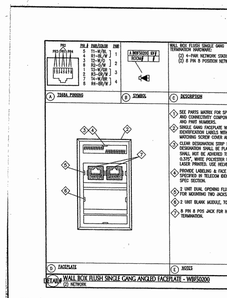

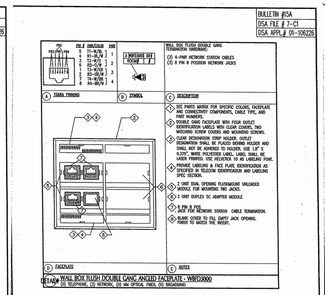


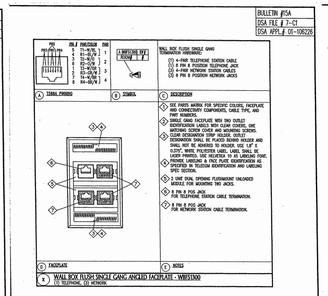

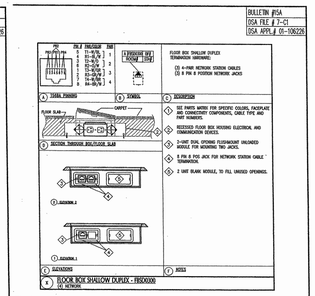

PART DESCRIPTION	PASS & SEYMOUR PART # WIREMOLD OR EQUAL (NO KNOWN EQUAL)	KRONE PART #
SINGLE GANG ANGLED DUPLEX FACEPLATE	AC-SAP-WH	
DOUBLE GANG ANGLED QUADPLEX FACEPLATE	AC-DAP-WH	
GFI RECEPTACLE COVER, BRASS	828GFITC	
ACTIVATE BEZEL	CM-MAB	
2-UNIT SINGLE OPENING MODULE	2A-U1KEY-WH	
2-UNIT DUAL OPENING MODULE	2A-U2KEY-WH	
2-UNIT SINGLE OPENING MODULE	2A-U1ATT-WH	
2-UNIT DUAL OPENING MODULE	2A-U2ATT-WH	
2-UNIT BLANK MODULE	2A-BL-WH	
8 PIN, 8 POS. T568A CAT6 NETWORK JACK, BLUE		6645-1-800-06
8 PIN, 8 POS. T568A CAT6 TEL JACK, WHITE		6645-1-800-01
4-PAIR NETWORK STATION CABLE, CAT6 PLENUM, BLUE		TN6SP-BL02
4-PAIR TELEPHONE STATION CABLE, CAT6 PLENUM, WHITE		TN6SP-WT02

3 OUTLET PARTS SCHEDULE

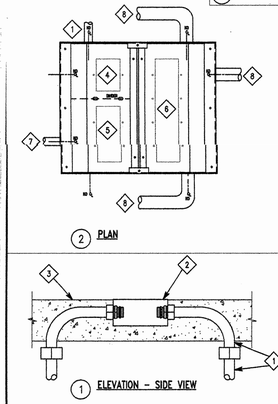


D SYMBOL	B DESCRIPTION
1	1¼" EMT FOR TELECOM WIRING. (REVD PVC PER RFI 157)
2	RECESSED FLOOR BOX.
3	CONCRETE SLAB.
4	1-GANG MOUNTING POSITION FOR TELECOM DEVICES.
5	2-GANG MOUNTING POSITION FOR QUAD POWER RECEPTACLE.
6	4-GANG MOUNTING POSITION FOR AV DEVICES.
7	1" EMT FOR ELECTRICAL POWER VOLTAGE WIRING.
8	1¼" EMT FOR A/V WIRING. ROUTE TO ABOVE ACCESSIBLE CEILING.


C DRAWING VIEWS — A NOTES

CAST-IN-PLACE COMBINATION POWER, TELECOM, & AV FLOOR BOX, 12⅛" X 10⅛" X 4", FSR FL 500P, WITH A 1-GANG POSITION FOR TELECOM DEVICES, A 2-GANG POSITION FOR POWER AND A 4-GANG POSITION FOR AV. PROVIDE A 1¼" RIGID, LONG-SWEEP ELBOW WITH A 1¼" RIGID-TO-EMT COUPLER FOR TELECOM

2 RECESSED FLOOR BOX DATA & AV OUTLET BOX

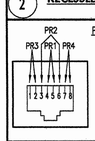


PIN #	PAIR/COLOR	PAIR
5	T1-W/BL	1
4	R1-BL/W	
3	T2-W/O	2
6	R2-O/W	
1	T3-W/GR	3
2	R3-GR/W	
7	T4-W/BR	4
8	R4-BR/W	

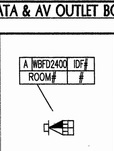

WALL BOX FLUSH DOUBLE GANG
TERMINATION HARDWARE:
(2) 4-PAIR TELEPHONE STATION CABLE
(2) 8 PIN 8 POSITION TELEPHONE JACK
(4) 4-PAIR NETWORK STATION CABLES
(4) 8 PIN 8 POSITION NETWORK JACKS

A T568A PINNING — B SYMBOL — C DESCRIPTION

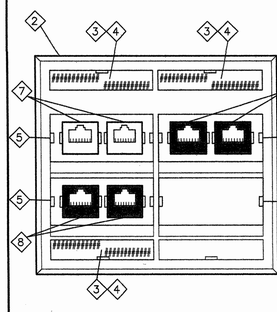

1. SEE PARTS MATRIX FOR SPECIFIC COLORS, FACEPLATE AND FIBER CONNECTIVITY COMPONENTS, CABLE TYPE, AND PART NUMBERS.
2. DOUBLE GANG FACEPLATE WITH FOUR OUTLET IDENTIFICATION LABELS WITH CLEAR COVERS, TWO MATCHING SCREW COVERS AND MOUNTING SCREWS.
3. CLEAR DESIGNATION STRIP HOLDER. OUTLET DESIGNATION SHALL BE PLACED BEHIND HOLDER AND SHALL NOT BE ADHERED TO HOLDER. USE 1.8" X 0.375", WHITE POLYESTER LABEL. LABEL SHALL BE LASER PRINTED. USE HELVETICA 10 AS LABELING FONT.
4. PROVIDE LABELING & FACE PLATE IDENTIFICATION AS SPECIFIED IN TELECOM IDENTIFICATION AND LABELING SPEC SECTION.
5. 2 UNIT DUAL OPENING FLUSHMOUNT UNLOADED MODULE FOR MOUNTING TWO JACKS.
6. 2 UNIT BLANK MODULE, TO FILL UNUSED OPENINGS.
7. 8 PIN 8 POS JACK FOR TELEPHONE STATION CABLE TERMINATION.
8. 8 PIN 8 POS JACK FOR NETWORK STATION CABLE TERMINATION.

D FACEPLATE — E NOTES

1 WALL BOX FLUSH DOUBLE GANG ANGLED FACEPLATE - WBFD2400

(2) TELEPHONE, (4) NETWORK

tBP
architecture
planning
interiors
management

tBP/Architecture
1000 Burnett Avenue, Suite 140
Concord, CA 94520
p: 9252466419 f: 9252466495

INFRASTRUCTURE DESIGN ASSOCIATES
1440 Broadway
Suite 304
Oakland, CA 94612

consultant

EXPIRES 12/31/06
Regis. No. 06606
SIGNATURE

DERIFICATION STAMP
DIV. OF THE STATE ARCHITECT
OFFICE OF REGULATION SERVICES
AC_____
APP. - 01-106226
DATE 1-12-06

name
address
city, state, zip
ph: fx:

SCIENCE BUILDING
LOS MEDANOS COLLEGE
Contra Costa Community College District

owner

tBP project number : 20247.00
file name:
drawn by: checked by:
date: NOVEMBER 15, 2004


NTS


drawing title: building no:
DETAILS
TELECOM OUTLETS

LMC SCIENCE 313-023-112.01-0-00.00
drawing no:
T6-1
drawing of

\\Los Medanos College\Science Building\BID Set\vcad\T6-1.dwg 11-08-04 01:23:33 PM cmendoza

12 "U" FRAMING CHANNEL SINGLE TRAPEZE ASSEMBLY

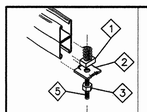
A ISOMETRIC	B PLAN SYMBOL	C PRODUCT DESCRIPTION
		SINGLE TRAPEZE ASSEMBLY FROM "U" CHANNEL FOR HANGING CABLE RUNWAY OR CABLE TRAY.

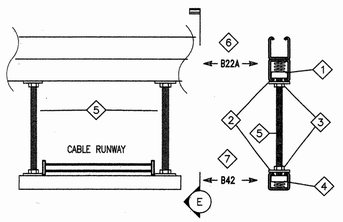


D ELEVATION | E SECTION | D NOTES

1. SPRING NUT 5/8"–11, 200 SERIES. B–LINE 5/8"–11 N255.
2. NO TWIST SQUARE WASHER 11/16" HOLE. B–LINE B202–1D.
3. HEX NUT 5/8"– 11. B–LINE 5/8" HN.
4. SPRING NUT 5/8"–11, 500 SERIES. B–LINE 5/8"–11 N555.
5. 5/8" THREADED ROD.
6. METAL FRAMING CHANNEL BACK–TO–BACK STYLE. 1–5/8" X 3–1/4", 12 GAUGE. B–LINE B22A.
7. METAL FRAMING CHANNEL 1–5/8" X 1", 12 GAUGE. B–LINE B42.

11 Z-BRACKET @ WALL


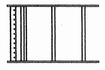
A PLAN SYMBOL	B PRODUCT DESCRIPTION
	SHEET METAL FITTING FOR PROVIDING CABLE RUNWAY DROPOUT.

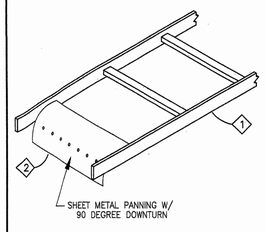

C ISOMETRIC VIEW | D NOTES

1. CABLE RUNWAY: 15" WIDE X 2" HIGH.
2. PANNING DOWNTURN DROPOUT.

10 CABLE RUNWAY

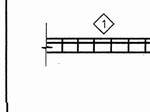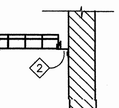
A ISOMETRIC VIEW	B PLAN SYMBOL	C DESCRIPTION
		ALLOWS FOR VERTICAL OR HORIZONTAL ATTACHMENT OF FLEXTRAY TO WALLS. THE Z–BRACKET CAN ALSO BE USED FOR WALL TERMINATIONS, RACK AND FLOOR ATTACHMENTS.


D ELEVATION VIEW

E PLAN VIEW | F NOTES

1. STEEL WIRE CABLE TRAY. WIRE CABLE TRAY SHALL BE CONSTRUCTED OF WELDED HIGH STRENGTH 8 GAUGE STEEL WIRE COATED AFTER FABRICATION WITH ELECTRO–PLATED ZINC GALVANIZING FOR USE IN INDOOR NON CORROSIVE ENVIRONMENTS.
2. Z–BRACKET – FLEXTRAY.
3. EXISTING WALL CONSTRUCTION. VERIFY IN FIELD.

9 CABLE RUNWAY END ENCLOSURE

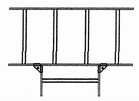
A PLAN SYMBOL	B PRODUCT DESCRIPTION
	"TEE" KIT FOR SPLICING TOGETHER PERPENDICULAR SECTIONS.

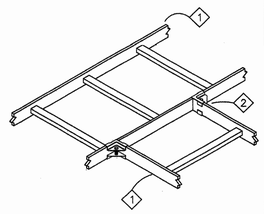


C ISOMETRIC VIEW | D NOTES

1. CABLE RUNWAY 15" WIDE X 2" HIGH.
2. RUNWAY STRINGER "TEE" KIT.

8 CABLE RUNWAY HORIZONTAL "TEE" ASSEMBLY

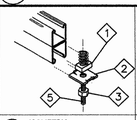
A ISOMETRIC	B PLAN SYMBOL	C PRODUCT DESCRIPTION
		DOUBLE TRAPEZE ASSEMBLY FROM "U" CHANNEL FOR HANGING CABLE TRAY AND CABLE RUNWAY.

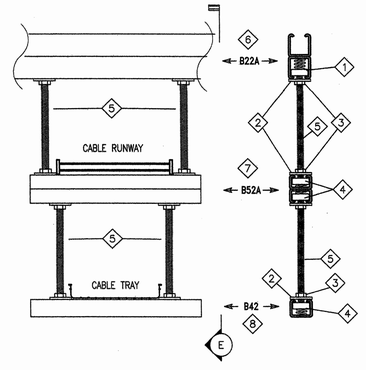


D ELEVATION & SECTION | E SECTION | D NOTES

1. SPRING NUT 5/8"–11, 200 SERIES. B–LINE 5/8"–11 N255.
2. NO TWIST SQUARE WASHER 11/16" HOLE. B–LINE B202–1D.
3. HEX NUT 5/8"– 11. B–LINE 5/8" HN.
4. SPRING NUT 5/8"–11, 500 SERIES. B–LINE 5/8"–11 N555.
5. 5/8" THREADED ROD.
6. METAL FRAMING CHANNEL BACK–TO–BACK STYLE. 1–5/8" X 3–1/4", 12 GAUGE. B–LINE B22A.
7. METAL FRAMING CHANNEL BACK–TO–BACK STYLE. 1–5/8" X 1–5/8", 12 GAUGE. B–LINE B52A.
8. METAL FRAMING CHANNEL 1–5/8" X 1", 12 GAUGE. B–LINE B42.

7 "U" FRAMING CHANNEL DOUBLE TRAPEZE ASSEMBLY


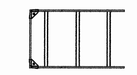
A PLAN SYMBOL	B PRODUCT DESCRIPTION
	RUNWAY TERMINATION ASSEMBLY

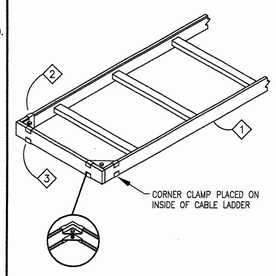


C ISOMETRIC VIEW | D NOTES

1. CABLE RUNWAY 15" WIDE X 2" HIGH
2. DE–BUR ALL CUT END PIECES PRIOR TO FINAL ASSEMBLY.
3. RUNWAY TERMINATION, FINISH TO MATCH STRINGERS.

6 DROP OUT FITTINGS

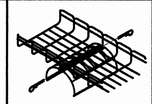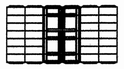A ISOMETRIC VIEW	B PLAN SYMBOL CTF2_DROPOUT	C DESCRIPTION
		DROP–OUT FITTING MAINTAINS BEND RADIUS OF WIRE. TWO COTTER PINS INCLUDED.


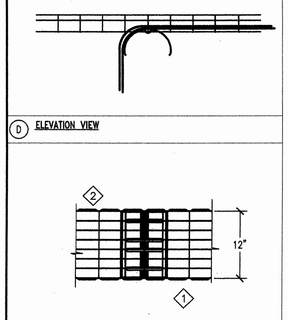



D ELEVATION VIEW

E PLAN VIEW | F NOTES

1. NOTE: CABLING CONTRACTOR SHALL NOT CUT EDGE MEMBERS OF STEEL WIRE CABLE TRAY
2. CUT OUT 2X2 GRID BETWEEN EQUIPMENT RACKS AT VERTICAL MOUNTED CABLE MANAGERS TO ALLOW CABLE PASSAGE

5 GROUND BOLT DETAIL

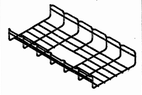
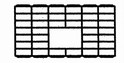
A ISOMETRIC VIEW	B PLAN SYMBOL	C DESCRIPTION
		CUT–OUTS TO PERMIT CABLE PASSAGE OVER EQUIPMENT RACKS.

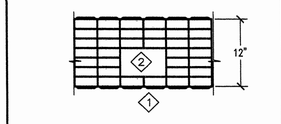


D PLAN VIEW | E NOTES

1. NOTE: CABLING CONTRACTOR SHALL NOT CUT EDGE MEMBERS OF STEEL WIRE CABLE TRAY
2. CUT OUT 2X2 GRID BETWEEN EQUIPMENT RACKS AT VERTICAL MOUNTED CABLE MANAGERS TO ALLOW CABLE PASSAGE

4 12" CUT-OUT OVER RACKS

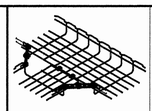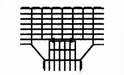
A ISOMETRIC VIEW	B PLAN SYMBOL	C DESCRIPTION
		JOINING METHOD AT TEE INTERSECTION.

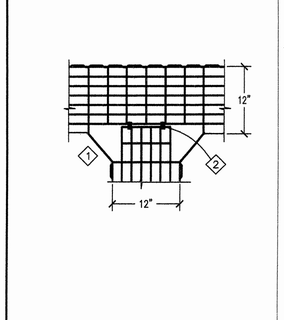


D PLAN VIEW | E NOTES

1. REINFORCE INSIDE CORNERS WITH SPLICE BARS WITH THE SAFETY EDGE, (3) SPLICE WASHERS AND (3) 1/4 INCH CARRIAGE BOLT WITH LOCK NUT IN EACH CORNER.
2. 12 X 2 INCH WIRE CABLE SHORT RADIUS TEE WITH (2) BOTTOM WASHERS, (2) TOP WASHERS AND (2) 1/4" CARRIAGE BOLTS WITH LOCK NUTS AT THE PERPENDICULAR JOINT BETWEEN SECTIONS.

3 12" TEE SECTION

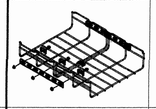
A ISOMETRIC VIEW	B PLAN SYMBOL	C DESCRIPTION
		END TO END SPLICE OF STRAIGHT SECTIONS

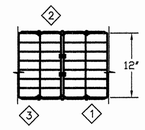


D PLAN VIEW | E NOTES

1. WIRE CABLE TRAY SHALL BE CONSTRUCTED OF WELDED HIGH STRENGTH 8 GAUGE STEEL WIRE COATED AFTER FABRICATION WITH ELECTRO–PLATED ZINC GALVANIZING FOR USE IN INDOOR NON CORROSIVE ENVIRONMENTS.
2. REINFORCE SIDES WITH SPLICE BARS WITH THE SAFETY EDGE, (3) SPLICE WASHERS AND (3) 1/4 INCH CARRIAGE BOLT WITH LOCK NUT IN EACH SIDE.
3. BOND EACH CONTINUOUS SECTION WIRE CABLE TRAY TO THE GROUND BAR IN THE ROOM WITH A TERMINAL GROUND SUPPORT. (SEE GROUND BAR DETAIL). ROUTE AN INSULATED #6 AWG GROUND CONDUCTOR TO EACH TERMINAL BRACKET. SUPPORT THE GROUND CABLE ON THE OUTER EDGE OF THE WIRE CABLE TRAY WITH CABLE SUPPORT CLIPS @ 12" O.C..

2 12" TO 12" SPLICE

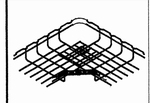A ISOMETRIC VIEW	B PLAN SYMBOL	C DESCRIPTION
		CUT–OUT OVER EQUIPMENT RACKS

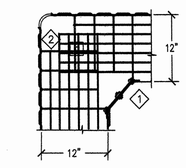

D PLAN VIEW | E NOTES

1. REINFORCE INSIDE CORNERS WITH SPLICE BARS WITH THE SAFETY EDGE, (3) SPLICE WASHERS AND (3) 1/4 INCH CARRIAGE BOLT WITH LOCK NUT IN EACH CORNER.
2. 12 X 2 INCH WIRE CABLE SHORT RADIUS BEND WITH CONTINUOUS OUTER EDGE, (2) SUPPORT WASHERS AND (1) 1/4 INCH CARRIAGE BOLTS WITH LOCK NUT

1 12" X 12" 90 DEGREE ANGLE

tBP
architecture
planning
interiors
management

LICENSED ARCHITECT
ROBERT W. SIMPSON, AIA
No. C-9855
STATE OF CALIFORNIA

tBP/Architecture
1000 Burnett Avenue, Suite 140
Concord, CA 94520
p: 925.246.6419 f: 925.246.6495

INFRASTRUCTURE DESIGN ASSOCIATES
1440 Broadway
Suite 304
Oakland, CA 94612

BICSI REGISTERED COMMUNICATIONS DISTRIBUTION DESIGNER

EXPIRES 12/31/06
Regis. No. 06606
SIGNATURE

consultant

name
address
city, state, zip
ph:
fx:

EXEMPTION STAMP
DIV. OF THE STATE ARCHITECT
DEPT. OF EDUCATION/OPSC
APP. NO. 01-05934
BY: [signature]
DATE 1-11-05

SCIENCE BUILDING
LOS MEDANOS COLLEGE

Contra Costa Community College District

owner

tBP project number : 20247.00
file name:
drawn by: checked by:
date: NOVEMBER 15, 2004


drawing title: DETAILS
STEEL WIRE
CABLE TRAY

building no:
LMC SCIENCE 313-023-112.01-0-00.00

drawing no: T6-2

drawing of

G:\Los Medanos College\Science Building\BID Set\vcad\T6-2.dwg 11-08-04 01:20:17 PM cmendoza

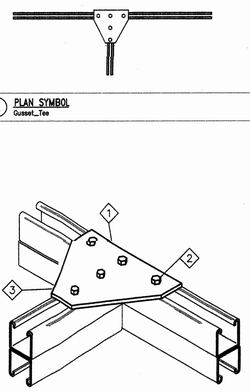


FIVE HOLE TEE GUSSET PLATE FOR USE IN JOINING HORIZONTAL SEGMENTS AT "U" AND DOUBLE "U" FRAMING CHANNEL. 1/4" THICK ELECTROPLATED ZINC.

A PLAN SYMBOL Gusset_Tee | B PRODUCT DESCRIPTION

1. FIVE HOLE TEE GUSSET PLATE WITH (5) 9/16" HOLES FOR 1/2" DIAMETER BOLTS.
2. FIVE 1/2-13, 1-1/4" LONG HEX HEAD BOLTS ZINC PLATED, WITH (7) 1/2-13 SPRING NUTS FOR 1-5/8" DEEP "U" FRAMING CHANNEL.
3. GUSSET PLATE SHALL BE MOUNTED ON TOP SIDE OF DOUBLE "U" CHANNEL TO LEAVE BOTTOM SIDE CLEAR FOR THREADED ROD SUPPORT OF CABLE LADDER AND WELDED WIRE TRAY.


C ISOMETRIC VIEW | D NOTES

10 FIVE HOLE GUSSET PLATE

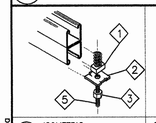

DOUBLE TRAPEZE ASSEMBLY FROM "U" CHANNEL FOR HANGING CABLE TRAY AND CABLE RUNWAY.


A ISOMETRIC | B PLAN SYMBOL | C PRODUCT DESCRIPTION

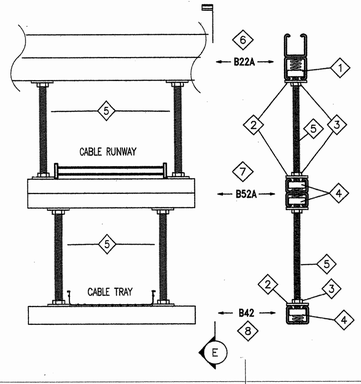

1. SPRING NUT 5/8"-11, 200 SERIES. B-LINE 5/8"-11 N255.
2. NO TWIST SQUARE WASHER 11/16" HOLE. B-LINE B202-1D.
3. HEX NUT 5/8"- 11. B-LINE 5/8" HN.
4. SPRING NUT 5/8"-11, 500 SERIES. B-LINE 5/8"-11 N555.
5. 5/8" THREADED ROD.
6. METAL FRAMING CHANNEL BACK-TO-BACK STYLE. 1-5/8" X 3-1/4", 12 GAUGE. B-LINE B22A.
7. METAL FRAMING CHANNEL BACK-TO-BACK STYLE. 1-5/8" X 1-5/8", 12 GAUGE. B-LINE B52A.
8. METAL FRAMING CHANNEL 1-5/8" X 1", 12 GAUGE. B-LINE B42.


D ELEVATION & SECTION | E SECTION | D NOTES

9 "U" FRAMING CHANNEL DOUBLE TRAPEZE ASSEMBLY

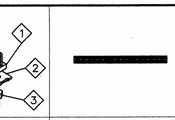

SINGLE TRAPEZE ASSEMBLY FROM "U" CHANNEL FOR HANGING CABLE RUNWAY OR CABLE TRAY.

A ISOMETRIC | B PLAN SYMBOL | C PRODUCT DESCRIPTION

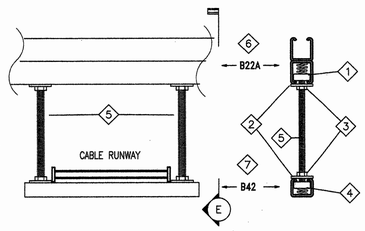

1. SPRING NUT 5/8"-11, 200 SERIES. B-LINE 5/8"-11 N255.
2. NO TWIST SQUARE WASHER 11/16" HOLE. B-LINE B202-1D.
3. HEX NUT 5/8"- 11. B-LINE 5/8" HN.
4. SPRING NUT 5/8"-11, 500 SERIES. B-LINE 5/8"-11 N555.
5. 5/8" THREADED ROD.
6. METAL FRAMING CHANNEL BACK-TO-BACK STYLE. 1-5/8" X 3-1/4", 12 GAUGE. B-LINE B22A.
7. METAL FRAMING CHANNEL 1-5/8" X 1", 12 GAUGE. B-LINE B42.

D ELEVATION | E SECTION | D NOTES

8 "U" FRAMING CHANNEL SINGLE TRAPEZE ASSEMBLY




GRID SUPPORT AND HANGER ROD *STIFFENER ASSEMBLY.*

A PLAN SYMBOL | B PRODUCT DESCRIPTION

1. DOUBLE "U" FRAMING CHANNEL SUPPORT GRID ASSEMBLY ANCHORED TO WALLS.
2. MAXIMUM DISTANCE FROM TOP OF CHANNEL WHERE THE HANGER ROD IS ATTACHED TO THE FIRST BOLT OF THE CHANNEL ROD STIFFENER IS 6".
3. B-LINE, B52A CHANNEL, 1-5/8" X 1-5/8", CHANNEL, PLAIN STEEL FINISH – 14 GAUGE THICK, PLAIN FINISH.
4. 5/8" ALL THREADED ROD, (ATR)
5. B22 CHANNEL LONGITUDINAL BRACE (9'-4" (2.8 M – MAXIMUM LENGTH) MOUNTED AT 45°.
6. B-LINE, B22 CHANNEL, 1-5/8" X 1-5/8" ROD STIFFENER WITH A MINIMUM OF TWO (2) SC228 ASSEMBLIES.
7. B-LINE, B335-2-5/8 THREE HOLE ADJUSTABLE HINGE WITH STANDARD PLAIN FINISH.
8. MAXIMUM SPACING BETWEEN SC-228 ASSEMBLIES IS 23".


C ISOMETRIC VIEW | D NOTES

7 TRAPEZE ASSEMBLY STRUCTURAL BRACING
NTS

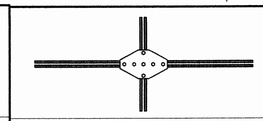

SEVEN HOLE CROSS GUSSET PLATE FOR USE IN JOINING HORIZONTAL SEGMENTS AT "U" AND DOUBLE "U" FRAMING CHANNEL. 1/4" THICK ELECTROPLATED ZINC.


A PLAN SYMBOL Gusset Cross | B PRODUCT DESCRIPTION

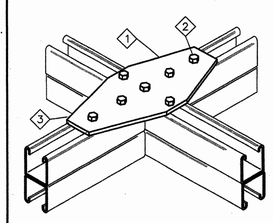

1. SEVEN HOLE CROSS GUSSET PLATE WITH (7) 9/16" HOLES FOR 1/2" DICROMATE BOLTS.
2. SEVEN 1/2-13, 1-1/4" LONG HEX HEAD BOLTS ZINC PLATED, WITH (7) 1/2-13 SPRING NUTS FOR 1-5/8" DEEP "U" FRAMING CHANNEL.
3. GUSSET PLATE SHALL BE MOUNTED ON TOP SIDE OF DOUBLE "U" CHANNEL TO LEAVE BOTTOM SIDE CLEAR FOR THREADED ROD SUPPORT OF CABLE LADDER AND WELDED WIRE TRAY.

C ISOMETRIC VIEW | D NOTES

6 SEVEN HOLE CROSS GUSSET PLATE

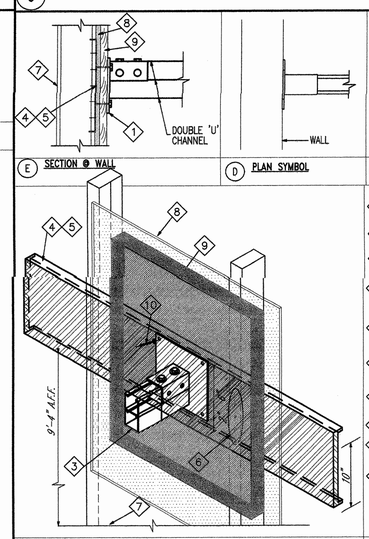

CUT AWAY SECTION OF TELECOM ROOM WALL SHOWING PLACEMENT OF *BACKING FOR ATTACHMENT OF* "U" CHANNEL BASE.

E SECTION @ WALL | D PLAN SYMBOL | B DESCRIPTION


1. POST BASE FOR B22, STANDARD FINISH PART #B280SQ
2. 5/8" DIAMETER 4 HOLES AT EACH CORNER
3. 1-5/8" X 1-5/8" CHANNEL, B-LINE #B22
4. 10" x 14 GA. MIN. TRACK, NOTCHED AND FASTENED TO STUDS W/ (5) #10 x 1/2" SHEET METAL SCREWS.
5. BACKING SHALL EXTEND AROUND THE PERIMETER OF ROOM.
6. BACKING FASTENED TO STUDS W/ (5) #10 x 1/2" SHEET METAL SCREWS.
7. 16 GA. MIN. METAL STUD, FLANGES SHALL NOT BE CUT.
8. GWB – GYPSUM WALL BOARD
9. 3/4" FIRE RESISTANT PLYWOOD
10. 3" x 1/4" STEEL, SELF-TAPPING SCREWS WITH 1" FENDER WASHERS FOR SECURING BASE PLATE TO WALL BACKING. SCREWS SHALL BE POSITIONED AT UPPER EDGE OF EACH OF THE FOUR PLATE MOUNTING HOLES.

C ISOMETRIC VIEW FROM BELOW | A NOTES

5 WALL ANCHORING ATTACHMENT DETAIL

METAL, DOUBLE "U" FRAMING CHANNEL. 12 GAUGE PLAIN FINISH, 1-5/8" WIDE. 3-1/4: TALL. 20 FOOT LENGTH TYPICAL.


A PLAN SYMBOL 3D Channel | B PRODUCT DESCRIPTION

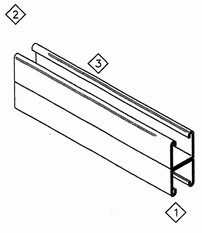

1. TYPICAL B-LINE B22A-240. NO HOLES IN DOUBLE "U" CHANNEL.
2. SPRING CLIPS SHALL BE UTILIZED TO ATTACH HARDWARE TO "U" FRAMING CHANNEL. NO NOT DRILL OR PUNCH HOLES IN THE "U" FRAMING CHANNEL.
3. SUPPORT OPEN SPANS OF DOUBLE "U" CHANNEL AT 6'-0" MIN.


C ISOMETRIC VIEW | D NOTES

4 DOUBLE "U" FRAMING CHANNEL

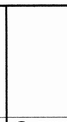

4"/6" PVC FIBER OPTIC PATCH CABLE TROUGH HUNG FROM "U" CHANNEL W/ THREADED ROD BRACKET.


A PLAN VIEW | B PLAN SYMBOL | C DESCRIPTION

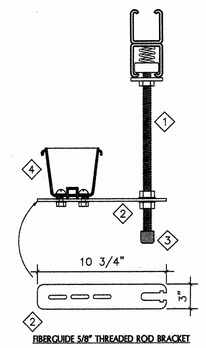

1. THREADED ROD SECURED TO "U" CHANNEL ABOVE WITH SPRING NUT, NO TWIST SQUARE WASHER AND HEX NUT, SIZED FOR 5/8" THREADED ROD.
2. THREADED ROD ATTACHMENT BRACKET, ADC TELECOMMUNICATIONS P/N FGS-HNTR-5/8".
3. CAP ALL THREADED RODS AND BOLT ENDS EXPOSED TO THE FLOOR WITH PLASTIC END CAPS. B-LINE PART # FOR 5/8" THREADED ROD = SB-300D.
4. FIBER OPTIC TROUGH ATTACHED TO THREADED ROD BRACKET. SEE FIBER OPTIC TROUGH DETAILS AND SPECIFICATIONS.


D ISOMETRIC VIEW | E NOTES

3 FIBER OPTIC TROUGH SUPPORT ROD CONNECTION @ "U" CHANNEL

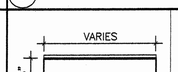

FIBER OPTIC TROUGH "STRAIGHT SECTION" (FGS-MSHS-A, 4") WITH JUNCTION ASSEMBLIES & END CAP KITS.


A PLAN VIEW | B PLAN SYMBOL | C DESCRIPTION

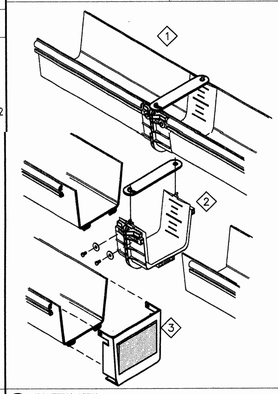

1. STRAIGHT FIBER TROUGH SECTION, 4". (2) 4" JUNCTION ASSEMBLIES REQUIRED FOR CONNECTION TO OTHER FIBER OPTIC TROUGH COMPONENTS.
2. JUCTION ASSEMBLY, 4" 4" JUNCTION ASSEMBLY W/ SNAP TOGETHER FEATURE AND FACTORY INSTALLED SET SCREWS.
3. END CAP KIT, 4" REQUIRED FOR TERMINATION OF DUCT WHERE NO OTHER FITTINGS ARE SHOWN OR CALLED FOR IN THE DRAWINGS OR SPECIFICATIONS.


D ISOMETRIC VIEW | E NOTES

2 4" STRAIGHT CONNECTIONS W/ JUNCTION ASSEMBLIES AND END CAP

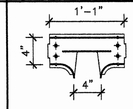

FIBER OPTIC THOUGH DOWNSPOUT

A PLAN VIEW | B PLAN SYMBOL | C DESCRIPTION

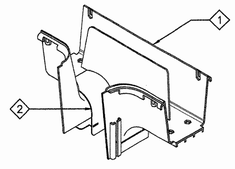

1. STANDARD DOWNSPOUT, 4". 4" JUNCTION ASSEMBLIES REQUIRED FOR CONNECTION TO OTHER FIBER OPTIC TROUGH COMPONENTS.
2. DOWNSPOUT INSERT FOR CONNECTION TO 2" VERTICAL DUCT OFFSET ASSEMBLY.

D DOWNSPOUT PERSPECTIVE | E NOTES

1 FIBER OPTIC TROUGH DOWNSPOUT

tBP architecture planning interiors management
tBP/Architecture
1000 Burnett Avenue, Suite 140
Concord, CA 94520
p: 925.246.6419 f: 925.246.6495

INFRASTRUCTURE DESIGN ASSOCIATES
1440 Broadway
Suite 304
Oakland, CA 94612
EXPIRES 12/31/06
Regist. No. 06606
SIGNATURE
consultant

VERIFICATION STAMP ONLY IF STATE ARCHITECT'S OR ENGINEER'S SEAL IS REQUIRED
APP. - 0/106366
DATE 1-13-05
name
address
city, state, zip
ph: fx:

SCIENCE BUILDING
LOS MEDANOS COLLEGE

Contra Costa Community College District


DWTHS

tBP project number : 20247.00
file name:
drawn by: checked by:
date: NOVEMBER 15, 2004

drawing title: DETAILS
FIBER OPTIC TROUGH AND "U"- CHANNEL

building no:
LMC SCIENCE 313-023-112.01-0-00.00
drawing no: T6-3
drawing of

S:\Los Medanos College\Science Building\BID Set\cad\T6-3.dwg 11-08-04 01:21:02 PM cmendoza

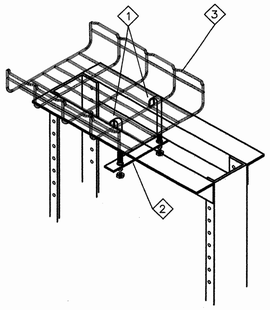

(A) SECTION VIEW



(B) PLAN SYMBOL

(C) DESCRIPTION


1. J-BOLT, B-LINE SB-1003-K.
2. TWO-HOLE STEEL PLATE, B-LINE SB-215-04.
3. STEEL-WIRE CABLE TRAY.


(D) ISOMETRIC VIEW

(E) NOTES

FIELD ASSEMBLY FOR ATTACHING EQUIPMENT RACK TO HORIZONTAL CABLE TRAY.

6 J-BOLT EQUIPMENT RACK SUPPORT ASSEMBLY

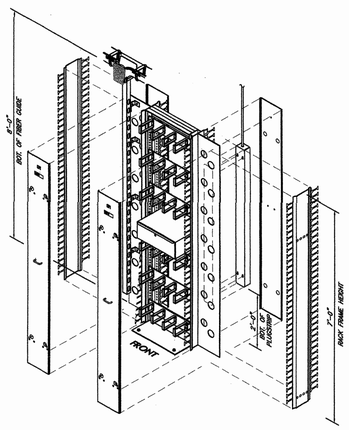

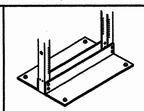


(A) ISOMETRIC VIEW

(B) PLAN SYMBOL

(C) DESCRIPTION

RACK FLOOR FLANGE ATTACHMENT TO CONCRETE FLOOR.

1. STANDARD 19" x 84" OPEN RAIL RACK.
2. RACK FLANGE
3. 5/8" EXPANSION ANCHOR WITH 3-1/2" EMBED INTO CONCRETE SLAB. (FOUR TOTAL).
   ANCHOR MUST BE TESTED AND APPROVED UNDER DUAL-LOADING CONDITIONS.
   HILTI KWIK-BOLT II, RAMSET/REDHEAD TRUBOLT, OR EQUAL, (NO KNOWN EQUAL).

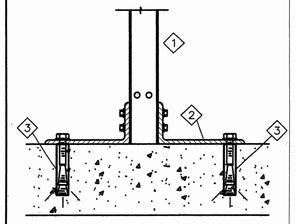


(D) PLAN VIEW

(E) NOTES

3 RACK ATTACHMENT AT CONCRETE FLOOR

1. 19 X 84 INCH SELF SUPPORTING, ALUMINUM, U.L. LISTED, POWDER COATED, EQUIPMENT RACK, DRILLED AND TAPPED, EIA/TIA SPACED HOLES FOR ATTACHING EQUIPMENT ON FRONT AND BACK.
2. (1) DOUBLE-SIDED VERTICAL RACK CABLE MANAGER ON EACH SIDE OF THE EQUIPMENT RACK.
3. LARGE HORIZONTAL RING PANEL, 2 RU.
4. RACK MOUNT POWER DISTRIBUTION UNIT (PDU), 16 AMP, 120 VOLT, WITH DISPLAY INTERFACE, (24) NEMA 5-20R OUTLETS, NEMA L5-20 POWER CORD, CORD RETAINER HOLES, SERIAL CABLE CONNECTION FOR INTERFACE
5. CONNECT PDU TO DROP CORD PLUG-IN CABLE WITH 120VAC, 20 AMP, L5-20R RECEPTACLE CONNECTOR FROM JUNCTION BOX MOUNTED TO ELECTRICAL BUSWAY ABOVE. CIRCUITRY, BUSWAY, JUNCTION BOX AND DROP CORD PROVIDED BY OTHERS.
6. 5/8" EXPANSION ANCHOR WITH 3-1/2" EMBED INTO CONCRETE SLAB (FOUR TOTAL). ANCHOR MUST BE TESTED AND APPROVED UNDER DUAL-LOADING CONDITIONS. HILTI KWIK-BOLT II, RAMSET/REDHEAD TRUBOLT, OR EQUAL, (NO KNOWN EQUAL).
7. PROVIDE # 6 COPPER GROUND CABLE BETWEEN THE RACK AND THE COPPER GROUND BAR.
8. 2" VERTICAL FIBER OPTIC SLOTTED DUCT TO BE MOUNTED INSIDE TO THE FRONT AND MIDDLE OF THE VERTICAL CABLE MANAGER.

(B) NOTES

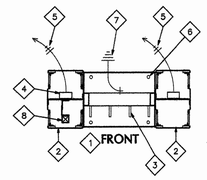


(A) ELEVATIONS

5 EQUIPMENT RACK BUILDOUT

1. 19 X 84 INCH SELF SUPPORTING, ALUMINUM, U.L. LISTED, POWDER COATED, WHITE EQUIPMENT RACK, DRILLED AND TAPPED, EIA/TIA SPACED HOLES FOR ATTACHING EQUIPMENT ON FRONT AND BACK.
2. (1) DOUBLE-SIDED VERTICAL RACK CABLE MANAGER ON EACH SIDE OF THE EQUIPMENT RACK.
3. LARGE HORIZONTAL RING PANEL, 2 RU, WHITE.
4. BASE DUST COVER, 19 INCH EQUIPMENT RACK, WHITE.
5. RACK RAILS, ON FRONT AND REAR OF RACK, HOLES DRILLED AND TAPPED ON EIA/TIA CENTERS.
6. RACK STORAGE DRAWER AND WORK SURFACE. MOUNT IN EQUIPMENT RACK AS SHOWN. TOP OF UNIT SHALL BE 34 INCHES A.F.F.
7. RACK ATTACHMENT, (4) PER RACK FASTENED W/ (4) 5/8" SAE GRADE 8 HEX HEAD BOLTS INTO IMBEDED CHANNELS OR APPROVED ANCHORS.

(B) NOTES

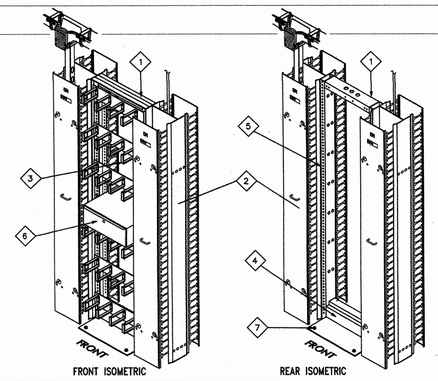

FRONT ISOMETRIC

REAR ISOMETRIC


(A) ISOMETRIC VIEWS

4 EQUIPMENT RACK ISOMETRICS

2 EQUIPMENT RACK PLAN

1. 19 X 84 INCH SELF SUPPORTING, ALUMINUM, U.L. LISTED, POWDER COATED, WHITE EQUIPMENT RACK, DRILLED AND TAPPED, EIA/TIA SPACED HOLES FOR ATTACHING EQUIPMENT ON FRONT AND BACK.
2. (1) DOUBLE-SIDED VERTICAL RACK CABLE MANAGER ON EACH SIDE OF THE EQUIPMENT RACK.
3. LARGE HORIZONTAL RING PANEL, 2 RU, WHITE.
4. BASE DUST COVER, 19 INCH EQUIPMENT RACK, WHITE.
5. RACK RAILS, ON FRONT AND REAR OF RACK, HOLES DRILLED AND TAPPED ON EIA/TIA CENTERS.
6. RACK STORAGE DRAWER AND WORK SURFACE. MOUNT IN EQUIPMENT RACK AS SHOWN. TOP OF UNIT SHALL BE 34 INCHES A.F.F.

(B) NOTES

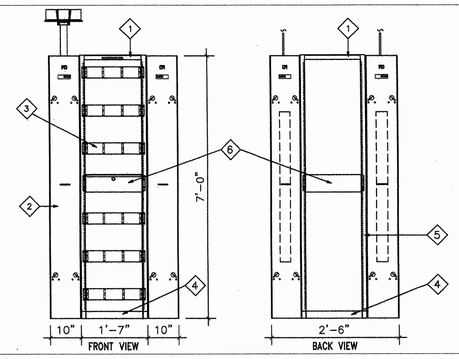

(A) ELEVATIONS

1 EQUIPMENT RACK ELEVATIONS

tBP
architecture
planning
interiors
management

LICENSED ARCHITECT © VIRGINIA, NEVADA, NEW MEXICO, OREGON, WASHINGTON © STATE OF CALIFORNIA
M. P. SMITH No. C-18887

tBP/architecture
1000 Bunett Avenue, Suite 140
Concord, CA 94520
p: 925.246.6419 f: 925.246.6495

INFRASTRUCTURE DESIGN ASSOCIATES
1440 Broadway
Suite 304
Oakland, CA 94612

EXPIRES: 12/31/06
Regis. No.: 06606

SIGNATURE

consultant

name
address
city, state, zip
ph: fx:

EXAMINATION STAMP
DIV. OF THE STATE ARCHITECT
OFFICE OF REGIONAL SERVICES

APP. - 01/18/05
REVIEWED BY: [illegible]
DATE: 1-31-05

SCIENCE BUILDING
LOS MEDANOS COLLEGE

Contra Costa Community College District

owner

tBP project number : 20247.00
file name:
drawn by: checked by:
date: NOVEMBER 15, 2004

drawing title: DETAILS
EQUIPMENT RACK


building no:

LMC SCIENCE 313-023-T12.01-0-00.00
drawing no: T6-4
drawing of

\Los Medanos College\Science Building\BID Set\acad\T6-4.dwg 11-08-04 08:22:58 AM cmendoza

1. STAINLESS STEEL MARKER TAG, COPPER RISER CABLE >1-1/4" DIAMETER, LABEL TYPE PANDUIT MMP350-C .75 x3.5 316 STAINLESS, EMBOSSED .25"h PRINTING, AIREL SAN SERIF FONT.
2. MACHINE PRINTED LABELING AT COPPER RISER CABLE < 1-1/4" DIAMETER, LABEL TYPE PANDUIT MMP350-C .75 x3.5 316 STAINLESS, MACHINE .25"h PRINTING, AIREL SAN SERIF FONT.
3. STAINLESS STEEL CABLE TIE W/NEOPRENE CUSHION SLEEVE, LOCATE RISER CABLE LABEL STRAP STEEL TYPE PANDUIT MLT65-CP316 NON-MAGNETIC,.18"w NO PRINTING
4. STAINLESS STEEL CABLE TIE W/NEOPRENE CUSHION SLEEVE, LOCATE LABEL TYPE PANDUIT PCSS-B-CR, NO PRINTING

A NOTES

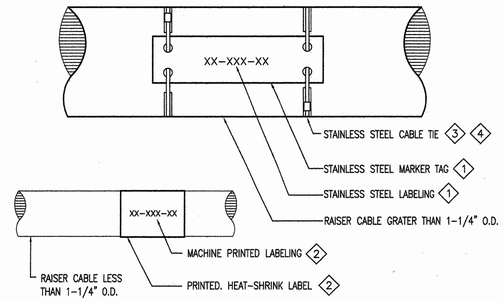


B PLAN VIEW

3 FIBER OPTIC CABLE LABELING

1. LABEL LOCATION AT INNER DUCT <1-1/4" DIAMETER, LABEL TYPE PANDUIT MMP350-C .75" x3.5" 316 STAINLESS MACHINE .25"h PRINTING, AIREL SAN SERIF FONT
2. LABEL LOCATION AT FIBER OPTIC RISER CABLE, LABEL TYPE PANDUIT MMP350-C .75" x3.5" 316 STAINLESS, MACHINE 25"h PRINTING, ARIEL SAN SERIF FONT.

A NOTES

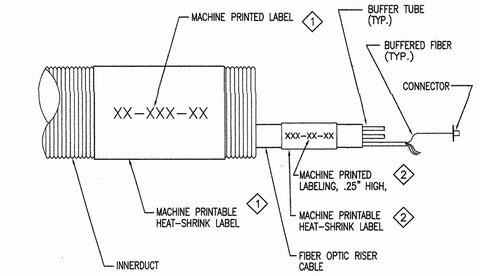

B PLAN VIEW


2 FIBER OPTIC CABLE & INNERDUCT LABELING

5 FIBER OPTIC RISER CABLE LABELING LOCATIONS

NOTE:


1. PANDUIT PLL 17 Y2.-2.5, 1.88" X .83" SELF LAMINATING LABEL ON COVER AND INTERIOR OF PULL BOX. MACHINE PRINTED .5 H, ARIEL SAN SERIF.
2. PULL BOX LABEL, SELF LAMINATING LABEL ON COVER AND INTERIOR OF PULL BOX. MACHINE PRINTED .5 H, ARIEL SAN SERIF.

A NOTES

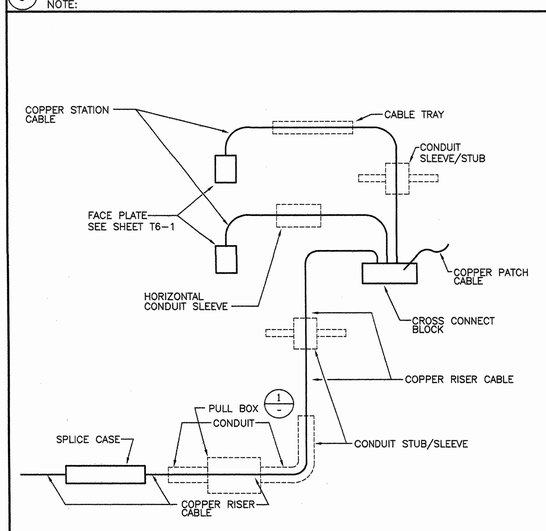

4 COPPER RISER AND STATION CABLE LABELING LOCATIONS

NOTE:

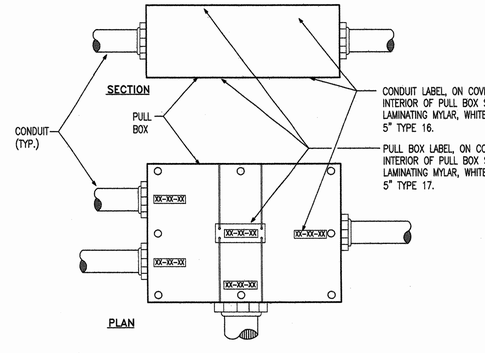

B PLAN VIEW

1 TYPICAL PULL BOX LABELING

tBP
architecture
planning
interiors
management

LICENSED ARCHITECT STATE OF CALIFORNIA RICHARD MARCUS, AIA No. C-26855 EXPIRES 12/31/06

tBP/Architecture
1000 Burnett Avenue, Suite 140
Concord, CA 94520
p: 925.246.6419 f: 925.246.6495

INFRASTRUCTURE DESIGN ASSOCIATES
1440 Broadway
Suite 304
Oakland, CA 94612

BKCST COMMUNICATIONS CONSULTANTS

EXPIRES 12/31/06
Regis. No. 06606
SIGNATURE

consultant

name
address
city, state, zip
ph: fx:

IDENTIFICATION STAMP DIV. OF THE STATE ARCHITECT OFFICE OF REGULATION SERVICES
APP. 10/20/2004
DATE 1-10-05

SCIENCE BUILDING
LOS MEDANOS COLLEGE

Contra Costa Community College District

owner

tBP project number : 20247.00
file name:
drawn by: checked by:
date: NOVEMBER 15, 2004

drawing title: DETAILS IDENTIFICATION AND LABELING
building no:
LMC SCIENCE 313-023-112.01-0-00.00
drawing no: T6-5
drawing of

J:\Los Medanos College\Science Building\BID Set\vcad\T6-5.dwg 11-08-04 09:21:42 AM cmendoza

1 WALL ASSEMBLY– THE 1 OR 2 HR. FIRE–RATED GYPSUM WALLBOARD/ STUD WALL ASSEMBLY SHALL BE CONSTRUCTED OF THE MATERIALS AND IN THE MANNER DESCRIBED IN THE INDIVIDUAL U300 OR U400 SERIES WALL OR PARTITION DESIGN IN THE UL FIRE RESISTANCE DIRECTORY AND SHALL INCLUDE THE FOLLOWING CONSTRUCTION FEATURES:

A. STUDS– WALL FRAMING MAY CONSIST OF EITHER WOOD STUDS OR STEEL CHANNEL STUDS. WOOD STUDS TO CONSIST OF NOM 2 BY 4 IN. LUMBER SPACED 16 IN. OC WITH NOM 2 BY 4 IN. LUMBER END PLATES AND CROSS BRACES STEEL STUDS TO BE 3–1/2 IN. WIDE BY 1–3/8 IN. DEEP CHANNELS SPACED MAX 24 IN. OC

B. WALL BOARD, GYPSUM*– 5/8 IN. THICK, 4FT WIDE WITH SQUARE OR TAPERED EDGES. THE GYPSUM WALLBOARD TYPE, THICKNESS, NUMBER OF LAYERS, FASTENER TYPE AND SHEET ORIENTATION SHALL BE AS SPECIFIED IN THE UNDIVIDUAL U300 OR U400 SERIES DESIGN IN THE UL FIRE RESISTANCE DIRECTORY. MAX DIAM OF OPENING IS 6 IN.

THE HOURLY F RATING OF THE FIRESTOP SYSTEM IS 1 HR WHEN INSTALLED IN A 1 HR FIRE RATED WALL AND 2 HR WHEN INSTALLED IN A 2 HR FIRE RATED WALL.

2 STEEL SLEEVE–CYLINDRICAL SLEEVE FABRICATED FROM MIN 0.019 IN. THICK (28 GAUGE) GALV SHEET AND HAVING A MIN 2 IN. LAP ALONG THE LONGITUDINAL SEAM. LENGTH OF STEEL SLEEVE TO BE EQUAL TO THICKNESS OF WALL PLUS APPROX 7/8 TO 1 IN. SUCH THAT WHEN INSTALLED, THE ENDS OF THE SLEEVES WILL PROJECT APPROX 7/16 TO 1/2 IN. BEYOND THE SURFACE OF THE WALL IN EACH SIDE OF THE WALL ASSEMBLY. SLEEVE INSTALLED BY COILING THE SHEET STEEL TO DIAM SMALLER THAN THE MAX 6 IN. DIAM THROUGH OPENINGS, INSERTING THE COIL THROUGH THE OPENINGS AND RELEASING THE COIL TO LET IT UNCOIL AGAINST THE CIRCULAR CUTOUTS IN THE GYPSUM WALLBOARD LAYERS.

3 CABLES– AGGREGATE CROSS–SECTIONAL AREA OF CABLES IN OPENING TO BE MIN 8 PERCENT TO MAX 36 PERCENT OF THE CROSS–SECTIONAL AREA OF THE SLEEVED OPENING IN WALL. CABLES TO BE RIGIDLY SUPPORTED ON BOTH SIDES OF WALL ASSEMBLY. THE SPACE BETWEEN CABLES AND PERIPHERY OF OPENING SHALL BE MIN 1/4 IN. TO MAX 2–1/2 IN. MIN SEPARATION BETWEEN ARMORED CABLES AND /OR METAL–CLAD CABLES (ITEM 3F) AND BETWEEN ARMORED CABLES AND /OR METAL–CLAD CABLES AND ALL OTHER TYPES OF CABLES SHALL BE 1/4 IN. ANY COMBINATION OF THE FOLLOWING TYPES AND SIZES OF COPPER CONDUCTOR CABLE MAY BE USED.

A. MAX 350 KCMIL SINGLE CONDUCTOR POWER CABLES; CROSS LINKED POLYETHYLENE (XLPE) INSULATION.

B. MAX 200 PAIR NO. 24 AWG CONDUCTOR TELECOMMUNICATION CABLES; POLYVINYL CHLORIDE (PVC) INSULATION AND JACKET.

C. MAX 7/C NO. 2/0 AWG MULTICONDUCTOR POWER AND CONTROL CABLES; XLPE OR PVC INSULATION WITH XLPE OR PVC JACKET.

D. MAX 3/C NO. 2/0 AWG CABLES; PVC INSULATION AND JACKET.

E. MAX 6/94 FIBER OPTIC (F.O.) CABLE; PVC INSULATION AND JACKET.


F. MAX FOUR COPPER CONDUCTOR NO. 2/0 AWG (OR SMALLER) ALUMINUM OR STEEL ARMORED CABLES OR METAL–CLAD CABLE CLASSIFIED AS A THROUGH PENETRATION PRODUCT. THE T RATING IS 0 HR WHEN ARMORED CABLES OR METAL–CLAD CABLES ARE USED. SEE THROUGH PENETRATING PRODUCT* (XHLY) CATEGORY IN THE FIRE RESISTANCE DIRECTORY FOR NAMES OF MANUFACTURERS. ANY ALUMINUM OR STEEL ARMORED CABLE OR METAL–CLAD CABLE CLASSIFIED AS A THROUGH PENETRATION PRODUCT MEETING THE ABOVE SPECIFICATIONS MAY BE USED.

4 PACKING MATERIAL–MIN 1 IN. THICKNESS OF MINERAL WOOL BATT INSULATION FIRMLY PACKED INTO STEEL SLEEVE ON BOTH SIDES OF THE WLL ASSEMBLY AS PERMANENT FORMS. PACKING MATERIAL TO BE RECESSED MIN 1 IN. FROM END OF STEEL SLEEVE (MIN 1/2 IN. FROM SURFACE OF GYPUM WALLBOARD) ON BOTH SIDES OF WALL ASSEMBLY.

5 FILL, VOID OR CAVITY MATERIAL*– CAULK–MIN 1 IN. THICKNESS OF FILL MATERIAL APPLIED WITHIN THE ANNULUS, FLUSH WITH BOTH ENDS OF THE STEEL SLEEVE. A NOM 1/4 IN. DIAM CONTINUOUS BEAD OF CAULK SHALL BE APPLIED GYPSUM WALLBOARD LAYERS ON BOTH SIDES OF THE WALL ASSEMBLY.


MINNESOTA MINING & MFG. CO. – CP 25WB+
* BEARING THE UL CLASSIFICATION MARKING

B FIRE STOPPING NOTES

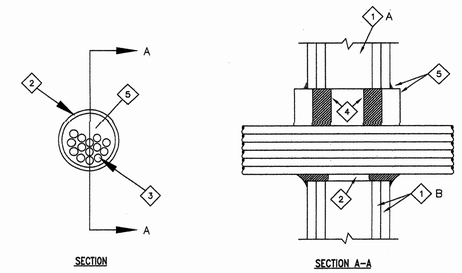

A SECTIONS

2 W-L-3032 · CABLE THROUGH FRAMED WALL
(1-HR RATED)

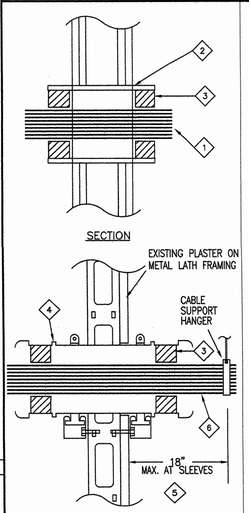

1 PENETRATING COMPONENTS: DATA OR VOICE CABLES W/ AGGREGATE CROSS–SECTIONAL AREA OF 5.0 SQUARE INCHES. RIGIDLY SUPPORT THE CABLES ON EACH SIDE OF THE SLEEVE ASSEMBLY. AGGREGATE OF CABLE FILL SHALL NOT EXCEED 40%. MAXIMUM DIAMETER OF OPENING SHALL NOT EXCEED 4".

2 EMT METAL SLEEVE.

3 MIN. 1" THICK PUTTY PACKED TIGHTLY INTO ANNULAR SPACE BETWEEN CABLES AND CONDUIT SLEEVE AS WELL AS THE INTERSTICES BETWEEN CABLES.

MINNESOTA MINING AND MANUFACTURING CO. – MPS–2+

4 BOX CONNECTOR AND BUSHING RING TO PROTECT STATION CABLES ARE NOT PART OF THE FIRE STOPPING SYSTEM AND ARE SHOWN FOR COORDINATION.

5 SUPPORT CABLES WITHIN 12" AT FIRESTOPPING SYSTEM ON BOTH SIDES OF THRU WALL PENETRATIONS. SEE UL FIRE RESISTANCE DIRECTORY.

6 MAXIMUM CABLE FILL 40%. APPROXIMATELY (132) – 4 PAIR 24 AWG STATION CABLES AND 2 STRAND MULTIMODE FIBER OPTIC CABLE W/ OVER SHEATH.

A PLAN/SECTION | B FIRE STOPPING NOTES

1 W-L-3031 · THROUGH WALL PENETRATION W/ EMT SLEEVE
(1-HR. RATED)

			PATHWAYS							CABLING				
			STATION CONDUIT		BACKBONE RISER CONDUIT	SLEEVE		INNERDUCT ENT		COPPER STATION CABLE		COPPER BACKBONE CABLE		FIBER OPTIC BACKBONE CABLE THROUGH FLOOR
SYSTEM	F–RATINGS	T–RATINGS	AT FLOOR	AT WALL		THROUGH VERTICAL PARTITION	THROUGH VERTICAL FLOOR	THROUGH FLOOR	THROUGH WALL	THROUGH FLOOR	THROUGH WALL	THROUGH FLOOR	THROUGH WALL	
W–L–3031	1 & 2 hr.	1/2, 1 & 1–1/2 hr.	yes	yes	yes	yes	yes	yes	yes	no	yes	yes	no	yes
W–L–3032	1 & 2 hr.	0 & 1/4 hr.	yes	yes	yes	yes	yes	yes	yes	no	yes	yes	no	yes

tBP
architecture
planning
interiors
management
tBP/Architecture
1000 Burnett Avenue, Suite 140
Concord, CA 94520
p: 9252466419 f: 9252466495

LICENSED ARCHITECT · REGISTERED PROFESSIONAL ENGINEER · STATE OF CALIFORNIA · RICHARD A. LEVINSON · No. C-9885

INFRASTRUCTURE DESIGN ASSOCIATES
1440 Broadway
Suite 304
Oakland, CA 94612

REGISTERED COMMUNICATIONS DISTRIBUTION DESIGNER · BICSI

EXPIRES 12/31/06
Regis. No. 06606
SIGNATURE

consultant

IDENTIFICATION STAMP
DIV. OF THE STATE ARCHITECT
OFFICE OF REGULATION SERVICES
APP. # 10/06456
DATE 12-10-04

name
address
city, state, zip
ph: fx:

SCIENCE BUILDING
LOS MEDANOS COLLEGE

Contra Costa Community College District

owner

tBP project number : 20247.00
file name:
drawn by: checked by:
date: NOVEMBER 15, 2004


drawing title: DETAILS FIRESTOPPING
building no:

LMC SCIENCE 313-023-112.01-0-00.00
drawing no: T6-6
drawing of

G:\Los Medanos College\Science Building\BID Set\acad\T6-6.dwg 11-08-04 08:19:00 AM cmendoza

DELETE ENTIRE SHEET PER ADDENDUM No. 2

A SYMBOL	B DESCRIPTION
S	LOUDSPEAKER BACKCAN. CONNECT WITH CONTINUOUS 1" EMT TO NEAREST LOUDSPEAKER BACKCAN. FOR FLUSH-MOUNT CEILING AUDIO/VISUAL CIRCUITS.

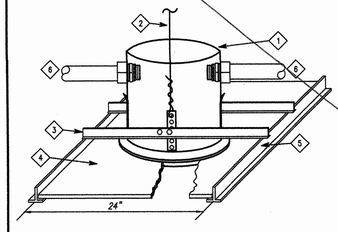

1. LOUDSPEAKER BACKCAN, ATLAS SOUND BMT95-4.
2. SAFETY WIRE TO BE ATTACHED TO STRUCTURAL CEILING AND LOUDSPEAKER BACKCAN. WIRE SHALL BE TAUT AND TIED AT BOTH ENDS WITH 3 TIGHT WRAPS, MIN. ASSURE WEIGHT OF BACKCAN IS NOT SUPPORTED BY CEILING TILE.
3. PROVIDE CHANNEL SUPPORTS FOR T-BAR TYPE FINISHED CEILING. 28" LONG, MIN. (TYP. OF 2).
4. TYPICAL LAY-IN TILE.
5. T-BAR CHANNEL GRID.
6. 1" EMT FOR LOW VOLTAGE AUDIO VISUAL CIRCUITS.

D ISOMETRIC VIEW — C NOTES

1 CEILING-RECESSED LOUDSPEAKER BACKCAN MOUNTING

INFRASTRUCTURE DESIGN ASSOCIATES
1440 Broadway
Suite 304
Oakland, CA 94612
consultant

tBP
architecture
planning
interiors
management
LICENSED ARCHITECT · STATE OF CALIFORNIA · ROBERT E. STEVENS · No. C-0885 · REGISTRATION EXPIRES 12-31-06
tBP/Architecture/
1000 Burnett Avenue, Suite 140
Concord, CA 94520
p: 925.246.6449 f: 925.246.6495

EXHIBIT STAMP
DIV. OF THE STATE ARCHITECT
OFFICE OF REGULATION SERVICES
APP. # 01-106336
ACCESS IS OK
DATE 1-11-05

name
address
city, state, zip
ph: fx:

SCIENCE BUILDING
LOS MEDANOS COLLEGE
Contra Costa Community College District
owner

tBP project number : 20247.00
file name:
drawn by: checked by:
date: NOVEMBER 15, 2004

drawing title: DETAILS AUDIOVISUAL
building no:

LMC SCIENCE 313-023-112.01-0-00.00
drawing no: T6-7
drawing of

J:\Los Medanos College\Science Building\BID Set\acad\T6-7.dwg 11-08-04 10:37:59 AM cmendoza

ADDENDUM
DSA FILE # 7-CI
DSA APPL # 01-106226

GENERAL NOTES

1. ALL WALL BENCHTOPS SHALL BE 25" DEEP INCLUDING BACK SPLASH (UNLESS OTHERWISE NOTED).
2. ALL ISLAND BENCHTOPS SHALL BE 60" DEEP (UNLESS OTHERWISE NOTED).
3. ALL BENCHES AND TABLES SHALL BE 36" HIGH (UNLESS OTHERWISE NOTED).
4. ALL BENCHTABLE TOPS TO BE 1" THICK EPOXY RESIN (UNLESS OTHERWISE NOTED).
5. ALL BACK AND SIDE SPLASHES AND PIPE DROP CURBS TO BE 1" THICK AND 4" HIGH.
6. PROVIDE SIDE SPLASH AT ALL BENCH TOPS AND SCULLERY SINKS AGAINST FUME HOODS AND/OR ADJACENT WALLS.
7. OVERALL LENGTH OF BENCHTOPS SHALL BE DETERMINED BY CASEWORK SIZES AND DIMENSIONS AS INDICATED ON PLANS. TOPS SHALL OVERHANG 1-1/2" AT EACH END AND 1" FROM FRONT OF BASE CABINETS AND TABLES. ALL OVERALL DIMENSIONS ARE GIVEN, 1/2" OVERHANG IS NOT INCLUDED.
8. ALL CASEWORK, FUME HOODS AND ANY OTHER FURNISHINGS WITH EXPOSED-TO-VIEW BACKS AND SIDES SHALL BE FINISHED.
9. INSTALL CLOSURE PANELS BETWEEN BACK OF CABINETS OR HOODS AND WALLS AT EXPOSED ENDS AND BETWEEN BASE CABINETS AND/OR HOODS THAT ARE SET BACK TO BACK.
10. ALL PENETRATIONS THROUGH BENCHTOP SHALL BE SEALED WITH SEALANT.
11. BACKS OF COUNTERTOPS AND SPLASHES AGAINST WALLS SHALL BE SEALED TO THE WALL WITH SEALANT.
12. CONTRACTOR SHALL FIELD VERIFY ALL DIMENSIONS PRIOR TO FABRICATION.
13. OWNER'S REPRESENTATIVE WILL SELECT COLORS FOR ALL COMPONENTS OF PROJECT INDICATED ON THESE DRAWINGS. COLOR SELECTION WILL BE FROM THE CASEWORK MANUFACTURER'S STANDARD COLOR LINE.
14. FREE STANDING SHELVING AND CASEWORK LESS THAN 18" DEEP SHALL BE SECURED TO PREVENT TIPPING. SUBMIT SHOP DRAWINGS OF ATTACHMENT PRIOR TO INSTALLATION.
15. SAFETY SHOWER/EYEWASH UNITS SHALL COMPLY WITH ADA & ANSI STANDARDS FOR USABILITY BY THE PHYSICALLY DISABLED. SAFETY SHOWER/EYEWASH UNITS SHALL BE FURNISHED UNDER DIVISION 11 FOR INSTALLATION UNDER DIVISION 15.
16. FOR LABORATORY SERVICE FITTING TYPES, LOCATIONS AND ORDER, SEE LABORATORY FURNISHINGS PLANS. THESE FITTINGS SHALL BE PROVIDED UNDER DIVISION 11, FOR INSTALLATION UNDER DIVISION 15.
17. WHERE NO FUME HOOD OCCURS ADJACENT TO CORROSIVE STORAGE CABINETS, ROUTE VENT PIPE ON PIPE CHASE UP ADJACENT PIPE DROP ENCLOSURE TO EXHAUST DUCT SYSTEM FOR CONNECTION BY DIVISION 15.
18. WHERE FUME HOOD OCCURS ADJACENT TO VACUUM PUMP OR CORROSIVE STORAGE CABINETS, ROUTE VENT PIPE ON PIPE CHASE TO FUME HOOD AND EXTEND 4" ABOVE FUME HOOD WORK SURFACE BEHIND SHIELD.
19. ALL SHOWER CHASE SHOWN ON THESE DRAWINGS INCLUDING FLEXIBLE DUCT HOSE, SHALL BE PROVIDED UNDER DIVISION 11. SHOWER 15 SHALL PROVIDE DUCTWORK TO 6" BELOW CEILING OR 9'-0" ABOVE FINISHED FLOOR, WHICHEVER IS GREATER AND AS OTHERWISE SHOWN. 3 (NOT USED)
20. LOCATION OF EQUIPMENT SUCH AS FUME HOODS, DRENCH/EYE/SAFETY CABINETS, BRACES OR ANY OTHER ITEMS THAT MAY BE AFFECTED BY OVERHEAD SERVICES SHALL BE COORDINATED WITH THE CEILING PLANS COORDINATED. NOTIFY OWNER'S REPRESENTATIVE OF DISCREPANCIES PRIOR TO PROCEEDING WITH WORK.
21. UNLESS OTHERWISE NOTED, ALL MISCELLANEOUS CHANNELS, BRACKETS AND FITTINGS INDICATED ON ALL LABORATORY FURNISHINGS DRAWINGS SHALL BE SUPPLIED, INSTALLED AND PAINTED UNDER DIVISION 11.
22. CONTRACTOR SHALL EXAMINE ALL LABORATORY FURNISHINGS PLANS AND COORDINATE WITH REFLECTED CEILING PLANS FOR PROPER CEILING HEIGHTS & PIPE DROP ENCLOSURE HEIGHTS AND LOCATIONS.

LABORATORY FURNISHINGS NOTES & LEGEND
LFN1 #2

SCIENCE BUILDING
LOS MEDANOS COLLEGE
Pittsburg, CA
Contra Costa Community College District — ARCHITECT: IBI/Architecture, 1000 Burnett Ave, Suite 140, Concord, CA 94520, T: 925.246.6400, F: 925.246.6405
Mechanical / Plumbing Engineer: Interface Engineering
Electrical Engineer: Interface Engineering

REGISTERED ARCHITECT — JUSTIN WARREN — No.C 24746 — STATE OF CALIFORNIA

ADDENDUM #2
DATE: 04/04/05
DSA NO: 01-106226
THIS REVISED IN PART
SHEET: LFN-01
SHEET: LFR-1

ADDENDUM
DSA FILE # 7-CI
DSA APPL # 01-106226

LABORATORY SYMBOLS LEGEND

	SYMBOL LEGEND	DESCRIPTION
1	CBBD	PIPE DROP ENCLOSURE
2		DRYING RACK
3		ADJUSTABLE WALL SHELVES (3 TIER U.O.N.)
4		ADJUSTABLE ISLAND/PENINSULA BENCH SHELVING (3 TIER U.O.N.)
5		CYLINDER RESTRAINT ASSEMBLY
6		MARINE EDGE
7		OPEN INDUSTRIAL METAL SHELF UNITS
8		18" ADJUSTABLE WALL SHELVING ON UNISTRUT
9	NOT USED	NOT USED
10		SAFETY STATION WITH RECESSED PULL-DOWN EYEWASH
11		MOVABLE TABLE
12		WIRE SHELVING UNIT
13		RECESSED MIXING UNIT, HOSE STATION
14	14	ELECTRICAL PEDESTAL BY DIVISION 16
15	NOT USED	NOT USED
16	EDDD	WATER PURIFIER - OWNER FURNISHED, OWNER INSTALLED

LABORATORY FURNISHINGS NOTES & LEGEND
LFN1 #2

SCIENCE BUILDING
LOS MEDANOS COLLEGE
Pittsburg, CA
Contra Costa Community College District — ARCHITECT: IBI/Architecture, 1000 Burnett Ave, Suite 140, Concord, CA 94520, T: 925.246.6400, F: 925.246.6405
Mechanical / Plumbing Engineer: Interface Engineering
Electrical Engineer: Interface Engineering

REGISTERED ARCHITECT — JUSTIN WARREN — No.C 24746 — STATE OF CALIFORNIA

ADDENDUM #2
DATE: 04/04/05
DSA NO: 01-106226
THIS REVISED IN PART
SHEET: LFN-02
SHEET: LFR-2

ADDENDUM
DSA FILE # 7-CI
DSA APPL # 01-106226

SEE DETAIL 1/LFN2 FOR FIXTURE SPACING

LABORATORY SERVICE FITTING SCHEDULE

ASSEMBLY	NOTES	MOUNTING	DETAIL
ICW	COLD WATER FITTING	DECK	1/LFN2
		HOOD	2/LFN2
		DECK (ADA)	3/LFN2
IWMOW	HOT WATER/COLD WATER MIXING VALVE	DECK	1/LFN2
		DECK (ADA)	3/LFN2
		DECK (SPRAY)	4/LFN2
DI	PURE WATER FITTING	DECK	1/LFN2
		WALL	5/LFN2
DH	DRENCH HOSE - SINGLE HEAD	DECK	1/LFN2
LA, LG, LV & BA	LABORATORY AIR, LABORATORY VACUUM, LABORATORY GAS, BLOWER AIR FITTING	DECK	1/LFN2
		HOOD	2/LFN2
		HOOD (ADA)	3/LFN2

NOTE: SERVICES TO AUTOCLAVE & UNDERCOUNTER WASHER BY DIVISION 15 LABORATORY PLUMBING.

LABORATORY FURNISHINGS NOTES & LEGEND
LFN1 #2

SCIENCE BUILDING
LOS MEDANOS COLLEGE
Pittsburg, CA
Contra Costa Community College District — ARCHITECT: IBI/Architecture, 1000 Burnett Ave, Suite 140, Concord, CA 94520, T: 925.246.6400, F: 925.246.6405
Mechanical / Plumbing Engineer: Interface Engineering
Electrical Engineer: Interface Engineering

REGISTERED ARCHITECT — JUSTIN WARREN — No.C 24746 — STATE OF CALIFORNIA

ADDENDUM #2
DATE: 04/04/05
DSA NO: 01-106226
THIS REVISED IN PART
SHEET: LFN-03
SHEET: LFR-3

S. J. AMOROSO
Request For Information/Clarification

DSA FILE NO. 7-CI
DSA APPL. No. 01-106226

To: IBI/Architecture, 1000 Burnett Ave, Suite 140, Concord, CA 94520
Attn: Celia Chiang, Tom Beckett
Fax: 925-246-6405
Project: LOS MEDANOS COLLEGE SCIENCE BUILDING, Contra Costa Community College District
ISP p/n: 20247.00
Subj.: Epoxy Sink Not Available
RFI No: **474**
Reference (dwg, spec.): 3/LF2-1a
Subcontractor RFI: DDI 22
Reply Requested By: 2/9/07

INFORMATION REQUESTED: Date: 2/1/07

Please note the attached Dow Diversified RFI No. 22 regarding the Epoxy Sink in Room 236. That sink specified is no made to the size requested. Please advise if the attached product data for a slowly sized sink will be acceptable.

SUGGESTED SOLUTION:
Cost Impact: ☐ Schedule Impact: ☐ Says By: Justin Warren

RESPONSE: DATE:

Depth of sink is critical factor for this service sink (glassware washing). No exception taken to changing the length and width per above, but depth must be 16"-18" minimum.

Tom Beckett / IBI Architecture

2/9/07

RFI # 000
Page 1

Dow Diversified, Inc.

REQUEST FOR INFORMATION
Los Medanos College Science Building, 2352K
Proj RFI#:
DDI RFI#: 22

To: Mark Delgado
Subject: Epoxy Sink Not Available
Spec: 11662
Drawings: 3/LF2-1a & DDI sheet 19&92
Fax: 925-427-7370
Room: 236

REQUEST:
The LF drawings call out an epoxy SK2 sink to 40" X 18" X 16". There is only 1 and it is in room 236.

The manufacturer has come back to me and said that they do not have a sink that large. In addition, with this sink sitting in front of a pipe chase there is concern with having enough room for the service fixtures.

The closest size available that will also allow for the service fixtures is the Lab Tops U63 which is 31" X 17" X 10". Please see the attached product data.

SUGGESTION:
Please approve the U63 as the largest available size that will fit in the space available.

PRIORITY: ASAP
DUE DATE: 2/7/2007.
BY: ☐ Ben Kemper DATE: 1/31/2007

Response By:
Response Date:
RESPONSE:

LaboratoryTops, Inc.

Product Dimensions

Standard Undermount Sinks

Part No.	Depth	Width	Corner Radius	Depth

Copyright Laboratory Tops, Inc. All rights reserved.

Los Medanos College
4CD Proj.# : L-SCS-B-23-SC
Science Building