EQUIPMENT LIST

ACI 1 ACO 1 ACI 2 ACO 2 ACI 3 ACO 3	"MITSUBISHI" DUCTLESS SPLIT-TYPE AIR CONDITIONER MS24WN/MU24WN HAVING A COOLING CAPICITY OF 22,800 BTUH AT ARI CONDITIONS. MINIMUM DRY COIL AIR FLOW AT LOW-MEDIUM-HIGH SPEEDS SHALL BE 431-491-565 CFM. MINIMUM EER/SEER IS 10.5 AND MAXIMUM POWER CONSUMPTION IS 2,170W AT ARI CONDITIONS. 115V./ 1ø/ 60Hz POWER SUPPLY TO INDOOR AND 208/230V./ 1ø/ 60Hz POWR SUPPLY TO OUTDOOR UNIT. PROVIDE MANUFACTURER'S REFRIGERANT PIPE PACKAGE. APPROXIMATE WEIGHT = 40 LBS. (INDOOR) AND 152 LBS. (OUTDOOR). ACI 4 ACO 4 Added ACI/4 and ACO/4 to Equipment List. Addendum No. 1
ACS 1 CU 1 ACS 2 CU 2	"TRANE" SPLIT COOLING SYSTEM: INDOOR UNIT – MODEL NUMBER TWE018P13 CONVERTABLE AIR HANDLER. SYSTEM SHALL HAVE A TOTAL COOLING CAPICITY OF 18,400 BTUH AND SENSIBLE OF 12,800 BTUH AT ARI CONDITIONS. MINIMUM DRY COIL AIR FLOW SHALL BE 600 CFM. MINIMUM SEER IS 12.6. (1) 1/4 HP INDOOR FAN FLA-1.5 208V/1ø/60HZ. APPROXIMATE WEIGHT = 140 LBS. OUTDOOR UNIT – MODEL NUMBER 2TTR2018A1000A CONDENSING UNIT. SYSTEM SHALL HAVE A COOLING CAPICITY OF 18,200 BTUH AND SENSIBLE OF 13,800 BTUH AT ARI CONDITIONS. MINIMUM EER/SEER IS 11.6/11.0. ELECTRICAL: FAN-1/15 HP, 0.6 FLA, COMPRESSOR-7.2 RLA, UNIT 10.0 MCA 15 MOCP, 208V/1ø/60Hz. APPROXIMATE WEIGHT = 200 LBS. PROVIDE SYSTEM WITH MANUFACTURER'S REFRIGERANT PIPE PACKAGE.
CT 1	COOLING TOWER: "EVAPCO" OR APPROVED TO PROVIDE 290 TONS OF COOLING-90°/80°/70° F WB, 10 HP – 460V-3ø ABB ACH400 VFD, 870 GPM, 3 WAY CONTROL VALVE, "EVAPCO" AT 19-214, SOLD WATER MAKEUP ± 16 GPM, STAINLESS STEEL SUMP, LADDER, RAILED PLATFORM, INVERTED DUTY MOTOR, PROVIDE BREAKOUT PRICING FOR LOW SOUND LEVEL FAN AND "DOLPHIN" SYSTEM. OPERATING WEIGHT-11,000 LBS INSTALL ON STRUCTURAL STEEL UNDERFLANGE BEAMS SIZED FOR PROPER DEFLECTION. SUPPORT ON CONCRETE PIERS TO ALL 48" BETWEEN MECHANICAL ROOM FLOOR LEVEL AND BOTTOM OF SUMP. PROVIDE SEISMIC SUPPORT. PROVIDE NON-POTABLE MAKEUP WATER AND PURGE EQUIPMENT. PROVIDE SANITARY AREA DRAIN WITH TOP 4" ABOVE FINISHED GRADE.
AS 1	AIR SEPARATOR: "SPIROVENT", MODEL HV HIGH VELOCITY MICROBUBBLE SPARATOR. UNIT SHALL BE 8". APPROXIMATE UNIT WEIGHT = 335 LBS.
ET 1	EXPANSION TANK: "WESSEL", MODEL FXA-800, 211 TANK VOLUME, 36"ø TANK, 63" TALL, 2" INLET. APPROXIMATE OPPERATING WEIGHT = 2,400 LBS.
RM 1	REFRIGERANT MONITOR: PROVIDE REFRIGERANT GAS LEAK MONITOR WITH MONITOR MOUNTED HORN AND BLUE STROBE COMPLETE WITH AUXILIARY EXTERIOR REMOTE HORN AND BLUE STROBE. MONITOR TO BE YOKOGAWA MODEL HGM300 OR EQUAL WITH A MINIMUM OF 3 REMOTE SENSORS. MONITOR SHALL BE REFRIGERANT SPECIFIC, SINGLE GAS SENSING, R-123 REFRIGERANT TYPE, HUMAN INTERFACE, WALL MOUNTED. IN ADDITION TO THE SPECIFICATION PROVIDE AND DO THE FOLLOWING, VERIFY REFRIGERATION MACHINERY ROOM AMBIENT SOUND LEVELS AND PROVIDE ALARM SIGNALING DEVICES WITH 15 dBA OR MORE ABOVE OPERATING AMBIENT. REFRIERANT MONITOR TO ALARM TO BUILDING MANAGEMENT SYSTEM.

INLET SCHEDULE

INLET DESIGNATION	AIRFLOWS CFM RANGE	INLET SIZE
A	0-250	12x12
B	251-565	18x18
C	566-840	22x22

1. AIR BALANCE ALL OPEN AREAS AND INDIVIDUAL ROOMS FOR EQUAL PRESSURE CONDITIONS.

TRANSFER AIR OPENING NOTES

SYMBOL	SIZE (WIDTH"xHEIGHT")	MAXIMUM TRANSFER AIR (CFM)
D	14x10	250
E	14x18	450

1. PROVIDE OPENING IN WALL ABOVE CEILING TO ALLOW TRANSFER OF PLENUM RETURN AIR. OPENINGS SHALL BE ABOVE CEILINGS AT ALL LOCATIONS MARKED WITH A ACCORDING TO THE SCHEDULE BELOW. LOCATE OPENINGS AT HIGHEST ELEVATION POSSIBLE. ALL OPENINGS SHALL BE FINISHED WITH GYP. BOARD.

AIR CONDITIONING LEGEND

- RETURN OR EXHAUST AIR DUCT
- SUPPLY AIR DUCT
- HOOD EXHAUST AIR VALVE-PHEONIX CONTROLS
- GENERAL EXHAUST AIR VALVE-PHEONIX CONTROLS
- SUPPLY AIR VALVE-PHEONIX CONTROLS
- FLEXIBLE CONNECTION
- HWS — HEATING HOT WATER SUPPLY
- HWR — HEATING HOT WATER RETURN
- BLV. — BALL VALVE
- BV. — BALANCE VALVE
- CKV. — CHECK VALVE
- LH.GC. — LEVER HANDLE GAS COCK
- THERMOMETER, PRESSURE GAUGE
- OUTSIDE AIR INTO LOUVER
- RETURN OR EXHAUST AIR INTO REGISTER
- SUPPLY AIR FROM REGISTER
- OUTSIDE AIR DUCT SECTION
- RETURN OR EXHAUST AIR DUCT SECTION
- SUPPLY AIR DUCT SECTION

- 12 x 10 — DUCT (FIRST FIGURE SIDE SHOWN, SECOND FIGURE SIDE NOT SHOWN)
- TURNING VANES
- FLEXIBLE DUCTWORK
- VCD — VOLUME CONTROL DAMPER
- R — RISE OR DROP IN DIRECTION OF ARROW
- T-H — ROOM THERMOSTAT
- Ø — DIAMETER
- AC — AIR CONDITIONING
- AD, AP — ACCESS DOOR, ACCESS PANEL
- CC — CENTER TO CENTER
- CFM,f — CUBIC FEET OF AIR PER MINUTE
- E — EXTRACTOR
- B — BREAKGLASS (FOR REFRIGERANT MONITOR)

EAD ,OAD ,RAD	EXHAUST AIR, OUTSIDE AIR, & RETURN AIR DAMPER
EF	EXHAUST FAN
°F	DEGREES FAHRENHEIT
FD / CSFD	FIRE DAMPER / COMBINATION SMOKE FIRE DAMPER
GA.	GAUGE
GALV.	GALVANIZED
AAV. / MAV.	AUTOMATIC / MANUAL AIR VENT
MAX., MIN.	MAXIMUM, MINIMUM
M.D.	MANUAL DAMPER
P.D.	PITCH DOWN IN DIRECTION OF ARROW
PRV.	PRESSURE REDUCING VALVE
RA, EA.	RETURN AIR, EXHAUST AIR
SA, OA.	SUPPLY AIR, OUTSIDE AIR
T.C.V.	TEMPERATURE CONTROL VALVE
T.C.P.	TEMPERATURE CONTROL PANEL
TYP.	TYPICAL
UCD	UNDERCUT DOOR
RD.	ROOF DRAIN
ROOMNAME / ---	ROOM NAME & NUMBER

PUMP SCHEDULE

SYMBOL	MANUFACTURER MODEL & SIZE	SERVICE	GPM	TDH FT. of H2O	MOTOR DATA HP	BHP	VOLT	PHASE	RPM	WEIGHT LBS.	REMARKS
CHWP 1	B&G MODEL 1510 – 4E	CONDENSER WATER	580	90	20	18	460	3	1750	740	PROVIDE WITH ABB ACH400 VFD AND MANUAL BYPASS
CWP 1	B&G MODEL 1510 – 5BC	CHILLED WATER	800	50	15	12.5	460	3	1750	680	PROVIDE WITH ABB ACH400 VFD AND MANUAL BYPASS

NOTES:

REHEAT COIL SCHEDULE

SYMBOL	MANUFACTURER & MODEL	CFM	MIN. ROW/ FPI	EAT °F	LAT °F	MINIMUM CAPACITY MBH.	GPM	EWT °F	LWT °F	MAXIMUM AIR P.D. IN. WC.	BRANCH PIPE HWS	BRANCH PIPE HWR	TCV. SIZE	TCV. CV.
RHC 2.8	TEMTROL REHEAT COIL MODEL: Z-8-A-2-B SIZE: 18x21	1680	2/8	55	92.8	68.95	3.2	180	135.6	0.24	3/4"	3/4"	1/2"	1.9
RHC 2.9	TEMTROL REHEAT COIL MODEL: Z-8-A-2-B SIZE: 18x21	1770	2/8	55	91.6	70.32	3.2	180	134.7	0.26	3/4"	3/4"	1/2"	1.9
RHC 2.11	TEMTROL REHEAT COIL MODEL: Z-8-A-2-B SIZE: 18x21	1650	2/8	55	92.9	67.9	3.1	180	134.8	0.23	3/4"	3/4"	1/2"	1.9
RHC 2.12	TEMTROL REHEAT COIL MODEL: Z-8-A-2-A SIZE: 12x15	750	2/8	55	96.4	33.64	1.9	180	143.5	0.22	3/4"	3/4"	1/2"	1.2
RHC 2.21	TEMTROL REHEAT COIL MODEL: Z-8-A-2-B SIZE: 18x18	1520	2/8	55	92.0	60.92	3.0	180	138.1	0.26	3/4"	3/4"	1/2"	1.9
RHC 2.22P	TEMTROL REHEAT COIL MDL: SWC-16-24x24x2-7 AL SIZE: 18x48	2600	2/7	55	93.0	107.22	5.5	180	140.2	0.22	1-1/4"	1-1/4"	3/4"	4.7
RHC 2.22P	TEMTROL REHEAT COIL MDL: SWC-16-24x24x2-7 AL SIZE: 18x48	2600	2/7	55	93.0	107.22	5.5	180	140.2	0.22	1-1/4"	1-1/4"	3/4"	4.7
RHC 2.22P	TEMTROL REHEAT COIL MDL: SWC-16-24x24x2-7 AL SIZE: 18x48	2600	2/7	55	93.0	107.22	5.5	180	140.2	0.22	1-1/4"	1-1/4"	3/4"	4.7
RHC 2.22P	TEMTROL REHEAT COIL MDL: SWC-16-24x24x2-7 AL SIZE: 18x48	2600	2/7	55	93.0	107.22	5.5	180	140.2	0.22	1-1/4"	1-1/4"	3/4"	4.7
RHC 2.27	TEMTROL REHEAT COIL MODEL: Z-8-A-2-C SIZE: 18x45	3640	2/8	55	91.4	143.64	6.9	180	137.1	0.24	1-1/4"	1-1/4"	3/4"	4.7

NOTES:
1. TRANSITION AS NECESSARY FROM DUCT SIZE SHOWN ON PLANS TO COIL SIZE.
2. PROVIDE ACCESS DOORS UPSTREAM OF ALL REHEAT COILS.
3. ALL BRANCH PIPES TO RHCs SHALL BE 3/4" UNLESS OTHERWISE NOTED.
4. TCVs BASED ON BELIMO B SERIES VALVES.

GENERAL NOTES

1. BRANCH DUCT SIZES TO INDIVIDUAL VAV BOXES SHALL BE THE INLET SIZE OF THE BOX UNLESS NOTED OTHERWISE.
2. PAINT ALL EXPOSED DUCTWORK, COLOR AS SELECTED BY ARCHITECT. DO NOT PAINT EXTERNALLY INSULATED DUCT SYSTEMS.
3. HYDRONIC HOT WATER PIPING TO INDIVIDUAL VAV BOXES SHALL BE 3/4" UNLESS NOTED OTHERWISE.
4. PROVIDE FIRE STOPPING ASSEMBLY PROTECTION FOR DUCT AND PIPE PENETRATIONS OF RATED ASSEMBLIES. FIRE STOP RATING SHALL MATCH RATED ASSEMBLY BEING PENETRATED.
5. PROVIDE EXHAUST DUCT TRANSITION TO FUME HOOD OUTLET SIZE, AS REQUIRED, AT CONNECTION TO FUME HOOD.
6. REFER TO STRUCTURAL DRAWINGS, S1.1 FOR SEISMIC DESIGN REQUIREMENTS.

AIR FILTER SCHEDULE

SYSTEM	ASHRAE EFF%	MAX. P.D. IN. WC INITIAL	MAX. P.D. IN. WC FINAL	REMARKS
AC 1	30%	.15	1.0	PRE-FILTERS
	85%	.68	1.5	SECONDARY FILTERS
AHU 2	30%	.15	1.0	PRE-FILTERS
	85%	.68	1.5	SECONDARY FILTERS
AHU 3	30%	.15	1.0	PRE-FILTERS
	85%	.68	1.5	SECONDARY FILTERS

NOTES:
1. PROVIDE "DWYER" 250-AF FILTER GAUGE AT ALL FILTER BANKS, FACTORY MOUNTED ON AHU'S.
2. QUANTITIES AND SIZES AS REQUIRED.
3. PROVIDE SUFFICIENT SPARE FILTERS FOR 3 COMPLETE CHANGE OUTS.

EXHAUST FAN SCHEDULE

SYMBOL	MANUFACTURER AND MODEL	MODEL NUMBER	CAPACITY CFM	CAPACITY ESP "WC	CAPACITY BHP	CAPACITY RPM	ELECTRICAL HP	ELECTRICAL VOLT	ELECTRICAL PH.	UNIT WEIGHT (LBS.)	COMMENTS / NOTES
EF 1	M.K. PLASTICS	AXIJET 3650	14,000	3.5	11.8	976	15	460	3	4000	SEE NOTE 1.
EF 2	M.K. PLASTICS	AXIJET 3650	14,000	3.5	11.8	976	15	460	3	4000	SEE NOTE 1.
EF 3	M.K. PLASTICS	AXIJET 3650	14,000	3.5	11.8	976	15	460	3	4000	SEE NOTE 1.
EF 4	GREENHECK	SWB-222-30	6,530	1.25	2.55	1,240	3	460	3	500	GENERAL EXHAUST FAN – UTILITY SET
EF 5	GREENHECK	CUBE-161HP-10	2,155	1.25	0.86	1,594	1	460	3	75	BATHROOM EXHAUST FAN
EF 6	GREENHECK	CW-085-D	320	0.25	0.03	1550	1/20	120	1	40	PROVIDE WITH MANUFACTURER WALL GRILLE AND SPEED CONTROLLER
EF 7	GREENHECK	CUBE-180HP-20	3,750	1.25	1.68	1725	2	460	3	130	SEE NOTE 2.
EF 8	GREENHECK	CUE-095-D	450	0.5	0.09	1,422	1/8	120	1	40	CHEMICAL WASTE STORAGE ROOM EXHAUST FAN, SEE NOTE 3.

NOTES:
1. LAB EXHAUST FAN – UTILITY FAN. TRIPLE FAN ASSEMBLY WITH TWO VFD'S AND AUTO LEAD/LAG CONTROLS. ASSEMBLY TO PROVIDE 28,000 CFM TOTAL EXHAUST CAPACITY WITH (2) FANS DELIVERING 14,000 CFM EACH. FAN MINIMUMS SHALL BE 6900 CFM EACH WITH (2) FANS DELIVERING 13,800 CFM TOTAL AT MINIMUM SETTINGS. PROVIDE (1) EPOXY COATED INLET PLENUM WITH OSA INLET, FRONT AND SIDE EXHAUST INLET AND MOTORIZED DAMPERS. LOUVERED RAIN GUARD.
2. CHILLER ROOM EXHAUST FAN – PROVIDE WITH VFD. FAN TO PROVIDE GENERAL VENTILATION OF 800 CFM AND IS TO RAMP UP AS REQUIRED BY A T-STAT TO MAINTAIN 96°f MAX (ADJ.) SPACE TEMPERATURE. ALSO, INTERCONNECT FAN TO REFRIGERANT MONITOR, ON ALARM FROM THE REFRIGERANT MONITOR SYSTEM THE FAN IS TO OVERRIDE ALL OTHER FUNCTIONS AND START, THE PURGE CYCLE EXHAUST FLOW OF 3,750 CFM. PURGE CONDITIONS ARE TO REMAIN UNTIL MANUALLY RESET.
3. EF/8 TO BE PROVIDED WITH THE FOLLOWING OPTIONS: UL/cUL 705, MOTOR W/ THERMAL OVERLOADS, SOLID STATE SPPED CONTROL, AND ROOF CURB. FAN TO ALSO BE COATED WITH HI-PRO POLYESTER – IVORY, COAT ENTIRE FAN AND FACTORY ATTACHED ACCESSORIES.

AIR HANDLER SCHEDULE

SYMBOL	MANUFACTURER MODEL & SIZE	FAN DATA: SUPPLY AIR CFM	SUPPLY FAN & MOTOR DATA: FAN SIZE	E.S.P.	H.P.	VOLT	PHASE	RPM	RETURN AIR CFM	RETURN FAN & MOTOR DATA: FAN SIZE	E.S.P.	H.P.	VOLT	PHASE	RPM	COOLING COIL DATA: CAPACITY MBH TC	SC	GPM AVAILABLE	CFM	MIN. FACE AREA FT²	EADB	EAWB	LADB	LAWB	EWT	LWT	ROWS / FPI	MAX. AIR P.D. IN. W.C	MAX. WATER P.D. – FT.	PRE-HEAT COIL DATA: MBH	GPM AVAILABLE	MIN. FACE AREA FT	EADB	EWT	LWT	ROWS / FPI	MAX. AIR P.D. IN. W.C.	MAX. WATER P.D. – FT.	MIN. O.A. CFM	APPROX. OPERATING WEIGHT (LBS.)	REMARKS
AHU 2	ENERGY LABS OUTDOOR ROOFTOP	59,850	542	2"	(2)40	460	3	900	21,350	445	1.5"	15	460	3	1800	2,581.4	2,438.1	429.9	59,850	120.3	89.51°F	66.0°F	51.79°F	51.31°F	45°F	57°F	6/6	0.80	7.99	972.1	32.3	120.3	44.9°F	180°F	120°F	1/6	0.08	2.19	38,510	37,300	SEE FILTER SCHEDULE SEE NOTE 4.
AHU 3	ENERGY LABS OUTDOOR ROOFTOP	20,100	365	2"	25	460	3	1200	18,060	365	1.5"	10	460	3	900	783.4	608.2	130.5	20,100	47.7	81.26°F	66.0°F	53.24°F	53.01°F	45°F	57°F	6/6	0.64	7.43	329.3	11.2	47.7	60 °F	180°F	120°F	1/6	0.06	1.6	5,030	18,500	SEE FILTER SCHEDULE

NOTES:
1. ALL UNITS SELECTIONS BASED ON 70 FT. ELEVATION.
2. ALL UNITS SHALL BE PROVIDED WITH SMOKE DETECTORS THAT SHALL SHUT THE AIR CONDITIONING UNIT DOWN UPON DETECTION OF SMOKE PER CMC 609. COORDINATE WITH FIRE ALARM ON ELECTRICAL DRAWINGS.
3. EACH UNIT SHALL BE WIRED FOR A SINGLE 120V/1ø/60Hz. POINT OF CONNECTION AND A SINGLE 460V/3ø/60Hz CONNECTION. UNITS SHALL BE PROVIDED WITH A ELECTRICAL CONVIENANCE OUTLET AND A 120V POWER CONNECTION WITHIN CONTROLS CABINET.
4. PROVIDE ONE VFD RATED AT 100 HP TOTAL TO CONTROL BOTH 40 HP MOTORS AT AHU-2 SUPPLY FAN.
5. PROVIDE ALL UNITS WITH PREMIUM EFFICENCY FANS.

Added note "Provide all units with premium efficiency fans" to AIR HANDLER SCHEDULE. Changed supply fan for AHU-2 from one fan at 75 HP to two fans at 40 HP. Added note to "Provide one 100 HP VFD to control both 40 HP motors at AHU-2 supply fan." Addendum No. 1

Modified return fan of AHU-2 to 15 HP.

Added reference to new note 4 in "REMARKS" column.

AIR CONDITIONING UNIT SCHEDULE

SYMBOL	MANUFACTURER MODEL & SIZE	FAN DATA: SUPPLY AIR CFM	SUPPLY FAN & MOTOR DATA: FAN SIZE	E.S.P.	H.P.	VOLT	PHASE	RPM	RETURN AIR CFM	RETURN FAN & MOTOR DATA: FAN SIZE	E.S.P.	H.P.	VOLT	PHASE	RPM	COOLING COIL DATA: CAPACITY MBH TC	SC	CFM	EADB	EAWB	LADB	LAWB	MIN. FACE AREA FT²	MAX. AIR P.D. IN. W.C.	HEATING COIL DATA: MBH	GPM AVAILABLE	MIN. FACE AREA FT	EADB	EWT	LWT	ROWS / FPI	MAX. AIR P.D. IN. W.C.	MAX. WATER P.D. – FT.	MIN. O.A. CFM	AIR COOLED CONDENSER LOAD (MCA/MOP)	TOTAL UNIT LOAD (MCA/MOP)	APPROX. OPERATING WEIGHT (LBS.)	FILTER QUANT./SIZE
AC 1A	ENERGY LABS OUTDOOR ROOFTOP	5600	182	2"	7.5	460	3	1800	5600	182	1.5"	7.5	460	3	1800	193	193	5600	84.92°F	64.0°F	53.1°F	51.4°F	13.0	0.43	229.8	11.6	13.0	56.5°F	180°F	140°F	1/12	0.1	2.1	2400	59.4/70	45.8/80	14,100	SEE FILTER SCHEDULE

NOTES:
1. ALL UNITS SELECTIONS BASED ON 70 FT. ELEVATION.
2. ALL UNITS SHALL BE PROVIDED WITH SMOKE DETECTORS THAT SHALL SHUT THE AIR CONDITIONING UNIT DOWN UPON DETECTION OF SMOKE PER CMC 609. COORDINATE WITH FIRE ALARM ON ELECTRICAL DRAWINGS.
3. EACH UNIT SHALL BE WIRED FOR A SINGLE 120V/1ø/60Hz. POINT OF CONNECTION AND A SINGLE 460V/3ø/60Hz CONNECTION. UNITS SHALL BE PROVIDED WITH A ELECTRICAL CONVIENANCE OUTLET AND A 120V POWER CONNECTION WITHIN CONTROLS CABINET.
4. PROVIDE ALL UNITS WITH PREMIUM EFFICENCY FANS.

Added note "Provide all units with premium efficiency fans" to AIR CONDITIONING UNIT SCHEDULE. Addendum No. 1

CHILLER

SYMBOL	MANUFACTURER MODEL & SIZE	EVAPORATOR: TONS	GPM	EWT °F	LWT °F	MAX PD FT. HD	FOUL	PASSES	CONDENSER: GPM	EWT °F	LWT °F	MAX PD FT. HD	FOUL	PASSES	MOTOR DATA: KW	VOLT	PHASE	MCA	LRA	FLA	MAX FUSE/ BREAKER (AMPS)	REFRIGERANT
CH 1	YORK YKBBBDPI-CJF-290 TONS	290	580	56	44	7.9	0.00010	2	800	80	90	10.4	0.00025	2	151	460	3	273	1950	219	450	123 290 LBS

NOTES: 1. ALL UNITS SELECTIONS BASED ON 0 FT. ELEVATION.
OPER. WT: 17925 LBS

tBP architecture planning interiors management
tBP/Architecture
1000 Burnett Avenue, Suite 140
Concord, CA 94520
p: 925.246.6419 f: 925.246.6495
architect

AINSWORTH ASSOCIATES
MECHANICAL ENGINEERS
SACRAMENTO, CA
consultant

ENVIRONMENTAL STAMP
DIV. OF THE STATE ARCHITECT
OFFICE OF REGULATION SERVICES
APP. #4919606
DATE 11-1-04

name
address
city, state, zip
ph: fx:
agency

SCIENCE BUILDING
LOS MEDANOS COLLEGE
Contra Costa Community College District
owner

tBP project number : 20241.00
file name:
drawn by: checked by:
date: NOVEMBER 15, 2004

Rev.	date:	description:

drawing title:
LEGENDS, SCHEDULES, EQUIPMENT LISTS, & NOTES

LMC SCIENCE 313-023-112.01-0-00.00
drawing no.:
M0.1
drawing of ?

\\2003-COST\DWG\M1-3.dwg Tue, Nov 16 2004 - 05:31pm

VAV BOX WEIGHT SCHEDULE

INLET SIZE	WEIGHT
5"ø & 6"ø	45 LBS.
7"ø & 8"ø	49 LBS.
10"ø	59 LBS.
12"ø	71 LBS.
14"ø	79 LBS.
16"ø	96 LBS.
24"ø	144 LBS.

NOTE: 1. WEIGHT INCLUDES TERMINAL BOX WITH ATTENUATOR SECTION AND WET COIL.

VARIABLE AIR VOLUME BOX SCHEDULE

SYMBOL	MANUFACTURER AND MODEL	MAX. CFM	MIN. CFM	AIR S.P. LOSS (MIN.)	REHEAT COIL DATA												REMARKS
					CFM	ROWS	MBH	AIR EAT	AIR LAT	AIR PD. IN.	WATER GPM	WATER EWT	WATER LWT	WATER PD. FT.	TCV SIZE	TCV CV	
VAV 3.30	GREENHECK MODEL DESV SIZE 09	735	300	0.14	300	1	11.4	55	90	0.11	0.80	180	149.6	0.10	1/2	0.8	
VAV 3.31	GREENHECK MODEL DESV SIZE 09	735	300	0.14	300	1	11.4	55	90	0.11	0.80	180	149.6	0.10	1/2	0.8	
VAV 2.1	GREENHECK MODEL DESV SIZE 07	475	240	0.17	240	1	9.30	55	91	0.1	0.70	180	155	0.4	1/2	0.8	
VAV 2.2	GREENHECK MODEL DESV SIZE 12	1,550	915	0.23	915	1	21.30	55	77	0.23	1.00	180	137.3	0.3	1/2	0.8	
CAV 2.3	GREENHECK MODEL DESV SIZE 10	1020	1020	0.19	1020	1	18.9	55	72	0.19	1.00	180	142.2	0.20	1/2	0.8	
VAV 2.4	GREENHECK MODEL DESV SIZE 12	2,585	775	0.21	775	1	18.50	55	83	0.21	1.00	180	143.0	0.3	1/2	0.8	
VAV 2.5	GREENHECK MODEL DESV SIZE 14	1,995	600	0.22	600	1	19.20	55	58	0.18	0.40	180	83.9	0	1/2	0.8	
VAV 2.6	GREENHECK MODEL DESV SIZE 14	1,910	575	0.20	575	1	15.90	55	81	0.17	0.50	180	116.4	0	1/2	0.8	
VAV 2.7	GREENHECK MODEL DESV SIZE 14	1,910	575	0.20	575	1	15.90	55	81	0.17	0.50	180	116.4	0	1/2	0.8	
VAV 2.10	GREENHECK MODEL DESV SIZE 08	640	300	0.18	300	1	10.20	55	87	0.16	0.80	180	154.5	0.5	1/2	0.8	
VAV 2.13	GREENHECK MODEL DESV SIZE 05	230	115	0.07	115	1	5.20	55	97	0.04	0.40	180	150.1	0.1	1/2	0.8	
VAV 2.14	GREENHECK MODEL DESV SIZE 05	280	140	0.10	140	1	5.80	55	93	0.06	.040	180	151.2	0.1	1/2	0.8	
VAV 2.15	GREENHECK MODEL DESV SIZE 06	345	175	0.19	175	1	6.20	55	96	0.09	0.60	180	157.5	0.2	1/2	0.8	
VAV 2.16	GREENHECK MODEL DESV SIZE 04	165	85	0.08	85	1	4.70	55	106	0.02	0.40	180	153.8	0.1	1/2	0.8	
VAV 2.17	GREENHECK MODEL DESV SIZE 07	430	215	0.14	215	1	9.00	55	94	0.08	0.80	180	156.7	0.5	1/2	0.8	
VAV 2.18	GREENHECK MODEL DESV SIZE 07	420	210	0.14	210	1	7.00	55	86	0.08	0.30	180	133.4	0.1	1/2	0.8	
VAV 2.19	GREENHECK MODEL DESV SIZE 09	740	370	0.14	370	1	13.4	55	85	0.11	1.0	180	151.8	0.2	1/2	0.8	
VAV 2.20	GREENHECK MODEL DESV SIZE 04	125	65	0.05	65	1	4.20	55	115	0.01	0.40	180	155.9	0.1	1/2	0.8	
VAV 2.23	GREENHECK MODEL DESV SIZE 08	665	300	0.19	300	1	10.3	55	89	0.17	1.0	180	158.5	0.7	1/2	0.8	
VAV 2.24	GREENHECK MODEL DESV SIZE 14	2,065	620	0.23	620	1	19.80	55	85	0.19	0.80	180	130.6	0.1	1/2	0.8	
VAV 2.25	GREENHECK MODEL DESV SIZE 14	2,220	665	0.26	665	1	25.90	55	91	0.22	1.90	180	152.9	0.4	1/2	1.2	
VAV 2.26	GREENHECK MODEL DESV SIZE 14	1,825	700	0.18	700	1	26.80	55	91	0.15	2.10	180	154.4	0.5	1/2	1.2	
VAV 2.28	GREENHECK MODEL DESV SIZE 05	265	135	0.09	135	1	4.60	55	87	0.06	0.20	180	134.0	0	1/2	0.8	
VAV 2.29	GREENHECK MODEL DESV SIZE 12	1,255	445	0.16	445	1	16.60	55	89	0.16	1.00	180	146.9	0.3	1/2	0.8	
VAV 2.30	GREENHECK MODEL DESV SIZE 10	880	440	0.15	440	1	15.40	55	87	0.15	1.70	180	161.3	0.5	1/2	1.2	
VAV 2.31	GREENHECK MODEL DESV SIZE 06	290	145	0.13	145	1	5.40	55	89	0.07	0.30	180	144.1	0.1	1/2	0.8	
VAV 2.32	GREENHECK MODEL DESV SIZE 05	195	100	0.05	100	1	3.80	55	90	0.03	0.20	180	129.2	0	1/2	0.8	
VAV 2.33	GREENHECK MODEL DESV SIZE 10	980	490	0.18	490	1	15.70	55	85	0.18	1.40	180	157.6	0.4	1/2	0.8	

NOTES: 1. VAV BOXES SHALL HAVE MULTI-POINT SENSORS, INTEGRAL ATTENUATOR, AND STERI-LOC LINING.
2. VAV BOX ENTERING WATER TEMPERATURE SHALL BE 180'F, EXITING TEMPERATURE SHALL BE APPROXIMATELY 140'F.
3. ALL REHEAT COILS SHALL HAVE 2-WAY TEMPERATURE CONTROL VALVES.
4. TRANSITION BRANCH DUCT TO VAV BOXES TO BOX INLET SIZE.
5. TCVs BASED ON BELIMO B SERIES VALVES.

SYMBOL	MANUFACTURER AND MODEL	MAX. CFM	MIN. CFM	AIR S.P. LOSS (MIN.)	REHEAT COIL DATA												REMARKS
					CFM	ROWS	MBH	AIR EAT	AIR LAT	AIR PD. IN.	WATER GPM	WATER EWT	WATER LWT	WATER PD. FT.	TCV SIZE	TCV CV	
VAV 3.1	GREENHECK MODEL DESV SIZE 12	1515	745	0.22	745	1	18.9	55	95	0.22	2.1	180	161.7	1.0	1/2	1.2	
VAV 3.2	GREENHECK MODEL DESV SIZE 12	1,590	475	0.24	475	1	16.9	55	88	0.24	1.00	180	146.2	0.30	1/2	0.8	
VAV 3.3	GREENHECK MODEL DESV SIZE 12	1590	475	0.24	475	1	16.9	55	88	0.24	1.00	180	146.2	0.30	1/2	0.8	
VAV 3.4	GREENHECK MODEL DESV SIZE 05	190	95	0.05	95	1	5.0	55	104	0.03	0.40	180	154.8	0.10	1/2	0.8	
VAV 3.5	GREENHECK MODEL DESV SIZE 07	490	245	0.18	245	1	9.7	55	92	0.1	0.90	180	158.7	0.60	1/2	0.8	
VAV 3.6	GREENHECK MODEL DESV SIZE 09	740	370	0.14	370	1	13.4	55	89	0.11	1.10	180	156.4	0.30	1/2	0.8	
VAV 3.7	GREENHECK MODEL DESV SIZE 04	180	90	0.09	90	1	6.9	55	62	0.03	0.20	180	110.5	0.10	1/2	0.8	
VAV 3.8	GREENHECK MODEL DESV SIZE 09	785	435	0.16	435	1	13.2	55	83	0.12	0.9	180	148.8	0.20	1/2	0.8	
VAV 3.9	GREENHECK MODEL DESV SIZE 04	180	90	0.07	80	1	3.9	55	95	0.03	0.20	180	134.3	0.10	1/2	0.8	
VAV 3.10	GREENHECK MODEL DESV SIZE 05	260	130	0.09	130	1	4.60	55	87	0.06	0.20	180	134.0	0	1/2	0.8	
VAV 3.11	GREENHECK MODEL DESV SIZE 07	425	215	0.14	215	1	8.9	55	94	0.08	0.80	180	156.2	0.40	1/2	0.8	
VAV 3.12	GREENHECK MODEL DESV SIZE 07	420	210	0.14	210	1	8.7	55	93	0.08	0.70	180	154.4	0.40	1/2	0.8	
VAV 3.13	GREENHECK MODEL DESV SIZE 07	420	210	0.14	210	1	8.7	55	93	0.08	0.70	180	154.4	0.40	1/2	0.8	
VAV 3.14	GREENHECK MODEL DESV SIZE 07	475	240	0.17	240	1	8.9	55	89	0.1	0.60	180	150.5	0.30	1/2	0.8	
VAV 3.15	GREENHECK MODEL DESV SIZE 10	1000	445	0.35	445	1	24.3	55	106	0.34	1.20	180	139.5	0.30	1/2	0.8	
VAV 3.16	GREENHECK MODEL DESV SIZE 14	1925	580	0.2	580	1	19.6	55	106	0.17	1.5	180	153.1	0.40	1/2	0.8	
VAV 3.17	GREENHECK MODEL DESV SIZE 08	590	295	0.15	295	1	11.3	55	85	0.14	0.9	180	155.4	0.60	1/2	0.8	
VAV 3.18	GREENHECK MODEL DESV SIZE 05	150	75	0.06	75	1	4.2	55	90	0.04	0.20	180	133.4	0.10	1/2	0.8	
VAV 3.19	GREENHECK MODEL DESV SIZE 06	160	80	0.14	80	1	5.2	55	87	0.07	0.30	180	140.1	0.10	1/2	0.8	
VAV 3.20	GREENHECK MODEL DESV SIZE 05	95	50	0.08	50	1	5.0	55	91	0.05	0.30	180	141.6	0.10	1/2	0.8	
VAV 3.21	GREENHECK MODEL DESV SIZE 04	120	60	0.04	60	1	3.9	55	115	0.01	0.30	180	152.2	0.10	1/2	0.8	
VAV 3.22	GREENHECK MODEL DESV SIZE 04	180	90	0.096	90	1	4.8	55	105	0.03	0.40	180	153.2	0.10	1/2	0.8	
VAV 3.23	GREENHECK MODEL DESV SIZE 06	615	305	0.17	305	1	13.5	55	76	0.15	0.80	180	146.4	0.50	1/2	0.8	
VAV 3.24	GREENHECK MODEL DESV SIZE 10	850	480	0.14	480	1	14.6	55	83	0.14	1.1	180	152.4	0.20	1/2	0.8	
VAV 3.25	GREENHECK MODEL DESV SIZE 05	200	100	0.05	100	1	3.2	55	84	0.03	0.10	180	116.8	00.0	1/2	0.8	
VAV 3.26	GREENHECK MODEL DESV SIZE 05	235	120	0.07	120	1	5.3	55	96	0.05	0.40	180	149.7	0.10	1/2	0.8	
VAV 3.27	GREENHECK MODEL DESV SIZE 04	175	90	0.09	90	1	4.9	55	105	0.03	0.40	180	154.3	0.10	1/2	0.8	
VAV 3.28	GREENHECK MODEL DESV SIZE 07	490	245	0.18	245	1	8.5	55	87	0.1	0.50	180	145.9	0.20	1/2	0.8	
VAV 3.29	GREENHECK MODEL DESV SIZE 09	735	300	0.14	300	1	11.4	55	90	0.11	0.80	180	149.6	0.10	1/2	0.8	

NOTES: 1. VAV BOXES SHALL HAVE MULTI-POINT SENSORS, INTEGRAL ATTENUATOR, AND STERI-LOC LINING.
2. VAV BOX ENTERING WATER TEMPERATURE SHALL BE 180'F, EXITING TEMPERATURE SHALL BE APPROXIMATELY 140'F.
3. ALL REHEAT COILS SHALL HAVE 2-WAY TEMPERATURE CONTROL VALVES.
4. TRANSITION BRANCH DUCT TO VAV BOXES TO BOX INLET SIZE.
5. TCVs BASED ON BELIMO B SERIES VALVES.

SUPPLY / HOOD / EXHAUST AIR VALVE SCHEDULE

SYMBOL	MANUFACTURER MODEL & SIZE	MAX. CFM	MIN. CFM	OFFSET CFM	MAX. CLG. CFM	REMARKS
HEX 2.22B	TRIATEK W112M-304SS-FACT	500	200	-	-	-
HEX 2.22C	TRIATEK W108M-304SS-FACT	500	200	-	-	-
SUP 2.27	TRIATEK W312M-H-FACT	3640	1625	400	3635	PROVIDE WITH IAC 3L SILENCER
GEX 2.27	TRIATEK W108M-H-FACT	525	35	-	-	-
HEX 2.27A	TRIATEK W112M-304SS-FACT	800	300	-	-	-
HEX 2.27B	TRIATEK W112M-304SS-FACT	800	300	-	-	-
HEX 2.27C	TRIATEK W112M-304SS-FACT	800	300	-	-	-
HEX 2.27D	TRIATEK W112M-304SS-FACT	800	300	-	-	-
HEX 2.27E	TRIATEK W112M-304SS-FACT	800	300	-	-	-

NOTES:
1. PROVIDE VALVE SYSTEMS COMPLETE WITH HOOD MONITORS, AND SASH SENSORS
2. HOOD CONTROLS SHALL BE CAPABLE OF TIE-IN WITH DDC ENERGY MANAGEMENT SYSTEM VIA GATEWAY.
3. ALL AIR VALVES SHALL BE PROVIDED WITH TRIATEX DIGITAL CONTROLLERS AND CONNECTED TO THE DDC SYSTEM VIA BACKNET INTERFACE.

SUPPLY / HOOD / EXHAUST AIR VALVE SCHEDULE

SYMBOL	MANUFACTURER MODEL & SIZE	MAX. CFM	MIN. CFM	OFFSET CFM	MAX. CLG. CFM	REMARKS
SUP 2.22A	TRIATEK W212M-H-FACT	2600	1200	2600	2600	PROVIDE WITH IAC 3L SILENCER
SUP 2.22B	TRIATEK W212M-H-FACT	2600	1200	-	2600	PROVIDE WITH IAC 3L SILENCER
SUP 2.22C	TRIATEK W212M-H-FACT	2600	1200	-	2600	PROVIDE WITH IAC 3L SILENCER
SUP 2.22D	TRIATEK W212M-H-FACT	2600	1200	-	2600	PROVIDE WITH IAC 3L SILENCER
HEX 2.22A	TRIATEK W112M-304SS-FACT	800	300	-	-	-
HEX 2.22B	TRIATEK W112M-304SS-FACT	800	300	-	-	-
HEX 2.22C	TRIATEK W112M-304SS-FACT	800	300	-	-	-
HEX 2.22D	TRIATEK W112M-304SS-FACT	800	300	-	-	-
HEX 2.22E	TRIATEK W112M-304SS-FACT	800	300	-	-	-
HEX 2.22F	TRIATEK W112M-304SS-FACT	800	300	-	-	-
HEX 2.22G	TRIATEK W112M-304SS-FACT	800	300	-	-	-
HEX 2.22H	TRIATEK W112M-304SS-FACT	800	300	-	-	-
HEX 2.22J	TRIATEK W112M-304SS-FACT	800	300	-	-	-
HEX 2.22K	TRIATEK W112M-304SS-FACT	800	300	-	-	-
HEX 2.22L	TRIATEK W112M-304SS-FACT	800	300	-	-	-
HEX 2.22M	TRIATEK W112M-304SS-FACT	800	300	-	-	-
HEX 2.22N	TRIATEK W112M-304SS-FACT	800	300	-	-	-
HEX 2.22P	TRIATEK W112M-304SS-FACT	800	300	-	-	-

NOTES:
1. PROVIDE VALVE SYSTEMS COMPLETE WITH HOOD MONITORS, AND SASH SENSORS
2. HOOD CONTROLS SHALL BE CAPABLE OF TIE-IN WITH DDC ENERGY MANAGEMENT SYSTEM VIA GATEWAY.
3. ALL AIR VALVES SHALL BE PROVIDED WITH TRIATEX DIGITAL CONTROLLERS AND CONNECTED TO THE DDC SYSTEM VIA BACKNET INTERFACE.

SUPPLY / HOOD / EXHAUST AIR VALVE SCHEDULE

SYMBOL	MANUFACTURER MODEL & SIZE	MAX. CFM	MIN. CFM	OFFSET CFM	MAX. CLG. CFM	REMARKS
SUP 2.8	TRIATEK W212M-H-FACT	1680	1515	190	1680	PROVIDE WITH IAC 3L SILENCER
GEX 2.8	TRIATEK W212M-H-FACT	1570	905	-	-	-
HEX 2.8	TRIATEK W112M-304SS-FACT	800	300	-	-	-
SUP 2.9	TRIATEK W212M-H-FACT	1770	1550	200	1770	PROVIDE WITH IAC 3L SILENCER
GEX 2.9	TRIATEK W212M-H-FACT	1670	950	-	-	-
HEX 2.9	TRIATEK W112M-304SS-FACT	800	300	-	-	-
SUP 2.11	TRIATEK W212M-H-FACT	1650	1650	185	1650	PROVIDE WITH IAC 3L SILENCER
GEX 2.11	TRIATEK W212M-H-FACT	1535	1035	-	-	-
HEX 2.11	TRIATEK W112M-304SS-FACT	800	300	-	-	-
SUP 2.12	TRIATEK W110M-H-FACT	750	540	85	750	PROVIDE WITH IAC 3L SILENCER
GEX 2.12	TRIATEK W108M-H-FACT	535	35	-	-	-
HEX 2.12A	TRIATEK W112M-304SS-FACT	800	300	-	-	-
HEX 2.12B	TRIATEK W108M-304SS-FACT	80	80	-	-	-
SUP 2.21	TRIATEK W212M-H-FACT	1520	715	170	1520	PROVIDE WITH IAC 3L SILENCER
GEX 2.21	TRIATEK W112M-H-FACT	740	90	-	-	-
HEX 2.21A	TRIATEK W112M-304SS-FACT	800	300	-	-	-
HEX 2.21B	TRIATEK W112M-304SS-FACT	800	300	-	-	-

NOTES:
1. PROVIDE VALVE SYSTEMS COMPLETE WITH HOOD MONITORS, AND SASH SENSORS
2. HOOD CONTROLS SHALL BE CAPABLE OF TIE-IN WITH DDC ENERGY MANAGEMENT SYSTEM VIA GATEWAY.
3. ALL AIR VALVES SHALL BE PROVIDED WITH TRIATEX DIGITAL CONTROLLERS AND CONNECTED TO THE DDC SYSTEM VIA BACKNET INTERFACE.

tBP architecture planning interiors management
tBP/Architecture
1000 Burnett Avenue, Suite 140
Concord, CA 94520
p: 925.246.6419 f: 925.246.6495
architect

AINSWORTH ASSOCIATES
MECHANICAL ENGINEERS
SACRAMENTO, CA
consultant

name
address
city, state, zip
ph: fx:
agency

SCIENCE BUILDING
LOS MEDANOS COLLEGE
Contra Costa Community College District

owner

tBP project number : 2024100
file name:
drawn by: checked by:
date: NOVEMBER 15, 2004

Rev: date: description:

drawing title:
LEGENDS, SCHEDULES, EQUIPMENT LISTS, & NOTES

LMC SCIENCE 313-023-112.01-0-00.00
drawing no.: **M0.2**
drawing of ?

\2003-023\DWG\M0-1.5.dwg Tim Nov/12/2004-08:40pm

PERFORMANCE CERTIFICATE OF COMPLIANCE — Part 1 of 3 — PERF-1

PROJECT NAME		DATE
SCIENCE BUILDING - LOS MEDANOS COLLEGE		4/20/2004
PROJECT ADDRESS: 2700 E. LELAND ROAD Pittsburg		Building Permit #
PRINCIPAL DESIGNER - ENVELOPE: tBP / Architecture	TELEPHONE: 925-246-6419	
DOCUMENTATION AUTHOR: Ainsworth Associates Mechanical Engineers	TELEPHONE: (916) 737-6014	Checked by/Date Enforcement Agency Use

GENERAL INFORMATION

DATE OF PLANS	BUILDING CONDITIONED FLOOR AREA	CLIMATE ZONE
	46,357 Sq.Ft.	12

BUILDING TYPE: [X] NONRESIDENTIAL [ ] HIGH RISE RESIDENTIAL [ ] HOTEL/MOTEL GUEST ROOM

PHASE OF CONSTRUCTION: [X] NEW CONSTRUCTION [ ] ADDITION [ ] ALTERATION [ ] EXISTING + ADDITION

STATEMENT OF COMPLIANCE

This Certificate of Compliance lists the building features and performance specifications needed to comply with Title 24, Parts 1 and 6, of the State Building Code. This certificate applies only to a Building using the performance compliance approach.

DOCUMENTATION AUTHOR	SIGNATURE	DATE
David Weston		11/11/04

The Principal Designers hereby certify that the proposed building design represented in the construction documents and modelled for this permit application are consistent with all other forms and worksheets, specifications, and other calculations submitted with this permit application. The proposed building as designed meets the energy efficiency requirements of the State Building Code, Title 24, Part 6.

ENV.	LTG.	MECH.	
[ ]	[ ]	[✓]	1. I hereby affirm that I am eligible under the provisions of Division 3 of the Business and Professions Code to sign this document as the person responsible for its preparation; and that I am licensed as a civil engineer, mechanical engineer, electrical engineer or architect.
[ ]	[ ]	[ ]	2. I affirm that I am eligible under the provisions of Division 3 of the Business and Professions Code Section 5537.2 or 6737.3 to sign this document as the person responsible for its preparation; and that I am a licensed contractor preparing documents for work that I have contracted to perform.
[ ]	[ ]	[ ]	3. I affirm that I am eligible under Division 3 of the Business and Professions Code to sign this document because it pertains to a structure or type of work described as exempt pusuant to Business and Professions Code Sections 5537, 5538, and 6737.1. (These sections of the Business and Professions Code are printed in full in the Nonresidential Manual.)

ENVELOPE COMPLIANCE

Indicate location on plans of Note Block for Mandatory Measures — Required Forms: ENV-1

PRINCIPAL ENVELOPE DESIGNER - NAME	SIGNATURE	LIC. NO.	DATE
RICHARD G. MANSELIUM		C-8605	12.14.04

LIGHTING COMPLIANCE

Indicate location on plans of Note Block for Mandatory Measures — Required Forms: Lighting Compliance Not In The Scope Of This Submittal

PRINCIPAL LIGHTING DESIGNER - NAME	SIGNATURE	LIC. NO.	DATE

MECHANICAL COMPLIANCE

Indicate location on plans of Note Block for Mandatory Measures — Required Forms: MECH-1, MECH-2, MECH-3

PRINCIPAL MECHANICAL DESIGNER - NAME	SIGNATURE	LIC. NO.	DATE
David A. Weston		M31220	11/11/04

Run Initiation Time: 04/20/04 09:36:37 Run Code: 1082478997

EnergyPro 3.1 By EnergySoft User Number: 5891 Job Number: 2003-003 Page: 3 of 38

PERFORMANCE CERTIFICATE OF COMPLIANCE — Part 2 of 3 — PERF-1

SCIENCE BUILDING - LOS MEDANOS COLLEGE — DATE: 4/20/2004

ANNUAL SOURCE ENERGY USE SUMMARY (kBtu/sqft-yr)

ENERGY COMPONENT	Standard Design	Proposed Design	Compliance Margin
Space Heating	33.26	34.97	-1.70
Space Cooling	60.08	30.60	29.48
Indoor Fans	18.17	17.51	0.66
Heat Rejection	0.00	10.18	-10.18
Pumps & Misc.	5.55	7.53	-1.98
Domestic Hot Water	10.23	10.41	-0.18
Lighting	42.16	42.16	0.00
Receptacle	16.59	16.59	0.00
Process	22.82	22.82	0.00
TOTALS:	208.85	192.76	16.09

Percent better than Standard: 7.7% (8.7% excluding process)

BUILDING COMPLIES

GENERAL INFORMATION

Building Orientation	(Southeast) 137 deg	Conditioned Floor Area	46,357 sqft.
Number of Stories	1	Unconditioned Floor Area	0 sqft.
Number of Systems	3	Conditioned Footprint Area	24,877 sqft.
Number of Zones	67		

	Orientation	Gross Area	Glazing Area	Glazing Ratio
Front Elevation	(Southeast)	7,425 sqft.	2,470 sqft.	33.3%
Left Elevation	(Southwest)	8,570 sqft.	3,183 sqft.	37.1%
Rear Elevation	(Northwest)	4,210 sqft.	1,596 sqft.	37.9%
Right Elevation	(Northeast)	7,786 sqft.	3,086 sqft.	39.6%
Total		27,991 sqft.	10,335 sqft.	36.9%
Roof		19,585 sqft.	0 sqft.	0.0%

	Standard	Proposed	LEED NC Energy & Atmosphere Credit
Lighting Power Density	1,432 Wlsqft.	1,432 Wlsqft.	Savings vs. Title 24 [1] 9.50%
Prescriptive Env. Heat Loss	9,394 Btu/h	5,740 Btu/h	Energy Performance Credit [2] 1 Points
Prescriptive Env. Heat Gain	957,586 Btu/h-F	661,693 Btu/h-F	

1. excludes process and receptacle 2. see LEED table 8-c or 8-d

Remarks:

Run Initiation Time: 04/20/04 09:36:37 Run Code: 1082478997

EnergyPro 3.1 By EnergySoft User Number: 5891 Job Number: 2003-003 Page: 4 of 38

PERFORMANCE CERTIFICATE OF COMPLIANCE — Part 3 of 3 — PERF-1

PROJECT NAME: SCIENCE BUILDING - LOS MEDANOS COLLEGE — DATE: 4/20/2004

ZONE INFORMATION

System Name	Zone Name	Occupancy Type	Floor Area (sqft.)	Inst. LPD (W/sf) 1	Port. LPD (W/sf) 1	Ctrl. Credits (W/sf) 2	Tailored LPD (W/sf) 3	Proc. Loads (W/sf)
AC-1	Large Tiered Classroom	Classroom	2,380	*1.600				2.000
AH-2	VAV2-1	Lobby (Main Entry & Assembly)	352	*1.500				
	VAV2-2	Corridor/Restroom/Support	2,040	*0.600				
	VAV2-3	Medical/Clinical Care	1,075	*1.400				
	VAV2-4	Classroom	1,550	*1.600				
	VAV2-5	Classroom	1,025	*1.600				3.390
	VAV2-6	Classroom	945	*1.600				
	VAV2-7	Classroom	945	*1.600				
	SUP2-8	Classroom	1,515	*1.600				
	SUP2-9	Classroom	1,550	*1.600				
	VAV2-10	Classroom	725	*1.600				
	SUP2-11	Classroom	1,650	*1.600				
	SUP2-12	Classroom	810	*1.600				
	VAV2-13	Office	90	*1.300				
	VAV2-14	Corridor/Restroom/Support	90	*0.600				
	VAV2-15	Office	140	*1.300				
	VAV2-16	Corridor/Restroom/Support	85	*0.600				
	VAV2-17	Corridor/Restroom/Support	540	*0.600				
	VAV2-18	Office	525	*1.300				
	VAV2-19	Office	1,050	*1.300				

Notes: 1. See LTG-1 (Items marked with asterisk, see LTG-2 by others) 2. See LTG-3 3. See LTG-4 — Items above require special documentation

EXCEPTIONAL CONDITIONS COMPLIANCE CHECKLIST

The local enforcement agency should pay special attention to the items specified in this checklist. These items require special written justification and documentation, and special verification to be used with the performance approach. The local enforcement agency determines the adequacy of the justification, and may reject a building or design that otherwise complies based on the adequacy of the special justification and documentation submitted.

	Plan	Field
The HVAC System "AC-1 ENERGY LABS: Premium Eff" 4.15 BHP Supply Fan Motor has been specified.		
The HVAC System "AC-1 ENERGY LABS: Premium Eff" 1.76 BHP Return Fan Motor has been specified.		
The HVAC System "AH-2 ENERGY LABS: Premium Eff" 47.06 BHP Supply Fan Motor has been specified.		
The HVAC System "AH-2 ENERGY LABS: Premium Eff" 8.59 BHP Return Fan Motor has been specified.		
The HVAC System "AH-3 ENERGY LABS: Premium Eff" 13.86 BHP Supply Fan Motor has been specified.		
The HVAC System "AH-3 ENERGY LABS: Premium Eff" 8.22 BHP Return Fan Motor has been specified.		
A Premium Eff 18.00 BHP Chilled Water Pump Motor has been specified.		
A Premium Eff 18.00 BHP Chilled Water Pump Motor has been specified.		
The Chilled Water Pump includes a Variable Speed Drive.		
A Premium Eff 5.00 BHP Hot Water Pump Motor has been specified.		
The Cooling Tower "Evapco 290 Tons: Premium Eff" 10.00 BHP Fan Motor has been specified.		

The exceptional features listed in this performance approach application have specifically been reviewed. Adequate written justification and documentation for their use have been provided by the applicant.

Authorized Signature or Stamp _____

Run Initiation Time: 04/20/04 09:36:37 Run Code: 1082478997

EnergyPro 3.1 By EnergySoft User Number: 5891 Job Number: 2003-003 Page: 5 of 38

PERFORMANCE CERTIFICATE OF COMPLIANCE — Part 3 of 3 — PERF-1

PROJECT NAME: SCIENCE BUILDING - LOS MEDANOS COLLEGE — DATE: 4/20/2004

ZONE INFORMATION

System Name	Zone Name	Occupancy Type	Floor Area (sqft.)	Inst. LPD (W/sf) 1	Port. LPD (W/sf) 1	Ctrl. Credits (W/sf) 2	Tailored LPD (W/sf) 3	Proc. Loads (W/sf)
	VAV2-20	Corridor/Restroom/Support	100	*0.600				
	SUP2-21	Classroom	1,075	*1.600				
	SUP2-22A	Classroom	530	*1.600				
	SUP2-22B	Classroom	530	*1.600				
	SUP2-22C	Classroom	530	*1.600				
	CAV2-23	Classroom	400	*1.600				
	VAV2-24	Classroom	945	*1.600				
	VAV2-25	Classroom	955	*1.600				
	VAV2-26	Classroom	1,250	*1.600				
	SUP2-27	Classroom	1,625	*1.600				
	CAV2-28	Classroom	190	*1.600				
	VAV2-29	Classroom	1,120	*1.600				
	VAV2-30	Classroom	1,100	*1.600				
	VAV2-31	Corridor/Restroom/Support	100	*0.600				
	VAV2-32	Precision Industrial	245	*1.500				
	VAV2-33	Classroom	1,225	*1.600				
AH-3	VAV3-29	Office	300	*1.300				
	VAV3-30	Office	300	*1.300				
	VAV3-31	Office	300	*1.300				
	VAV3-28	Office	200	*1.300				

Notes: 1. See LTG-1 (Items marked with asterisk, see LTG-2 by others) 2. See LTG-3 3. See LTG-4 — Items above require special documentation

EXCEPTIONAL CONDITIONS COMPLIANCE CHECKLIST

The local enforcement agency should pay special attention to the items specified in this checklist. These items require special written justification and documentation, and special verification to be used with the performance approach. The local enforcement agency determines the adequacy of the justification, and may reject a building or design that otherwise complies based on the adequacy of the special justification and documentation submitted.

	Plan	Field
A Premium Eff 12.50 BHP Condenser Water Pump Motor has been specified.		
The Cooling Tower "250 Ton Tower/25HP" includes a Two Speed Fan.		

The exceptional features listed in this performance approach application have specifically been reviewed. Adequate written justification and documentation for their use have been provided by the applicant.

Authorized Signature or Stamp _____

Run Initiation Time: 04/20/04 09:36:37 Run Code: 1082478997

EnergyPro 3.1 By EnergySoft User Number: 5891 Job Number: 2003-003 Page: 6 of 38

PERFORMANCE CERTIFICATE OF COMPLIANCE — Part 3 of 3 — PERF-1

PROJECT NAME: SCIENCE BUILDING - LOS MEDANOS COLLEGE — DATE: 4/20/2004

ZONE INFORMATION

System Name	Zone Name	Occupancy Type	Floor Area (sqft.)	Inst. LPD (W/sf) 1	Port. LPD (W/sf) 1	Ctrl. Credits (W/sf) 2	Tailored LPD (W/sf) 3	Proc. Loads (W/sf)
	VAV3-8	Classroom	870	*1.600				
	VAV3-9	Classroom	225	*1.600				6.450
	VAV3-10	Office	100	*1.300				
	VAV3-11	Office	300	*1.300				
	VAV3-12	Office	300	*1.300				
	VAV3-13	Office	300	*1.300				
	VAV3-14	Office	310	*1.300				

Notes: 1. See LTG-1 (Items marked with asterisk, see LTG-2 by others) 2. See LTG-3 3. See LTG-4 — Items above require special documentation

EXCEPTIONAL CONDITIONS COMPLIANCE CHECKLIST

The local enforcement agency should pay special attention to the items specified in this checklist. These items require special written justification and documentation, and special verification to be used with the performance approach. The local enforcement agency determines the adequacy of the justification, and may reject a building or design that otherwise complies based on the adequacy of the special justification and documentation submitted.

	Plan	Field

The exceptional features listed in this performance approach application have specifically been reviewed. Adequate written justification and documentation for their use have been provided by the applicant.

Authorized Signature or Stamp _____

Run Initiation Time: 04/20/04 09:36:37 Run Code: 1082478997

EnergyPro 3.1 By EnergySoft User Number: 5891 Job Number: 2003-003 Page: 8 of 38

ENVELOPE COMPLIANCE SUMMARY — Performance — ENV-1

PROJECT NAME: SCIENCE BUILDING - LOS MEDANOS COLLEGE — DATE: 4/20/2004

OPAQUE SURFACES

#	Surface Type	Framing Type	Area	U-Fac.	Act. Azm.	Tilt	Solar Gains Y/N	Form 3 Reference	Location / Comments
1	Roof	None	0	0.021	0	0	X	R-30 Roof	Large Tiered Classroom
2	Wall	Metal	178	0.120	333	90	X	Stucco R-19 Metal Stud Wall	Large Tiered Classroom
3	Wall	Metal	32	0.120	63	90	X	Stucco R-19 Metal Stud Wall	Large Tiered Classroom
4	Wall	Metal	144	0.120	243	90	X	Stucco R-19 Metal Stud Wall	Large Tiered Classroom
5	Wall	Metal	255	0.120	153	90	X	Stucco R-19 Metal Stud Wall	Large Tiered Classroom
6	Wall	Metal	50	0.120	243	90	X	Stucco R-19 Metal Stud Wall	VAV2-1
7	Wall	Metal	983	0.120	63	90	X	Stucco R-19 Metal Stud Wall	VAV2-3
8	Wall	Metal	360	0.120	63	90	X	Stucco R-19 Metal Stud Wall	VAV2-4
9	Wall	Metal	339	0.120	243	90	X	Stucco R-19 Metal Stud Wall	VAV2-5
10	Wall	Metal	65	0.120	153	90	X	Stucco R-19 Metal Stud Wall	VAV2-5
11	Wall	Metal	215	0.120	63	90	X	Stucco R-19 Metal Stud Wall	VAV2-6
12	Wall	Metal	215	0.120	63	90	X	Stucco R-19 Metal Stud Wall	VAV2-7
13	Wall	Metal	360	0.120	243	90	X	Stucco R-19 Metal Stud Wall	SUP2-8
14	Wall	Metal	360	0.120	63	90	X	Stucco R-19 Metal Stud Wall	SUP2-9
15	Wall	Metal	180	0.120	63	90	X	Stucco R-19 Metal Stud Wall	VAV2-10
16	Wall	Metal	260	0.120	243	90	X	Stucco R-19 Metal Stud Wall	SUP2-11
17	Wall	Metal	73	0.120	243	90	X	Stucco R-19 Metal Stud Wall	VAV2-13
18	Wall	Metal	73	0.120	243	90	X	Stucco R-19 Metal Stud Wall	VAV2-14
19	Wall	Metal	110	0.120	243	90	X	Stucco R-19 Metal Stud Wall	VAV2-15
20	Wall	Metal	135	0.120	63	90	X	Stucco R-19 Metal Stud Wall	VAV2-16

FENESTRATION SURFACES

Site Assembled Glazing [ ] — Check box if Building is >= 100,000 sqft of CFA and >= 10,000 sqft vertical glazing then NFRC Certification is required. Follow NFRC 100-SB Procedures and submit NFRC Label Certificate Form.

#	Type	Area	U-Fac.	Act. Azm.	SHGC	Glazing Type	Location / Comments
1	Window	304	0.310	333	0.31	GLAZ	Large Tiered Classroom
2	Window	84	0.310	63	0.31	GLAZ	Large Tiered Classroom
3	Window	576	0.310	243	0.31	GLAZ	Large Tiered Classroom
4	Window	120	0.310	243	0.31	GLAZ	VAV2-1
5	Window	112	0.310	63	0.31	GLAZ	VAV2-3
6	Window	360	0.310	63	0.31	GLAZ	VAV2-4
7	Window	96	0.310	243	0.31	GLAZ	VAV2-5
8	Window	220	0.310	63	0.31	GLAZ	VAV2-6
9	Window	220	0.310	63	0.31	GLAZ	VAV2-7
10	Window	360	0.310	243	0.31	GLAZ	SUP2-8
11	Window	360	0.310	63	0.31	GLAZ	SUP2-9
12	Window	180	0.310	63	0.31	GLAZ	VAV2-10
13	Window	220	0.310	243	0.31	GLAZ	SUP2-11
14	Window	72	0.310	243	0.31	GLAZ	VAV2-13
15	Window	72	0.310	243	0.31	GLAZ	VAV2-14

EXTERIOR SHADING

#	Exterior Shade Type	SHGC	Window Hgt.	Wd.	Overhang Len.	Hgt.	LExt.	RExt.	Left Fin Dist.	Len.	Hgt.	Right Fin Dist.	Len.	Hgt.
1	None	0.76	6.0	38.0	4.0	1.0	4.0	4.0						
2	None	0.76												
3	None	0.76												
4	None	0.76	120.0	10.0	5.0	0.1	2.0	2.0						
5	None	0.76	120.0	10.0	5.0	0.1	2.0	2.0						
6	None	0.76	10.0	13.0	6.0	2.0	6.0	6.0						
7	None	0.76												
8	None	0.76												
9	None	0.76												
10	None	0.76												
11	None	0.76												
12	None	0.76												
13	None	0.76												
14	None	0.76												
15	None	0.76												

Run Initiation Time: 04/20/04 09:36:37 Run Code: 1082478997

EnergyPro 3.1 By EnergySoft User Number: 5891 Job Number: 2003-003 Page: 9 of 38

ENVELOPE COMPLIANCE SUMMARY — Performance — ENV-1

PROJECT NAME: SCIENCE BUILDING - LOS MEDANOS COLLEGE — DATE: 4/20/2004

OPAQUE SURFACES

#	Surface Type	Framing Type	Area	U-Fac.	Act. Azm.	Tilt	Solar Gains Y/N	Form 3 Reference	Location / Comments
21	Wall	Metal	115	0.120	183	90	X	Stucco R-19 Metal Stud Wall	VAV2-16
22	Roof	None	540	0.021	0	0	X	R-30 Roof	VAV2-17
23	Wall	Metal	470	0.120	243	90	X	Stucco R-19 Metal Stud Wall	VAV2-17
24	Roof	None	85	0.021	0	0	X	R-30 Roof	VAV2-18
25	Roof	None	440	0.021	0	0	X	R-30 Roof	VAV2-18
26	Roof	None	120	0.021	0	0	X	R-30 Roof	VAV2-19
27	Roof	None	930	0.021	0	0	X	R-30 Roof	VAV2-19
28	Roof	None	100	0.021	0	0	X	R-30 Roof	VAV2-20
29	Wall	Metal	110	0.120	333	90	X	Stucco R-19 Metal Stud Wall	VAV2-20
30	Wall	Metal	100	0.120	63	90	X	Stucco R-19 Metal Stud Wall	VAV2-20
31	Roof	None	1,075	0.021	0	0	X	R-30 Roof	SUP2-21
32	Wall	Metal	260	0.120	63	90	X	Stucco R-19 Metal Stud Wall	SUP2-21
33	Roof	None	530	0.021	0	0	X	R-30 Roof	SUP2-22A
34	Wall	Metal	120	0.120	63	90	X	Stucco R-19 Metal Stud Wall	SUP2-22A
35	Roof	None	530	0.021	0	0	X	R-30 Roof	SUP2-22B
36	Wall	Metal	120	0.120	63	90	X	Stucco R-19 Metal Stud Wall	SUP2-22B
37	Roof	None	530	0.021	0	0	X	R-30 Roof	SUP2-22C
38	Wall	Metal	120	0.120	63	90	X	Stucco R-19 Metal Stud Wall	SUP2-22C
39	Roof	None	400	0.021	0	0	X	R-30 Roof	CAV2-23
40	Wall	Metal	150	0.120	63	90	X	Stucco R-19 Metal Stud Wall	CAV2-23

FENESTRATION SURFACES

Site Assembled Glazing [ ] — Check box if Building is >= 100,000 sqft of CFA and >= 10,000 sqft vertical glazing then NFRC Certification is required. Follow NFRC 100-SB Procedures and submit NFRC Label Certificate Form.

#	Type	Area	U-Fac.	Act. Azm.	SHGC	Glazing Type	Location / Comments
16	Window	110	0.310	243	0.31	GLAZ	VAV2-15
17	Window	30	0.310	63	0.31	GLAZ	VAV2-16
18	Window	30	0.310	183	0.31	GLAZ	VAV2-16
19	Window	30	0.310	243	0.31	GLAZ	VAV2-17
20	Window	30	0.310	63	0.31	GLAZ	VAV2-20
21	Window	250	0.310	63	0.31	GLAZ	SUP2-21
22	Window	120	0.310	63	0.31	GLAZ	SUP2-22A
23	Window	120	0.310	63	0.31	GLAZ	SUP2-22B
24	Window	120	0.310	63	0.31	GLAZ	SUP2-22C
25	Window	140	0.310	63	0.31	GLAZ	CAV2-23
26	Window	220	0.310	63	0.31	GLAZ	VAV2-24
27	Window	220	0.310	63	0.31	GLAZ	VAV2-25
28	Window	290	0.310	63	0.31	GLAZ	VAV2-26
29	Window	360	0.310	243	0.31	GLAZ	SUP2-27
30	Window	75	0.310	243	0.31	GLAZ	CAV2-28

EXTERIOR SHADING

#	Exterior Shade Type	SHGC	Window Hgt.	Wd.	Overhang Len.	Hgt.	LExt.	RExt.	Left Fin Dist.	Len.	Hgt.	Right Fin Dist.	Len.	Hgt.
16	None	0.76												
17	None	0.76	10.0	14.0	6.0	2.0	6.0	6.0						
18	None	0.76	7.0	4.0	7.0	0.1	7.0	7.0						
19	None	0.76												
20	None	0.76												
21	None	0.76	10.0	8.5	6.0	2.0	6.0	6.0						
22	None	0.76	10.0	13.0	6.0	2.0	6.0	6.0						
23	None	0.76	10.0	13.0	6.0	2.0	6.0	6.0						
24	None	0.76	10.0	13.0	6.0	2.0	6.0	6.0						
25	None	0.76	10.0	13.0	6.0	2.0	6.0	6.0						
26	None	0.76	10.0	13.0	6.0	2.0	6.0	6.0						
27	None	0.76	10.0	13.0	6.0	2.0	6.0	6.0						
28	None	0.76	10.0	13.0	6.0	2.0	6.0	6.0						
29	None	0.76	10.0	13.0	6.0	2.0	6.0	6.0						
30	None	0.76	10.0	13.0	6.0	2.0	6.0	6.0						

Run Initiation Time: 04/20/04 09:36:37 Run Code: 1082478997

EnergyPro 3.1 By EnergySoft User Number: 5891 Job Number: 2003-003 Page: 10 of 38

tBP architecture planning interiors management

tBP/Architecture
1000 Burnett Avenue, Suite 140
Concord, CA 94520
p: 925.246.6419 f: 925.246.6495

architect

AINSWORTH ASSOCIATES
MECHANICAL ENGINEERS
SACRAMENTO, CA
925-2029-009

consultant

name
address
city, state, zip
ph:
fx:

agency

SCIENCE BUILDING
LOS MEDANOS COLLEGE
Contra Costa Community College District

owner

tBP project number : 20241.00

file name:

drawn by: checked by:

date: NOVEMBER 15, 2004

Rev.	date:	description:

drawing title:
TITLE 24-MECHANICAL & ENVELOPE TITLE 24 DOCUMENTS

LMC SCIENCE 313-023-T12.01-0-00.00
drawing no:
M0.3
drawing of ?

\2003-023\DWG\ENG\M-0-J-Reg Then Nov\11-2004-09:43pm

ENVELOPE COMPLIANCE SUMMARY — Performance ENV-1

PROJECT NAME: SCIENCE BUILDING - LOS MEDANOS COLLEGE — DATE: 4/20/2004

OPAQUE SURFACES

#	Surface Type	Framing Type	Area	U-Fac.	Act. Azm.	Tilt	Solar Gains Y/N	Form 3 Reference	Location / Comments
41	Roof	None	945	0.021	0	0	X	R-30 Roof	VAV2-24
42	Wall	Metal	215	0.120	63	90	X	Stucco R-19 Metal Stud Wall	VAV2-24
43	Roof	None	955	0.021	0	0	X	R-30 Roof	VAV2-25
44	Wall	Metal	215	0.120	63	90	X	Stucco R-19 Metal Stud Wall	VAV2-25
45	Roof	None	1,250	0.021	0	0	X	R-30 Roof	VAV2-26
46	Wall	Metal	280	0.120	63	90	X	Stucco R-19 Metal Stud Wall	VAV2-26
47	Roof	None	1,625	0.021	0	0	X	R-30 Roof	SUP2-27
48	Wall	Metal	570	0.120	243	90	X	Stucco R-19 Metal Stud Wall	SUP2-27
49	Wall	Metal	385	0.120	243	90	X	Stucco R-19 Metal Stud Wall	SUP2-27
50	Roof	None	180	0.021	0	0	X	R-30 Roof	CAV2-28
51	Wall	Metal	505	0.120	243	90	X	Stucco R-19 Metal Stud Wall	CAV2-28
52	Roof	None	1,120	0.021	0	0	X	R-30 Roof	VAV2-29
53	Wall	Metal	260	0.120	243	90	X	Stucco R-19 Metal Stud Wall	VAV2-29
54	Roof	None	1,100	0.021	0	0	X	R-30 Roof	VAV2-30
55	Wall	Metal	230	0.120	243	90	X	Stucco R-19 Metal Stud Wall	VAV2-30
56	Roof	None	100	0.021	0	0	X	R-30 Roof	VAV2-31
57	Wall	Metal	95	0.120	243	90	X	Stucco R-19 Metal Stud Wall	VAV2-31
58	Roof	None	245	0.021	0	0	X	R-30 Roof	VAV2-32
59	Wall	Metal	120	0.120	243	90	X	Stucco R-19 Metal Stud Wall	VAV2-33
60	Roof	None	245	0.021	0	0	X	R-30 Roof	VAV2-33

FENESTRATION SURFACES

Site Assembled Glazing ☐ Check box if Building is >= 100,000 sqft of CFA and >= 10,000 sqft vertical glazing then NFRC Certification is required. Follow NFRC 100-SB Procedures and submit NFRC Label Certificate Form.

#	Type	Area	U-Fac.	Act. Azm.	SHGC	Glazing Type	Location / Comments
31	Window	250	0.310	243	0.31	GLAZ	VAV2-29
32	Window	235	0.310	243	0.31	GLAZ	VAV2-30
33	Window	90	0.310	243	0.31	GLAZ	VAV2-31
34	Window	145	0.310	243	0.31	GLAZ	VAV2-33
35	Window	30	0.310	153	0.31	GLAZ	VAV3-29
36	Window	30	0.310	153	0.31	GLAZ	VAV3-29
37	Window	30	0.310	153	0.31	GLAZ	VAV3-29
38	Window	30	0.310	153	0.31	GLAZ	VAV3-29
39	Window	30	0.310	153	0.31	GLAZ	VAV3-29
40	Window	30	0.210	153	0.31	GLAZ	VAV3-29
41	Window	30	0.210	153	0.31	GLAZ	VAV3-30
42	Window	30	0.310	153	0.31	GLAZ	VAV3-30
43	Window	30	0.310	153	0.31	GLAZ	VAV3-30
44	Window	30	0.310	153	0.31	GLAZ	VAV3-30
45	Window	30	0.310	153	0.31	GLAZ	VAV3-30

EXTERIOR SHADING

#	Exterior Shade Type	SHGC	Window Hgt.	Window Wd.	Overhang Len.	Overhang Hgt.	Overhang LExt.	Overhang RExt.	Left Fin Dist.	Left Fin Len.	Left Fin Hgt.	Right Fin Dist.	Right Fin Len.	Right Fin Hgt.
31	None	0.76	10.0	13.0	6.0	2.0	6.0	6.0						
32	None	0.76	10.0	13.0	6.0	2.0	6.0	6.0						
33	None	0.76	10.0	13.0	6.0	2.0	6.0	6.0						
34	None	0.76	10.0	13.0	6.0	2.0	6.0	6.0						
35	None	0.76												
36	None	0.76												
37	None	0.76												
38	None	0.76												
39	None	0.76												
40	None	0.76												
41	None	0.76												
42	None	0.76												
43	None	0.76												
44	None	0.76												
45	None	0.76												

Run Initiation Time: 04/20/04 09:36:37 Run Code: 1082478997

EnergyPro 3.1 By EnergySoft User Number: 5891 Job Number: 2003-003 Page: 11 of 38

ENVELOPE COMPLIANCE SUMMARY — Performance ENV-1

PROJECT NAME: SCIENCE BUILDING - LOS MEDANOS COLLEGE — DATE: 4/20/2004

OPAQUE SURFACES

#	Surface Type	Framing Type	Area	U-Fac.	Act. Azm.	Tilt	Solar Gains Y/N	Form 3 Reference	Location / Comments
61	Wall	Metal	110	0.120	153	90	X	Stucco R-19 Metal Stud Wall	VAV3-29
62	Wall	Metal	110	0.120	153	90	X	Stucco R-19 Metal Stud Wall	VAV3-29
63	Wall	Metal	110	0.120	153	90	X	Stucco R-19 Metal Stud Wall	VAV3-29
64	Wall	Metal	110	0.120	153	90	X	Stucco R-19 Metal Stud Wall	VAV3-30
65	Wall	Metal	110	0.120	153	90	X	Stucco R-19 Metal Stud Wall	VAV3-30
66	Wall	Metal	110	0.120	153	90	X	Stucco R-19 Metal Stud Wall	VAV3-30
67	Wall	Metal	170	0.120	63	90	X	Stucco R-19 Metal Stud Wall	VAV3-31
68	Wall	Metal	330	0.120	153	90	X	Stucco R-19 Metal Stud Wall	VAV3-31
69	Wall	Metal	110	0.120	153	90	X	Stucco R-19 Metal Stud Wall	VAV3-28
70	Wall	Metal	110	0.120	153	90	X	Stucco R-19 Metal Stud Wall	VAV3-28
71	Wall	Metal	195	0.120	243	90	X	Stucco R-19 Metal Stud Wall	VAV3-27
72	Wall	Metal	140	0.120	153	90	X	Stucco R-19 Metal Stud Wall	VAV3-27
73	Wall	Metal	148	0.120	153	90	X	Stucco R-19 Metal Stud Wall	VAV3-26
74	Roof	None	260	0.021	0	0	X	R-30 Roof	VAV3-26
75	Roof	None	260	0.021	0	0	X	R-30 Roof	VAV3-25
76	Roof	None	550	0.021	0	0	X	R-30 Roof	VAV3-24
77	Roof	None	215	0.021	0	0	X	R-30 Roof	VAV3-23
78	Roof	None	220	0.021	0	0	X	R-30 Roof	VAV3-23
79	Roof	None	770	0.021	0	0	X	R-30 Roof	VAV3-23
80	Roof	None	245	0.021	0	0	X	R-30 Roof	VAV3-22

FENESTRATION SURFACES

Site Assembled Glazing ☐ Check box if Building is >= 100,000 sqft of CFA and >= 10,000 sqft vertical glazing then NFRC Certification is required. Follow NFRC 100-SB Procedures and submit NFRC Label Certificate Form.

#	Type	Area	U-Fac.	Act. Azm.	SHGC	Glazing Type	Location / Comments
46	Window	30	0.310	153	0.31	GLAZ	MAV3-30
47	Window	30	0.310	63	0.31	GLAZ	MAV3-31
48	Window	30	0.310	153	0.31	GLAZ	MAV3-31
49	Window	30	0.310	153	0.31	GLAZ	MAV3-31
50	Window	30	0.310	153	0.31	GLAZ	MAV3-31
51	Window	30	0.310	153	0.31	GLAZ	MAV3-31
52	Window	30	0.310	153	0.31	GLAZ	MAV3-31
53	Window	30	0.310	153	0.31	GLAZ	MAV3-28
54	Window	30	0.310	153	0.31	GLAZ	MAV3-28
55	Window	30	0.310	153	0.31	GLAZ	MAV3-28
56	Window	30	0.310	153	0.31	GLAZ	MAV3-28
57	Window	30	0.310	153	0.31	GLAZ	MAV3-27
58	Window	32	0.310	153	0.31	GLAZ	MAV3-26
59	Window	32	0.310	333	0.31	GLAZ	MAV3-22
60	Window	32	0.310	333	0.31	GLAZ	MAV3-22

EXTERIOR SHADING

#	Exterior Shade Type	SHGC	Window Hgt.	Window Wd.	Overhang Len.	Overhang Hgt.	Overhang LExt.	Overhang RExt.	Left Fin Dist.	Left Fin Len.	Left Fin Hgt.	Right Fin Dist.	Right Fin Len.	Right Fin Hgt.
46	None	0.76												
47	None	0.76												
48	None	0.76												
49	None	0.76												
50	None	0.76												
51	None	0.76												
52	None	0.76												
53	None	0.76												
54	None	0.76												
55	None	0.76												
56	None	0.76												
57	None	0.76												
58	None	0.76												
59	None	0.76												
60	None	0.76												

Run Initiation Time: 04/20/04 09:36:37 Run Code: 1082478997

EnergyPro 3.1 By EnergySoft User Number: 5891 Job Number: 2003-003 Page: 12 of 38

ENVELOPE COMPLIANCE SUMMARY — Performance ENV-1

PROJECT NAME: SCIENCE BUILDING - LOS MEDANOS COLLEGE — DATE: 4/20/2004

OPAQUE SURFACES

#	Surface Type	Framing Type	Area	U-Fac.	Act. Azm.	Tilt	Solar Gains Y/N	Form 3 Reference	Location / Comments
81	Wall	Metal	161	0.120	333	90	X	Stucco R-19 Metal Stud Wall	VAV3-20
82	Roof	None	220	0.021	0	0	X	R-30 Roof	VAV3-21
83	Wall	Metal	161	0.120	333	90	X	Stucco R-19 Metal Stud Wall	VAV3-21
84	Roof	None	125	0.021	0	0	X	R-30 Roof	VAV3-20
85	Roof	None	150	0.021	0	0	X	R-30 Roof	VAV3-19
86	Wall	Metal	128	0.120	317	90	X	Stucco R-19 Metal Stud Wall	VAV3-19
87	Roof	None	110	0.021	0	0	X	R-30 Roof	VAV3-18
88	Wall	Metal	160	0.120	333	90	X	Stucco R-19 Metal Stud Wall	VAV3-18
89	Roof	None	510	0.021	0	0	X	R-30 Roof	VAV3-17
90	Wall	Metal	80	0.120	333	90	X	Stucco R-19 Metal Stud Wall	VAV3-17
91	Wall	Metal	178	0.120	153	90	X	Stucco R-19 Metal Stud Wall	VAV3-17
92	Roof	None	1,265	0.021	0	0	X	R-30 Roof	VAV3-16
93	Wall	Metal	392	0.120	317	90	X	Stucco R-19 Metal Stud Wall	VAV3-16
94	Wall	Metal	288	0.120	243	90	X	Stucco R-19 Metal Stud Wall	VAV3-16
95	Wall	Metal	547	0.120	153	90	X	Stucco R-19 Metal Stud Wall	VAV3-16
96	Roof	None	1,210	0.021	0	0	X	R-30 Roof	VAV3-15
97	Wall	Metal	160	0.120	333	90	X	Stucco R-19 Metal Stud Wall	VAV3-15
98	Wall	Metal	160	0.120	153	90	X	Stucco R-19 Metal Stud Wall	VAV3-15
99	Wall	Metal	0	0.120	333	90	X	Stucco R-19 Metal Stud Wall	VAV3-1
100	Wall	Metal	0	0.120	153	90	X	Stucco R-19 Metal Stud Wall	VAV3-1

FENESTRATION SURFACES

Site Assembled Glazing ☐ Check box if Building is >= 100,000 sqft of CFA and >= 10,000 sqft vertical glazing then NFRC Certification is required. Follow NFRC 100-SB Procedures and submit NFRC Label Certificate Form.

#	Type	Area	U-Fac.	Act. Azm.	SHGC	Glazing Type	Location / Comments
61	Window	32	0.310	333	0.31	GLAZ	MAV3-21
62	Window	32	0.310	333	0.31	GLAZ	MAV3-21
63	Window	32	0.310	317	0.31	GLAZ	MAV3-19
64	Window	32	0.310	153	0.31	GLAZ	MAV3-17
65	Window	32	0.310	317	0.31	GLAZ	MAV3-16
66	Window	32	0.310	317	0.31	GLAZ	MAV3-16
67	Window	32	0.310	317	0.31	GLAZ	MAV3-16
68	Window	32	0.310	317	0.31	GLAZ	MAV3-16
69	Window	160	0.310	243	0.31	GLAZ	MAV3-16
70	Window	32	0.310	243	0.31	GLAZ	MAV3-16
71	Window	32	0.310	153	0.31	GLAZ	MAV3-16
72	Window	32	0.310	153	0.31	GLAZ	MAV3-16
73	Window	32	0.310	153	0.31	GLAZ	MAV3-16
74	Window	32	0.310	153	0.31	GLAZ	MAV3-16
75	Window	320	0.310	333	0.31	GLAZ	MAV3-15

EXTERIOR SHADING

#	Exterior Shade Type	SHGC	Window Hgt.	Window Wd.	Overhang Len.	Overhang Hgt.	Overhang LExt.	Overhang RExt.	Left Fin Dist.	Left Fin Len.	Left Fin Hgt.	Right Fin Dist.	Right Fin Len.	Right Fin Hgt.
61	None	0.76												
62	None	0.76												
63	None	0.76												
64	None	0.76												
65	None	0.76												
66	None	0.76												
67	None	0.76												
68	None	0.76												
69	None	0.76												
70	None	0.76												
71	None	0.76												
72	None	0.76												
73	None	0.76												
74	None	0.76												
75	None	0.76												

Run Initiation Time: 04/20/04 09:36:37 Run Code: 1082478997

EnergyPro 3.1 By EnergySoft User Number: 5891 Job Number: 2003-003 Page: 13 of 38

ENVELOPE COMPLIANCE SUMMARY — Performance ENV-1

PROJECT NAME: SCIENCE BUILDING - LOS MEDANOS COLLEGE — DATE: 4/20/2004

OPAQUE SURFACES

#	Surface Type	Framing Type	Area	U-Fac.	Act. Azm.	Tilt	Solar Gains Y/N	Form 3 Reference	Location / Comments
101	Wall	Metal	124	0.120	243	90	X	Stucco R-19 Metal Stud Wall	VAV3-2
102	Wall	Metal	531	0.120	317	90	X	Stucco R-19 Metal Stud Wall	VAV3-2
103	Wall	Metal	87	0.120	333	90	X	Stucco R-19 Metal Stud Wall	VAV3-2
104	Wall	Metal	175	0.120	243	90	X	Stucco R-19 Metal Stud Wall	VAV3-3
105	Wall	Metal	372	0.120	153	90	X	Stucco R-19 Metal Stud Wall	VAV3-3
106	Roof	None	125	0.021	0	0	X	R-30 Roof	VAV3-4
107	Wall	Metal	220	0.120	243	90	X	Stucco R-19 Metal Stud Wall	VAV3-4
108	Wall	Metal	124	0.120	153	90	X	Stucco R-19 Metal Stud Wall	VAV3-4
109	Roof	None	315	0.021	0	0	X	R-30 Roof	VAV3-5
110	Wall	Metal	220	0.120	63	90	X	Stucco R-19 Metal Stud Wall	VAV3-5
111	Wall	Metal	241	0.120	153	90	X	Stucco R-19 Metal Stud Wall	VAV3-5
112	Wall	Metal	498	0.120	333	90	X	Stucco R-19 Metal Stud Wall	VAV3-6
113	Wall	Metal	145	0.120	270	90	X	Stucco R-19 Metal Stud Wall	VAV3-6
114	Wall	Metal	195	0.120	243	90	X	Stucco R-19 Metal Stud Wall	VAV3-10
115	Wall	Metal	140	0.120	153	90	X	Stucco R-19 Metal Stud Wall	VAV3-10
116	Wall	Metal	110	0.120	153	90	X	Stucco R-19 Metal Stud Wall	VAV3-11
117	Wall	Metal	110	0.120	153	90	X	Stucco R-19 Metal Stud Wall	VAV3-11
118	Wall	Metal	110	0.120	153	90	X	Stucco R-19 Metal Stud Wall	VAV3-11
119	Wall	Metal	110	0.120	153	90	X	Stucco R-19 Metal Stud Wall	VAV3-12
120	Wall	Metal	110	0.120	153	90	X	Stucco R-19 Metal Stud Wall	VAV3-12

FENESTRATION SURFACES

Site Assembled Glazing ☐ Check box if Building is >= 100,000 sqft of CFA and >= 10,000 sqft vertical glazing then NFRC Certification is required. Follow NFRC 100-SB Procedures and submit NFRC Label Certificate Form.

#	Type	Area	U-Fac.	Act. Azm.	SHGC	Glazing Type	Location / Comments
76	Window	320	0.310	153	0.31	GLAZ	MAV3-15
77	Window	200	0.310	333	0.31	GLAZ	MAV3-1
78	Window	120	0.310	333	0.31	GLAZ	MAV3-1
79	Window	200	0.310	153	0.31	GLAZ	MAV3-1
80	Window	120	0.310	153	0.31	GLAZ	MAV3-1
81	Window	36	0.310	243	0.31	GLAZ	MAV3-2
82	Window	36	0.310	317	0.31	GLAZ	MAV3-2
83	Window	36	0.310	317	0.31	GLAZ	MAV3-2
84	Window	36	0.310	317	0.31	GLAZ	MAV3-2
85	Window	36	0.310	317	0.31	GLAZ	MAV3-2
86	Window	36	0.310	333	0.31	GLAZ	MAV3-2
87	Window	36	0.310	333	0.31	GLAZ	MAV3-2
88	Window	36	0.310	333	0.31	GLAZ	MAV3-2
89	Window	36	0.310	243	0.31	GLAZ	MAV3-3
90	Window	36	0.310	243	0.31	GLAZ	MAV3-3

EXTERIOR SHADING

#	Exterior Shade Type	SHGC	Window Hgt.	Window Wd.	Overhang Len.	Overhang Hgt.	Overhang LExt.	Overhang RExt.	Left Fin Dist.	Left Fin Len.	Left Fin Hgt.	Right Fin Dist.	Right Fin Len.	Right Fin Hgt.
76	None	0.76												
77	None	0.76			10.0	20.0		8.0	0.2	8.0	8.0			
78	None	0.76												
79	None	0.76			10.0	20.0		8.0	0.2	8.0	8.0			
80	None	0.76												
81	None	0.76												
82	None	0.76												
83	None	0.76												
84	None	0.76												
85	None	0.76												
86	None	0.76												
87	None	0.76												
88	None	0.76												
89	None	0.76												
90	None	0.76												

Run Initiation Time: 04/20/04 09:36:37 Run Code: 1082478997

EnergyPro 3.1 By EnergySoft User Number: 5891 Job Number: 2003-003 Page: 14 of 38

ENVELOPE COMPLIANCE SUMMARY — Performance ENV-1

PROJECT NAME: SCIENCE BUILDING - LOS MEDANOS COLLEGE — DATE: 4/20/2004

OPAQUE SURFACES

#	Surface Type	Framing Type	Area	U-Fac.	Act. Azm.	Tilt	Solar Gains Y/N	Form 3 Reference	Location / Comments
121	Wall	Metal	110	0.120	153	90	X	Stucco R-19 Metal Stud Wall	VAV3-12
122	Wall	Metal	110	0.120	153	90	X	Stucco R-19 Metal Stud Wall	VAV3-13
123	Wall	Metal	110	0.120	153	90	X	Stucco R-19 Metal Stud Wall	VAV3-13
124	Wall	Metal	110	0.120	153	90	X	Stucco R-19 Metal Stud Wall	VAV3-13
125	Wall	Metal	280	0.120	63	90	X	Stucco R-19 Metal Stud Wall	VAV3-14
126	Wall	Metal	270	0.120	153	90	X	Stucco R-19 Metal Stud Wall	VAV3-14

FENESTRATION SURFACES

Site Assembled Glazing ☐ Check box if Building is >= 100,000 sqft of CFA and >= 10,000 sqft vertical glazing then NFRC Certification is required. Follow NFRC 100-SB Procedures and submit NFRC Label Certificate Form.

#	Type	Area	U-Fac.	Act. Azm.	SHGC	Glazing Type	Location / Comments
91	Window	36	0.310	243	0.31	GLAZ	MAV3-3
92	Window	36	0.310	243	0.31	GLAZ	MAV3-3
93	Window	36	0.310	153	0.31	GLAZ	MAV3-3
94	Window	36	0.310	153	0.31	GLAZ	MAV3-3
95	Window	36	0.310	153	0.31	GLAZ	MAV3-3
96	Window	36	0.310	153	0.31	GLAZ	MAV3-4
97	Window	36	0.310	153	0.31	GLAZ	MAV3-5
98	Window	36	0.310	153	0.31	GLAZ	MAV3-5
99	Window	36	0.310	153	0.31	GLAZ	MAV3-5
100	Window	36	0.310	153	0.31	GLAZ	MAV3-5
101	Window	112	0.310	333	0.31	GLAZ	MAV3-6
102	Window	30	0.310	153	0.31	GLAZ	MAV3-10
103	Window	30	0.310	153	0.31	GLAZ	MAV3-11
104	Window	30	0.310	153	0.31	GLAZ	MAV3-11
105	Window	30	0.310	153	0.31	GLAZ	MAV3-11

EXTERIOR SHADING

#	Exterior Shade Type	SHGC	Window Hgt.	Window Wd.	Overhang Len.	Overhang Hgt.	Overhang LExt.	Overhang RExt.	Left Fin Dist.	Left Fin Len.	Left Fin Hgt.	Right Fin Dist.	Right Fin Len.	Right Fin Hgt.
91	None	0.76												
92	None	0.76												
93	None	0.76												
94	None	0.76												
95	None	0.76												
96	None	0.76												
97	None	0.76												
98	None	0.76												
99	None	0.76												
100	None	0.76												
101	None	0.76												
102	None	0.76												
103	None	0.76												
104	None	0.76												
105	None	0.76												

Run Initiation Time: 04/20/04 09:36:37 Run Code: 1082478997

EnergyPro 3.1 By EnergySoft User Number: 5891 Job Number: 2003-003 Page: 15 of 38

ENVELOPE COMPLIANCE SUMMARY — Performance ENV-1

PROJECT NAME: SCIENCE BUILDING - LOS MEDANOS COLLEGE — DATE: 4/20/2004

OPAQUE SURFACES

#	Surface Type	Framing Type	Area	U-Fac.	Act. Azm.	Tilt	Solar Gains Y/N	Form 3 Reference	Location / Comments

FENESTRATION SURFACES

Site Assembled Glazing ☐ Check box if Building is >= 100,000 sqft of CFA and >= 10,000 sqft vertical glazing then NFRC Certification is required. Follow NFRC 100-SB Procedures and submit NFRC Label Certificate Form.

#	Type	Area	U-Fac.	Act. Azm.	SHGC	Glazing Type	Location / Comments
106	Window	30	0.310	153	0.31	GLAZ	MAV3-11
107	Window	30	0.310	153	0.31	GLAZ	MAV3-11
108	Window	30	0.310	153	0.31	GLAZ	MAV3-11
109	Window	30	0.310	153	0.31	GLAZ	MAV3-12
110	Window	30	0.310	153	0.31	GLAZ	MAV3-12
111	Window	30	0.310	153	0.31	GLAZ	MAV3-12
112	Window	30	0.310	153	0.31	GLAZ	MAV3-12
113	Window	30	0.310	153	0.31	GLAZ	MAV3-12
114	Window	30	0.310	153	0.31	GLAZ	MAV3-12
115	Window	30	0.310	153	0.31	GLAZ	MAV3-13
116	Window	30	0.310	153	0.31	GLAZ	MAV3-13
117	Window	30	0.310	153	0.31	GLAZ	MAV3-13
118	Window	30	0.310	153	0.31	GLAZ	MAV3-13
119	Window	30	0.310	153	0.31	GLAZ	MAV3-13
120	Window	30	0.310	153	0.31	GLAZ	MAV3-13

EXTERIOR SHADING

#	Exterior Shade Type	SHGC	Window Hgt.	Window Wd.	Overhang Len.	Overhang Hgt.	Overhang LExt.	Overhang RExt.	Left Fin Dist.	Left Fin Len.	Left Fin Hgt.	Right Fin Dist.	Right Fin Len.	Right Fin Hgt.
106	None	0.76												
107	None	0.76												
108	None	0.76												
109	None	0.76												
110	None	0.76												
111	None	0.76												
112	None	0.76												
113	None	0.76												
114	None	0.76												
115	None	0.76												
116	None	0.76												
117	None	0.76												
118	None	0.76												
119	None	0.76												
120	None	0.76												

Run Initiation Time: 04/20/04 09:36:37 Run Code: 1082478997

EnergyPro 3.1 By EnergySoft User Number: 5891 Job Number: 2003-003 Page: 16 of 38

ENVELOPE COMPLIANCE SUMMARY — Performance ENV-1

PROJECT NAME: SCIENCE BUILDING - LOS MEDANOS COLLEGE — DATE: 4/20/2004

OPAQUE SURFACES

#	Surface Type	Framing Type	Area	U-Fac.	Act. Azm.	Tilt	Solar Gains Y/N	Form 3 Reference	Location / Comments

FENESTRATION SURFACES

Site Assembled Glazing ☐ Check box if Building is >= 100,000 sqft of CFA and >= 10,000 sqft vertical glazing then NFRC Certification is required. Follow NFRC 100-SB Procedures and submit NFRC Label Certificate Form.

#	Type	Area	U-Fac.	Act. Azm.	SHGC	Glazing Type	Location / Comments
121	Window	30	0.310	153	0.31	GLAZ	VAV3-14
122	Window	30	0.310	153	0.31	GLAZ	VAV3-14
123	Window	30	0.310	153	0.31	GLAZ	VAV3-14

EXTERIOR SHADING

#	Exterior Shade Type	SHGC	Window Hgt.	Window Wd.	Overhang Len.	Overhang Hgt.	Overhang LExt.	Overhang RExt.	Left Fin Dist.	Left Fin Len.	Left Fin Hgt.	Right Fin Dist.	Right Fin Len.	Right Fin Hgt.
121	None	0.76												
122	None	0.76												
123	None	0.76												

Run Initiation Time: 04/20/04 09:36:37 Run Code: 1082478997

EnergyPro 3.1 By EnergySoft User Number: 5891 Job Number: 2003-003 Page: 17 of 38

CERTIFICATE OF COMPLIANCE — Performance MECH-1

PROJECT NAME: SCIENCE BUILDING - LOS MEDANOS COLLEGE — DATE: 4/20/2004

SYSTEM FEATURES

SYSTEM NAME	MECHANICAL SYSTEMS: Chiller	Cooling Tower	Cooling Tower	NOTE TO FIELD
TIME CONTROL	n/a	n/a	n/a	
SETBACK CONTROL	n/a	n/a	n/a	
ISOLATION ZONES	n/a	n/a	n/a	
HEAT PUMP THERMOSTAT?

CERTIFICATE OF COMPLIANCE — Performance — MECH-1

PROJECT NAME: SCIENCE BUILDING - LOS MEDANOS COLLEGE | DATE: 4/20/2004

SYSTEM FEATURES

SYSTEM NAME	MECHANICAL SYSTEMS: Hot Water Boiler	DHW Heater	AC-1	NOTE TO FIELD
TIME CONTROL	n/a	n/a	Programmable Switch	
SETBACK CONTROL	n/a	n/a	Heating Required	
ISOLATION ZONES	n/a	n/a	n/a	
HEAT PUMP THERMOSTAT?	n/a	n/a	n/a	
ELECTRIC HEAT?	n/a	n/a	n/a	
FAN CONTROL	n/a	n/a	FC w/Vanes	
VAV MINIMUM POSITION CONTROL?	n/a	n/a	Yes	
SIMULTANEOUS HEAT/COOL?	n/a	n/a	Yes	
HEATING SUPPLY RESET	n/a	n/a	Constant Temp	
COOLING SUPPLY RESET	n/a	n/a	OA Reset	
HEAT REJECTION CONTROL	n/a	n/a	n/a	
VENTILATION	n/a	n/a	Air Balance	
OUTDOOR DAMPER CONTROL	n/a	n/a	Auto	
ECONOMIZER TYPE	n/a	n/a	Fixed Temp (Integrated)	
DESIGN O.A. CFM (MECH-3, COLUMN I)	n/a	n/a	1785 cfm	
HEATING EQUIPMENT TYPE	Gas Fired	Gas Fired	None	
HEATING EQUIPMENT EFFICIENCY	85%	79%	n/a	
COOLING EQUIPMENT TYPE	n/a	n/a	Packaged VAV	
COOLING EQUIPMENT EFFICIENCY	n/a	n/a	9.5 EER	
MAKE AND MODEL NUMBER	PKN 1000	NORITZ N-132	AC-1 ENERGY LABS	
PIPE INSULATION REQUIRED?	Yes	Yes	Yes	
PIPE/DUCT INSULATION PROTECTED?	Yes	Yes	Yes	
HEATING DUCT LOCATION R-VALUE	n/a / n/a	n/a / n/a	Ducts in Attic / 4.2	
COOLING DUCT LOCATION R-VALUE	n/a / n/a	n/a / n/a	Ducts in Attic / 4.2	
VERIFIED SEALED DUCTS IN CEILING/ROOF SPACE	n/a	n/a	No	

CODE TABLES: Enter code from table below into columns above.

		TIME CONTROL	SETBACK CTRL.	ISOLATION ZONES	FAN CONTROL
HEAT PUMP THERMOSTAT?		S: Prog. Switch	H: Heating	Enter Number of	I: Inlet Vanes
ELECTRIC HEAT?		O: Occupancy Sensor	C: Cooling	Isolation Zones.	P: Variable Pitch
VAV MINIMUM POSITION CONTROL?	Y: Yes	M: Manual Timer	B: Both		V: VFD
SIMULTANEOUS HEAT / COOL?	N: No				O: Other C: Curve
HEAT AND COOL SUPPLY RESET?		VENTILATION	OUTDOOR DAMPER	ECONOMIZER	O.A. CFM
HIGH EFFICIENCY?		B: Air Balance	A: Auto	A: Air	Enter Outdoor Air
PIPE INSULATION REQUIRED?		C: Outside Air Cert.	G: Gravity	W: Water	CFM.
PIPE/DUCT INSULATION PROTECTED?		M: Out. Air Measure		N: Not Required	Note: This shall be no
SEALED DUCTS IN CEILING/ROOF SPACE?		D: Demand Control		EC: Economizer	less than Col. H on
		N: Natural		Control See Section	MECH-3.
				144(e)3	

NOTES TO FIELD - For Building Department Use Only

Run Initiation Time: 04/20/04 09:36:37 Run Code: 1082478997

CERTIFICATE OF COMPLIANCE — Performance — MECH-1

PROJECT NAME: SCIENCE BUILDING - LOS MEDANOS COLLEGE | DATE: 4/20/2004

SYSTEM FEATURES

SYSTEM NAME	MECHANICAL SYSTEMS: AH-2	AH-3		NOTE TO FIELD
TIME CONTROL	Programmable Switch	Programmable Switch		
SETBACK CONTROL	Heating Required	Heating Required		
ISOLATION ZONES		n/a		
HEAT PUMP THERMOSTAT?	n/a	n/a		
ELECTRIC HEAT?	n/a	n/a		
FAN CONTROL	FC w/Vanes	FC w/Vanes		
VAV MINIMUM POSITION CONTROL?	Yes	Yes		
SIMULTANEOUS HEAT/COOL?	Yes	Yes		
HEATING SUPPLY RESET	Constant Temp	Constant Temp		
COOLING SUPPLY RESET	OA Reset	OA Reset		
HEAT REJECTION CONTROL	n/a	n/a		
VENTILATION	Air Balance	Air Balance		
OUTDOOR DAMPER CONTROL	Auto	Auto		
ECONOMIZER TYPE	Fixed Temp (Integrated)	Fixed Temp (Integrated)		
DESIGN O.A. CFM (MECH-3, COLUMN I)	35406 cfm	6231 cfm		
HEATING EQUIPMENT TYPE	None	None		
HEATING EQUIPMENT EFFICIENCY	n/a	n/a		
COOLING EQUIPMENT TYPE	Built-Up VAV	Built-Up VAV		
COOLING EQUIPMENT EFFICIENCY	n/a	n/a		
MAKE AND MODEL NUMBER	AH-2 ENERGY LABS	AH-3 ENERGY LABS		
PIPE INSULATION REQUIRED?	Yes	Yes		
PIPE/DUCT INSULATION PROTECTED?	Yes	Yes		
HEATING DUCT LOCATION R-VALUE	Ducts in Attic / 4.2	Ducts in Attic / 4.2		
COOLING DUCT LOCATION R-VALUE	Ducts in Attic / 4.2	Ducts in Attic / 4.2		
VERIFIED SEALED DUCTS IN CEILING/ROOF SPACE	No	No		

CODE TABLES: Enter code from table below into columns above.

		TIME CONTROL	SETBACK CTRL.	ISOLATION ZONES	FAN CONTROL
HEAT PUMP THERMOSTAT?		S: Prog. Switch	H: Heating	Enter Number of	I: Inlet Vanes
ELECTRIC HEAT?		O: Occupancy Sensor	C: Cooling	Isolation Zones.	P: Variable Pitch
VAV MINIMUM POSITION CONTROL?	Y: Yes	M: Manual Timer	B: Both		V: VFD
SIMULTANEOUS HEAT / COOL?	N: No				O: Other C: Curve
HEAT AND COOL SUPPLY RESET?		VENTILATION	OUTDOOR DAMPER	ECONOMIZER	O.A. CFM
HIGH EFFICIENCY?		B: Air Balance	A: Auto	A: Air	Enter Outdoor Air
PIPE INSULATION REQUIRED?		C: Outside Air Cert.	G: Gravity	W: Water	CFM.
PIPE/DUCT INSULATION PROTECTED?		M: Out. Air Measure		N: Not Required	Note: This shall be no
SEALED DUCTS IN CEILING/ROOF SPACE?		D: Demand Control		EC: Economizer	less than Col. H on
		N: Natural		Control See Section	MECH-3.
				144(e)3	

NOTES TO FIELD - For Building Department Use Only

Run Initiation Time: 04/20/04 09:36:37 Run Code: 1082478997

ENVELOPE MANDATORY MEASURES — ENV-MM

PROJECT NAME: SCIENCE BUILDING - LOS MEDANOS COLLEGE | DATE: 4/20/2004

DESCRIPTION			Designer	Enforcement
[X]	118(a)	Installed Insulating Material shall have been certified by the manufacturer to comply with the California Quality Standards for insulating material, Title 20, Chapter 4, Article 3.		
[X]	118(c)	All insulating Materials shall be installed in compliance with the flame spread rating and smoke density requirements of Sections 2602 and 707 of Title 24, Part 2.		
[X]	117(a)	All Exterior Joints and openings in the building that are observable sources of air leakage shall be caulked, gasketed, weatherstripped or otherwise sealed.		
[X]	116(b)	Site Constructed Doors, Windows and Skylights shall be caulked between the unit and the building, and shall be weatherstripped (except for unframed glass doors and fire doors).		
[X]	116(a)1	Manufactured Doors and Windows installed shall have air infiltration rates not exceeding those shown in Table Number 1-E. of the Standards. Manufactured fenestration products must be labeled for U-value according to NFRC procedures.		
[X]	118(e)	Demising Walls in Nonresidential Buildings: The opaque portions of framed demising walls in nonresidential buildings shall have insulation with an installed R-value of no less than R-11 between framing members.		

MECHANICAL MANDATORY MEASURES — Part 1 of 2 — MECH-MM

PROJECT NAME: SCIENCE BUILDING - LOS MEDANOS COLLEGE | DATE: 4/20/2004

DESCRIPTION			Designer	Enforcement
Equipment and Systems Efficiencies				
[X]	111	Any appliance for which there is a California standard established in the Appliance Efficiency Regulations will comply with the applicable standard.		
[ ]	115(a)	Fan type central furnaces shall not have a pilot light.		
[X]	123	Piping, except that conveying fluids at temperatures between 60 and 105 degrees Fahrenheit, or within HVAC equipment, shall be insulated in accordance with Standards Section 123.		
[X]	124	Air handling duct systems shall be installed and insulated in compliance with Sections 601, 603 and 604 of the Uniform Mechanical Code.		
Controls				
	122(e)	Each space conditioning system shall be installed with one of the following:		
[X]	122(e)1A	Each space conditioning system serving building types such as offices and manufacturing facilities (and all others not explicitly exempt from the requirements of Section 112 (d)) shall be installed with an automatic time switch with an accessible manual override that allows operation of the system during off-hours for up to 4 hours. The time switch shall be capable of programming different schedules for weekdays and weekends and have program backup capabilities that prevent the loss of the device's program and time setting for at least 10 hours if power is interrupted; or		
[ ]	122(e)1B	An occupancy sensor to control the operating period of the system; or		
[X]	122(e)1C	A 4-hour timer that can be manually operated to control the operating period of the system.		
[X]	122(e)2	Each space conditioning system shall be installed with controls that temporarily restart and temporarily operate the system as required to maintain a setback heating and/or a setup cooling thermostat setpoint.		
[ ]	122(g)	Each space conditioning system serving multiple zones with a combined conditioned floor area more than 25,000 square feet shall be provided with isolation zones. Each zone: shall not exceed 25,000 square feet; shall be provided with isolation devices, such as valves or dampers, that allow the supply of heating or cooling to be setback or shut off independently of other isolation areas; and shall be controlled by a time control device as described above.		
[X]	122(a&b)	Each space conditioning system shall be controlled by an individual thermostat that responds to temperature within the zone. Where used to control heating, the control shall be adjustable down to 55 degrees F or lower. For cooling, the control shall be adjustable up to 85 degrees F or higher. Where used for both heating and cooling, the control shall be capable of providing a deadband of at least 5 degrees F within which the supply of heating and cooling is shut off or reduced to a minimum.		
[X]	122(c)	Thermostats shall have numeric setpoints in degrees Fahrenheit (F) and adjustable setpoint stops accessible only to authorized personnel.		
[ ]	112(b)	Heat pumps shall be installed with controls to prevent electric resistance supplementary heater operation when the heating load can be met by the heat pump alone.		

MECHANICAL MANDATORY MEASURES — Part 2 of 2 — MECH-MM

PROJECT NAME: SCIENCE BUILDING - LOS MEDANOS COLLEGE | DATE: 4/20/2004

Description			Designer	Enforcement
Ventilation				
[X]	121(e)	Controls shall be provided to allow outside air dampers or devices to be operated at the ventilation rates as specified on these plans.		
[ ]	122(f)	Gravity or automatic dampers interlocked and closed on fan shutdown shall be provided on the outside air intakes and discharges of all space conditioning and exhaust systems.		
[ ]	122(f)	All gravity ventilating systems shall be provided with automatic or readily accessible manually operated dampers in all openings to the outside, except for combustion air openings.		
[ ]	121(f)1	Air Balancing: The system shall be balanced in accordance with the National Environmental Balancing Bureau (NEBB) Procedural Standards (1983); or Associated Air Balance Council (AABC) National Standards (1989); or		
[X]	121(f)2	Outside Air Certification: The system shall provide the minimum outside air as shown on the mechanical drawings, and shall be measured and certified by the installing licensed C-20 mechanical contractor and certified by (1) the design mechanical engineer, (2) the installing licensed C-20 mechanical contractor, or (3) the person with overall responsibility for the design of the ventilation system; or		
[ ]	121(f)3	Outside Air Measurement: The system shall be equipped with a calibrated local or remote device capable of measuring the quantity of outside air on a continuous basis and displaying that quantity on a readily accessible display device; or		
[ ]	121(f)4	Another method approved by the Commission.		
Service Water Heating Systems				
[ ]	113(b)2	If a circulating hot water system is installed, it shall have a control capable of automatically turning off the circulating pump(s) when hot water is not required.		
[ ]	113(b)3B	Lavatories in restrooms of public facilities shall be equipped with controls to limit the outlet temperature to 110 degrees F.		
[ ]	113(b)3C	Lavatories in restrooms of public facilities shall be equipped with one of the following: Outlet devices that limit the flow of hot water to a maximum of 0.5 gallons per minute. Foot actuated control valves, and outlet devices that limit the flow of hot water to a maximum of 0.75 gallons per minute. Proximity sensor actuated control valves, and outlet devices that limit the flow of hot water to a maximum of 0.75 gallons per minute. Self-closing valves, and outlet devices that limit the flow of hot water to a maximum of 2.5 gallons per minute, and 0.25 gallons/cycle (circulating system). Self-closing valves, and outlet devices that limit the flow of hot water to a maximum of 2.5 gallons per minute, and 0.50 gallons/cycle (non-circulating system). Self-closing valves, and outlet devices that limit the flow of hot water to a maximum of 2.5 gallons per minute, and 0.75 gallons/cycle (foot switches and proximity sensor controls).		

tBP architecture planning interiors management
tBP/architecture
1000 Burnett Avenue, Suite 140
Concord, CA 94520
p: 925.246.6419 f: 925.246.6495
architect

AINSWORTH ASSOCIATES
MECHANICAL ENGINEERS
SAN LEANDRO, CA
(925) 2005-029
consultant

DSA/OSHPD/DGS APPROVAL STAMP
No. 03-111
APPL. # 04-106
AC
DATE 1-11-05
agency

name
address
city, state, zip
ph: fx

SCIENCE BUILDING
LOS MEDANOS COLLEGE

Contra Costa Community College District

owner


tBP project number : 202417.00
file name:
drawn by: checked by:
date: NOVEMBER 15, 2004

Rev:	date:	description:

drawing title:
TITLE 24-MECHANICAL & ENVELOPE TITLE 24 DOCUMENTS

LMC SCIENCE 313-023-112.01-0-00.00
drawing no.:
M0.5
drawing of ?

I:\2003-029\DWG\M0-1.5.dwg Tina Nov/1,2004-03:4pm

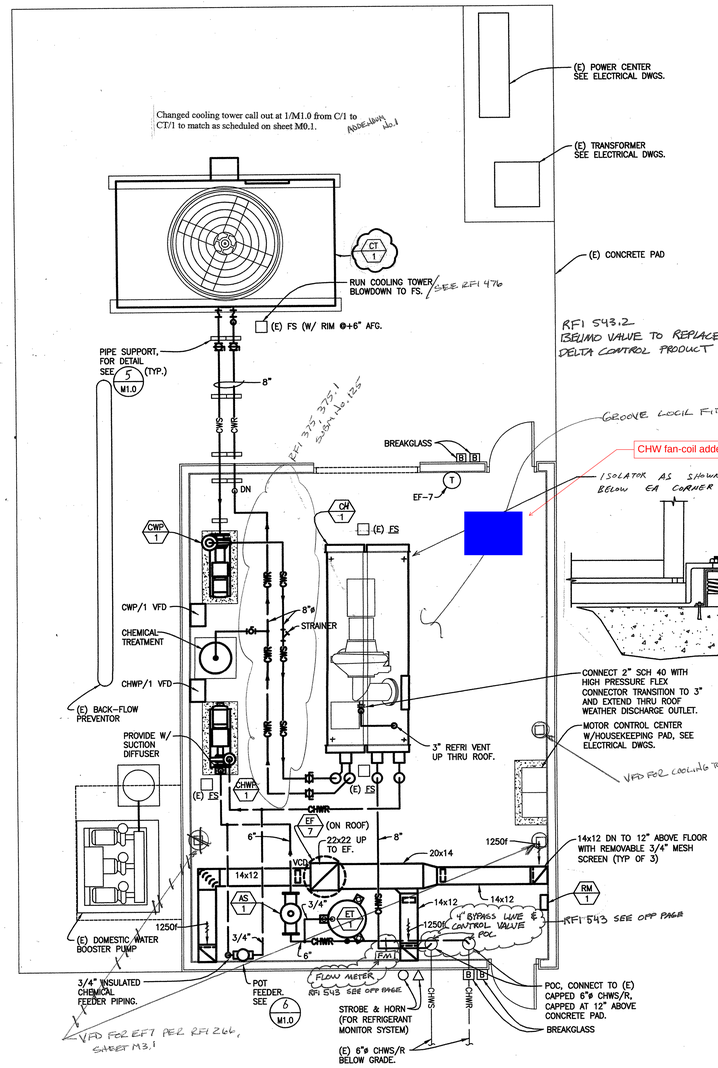

AIR CONDITIONING - MECHANICAL/CHILLER/PUMP BUILDING

1 / M1.0

SCALE: 1/4"=1'-0"


NOTES:

1. OUTSIDE EACH CHILLER EXIT DOOR PROVIDE THE FOLLOWING PER CMC 1108.5 AND CMC 1109.4:
   - BREAKGLASS TYPE ON ONLY SWITCH TO START PURGE EXHAUST FAN IF NOT ON MANUAL RESET.
   - BREAKGLASS TYPE OFF ONLY CONTROL FOR ALL EQUIPMENT IN THE CHILLER ROOM THAT IS NOT REQUIRED FOR PURGE OPERATION. AUTOMATIC ACTIVATION OF SHUT OFF ALSO REQUIRED WHEN REFRIGERANT MONITOR ALARMS.

AIR CONDITIONING - PARTIAL PLAN - HWS/HWR CONNECTION TO EXISTING DETAILS

2 / M1.0

NO SCALE

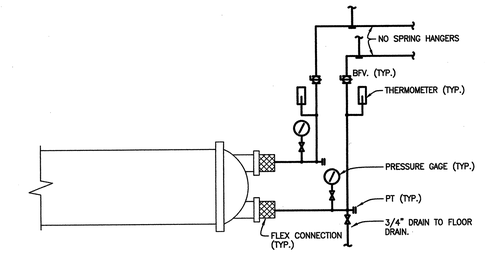


NOTES: 1. CONDENSER SIMILAR, OFFSET PIPING TO ALLOW HEAD REMOVAL.

EVAPORATOR/ PIPING CONNECTION DETAIL

2 / M1.0


NO SCALE

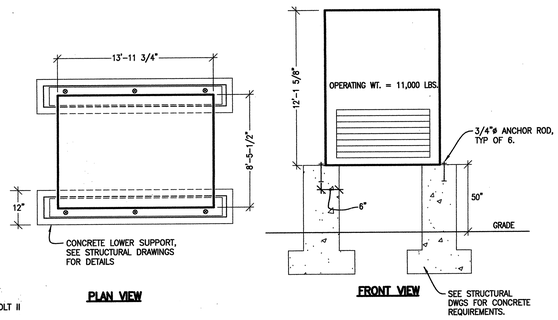

COOLING TOWER DETAIL

3 / M1.0


NO SCALE

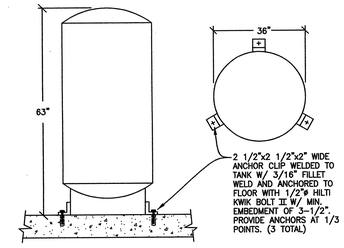

EXPANSION TANK ANCHORAGE DETAIL

4 / M1.0


NO SCALE

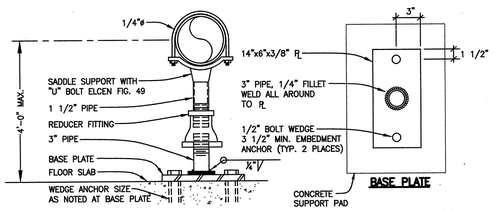

PIPE SUPPORT DETAIL

5 / M1.0


NO SCALE

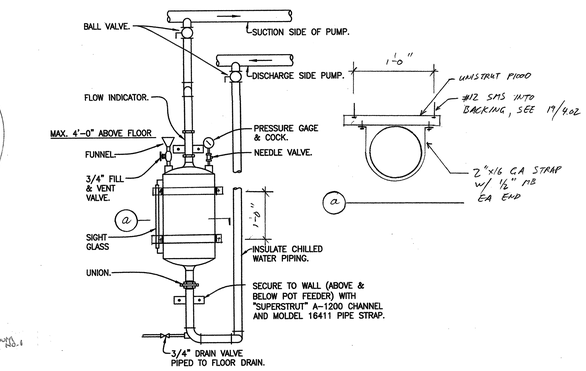

CHEMICAL POT FEEDER DETAIL

6 / M1.0


NO SCALE

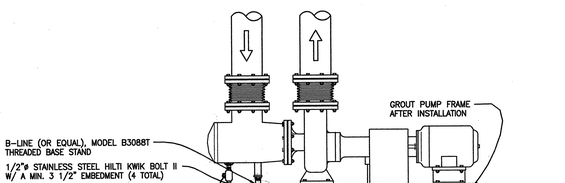

PUMP SUPPORT DETAIL

7 / M1.0

NO SCALE

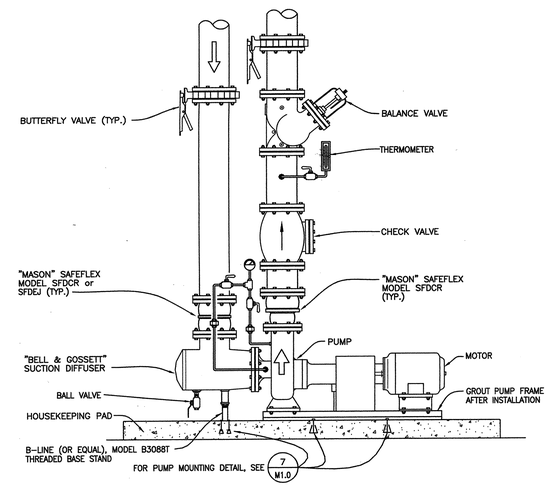


NOTE: 1. "MASON" SAFEFLEX MODEL SFDCR OR SFDEJ TO BE COORDINATED WITH PIPE SIZES SUCTION AND DISCHARGE SIZES.

CHILLED WATER PUMP PIPING DETAIL

8 / M1.0

NO SCALE

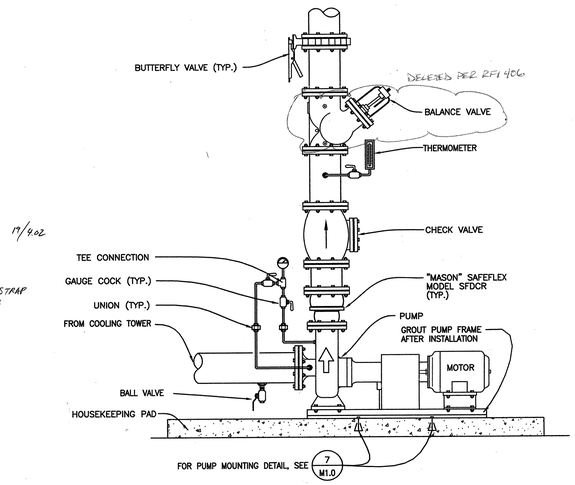

CONDENSER WATER PUMP PIPING DETAIL

9 / M1.0

NO SCALE

tBP architecture planning interiors management
tBP/Architecture
1000 Burnett Avenue, Suite 140
Concord, CA 94520
p: 925.246.6494 f: 925.246.6495
architect

AINSWORTH ASSOCIATES
MECHANICAL ENGINEERS
SACRAMENTO, CA
consultant

DEPARTMENT OF STATE ARCHITECT DIV. OF THE STATE ARCHITECT OFFICE OF REGULATION SERVICES APP. # 04-109205 DATE 11-15-05
name
address
city, state, zip
ph:
fx:
agency

SCIENCE BUILDING
LOS MEDANOS COLLEGE

Contra Costa Community College District

owner

tBP project number : 20247.00
file name:
drawn by: checked by:
date: NOVEMBER 15, 2004

Rev:	date:	description:

drawing title:
AIR CONDITIONING - MECHANICAL/CHILLER/PUMP BUILDING AND DETAILS

LMC SCIENCE 313-023-112.01-0-00.00
drawing no.: M1.0
drawing of ?

\\2003-023\DWG\M1-0.dwg Time:Now\20004-05-02pm

S. J. AMOROSO
Request For Information/Clarification

DSA FILE NO. 7-C1
DSA APPL. No. 01-106226

To: tBP/Architecture, 1000 Burnett Ave, Suite 140, Concord, CA 94520
Attn: Celia Chiang, Tom Beckett
Fax: 925-246-6495

Project: LOS MEDANOS COLLEGE SCIENCE BUILDING, Contra Costa Community College District
tBP p/n: 20247.00

Subj.: HVAC conflict 1st floor- 38"SA duct & beam
RFI No: **66.1**
Reference (dwg, spec): M1.2, S2.2.1
Subcontractor RFI: Monterey 02

Reply Requested By: 1/27/06

Date: 1/23/06

INFORMATION REQUESTED:
Original question in RFI No. 66:
In the process of detailing HVAC for underside of the second floor, we have identified the following conflict between HVAC duct and structural steel. On sheet M1.2, at approximately the line 4.8, the 38" branch near the 38" SA duct take off conflicts with the western LVL beam which frames to the column line following as shown on sheet S2.2.1. Note that ceilings are typically at 10'-0" height. Please advise.
Upon review of the response to RFI No. 66, it does not appear that the response is correct. Per Monterey: "How do you lay a 52"x22" wide duct into either a 30" round or 48" rear duct without using a transition that would need to be 48"x20" excluding insulation or liner that will be an add of approximately 4" to the 22" dimension. Please review the duct with the downlight, overhead light and projector screen interference? Please provide a drawing of this design change."

SUGGESTED SOLUTION: None.

Cost Impact: ☐ Schedule Impact: ☐ days By: Mark Delgado

RESPONSE: DATE:

Division	1/27/2006 2:35:49 PM
See attached sketches for recommended duct routing / changes. For light and projector screen interference, recommend spanning ductwork similar to detail 10, sheet S.02 Note that actual amount of ductwork has not increased (actual size has decreased).	


Attachments: By:


TRANSMITTAL RECORD:

FROM	TO	DATE
S.J. AMOROSO	tBP / ARCHITECTURE	1/23/06 1/25/06
tBP / ARCHITECTURE	ENGINEER/CONSULTANT	1/25/06
ENGINEER/CONSULTANT	tBP / ARCHITECTURE	1/27/06

RFI # 000
Page 1

cc: DONOVAN, ACM

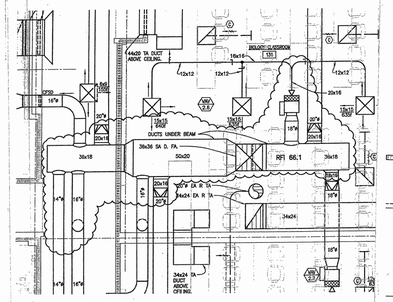

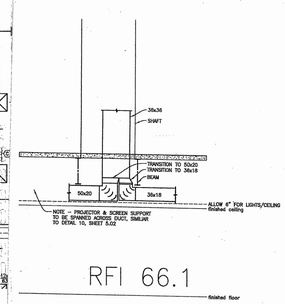

S. J. AMOROSO
Request For Information/Clarification

DSA FILE NO. 7-C1
DSA APPL. No. 01-106226

To: tBP/Architecture, 1000 Burnett Ave, Suite 140, Concord, CA 94520
Attn: Celia Chiang, Tom Beckett
Fax: 925-246-6495

Project: LOS MEDANOS COLLEGE SCIENCE BUILDING, Contra Costa Community College District
tBP p/n: 20247.00

Subj.: HVAC conflict 1st floor- 20" EA duct conflicts with 34x24 duct at 4.9 line
RFI No: **72**
Reference (dwg, spec): M1.2, S2.2.1
Subcontractor RFI: Monterey 02

Reply Requested By: 1/10/06

Date: 1/3/06

INFORMATION REQUESTED:
In the process of detailing HVAC for underside of the second floor, we have identified the following conflict between HVAC duct and structural steel. On sheet M1.2, at approximately 4.9 line, the 20" EA duct at G-4 line is in conflict with the 34x24 duct at 4.9 line. Please advise.

SUGGESTED SOLUTION: None.

Cost Impact: ☐ Schedule Impact: ☐ days By: Mark Delgado

RESPONSE: DATE:

Attachments: By:

TRANSMITTAL RECORD:


FROM	TO	DATE
S.J. AMOROSO	tBP / ARCHITECTURE	1/3/06
tBP / ARCHITECTURE	ENGINEER/CONSULTANT	
ENGINEER/CONSULTANT	tBP / ARCHITECTURE	
tBP / ARCHITECTURE	S.J. AMOROSO	
S.J. AMOROSO	ORIGINATOR	

RFI # 000
Page 1

Summary of Comments on To:

Page: 1

Sequence number: 1
Author: Donahoe
Subject: Deletion
Date: 12/6/2006 4:43:05 PM
Recommend re-routing the 20" diameter exhaust air duct to avoid conflict.
See attached for re-routing. Contractor to show re-routing within shop drawings for review.

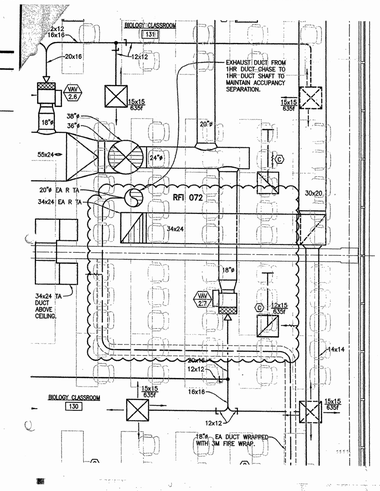

S. J. AMOROSO
Request For Information/Clarification

DSA FILE NO. 7-C1
DSA APPL. No. 01-106226

To: tBP/Architecture, 1000 Burnett Ave, Suite 140, Concord, CA 94520
Attn: Celia Chiang, Tom Beckett
Fax: 925-246-6495

Project: LOS MEDANOS COLLEGE SCIENCE BUILDING, Contra Costa Community College District
tBP p/n: 20247.00

Subj.: HVAC conflict 1st floor- EUP-2.2 conflict with light and ceiling tray
RFI No: **74.1**
Reference (dwg, spec): M1.2, S2.2.1
Subcontractor EFI: Mowbray 02

Reply Requested By: 1/27/06

Date: 1/23/06

INFORMATION REQUESTED:
We have received the response to RFI Dis. 74 and forwarded this onto our subcontractor and mechanical engineer. Per our discussion on 1/23/06, they require a flat the response source to address this issue. Are they correct (adding 4) without a drawing of the response. Please provide a drawing of this design change. Please advise.

SUGGESTED SOLUTION: None.

Cost Impact: ☐ Schedule Impact: ☐ days By: Mark Delgado

RESPONSE: DATE:

Division	1/27/2006 2:12:27 PM
See discussed with dolpher and does not appear to be a conflict. • Refer to proposed Ductwork routing • Refer proposed Ductwork routing to be reviewed on shop drawings	


Attachments: By:


TRANSMITTAL RECORD:


FROM	TO	DATE
S.J. AMOROSO	tBP / ARCHITECTURE	1/23/06 1/25/06
tBP / ARCHITECTURE	ENGINEER/CONSULTANT	1/25/06
ENGINEER/CONSULTANT	tBP / ARCHITECTURE	1/27/06
tBP / ARCHITECTURE	S.J. AMOROSO	1/27/06
S.J. AMOROSO	ORIGINATOR	

RFI # 000
Page 1

cc: DONOVAN, ACM, EW Beam

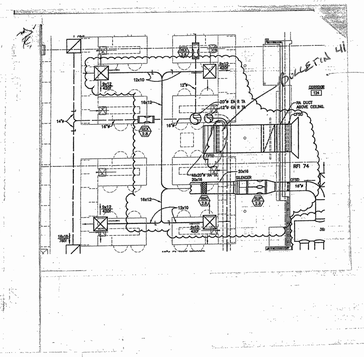

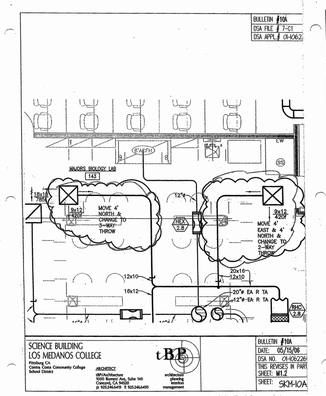

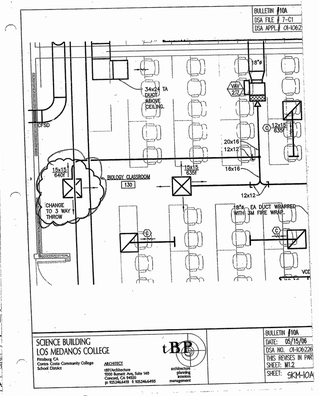

Los Medanos College
4CD Proj. #: L-565-B-23-SC
Science Building

Revised AC-1 supply and return drops due to relocation of AC-1 on roof.
ADDENDUM No.1

LINEAR SUPPLY DIFFUSER, FL-30-JT, WITH INSULATED PLENUM & 12"ø INLET, 4-FOOT LENGTH, 560 CFM TOTAL. (TYP 9)

LINEAR RETURN REGISTER, FBR1-20, WITH INSULATED HOOD/LIGHT SHIELD. 4-FOOT LENGTH, 560 CFM TOTAL. (TYP 10)

LARGE "TIRED" CLASSROOM 141

BIOLOGY CLASSROOM 142

LOBBY 140

CORRIDOR 124

STAIR #2 139

ELECTRICAL 137

REST RM. 136

REST RM. 135

COLD ROOM 134

CADAVER 133

CHEM. WASTE STORAGE 138

ELEV. #2

REFRIGERANT PIPING FROM ABOVE.

3/4" CD DROP TO AIR GAP. SEE PLUMBING DRAWINGS FOR CONTINUATION.

12x8 EA RISER TO ABOVE. PROVIDE TWO (ONE HIGH & ONE LOW) 10x6 EXHAUST AIR GRILLES (TITUS MODEL 301-RS-SS). TOP GRILLE TO BE AT 12'-0" AFF. BOTTOM GRILLE TO BE AT +1'-0" AFF. PROVIDE GRILLES WITH S.S. OPPOSED BLADE DAMPERS.

EA DUCT TO BE STAINLESS STEEL

LINEAR SUPPLY DIFFUSER, 2 SLOT FL-10-JT, WITH INSULATED PLENUM & 8"ø INLET, 2-FOOT LENGTH, 160 CFM TOTAL. BORDER TYPE 66.

TRANSFER AIR DUCT ABOVE CEILING.


MATCHLINE (SEE M1.2)

MATCHLINE (SEE M1.2)

AIR CONDITIONING - 1ST FLOOR - PARTIAL PLAN

SCALE: 1/4"=1'-0"

1 / M1.1

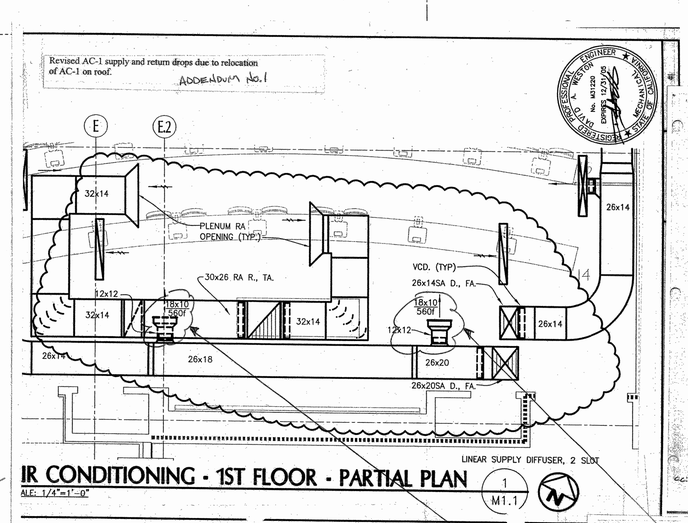

AIR CONDITIONING - 1ST FLOOR - PARTIAL PLAN

SCALE: 1/4"=1'-0"

1 / M1.1

S. J. AMOROSO
Request For Information/Clarification

DSA FILE NO. 7-C1
DSA APPL. No. 01-106226

To: tBPArchitecture, 1000 Burnett Ave, Suite 140, Concord, CA 94520
Attn: Celia Chiang, Tom Beckett
Fax: 925-246-6495
Subj.: 1st Floor Lecture Hall HVAC Issues
Reference (dwg, spec): M1.1, M4.1
Project: LOS MEDANOS COLLEGE SCIENCE BUILDING, Contra Costa Community College District
tBP job: 20247.00
RFI No: 122
Subcontractor RFI# Monterey 5
Reply Requested By: 2/10/06
Date: 2/3/06

INFORMATION REQUESTED:
Please note the attached Monterey Mechanical RFI No. 5 regarding HVAC issues in the Lecture Hall Room 141.

1. M1.1 shows (2) 18"x10" side wall supply air registers fed by the main supply north of 2-8 Row. There is no wall where these registers are located.
2. M4.1 shows a 12"ø pipe penetration piping entering classroom #141 north of 2-8 fine and west of 1" Box, turning up and through the roof by AC-1. This piping will be exposed.
3. Location of the T-Stat for AC-1 is show in the closet.

Please advise and provide a sketch if necessary.

SUGGESTED SOLUTION:

Cost Impact: ☐ Schedule Impact: ☐ days By: Mark Delgado

RESPONSE: DATE:

Author: Brandon
Date: 2/6/2006 8:16:31 AM
Responses as follows:
1. Revise 18"x10" side wall registers to linear diffusers – see attached sketch for details.
2. Piping to be run concealed above the ceiling. Provide a 4" beam penetration at 8 line. At beam penetration, decrease piping to 8" ø. Coordinate locations. Reference attachments for structural requirements and architectural section.
3. T-stat is shown on drawing M4.1; however, see attachment for revised location.

Attachments:

By:

TRANSMITTAL RECORD:

FROM	TO	DATE
S.J. AMOROSO	tBP / ARCHITECTURE	2/3/06
tBP / ARCHITECTURE	ENGINEER/CONSULTANT	2/3/06
ENGINEER/CONSULTANT	tBP / ARCHITECTURE	2/3/06
tBP / ARCHITECTURE	S.J. AMOROSO	2/3/06
S.J. AMOROSO	CM/GM/OR	2/3/06

RFI # 000
Page 1

cc: ROSCOE

RFI 122 Response

WALL TYPES -

(FOR REFERENCE ONLY. WALL TYPES ON ARCHITECTURAL DRAWINGS SHALL TAKE PRECEDENCE.)


1-HR FIRE RATED ASSEMBLY

1-HR FIRE RATED ASSEMBLY (OCCUPANCY SEPARATION)

2-HR FIRE RATED ASSEMBLY (AT CHEMICAL WASTE STORAGE ONLY)

STUD PARTITION
REFER TO SHEET 4.02 FOR PARTITION TYPES

KEY PLAN

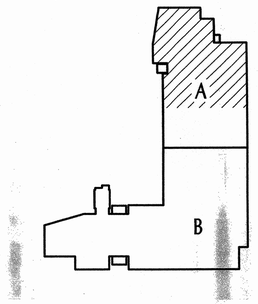

tBP architecture planning interiors management
tBP/Architecture
1000 Burnett Avenue, Suite 140
Concord, CA 94520
p: 925.246.6419 f: 925.246.6495
architect

AINSWORTH ASSOCIATES
MECHANICAL ENGINEERS
SACRAMENTO, CA
(25-2005-009)
consultant

CONSTRUCTION STAMP
DIV. OF THE STATE ARCHITECT
OFFICE OF REGULATION SERVICES
APPL. # 01-106226
DATE 2-13-06

name
address
city, state, zip
ph: fx:
agency

SCIENCE BUILDING
LOS MEDANOS COLLEGE

Contra Costa Community College District

owner

tBP project number : 20247.00
file name:
drawn by: checked by:
date: NOVEMBER 15, 2004

Rev:	date:	description:

drawing title:
AIR CONDITIONING - 1ST FLOOR - PARTIAL PLAN

LMC SCIENCE 313-023-112.01-0-00.00
drawing no: M1.1
drawing of ?

BULLETIN IDA

L:\2005-009\M\M1.1-Aug Time:Nov/1/2004-08:49pm

S. J. AMOROSO
Request For Information/Clarification

DSA FILE NO. 7-C1
DSA APPL. No. 01-106226

To: IBI/Architecture, 1000 Burnett Ave, Suite 140, Concord, CA 94520
Project: LOS MEDANOS COLLEGE SCIENCE BUILDING, Contra Costa Community College District
Attn: Celia Chiang, Tom Beckett
Fax: 925-246-6495
IBI# pln: 20247.00
Subj.: Venting of corrosives storage cabinets
RFI No: 76.1
Reference (dreg, spec.): LF1-02, M1.3, M1.2
Subcontractor RFI: Monterey 12

Reply Requested By: 1/2/06

INFORMATION REQUESTED: Date: 1/2/06

Per Details from REFERENCE:
Original question in RFI No. 76:
Per details on sheet LF1-02, at underside of the isolated floor, we have identified the following ducted exhaust inlets: duct size/ elevation cited. On sheet M1.3, the CHFD for the 24" EA duct at line 7.3 and the F.3 to the east balances the exterior and room 128 will be negatively pressured. The mechanical engineer has indicated that the 24" EA duct does into the ceiling. Also, there is not enough mechanical room for the CHFD inferior and the dual inlet. Please advise.

We have forwarded the response to RFI No. 76 to our mechanical subcontractor and drafter and have are requesting a drawing of the design change to clarify the RFI response. Please provide a response ASAP.

SUGGESTED SOLUTION: None

Cost Impact: ☐ Schedule Impact: ☐ days By/ Work Delipads

RESPONSE: DATE: 1/2/2006 9:41:28 PM


Response as follows:
1. Room 125 - Does attached sketch for mechanical connections. Old Response to RFI #75.)
2. See attached for sketching. Note - duct size at interior locking effect the generator location so we had the duct with 90 degrees. Architectural/structural team can play for transport to reposition room. Also and routing to be reviewed when drop ceiling is added.


By:

TRANSMITTAL RECORD:

FROM	TO	DATE
S.J. AMOROSO	IBI / ARCHITECTURE	1-2-06
IBI / ARCHITECTURE	MONTEREY BAY ASSIST	1-3-06
MONTEREY BAY ASSIST	IBI / ARCHITECTURE	1-4-06
IBI / ARCHITECTURE	S.J. AMOROSO	1-4-06
S.J. AMOROSO	ORIGINATOR	

RFI # 000
Page 1

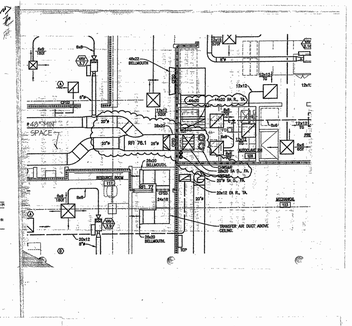

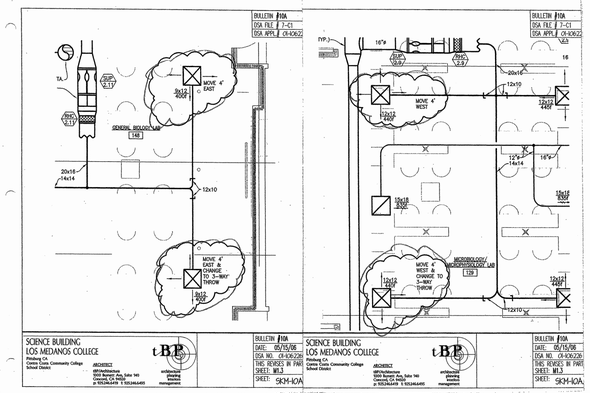

S. J. AMOROSO
Request For Information/Clarification

DSA FILE NO. 7-C1
DSA APPL. No. 01-106226

To: IBI/Architecture, 1000 Burnett Ave, Suite 140, Concord, CA 94520
Project: LOS MEDANOS COLLEGE SCIENCE BUILDING, Contra Costa Community College District
Attn: Celia Chiang, Tom Beckett
Fax: 925-246-6495
IBI# pln: 20247.00
Subj.: Venting of corrosives storage cabinets
RFI No: 315
Reference (dreg, spec.): LF 1-02,
Subcontractor RFI:

Reply Requested By: 8/21/06

INFORMATION REQUESTED: Date: 8/14/06

Per details on sheet LF1-02, there is a vent connected to building exhaust systems at corrosives storage base cabinets and acid/base storage base cabinets. Per review of the LF drawings, these types of cabinets occur in the following locations:
1. An island in room 125.
2. The west wall of room 145
3. The north wall of room 148
4. The west wall of room 235.

On sheet M1.2, a connection to the HVAC system is shown for item 2 above. No similar connection is shown on the contract drawings for the remaining 3 locations. Please advise.

SUGGESTED SOLUTION:
Cost Impact: ☐ Schedule Impact: ☐ days By: Bryan Newman

RESPONSE: DATE:

Response as follows:
1) Room 125 - See attached sketch for mechanical connections.
2) Room 145 - No changes required - reference sheet M1.2 for connection(s).
3) Room 148 - Refer to General Note #18/Sheet LF1-00.
4) Room 235 - Refer to sheet LF1-02 - CS cabinet below fume hoods to have 3" diameter vent through bench-top behind baffle (extend 4" above bench-top).

Dave Norton/AAME
8/29/06

RFI # 000
Page 1

S. J. AMOROSO
Request For Information/Clarification

DSA FILE NO. 7-C1
DSA APPL. No. 01-106226

To: IBI/Architecture, 1000 Burnett Ave, Suite 140, Concord, CA 94520
Project: LOS MEDANOS COLLEGE SCIENCE BUILDING, Contra Costa Community College District
Attn: Celia Chiang, Tom Beckett
Fax: 925-246-6495
IBI# pln: 20247.00
Subj.: Venting of corrosives storage cabinets
RFI No: 315.1
Reference (dreg, spec.): LF 1-02,
Subcontractor RFI:

Reply Requested By: 9/21/06

INFORMATION REQUESTED: Date: 9/14/06

Per response to RFI 315, the island in room 125 is to be vented to the "regular" building exhaust system with standard material ducting. Please confirm that this is correct (i.e. the vented gases won't pose a corrosive problem for the duct and fans).

Per response to RFI 315, the corrosive cabinets in rooms 148 and 235 are to be vented to nearby fume hoods. Please indicate what material should be used for this piping.

SUGGESTED SOLUTION:
Cost Impact: ☐ Schedule Impact: ☐ days By: Bryan Newman

RESPONSE: DATE:

Per previous discussions with RFP, venting this to general exhaust is acceptable, therefore, part 1 of the RFI is confirmed as correct.


As for the material -see response per RFP.

David Norton/AAME - 9/21/06


The piping material should be PVC.

Richard H. Cole/RFP - 9/21/06

RFI # 000
Page 1

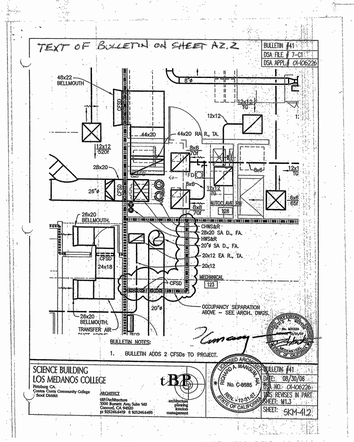

Los Medanos College
4CD Proj. #: L-565-B-23-SC
Science Building

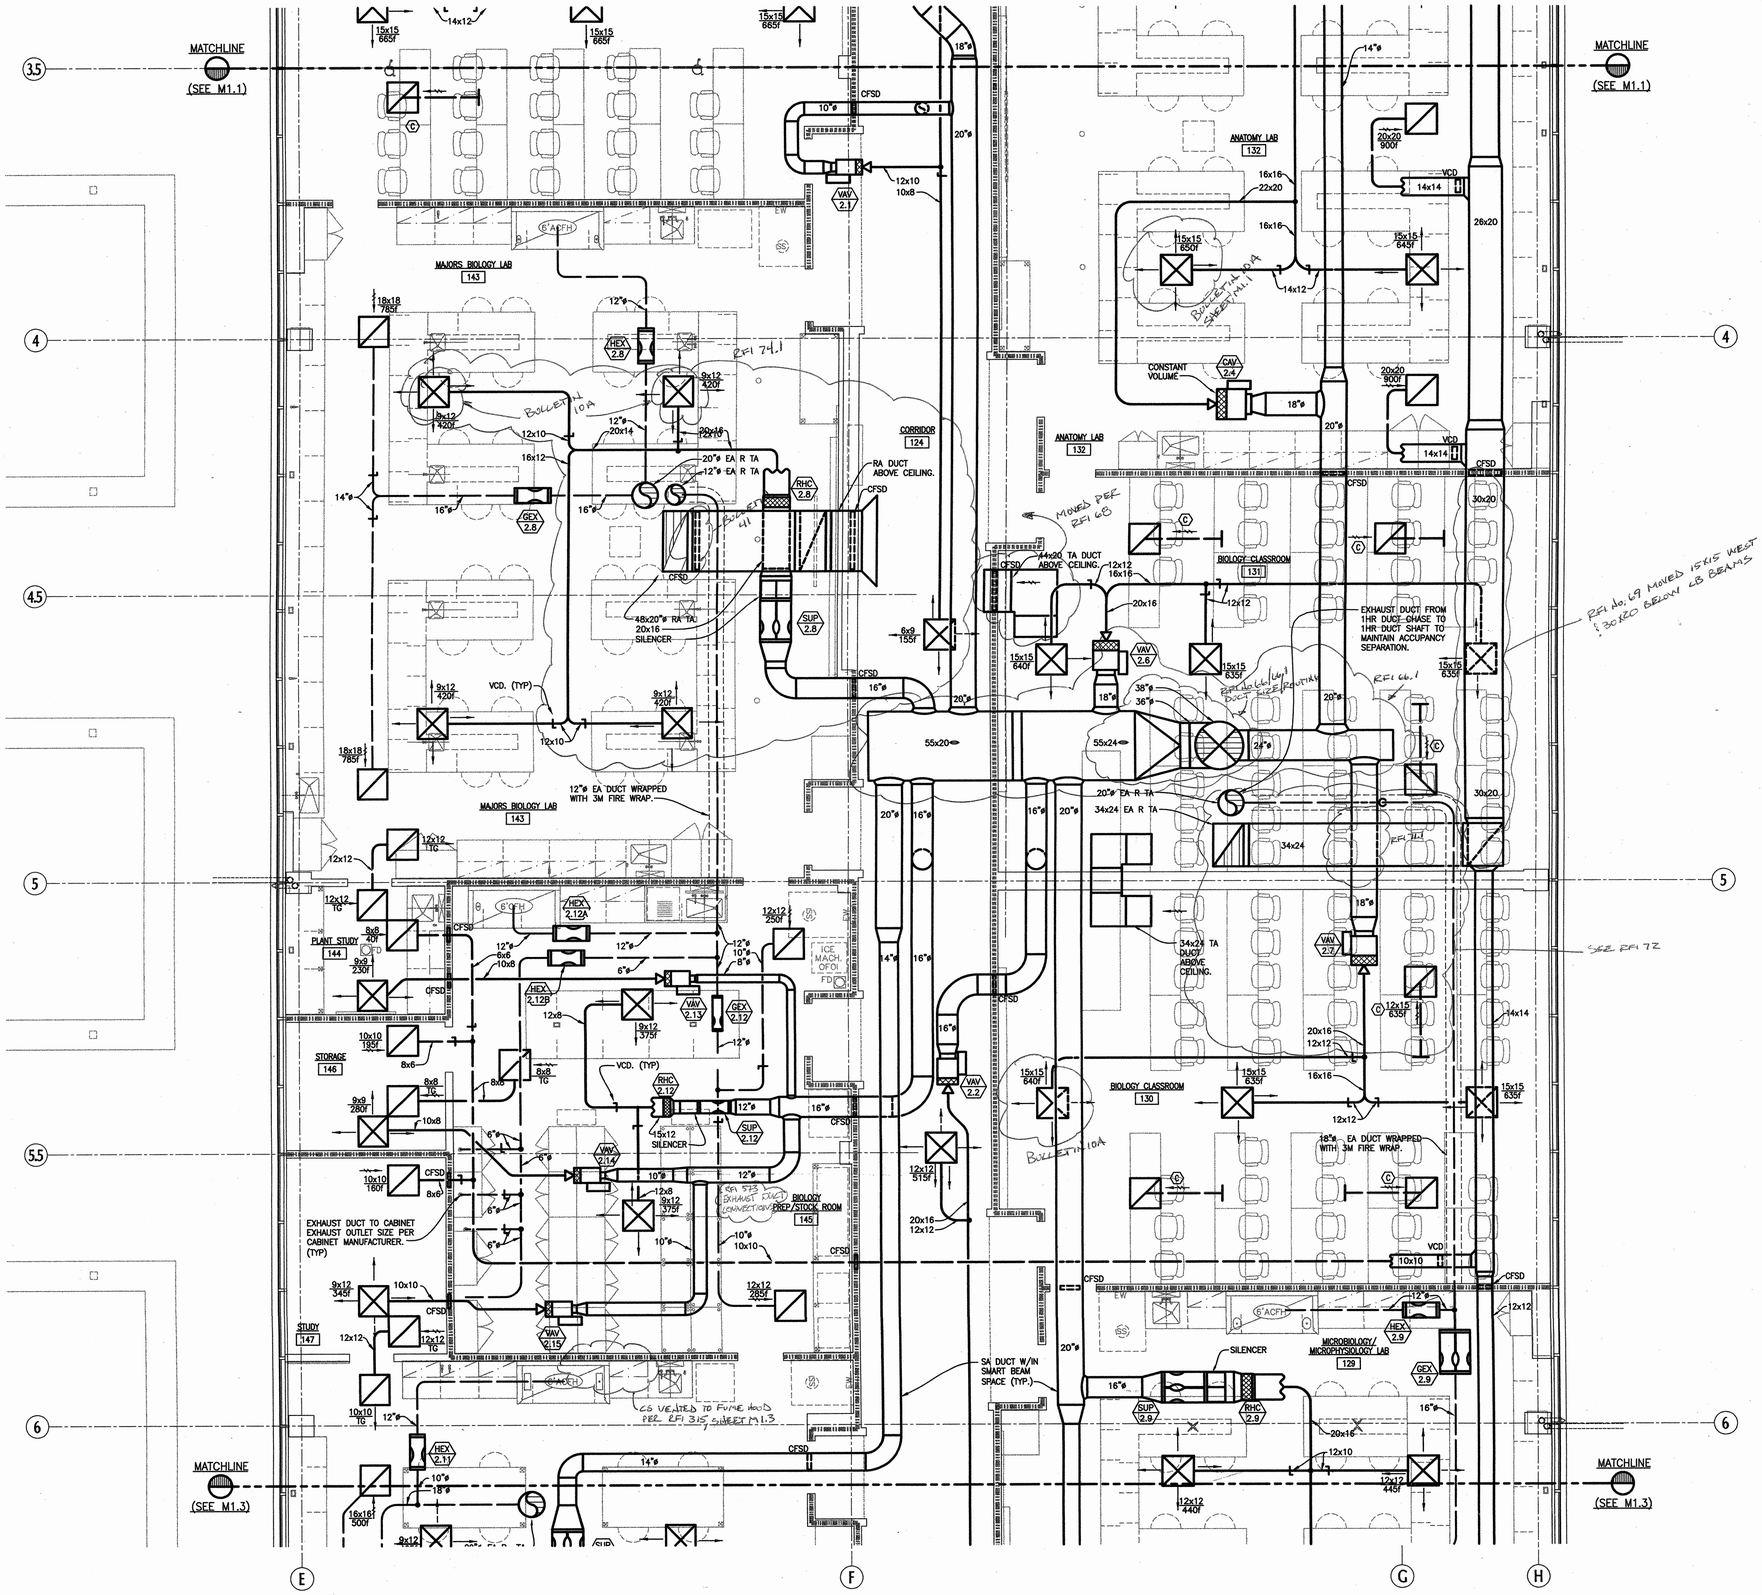

AIR CONDITIONING - 1ST FLOOR - PARTIAL PLAN

SCALE: 1/4"=1'-0"

S. J. AMOROSO
Request For Information/Clarification

DSA FILE NO. 7-01
DSA APPL. No. 01-106226

To: tBP/Architecture, 1000 Burnett Ave, Suite 140, Concord, CA 94520
Attn: Celia Chiang, Tom Beckett
Fax: 925-246-6495

Project: LOS MEDANOS COLLEGE SCIENCE BUILDING, Contra Costa Community College District
tBP ph: 20247.00

Subj: Transformer to power Tristek fume hood valves
Reference (dwg, spec.): none

RFI No: 498
Subcontractor RFI:

Reply Requested By: 3/14/07

INFORMATION REQUESTED: Date: 3/7/07

During meeting Arkoroso has had with subcontractors to plan building start up, CommAir has mentioned "one transformer per room to power the above-ceiling Tristek valves in that room." We have looked for this on the contract documents nor is Arkoroso able to accurately identify this device in the specifications.

Repeated requests to CommAir to provide an informed RFI on this topic have not been answered.

We understand from CommAir that there is one of these transformers per room. The drawback to this is that if CommAir forgets to shut off this single device, ALL fume hoods in that room would be out of operation. The end user has indicated a preference that the valves for each fume hood be powered separately. Given that these transformers are not shown on the contract drawings, currently there is NO power to them.

One possible solution is to utilize the power that is being taken to the fume hoods themselves (there are 3 dedicated circuits to each fume hood).

As discussed with the architect, this vague RFI is being written to provide a paper trail for this topic given the lack of a detailed RFI from CommAir.

Please advise on power to these transformers and also location of these transformers as well as if there is one per room or one per fume hood.

SUGGESTED SOLUTION:
Cost Impact: ☐ Schedule Impact: ☐ days By: Justin Warren

RESPONSE: DATE:
No exception taken to use one of the three circuits at each fume hood to power the Tristek transformer. There will be one transformer per hood.

Jim Weaver / tBP Architecture
Richard Cella / RFD

3/15/07

RFI # 000

S. J. AMOROSO
Request For Information/Clarification

DSA FILE NO: 7-C1
DSA APPL. No. 01-106226

To: tBP/Architecture, 1000 Burnett Ave, Suite 140, Concord, CA 94520
Attn: Celia Chiang, Tom Beckett
Fax: 925-246-6495

Project: LOS MEDANOS COLLEGE SCIENCE BUILDING, Contra Costa Community College District
tBP ph: 20247.00

Subj: Transformer to power Tristek fume hood valves and fume hood devices
Reference (dwg, spec.): none

RFI No: 498.1
Subcontractor RFI:

Reply Requested By: 5/1/07

INFORMATION REQUESTED: Date: 4/24/07

In the response to RFI No. 498, the information given was that one of the three circuits being taken to the fume hoods can be used to power the tristek transformer and that there is one transformer per hood.
Part A:
Please provide the circuit numbers of the circuits to be used for this purpose, at each hood.

Part B: Also, is there one transformer per hood, or is the one transformer per hood and also one transformer per Tristek valve?

Part C: If the latter is the case, can these multiple transformers all be fed from the single circuit being designated in the response to part A of this RFI?

SUGGESTED SOLUTION:
Cost Impact: ☐ Schedule Impact: ☐ days By: Justin Warren

RESPONSE: DATE: 5/2/07

Part A: Each hood is shown on the plans with three circuits (and circuit numbers) provided. Hoods should be wired per manufacturer's recommendations, but which circuit of the three is used for what purpose in each hood (including which feeds the transformer) is not qualified by us.
Part B: There is one transformer per hood.
Part C: There are already three circuits to be provided per hood, and no need to pull an additional circuit to feed the transformers.

James Cooley, Sr. Project Engineer, Michael Watt Engineering

RFI # 000
Page 1

WALL TYPES

(FOR REFERENCE ONLY. WALL TYPES ON ARCHITECTURAL DRAWINGS SHALL TAKE PRECEDENCE.)


1-HR FIRE RATED ASSEMBLY

1-HR FIRE RATED ASSEMBLY (OCCUPANCY SEPARATION)

2-HR FIRE RATED ASSEMBLY (AT CHEMICAL WASTE STORAGE ONLY)

STUD PARTITION
REFER TO SHEET 4.02 FOR PARTITION TYPES

KEY PLAN

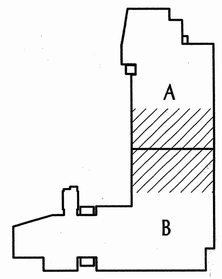

tBP
architecture
planning
interiors
management
tBP/architecture
1000 Burnett Avenue, Suite 140
Concord, CA 94520
p: 925.246.6419 f: 925.246.6495
architect

AINSWORTH ASSOCIATES
MECHANICAL ENGINEERS
SACRAMENTO, CA
consultant

name
address
city, state, zip
ph
fx
agency

SCIENCE BUILDING
LOS MEDANOS COLLEGE
Contra Costa Community College District

owner


tBP project number : 20247.00
file name:
drawn by: checked by:
date: NOVEMBER 15, 2004

Rev	date:	description:

drawing title:
AIR CONDITIONING - 1ST FLOOR - PARTIAL PLAN

LMC SCIENCE 313-023-712.01-0-00.00
drawing no:
M1.2
drawing of ?

I:\2003-023\DWG\M1-1-4.dwg, Time Now\ 20004-03-14pm

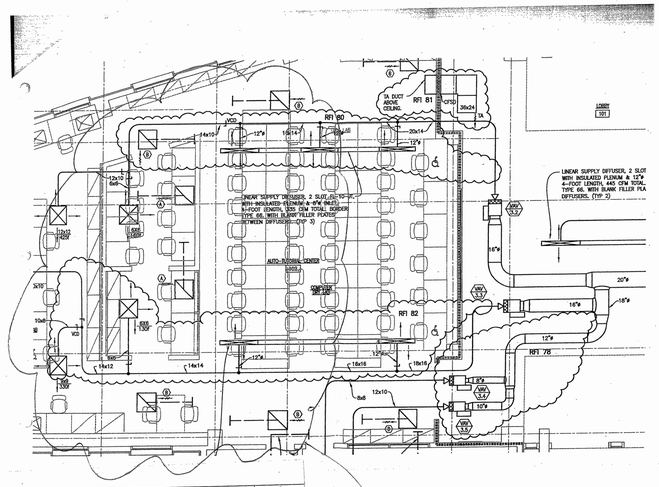
RFI 81
RFI 80
RFI 82
RFI 78
LOBBY
101
LINEAR SUPPLY DIFFUSER, 2 SLOT, FL-10'-7", WITH INSULATED PLENUM, 8 5/8" INLET, 4-FOOT LENGTH, 360 CFM TOTAL, BORDER TYPE 66, WITH BLANK FILLER PLATES BETWEEN DIFFUSERS. (TYP 3)
LINEAR SUPPLY DIFFUSER, 2 SLOT FL-10'-7", WITH INSULATED PLENUM & 8"W INLET, 4-FOOT LENGTH, 360 CFM TOTAL, BORDER TYPE 66, WITH BLANK FILLER PLATES BETWEEN DIFFUSERS. (TYP 2)
AUTO-TUTORIAL CENTER
1,000 s.f.
COMPUTER LAB
1,000 s.f.
VCD
VAV 1.3
VAV 1.4
VAV 1.7
CFSD
36x24
20x14
18x14
18x16
16x14
12x10
10x8
8x8
12x12 45SF
8x8 210F
8x8 210F
8x8 210F

AIR CONDITIONING - 1ST FLOOR - PARTIAL PLAN

SCALE: 1/4"=1'-0"

1 / M1.3

MATCHLINE (SEE M1.2)

MATCHLINE (SEE M1.4)

MATCHLINE (SEE M1.4)

3/4" CD DROP TO AIR GAP. SEE PLUMBING DRAWINGS FOR CONTINUATION.

REFRIGERANT PIPING FROM ABOVE.

REFRIGERANT PIPING FROM ABOVE.

3'-0" x 4'-0" MIN CLR SPACE

SMART BEAM SPACE (TYP.)

CFSD

GENERAL BIOLOGY LAB 148

MICROBIOLOGY/ MICROPHYSIOLOGY LAB 129

MICRO PREP/STOCK ROOM 125

CORRIDOR 124

DATA 151

ELEV. EQUIP. 150

STORAGE 149

ELEV. EQUIP. 117

RESOURCE ROOM 111

WOMEN 110

MECHANICAL 123

PREP/STORAGE 127

AUTOCLAVE RM 128

STOR. 126

STORAGE 122

OFFICE 116

OFFICE 117

OFFICE 118

OFFICE 119

OFFICE 120

OFFICE 121

BULLETIN 10A

BULLETIN 41

RFI No 76.1

DUCT SHORTENED PER RFI 77

TRANSFER AIR DUCT ABOVE CEILING.

DUCTING ADDED TO LOUVER OVER DOOR, SEE RFI 311, SHEET A4-1

CAN BE RESIZED PER RFI 75

CROSSOVER VENTING PER RFI 315

CHWS&R 26"ø SA D., FA.

HWS&R 20"ø SA D., FA.

20x12 EA R., TA.

46x24 RA R., TA.

20"ø EA R., TA. SILENCER

26x20 BELLMOUTH.

50x26 BELLMOUTH

VCD (TYP)

ACI 1

ACS 1

CO

AHU

HEX 2.11

SUP 2.11

RHC 2.11

GEX 2.11

SUP 2.9

RHC 2.9

GEX 2.9

VAV 3.7

VAV 3.9

VAV 3.8

VAV 3.12

VAV 3.13

VAV 3.14

VAV 2.16

VAV 2.15

ADDENDUM #1
DSA FILE # 1-01
DSA APP. # 01-106226

Provided bell-mouth size of 50x26 at return air duct in corridor 124. Added size of bell mouths to 24x18 transfer duct in hallway next to Resource Room 111. Moved exhaust air registers in Autoclave Room 128 to avoid duct and heating hot water drops at shaft. Added TCP location in Mechanical Room 123.

ADDENDUM #1 Dec. 7

AIR CONDITIONING - 1ST FLOOR - PARTIAL PLAN

SCALE: 1/4"=1'-0"

1 / M1.3


1HR FIRE RATED ASSEMBLY

1HR FIRE RATED ASSEMBLY (OCCUPANCY SEPARATION)

2-HR FIRE RATED ASSEMBLY (AT CHEMICAL WASTE STORAGE ONLY)

STUD PARTITION
REFER TO SHEET 4.02 FOR PARTITION TYPES

KEY PLAN

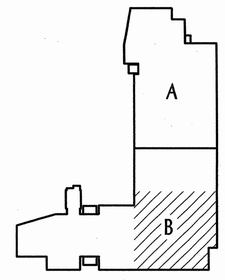

tBP architecture planning interiors management

tBP/Architecture
1000 Burnett Avenue, Suite 140
Concord, CA 94520
p: 925.246.6419 f: 925.246.6495

architect

AINSWORTH ASSOCIATES
MECHANICAL ENGINEERS
SACRAMENTO, CA
(916) 2028-2028

consultant

name
address
city, state, zip
ph: fx:

agency

SCIENCE
LOS MEDANOS

Contra Costa Community College District

owner

tBP project number : 20241.00

file name:

drawn by: checked by:

date: NOVEMBER 15, 2004

Rev:	date:	description:

drawing title:
AIR CONDITIONING - 1ST FLOOR - PARTIAL PLAN

LMC SCIENCE 313-023-112.01-0-00.00

drawing no: M1.3

drawing of ?

LICENSED ARCHITECT STATE OF CALIFORNIA

\2005-0070\M65N1-1.dwg Time:Nov/12/2004-09:44pm

Rev 8

S. J. AMOROSO
Request For Information/Clarification

DSA FILE NO. 7-C1
DSA APPL. No. 01-106226

To: IBP/Architecture
1000 Burnett Ave, Suite 140
Concord, CA 94520

Attn: Celia Chiang, Tom Beckett
Fax: 925-246-6485

Subj.: Elevation of AC5-2 in room 237

Reference (dwg, spec.) : M2.1, A2-3

Project: LOS MEDANOS COLLEGE SCIENCE BUILDING
Contra Costa Community College District

IBP p/n: 20247.00

RFI No: **244**
Subcontractor RFI: Monterey II

Reply Requested By: **6/16/06**

INFORMATION REQUESTED: Date: 6/6/06

On drawings M2.1,fan coil AC5-2 is shown hung in storage room 237 serving the elevator machine room 238 via side wall registers and grills. Drawings A3.3 indicate the ceiling height of room 238 to be the typical 10'-0" height while room 238 is 9'-4½". Is AC5-2 mounted below the 10'-0" ceiling in room 237? Please indicate the elevation of this unit.

SUGGESTED SOLUTION:

Cost Impact: ☐ **Schedule Impact:** ☐ days By: Mark Delgado

RESPONSE: AC5-2 is located above the ceiling, recommend changing sidewall diffusers to ceiling diffuser. SA diffuser to be 1x1x3 and return air to be sized at 1x1x6. Note that exact location of the diffusers are not critical and can be field located in the general area. Modifications to the shop drawings not required.

DATE
6/14/06

Attachments: Contractor to indicate change in as-built drawings. By: Dave Morton/AMO

TRANSMITTAL RECORD:

FROM	TO	DATE
S.J. AMOROSO	IBP / ARCHITECTURE	6/6/06
IBP / ARCHITECTURE	ENGINEER/CONSULTANT	6/14/06
ENGINEER/CONSULTANT	IBP / ARCHITECTURE	6/14/06
IBP / ARCHITECTURE	S.J. AMOROSO	6/14/06
S.J. AMOROSO	ORIGINATOR	

RFI # 000
Page 1

Los Medanos College
4CD Proj. #: L-565-B-23-SC
Science Building

AIR CONDITIONING - 1ST FLOOR - PARTIAL PLAN

1 / M1.4

SCALE: 1/4"=1'-0"

LINEAR SUPPLY DIFFUSER, 2 SLOT FL-10-JT, WITH INSULATED PLENUM & 8"ø INLET, 4-FOOT LENGTH, 1335 CFM TOTAL BORDER TYPE 66. WITH BLANK FILLER PLATES BETWEEN DIFFUSERS. (TYP 3)

LINEAR SUPPLY DIFFUSER, 2 SLOT FL-10-JT, WITH INSULATED PLENUM & 12"ø INLET, 4-FOOT LENGTH, 445 CFM TOTAL BORDER TYPE 66. WITH BLANK FILLER PLATES BETWEEN DIFFUSERS. (TYP 2)

LINEAR SUPPLY DIFFUSER, 2 SLOT FL-10-JT, WITH INSULATED PLENUM & 8"ø INLET, 4-FOOT LENGTH, 360 CFM TOTAL BORDER TYPE 66. WITH BLANK FILLER PLATES BETWEEN DIFFUSERS. (TYP 2)

RA SIMILAR TO 9/M6.1. EXTEND/TERMINATE AS SHOWN

RFI 78.J
RFI 79. NO SKETCH PROVIDED

RFI 80
RFI 81
RFI 82

BULLETIN 49
BULLETIN 10A

STAIR #1 105
LOBBY 101
BIOLOGY CLASSROOM 152
AUTO-TUTORIAL CENTER 102
COMPUTER DRY LAB
VIDEO SET-UP LAB
SET-UP LAB
GROUP STUDY 103
GROUP STUDY 104
ELEV. #1
MEN 109
JAN. 108
OFFICE 112
OFFICE 113
OFFICE 114
OFFICE 115

MATCHLINE (SEE M1.3)

WALL TYPES

(FOR REFERENCE ONLY. WALL TYPES ON ARCHITECTURAL DRAWINGS SHALL TAKE PRECEDENCE.)


1-HR FIRE RATED ASSEMBLY

1-HR FIRE RATED ASSEMBLY (OCCUPANCY SEPARATION)

2-HR FIRE RATED ASSEMBLY (AT CHEMICAL WASTE STORAGE ONLY)

STUD PARTITION
REFER TO SHEET 4.02 FOR PARTITION TYPES

KEY PLAN

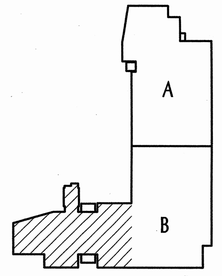

tBP architecture
architecture
planning
interiors
management
tBP/architecture
1000 Burnett Avenue, Suite 140
Concord, CA 94520
p: 925.246.6419 f: 925.246.6495
architect

AINSWORTH ASSOCIATES
MECHANICAL ENGINEERS
SACRAMENTO, CA
consultant

name
address
city, state, zip
ph:
fx:
agency

SCIENCE BUILDING
LOS MEDANOS COLLEGE

Contra Costa Community College District

owner


tBP project number : 2024.00
file name:
drawn by: checked by:
date: NOVEMBER 15, 2004


Rev.	date:	description:


drawing title:
AIR CONDITIONING -
1ST FLOOR - PARTIAL PLAN

LMC SCIENCE 313-023-112.01-0-00.00
drawing no:
M1.4
drawing of ?

\2005-009\DWG\M1-1-4.dwg Tue,Nov/1/2004-05:45pm

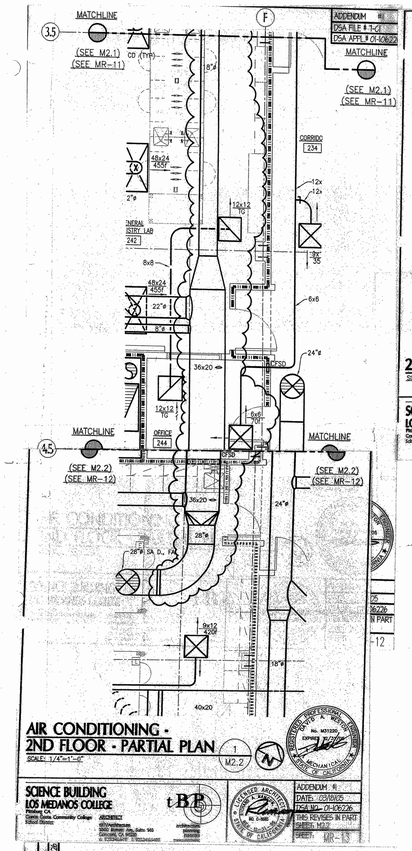

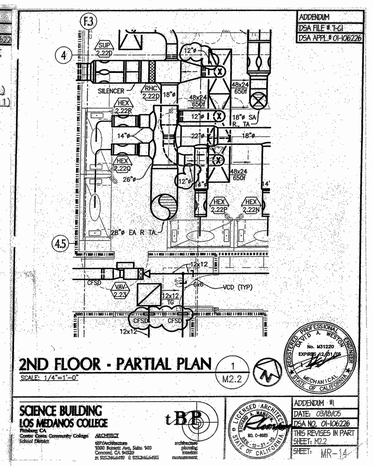

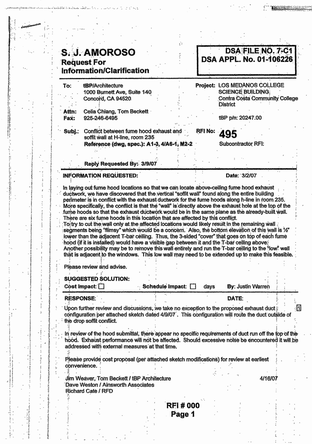

S. J. AMOROSO
Request For Information/Clarification

DSA FILE NO. 7-C1
DSA APPL. No. 01-106226

To: ISP/Architecture, 1000 Burnett Ave, Suite 140, Concord, CA 94520
Project: LOS MEDANOS COLLEGE SCIENCE BUILDING, Contra Costa Community College District
Attn: Celia Chiang, Tom Beckett
Fax: 925-246-6495
ISP job: 20247.00
Subj.: Conflict between fume hood exhaust and soffit wall at H-line, room 235
Reference (dwg, spec.): A1-0, 4/A5-1, M3-2
RFI No: 495
Subcontractor RFI
Reply Requested By: 3/9/07

INFORMATION REQUESTED: Date: 3/2/07

In laying out fume hood locations so that we can locate above-ceiling fume hood exhaust ductwork, we have discovered that the vertical "soffit wall" found along the entire building perimeter is in conflict with the exhaust ductwork for the fume hoods along h-line in room 235. More specifically, the conflict is that the "wall" is directly above the exhaust hole at the top of the fume hood so that the exhaust ductwork would be in the same location as the already-built wall. Please see attached sketch showing location where the conflict occurs.
To try to cut the wall only at the affected locations would likely result in the remaining wall segments being "flimsy" which would be a concern. Also, the bottom elevation of this wall is 9" lower than the adjacent T-bar ceiling. Thus, the 3-sided "cover" that goes on top of each fume hood (if it is installed) would have a visible gap between it and the T-bar ceiling above; Another possibility may be to remove this wall entirely and run the T-bar ceiling to the "low" wall that is adjacent to the windows. This low wall may need to be extended up to make this feasible.

Please review and advise.

SUGGESTED SOLUTION:
Cost Impact: ☐ Schedule Impact: ☐ days By: Justin Warren

RESPONSE: DATE:


Upon further review and discussions, we take no exception to the proposed exhaust duct configuration per attached sketch dated 4/9/07 . This configuration will route the duct outside of the drop soffit conflict.


In review of the hood submittal, there appear no specific requirements of duct run off the top of the hood. Exhaust performance will not be affected. Should excessive noise be encountered it will be addressed with external measures at that time.


Please provide cost proposal (per attached sketch modifications) for review at earliest convenience.

Jim Weaver, Tom Beckett / ISP Architecture 4/18/07
Dave Weston / Ainsworth Associates
Richard Cate / RFD

RFI # 000
Page 1

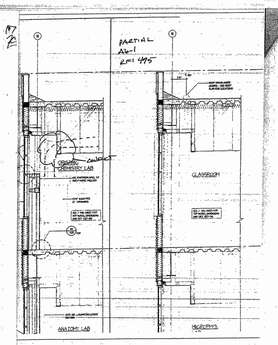

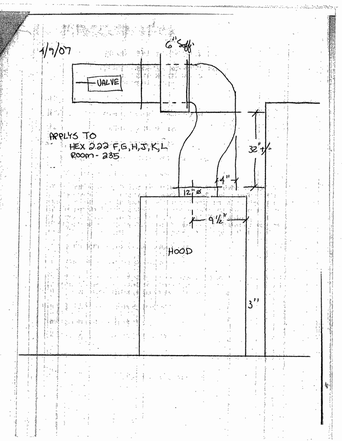

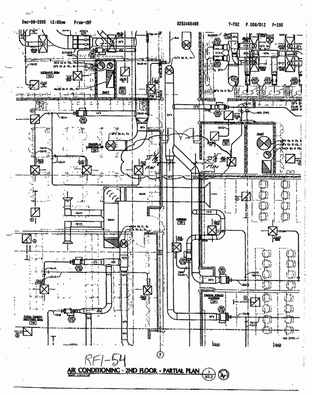



S. J. AMOROSO
Request For Information/Clarification

DSA FILE NO. 7-G1
DSA APPL. No. 01-106226

To: ISP/Architecture, 1000 Burnett Ave, Suite 140, Concord, CA 94520
Project: LOS MEDANOS COLLEGE SCIENCE BUILDING, Contra Costa Community College District
Attn: Celia Chiang, Tom Beckett
Fax: 925-246-6495
ISP job: 20247.00
Subj.: Ductwork Layout Conflicts on Page M2.2 and M2.4
Reference (dwg, spec): M2.2 and M2.4
RFI No: 110
Subcontractor RFI# Monterey 3
Reply Requested By: 2/6/06

INFORMATION REQUESTED: Date: 1/30/06
Please note the attached RFI No. 3 from Monterey Mechanical regarding several conflicts on pages M2.2 and M2.4. Sketches are clouded and numbered per the RFI. Please advise and provide a sketch if necessary.

SUGGESTED SOLUTION:
Cost Impact: ☐ Schedule Impact: ☐ days By: Mark Delgado

RESPONSE: DATE:
Sequence number: 1
Author: Mark
Subject: Note
Date: 2/6/2006 1:49:39 PM
Status: Open Priority: Normal
1. Dip 18" round 6in top of duct and run above 26" round.
2. Protector to be supported by trapeze - see arch. dwgs for details.
3. Provide transition fitting.
4. Recommend shifting diffuser north by 40" to avoid conflict. Also relocate adjacent EA diffuser so that layout is symmetric.
5. Beam penetration to be provided similar to first bays ./.

Note - these items were discussed during the 02/01/06 site meeting. Contractor to show changes in shop drawings.

TRANSMITTAL RECORD:

FROM	TO	DATE
S.J. AMOROSO	ISP / ARCHITECTURE	1/30/06
ISP / ARCHITECTURE	ENGINEER/CANELA TAIAT	
ENGINEER/CONSULTANT	ISP / ARCHITECTURE	
ISP / ARCHITECTURE	S.J. AMOROSO	
S.J. AMOROSO	ORIGINATOR	

RFI # 000
Page 1

MONTEREY MECHANICAL
ENGINEERED COMMUNICATING AIR CONDITIONING
3021 Wilbur Ave, Antioch, CA 94509 ● Phone (925) 757-6400 ● Fax (925) 757-6576

REQUEST FOR INFORMATION

PROJECT: Los Medanos College Science Building

MMC RFI #: 003

SUBJECT: 2nd Floor HVAC Duct Conflicts

DATE REQUESTED: 1/26/06

QUESTION

FROM: Steve Harris-MMC	TO: Mark G. Delgado-SJA	DATE: 1/11/06

Reference Drawings: M2.2, M2.4
Reference Specification: Div 15

While in the process of detailing the ductwork layout with structural, architectural reflected ceiling plan, electrical & plumbing, we have discovered several conflicts on contract drawings: M2.2,M2.4


1. 18" SA duct – interferes with 26" EA duct. Not enough space.
2. Pripeller support bolt interfers with duct.
3. Diameter shows a 22" round duct tapping into the side of a 36"W x 20"h duct.
4. 12"SA duct interferes w/22" SA duct. Not enough space.
5. 10x14 SA duct needs to rise, interferes w/beam & ceiling height. Not enough space.


See the attached (3) sketches. Conflicts are clouded and numbered per the list above.


Please Advise

RESPONSE

FROM:	TO:	DATE:

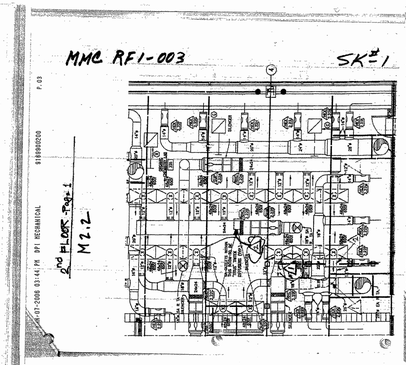

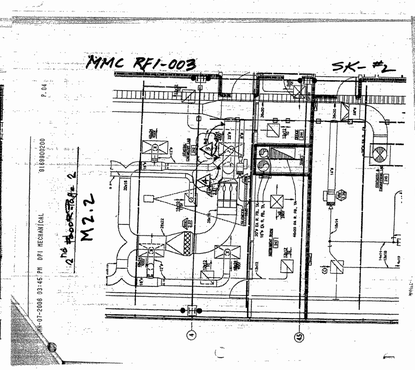

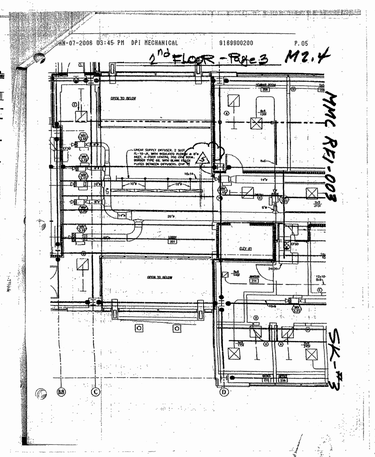


Los Medanos College
4CD Proj. #: L-565-B-23-SC
Science Building

Moved AC-1 to provide clearances from walls at column lines 'F' and '26'.

Moved 18" Ø duct west to allow 36x20 flat oval duct to avoid corridor wall.


Addendum No 1

ADDENDUM #1
DSA FILE # 1-CU
DSA APPL # 01-106226

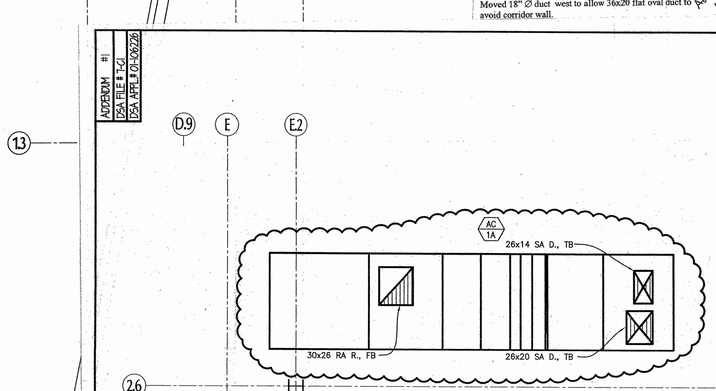

AIR CONDITIONING - 2ND FLOOR - PARTIAL PLAN

SCALE: 1/4"=1'-0"

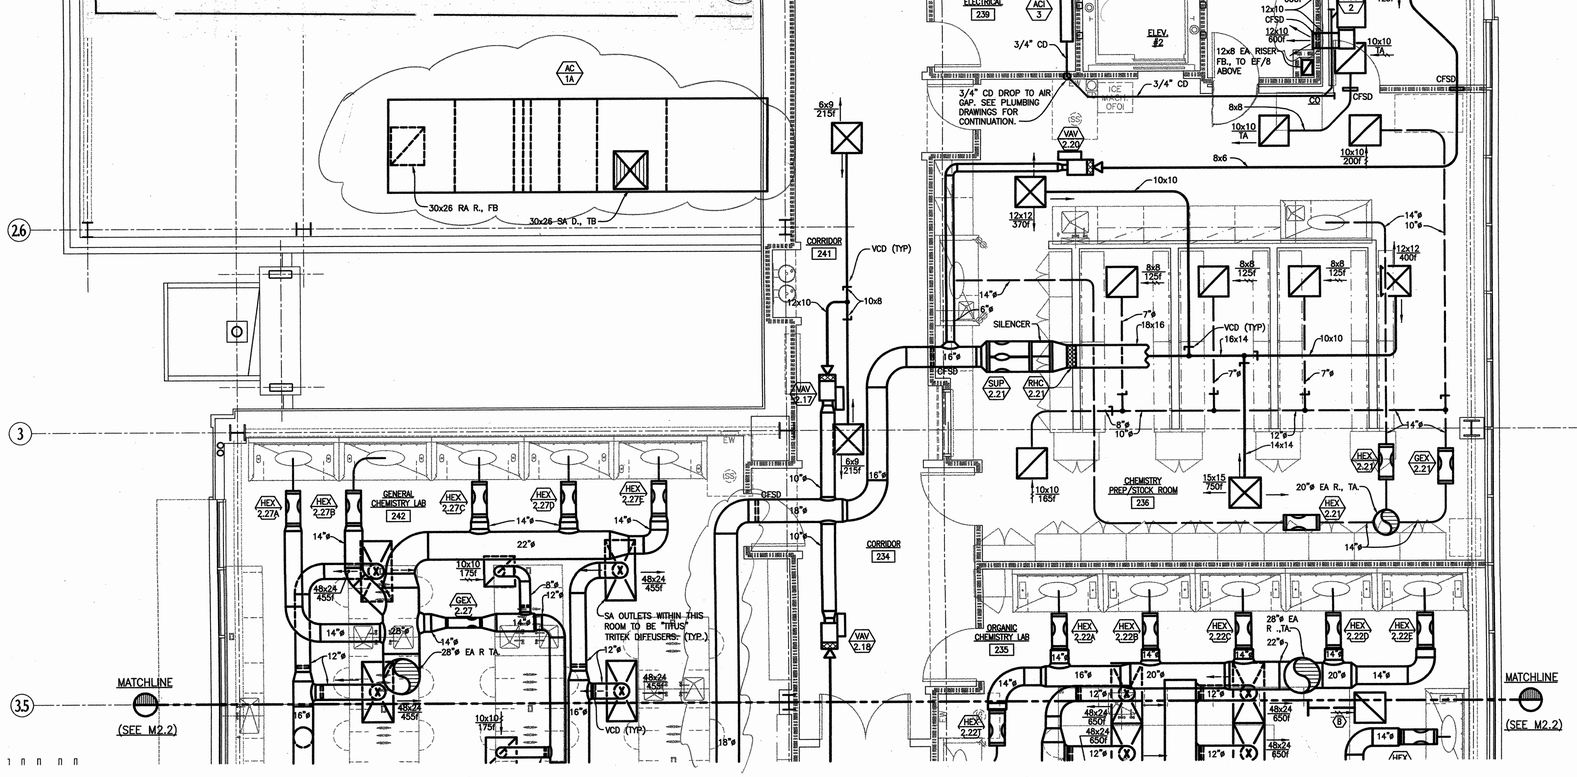


AIR CONDITIONING - 2ND FLOOR - PARTIAL PLAN

SCALE: 1/4"=1'-0"

1 M2.1

ADDENDUM #1
DSA FILE # 1-CU
DSA APPL # 01-106226

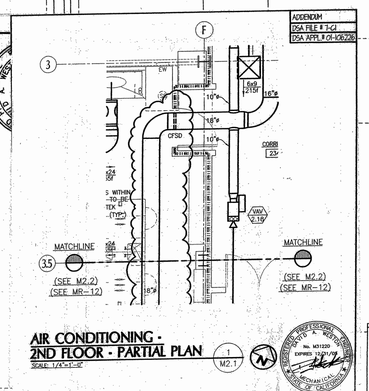

AIR CONDITIONING - 2ND FLOOR - PARTIAL PLAN

SCALE: 1/4"=1'-0"

1 M2.1

ADDENDUM #1
DATE: 03/08/05
DSA NO. 01-106226
THIS REVISES IN PART
SHEET: M2.1
SHEET: MR-11

SCIENCE BUILDING
LOS MEDANOS COLLEGE
Pittsburg CA
Contra Costa Community College District

tBP
architecture
planning
interiors
management
1000 Burnett Avenue, Suite 140
Concord, CA 94520
p: 925.246.6419 f: 925.246.6495

NOTES:

1. ROUTE MEDIUM PRESSURE DUCTWORK THROUGH SMART BEAMS UNLESS NOTED OTHERWISE.
2. MEDIUM PRESSURE DUCTWORK ROUTED BELOW BEAMS.
3. ROUTE DUCTWORK THROUGH SMART BEAMS.

WALL TYPES -

(FOR REFERENCE ONLY. WALL TYPES ON ARCHITECTURAL DRAWINGS SHALL TAKE PRECEDENCE.)


1-HR FIRE RATED ASSEMBLY

1-HR FIRE RATED ASSEMBLY (OCCUPANCY SEPARATION)

2-HR FIRE RATED ASSEMBLY (AT CHEMICAL WASTE STORAGE ONLY)

STUD PARTITION
REFER TO SHEET 4.02 FOR PARTITION TYPES

KEY PLAN

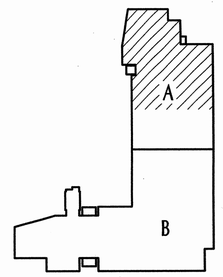

architect

AINSWORTH ASSOCIATES
MECHANICAL ENGINEERS
SACRAMENTO, CA
(25) 2005-008

consultant

DSA IDENTIFICATION STAMP
DIV. OF THE STATE ARCHITECT
OFFICE OF REGIONAL SERVICES
APP. # 01-106226
DATE 3/15/05

name
address
city, state, zip
ph: fx:

agency

owner

SCIENCE BUILDING
LOS MEDANOS COLLEGE
Contra Costa Community College District

tBP project number : 20241.00
file name:
drawn by: checked by:
date: NOVEMBER 15, 2004

Rev:	date:	description:

drawing title:
AIR CONDITIONING - 2ND FLOOR - PARTIAL PLAN

LMC SCIENCE 313-023-112.01-0-00.00
drawing no:
M2.1
drawing of ?

\2025-009\DWG\M2-1-4.dwg Time:Nov/1/2004-09:45pm

AIR CONDITIONING - 2ND FLOOR - PARTIAL PLAN

SCALE: 1/4"=1'-0"

1 / M2.2

MATCHLINE (SEE M2.1)

MATCHLINE (SEE M2.3)

ORGANIC CHEMISTRY LAB 235

GENERAL CHEMISTRY LAB 242

INSTRUMENT ROOM 243

SHAFT

OFFICE 244

STRENGTH & ENGINEERING LAB 245

PHYSICAL SCIENCES PREP/STOCK ROOM 246

CORRIDOR 234

CORRIDOR 227

OFFICE 232

INSTRUMENT ROOM 233

PHYSICAL SCIENCES CLASSROOM 231

PHYSICAL SCIENCES CLASSROOM 230

SA OUTLETS WITHIN THIS ROOM TO BE "TITUS" TRITEK DIFFUSERS (TYP.)

SILENCER

24x20 TRANSFER ABOVE CEILING.

24x20 TRANSFER

HEX 2.22L RFI 558

HEX VALVE SIZE PER RFI 343

RFI 495

RFI 514 SEE CAP. PAGE

Moved 36x20 flat oval duct above General Chemistry Lab 242 to avoid wall at entry to Lab.

Moved 36x20 flat oval duct above General Chemistry Lab 242 to avoid wall at entry to Lab.

Provided combination fire smoke dampers at supply and transfer ducts serving Office 232. Indicated sizes of 12" ø supply air ducts to 48x24 supply air diffusers in Organic Chemistry Lab 235.

Provided bell-mouth size of 18x16 at return air duct above Strength & Engineering Lab 245. Provided bell-mouth size of 18x16 at return air duct above Physical Sciences Prep/Stockroom 246. Provided bell-mouth size of 46x24 at return air duct above Physical Sciences Classroom 231.

ADDENDUM No. 1

WALL TYPES -

(FOR REFERENCE ONLY. WALL TYPES ON ARCHITECTURAL DRAWINGS SHALL TAKE PRECEDENCE.)


1-HR FIRE RATED ASSEMBLY

1-HR FIRE RATED ASSEMBLY (OCCUPANCY SEPARATION)

2-HR FIRE RATED ASSEMBLY (AT CHEMICAL WASTE STORAGE ONLY)

STUD PARTITION
REFER TO SHEET 4.02 FOR PARTITION TYPES

KEY PLAN

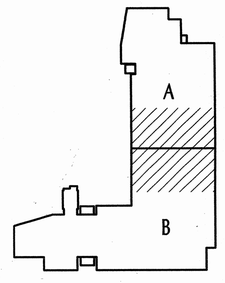

S. J. AMOROSO
Request For Information/Clarification

DSA FILE NO. 7-C1
DSA APPL. No. 01-106226

To: tBP/Architecture, 1000 Burnett Ave, Suite 140, Concord, CA 94520
Attn: Celia Chiang, Tom Beckett
Fax: 925-246-6496
Subj.: Hex valve duct size
Reference (dwg, spec.): M2.1, M2.2
Reply Requested By: 9/14/06

Project: LOS MEDANOS COLLEGE SCIENCE BUILDING, Contra Costa Community College District
tBP p/n: 20247.00
RFI No: 343
Subcontractor RFI: Monterey 14

INFORMATION REQUESTED: Date: 9/7/06

Hex valves 2.22 A thru H, J thru N, P thru T and 2.27 A thru E, located on the second floor do not specify size of duct from valve to hood. Please indicate duct size.

SUGGESTED SOLUTION:
Cost Impact: ☐ Schedule Impact: ☐ days By: Justin Warren

RESPONSE: DATE:
Duct size should be 14" diameter with reduction to hood connection size (if necessary) at hood.

Dave Weston/AMS - 9/8/06

RFI # 000
Page 1

tBP/Architecture
1000 Burnett Avenue, Suite 140
Concord, CA 94520
p: 925.246.6419 f: 925.246.6495

architecture
planning
interiors
management

architect

AINSWORTH ASSOCIATES
MECHANICAL ENGINEERS
SACRAMENTO, CA

consultant

DIVISION OF THE STATE ARCHITECT
OFFICE OF REGULATION SERVICES
APP. - 0010620
ACCEPTED
DATE 1-10-07

name
address
city, state, zip
ph
fx

agency

SCIENCE BUILDING
LOS MEDANOS COLLEGE

Contra Costa Community College District

owner

tBP project number : 20247.00
file name:
drawn by: checked by:
date: NOVEMBER 15, 2004

Rev.	date:	description:

drawing title:
AIR CONDITIONING - 2ND FLOOR - PARTIAL PLAN

LMC SCIENCE 313-023-T12.01-0-00.00
drawing no.: **M2.2**
drawing of ?

\\2003-023\DWG\M-21-1.dwg Time:Nov/1,2004-03:46pm

S. J. AMOROSO
Request For Information/Clarification

DSA FILE NO. 7-C1
DSA APPL. No. 01-106226

To: tBP/Architecture
1000 Burnett Ave, Suite 140
Concord, CA 94520

Attn: Celia Chiang, Tom Beckett
Fax: 925-246-6495

Project: LOS MEDANOS COLLEGE
SCIENCE BUILDING
Contra Costa Community College District

tBP p/n: 20247.00

Subj.: Brace in Room 203 along 8.5 Line

RFI No: **433**

Reference (dwg, spec.): Attached Sketch

Subcontractor RFI:

Reply Requested By: 12/11/06

INFORMATION REQUESTED: **Date:** 12/4/06

Please note the attached Sketch regarding the brace for Room 203 along 8.5 Line. SJA proposes to relocate the brace up to 24" up vertical stub in lieu of 12" per plan due to Ductwork and Fire sprinkler piping. Please advise.

SUGGESTED SOLUTION:

Cost Impact: ☐ **Schedule Impact:** ☐ **days** **By:** Mark Delgado

RESPONSE: **DATE:**


Structural approval will not be granted by DSA for this approach. Per discussion with M.E. at jobwalk 12/5/06, duct is to be transitioned up to allow bracing to be installed within lower 12" of soffit drop. No cost to owner.

Tom Beckett / tBP Architecture

12/6/06

RFI # 000
Page 1

Los Medanos College
4CD Proj. #: L-565-B-23-SC
Science Building

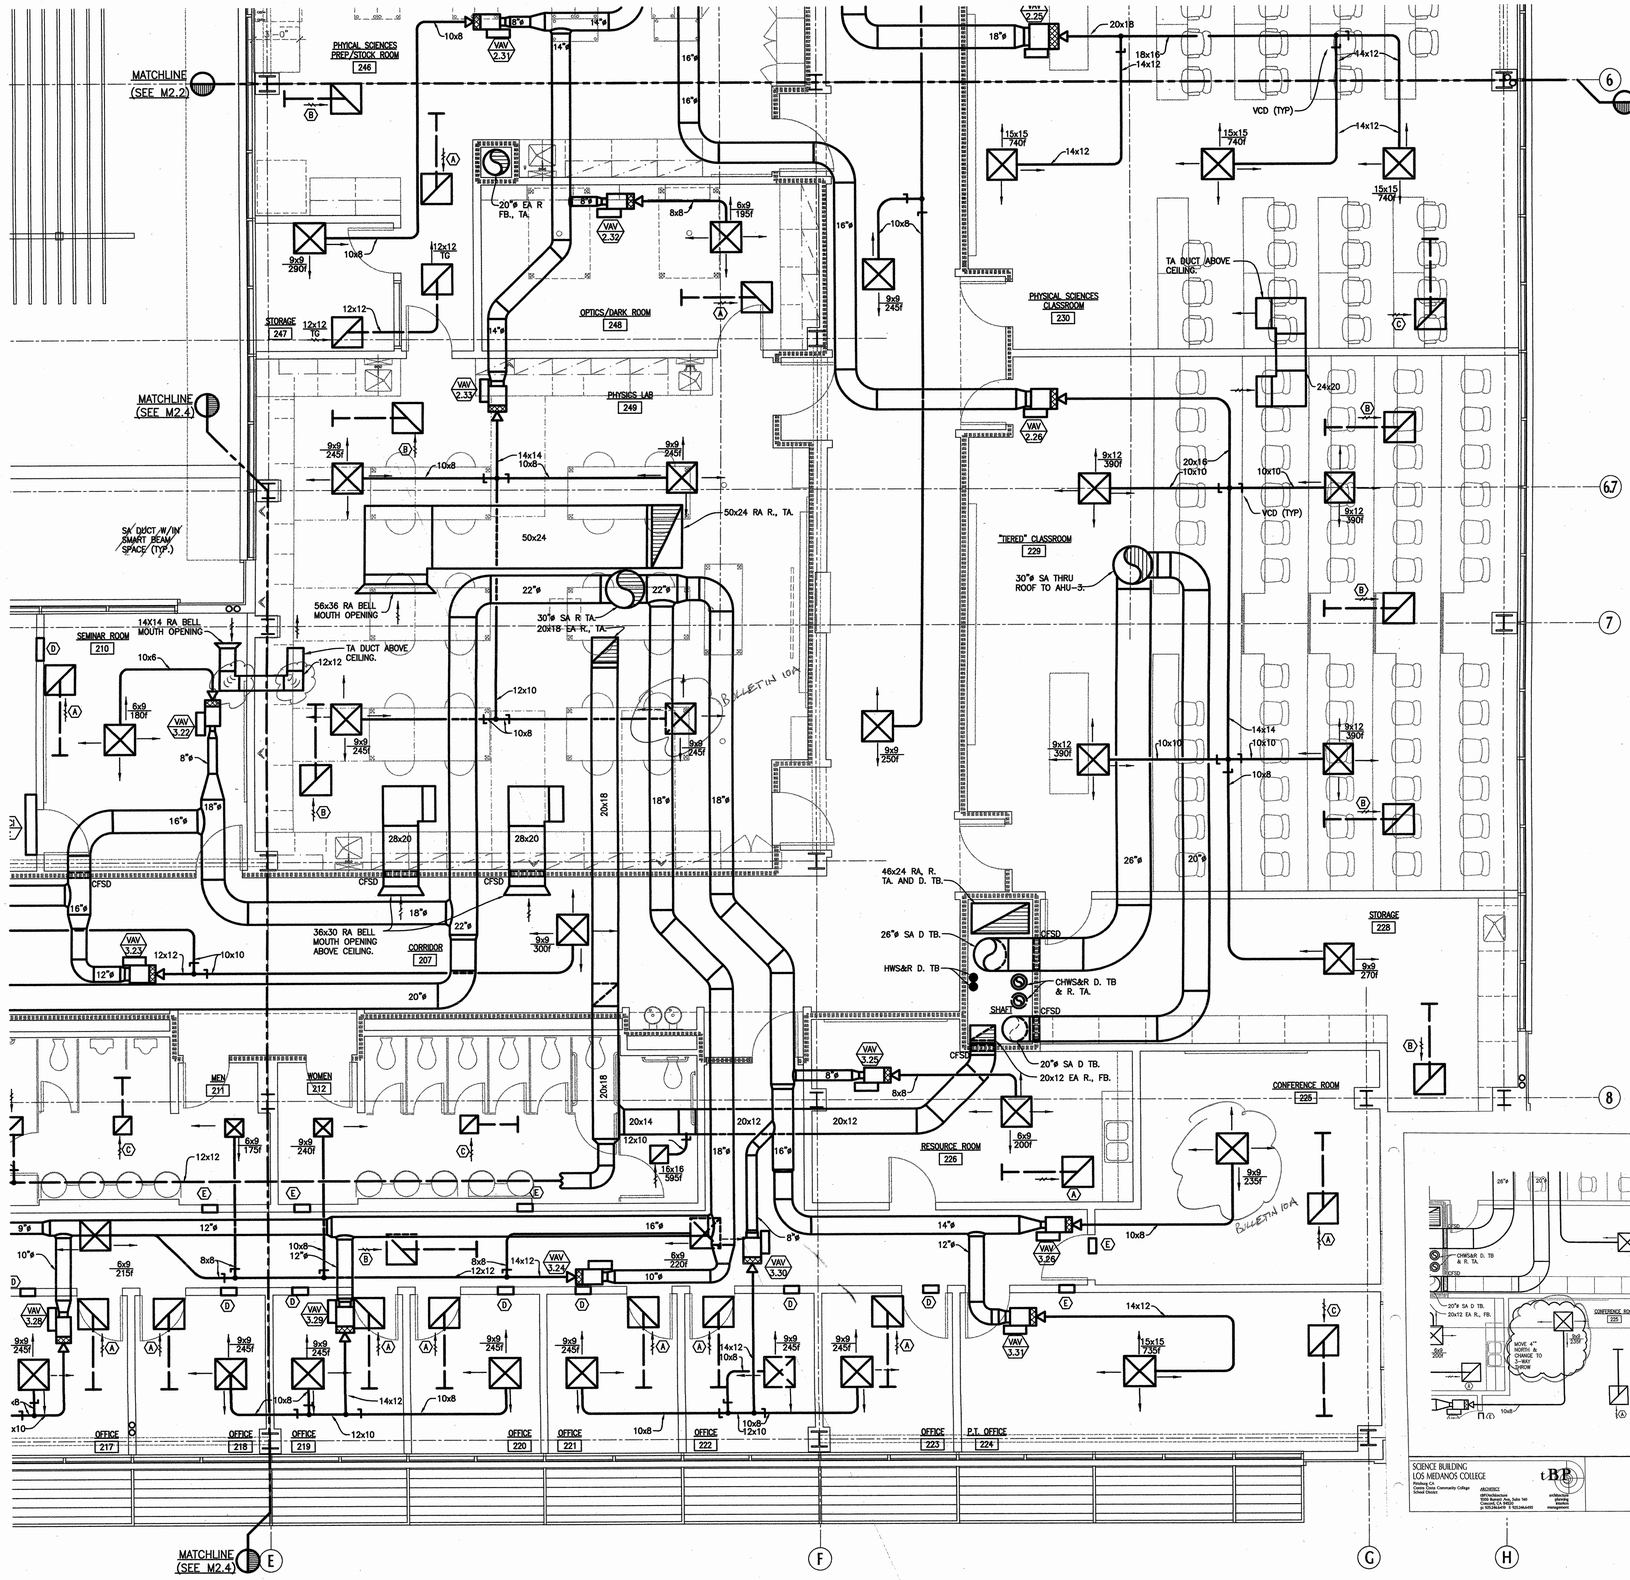

AIR CONDITIONING - 2ND FLOOR - PARTIAL PLAN

SCALE: 1/4"=1'-0"

1 / M2.3

WALL TYPES - (FOR REFERENCE ONLY. WALL TYPES ON ARCHITECTURAL DRAWINGS SHALL TAKE PRECEDENCE.)

1HR FIRE RATED ASSEMBLY

RATED ASSEMBLY

ANCY SEPARATION)

E RATED ASSEMBLY

ICAL WASTE STORAGE ONLY)

RTITION

D SHEET 4.02 FOR PARTITION TYPES

Removed unnecessary note "SA DUCT W/ IN SMART BEAM (TYP.)" above Seminar Room 210 and to the left of Physics Lab 249. Addendum #1

ADDENDUM
DSA FILE # 7-C1
DSA APPL # 09-106226

AIR CONDITIONING - 2ND FLOOR - PARTIAL PLAN
SCALE: 1/4"=1'-0" 1 / M2.3

SCIENCE BUILDING
LOS MEDANOS COLLEGE
Pittsburg CA
Contra Costa Community College School District
ARCHITECT
tBP/Architecture
1000 Burnett Ave, Suite 140
Concord, CA 94520
p: 925.246.6419 f: 925.246.6495
architecture planning interiors management

ADDENDUM #1
DATE: 09/06/05
DSA NO. 09-106226
THIS REVISES IN PART
SHEET: M2.3
SHEET: MR-16

BULLETIN #10A
DSA FILE # 7-C1
DSA APPL # 09-106226
DATE: 05/15/06
DSA NO. 09-106226
THIS REVISES IN PART
SHEET: M2.3
SHEET: SKH-10A

tBP
architecture
planning
interiors
management

tBP/Architecture
1000 Burnett Avenue, Suite 140
Concord, CA 94520
p: 925.246.6419 f: 925.246.6495

architect

AINSWORTH ASSOCIATES
MECHANICAL ENGINEERS
SACRAMENTO, CA
916.363.9126

consultant

name
address
city, state, zip
ph:
fx:

agency

SCIENCE BUILDING
LOS MEDANOS COLLEGE

Contra Costa Community College District

owner

tBP project number : 2024.00
file name:
drawn by: checked by:
date: NOVEMBER 15, 2004


Rev:	date:	description:

drawing title:
AIR CONDITIONING - 2ND FLOOR - PARTIAL PLAN

LMC SCIENCE 313-023-T12.01-0-00.00
drawing no.:
M2.3
drawing of ?

I:\2003\03-023\DWG\M2-2.1-4.dwg Time:Nov/1,2004-05:40pm

ADDENDUM #1
DSA FILE # 7-C1
DSA APPL # 01-106226

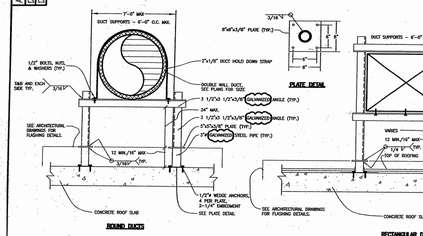

DUCT SUPPORT ON ROOF DETAIL

3 / M3.1

BIG SCALE
NOTES:
1. REFER TO STRUCTURAL DRAWINGS FOR ANCHOR BOLT MINIMUM EMBEDMENT, CONCRETE AND STEEL REQUIREMENTS.
2. REFER TO ARCHITECTURAL DRAWINGS & SPECIFICATIONS FOR THROUGH ROOF PENETRATION FLASHING DETAILS, REQUIREMENTS.

SCIENCE BUILDING
LOS MEDANOS COLLEGE
Pittsburg, CA
Contra Costa Community College School District

ARCHITECT
tBP/Architecture
1000 Burnett Ave, Suite 140
Concord, CA 94520
p: 925.246.6491 f: 925.246.6495

tBP architecture planning interiors management

ADDENDUM #1
DATE: 03/06/06
DSA NO. 01-106226
THIS REVISES IN PART
SHEET: M3.1
SHEET: MR-18

S. J. AMOROSO
Request For Information/Clarification

DSA FILE NO. 7-C1
DSA APPL. No. 01-106226

To: tBP/Architecture, 1000 Burnett Ave, Suite 140, Concord, CA 94520
Project: LOS MEDANOS COLLEGE, SCIENCE BUILDING, Contra Costa Community College District
Attn: Celia Chiang, Tom Beckett
Fax: 925-246-6495
tBP p/n: 20247.00
Subj.: Orientation of ACO 1, 2, 3 and 4
RFI No: **362** Subcontractor RFI
Reference (dwg, spec.): M3-1
Reply Requested By: 9/29/06


INFORMATION REQUESTED: Date: 9/28/06
HOT HOT HOT
Per roof plan on sheet M3.1 (as well as Addendum no. 1 which added AC) #) the orientation of ACO's 1, 2, 3 and 4 are shown. We would like to rotate each of these units 90 degrees from that shown on the plans. Rotating the units in the manner will present to shortest possible dimension of the unit supports to the flow of water running along the roof. This allows for a more prudent roofing scenario. Please advise if this is acceptable.

SUGGESTED SOLUTION:
Cost Impact: ☐ Schedule Impact: ☐ days By: Mark Delgado

RESPONSE: DATE:
From a mechanical viewpoint, the orientation of the ACUs is not critical and can be shifted and/or rotated. Contractor to maintain clearance between units as recommended by the manufacturer and keep units a minimum of 4'-0" from perapet wall.

Dave Weston/AAHE - 9/28/06

RFI # 000
Page 1

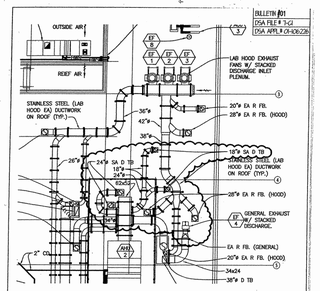

AIR CONDITIONING - PARTIAL ROOF PLAN

1 / M3.1

SCALE: 1/16"=1'-0"

BULLETIN #01


SCIENCE BUILDING
LOS MEDANOS COLLEGE
Pittsburg, CA
Contra Costa Community College School District

ARCHITECT
tBP/Architecture
1000 Burnett Ave, Suite 140
Concord, CA 94520
p: 925.246.6491 f: 925.246.6495

tBP architecture planning interiors management

BULLETIN #01
DATE: 1/04/06
DSA NO. 01-106226
THIS REVISES IN PART
SHEET: M3.1
SHEET: SK01-01

ADDENDUM #1
DSA FILE # 7-C1
DSA APPL # 01-106226

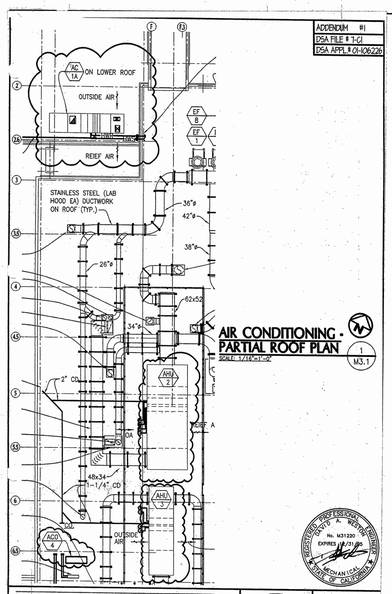

AIR CONDITIONING - PARTIAL ROOF PLAN

M3.1

SCALE: 1/16"=1'-0"

REGISTERED PROFESSIONAL ENGINEER — No. M31220 — EXPIRES 12-31-2007 — MECHANICAL — STATE OF CALIFORNIA

SCIENCE BUILDING
LOS MEDANOS COLLEGE
Pittsburg, CA
Contra Costa Community College School District

ARCHITECT
tBP/Architecture
1000 Burnett Ave, Suite 140
Concord, CA 94520
p: 925.246.6491 f: 925.246.6495

tBP architecture planning interiors management

REGISTERED ARCHITECT — No. C-9466 — 12-31-2007 — CALIFORNIA

ADDENDUM #1
DATE: 03/06/06
DSA NO. 01-106226
THIS REVISES IN PART
SHEET: M3.1
SHEET: MR-18

S. J. AMOROSO
Request For Information/Clarification

DSA FILE NO. 7-C1
DSA APPL. No. 01-106226

To: tBP/Architecture, 1000 Burnett Ave, Suite 140, Concord, CA 94520
Project: LOS MEDANOS COLLEGE, SCIENCE BUILDING, Contra Costa Community College District
Attn: Celia Chiang, Tom Beckett
Fax: 925-246-6495
tBP p/n: 20247.00
Subj.: VFD Locations
RFI No: **266** (REVISED 07/13/06)
Subcontractor RFI: EWS 23
Reference (dwg, spec.): EF-1, EF-2, EF-3, EF-7
Reply Requested By: 7/5/06

INFORMATION REQUESTED: Date: 6/27/06
Please note the attached Edward Scott Electric RFI No. 23 regarding the VFD Locations for EF-1, EF-2, EF-3 and EF-7. Please advise.

SUGGESTED SOLUTION:
Cost Impact: ☐ Schedule Impact: ☐ days By: Justin Warren

RESPONSE: DATE:
Response by TWP: Per the mechanical consultant's input, the 'VFD' for 'EF-1' and 'EF-3' will be located on the roof at the fan units. (See the following response by AAHE for locations.) The electrical connection will be a single point connection to the 'VFD'. Combination magnetic starter/disconnect switch (shown on contract electrical drawings) 'EF-1', and 'EF-2' should be deleted. Per mechanical consultant, 'EF-3' does not have a 'VFD', therefore 'EF-3' shall be connected to a combination motor starter/disconnect switch as shown on contract electrical drawings. SOUTH OF WEST Per mechanical consultant, 'EF-7' has a 'VFD' and shall be located on the ~~west~~ wall adjacent to the ~~fancoil~~ room. Starter for 'EF-7' in 'MCC-CB' shall be deleted. Larry Lai/TWP 7/12/06
CHIANG.

Response by AAHE:
Locate VFDs as follows:
EF-1 and EF-3's VFD is to be mounted on the roof adjacent to the fan. Note that per discussions with Fan Representative, a unistrut stand and NEMA 3 enclosure are to be provided.
EF-3 - per Contract Documents - no VFD. Needs starter. Note that this fan is back-up fan in case either EF-1 or EF-3 fails.
EF-7 - Mount on wall in chiller room - Recommended location is on west wall. Locate south of CHWV/1. Note that exact location is not important. Field coordinate exact location between electrical and mechanical sub-contractor.
Dave Weston/AAHE 7/12/06

RFI # 000
Page 1

EDWARD W. SCOTT ELECTRIC CO., INC.
435 HARRIET STREET
San Francisco, CA 94103-4914
Phone: (415) 626-0701 Fax: (415) 626-2837

REQUEST FOR INFORMATION

PROJECT: SCIENCE BLDG. LMC R.F.I.# 23 R.F.I. Date 6/27/06
JOB: 2951 ACTUAL REPLY DATE

TO: MARK DELGADO
CO: AMOROSO CONST.
REF/DWG: MOUNTING DETAILS
LOCATION: VARIOUS

POTENTIAL COST IMPACT
___ COST ___ SCHEDULE
___ OTHER ___ LABOR
___ NO IMPACT ___ MATERIAL

INFORMATION REQUESTED: WE ARE UNABLE TO FIND THE VFD LOCATIONS FOR EF-1, EF-2, EF-3 OR EF-7 (LOCATED IN CHILLER PUMP AREA). PLEASE ADVISE.

REPLY REQUIRED BY: SIGNED:
NOTE: IF NO REPLY IS RECEIVED BY US BY THE ABOVE NOTED DATE, A TIME EXTENSION WILL BE REQUIRED WITH POSSIBLE COST IMPACTS.

RESPONSE:

DATED: SIGNED:

S. J. AMOROSO
Request For Information/Clarification

DSA FILE NO. 7-C1
DSA APPL. No. 01-106226

To: tBP/Architecture, 1000 Burnett Ave, Suite 140, Concord, CA 94520
Project: LOS MEDANOS COLLEGE, SCIENCE BUILDING, Contra Costa Community College District
Attn: Celia Chiang, Tom Beckett
Fax: 925-246-6495
tBP p/n: 20247.00
Subj.: Relocating AHU-2 to the west
RFI No: **140** Subcontractor RFI#
Reference (dwg, spec): M3-1, B2.3.2
Reply Requested By: 2/10/06

INFORMATION REQUESTED: Date: 2/6/06
This RFI is written to confirm various conversations that have been held over the last few days regarding relocating AHU-2 to the west (The north AHU on the high roof). This decision is a result of having according to Kone the wrong roof curb supplied. The curb supplied is not required for 2" floor above-ceiling MEP. The new location of AHU-2 is to relocate the western "edge" of the equipment so that it is centered over F-line W24 beams, a move of approximately 1'-6" to the west. The W13 beams at approximately F-4 line would shift west an equal distance to provide support for the eastern "edge" of the AHU. The screen wall will remain in the location shown on the drawings (see M4.4). The new location of AHU-2 will require the removal of a hat AHU which will now be directly over a door above below. This challenge will have to be resolved with the involvement of both the mechanical engineer and the mechanical contractor. However, this is the only challenge we foresee at this time. This concept has been discussed amongst the following parties: tBP, Dasse, Ainsworth, SJA, Roscoe and Monterey. Please confirm.

SUGGESTED SOLUTION:
Cost Impact: ☐ Schedule Impact: ☐ days By: Mark Delgado

RESPONSE: DATE: 2-15-06
SEE ATTACHED MEP2 RESPONSE

Attachments:
By: C-CHIANG/tBP

TRANSMITTAL RECORD:

FROM	TO	DATE
S.J. AMOROSO	tBP / ARCHITECTURE	2/6/06
tBP / ARCHITECTURE	ENGINEER/CONSULTANT	2/6/06
ENGINEER/CONSULTANT	tBP / ARCHITECTURE	2-13-06
tBP / ARCHITECTURE	S.J. AMOROSO	2-15-06

RFI # 000
Page 1

Project Memorandum

tBP Architecture Planning Interiors Management

Date: 02/13/2006
To: S.J. Amoroso
390 Bridge Parkway
Redwood Shores CA 94065
Attn: Mark Delgado
Proj: LOS MEDANOS COLLEGE SCIENCE BUILDING
Contra Costa Community College District
Proj No.: 20247.0007.4
DSA No.: 01-106226; File # 7-C1
From: Celia Chiang, tBP/Architecture
cc: T. Beckett, B. Hiebe, C. Perrotta, file

RESPONSE TO RFI #140 – PROPOSED RELOCATION OF AHU-2

The structural engineer, mechanical engineer and Architect have reviewed this RFI regarding the proposed relocation of AHU-2.

Responses are as follows:

DASSE: Relocation of AHU-2 is structurally acceptable.

AAME: Conversations with M. Delgado of SJA are confirmed. Shift of AHU and associated piping appear to be acceptable.

Actual routing of piping to be indicated within shop drawings for review. A complete review can not be done until the AHU is submitted.

Routing shown on M4.4 in door above can be relocated if necessary. Since AHU is a custom unit, it may be possible to locate pipe drop thru roof on east side of unit.

tBP: We take no exception to the proposed relocation of the AHU, provided the following items are coordinated:

- Provide credit for deletion of W12X14 previously supporting west edge of AHU-2
- Roof penetrations for pipe drops may require reinforcement at deck openings per details 9, 10, 11/S7.3. Multiple deck openings shall be located per sheet note 10 on S7.3
- Although there may be no impact to location of vertical supports at screen wall, duct openings through screen wall are to be coordinated with location of vertical supports.
- Location of Mechanical Equipment Curb at AHU-2 per detail 4/7.03 as noted on A0-7 Roof Horizontal Control plan shall be revised. SJA to issue confirmation RFI noting revised dimensions based on relocation of unit and size of unit per AHU submittal.

1000 Burnett Avenue, Suite 140 • Concord, CA 94520-2258 • Phone: (925) 246-6419 • Fax: (925) 246-6495

S. J. AMOROSO
Request For Information/Clarification

DSA FILE NO. 7-C1
DSA APPL. No. 01-106226

To: tBP/Architecture, 1000 Burnett Ave, Suite 140, Concord, CA 94520
Project: LOS MEDANOS COLLEGE, SCIENCE BUILDING, Contra Costa Community College District, DWSU
Attn: Celia Chiang, Tom Beckett
Fax: 925-246-6495
tBP p/n: 20247.00
Subj.: Rooftop unit BAS cut-ins
RFI No: **460** Subcontractor RFI: Mattis 8
Reference (dwg, spec.):
Reply Requested By: 1/11/07

INFORMATION REQUESTED: Date: 1/4/07
See attached Mattis RFI No. 8 regarding blanked holes in the rooftop AHUs for BAS power. Please confirm that this is acceptable.

SUGGESTED SOLUTION:
Cost Impact: ☐ Schedule Impact: ☐ days By: Bryan Newman

RESPONSE: DATE:

Recommend the following actions:

1. Mechanical Contractor to have AHU representative (Norman Wright) to visit site and verify field conditions as Conduit was to be provided.

2. Commair recommendations appear acceptable if confirmed by Norman Wright.

3. It is AAME's opinion that no added cost should occur to the project based on this RFI.

David Weston / Ainsworth Associates
Jim Weaver / tBP Architecture

1/23/07

RFI # 000
Page 1

CommAir
1301 Shary Circle # 15
Concord, California 94518
(925) 771(0244 / fax (925) 685-5209

REQUEST FOR I/NFORMATION

DATE 01/05/2007 RFI# 0044
JOB NO 667/000018 BY Chris Olvera
PROJECT LMC Science

TO: Monterey Mechanical
3665 Vilbur Ave
Antioch, CA 94509
925-757-4640 Fax 757-0574
ATTN: Dan Riedmiller

DIST

Title or Section of Work: Rooftop Unit BAS Cut-ins

Drawing Location	Specification Location
Cost Impact ☐ Yes ☐ No Estimate	
Time Impact ☐ Yes ☐ No Estimate	

Description of Problem / Attach sketches as required
1) After a review of the AHUs and the rooftop AC units it was noted that the factory did not install a conduit run or raceway to get 110V power to the factory mounted BAS controller panels. In at least one instance these factory mounted enclosure are recessed into the unit and no available space outside the panel to run conduit for the 110V power.
2) There is no installed conduit or access point into the units to complete the Infinet wire (communications bus) to the Andover Control module.


Response Requested By: Christopher J. Olvera – (510) 772-9340
Proposed Solution:
1) - Therefore we will need to drill a hole inside of the factory installed panel and route to the available 110V power source.
2) - We will need to drill a second hole into the units to get the Infinet wire (communication bus) into the Andover control module.
Note: These openings will be sealed with appropriate conduit connections.

Signed	Christopher J. Olvera
Organization	Carrier
Date	01/05/2007
Distribution	☐ Architect ☐ Super ☐ Mech. Eng ☐ Elec. Eng. ☐ Owner ☐

Los Medanos College
4CD Proj. #: L-565-B-23-SC
Science Building

ADDENDUM
DSA FILE # 1-C
DSA APPL # 01-106226

ELEV #1

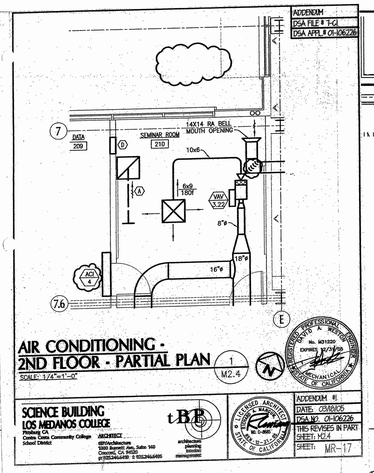

AIR CONDITIONING - 2ND FLOOR - PARTIAL PLAN (1 / M2.4)
SCALE: 1/4"=1'-0"

SCIENCE BUILDING
LOS MEDANOS COLLEGE
Pittsburg, CA
Contra Costa Community College District

ARCHITECT
tBP/Architecture
1000 Bunett Avenue, Suite 140
Concord, CA 94520
p: 925.246.6419 f: 925.246.6495

ADDENDUM #1
DATE: 05/06/05
DSA NO. 01-106226
THIS REVISED IN PART
SHEET: M2.4
SHEET: MR-17

AIR CONDITIONING - 2ND FLOOR - PARTIAL PLAN (1 / M2.4)
SCALE: 1/4"=1'-0"

WALL TYPES

(FOR REFERENCE ONLY. WALL TYPES ON ARCHITECTURAL DRAWINGS SHALL TAKE PRECEDENCE.)


1-HR FIRE RATED ASSEMBLY

1-HR FIRE RATED ASSEMBLY (OCCUPANCY SEPARATION)

2-HR FIRE RATED ASSEMBLY (AT CHEMICAL WASTE STORAGE ONLY)

STUD PARTITION
REFER TO SHEET 4.02 FOR PARTITION TYPES

KEY PLAN

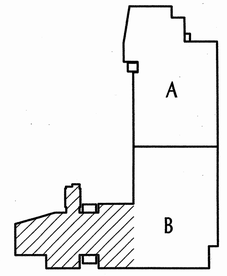

tBP architecture planning interiors management

architect

AINSWORTH ASSOCIATES
MECHANICAL ENGINEERS
SACRAMENTO, CA
LPS 2028-2028

consultant

DSA approved
name
address
city, state, zip
ph

agency

owner


tBP project number : 20241.00
file name:
drawn by: checked by:
date: NOVEMBER 15, 2004

Rev:	date:	description:

drawing title:
AIR CONDITIONING - 2ND FLOOR - PARTIAL PLAN

LMC SCIENCE 313-023-T12.01-0-00.00
drawing no:
M2.4
drawing of ?

\\2023-023\DWG\M2.4-2nd Floor Plan.dwg Thursday, November 21, 2024 - 4:46pm

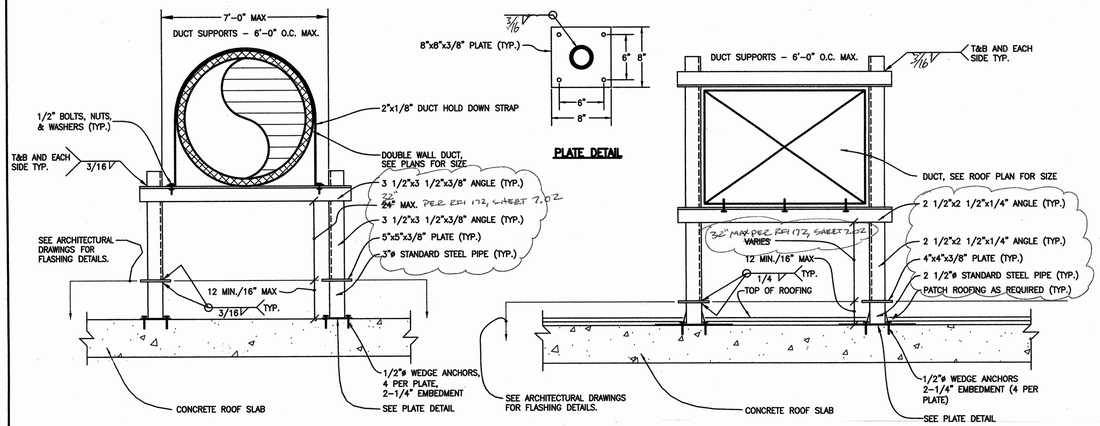


DUCT SUPPORT ON ROOF DETAIL

3 / M3.1

NO SCALE

NOTES:
1. REFER TO STRUCTURAL DRAWINGS FOR ANCHOR BOLT MINIMUM EMBEDMENT, DIAMETER, AND TESTING REQUIREMENTS.

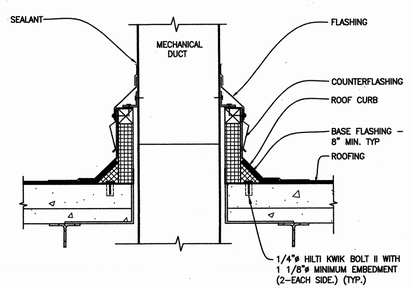


DUCT THROUGH ROOF AT ROOF CURB


2 / M3.1

NO SCALE

NOTES:
1. PROVIDE SLOPED ROOF CURB AS REQUIRED TO LEVEL AC UNITS.
2. SEE DETAIL 19 SHEET 7.01 FOR INSTALLATION DETAILS.

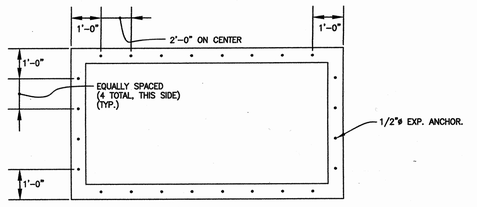


MOUNTING CLIPS LAYOUT PLAN. N.T.S.

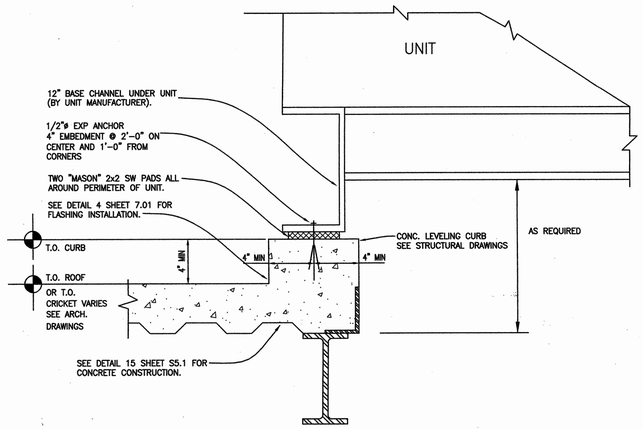

AIR HANDLING UNIT MOUNTING DETAIL

4 / M3.1

NO SCALE

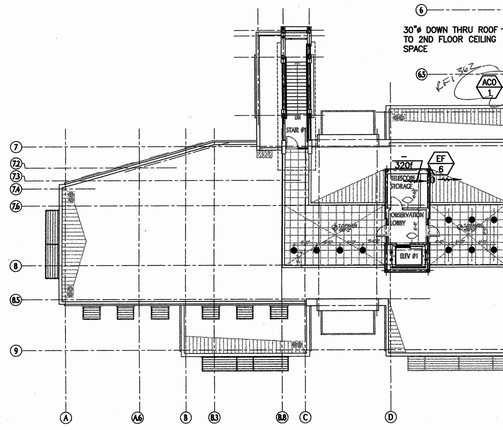

AIR CONDITIONING - ROOF PLAN


1 / M3.1

SCALE: 1/16"=1'-0"

Revised AC/1A, AHU-2 and AHU-3 sizes at "Air Conditioning – Roof Plan" 1/M3.1. Moved AC/1A to provided clearances from parapet and building walls at "Air Conditioning – Roof Plan" 1/M3.1. Added ACO/4 next to ACO/1 at "Air Conditioning – Roof Plan" 1/M3.1.

Revised support steel at "Duct Support on Roof Detail" 3/M3.1 to galvanized. Added note "2. Refer to Architectural drawings and specifications for painting galvanized steel when galvanized coating is damaged during installation".


ADDENDUM #1

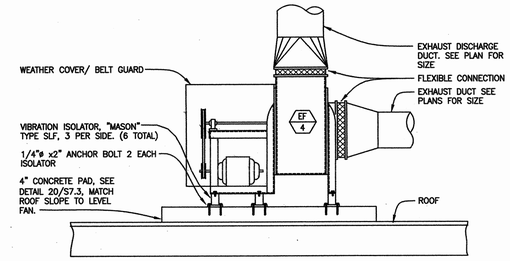

EXHAUST FAN MOUNTING DETAIL

6 / M3.1


NO SCALE:

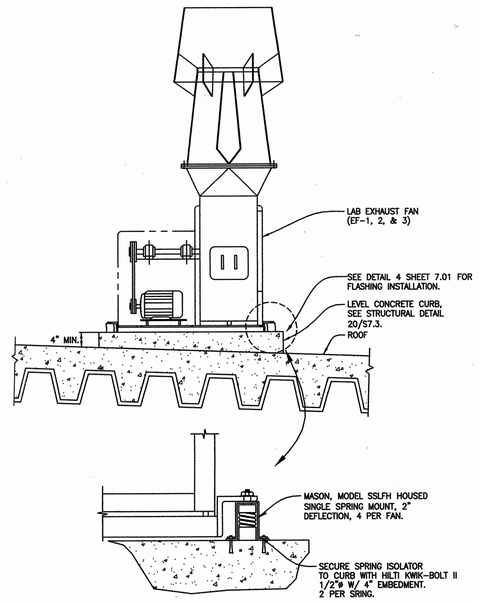

LAB EXHAUST FAN MOUNTING DETAIL

5 / M3.1


NO SCALE:

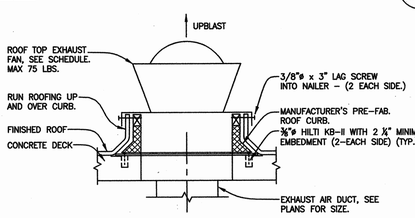

ROOF TOP EXHAUST FAN DETAIL

7 / M3.1

NO SCALE:

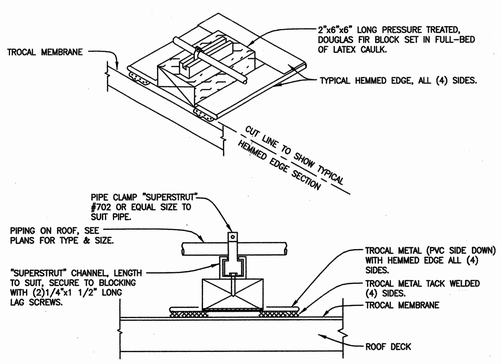


PIPE SUPPORT ON ROOF

8 / M3.1

NO SCALE:

NOTE: 1. PROVIDE CODE REQUIRED PITCH IN PIPING SYSTEM, WHERE APPLICABLE, BY VARYING BLOCK HEIGHT (2"MIN.) OR CHANNEL HEIGHT.

KEY PLAN

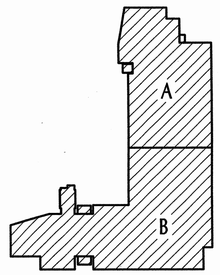

tBP architecture planning interiors management
tBP/Architecture
1000 Burnett Avenue, Suite 140
Concord, CA 94520
p: 925.246.6419 f: 925.246.6495
architect

AINSWORTH ASSOCIATES
MECHANICAL ENGINEERS
SACRAMENTO, CA
(25-2005-026)
consultant

name
address
city, state, zip
ph: fx:
agency

SCIENCE BUILDING
LOS MEDANOS COLLEGE

Contra Costa Community College District

owner

tBP project number : 202417.00

file name:

drawn by: checked by:

date: NOVEMBER 15, 2004

Rev:	date:	description:

drawing title:
AIR CONDITIONING - ROOF PLAN

LMC SCIENCE 313-023-112.01-0-00.00

drawing no:
M3.1
drawing of ?

\2003-0078\M3-1.dwg Time:Nov/1/2004-03:4:47pm

SCIENCE BUILDING
LOS MEDANOS COLLEGE

Contra Costa Community College District

owner

tBP project number : 2004100

file name:

drawn by: checked by:

date: NOVEMBER 15, 2004

ltr date description

drawing title:
HYDRONICS - FIRST FLOOR PARTIAL PLAN

LMC SCIENCE 313-023-1T2.01-0-00.00
drawing no: **M4.1**
drawing of ?

agency

name
address
city, state, zip
ph# fx

DEMOLITION STAMP
DSA OF THE STATE ARCHITECT
OFFICE OF REGULATION SERVICES
APPL. 01-108529
REVIEWED FOR
DATE 5-15-05

consultant

AINSWORTH ASSOCIATES
MECHANICAL ENGINEERS
SACRAMENTO, CA

LICENSED ARCHITECT
STATE OF CALIFORNIA
RENEWAL 08/31/2005
EXPIRES 12/31/09


JOB: 2003-003


architect

tBP/Architecture
1000 Burnett Avenue, Suite 140
Concord, CA 94520
p: 925.246.6419 f: 925.246.6495

architecture
planning
interiors
management

KEY PLAN

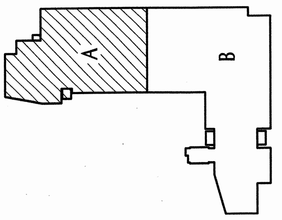

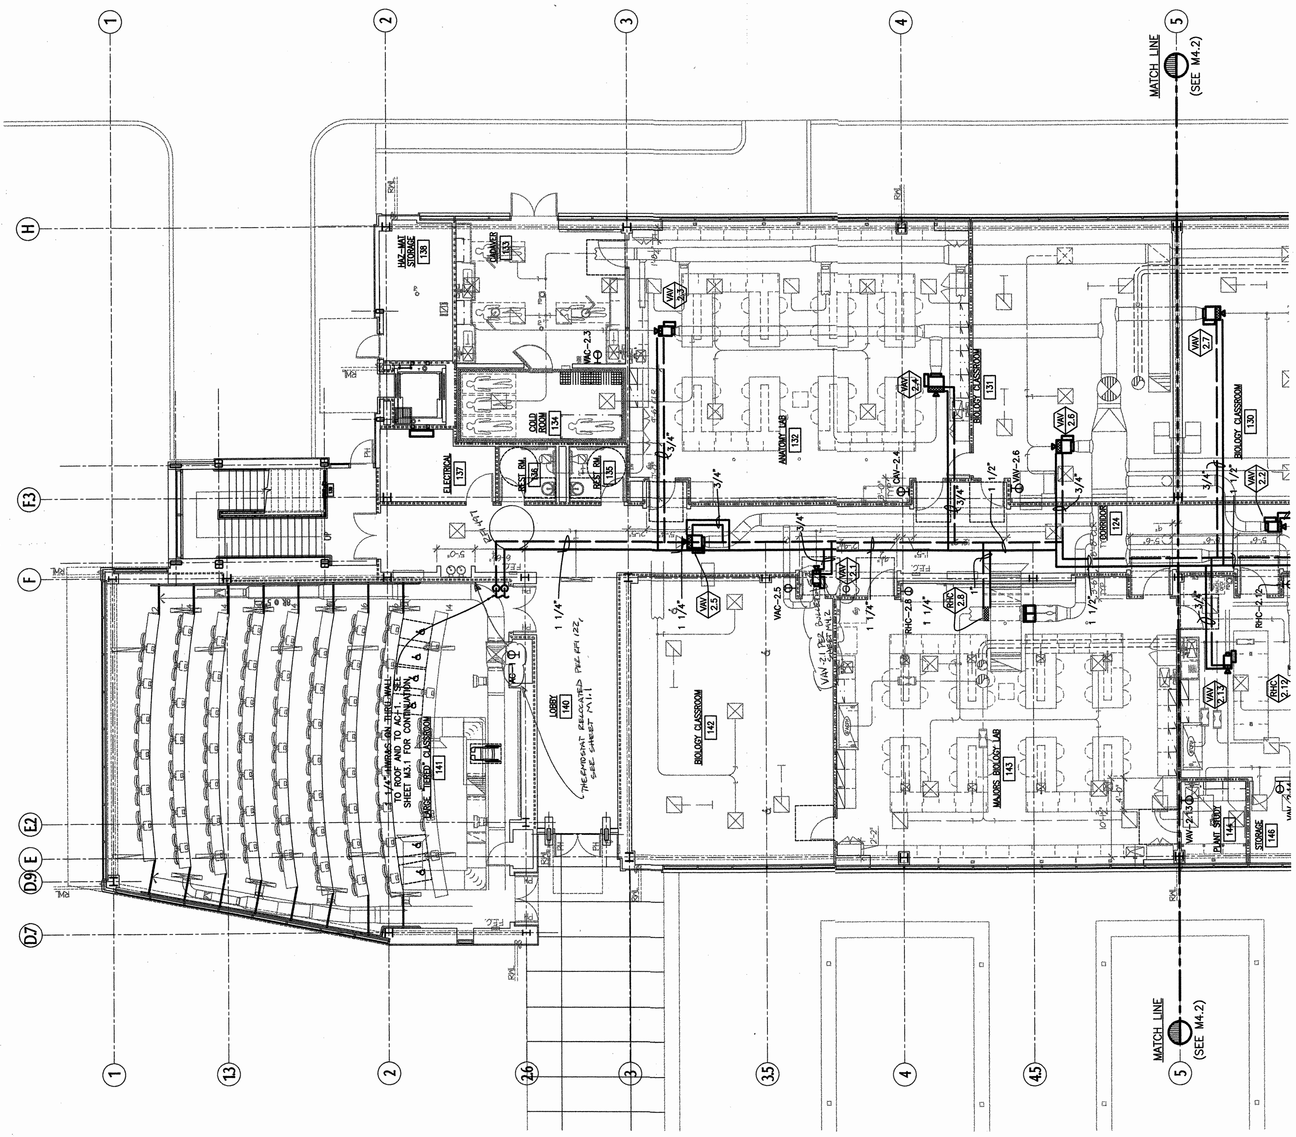

HYDRONICS - FIRST FLOOR PARTIAL PLAN

SCALE: 1/4"=1'-0"

1 M4.1

\2003-003\DWG\M4-1.dwg Time:Mon\2004-03-4?pm

S. J. AMOROSO
Request For Information/Clarification

DSA FILE NO. 7-C1
DSA APPL. No. 01-106226

To: IBP/Architecture
1000 Burnett Ave, Suite 140
Concord, CA 94520

Attn: Celia Chiang, Tom Beckett
Fax: 925-246-6495

Subj: Existing Underground Hot Water Piping

Reference (dwg, spec):

Reply Requested By: 1/26/06

Project: LOS MEDANOS COLLEGE SCIENCE BUILDING
Contra Costa Community College District

IBP j#n: 20247.00

RFI No: **103**
Subcontractor RFM Monterey 4

Date: 1/20/06

INFORMATION REQUESTED:
URGENT
Please note the attached Monterey Mechanical RFI No. 4 regarding Points of Connection for the hydronics piping. Please advise and provide a sketch is necessary.

SUGGESTED SOLUTION:

Cost Impact: ☐ Schedule Impact: ☐ days By: Mark Delgado

RESPONSE: DATE:

Direction 1/20/2006 9:24:29 AM

See attached sketch for new points of connection. Contractor to field verify exact points of connection. Additionally note that (2) chilled water lines at the pool building are run into the building, turned up 90 degrees and capped for future use. Reference detail 2, sheet M1.5. CONTRACTOR TO PROVIDE DETAILED BREAKDOWN OF CREDIT FOR UNDERGROUND CHILLED WATER LINE, AS JUST THE ASPHALT FOR POC. PROVISION FOR REVISED

Attachments:

By:

TRANSMITTAL RECORD:

FROM	TO	DATE
S.J. AMOROSO	IBP / ARCHITECTURE	1/20/06
IBP / ARCHITECTURE	ENGINEER/CONSULTANT	1/20/06
ENGINEER/CONSULTANT	IBP / ARCHITECTURE	1/20/06
IBP / ARCHITECTURE	S.J. AMOROSO	1/20/06
S.J. AMOROSO	ORIGINATOR	

RFI # 000
Page 1

MONTEREY MECHANICAL
HYDRONIC ENVIRONMENTAL FABRICATION
3600 Wilkie Ave, Antioch, CA 94509 ● Phone: (925) 757-4600 ● Fax: (925) 757-4576

REQUEST FOR INFORMATION

PROJECT: Los Medanos College Science Building

MMC RFI #: 004

SUBJECT: Existing Underground Hot Water Piping

DATE REQUESTED: 1/24/06

QUESTION

FROM: Steve Harris-MMC	TO: Mark G. Delgado-SJA	DATE: 1/19/06


Reference Drawing: M1.0, M4.2
Reference Specification: Section 15500

After our wet side subcontractor performed a site investigation with your on site superintendent and the L.O.R.; they have informed us that the points of connection for the hydronic HWS/R at both the (E) pool building and the (N) science building are not as shown on the plans. Please clarify the actual points of connection for this piping.

A response is urgent as this piping affects the foundation.
Please Advise

RESPONSE

FROM:	TO:	DATE:

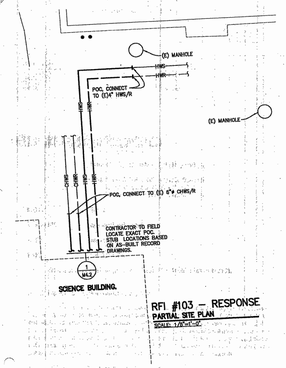

S. J. AMOROSO
Request For Information/Clarification

DSA FILE NO. 7-C1
DSA APPL. No. 01-106226

To: IBP/Architecture
1000 Burnett Ave, Suite 140
Concord, CA 94520

Attn: Celia Chiang, Tom Beckett
Fax: 925-246-6495

Subj: Dimensions of chilled water lines at Line G— INSIDE THE BUILDING
Reference (dwg, spec.) Addendum #1

Reply Requested By: 2/27/06

Project: LOS MEDANOS COLLEGE SCIENCE BUILDING
Contra Costa Community College District

IBP j#n: 20247.00

RFI No: **155.1**
Subcontractor RFI: Matrix 3

Date: 2/23/06

INFORMATION REQUESTED:
URGENT
Original text or RFI No. 155:
Please note the attached Matrix (Monterey Mechanical Sub) RFI regarding the chilled water lines that were moved towards line G in addendum No. 1. Please provide a dimension from line G to , the CHWS, CHWR, HWS and HWR lines.

RFI No. 155.1:
The addendum no. 1 change referenced is per sketch M1-D which moved the stub-up locations within the building.

The response to this RFI provided information on POC locations on the building exterior. We had that information from previous field verification. The information that is needed is the location of the CHWS CHWR, HWS and HWR line stub-ups WITHIN the building. We need dimensions off of grid lines to locate these as we are not to scale the drawings. Please provide dimensional information to locate stub-up locations.

SUGGESTED SOLUTION:

Cost Impact: ☐ Schedule Impact: ☐ days By: Mark Delgado

RESPONSE: DATE:

Response number: 1
Author: Matrix
Subject: Note
Date: 2/26/2006 9:53:49 AM
The location of the CHWS/R, CHWS/R and HWS/R needs to be coordinated by the Contractor with all other trades. The exact location along the south wall of the mechanical room is not critical, but needs to be coordinated with the location of the vacuum pump and domestic cold water riser. Size attached for our recommendation. Also note that Contractor can stagger the shut off valve height if needed for coordination (install short off valves within riser between 30" and 48" AFF).


Attachments:

By:

TRANSMITTAL RECORD:

FROM	TO	DATE
S.J. AMOROSO	IBP / ARCHITECTURE	2/23/06
IBP / ARCHITECTURE	ENGINEER/CONSULTANT	2/26/06

RFI # 000
Page 1

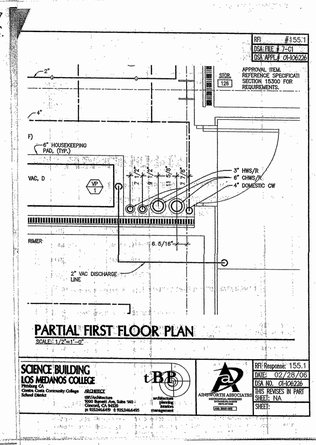

Bulletin No.52

Date: 11/1/2006

To: S.J. Amoroso Construction
390 Bridge Parkway
Redwood shores CA 94065

Project: LOS MEDANOS COLLEGE SCIENCE BUILDING
Contra Costa Community College District
DSA No. 01-106226; File # 7-C1
IBP Pj#J 20247.00

Description:
REFERENCE: Sheet M4.2, M4.4 and M5.2, RFI #386

Adjust locations of thermostats per coordination with furniture as indicated in the attached sketches. Sketches also address thermostats locations associated with RFI 386. Reference SKM-52.1 to SKM-52.4.


No cost shall apply to owner as Contract Documents require one thermostat per VAV box. Quantity of thermostats are not in questions, just location. It is also our understanding from conversations with the Controls Subcontractor that the subject stats have yet to be installed; therefore, no re-work is required.


Issued By: Architect
Requested By: Mechanical, Owner
Reason: Furniture coordination to locations of thermostats
Enclosures: SKM-52.1 to SKM-52.4

Distribution:

Copies:	Name:	Organization:
1 copy	Mark Delgado	S. J. Amoroso
1 copy	Cam Perrotta	CCCC District
1 copy	Bob Hacke	Inspector of Record
1 copy	Tom Beckett	IBP/Architecture
1 copy	File 20247.007.4	IBP/Architecture
1 copy	Dave Weston	AAMR
1 copy	Stephanie O'Brian	Dovetail

Action:
☒ For Information/Clarification only
☐ Provide Price/Credit Proposal. (Refer to this Bulletin No. when responding)
☐ Requires DSA review and approval
☐ Proceed as authorized by District

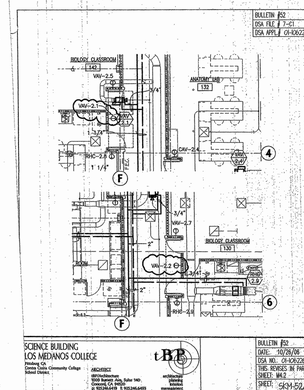

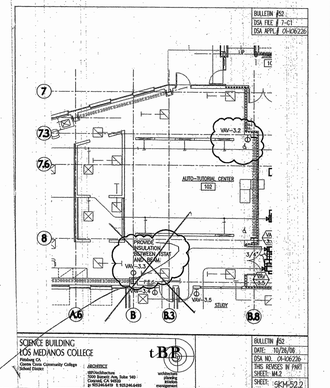

Bulletin No.52 (Revised 11/6/06)

Date: 11/6/2006

To: S.J. Amoroso Construction.
390 Bridge Parkway
Redwood shores CA 94065

Project: LOS MEDANOS COLLEGE SCIENCE BUILDING
Contra Costa Community College District
DSA No. 01-106226; File # 7-C1
IBP Pj#J 20247.00

Description:
REFERENCE: Sheet M4.2, M4.4 and M5.2, RFI #386

Adjust locations of thermostats per coordination with furniture as indicated in the attached sketches. Sketches also address thermostats locations associated with RFI 386. Reference SKM-52.1, SKM-52.2R1, SKM-52.3 to SKM-52.4.


No cost shall apply to owner as Contract Documents require one thermostat per VAV box. Quantity of thermostats are not in questions, just location. It is also our understanding from conversations with the Controls Subcontractor that the subject stats have yet to be installed; therefore, no re-work is required.

Issued By: Architect
Requested By: Mechanical, Owner
Reason: Furniture coordination to locations of thermostats
Enclosures: SKM-52.1, SKM-52.2R1, SKM-52.3 to SKM-52.4.


Distribution:

Copies:	Name:	Organization:
1 copy	Mark Delgado	S. J. Amoroso
1 copy	Cam Perrotta	CCCC District
1 copy	Bob Hacke	Inspector of Record
1 copy	Tom Beckett	IBP/Architecture
1 copy	File 20247.007.4	IBP/Architecture
1 copy	Dave Weston	AAMR
1 copy	Stephanie O'Brian	Dovetail

Action:
☒ For Information/Clarification only
☐ Provide Price/Credit Proposal. (Refer to this Bulletin No. when responding)
☐ Requires DSA review and approval
☐ Proceed as authorized by District

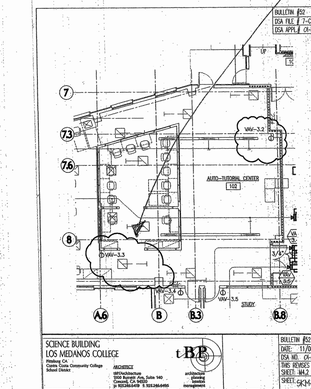


Los Medanos College
4CD Proj. #: L-565-B-23-SC
Science Building

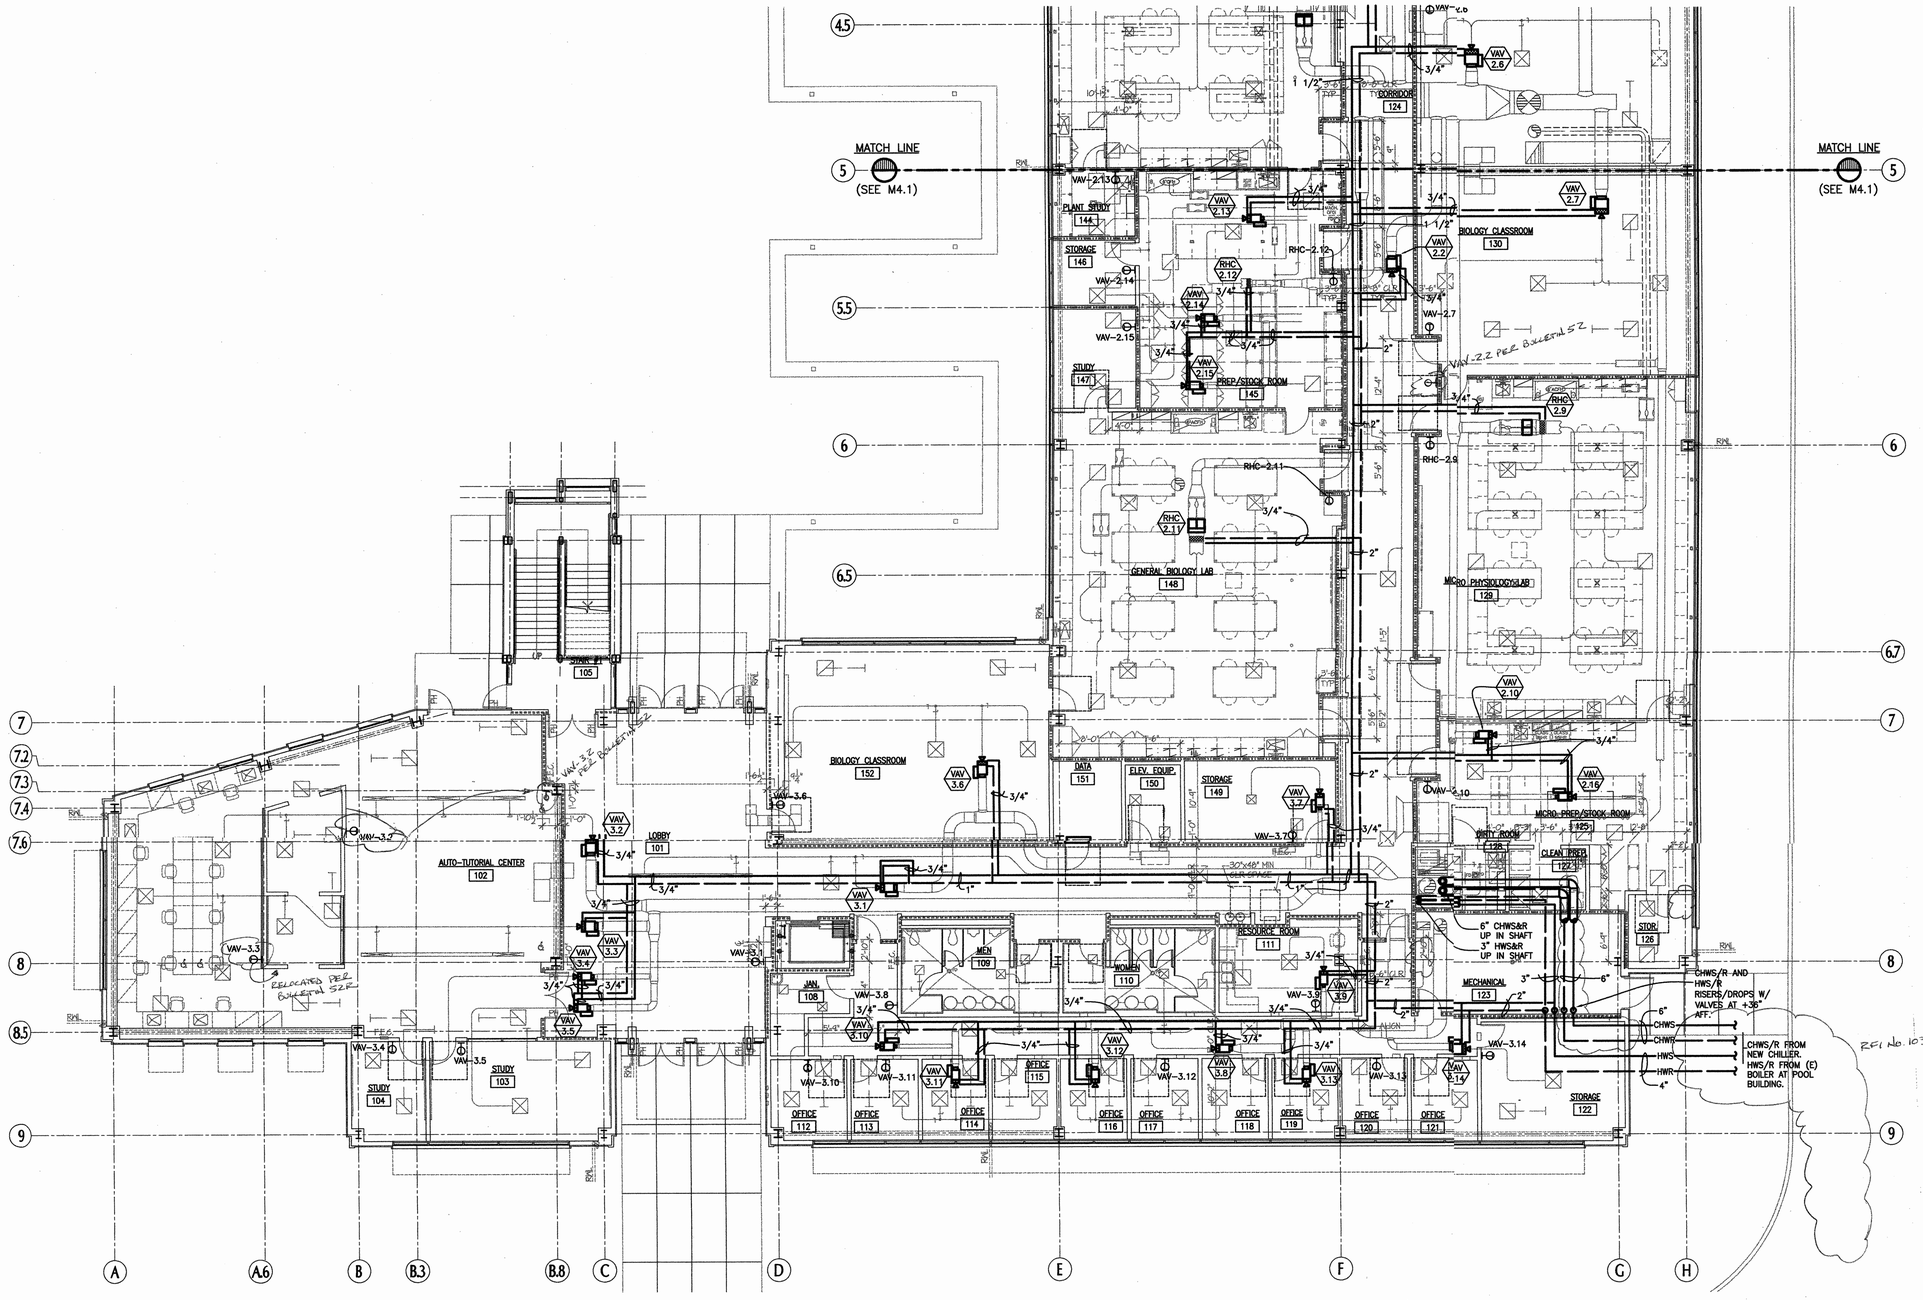


HYDRONICS - FIRST FLOOR PARTIAL PLAN

1 / M4.2

SCALE: 1/8"=1'-0"

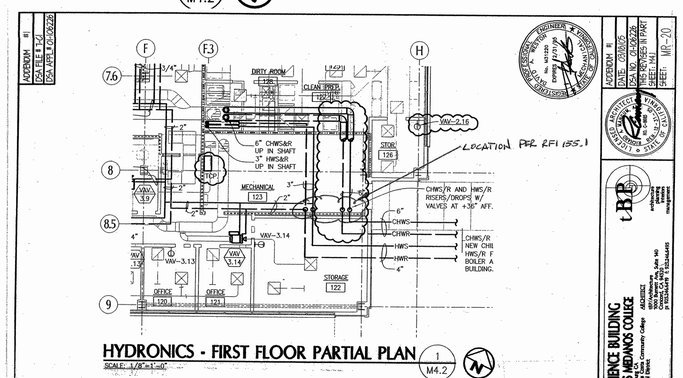

KEY PLAN

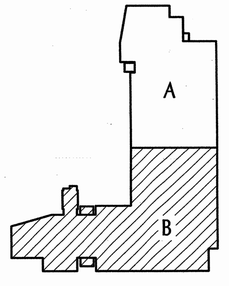

Moved CHWS&R and HWS&R closer to exterior door of Mechanical 123 at "Hydronics – First Floor Partial Plan" 1/M4.2. Added temperature sensor for VAV-2.16 in Storage 126 at "Hydronics – First Floor Partial Plan" 1/M4.2. Added TCP location in Mechanical Room 123.

ADDENDUM No.1

tBP
architecture
planning
interiors
management

tBP/Architecture
1000 Burnett Avenue, Suite 140
Concord, CA 94520
p: 925.246.6419 f: 925.246.6495

architect

AINSWORTH ASSOCIATES
MECHANICAL ENGINEERS
SACRAMENTO, CA

consultant

name
address
city, state, zip
ph: fx:

agency

Contra Costa Community College District

owner

tBP project number : 2024.00

file name:

drawn by: checked by:

date: NOVEMBER 15, 2004

Rev:	date:	description:

drawing title:
HYDRONICS -
FIRST FLOOR PARTIAL PLAN


LMC SCIENCE 313-023-112.01-0-00.00

drawing no.:
M4.2
drawing of ?

APPROVED FOR CONSTRUCTION
DIV. OF THE STATE ARCHITECT
OFFICE OF REGULATION SERVICES
APP. # 05.0022.28
DATE 1-11-05

LICENSED ARCHITECT
No. C-28886
REGISTERED PROFESSIONAL ENGINEER
No. M31520
EXPIRES 12/31/06

I:\2005-023\DWG\M4-1-2.dwg Tue, Nov 02, 2004 - 05:41pm

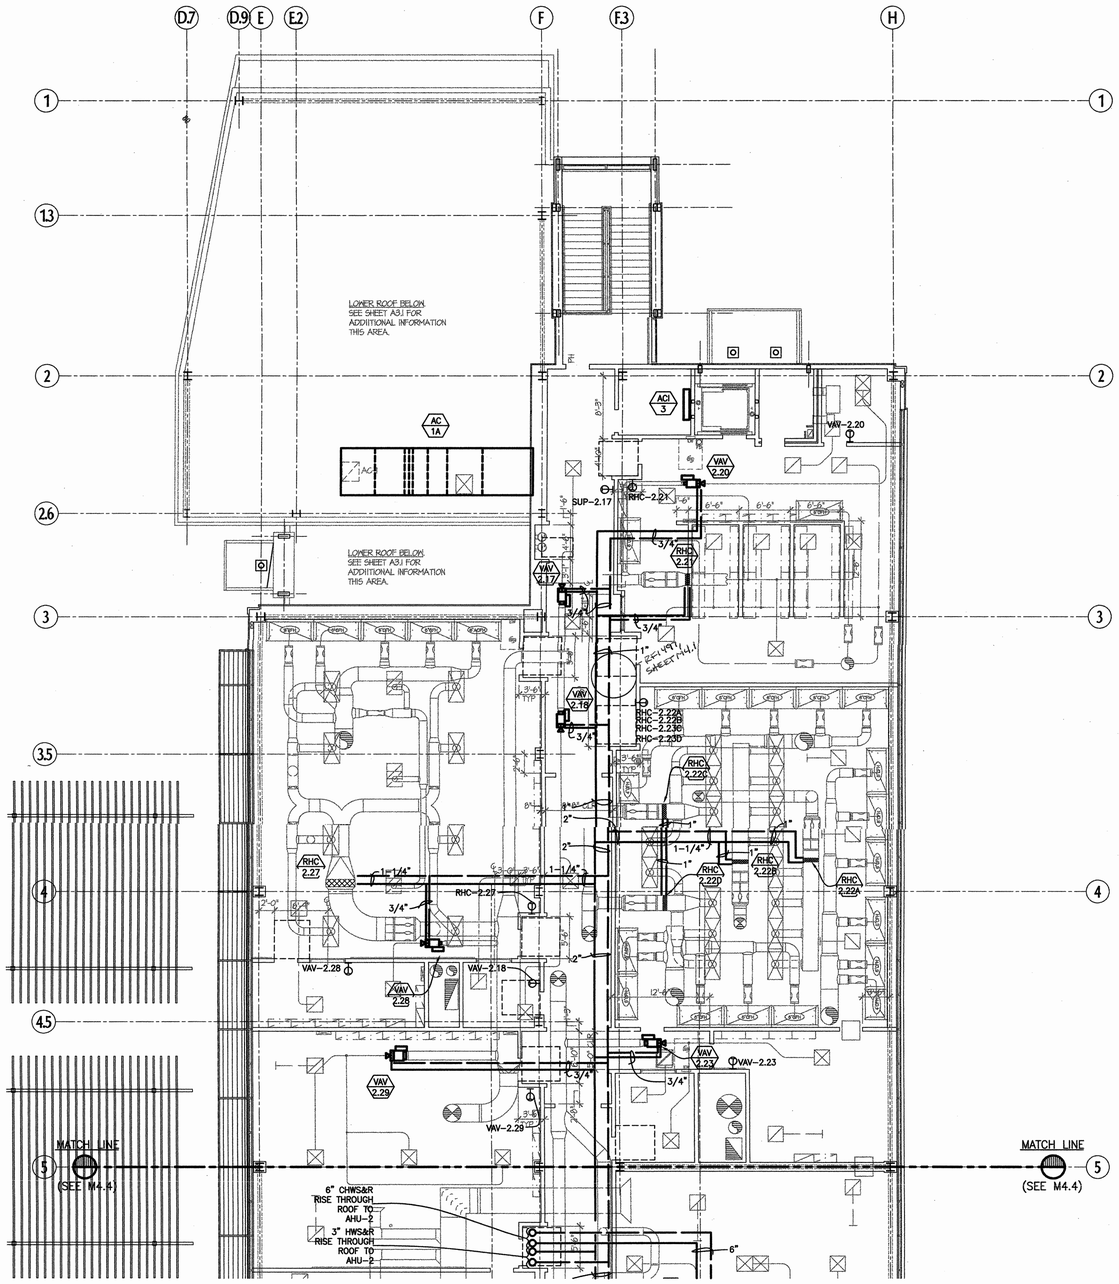


HYDRONICS - SECOND FLOOR PARTIAL PLAN

SCALE: 1/8"=1'-0"

1 / M4.3

KEY PLAN

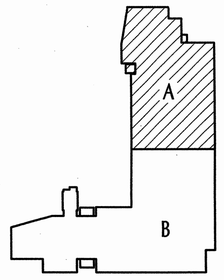

tBP
architecture
planning
interiors
management
tBP/Architecture
1000 Burnett Avenue, Suite 140
Concord, CA 94520
p: 925.246.6419 f: 925.246.6495
architect

AINSWORTH ASSOCIATES
MECHANICAL ENGINEERS
SACRAMENTO, CA
consultant

name
address
city, state, zip
ph: fx:
agency

SCIENCE BUILDING
LOS MEDANOS COLLEGE

Contra Costa Community College District

owner


tBP project number : 2024.00
file name:
drawn by: checked by:
date: NOVEMBER 15, 2004


Rev:	date:	description:


drawing title:
HYDRONICS -
SECOND FLOOR PARTIAL PLAN

LMC SCIENCE 313-023-712.01-0-00.00
drawing no.:
M4.3
drawing of ?

2023-028\DWG\M-4.3-1.dwg Tile:Nov\3.2004-03:48pm

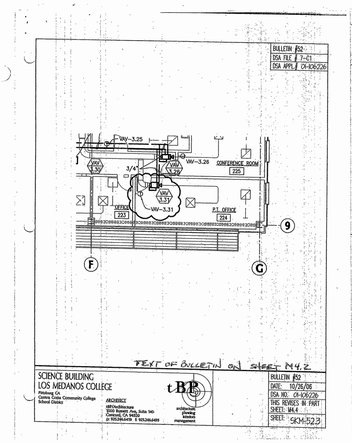
BULLETIN #52
DSA APPL # 04-106226
VAV-3.25
VAV-3.26
CONFERENCE ROOM
225
VAV-3.27
VAV-3.31
P.I. OFFICE
224
VAV-3.32
VAV-3.33
3/4"
9
F
G
TEXT OF BULLETIN on SHEET M4.2
SCIENCE BUILDING
LOS MEDANOS COLLEGE
Pittsburg, CA
Contra Costa Community College
School District
ARCHITECT
architecture
planning
interiors
management
tBP
BULLETIN #52
DATE: 10/26/06
DSA NO.: 04-106226
THIS REVISED IN PART
SHEET: M4.4
SHEET: SKM-523

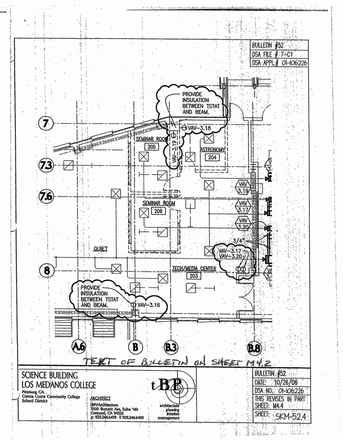
BULLETIN #52
DSA APPL # 04-106226
PROVIDE INSULATION BETWEEN T-STAT AND BEAM.
VAV-3.16
SEMINAR ROOM
205
KITCHENETTE
204
VAV-3.17
VAV-3.18
SEMINAR ROOM
206
VAV-3.19
VAV-3.20
3/4"
QUIET
VAV-3.12
VAV-3.30
TECH MEDIA CENTER
203
PROVIDE INSULATION BETWEEN T-STAT AND BEAM.
VAV-3.15
7
7.3
7.6
8
A.6
B
B.3
B.8
TEXT OF BULLETIN on SHEET M4.2
SCIENCE BUILDING
LOS MEDANOS COLLEGE
Pittsburg, CA
Contra Costa Community College
School District
ARCHITECT
architecture
planning
interiors
management
tBP
BULLETIN #52
DATE: 10/26/06
DSA NO.: 04-106226
THIS REVISED IN PART
SHEET: M4.4
SHEET: SKM-524

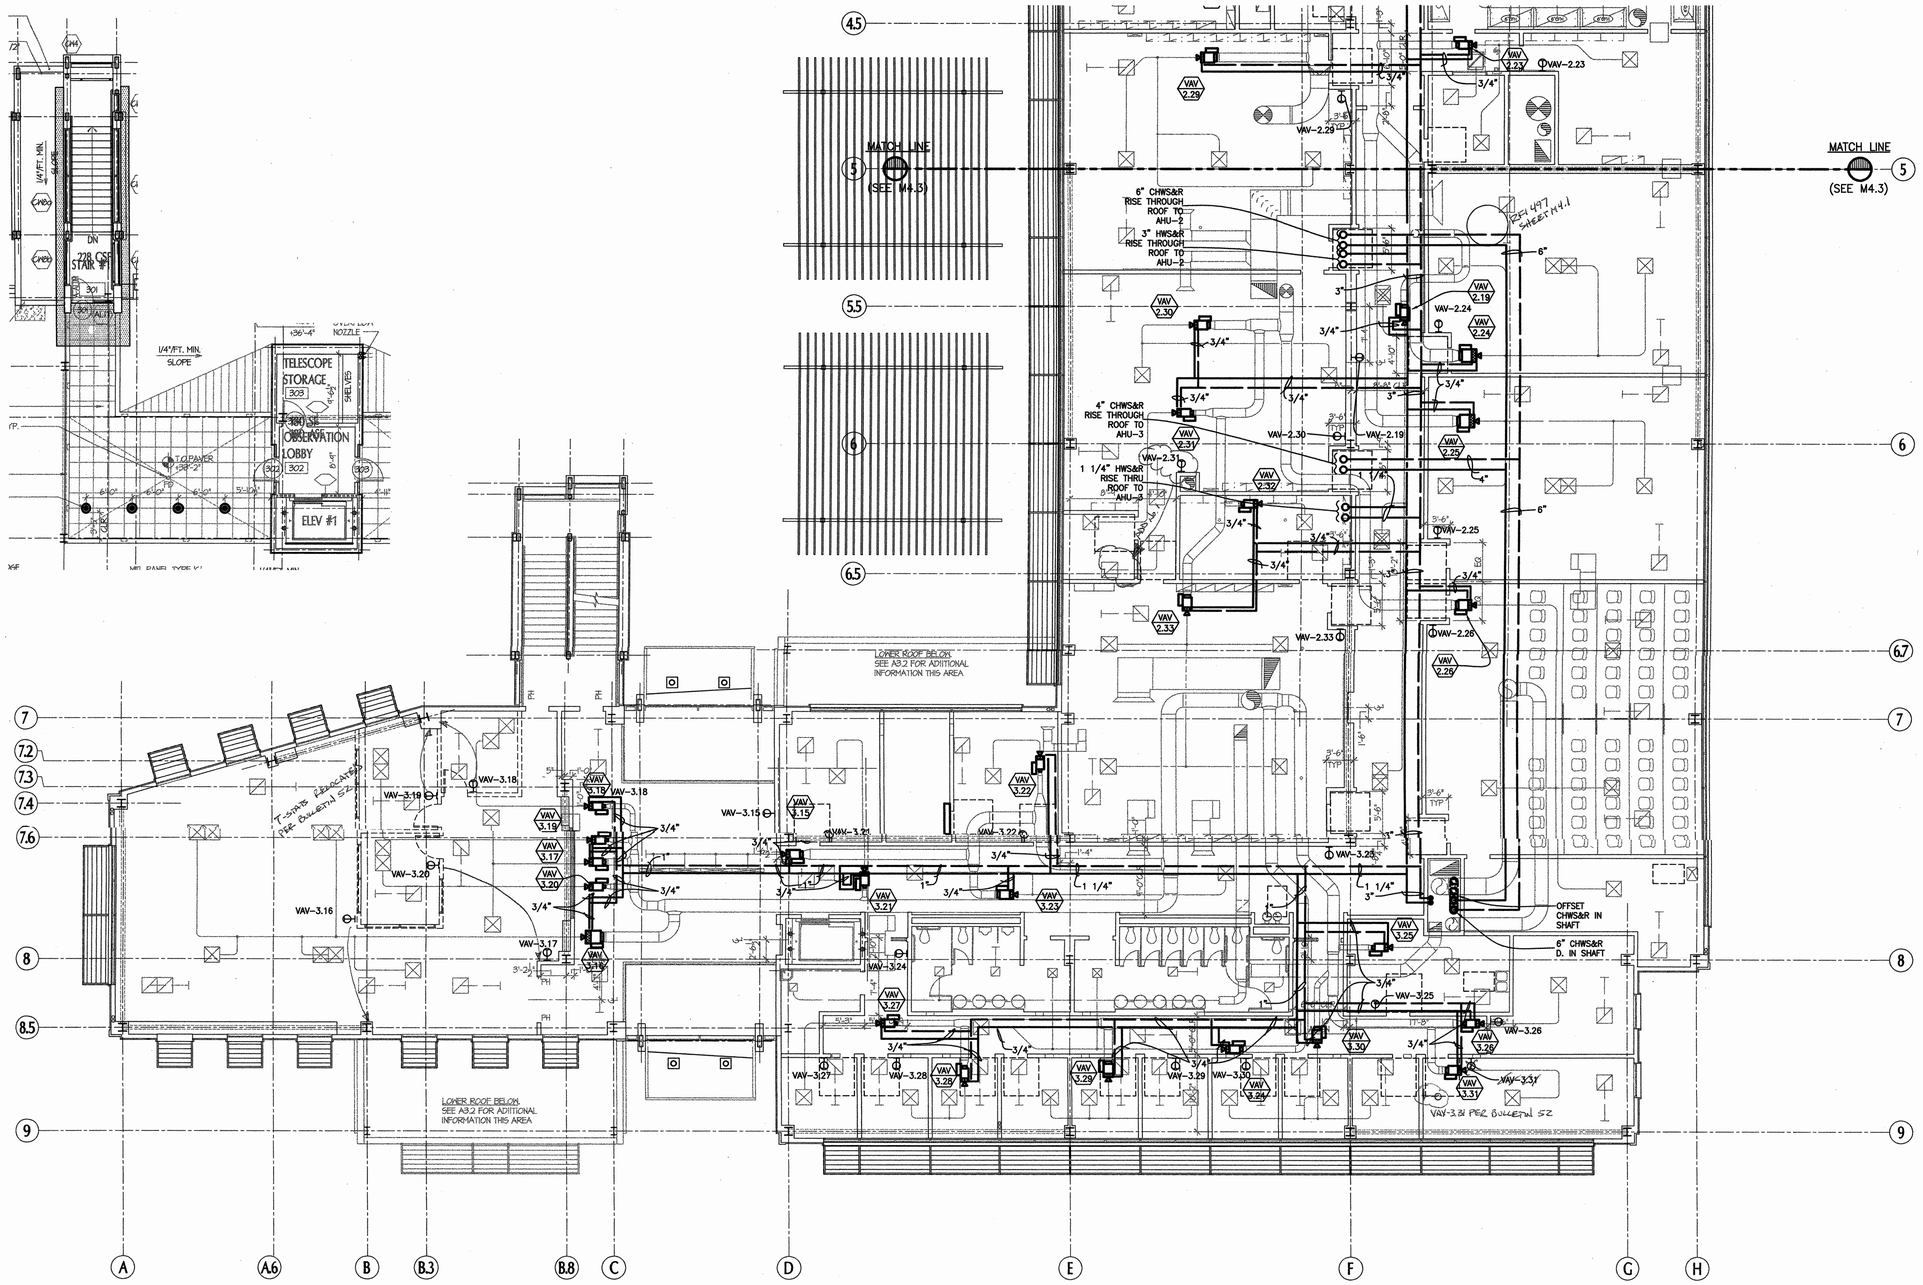


HYDRONICS - SECOND FLOOR PARTIAL PLAN


1 / M4.4

SCALE: 1/8"=1'-0"

Moved temperature sensor for VAV 2.31 to wall next to interior door in Storage 247 at "Hydronics – Second Floor Partial Plan" 1/M4.4. ADDENDUM No. 1

KEY PLAN

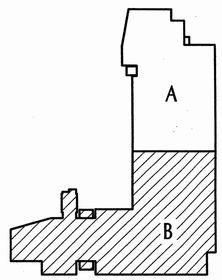

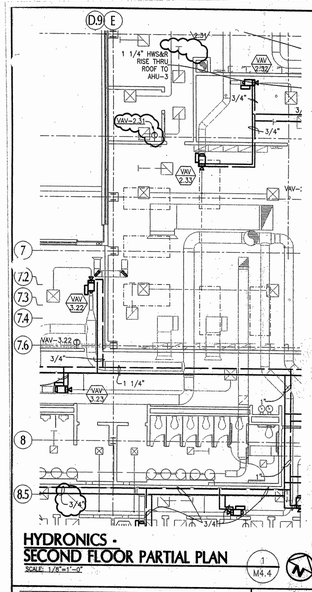

ADDENDUM #1
DSA FILE # 7-21
DSA APPL # 01-106226

tBP/Architecture
1000 Burnett Avenue, Suite 140
Concord, CA 94520
p: 925.246.6419 f: 925.246.6495

AINSWORTH ASSOCIATES
MECHANICAL ENGINEERS
SACRAMENTO, CA
(916) 929-0929

SCIENCE BUILDING
LOS MEDANOS COLLEGE
Pittsburg, CA
Contra Costa Community College School District

ARCHITECT
tBP/Architecture
1000 Burnett Ave, Suite 140
Concord, CA 94520
p: 925.246.6419 f: 925.246.6495

tBP architecture planning interiors management

ADDENDUM #1
DATE: 03/30/05
DSA NO. 01-106226
THIS REVISES IN PART
SHEET: M4.4
SHEET: MR-21

DSA IDENTIFICATION STAMP
DIV. OF THE STATE ARCHITECT
OFFICE OF REGULATION SERVICES
APP. # 01-106226
DATE 1-11-05

name
address
city, state, zip
ph:
fx:

SCIENCE BUILDING
LOS MEDANOS COLLEGE

Contra Costa Community College District

tBP project number : 20241.00
file name:
drawn by: checked by:
date: NOVEMBER 15, 2004


Rev:	date:	description:

drawing title:
HYDRONICS - SECOND FLOOR PARTIAL PLAN


LMC SCIENCE 313-023-112.01-0-00.00
drawing no.: M4.4
drawing of ?

architect
consultant
agency
owner

\2023-023\DWG\M-4.3-4.dwg Thursday,Nov\11\2004-03:46pm

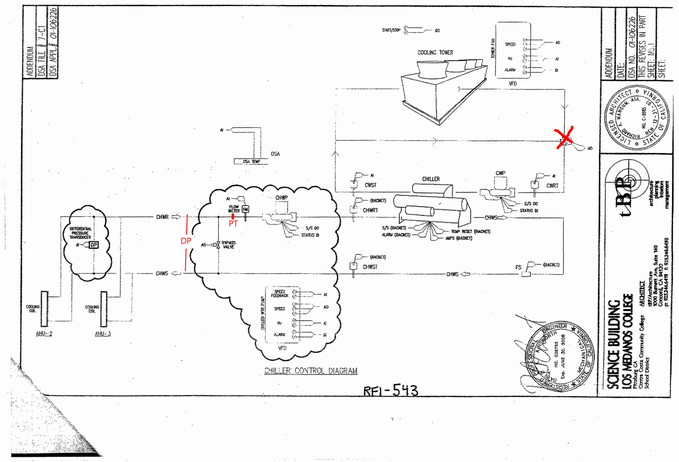

CHILLER CONTROL DIAGRAM

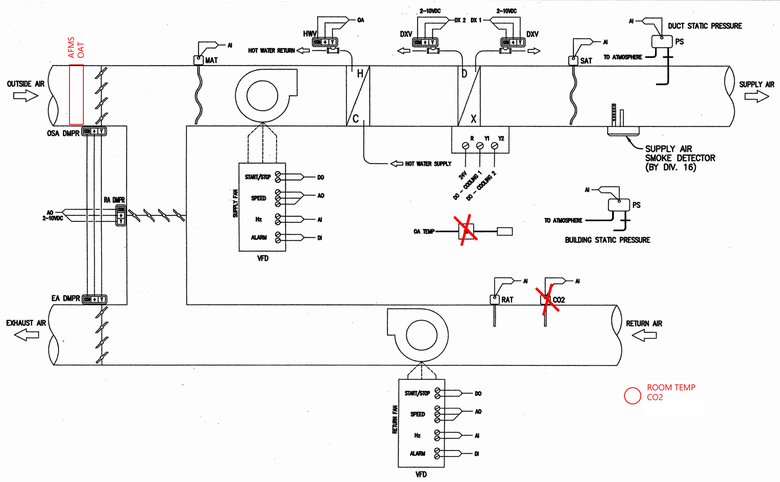

AC UNIT CONTROL (AC1)

SUPPLY AND RETURN FAN CONTROL

THE FANS SHALL BE TURNED ON WHEN THE UNIT IS ENABLED TO RUN (SCHEDULED ON). IF THE UNIT IS NOT ENABLED TO RUN (SCHEDULED OFF) THE FANS SHALL BE TURNED OFF. AFTER THE FAN IS TURNED OFF, A FIVE MINUTE TIME DELAY MUST ELAPSE BEFORE THE FAN CAN BE TURNED BACK ON.

SUPPLY FAN VFD CONTROL

WHEN THE FAN IS ON THE VFD SHALL RAMP TO MAINTAIN A DUCT STATIC SET POINT OF 1.0 I.W.C (ADJUSTABLE). WHEN THE FAN IS OFF THE VFD SHALL RAMP TO 0 HZ.

RETURN FAN VFD CONTROL

WHEN THE RETURN FAN IS ON THE RETURN FAN VFD SHALL RAMP TO MAINTAIN A BUILDING STATIC SET POINT OF 0.025 I.W.C (ADJUSTABLE). WHEN THE FAN IS OFF THE VFD SHALL RAMP TO 0 HZ.

DX COOLING CONTROL

WHEN THE FAN IS ON AND THE FAN HAS PROOF OF AIR FLOW AND A REQUEST FOR COOLING IS ON AND THE REQUEST FOR HEATING IS OFF AND THE SUPPLY AIR TEMPERATURE IS ABOVE 62 DEGREES THEN THE FIRST STAGE OF COOLING SHALL BE TURNED ON. IF THE SUPPLY AIR TEMPERATURE IS ABOVE 62 DEGREES FOR FIVE MINUTES THE SECOND STAGE OF COOLING SHALL BE TURNED ON. IF THE REQUEST FOR COOLING IS OFF OR THE REQUEST FOR HEATING IS ON OR THE FAN STATUS IS OFF OR THE FAN IS OFF THEN THE COOLING SHALL BE TURNED OFF. IF THE SUPPLY AIR TEMPERATURE SHOULD FALL BELOW THE LOW LIMIT LOCKOUT SET POINT OF 44 DEGREES ONE STAGE OFF COOLING SHALL BE TURNED OFF FOR A FIVE MINUTE TIME DELAY.

COOLING REQUEST

THE REQUEST FOR COOLING SHALL BE TURNED ON WHEN MORE THAN 40% (ADJUSTABLE) OF THE TOTAL ZONES OCCUPIED ARE CALLING FOR COOLING. THE REQUEST FOR COOLING SHALL BE TURNED OFF IF THERE ARE NO ZONES CALLING FOR COOLING.

HW VALVE CONTROL

WHEN THE SUPPLY FAN IS ON AND A REQUEST FOR HEATING IS ON THE HW VALVE SHALL MODULATE TO MAINTAIN IT'S SUPPLY AIR SET POINT OF 120 DEGREES (ADJUSTABLE). WHEN THE SUPPLY FAN IS OFF THE HW VALVE SHALL MOVE TO THE CLOSED POSITION.

HEATING REQUEST

WHEN THE FAN IS ON AND THE MAX ZONE TEMP DIFF IS EQUAL TO OR BELOW MINUS THREE (–3) DEGREES, THE HEATING REQUEST SHALL BE TURNED ON.

ECONOMIZER CONTROL

WHEN THE SUPPLY FAN IS ON AND THE OUTSIDE AIR TEMPERATURE IS BELOW THE OUTSIDE AIR LOCKOUT SET POINT (ADJUSTABLE) OF 68 DEGREES MINUS 2 (–2) DEGREES AND THE OUTSIDE AIR TEMPERATURE IS BELOW THE RETURN AIR TEMPERATURE MINUS 2 (–2) DEGREES THE OUTSIDE AIR DAMPERS SHALL MODULATE TO MAINTAIN A MIXED AIR SET POINT. IF THE OUTSIDE AIR TEMPERATURE RISES ABOVE THE OUTSIDE AIR LOCKOUT SET POINT OR THE OUTSIDE AIR RISES ABOVE THE RETURN AIR THE DAMPERS SHALL MODULATE TO THEIR MINIMUM POSITION TO MAINTAIN ITS CO2 LEVEL SET POINT OF 700PPM. THE DAMPERS SHALL CLOSE WHEN THE FAN IS TURNED OFF.

MIXED AIR SET POINT SCHEDULE

MAX VAV ZONE TEMP DIFF	MA SET POINT
0	70
0.5	62.5
1	55


MAX VAV ZONE TEMP DIFF = (VAV ZONE TEMPERATURE – VAV ZONE SET POINT)

ALARMS

* IF THE SUPPLY FAN IS ON AND A VFD FAULT IS DETECTED A SUPPLY FAN VFD FAILURE ALARM SHALL BE GENERATED.
* IF THE RETURN FAN IS ON AND A VFD FAULT IS DETECTED A RETURN FAN VFD FAILURE ALARM SHALL BE GENERATED.
* IF THE SUPPLY FAN IS ON AND THE DUCT STATIC IS NOT BETWEEN +/– 0.2 IWC OF IT'S SET POINT FOR 10 MINUTES A DUCT STATIC ALARM SHALL BE GENERATED.
* IF THE RETURN FAN IS ON AND THE BUILDING STATIC IS NOT BETWEEN +/– 0.1 IWC OF ITS SET POINT FOR 10 MINUTES A BUILDING STATIC ALARM SHALL BE GENERATED.
* IF THE SUPPLY FAN IS ON AND THE CO2 LEVEL ARE GREATER THAN 1000PPM FOR 5 MINUTES A HIGH CO2 LEVEL ALARM SHALL BE GENERATED. WHEN THE CO2 LEVEL GOES BELOW 800PPM THE ALARM SHALL CLEAR.

CONTROL DIAGRAM AC1

TAG	ITEM
D2605	D2605 INFINITY VAV CONTROLLER
CHWP	CHILLED WATER VALVE PUMP
CHWR	CHILLED WATER RETURN
CHWRT	CHILLED WATER RETURN TEMPERATURE
CHWS	CHILLED WATER SUPPLY
CHWST	CHILLED WATER SUPPLY TEMPERATURE
CHWV	2 WAY CHILLED WATER VALVE
CT	CURRENT TRANSDUCER
CW	CONDENSOR WATER
CWP	CONDENSOR WATER PUMP
CWRT	CONDENSOR WATER RETURN TEMPERATURE
CWST	CONDENSOR WATER SUPPLY TEMPERATURE
DMPR	DAMPER
EA	EXHAUST AIR
FS	FLOW STATUS
HWP	HOT WATER PUMP
HWR	HOT WATER RETURN
HWRT	HOT WATER RETURN TEMPERATURE
HWS	HOT WATER SUPPLY
HWST	HOT WATER SUPPLY TEMPERATURE
HWV	2 WAY HOT WATER VALVE
MAT	MIXED AIR TEMP. SENSOR – AVERAGING
OSA	OUTSIDE AIR
PS	DIFFERENTIAL PRESSURE TRANSDUCER
RA	RETURN AIR
RAT	RETURN AIR TEMPERATURE SENSOR
SAT	SUPPLY AIR TEMP. SENSOR – AVERAGING
S/S	START/STOP
VFD	VARIABLE FREQUENCY DRIVE
ZT	ZONE TEMPERATURE SENSOR

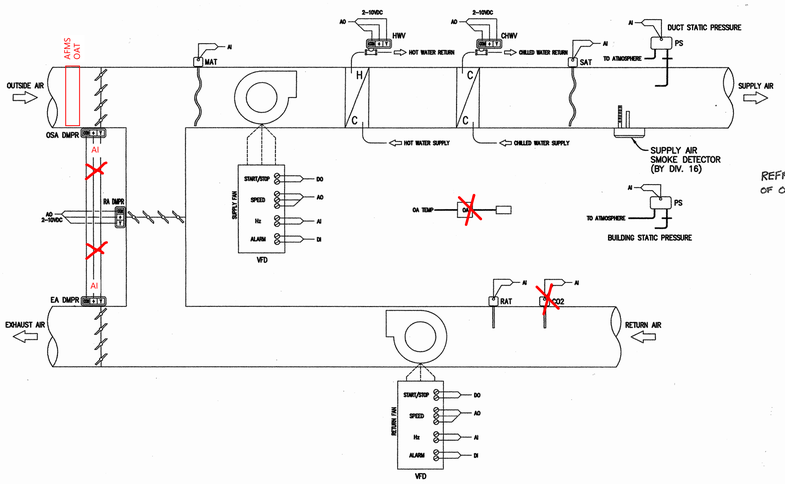

REFRIGERANT MONITOR SEQUENCE OF OPERATIONS RFI 562

AHU UNIT CONTROL (AHU2, AHU3)

SUPPLY AND RETURN FAN CONTROL

THE FANS SHALL BE TURNED ON WHEN THE UNIT IS ENABLED TO RUN (SCHEDULED ON). IF THE UNIT IS NOT ENABLED TO RUN (SCHEDULED OFF) THE FANS SHALL BE TURNED OFF. AFTER THE FAN IS TURNED OFF, A FIVE MINUTE TIME DELAY MUST ELAPSE BEFORE THE FAN CAN BE TURNED BACK ON.

SUPPLY FAN VFD CONTROL

WHEN THE FAN IS ON THE VFD SHALL RAMP TO MAINTAIN A DUCT STATIC SET POINT OF 1.0 I.W.C (ADJUSTABLE). WHEN THE FAN IS OFF THE VFD SHALL RAMP TO 0 HZ.

RETURN FAN VFD CONTROL

WHEN THE RETURN FAN IS ON THE RETURN FAN VFD SHALL RAMP TO MAINTAIN A BUILDING STATIC SET POINT OF 0.025 I.W.C (ADJUSTABLE). WHEN THE FAN IS OFF THE VFD SHALL RAMP TO 0 HZ.

CHW VALVE CONTROL

WHEN THE SUPPLY FAN IS ON THE CHW VALVE SHALL MODULATE TO MAINTAIN ITS SUPPLY AIR SET POINT. WHEN THE SUPPLY FAN IS OFF THE CHW VALVE SHALL MOVE TO THE CLOSED POSITION.

CHW REQUEST

WHEN THE CHW VALVE IS OPEN MORE THAN 90% FOR 5 MINUTES A REQUEST FOR CHILLED WATER IS TO BE TURNED ON. WHEN THE CHW VALVE IS CLOSED FOR 15 MINUTES THE REQUEST FOR CHILLED WATER SHALL BE TURNED OFF.

SUPPLY AIR RESET SCHEDULE

THE SUPPLY AIR SET POINT SHALL BE RESET BASED ON THE HIGHEST VAV ZONE VARIANCE FROM SET POINT. (I.E. VAV ZONE TEMPERATURE – VAV ZONE SET POINT). SEE RESET SCHEDULE BELOW.

MAX VAV ZONE TEMP DIFF	SA SET POINT
2	55
1	62.5
0 TO –1.9	70
–2	120

HW VALVE CONTROL

WHEN THE SUPPLY FAN IS ON AND A REQUEST FOR HEATING IS ON THE HW VALVE SHALL MODULATE TO MAINTAIN IT'S SUPPLY AIR SET POINT. WHEN THE SUPPLY FAN IS OFF THE HW VALVE SHALL MOVE TO THE CLOSED POSITION.

HEATING REQUEST

WHEN THE FAN IS ON AND THE MAX ZONE TEMP DIFF IS EQUAL TO OR BELOW MINUS THREE (–3) DEGREES, THE HEATING REQUEST SHALL BE TURNED ON.

ECONOMIZER CONTROL

WHEN THE SUPPLY FAN IS ON AND THE OUTSIDE AIR TEMPERATURE IS BELOW THE OUTSIDE AIR LOCKOUT SET POINT (ADJUSTABLE) OF 68 DEG. MINUS 2 (–2) DEGREES AND THE OUTSIDE AIR TEMPERATURE IS BELOW THE RETURN AIR TEMPERATURE MINUS 2 (–2) DEGREES THE OUTSIDE AIR DAMPERS SHALL MODULATE TO MAINTAIN A MIXED AIR SET POINT. IF THE OUTSIDE AIR TEMPERATURE RISES ABOVE THE OUTSIDE AIR LOCKOUT SET POINT OR THE OUTSIDE AIR RISES ABOVE THE RETURN AIR THE DAMPERS SHALL MODULATE TO THEIR MINIMUM POSITION TO MAINTAIN ITS CO2 LEVEL SET POINT OF 700PPM. THE DAMPERS SHALL CLOSE WHEN THE FAN IS TURNED OFF.

MIXED AIR SET POINT SCHEDULE


MAX VAV ZONE TEMP DIFF	MA SET POINT
0	70
0.5	62.5
1	55

MAX VAV ZONE TEMP DIFF = (VAV ZONE TEMPERATURE – VAV ZONE SET POINT)

ALARMS

* IF THE SUPPLY FAN IS ON AND A VFD FAULT IS DETECTED A SUPPLY FAN VFD FAILURE ALARM SHALL BE GENERATED.
* IF THE RETURN FAN IS ON AND A VFD FAULT IS DETECTED A RETURN FAN VFD FAILURE ALARM SHALL BE GENERATED.
* IF THE SUPPLY FAN IS ON AND THE DUCT STATIC IS NOT BETWEEN +/– 0.2 IWC OF IT'S SET POINT FOR 10 MINUTES A DUCT STATIC ALARM SHALL BE GENERATED.
* IF THE RETURN FAN IS ON AND THE BUILDING STATIC IS NOT BETWEEN +/– 0.1 IWC OF ITS SET POINT FOR 10 MINUTES A BUILDING STATIC ALARM SHALL BE GENERATED.
* IF THE SUPPLY FAN IS ON AND THE CO2 LEVEL ARE GREATER THAN 1000PPM FOR 5 MINUTES A HIGH CO2 LEVEL ALARM SHALL BE GENERATED. WHEN THE CO2 LEVEL GOES BELOW 800PPM THE ALARM SHALL CLEAR.

CONTROL DIAGRAM AHU2, AHU3

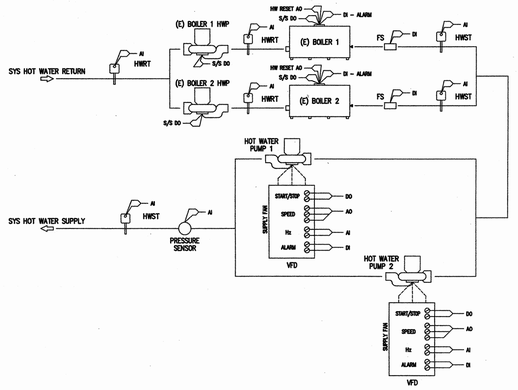

BOILER CONTROL

BOILER LEAD LAG CONTROL

IF A FAILURE IS DETECTED ON THE LEAD BOILER THE LAG BOILER SHALL BECOME LEAD. THE BOILERS SHALL CHANGE BETWEEN LEAD AND LAG ONCE A WEEK IF THERE ARE NO FAILURES ON THE LAG BOILER.

HOT WATER REQUEST

WHEN A BUILDING FAN IS ON AND THE OUTSIDE AIR TEMPERATURE IS BELOW BOILER LOCKOUT SET POINT OF 65 DEGREES (ADJUSTABLE) THE HOT WATER REQUEST SHALL BE TURNED ON. IF THE BUILDING FANS ARE OFF OR THE OUTSIDE AIR TEMPERATURE RISES ABOVE THE BOILER LOCKOUT PLUS TWO (+2) DEGREES THE HOT WATER REQUEST SHALL TURN.

HOT WATER PUMP CONTROL

THE LEAD HOT WATER PUMP SHALL BE TURNED ON IF THE HOT WATER REQUEST ON. THE HOT WATER PUMP SHALL BE TURNED OFF WHEN THE BOILER REQUEST IS OFF AND A FIVE MINUTE TIME DELAY HAS ELAPSED.

BOILER CONTROL

THE LEAD BOILER SHALL BE TURNED ON IF THE BOILER REQUEST IN ON AND THERE IS PROOF OF HOT WATER FLOW. THE BOILER SHALL BE TURNED OFF WHEN THE BOILER REQUEST OF OFF OR THERE IS NO PROOF OF HOT WATER FLOW.

BOILER RESET

WHEN THE BOILER IS ON THE AND HOT WATER SUPPLY TEMPERATURE IS BELOW ITS HOT WATER SUPPLY SET POINT THE BOILER RESET SHALL BE TURNED ON. IF THE BOILER IS OFF OR THE HOT WATER SUPPLY TEMPERATURE IS ABOVE ITS HOT WATER SET POINT PLUS FIVE (+5) DEGREES THE BOILER RESET SHALL BE TURNED OFF.

HOT WATER SUPPLY TEMPERATURE RESET SCHEDULE

THE HOT WATER SUPPLY TEMPERATURE SET POINT SHALL BE RESET OFF THE OUTSIDE AIR TEMPERATURE. SEE RESET SCHEDULE BELOW. (ALL CALCULATIONS ARE LINEAR)

OSA TEMP	HWS SET POINT
70	90
60	120
50	150

HW SYSTEM PUMP CONTROL

HOT WATER SYSTEM LEAD LAG CONTROL

IF A FAILURE IS DETECTED ON THE LEAD PUMP AND THE LAG PUMP HAS NO FAILURES THE LAG PUMP SHALL BECOME LEAD. THE PUMPS SHALL CHANGE BETWEEN LEAD AND LAG ONCE A WEEK IF THERE ARE NO PUMP FAILURES ON THE LAG PUMP.

HOT WATER SYSTEM PUMP CONTROL

WHEN THE HOT WATER REQUEST IS ON, THE LEAD SYSTEM PUMP SHALL BE TURNED ON. WHEN THE HOT WATER REQUEST IS OFF THEN THE LEAD PUMP SHALL TURN OFF AFTER A FIVE MINUTE TIME DELAY.

HOT WATER SYSTEM VFD PUMP CONTROL


WHEN THE LEAD PUMP IS ON, THE VFD SHALL RAMP TO MAINTAIN ITS DIFFERENTIAL SET POINT OF ( ) PSI. WHEN THE LEAD PUMP IS OFF THE VFD SHALL RAMP TO 0 HZ.

DOMESTIC HW PUMP CONTROL

HOT WATER PUMP CONTROL

WHEN THE BUILDING IS OCCUPIED THE DOMESTIC HOT WATER PUMP SHALL BE TURNED ON. WHEN THE BUILDING IS NOT OCCUPIED THE DOMESTIC HOT WATER PUMP SHALL BE TURNED OFF.

BOILER CONTROL DIAGRAM

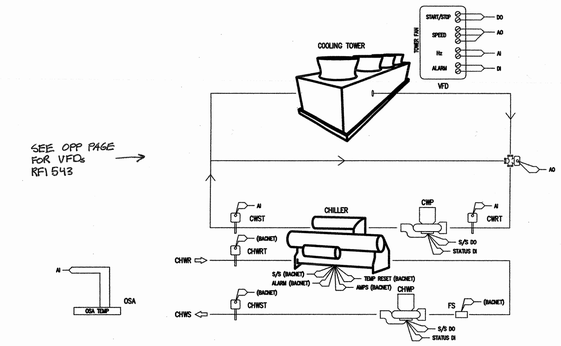

CHILLER CONTROL

CHILLER WATER PUMP CONTROL

WHEN A REQUEST FOR THE CHILLER IS ON THE CHILLED WATER PUMP SHALL BE TURNED ON. WHEN THE REQUEST FOR THE CHILLER IS OFF THE CHILLED WATER PUMP SHALL BE TURNED OFF AFTER A 5 MINUTES TIME DELAY.

CHILLER CONTROL (BACNET INTERFACE)

WHEN A REQUEST FOR THE CHILLER IS ON AND THE CHILLED WATER PUMP STATUS IS ON AND THE CONDENSER WATER PUMP STATUS IS ON THEN CHILLER SHALL BE TURNED ON. WHEN THE REQUEST FOR THE CHILLER IS OFF OR THE CHILLED WATER PUMP STATUS IS OFF OR THE CONDENSER WATER PUMP STATUS IS OFF THE CHILLER SHALL BE TURNED OFF.

CHILLED WATER RESET CONTROL (BACNET INTERFACE)

WHEN A REQUEST FOR THE CHILLER IS ON THE CHILLED WATER SUPPLY TEMPERATURE SHALL BE RESET BASED ON THE CHILLERS RETURN WATER TEMPERATURE. (SEE SCHEDULE BELOW)

CHW RETURN TEMP	CHW SUPPLY SET POINT
54	44
49	49
44	54

CHILLER CONTROL DIAGRAM

COOLING TOWER CONTROL

COOLING TOWER CONDENSER WATER PUMP CONTROL


WHEN A REQUEST FOR THE CHILLER IS ON THE CONDENSER WATER PUMP SHALL BE TURNED ON. WHEN THE REQUEST FOR THE CHILLER IS OFF THE CONDENSER WATER PUMP SHALL BE TURNED OFF AFTER A 5 MINUTES TIME DELAY.

COOLING TOWER FAN VFD CONTROL

WHEN THE CONDENSER WATER PUMP IS ON THE COOLING TOWER VFD SHALL RAMP TO MAINTAIN THE CONDENSER WATER SET POINT OF 78 DEG. (CHECK W/CHILLER MANUFACTURE FOR DESIGN SET POINT), WHEN THE CONDENSER PUMP IS OFF THE VFD SHALL RAMP TO 0 HZ.

COOLING TOWER VALVE CONTROL

WHEN THE CONDENSER WATER PUMP IS ON THE CONDENSER VALVE SHALL MODULATE TO MAINTAIN THE CONDENSER WATER SET POINT MINUS 2 DEGREES. WHEN THE CONDENSER PUMP IS OFF THE VALVE SHALL MOVE TO THE OPEN POSITION (FULL FLOW TO TOWER).

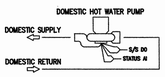

DOMESTIC HOT WATER CONTROL DIAGRAM

DOMESTIC HW PUMP CONTROL

HOT WATER PUMP CONTROL

WHEN THE BUILDING IS OCCUPIED THE DOMESTIC HOT WATER PUMP SHALL BE TURNED ON. WHEN THE BUILDING IS NOT OCCUPIED THE DOMESTIC HOT WATER PUMP SHALL BE TURNED OFF.

tBP architecture planning interiors management
tBP/Architecture
1000 Burnett Avenue, Suite 140
Concord, CA 94520
p: 925.246.6419 f: 925.246.6495
architect
AINSWORTH ASSOCIATES
MECHANICAL ENGINEERS
SACRAMENTO, CA
(209) 2009-008
consultant

EXPIRATION STAMP ONLY OF THE STATE ARCHITECT OR DELEGATION PROJECTS
APP. # 04-118626
DATE 1-13-05
BY JS

name
address
city, state, zip
ph# f/c

agency

SCIENCE BUILDING
LOS MEDANOS COLLEGE

Contra Costa Community College District

owner


tBP project number : 20241.00
file name:
drawn by: checked by:
date: NOVEMBER 15, 2004

Rev:	date:	description:

drawing title:
MECHANICAL-
CONTROL DIAGRAMS

LMC SCIENCE 313-023-112.01-00.00
drawing no:
M5.1
drawing of ?

\2003-029\DWG\M5-1-2.dwg Thu, Nov\2\2004-03:49pm

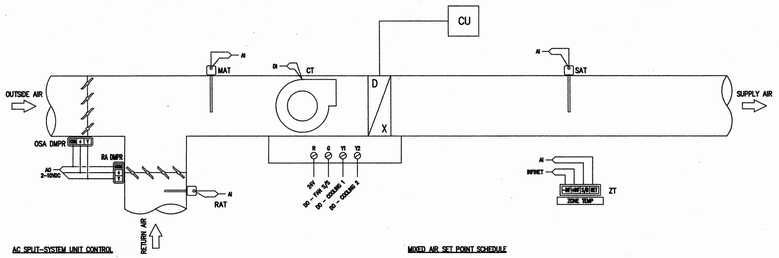

AC SPLIT-SYSTEM UNIT CONTROL

FAN CONTROL

THE FAN SHALL BE TURNED ON WHEN THE UNIT SCHEDULED IS ON. IF THE UNIT SCHEDULE IS OFF THE FAN SHALL BE TURNED OFF. AFTER THE FAN IS TURNED OFF, A FIVE MINUTE TIME DELAY MUST ELAPSE BEFORE THE FANS CAN BE TURNED BACK ON.

COOLING CONTROL

WHEN THE FAN IS ON AND THE FAN HAS PROOF OF AIRFLOW AND THE ZONE TEMPERATURE IS ABOVE ITS SET POINT PLUS TWO (+2) DEGREES AND THE SUPPLY AIR TEMPERATURE IS ABOVE 62 DEGREES THEN THE FIRST STAGE OF COOLING SHALL BE TURNED ON. IF THE SUPPLY AIR TEMPERATURE IS ABOVE 62 DEGREES FOR FIVE MINUTES THE SECOND STAGE OF COOLING SHALL BE TURNED ON. IF THE ZONE TEMPERATURE FALLS BELOW ITS SET POINT OR THE FAN STATUS IS OFF OR THE FAN IS OFF THEN THE COOLING SHALL BE TURNED OFF. IF THE SUPPLY AIR TEMPERATURE SHOULD FALL BELOW THE LOW LIMIT LOCKOUT SET POINT OF 44 DEGREES ONE STAGE OFF COOLING SHALL BE TURNED OFF FOR A FIVE MINUTE TIME DELAY.

ECONOMIZER CONTROL

WHEN THE FAN IS ON AND THE OUTSIDE AIR TEMPERATURE IS BELOW THE OUTSIDE AIR LOCKOUT SET POINT (ADJUSTABLE) OF 68 DEGREES MINUS 2 (-2) DEGREES AND THE OUTSIDE AIR TEMPERATURE IS BELOW THE RETURN AIR TEMPERATURE MINUS 2 (-2) DEGREES THE OUTSIDE AIR DAMPERS SHALL MODULATE TO MAINTAIN A MIXED AIR SET POINT. IF THE OUTSIDE AIR TEMPERATURE RISES ABOVE THE OUTSIDE AIR LOCKOUT SET POINT OR THE OUTSIDE AIR RISES ABOVE THE RETURN AIR SET POINT OR THE HEATING IS ON THE DAMPERS SHALL MODULATE TO THEIR MINIMUM POSITION OF 20% (ADJUSTABLE). THE DAMPERS SHALL CLOSE WHEN THE FAN IS TURNED OFF.

MIXED AIR SET POINT SCHEDULE


MAX ZONE DIFF	MA SET POINT
0	70
0.5	62.5
1	55

ZONE DIFF = (VAV ZONE SPACE TEMP – VAV ZONE SPACE SET POINT)

ALARM(S)

A DAILY RUNTIME ALARMS IS BEING CALCULATED FOR THIS UNIT. ONCE THE RUNTIME ALARM EXCEEDS A 24 HR. LIMIT (ADJUSTABLE) AND ALARM IS LOGGED AND SENT TO THE ALARM VIEW WINDOW. ONCE THE UNIT IS SHUT DOWN THE DAILY RUNTIME WILL RESET TO ZERO.
IF BOTH STAGES OF COOLING ARE ON AND THE SUPPLY AIR TEMPERATURE IS ABOVE 60 DEG. FOR MORE THAN 15 MINUTES A COOLING ALARM SHALL BE GENERATED.
IF THE ZONE IS OCCUPIED AND THE ZONE TEMPERATURE IS +/– 5 DEGREES FROM SET POINT FOR 15 MINUTES AN OUT OF RANGE TEMPERATURE ALARM SHALL BE ACTIVE.

AC SPLIT SYSTEM
ACI-1, ACI-2, ACI-3, ACI-4, ACS-1, ACS-2
Add ACI-4 to AC Split System control diagram title.
ADDENDUM No. 1

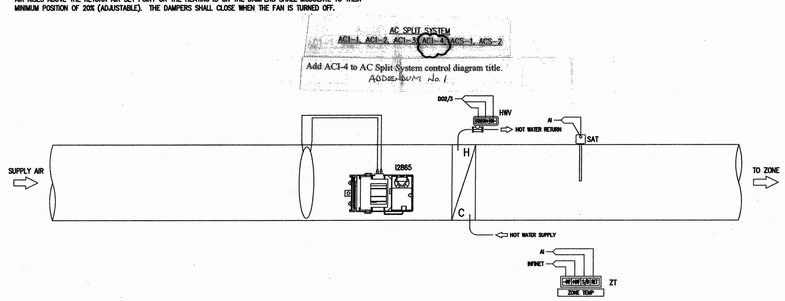

VAV ZONE W/REHEAT

VAV DAMPER CONTROL

THE VAV DAMPER SHALL MODULATE TO MAINTAIN ITS CFM SET POINT WHEN THE FLOOR IS SCHEDULED ON OR ITS OVERRIDE IS ACTIVE. THE DAMPER SHALL CLOSE WHEN SCHEDULE AND THE OVERRIDE IS INACTIVE.

CFM SET POINT CONTROL

THE CFM SET POINT SHALL BE RESET FROM ITS MINIMUM TO MAXIMUM CFM SET POINTS BY A PI CALCULATION TO MAINTAIN ITS ZONE TEMPERATURE COOLING SET POINT OF 74 DEG. (ADJUSTABLE).
NOTE: THE COOLING SET POINT SHALL ALWAYS BE AT LEAST 4 DEGREES HIGHER THAN THE HEATING SET POINT.

HOT WATER VALVE CONTROL

WHEN THE SPACE TEMPERATURE IS BELOW ITS SPACE SET POINT THE HOT WATER VALVE SHALL MODULATE TO MAINTAIN ITS SUPPLY AIR SET POINT. SEE BELOW SCHEDULE.

HOT WATER VALVE SUPPLY AIR SET POINT

THE SUPPLY AIR SET POINT SHALL BE RESET BASED ON THE ZONE TEMPERATURE VARIANCE FROM THE ZONE TEMPERATURE HEATING SET POINT OF 70 DEG. (ADJUSTABLE). SEE RESET SCHEDULE BELOW. (ZONE DIFF = ZONE TEMPERATURE – ZONE SET POINT)

ALARM(S)

IF THE ZONE IS OCCUPIED AND THE ZONE TEMPERATURE IS +/– 5 DEGREES FROM SET POINT FOR 15 MINUTES AN OUT OF RANGE TEMPERATURE ALARM SHALL BE ACTIVE.

REHEAT COIL

HOT WATER VALVE CONTROL

WHEN UNIT IS SCHEDULED TO RUN OR AN OVERRIDE IS ACTIVE AND SPACE TEMPERATURE IS BELOW ITS SPACE SET POINT THE HOT WATER VALVE SHALL MODULATE TO MAINTAIN ITS SUPPLY AIR SET POINT. SEE BELOW SCHEDULE.
WHEN THE UNIT IS SCHEDULED OFF AND NO OVERRIDE IS ACTIVE THE HOT WATER VALVE SHALL MOVE TO THE CLOSED POSITION

HOT WATER VALVE SUPPLY AIR SET POINT


THE SUPPLY AIR SET POINT SHALL BE RESET BASED ON THE ZONE TEMPERATURE VARIANCE FROM THE ZONE TEMPERATURE SET POINT (ADJUSTABLE). SEE RESET SCHEDULE BELOW. (ZONE DIFF = ZONE TEMPERATURE – ZONE SET POINT)

ZONE TEMP DIFF	SA SET POINT
0	70
–1	90
–2	110

ALARM(S)

IF THE ZONE IS OCCUPIED AND THE ZONE TEMPERATURE IS +/– 5 DEGREES FROM SET POINT FOR 15 MINUTES AN OUT OF RANGE TEMPERATURE ALARM SHALL BE ACTIVE.

VAV WITH HOT WATER REHEAT VALVE

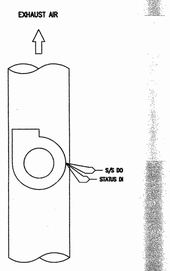

EXHAUST FAN CONTROL

EXHAUST FAN CONTROL

WHEN THE BUILDING IS OCCUPIED THE EXHAUST FANS SHALL BE TURNED ON. WHEN THE BUILDING IS UNOCCUPIED THE FAN SHALL BE TURNED OFF.

EXHAUST FAN CONTROL DIAGRAM

LABORATORY SYSTEM ZONE CONTROL (BACNET INTERFACE)

ZONE COOLING CONTROL (BACNET INTERFACE)

WHEN THE SPACE TEMPERATURE IS ABOVE ITS SPACE SET POINT THE COOLING SIGNAL SHALL RAMP TO MAINTAIN ITS ZONE SET POINT OF 72 DEG. (ADJUSTABLE).

ZONE HOT WATER VALVE CONTROL(BACNET INTERFACE)

WHEN THE SPACE TEMPERATURE IS BELOW ITS SPACE SET POINT THE HOT WATER VALVE SHALL MODULATE TO MAINTAIN ITS SUPPLY AIR SET POINT. SEE BELOW SCHEDULE.


ZONE HOT WATER VALVE SUPPLY AIR SET POINT (BACNET INTERFACE)

THE SUPPLY AIR SET POINT SHALL BE RESET BASED ON THE ZONE TEMPERATURE VARIANCE FROM THE ZONE TEMPERATURE SET POINT (ADJUSTABLE). SEE RESET SCHEDULE BELOW. (ZONE DIFF = ZONE TEMPERATURE – ZONE SET POINT)


ZONE TEMP DIFF	SA SET POINT
0	70
–1	90
–2	110


ZONE ALARM(S) (BACNET INTERFACE)


IF THE ZONE GOES INTO ALARM A GENERAL FAILURE ALARM SHALL BECOME ACTIVE.

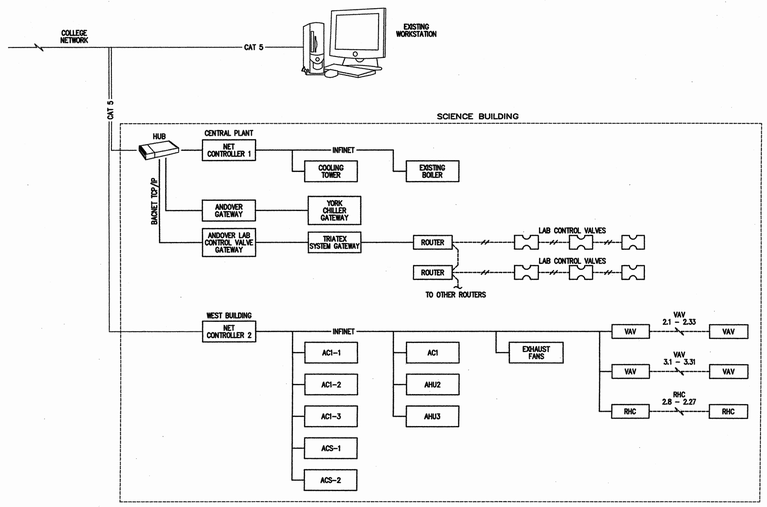

CONTROL RISER DIAGRAM

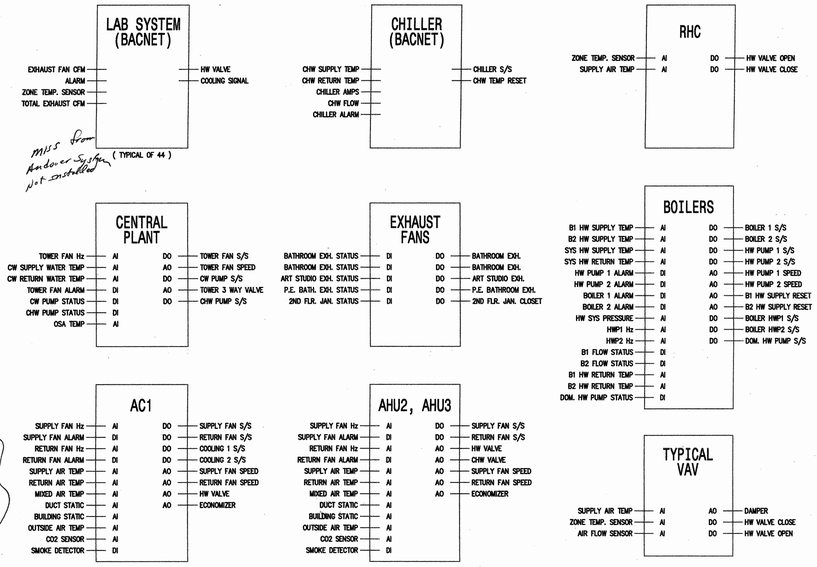

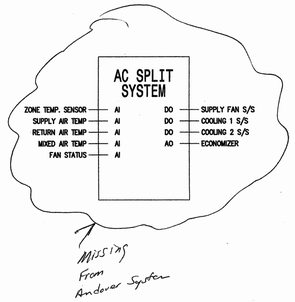

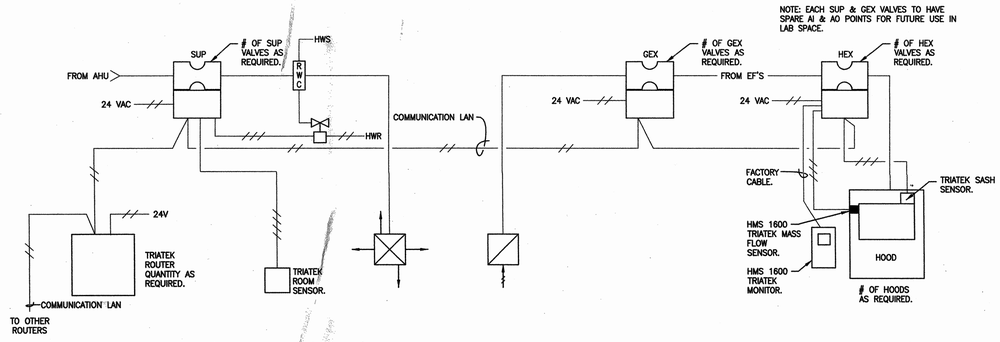

NOTE: ALL LAB COMPONENTS AND POWER SUPPIES SHALL BE UL OR ETL LISTED.

LAB CONTROL WIRING DETAIL

tBP
architecture
planning
interiors
management
tBP/Architecture
1000 Burnett Avenue, Suite 140
Concord, CA 94520
p: 925.246.6419 f: 925.246.6495
architect
AINSWORTH ASSOCIATES
MECHANICAL ENGINEERS
SACRAMENTO, CA
consultant

ENVIRONMENTAL STAMP
DEPT. OF REGULATION SERVICES
APP. APPROVED
DATE

name
address
city, state, zip
ph:
fx:
agency

SCIENCE BUILDING
LOS MEDANOS COLLEGE
Contra Costa Community College District

owner

tBP project number : 20241.00
file name:
drawn by: checked by:
date: NOVEMBER 15, 2004

Rev:	date:	description:

drawing title:
MECHANICAL: CONTROL DIAGRAMS

LMC SCIENCE 313-023-112.01-0-00.00
drawing no.: M5.2
drawing of ?

\2005-OCP\DWGS\M-51-2.dwg Time:Nov\l\2004-05:44pm

S. J. AMOROSO
Request For Information/Clarification

DSA FILE NO. 7-C1
DSA APPL. No. 01-106226

To: tBP/Architecture, 1000 Burnett Ave, Suite 140, Concord, CA 94520
Attn: Celia Chiang, Tom Beckett
Fax: 925-246-6495
Subj.: VAV Support Detail
Project: LOS MEDANOS COLLEGE SCIENCE BUILDING, Contra Costa Community College District
tBP pln: 20247.00
RFI No: 233
Reference (dwg, spec.) : M6.1 Details 3, 12
Subcontractor RFI: Monterey 8
Reply Requested By: 6/2/06

INFORMATION REQUESTED: Date: 5/26/06

Please note the attached Monterey Mechanical RFI No. 8 regarding the VAV box support details 3 and 12 on M6.1. Please advise.

SUGGESTED SOLUTION:
Cost Impact: ☐ Schedule Impact: ☐ days By: Mark Delgado

RESPONSE: DATE: 5.31.06
AAMS response: Proposed support details appear acceptable to AAMS.
Recommend accepting proposed attachment details at no cost or schedule
DASSE Response: Use of detail no. 9 with mark-ups is structurally acceptable. Use of Tolco concrete inserts is structurally acceptable.

Attachments:
By: AAMS / DASSE

TRANSMITTAL RECORD:

FROM	TO	DATE
S.J. AMOROSO	tBP / ARCHITECTURE	5/26/06
tBP / ARCHITECTURE	ENGINEER/CONSULTANT	5.31.06
ENGINEER/CONSULTANT	tBP / ARCHITECTURE	5.31.06
tBP / ARCHITECTURE	S.J. AMOROSO	5.31.06
S.J. AMOROSO	ORIGINATOR	

RFI # 000
Page 1

MONTEREY MECHANICAL
ENGINEERING CONTRACTING FABRICATION
3665 Wilbur Ave, Antioch, CA 94509 ● Phone: (925) 757-6400 ● Fax: (925) 757-6576

REQUEST FOR INFORMATION

PROJECT: Los Medanos College Science Building
MMC RFI #: 008
SUBJECT: VAV Box Support Detail
DATE REQUESTED: 6/1/06

QUESTION

FROM: Steve Harris-MMC | TO: Mark G. Delgado-SJA | DATE: 6/26/06

Reference Drawing: M6.1, Detail 12, Detail 3
Reference Specification: Div 16


1. Detail 12 calls for supports consisting of hanger rods and channel strut for all VAV boxes. To help with access to the controls and actuators mounted to the side of the VAV's we propose using the attached detail marked No.5, that uses straps for boxes under 50lbs.(wet). The straps can be hung as not to block access of controls. All boxes over 50lbs. would be supported by Detail 12 as shown on Contract drawing M6.1.
2. Detail 3 shows several options for upper rod inserts for pipe. We would like to use a pre fabricated concrete deck insert Tolco Fig. 109A with 3/8"rod for all VAV boxes over 50 lbs. This insert has been previously approved for use as a pipe insert on this project. See attached sheet.


Please Advise

RESPONSE

FROM: | TO: | DATE:

DASSE Response
1. Use of detail no 9 with mark-ups is structurally acceptable.
2. Use of Tolco concrete insert is structurally acceptable. Guy J 5-31-06

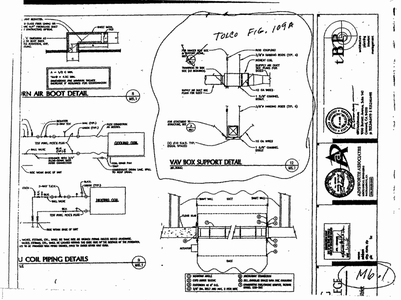

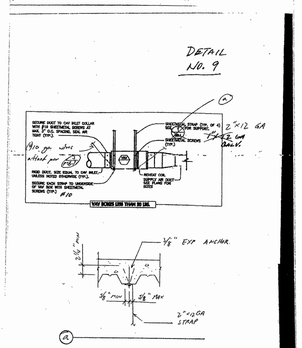

S. J. AMOROSO
Request For Information/Clarification

DSA FILE NO. 7-C1
DSA APPL. No. 01-106226

To: tBP/Architecture, 1000 Burnett Ave, Suite 140, Concord, CA 94520
Attn: Celia Chiang, Tom Beckett
Fax: 925-246-6495
Subj.: Lab exhaust hood connections
Project: LOS MEDANOS COLLEGE SCIENCE BUILDING, Contra Costa Community College District
tBP pln: 20247.00
RFI No: 261
Reference (dwg, spec.) : 14/M6.1, spec 15890-1.02C
Subcontractor RFI: Monterey 10.1
Reply Requested By: 7/26/06

INFORMATION REQUESTED: Date: 7/20/06

See attached Monterey RFI No. 10.1 regarding Lab Hood Exhaust Duct Transverse Joint. Please advise.

SUGGESTED SOLUTION:
Cost Impact: ☐ Schedule Impact: ☐ days By: Justin Warren

RESPONSE: DATE:
Proposed exhaust duct joint has been accepted by Owner and Design team.

Dave Reston/AAMS - 8/21/06

RFI # 000
Page 1

MONTEREY MECHANICAL
ENGINEERING CONTRACTING FABRICATION
3665 Wilbur Ave, Antioch, CA 94509 ● Phone: (925) 757-6400 ● Fax: (925) 757-6576

REQUEST FOR INFORMATION

PROJECT: Los Medanos College Science Building
MMC RFI #: 010
SUBJECT: Stainless Steel Lab Hood Exhaust Duct Transverse Joint
DATE REQUESTED: 8/2/06

QUESTION


FROM: Steve Harris-MMC | TO: Mark G. Delgado-SJA | DATE: 6/21 /06


Reference Drawing: M6.1, Detail 14
Reference Specification: 15890, 1.02, C

1. Detail 14, drawing M6.1 indicates that the lab hood exhaust duct is to be constructed using 18 gage stainless steel with welded joints. We will need to provide a flanged joint, at a minimum, where the duct attaches to a lab air valve, flex connection to equipment, and at the hoods. No detail has been provided in the contract documents so we propose using the attached "Hood Exhaust Duct Transverse Joint Detail Connection Detail". This is an industrial type detail that is commonly used for heavy gage ductwork. In fact, Monterey Mechanical used this exact joint detail to join the 18 gage ductwork exhausting the 140 fume hoods that was part of the U.S. Geological Survey Facility in Menlo Park. The project fume hoods that was part of the U.S. Geological Survey Facility in Menlo Park. The project specified Plastite joint adhesive for all fume duct sealing that included approximately 5000 joints. The Plastite provides a bond almost as permanent as weld. Although, with some effort you can break the seal with a thin saw blade if equipment needs to be replaced, or duct changes are required. Plastite was also used in a spray form to coat the interior of fume ducts, so it performs well when exposed to chemicals.

We would also propose the use of this joint detail in lieu of field welding. Field welds can be prone to deficiencies as the environment can not always be controlled, not to mention the additional issues associated with welding in place. Welding in a shop environment is conducive to the fabrication process, we would shop fabricate the ductwork and ship to the site in the largest sections practical to minimize field joints. We feel that both the Owner and Monterey Mechanical would benefit from the use of this joint, while it is not an inexpensive joint, the flanges add strength to the duct, and allow more flexibility in the installation. See the attached documentation.


Please Advise

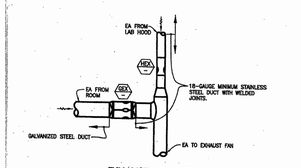

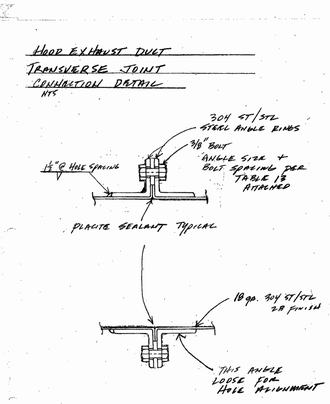

LABRATORY DUCT CONSTRUCTION DETAIL 14 M6.1
NO SCALE

RFI # 000
Page 1

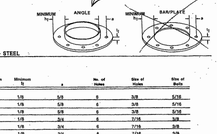

FLANGE (TYPE F-1) — STEEL

Inside Diameter	Minimum No	Minimum In	A	No. of Holes	Size of Holes	Size of Bolts
4-1/16	1	1/8	3/8	8	3/8	3/16
8-1/8	1	1/8	3/8	8	3/8	5/16
8-1/8	1	1/8	3/8	8	3/8	5/16
10-1/8	1-1/8	1/8	3/8	8	7/16	3/8
12-1/8	1-1/4	1/8	3/8	8	7/16	3/8
14-1/8	1-1/4	1/8	3/8	8	7/16	3/8
16-1/8	1-1/4	1/8	3/8	8	7/16	3/8
18-1/8	1-1/4	1/8	3/8	10	7/16	3/8
20-1/8	1-1/4	1/8	3/8	10	7/16	3/8
22-1/8	1-1/2	3/16	7/8	12	7/16	3/8
24-1/8	1-1/2	3/16	7/8	12	7/16	3/8
28-1/8	1-1/2	3/16	7/8	14	7/16	3/8
28-1/8	1-1/2	3/16	7/8	14	7/16	3/8
30-1/8	1-1/2	3/16	7/8	16	7/16	3/8
32-1/8	1-1/2	3/16	7/8	16	7/16	3/8
34-1/8	1-1/2	3/16	7/8	18	7/16	3/8
36-1/8	1-1/2	3/16	7/8	18	7/16	3/8
38-1/8	2	3/16	1-1/8	20	7/16	3/8
40-1/8	2	3/16	1-1/8	20	7/16	3/8
42-1/8	2	3/16	1-1/8	22	7/16	3/8
44-1/8	2	3/16	1-1/8	22	7/16	3/8
46-1/8	2	3/16	1-1/8	24	7/16	3/8
48-1/8	2	3/16	1-1/8	24	7/16	3/8
50-1/8	2-1/2	3/16	1-3/8	26	7/16	3/8
52-1/8	2-1/2	3/16	1-3/8	26	7/16	3/8
54-1/8	2-1/2	3/16	1-3/8	28	7/16	3/8
56-1/8	2-1/2	3/16	1-3/8	28	7/16	3/8
58-1/8	2-1/2	3/16	1-3/8	30	7/16	3/8
60-1/8	2-1/2	3/16	1-3/8	30	7/16	3/8

NOTE: Dimensions shown apply for plate flanges and angle flanges. Common steel table A-36*.

Copyright © 1977 All rights reserved. This material may not be reproduced in any form

5-6

PHYSICAL SPECIFICATIONS (Cont.)

Thermal Shock: PLASITE 7122, 7122HAR, 7122TFE & 7122HARAS - Unaffected in 5 cycles, minus 70°F to plus 212°F.
PLASITE 7122AS - Test not run, but similar to other PLASITE 7122 systems.
Water: PLASITE 7122 - 96 at 77°
PLASITE 7122HAR, 7122TFE & 7122HARAS - 47 at 66°
PLASITE 7122AS - NR

FILM THICKNESS PER COAT
PLASITE 7122, 7122HAR, 7122TFE & 7122HARAS - 6 to 8 mils dry, 10 to 14 mils wet (depending on substrate)
PLASITE 7122AS - 12 mils to 125 sq ft/gal, caulking gun or spatula.

COVERAGE
PLASITE 7122, 7122HAR, 7122TFE & 7122HARAS - 800 sq ft/gal, 1 gallon will yield approximately 100 sq ft at 8 mils dry film, not including waste.
PLASITE 7122AS - 1 gallon will yield approximately 160 cubic inches.

THINNERS
PLASITE 7179Clear - A medium fast thinner to be used for internal tank lining.

PLASITE 79 Thinner - A slower thinner to be used in services that do not include immersion where application conditions require a slower thinner.

It will always be necessary to thin the coating. The applicator must make exact thinner adjustments based on his equipment and on surface temperature. The following thinning guidelines are suggested.

Normal application temperatures and conditions will require the addition of approximately 10% thinner by volume with approximately 5% additional thinner added for each 10° increase in temperature. It is recommended that the amount of thinner required on each order amount to approximately 20% of the coating used.

DRYING TIMES
PLASITE 7122, 7122HAR, 7122TFE & 7122HARAS - Surface dry-hard to tack-free in 7 to 9 hours at 70°F.
PLASITE 7122AS - Tack-free in 1 to 2 hours at 70°F.

CURING
Maximum chemical resistance and coating will take place in 5 days at 70°F. PLASITE 7122 and 7122HAR coatings should not be applied when air temperature or temperature of surface to be coated is below 50°F. Allow 10 hours after 50°F. temperature is reached before immersion service. PLASITE 7179 is required for proper polymerization. PLASITE 7122 systems should be thick cured for all fume sensitive immersion services.

PLASITE 7122/HAR/AS and 7122AS are not intended for immersion service.

Fume curing at elevated temperatures does increase resistance to certain chemicals; therefore, when exposure to these chemicals is recommended to obtain maximum resistance.

Listed below are a few fume curing schedules that may be used for time and work planning. Allow to stand at room temperature for 4 hours before exposing to fumes. Fume at 70°F. for 24 hours, then at 90°F. 

Actual fume curing schedules will depend on the job conditions and the type of fumes to be encountered. The above schedules are suggested as a guide only. Final cure may be checked by exposing cured surface to fumes and then checking for softness. Softness indicates incomplete cure. Fume curing can be considered complete when surface remains hard after exposure to fumes. The film should remain/be/ after exposure if curing is properly noted.

SURFACE PREPARATION
PLASITE 7122, 7122HAR & 7122TFE
Steel
High Temperature & Immersion Service
All sharp edges shall be ground to produce a radius and all imperfections such as; slag welds, delamination, etc. may be used. Hand blast any rust, mill scale or abrasive blasting. Slag welds shall be vertical cold.

Degrease surface prior to sandblasting. Organic solvents, alkaline solutions, steam, hot water with detergents or other systems that will completely remove dirt, oil, grease, etc. from the surface. Hand blasting may required additional decontamination.

The surface shall be blasted to an SSPC-SP6 or NACE No. 1 white metal surface using a Venturi blast nozzle supplied with 80 to 100 psi. An anchor pattern of "keen" to the touch is recommended and shall be checked by an SPG to the total film thickness of the coating.

Contaminated grit shall not be used for the finish work.

The blasting media used shall be a natural abrasive, in good grit, of dag grit (similar or equal to BLACK BEAUTY). The blasting media shall be free of oil or any hard contaminated that the amount of thinner required on each order amount to approximately 20% of the coating used.

The anchor pattern shall be sharp and no evidence of a polished surface is allowed.

Remove all traces of grit and dust with a vacuum cleaner or by brushing. Care must be taken to avoid contaminating the surface with fingerprints or from contaminants carried on the worker's clothes.

The surface temperature shall be maintained at a minimum of 5°F/3°C above the dew point to prevent oxidation of the surface. The coating shall be applied within the same day that the surface has been prepared. Visible oxidation or contamination is not allowed.

PLASITE 7122/HARAS
Steel
Properly applied and PLASITE 7122 or 7122HAR which will require a minimum SSPC-SP6 commercial blast cleaning with a surface profile of 1 mil to 2 mils. Brush off 20 to 50% of the total film thickness of the system.

spray gun to first opening liquid valve and then adjusting air valve to give an 8-12 inch wide spray pattern with best possible atomization.

Airless Spray Application
Allow to dry approximately one minute but not long enough to allow film to completely dry.

Apply crisscross multi-passes, ensuring gun is fairly rapid rate, maintaining a wet edge throughout application. Allow to dry approximately 30 minutes. Apply second coat together as will have an average D.F. (WFDR-17) mils/unit wet film. By allowing the coating to flashoff for a few minutes, several more feet multi-passes may be applied before the film will set up. Allow to dry approximately 30 minutes. Apply third coat as per above procedure for overall total average D.F. (WFDR-17) mils/unit wet film.

Overcoat time will vary both with temperature and ventilation and will equate 8-12 hours at 70°F/21°C for exposed systems. Less time is required for exposure. Remove all overspray by dry brushing or scraping if required.

Clean equipment with PLASITE 7179 Thinner immediately after use with Plastite thinner to prevent the setting of the coating.

Note: Do not use PLASITE 7179 Thinner on rubber, neoprene, and butyl linings/joints using PLASITE 7122 thinned a minimum of 25% by volume with PLASITE 7179Thinner.

Brush
Brush recommended for small areas and repairs only. Use a high quality brush and apply PLASITE 7122 in even coats of about 3 mils dry film per coat. Allow to dry 8 hours at 70°F/21°C. Apply second coat. Allow to dry 8 hours at 70°F/21°C. Apply third coat. Allow to dry to "brush out." Allow to dry total time. Reverse until surface film thickness is built up to 12 mils dry film thickness of 2.5-3 mils/12ft returns can be obtained per coat by this method.

Note: PLASITE 7122/HAR/AS requires special frequently when applied by brush.

Roller
Roller application of PLASITE 7122, 7122HAR and 7122TFE: Surface will normally be cure-free in 2-3 hours at 70°F/21°C.

Overcoat time will vary both with temperature and curing will take place in 5 days at 70°F/21°C. PLASITE 7122 systems should not be applied when air temperature or temperature of surface to be coated is below 50°F/10°C. Allow 24 hours after 50°F/10°C. temperature is reached before immersion service. PLASITE 7179 is required for proper polymerization. PLASITE 7122 systems should be fume cured for all fume sensitive immersion services.

Fume curing at elevated temperatures does increase resistance to certain chemicals; therefore, when exposure to these chemicals is recommended to obtain maximum resistance.

Listed below are a few fume curing schedules that may be used for time and work planning. Prior to exposing the metal to the fume curing temperature, it is necessary that the coating be allowed to cure at room temperature for 24 hours. Fume at 70°F/21°C. for 24 hours, then at 90°F/32°C. for an additional 24 hours. The temperature should be raised by approximately 20°F/10°C. every 24 hours until the desired fume curing temperature is reached.

Final cure may be checked by exposing cured surface to fumes and then checking for softness. Softness indicates incomplete cure. Fume curing can be considered complete. Surface should exhibition after exposure if properly cured.

INSPECTION
Refer to Plastite Bulletin PA-3, Section 5, for inspection requirements.

SAFETY NOTICE
PLASITE 7122 CONTAINS ISOCYANATE AND CAN BE DEMANDED BY GOOD PRACTICE, STATE AND LOCAL SAFETY CODES, ETC. MUST BE USED WITH ADEQUATE VENTILATION. Avoid breathing vapors and spray mist. Avoid contact with skin and eyes. Use protective clothing and respirator approved for isocyanate spray mist. When working in tanks, rooms and other enclosed spaces, adequate ventilation must be provided. Refer to Plastite Bulletin PA-3. Keep out of the reach of children.

CAUTION - Read and follow all caution statements on this product data sheet, material safety data sheet and container label for this product.



S. J. AMOROSO
Request For Information/Clarification

DSA FILE NO. 7-C1
DSA APPL. No. 01-106226

To: tBP/Architecture, 1000 Burnett Ave, Suite 140, Concord, CA 94520
Attn: Celia Chiang, Tom Beckett
Fax: 925-246-6495
Subj.: Lab exhaust hood connections
Project: LOS MEDANOS COLLEGE SCIENCE BUILDING, Contra Costa Community College District
tBP pln: 20247.00
RFI No: 261.1
Subcontractor RFI: Monterey 10.1
Reply Requested By: 7/26/06

INFORMATION REQUESTED: Date: 7/26/06

See attached Monterey RFI No. 10.1 regarding Lab Hood Exhaust Duct Transverse Joint. Please advise.

SUGGESTED SOLUTION:
Cost Impact: ☐ Schedule Impact: ☐ days By: Justin Warren

RESPONSE: DATE:
Proposed exhaust duct joint has been accepted by Owner and Design team.

Dave Reston/AAMS - 8/21/06

RFI # 000
Page 1

WISCONSIN PROTECTIVE COATINGS CORP.
MANUFACTURERS
HI-RESISTANT PROTECTIVE COATINGS
P.O. BOX 0147
GREEN BAY, WISCONSIN 54305-0147
PHONE: (800) CODE 414 - (920) 497-6040
ORDER ENTRY FAX: (414) - 437-8249 LAB AND MARKETING FAX: (414) - 437-8305

TECHNICAL BULLETIN
7122AS
FEBRUARY 1993
(Replaces December 1992)

PLASITE 7122AS JOINT ADHESIVE SEALANT

TYPE: High solids modified epoxy sealer cured with an alkaline curing agent.

INTENDED USE: As a sealer and adhesive for seams and interlocks for interior and bottom of fume hood exhaust ducts.

FOR INDUSTRIAL USE ONLY!

CHEMICAL RESISTANCE: Excellent chemical resistance to a wide range of acids, alkalies, solvents and water solutions.
SURFACE PREPARATION: Steel surfaces may be prepared by blasting as required by ZONE OF USAGE. Refer to PLASITE Technical Bulletin 7122.
APPLICATION PROCEDURE: Stiff bristle brush; caulking gun; spatula technique.
POT LIFE: 2 hours at 70°F.
CURING TIME:
DRYING TIME: Tack free in 1 to 2 hours at 70°F.
CURING TIME: 5 to 7 days at 70 to 90°F.
SOLIDS: 80% ±4% by weight; 70% ±4% by volume.
VOC CONTENT: 2.8 lbs. per gallon; 33.5 lbs. per gallon.
SHELF LIFE: 6 months at 70°F.
ADDITIONAL INFORMATION: For additional application information refer to fume hood exhaust systems - Bulletin 205-372.

VOLATILE ORGANIC COMPOUNDS CONTENT

COLOR	COATING AS SUPPLIED (ASTM METHOD D2369) Lbs./Gal	Grams/Liter
Lt. Grey	1.39 ±4%	162 ±4%

READ THIS NOTICE
SAFETY AND MISCELLANEOUS EQUIPMENT

For tank lining work, it is recommended that the operator provide himself with clean coveralls and rubber soled shoes and observe good personal hygiene. Certain personnel may be sensitive to various types of resins which may cause dermatitis.
2. THE SOLVENT IN THIS COATING IS FLAMMABLE AND CARE AS DEMANDED BY GOOD PRACTICE, STATE AND LOCAL SAFETY CODES, ETC. MUST BE USED. Keep away from heat, sparks and open flame and use necessary safety precautions to avoid fire. Avoid contact with eyes, skin and clothing. Avoid breathing vapors and spray mist. When working in tanks, rooms and other enclosed spaces, adequate ventilation must be provided. Refer to PLASITE Bulletin PA-3.
3. CAUTION - Read and follow all caution statements on this product technical bulletin, material safety data sheet and container label for this product.

7122 Systems
High Solids Epoxy Protective Coatings
7122HAR • 7122TFE
7122HARAS & 7122AS
Meets FDA Requirements

PLASITE PRODUCT DATA

TYPE
PLASITE 7122 is a cross linked epoxy phenolic cured with an alkaline curing agent formulated with a wide range of chemical resistance. PLASITE 7122 systems are recommended for use in immersion service environments where staining, blistering, solvation and other physical properties of PLASITE 7122.

INTENDED USE
PLASITE 7122 - As a tank lining and for industrial maintenance.
PLASITE 7122HAR - As a tank lining and for industrial maintenance where additional abrasion resistance is required.
PLASITE 7122TFE - As a tank lining and for industrial maintenance where release properties are required to facilitate weld product shelling, lining-in and forming systems.
PLASITE 7122HARAS - As a fiber coating for areas where abrasion and chemical resistance is required.
PLASITE 7122AS - As a water and solvent adhesive for seams and interlocks for the interior and exterior of fume hood ductwork.

PLASITE 7122 systems meet the FDA requirements for 21 CFR, 175.300. FOR INDUSTRIAL USE ONLY!

TEMPERATURE RESISTANCE
Dry Heat: Continuous to 300°F in vehicle. Continuous immersion to 200°F in water or petroleum refinegas.

COLORS
PLASITE 7122 - Grey, Lt. Grey, Med. Grey, White, Lt. Buff
PLASITE 7122HAR - Green, Lt. Grey, Med. Grey, White
PLASITE 7122TFE - Off White, Lt. Grey, Med. Grey
PLASITE 7122HARAS - Lt. Grey, Med. Grey, Green
PLASITE 7122AS - Grey

Water Stable colors may not be suitable for food service. Consult Carboline Technical Service Department.

VOC CONTENT

Solids*	COATING AS SUPPLIED (ASTM METHOD D2369)		TOTALLY CURED FILM (ASTM METHOD D3960)	
	Lbs./Gal	Grams/Liter	Lbs./Gal	Grams/Liter
70%	3.50 ±3%	419 ±3%	5.00 ±3%	419 ±3%
71%HAR	3.54 ±3%	423 ±3%	3.65 ±3%	437 ±3%
74%TFE	3.64 ±3%	435 ±3%	3.81 ±3%	456 ±3%
70%HARAS	3.80 ±3%	455 ±3%	5.43 ±3%	650 ±3%
100%AS	1.91 ±3%	229 ±3%	Not Required	Not Required

VOC content varies between colors. Contact Plastite Technical Service Department for VOC of specific colors.

PHYSICAL SPECIFICATIONS
Pigments: Titanium-dioxide, inerts and tinting colors.

Solids: PLASITE 7122 - 67% ±2% by weight; 50% ±2% by volume
PLASITE 7122HAR - 68% ±2% by weight; 50% ±2% by volume
PLASITE 7122TFE - 69% ±2% by weight; 51% ±2% by volume
PLASITE 7122HARAS - 76% ±2% by weight; 63% ±2% by volume
PLASITE 7122AS - 69% ±2% by weight; 78% ±2% by volume

Pot Life: PLASITE 7122, 7122HAR, 7122TFE & 7122HARAS - Approx. 24 hours at 70°F.
PLASITE 7122AS - Approx. 8 hours at 70°F.

Shelf Life: PLASITE 7122, 7122HAR, 7122TFE & 7122HARAS - 24 months at 70°F.
PLASITE 7122AS - 6 months at 70°F.
Material is also should be kept from direct sunlight down away from heat.

Spray Viscosity: PLASITE 7122 - 28 to 7 seconds Ford Cup #4 depending on color
PLASITE 7122HAR - 27 to 7 seconds Ford Cup #4
PLASITE 7122TFE - 30 to 7 seconds Ford Cup #4 depending on color
PLASITE 7122AS - N/A

Shipping Weight: Approximately 13.3 lbs/gal.

*Abrasion Resistance: Average loss per 1000 cycles, Taber CS-17 wheel, 1000 gram load.
PLASITE 7122 - 47 milligrams
PLASITE 7122HAR - 5.6 milligrams
PLASITE 7122TFE - 47 milligrams
PLASITE 7122HARAS - Similar to 7122HAR.
PLASITE 7122AS - NA

Note: Taber test cannot be conducted due to soft consistency.

*Surface Hardness: ASTM Method D4366-84 Koenig Pendulum (Glass Standard = 250 seconds)
PLASITE 7122 - 180 seconds
PLASITE 7122HAR - 180 seconds
PLASITE 7122TFE - 180 seconds
PLASITE 7122HARAS - 180 seconds

*Note: Above tests were conducted on film cured at 150°F.

PLASITE® 7122

The perfect pattern shall be sharp and no evidence of a polished surface is allowed.

Remove all traces of grit and dust with a vacuum cleaner or by brushing. Care must be taken to avoid contaminating the surface with fingerprints or from contaminants carried on the worker's clothes.

The surface temperature shall be maintained at a minimum of 5°F/3°C above the dew point to prevent oxidation of the surface. The coating shall be applied within the same day that the surface has been prepared. Visible oxidation or contamination is not allowed.

Surface Preparation Alternatives
Degrease surface as described above in SURFACE PREPARATION-Steel.

SSPC-SP10 or NACE No. 2 (near white metal blast cleaning) - strong fumes and splash zone.
SSPC-SP6 or NACE No. 3 (commercial blast cleaning) - high temperature fumes.
SSPC-SP3 or NACE No. 4 (brush-off blast cleaning) - chemical atmosphere and splash.
SSPC-SP2 (power tool cleaning) - chemical atmosphere and washdown.

When utilized, blistering primer should be applied as soon as possible after surface preparation.

Surface preparation for chemical atmosphere and weathering must result in a surface profile of 1 mil to 2 mils. If the steel is rolled and the type of surface preparation does not leave a reasonably rough surface on the steel, the heavy film system is not recommended.

Depending on service conditions, film thickness requirements may be reduced. Consult Carboline's Technical Service Department for further information.

Application Conditions
Contact Carboline's Technical Service Department for a recommendation.

Mixing and Thinning
Carboline Technical Service.

Agitate all to clean and process free with a fixed produced anchor pattern or "keen" as described earlier under STEEL. In addition, the blasted surface shall be vacuum cleaned to remove all dust.

PLASITE 7179 is required for proper polymerization.

PLASITE 7122 should be fume cured for all fume sensitive immersion services.

Fume curing at elevated temperatures does increase resistance to certain chemicals; therefore, when exposure to these chemicals is recommended to obtain maximum resistance.

Listed below are a few fume curing schedules that may be used for time and work planning. Prior to exposing the metal to the fume curing temperature, it is necessary that the coating be allowed to cure at room temperature for 24 hours. Fume at 70°F. for 24 hours, then at 90°F. for an additional 24 hours. The temperature should be raised by approximately 20°F/10°C. every 24 hours until the desired fume curing temperature is reached.


Final cure may be checked by exposing cured surface to fumes and then checking for softness. Softness indicates incomplete cure. Fume curing can be considered complete. Surface should exhibition after exposure if properly cured.

Inspection
Refer to Plastite Bulletin PA-3, Section 5, for inspection requirements.

Safety Notice
PLASITE 7122 CONTAINS ISOCYANATE AND CAN BE DEMANDED BY GOOD PRACTICE, STATE AND LOCAL SAFETY CODES, ETC. MUST BE USED WITH ADEQUATE VENTILATION. Avoid breathing vapors and spray mist. Avoid contact with skin and eyes. Use protective clothing and respirator approved for isocyanate spray mist. When working in tanks, rooms and other enclosed spaces, adequate ventilation must be provided. Refer to Plastite Bulletin PA-3. Keep out of the reach of children.

CAUTION - Read and follow all caution statements on this product data sheet, material safety data sheet and container label for this product.

Los Medanos College
4CD Proj. #: 1-S65-B-23-SC
Science Building

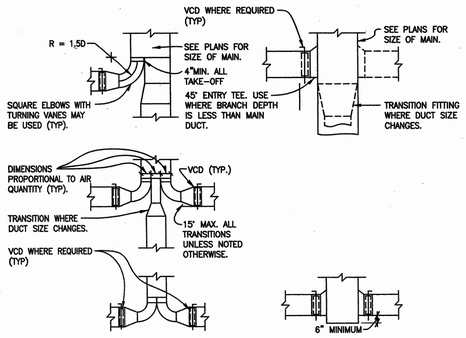

NOTE: DETAIL APPLICABLE WHERE BRANCH AIR QUANTITIES ARE 1,000 CFM OR MORE.

LARGE BRANCH DUCT

NOTE: DETAIL APPLICABLE WHERE BRANCH AIR QUANTITIES ARE LESS THAN 1,000 CFM

SMALL BRANCH DUCT

(LOW VELOCITY 1300 FPM, DUCT SYSTEMS ONLY.)


NOTE: DUCT SYSTEMS NOT INSTALLED IN ACCORDANCE WITH THIS DETAIL WILL BE REJECTED.

LOW VELOCITY BRANCH DUCT TAKE-OFF DETAIL

NO SCALE

1 / M6.1

ROUND DUCT SIZE SHALL NOT EXCEED PRESSURE DROP OF .06"/ 100FT OF DUCT. AND VELOCITY OF RECTANGULAR RUNOUT CONNECTED TO, EXCEPT AT LAB DIFFUSERS (TRITEC). AT 24x48 LAB DIFFUSERS, TRANSITION TO DIFFUSER INLET SIZE.

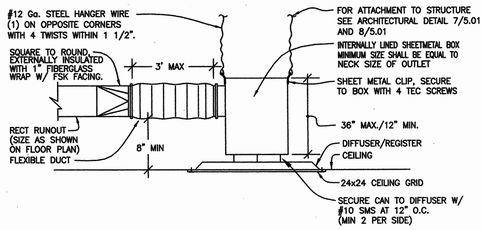


NOTES:
1. NO BENDS GREATER THAN 45° WILL BE ALLOWED IN FLEXIBLE DUCTS.
2. MINIMUM BEND RADIUS FOR FLEXIBLE DUCTS SHALL NOT BE LESS THAN 1.5
3. WIRE TIE EXTERNAL INSTALLATION IN PLACE AT MINIMUM OF 3 LOCATIONS.
4. VERIFY SHEET METAL SCREW (SMS) USED TO ATTACHED TO DIFFUSER DOES NOT IMPEDE OPPOSED BLADE DAMPER (OBD) OPPERATION.

DUCT CONNECTION TO DIFFUSER/ REGISTER DETAIL

NO SCALE:

4 / M6.1

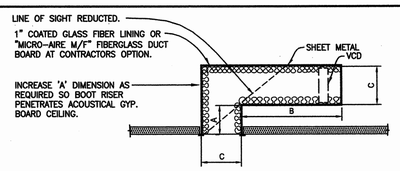


A = 1/2 C MIN.
*A+B = 4.5C MIN.
DIMENSIONS ARE MINIMUM VALUES
INCREASE IF REQUIRED FOR COORDINATION


RETURN AIR BOOT DETAIL

SEE RFI 328

NO SCALE:

8 / M6.1

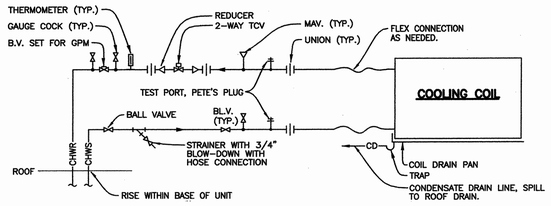

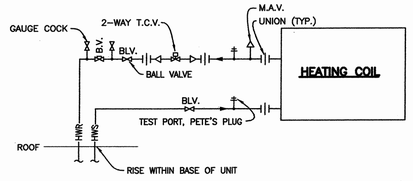


NOTES:
1. ALL VALVES, FITTINGS, ETC., SHALL BE SAME SIZE AS BRANCH PIPING UNLESS NOTED OTHERWISE.
2. ALL VALVES, FITTINGS, ETC., SHALL BE LOCATED WITHING THE CORE SIDE OF THE INTERIOR OF THE PEREMITER.
3. UNITS TO BE PROVIDED WITH PIPING CHASES, PIPES TO ENTER WITHIN UNIT CURB.


AHU COIL PIPING DETAILS

SEE RFI 497, SHEET M4.1

NO SCALE

9 / M6.1

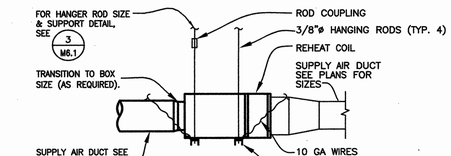

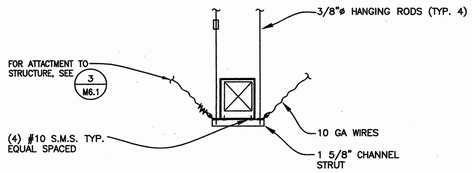


VAV BOX SUPPORT DETAIL

SEE RFI 233

NO SCALE:

12 / M6.1

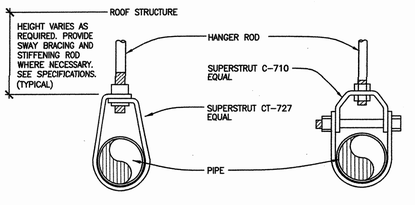

UNINSULATED COPPER PIPE — UNINSULATED PIPE


INSULATED COPPER PIPE — INSULATED PIPE


NOTE: FOR HANGER ROD SIZE & SUPPORT DETAIL, SEE 3 M6.1

PIPE HANGER DETAIL

NO SCALE:

2 / M6.1

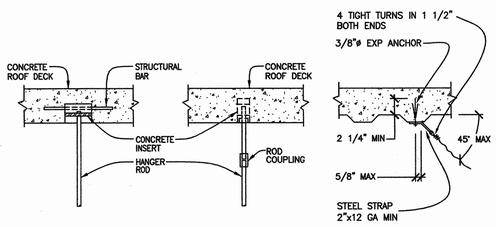

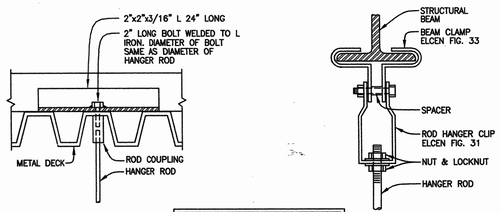


HANGER ROD SCHEDULE	
PIPE SIZE	ROD SIZE
1/2" TO 4"	3/8"ø
5" TO 8"	1/2"ø
10" TO 12"	5/8"ø

SEE RFI 233

HANGER ROD SUPPORT DETAILS

NO SCALE:

3 / M6.1

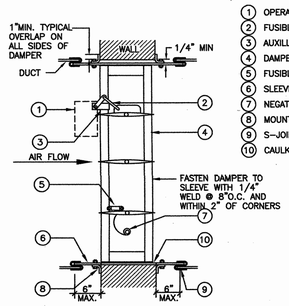


1. OPERATOR/ACTUATOR
2. FUSIBLE ROD
3. AUXILLARY OPERATING JACK SHAFT
4. DAMPER FRAME
5. FUSIBLE LINK LOCK
6. SLEEVE
7. NEGATOR SPRING
8. MOUNTING ANGLES (1 1/2"x 1 1/2" x 1/8")
9. S-JOINT, SLEEVE TO DUCT
10. CAULKING MATERIAL (GE RTV 108 SEALANT)

1. FIRE DAMPER DETAIL FOR REFERENCE ONLY.
2. FIRE DAMPERS SHALL BE STATE FIRE MARSHALL APPROVED AND INSTALLED STRICTLY PER MANUFACTURER'S PRINTED INSTRUCTIONS.
3. MANUFACTURER'S INSTALLATION INSTRUCTIONS SHALL BE MADE AVAILABLE TO THE INSPECTING AUTHORITIES.

COMBINATION FIRE/SMOKE DAMPER DETAIL

NO SCALE:

5 / M6.1

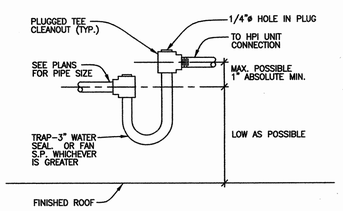


DRAIN PIPE DETAIL

NO SCALE:

6 / M6.1


DELETED PER ADDENDUM NO. 2

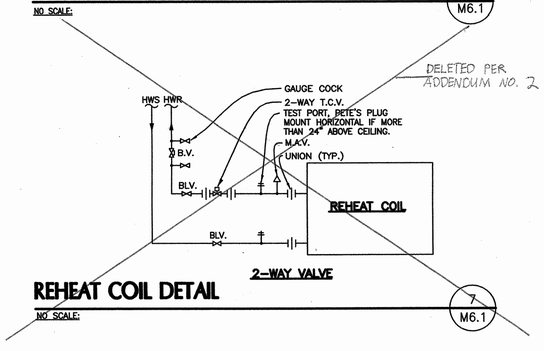

REHEAT COIL DETAIL

NO SCALE:

7 / M6.1

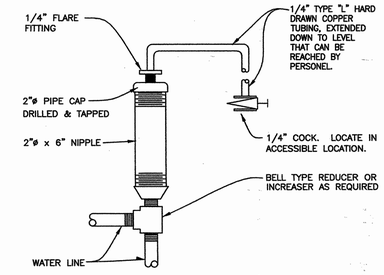


INSTALL AT ALL HIGH POINTS OF NEW PIPING AS DETAILED.

MANUAL AIR VENT DETAIL

NO SCALE:

10 / M6.1

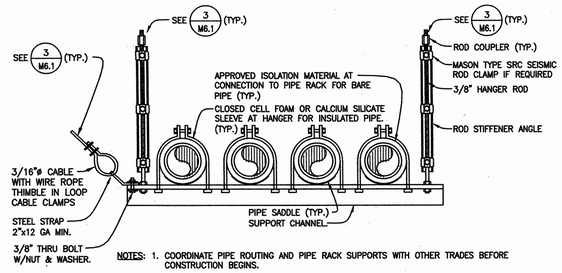


NOTES: 1. COORDINATE PIPE ROUTING AND PIPE RACK SUPPORTS WITH OTHER TRADES BEFORE CONSTRUCTION BEGINS.

TRAPEZE PIPE RACK

NO SCALE:

11 / M6.1

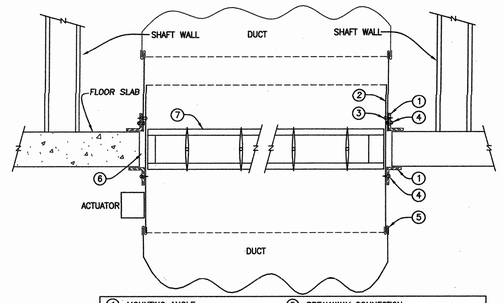

1 MOUNTING ANGLE	5 BREAKAWAY CONNECTION
2 CSFD INNER SLEEVE	6 FILL ANNULAR SPACE WITH FIRE CAULKING
3 FASTENERS AT 8" O.C.	7 COMBINATIN FIRE/SMOKE DAMPER, RUSKIN MODEL ESD-36C
4 3/8" DIA. BOLT AND NUT, 2 PER SIDE	

CSFD DETAIL FLOOR SHAFTS

NO SCALE:


NOTES:
1. DETAIL ABOVE IS FOR REFERENCE PURPOSES ONLY.
2. COMBINATION SMOKE/FIRE DAMPERS SHALL BE INSTALLED IN ACCORDANCE WITH MANUFACTURER'S INSTALLATION INSTRUCTIONS.
3. PROVIDE HINGED ACCESS DOOR AT EACH DAMPER LOCATION, SEE SPECIFICATIONS FOR ACCESS DOOR.
4. OUTER SLEEVE SHALL BE PROVIDED BY INSTALLING CONTRACTOR.

EVECTICAL


HORIZONTAL CFSD

NO SCALE:

13 / M6.1

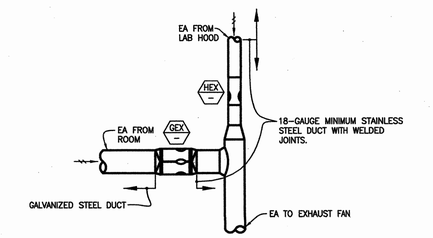

EXHAUST AIR SYSTEM

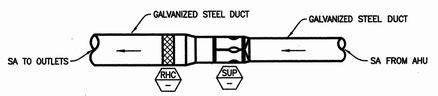

SUPPLY AIR SYSTEM

SEE RFI 261, 261.1

LABRATORY DUCT CONSTRUCTION DETAIL

NO SCALE

14 / M6.1

tBP
architecture
planning
interiors
management
tBP/Architecture
1000 Burnett Avenue, Suite 140
Concord, CA 94520
p: 925.246.6419 f: 925.246.6495
architect

AINSWORTH ASSOCIATES
MECHANICAL ENGINEERS
SACRAMENTO, CA
consultant

name
address
city, state, zip
ph:
fx:
agency

SCIENCE BUILDING
LOS MEDANOS COLLEGE

Contra Costa Community College District

owner

tBP project number : 20241.00

file name:

drawn by: checked by:

date: NOVEMBER 15, 2004

Rev	date:	description:

drawing title:
MECHANICAL-
DETAILS

LMC SCIENCE 313-023-T12.01-0-00.00
drawing no:
M6.1
drawing of ?


I:\2005-005\DWG\M-6-Lang Time Nov\20041-03.dwg, 11/15/2004 4:03:49 pm

SYSTEM NO. C–AJ–5002

F RATINGS – 2 AND 3 HR (SEE ITEMS 1A AND 4)
T RATINGS – 0, 1/2 AND 1 HR (SEE ITEMS 1A AND 4)
L RATING AT AMBIENT – 2 CFM/sq ft
L RATING AT 400 F – LESS THAN 1 CFM/sq ft

1. FLOOR OR WALL ASSEMBLY – MIN 2–1/2 IN. THICK REINFORCED LIGHTWEIGHT OR NORMAL WEIGHT (100–150 PCF) CONCRETE. WALL MAY ALSO BE CONSTRUCTED OF ANY UL CLASSIFIED CONCRETE BLOCKS*. MAX DIAM OF OPENING IS 36 IN. SEE CONCRETE BLOCKS (CAZT) CATEGORY IN THE FIRE RESISTANCE DIRECTORY FOR NAMES OF MANUFACTURERS.
   1A. STEEL SLEEVE (OPTIONAL, NOT SHOWN) – NOM 36 IN. DIAM (OR SMALLER) SCHEDULE 10 (OR HEAVIER) STEEL PIPE SLEEVE CAST INTO MIN 4–1/2 IN. THICK CONCRETE FLOOR OR WALL. SLEEVE TO BE FLUSH WITH OR PROJECT MAX 2 IN. FROM TOP SURFACE OF FLOOR OR FROM BOTH SURFACES OF WALL. WHEN STEEL SLEEVE IS USED, F RATING IS 2 HR AND T RATING IS 0 HR.
2. PIPE – NOM 4 IN. DIAM (OR SMALLER) TYPE L (OR HEAVIER) COPPER PIPE, NOM 15 IN. DIAM (OR SMALLER) SERVICE WEIGHT (OR HEAVIER) CAST IRON SOIL PIPE, NOM 30 IN. DIAM (OR SMALLER) CLASS 50 (OR HEAVIER) DUCTILE IRON PRESSURE PIPE OR NOM 30 IN. DIAM (OR SMALLER) SCHEDULE 10 (OR HEAVIER) STEEL PIPE CENTERED IN THE OPENING AND RIGIDLY SUPPORTED ON BOTH SIDES OF THE FLOOR OR WALL ASSEMBLY.
3. PIPE COVERING* – NOM 1, 2 OR 3 IN. THICK HOLLOW CYLINDRICAL HEAVY DENSITY (MIN. 3.5 PCF) GLASS FIBER UNITS JACKETED ON THE OUTSIDE WITH AN ALL SERVICE JACKET. LONGITUDINAL JOINTS SEALED WITH METAL FASTENERS OR FACTORY–APPLIED SELF–SEALING LAP TAPE. TRANSVERSE JOINTS SECURED WITH METAL FASTENERS OR WITH BUTT STRIP TAPE SUPPLIED WITH THE PRODUCT. SEE PIPE AND EQUIPMENT COVERING – MATERIALS* (BRGU) CATEGORY IN BUILDING MATERIALS DIRECTORY FOR NAMES OF MANUFACTURERS. ANY PIPE COVERING MATERIAL MEETING THE ABOVE SPECIFICATIONS AND BEARING THE UL CLASSIFICATION MARKING WITH A FLAME SPREAD INDEX OF 25 OR LESS AND A SMOKE DEVELOPED INDEX OF 50 OR LESS MAY BE USED.
4. FIRESTOP SYSTEM – THE DETAILS OF THE FIRESTOP SYSTEM SHALL BE AS FOLLOWS:
   A. FILL,VOID OR CAVITY MATERIALS* – WRAP STRIP – NOM 1/4 IN. THICK INTUMESCENT ELASTOMERIC MATERIAL FACED ON ONE SIDE WITH ALUMINUM FOIL, SUPPLIED IN 2 IN. WIDE BY 24 IN. LONG STRIPS. NOM 2 IN. WIDE STRIPS TIGHTLY–WRAPPED AROUND PIPE COVERING (FOIL SIDE EXPOSED) TO FILL ANNULAR SPACE. EACH LAYER OF WRAP STRIP IS TO BE INSTALLED WITH A BUTTED SEAM, WITH THE BUTTED SEAMS IN SUCCESSIVE LAYERS STAGGERED. WRAP STRIP LAYERS SECURELY BOUND WITH STEEL WIRE OR ALUMINUM FOIL TAPE AND SLIDE INTO ANNULAR SPACE SUCH THAT THE TOP EDGES ARE RECESSED MIN 1/2 IN. FROM TOP SURFACE OF FLOOR. IN WALL ASSEMBLIES, THE WRAP STRIP LAYERS SHALL BE INSTALLED IN THE SAME MANNER USED FOR FLOOR ASSEMBLIES BUT SHALL BE INSTALLED SYMMETRICALLY ON BOTH SIDES OF THE WALL. THE MIN NUMBER OF WRAP STRIP LAYERS REQUIRED IS DEPENDENT UPON THE MAX PIPE SIZE AND THE PIPE COVERING THICKNESS, AS SHOWN IN THE ADJACENT TABLE:
   A. FILL,VOID OR CAVITY MATERIALS* – CAULK – APPLIED TO FILL THE ANNULAR SPACE (OVER EDGES OF WRAP STRIP LAYERS) TO A MIN DEPTH OF 1/2 IN., FLUSH WITH TOP SURFACE OF FLOOR OR BOTH SURFACES OF WALL.

   MINNESOTA MINING & MFG CO – CP 25WB+
   *BEARING THE UL CLASSIFICATION MARKING

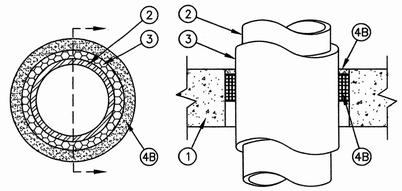


Min Floor or Wall Thkns In.	Max Pipe Dia In.	Nom Pipe Covering Thkns In.	Annular Space In.	Min. No. of Wrap Strip Layers	F Rating Hr	T Rating Hr
2–1/2	6	1	1/4 to 3/8	1	2	1
2–1/2	6	2	1/2 to 5/8	2	2	1
2–1/2	12	1	1/4 to 3/8	1	2	1/2
4–1/2	12	1	1/4 to 3/8	1	2	1
4–1/2	12	2	1/2 to 5/8	2	2	1
4–1/2	20	1	1/2 to 1	2	2	1
4–1/2	30	2	3/4 to 1–1/4	3	2	1
4–1/2	20	3	1 to 1–1/2	4	2	1

INSULATED PIPE

SYSTEM NO C–AJ–1014

(FORMERLY SYSTEM NO. 133)
F RATING––2 HR
T RATING––0 HR
L RATING AT AMBIENT––LESS THAN 1 CFM/sq ft (SEE ITEM 4)
L RATING AT 400° F––LESS THAN 1 CFM/sq ft (SEE ITEM 4)

1. FLOOR OR WALL ASSEMBLY – MIN 3–1/4 IN. THICK REINFORCED LIGHTWEIGHT OR NORMAL WEIGHT (100–150 PCF) CONCRETE. WALL MAY ALSO BE CONSTRUCTED OF ANY UL CLASSIFIED CONCRETE BLOCKS*. MAX DIAM OF CIRCULAR OPENING IS 6 IN.
   SEE CONCRETE BLOCKS (CAZT) CATEGORY IN THE FIRE RESISTANCE DIRECTORY FOR NAMES OF MANUFACTURERS.
2. THROUGH PENETRANTS – ONE METALLIC PIPE OR CONDUIT TO BE CENTERED WITHIN THE FIRESTOP SYSTEM. A NOM ANNULAR SPACE OF 3/4 IN. IS REQUIRED WITHIN THE FIRESTOP SYSTEM. PIPE OR CONDUIT TO BE RIGIDLY SUPPORTED ON BOTH SIDES OF FLOOR OR WALL ASSEMBLY. THE FOLLOWING TYPES AND SIZES OF METALLIC PIPES OR CONDUITS MAY BE USED:
   A. NOM 4 IN. DIAM (OR SMALLER) SCHEDULE 10 (OR HEAVIER) STEEL PIPE.
   B. CONDUIT – NOM 4 IN. DIAM (OR SMALLER) STEEL ELECTRICAL METALLIC TUBING OR STEEL CONDUIT.
3. PACKING MATERIAL – MIN 4 PCF MINERAL WOOL BATT INSULATION FIRMLY PACKED INTO OPENING AS A PERMANENT FORM. PACKING MATERIAL TO BE RECESSED FROM TOP SURFACE OF FLOOR OR FROM BOTH SURFACES OF WALL AS REQUIRE TO ACCOMMODATE THE REQUIRED THICKNESS OF FILL MATERIAL.
   MIN THICKNESS OF PACKING MATERIAL IN FLOORS AND WALLS TO BE 2–3/4 IN. AND 2–1/4 IN., RESPECTIVELY.
4. FILL,VOID OR CAVITY MATERIAL* – SEALANT – MIN 1/2 IN. THICKNESS OF FILL MATERIAL APPLIED WITHIN ANNULUS, FLUSH WITH TOP SURFACE OF FLOOR OR WITH BOTH SURFACES OF WALL. AS AN ALTERNATE, THE PERMANENT FORMING MATERIAL (ITEM 3) MAY BE OMITTED IF THE FILL MATERIAL THICKNESS IS INCREASED TO A MIN 1–1/2 IN.
   MINNESOTA MINING & MFG CO – TYPES FB–2000 OR FB–2000+.
   (NOTE: L RATINGS APPLY ONLY WHEN FB–2000+ IS USED.)
   *BEARING THE UL CLASSIFICATION MARKING

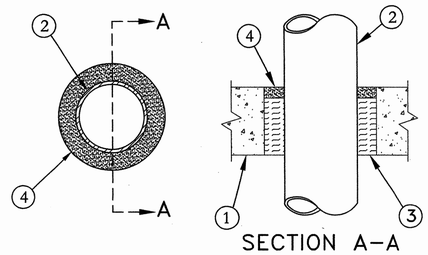


SECTION A–A

UNINSULATED PIPE

PIPE THRU CONCRETE FLOOR DETAIL
NO SCALE
1 / M6.2

SYSTEM NO. W–L–5032

F RATING – 2 HR
T RATING – 1 OR 2 HR (SEE ITEMS 3 AND 3A)

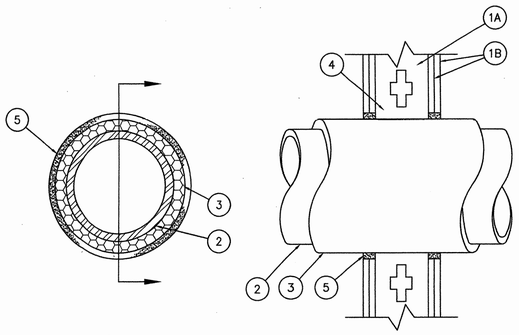


1. WALL ASSEMBLY – THE FIRE–RATED GYPSUM WALLBOARD/STUD WALL ASSEMBLY SHALL BE CONSTRUCTED OF THE MATERIALS AND IN THE MANNER SPECIFIED IN THE INDIVIDUAL U300 OR U400 SERIES WALL AND PARTITION DESIGNS IN THE UL FIRE RESISTANCE DIRECTORY AND SHALL INCLUDE THE FOLLOWING CONSTRUCTION FEATURES:
   A. STUDS – WALL FRAMING MAY CONSIST OF EITHER WOOD STUDS OR STEEL CHANNEL STUDS. WOOD STUDS TO CONSIST OF NOM 2 BY 4 IN. LUMBER SPACED 16 IN. OC. STEEL STUDS TO BE MIN 2–1/2 IN. WIDE AND SPACED MAX 24 IN. OC. WHEN STEEL STUDS ARE USED AND THE DIAM AT THE OPENING EXCEEDS THE WIDTH OF STUD CAVITY, THE OPENING SHALL BE FRAMED ON ALL SIDES USING LENGTHS OF STEEL STUD INSTALLED BETWEEN THE VERTICAL STUDS AND SCREW–ATTACHED TO THE STEEL STUDS AT EACH END. THE FRAMED OPENING IN THE WALL SHALL BE 7–1/2 IN. WIDER AND 7–1/2 IN. HIGHER THAN THE DIAM OF THE PENETRATING ITEM SUCH THAT, WHEN THE PENETRATING ITEM IS CENTERED IN THE OPENING, A 3–3/4 IN. CLEARANCE IS PRESENT BETWEEN THE PENETRATING ITEM AND THE FRAMING IN ALL FOUR SIDES.
   B. GYPSUM BOARD* – TWO LAYERS OF 5/8 IN. THICK GYPSUM WALLBOARD, AS SPECIFIED IN THE INDIVIDUAL WALL AND PARTITION DESIGN. MAX DIAM OF OPENING IS 14–1/2 IN. FOR WOOD STUD WALLS AND 31–1/2 IN. FOR STEEL STUD WALLS.
2. THROUGH PENETRANTS – ONE METALLIC PIPE, CONDUIT OR TUBING TO BE INSTALLED EITHER CONCENTRICALLY OR ECCENTRICALLY WITHIN THE FIRESTOP SYSTEM. PIPE, CONDUIT OR TUBING TO BE RIGIDLY SUPPORTED ON BOTH SIDES OF FLOOR OR WALL ASSEMBLY. THE FOLLOWING TYPES AND SIZES OF METALLIC PIPES, CONDUITS OR TUBING MAY BE USED:
   A. STEEL PIPE – NOM 24 IN. DIAM (OR SMALLER) SCHEDULE 10 (OR HEAVIER) STEEL PIPE.
   B. CONDUIT – NOM 4 IN. DIAM (OR SMALLER) ELECTRICAL METALLIC TUBING OR STEEL CONDUIT.
   C. COPPER TUBING – NOM 6 IN. DIAM (OR SMALLER) TYPE L (OR HEAVIER) COPPER TUBING.
   D. COPPER PIPE – NOM 6 IN. DIAM (OR SMALLER) REGULAR (OR HEAVIER) COPPER PIPE.
3. PIPE COVERING MATERIALS* – USED IN CONJUNCTION WITH ITEM 4. NOM 3 IN. THICK UNFACED MINERAL FIBER PIPE INSULATION SIZED TO THE OUTSIDE DIAM OF PIPE OR TUBE. PIPE INSULATION SECURED WITH MIN 8 AWG STEEL WIRE SPACED MAX 12 IN. OC. AN NOM ANNULAR SPACE OF 3/4 IN. IS REQUIRED WITHIN THE FIRESTOP SYSTEM. WHEN MINERAL WOOL PIPE COVERING IS USED, THE T RATING IS 2 HR. OWENS CORNING HT INC, DIV OF OWENS CORNING – HIGH TEMPERATURE PIPE INSULATION 1200, HIGH TEMPERATURE PIPE INSULATION 8PF OR HIGH TEMPERATURE PIPE INSULATION THERMALOC
   A. PIPE COVERING* – USED AS AN ALTERNATE TO ITEM 3 AND 4. NOM 1 IN. THICK HOLLOW CYLINDRICAL HEAVY DENSITY (MIN 3.5 PCF) GLASS FIBER UNITS JACKETED ON THE OUTSIDE WITH AN ALL SERVICE JACKET. LONGITUDINAL JOINTS TIGHTLY BUTTED AND SEALED WITH METAL FASTENERS OR FACTORY APPLIED SELF–SEALING LAP TAPE. TRANSVERSE JOINTS SECURED WITH METAL FASTENERS OR WITH BUTT TAPE SUPPLIED WITH THE PRODUCT. A NOM ANNULAR SPACE OF 3/4 IN. IS REQUIRED WITHIN THE FIRESTOP SYSTEM. WHEN GLASS FIBER PIPE COVERING IS USED, THE T RATING IS 1 HR. SEE PIPE AND EQUIPMENT COVERING – MATERIALS (BRGU) CATEGORY IN THE BUILDING MATERIALS DIRECTORY FOR THE NAMES OF MANUFACTURERS. ANY PIPE COVERING MATERIAL MEETING THE ABOVE SPECIFICATIONS AND BEARING THE UL CLASSIFICATION MARKING WITH A FLAME SPREAD INDEX OF 25 OR LESS AND A SMOKE DEVELOPED INDEX OF 50 OR LESS MAY BE USED.
4. SHEETING MATERIAL (NOT SHOWN) – USED IN CONJUNCTION WITH ITEM 3. FOIL–SCRIM–KRAFT OR ALL SERVICE JACKET MATERIAL SHALL BE WRAPPED AROUND THE OUTER CIRCUMFERENCE OF THE PIPE COVERING MATERIAL (ITEM 3) WITH THE KRAFT SIDE EXPOSED. LONGITUDINAL JOINTS SEALED WITH METAL FASTENERS. SEE SHEATHING MATERIALS (BVDV) CATEGORY IN THE BUILDING MATERIALS DIRECTORY FOR NAMES OF MANUFACTURERS. ANY SHEATHING MATERIAL MEETING THE ABOVE SPECIFICATIONS AND BEARING THE UL CLASSIFICATION MARKING WITH A FLAME SPREAD INDEX OF 25 OR LESS AND A SMOKE DEVELOPED INDEX OF 50 OR LESS MAY BE USED.
5. FILL,VOID OR CAVITY MATERIAL* – SEALANT – MIN 1–1/4 IN. THICKNESS OF FILL MATERIAL APPLIED WITHIN THE ANNULUS ON BOTH SURFACES OF WALL. ADDITIONAL FILL MATERIAL TO BE INSTALLED SUCH THAT A MIN 1/4 IN. CROWN IS FORMED AROUND THE PENETRATING ITEM.

INSULATED PIPE

SYSTEM NO. W–L–1010

F RATING–– 2 HR
T RATING––0 HR
L RATING AT AMBIENT––LESS THAN 1 CFM/sq ft (SEE ITEM 3)
L RATING AT 400° F––LESS THAN 1 CFM/sq ft (SEE ITEM 3)

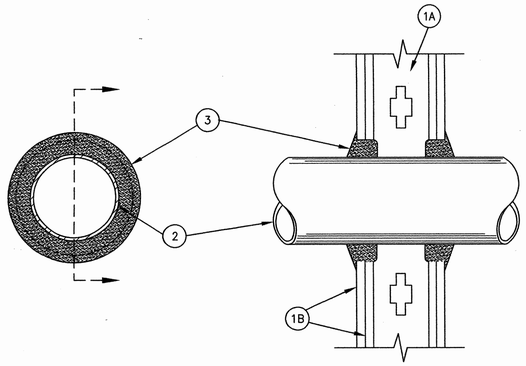

WALL ASSEMBLY – THE FIRE RATED GYPSUM WALLBOARD/STUD WALL ASSEMBLY SHALL BE CONSTRUCTED OF THE MATERIALS AND IN THE MANNER SPECIFIED IN THE INDIVIDUAL U300 OR U400 SERIES WALL AND PARTITION DESIGNS IN THE UL FIRE RESISTANCE DIRECTORY AND SHALL INCLUDE THE FOLLOWING CONSTRUCTION FEATURES:
A. STUDS – WALL FRAMING MAY CONSIST OF EITHER WOOD STUDS OR STEEL CHANNEL STUDS. WOOD STUDS TO CONSIST OF NOM 2 BY 4 IN. LUMBER SPACED 16 IN. OC. STEEL STUDS TO BE MIN 2–1/2 IN. WIDE AND SPACED MAX 24 IN. OC. WHEN STEEL STUDS ARE USED AND THE DIAM OF OPENING EXCEEDS THE WIDTH OF STUD CAVITY, THE OPENING SHALL BE FRAMED ON ALL SIDES USING LENGTHS OF STEEL STUD INSTALLED BETWEEN THE VERTICAL STUDS AND SCREW ATTACHED TO THE STEEL STUDS AT EACH END. THE FRAMED OPENING IN THE WALL SHALL BE 4 TO 6 IN. WIDER AND 4 TO 6 IN. HIGHER THAN THE DIAM OF THE PENETRATING ITEM SUCH THAT, WHEN THE PENETRATING ITEM IS CENTERED IN THE OPENING, A 2 TO 3 IN. CLEARANCE IS PRESENT BETWEEN THE PENETRATING ITEM AND THE FRAMING IN ALL FOUR SIDES.
1. B. GYPSUM BOARD* – TWO LAYERS OF NOM 5/8 IN. THICK GYPSUM WALLBOARD, AS SPECIFIED IN THE INDIVIDUAL WALL AND PARTITION DESIGN. MAX DIAM OF OPENING IS 14–1/2 IN. FOR WOOD STUD WALLS AND 25–1/2 IN. FOR STEEL STUD WALLS.

THROUGH PENETRANTS – ONE METALLIC PIPE, CONDUIT OF TUBING TO BE CENTERED WITHIN THE FIRESTOP SYSTEM. PIPE, CONDUIT OR TUBING TO BE RIGIDLY SUPPORTED ON BOTH SIDES OF WALL ASSEMBLY. THE FOLLOWING TYPES AND SIZES OF METALLIC PIPES, CONDUITS OR TUBING MAY BE USED:

A. STEEL PIPE – NOM 24 IN. DIAM (OR SMALLER) SCHEDULE 10 (OR HEAVIER) STEEL PIPE. A NOM ANNULAR SPACE OF 3/4 IN. IS REQUIRED WITHIN THE FIRESTOP SYSTEM.

B. STEEL PIPE – NOM 4 IN. DIAM (OR SMALLER) SCHEDULE 5 (OR HEAVIER) STEEL PIPE. A NOM ANNULAR SPACE OF 3/4 IN. IS REQUIRED WITHIN THE FIRESTOP SYSTEM.

2. C. CONDUIT – NOM 4 IN. DIAM (OR SMALLER) STEEL ELECTRICAL METALLIC TUBING OR STEEL CONDUIT. A NOM ANNULAR SPACE OF 3/4 IN. IS REQUIRED WITHIN THE FIRESTOP SYSTEM.

D, COPPER TUBING – NOM 6 IN. DIAM (OR SMALLER) TYPE L (OR HEAVIER) COPPER TUBING. A NOM ANNULAR SPACE OF 3/4 IN. IS REQUIRED WITHIN THE FIRESTOP SYSTEM.

3. FILL,VOID OR CAVITY MATERIAL* – SEALANT – MIN 1–1/4 IN. THICKNESS OF FILL MATERIAL APPLIED WITHIN THE ANNULUS ON BOTH SURFACES OF WALL. ADDITIONAL FILL MATERIAL TO BE INSTALLED SUCH THAT A MIN 1/4 IN. CROWN IS FORMED AROUND THE PENETRATING ITEM. MINNESOTA MINING & MFG CO – TYPES FB–2000, FB–2000+. (NOTE: L RATINGS APPLY ONLY WHEN FB–2000+ IS USED).


*BEARING THE UL CLASSIFICATION MARKING

UNINSULATED PIPE

PIPE THRU 1 HOUR FIRE RATED WALL DETAIL
NO SCALE
2 / M6.2

SYSTEM NO. W–L–5001

F RATINGS – 1 AND 2 HR (SEE ITEM 1)
T RATINGS – 3/4, 1 AND 1–1/2 HR (SEE ITEM 3)
L RATING AT AMBIENT – 2 CFM/sq ft
L RATING AT 400 F – LESS THAN 1 CFM/sq ft

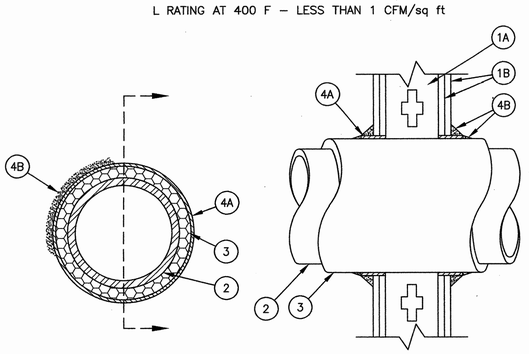


1. WALL ASSEMBLY – THE 1 OR 2 HR FIRE–RATED GYPSUM WALLBOARD/STUD WALL ASSEMBLY SHALL BE CONSTRUCTED OF THE MATERIALS AND IN THE MANNER DESCRIBED IN THE INDIVIDUAL U300 OR U400 SERIES WALL OR PARTITION DESIGN IN THE UL FIRE RESISTANCE DIRECTORY AND SHALL INCLUDE THE FOLLOWING CONSTRUCTION FEATURES:
   A. STUDS – WALL FRAMING MAY CONSIST OF EITHER WOOD STUDS OR STEEL CHANNEL STUDS. WOOD STUDS TO CONSIST OF NOM 2 BY 4 IN. LUMBER SPACED 16 IN. OC WITH NOM 2 BY 4 IN. LUMBER END PLATES AND CROSS BRACES. STEEL STUDS TO BE MIN 3–5/8 IN. WIDE BY 1–3/8 IN. DEEP CHANNELS SPACED MAX 24 IN. OC.
   B. GYPSUM BOARD* – NOM 5/8 IN. THICK, 4 FT WIDE WITH SQUARE OR TAPERED EDGES. THE GYPSUM WALLBOARD TYPE, THICKNESS, NUMBER OF LAYERS, FASTENER TYPE AND SHEET ORIENTATION SHALL BE AS SPECIFIED IN THE INDIVIDUAL U300 OR U400 SERIES DESIGN IN THE UL FIRE RESISTANCE DIRECTORY. MAX DIAM OF OPENING IS 14–1/2 IN FOR WOOD STUD WALLS AND 18 IN. FOR STEEL STUD WALLS. THE HOURLY F RATING OF THE FIRESTOP SYSTEM IS 1 HR WHEN INSTALLED IN A 1 HR FIRE RATED WALL AND 2 HR WHEN INSTALLED IN A 2 HR FIRE RATED WALL.
2. THROUGH PENETRANTS – ONE METALLIC PIPE OR TUBING TO BE CENTERED WITHIN THE FIRESTOP SYSTEM. PIPE OR TUBING TO BE RIGIDLY SUPPORTED ON BOTH SIDES OF WALL ASSEMBLY. THE FOLLOWING TYPES AND SIZES OF METALLIC PIPES OR TUBING MAY BE USED:
   A. STEEL PIPE – NOM 12 IN. DIAM (OR SMALLER) SCHEDULE 10 (OR HEAVIER) STEEL PIPE.
   B. COPPER TUBING – NOM 6 IN. DIAM (OR SMALLER) TYPE L (OR HEAVIER) COPPER TUBING.
   C. COPPER PIPE – NOM 6 IN. DIAM (OR SMALLER) REGULAR (OR HEAVIER) COPPER PIPE.
3. PIPE COVERING* – NOM 1 OR 2 IN. THICK HOLLOW CYLINDRICAL HEAVY DENSITY (MIN 3.5 PCF) GLASS FIBER UNITS JACKETED ON THE OUTSIDE WITH AN ALL SERVICE JACKET. LONGITUDINAL JOINTS SEALED WITH METAL FASTENERS OR FACTORY–APPLIED SELF–SEALING LAP TAPE. TRANSVERSE JOINTS SEALED WITH METAL FASTENERS OR WITH BUTT STRIP TAPE SUPPLIED WITH THE PRODUCT. WHEN NOM 1 IN. THICK PIPE COVERING IS USED, THE ANNULAR SPACE BETWEEN THE PIPE COVERING AND THE CIRCULAR CUTOUT IN THE GYPSUM WALLBOARD LAYERS ON EACH SIDE OF THE WALL SHALL BE MIN 1/4 IN. TO MAX 3/8 IN. WHEN NOM 2 IN. THICK PIPE COVERING IS USED, THE ANNULAR SPACE BETWEEN THE PIPE COVERING AND THE CIRCULAR CUTOUT IN THE GYPSUM WALLBOARD LAYERS ON EACH SIDE OF THE WALL SHALL BE MIN 1/2 IN. TO MAX 3/4 IN. SEE PIPE AND EQUIPMENT COVERING – MATERIALS (BRGU) CATEGORY IN BUILDING MATERIALS DIRECTORY FOR NAMES OF MANUFACTURERS. ANY PIPE COVERING MATERIAL MEETING THE ABOVE SPECIFICATIONS AND BEARING THE UL CLASSIFICATION MARKING WITH A FLAME SPREAD INDEX OF 25 OR LESS AND A SMOKE DEVELOPED INDEX OF 50 OR LESS MAY BE USED. THE HOURLY T RATING OF THE FIRESTOP SYSTEM IS 3/4 HR WHEN NOM 1 IN. THICK PIPE COVERING IS USED.THE HOURLY T RATING OF THE FIRESTOP SYSTEM IS 1 HR AND 1–1/2 HR WHEN NOM 2 IN. THICK PIPE COVERING IS USED WITH 1 HR AND 2 HR FIRE RATED WALLS, RESPECTIVELY.
4. FIRESTOP SYSTEM – INSTALLED SYMMETRICALLY ON BOTH SIDES OF WALL ASSEMBLY. THE DETAILS OF THE FIRESTOP SYSTEM SHALL BE AS FOLLOWS:
   A. FILL,VOID OR CAVITY MATERIALS* – WRAP STRIP – NOM 1/4 IN. THICK INTUMESCENT ELASTOMERIC MATERIAL FACED ON ONE SIDE WITH ALUMINUM FOIL, SUPPLIED IN 2 IN. WIDE STRIPS. NOM 2 IN. WIDE STRIP TIGHTLY WRAPPED AROUND PIPE COVERING (FOIL SIDE OUT) WITH SEAM BUTTED. WRAP STRIP LAYER SECURELY BOUND WITH STEEL WIRE OR ALUMINUM FOIL TAPE AND SLID INTO ANNULAR SPACE APPROX 1–1/4 IN. SUCH THAT APPROX 3/4 IN. OF THE WRAP STRIP WIDTH PROTRUDES FROM THE WALL SURFACE. ONE LAYER OF WRAP STRIP IS REQUIRED WHEN NOM 1 IN. THICK PIPE COVERING IS USED. TWO LAYERS OF WRAP STRIP ARE REQUIRED WHEN NOM 2 IN. THICK PIPE COVERING IS USED.
   B. FILL,VOID OR CAVITY MATERIALS* – CAULK – MIN 1/4 IN. DIAM CONTINUOUS BEAD APPLIED TO THE WRAP STRIP/WALL INTERFACE AND TO THE EXPOSED EDGE OF THE WRAP STRIP LAYER APPROX 3/4 IN. FROM THE WALL SURFACE.

INSULATED PIPE

SYSTEM NO. W–L–1003

F RATINGS–– 1 AND 2 HR (SEE ITEM 1)
T RATING––0 HR

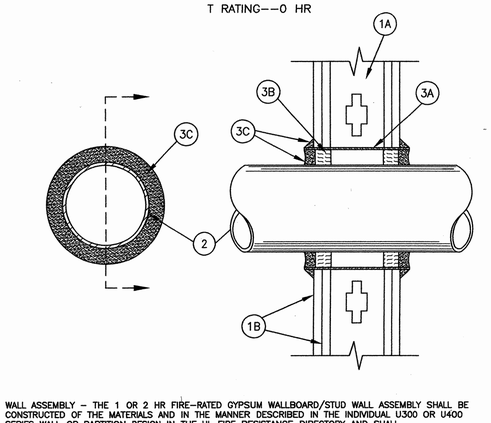

1. WALL ASSEMBLY – THE 1 OR 2 HR FIRE–RATED GYPSUM WALLBOARD/STUD WALL ASSEMBLY SHALL BE CONSTRUCTED OF THE MATERIALS AND IN THE MANNER DESCRIBED IN THE INDIVIDUAL U300 OR U400 SERIES WALL OR PARTITION DESIGN IN THE UL FIRE RESISTANCE DIRECTORY AND SHALL INCLUDE THE FOLLOWING CONSTRUCTION FEATURES:
   A. STUDS – WALL FRAMING MAY CONSIST OF EITHER WOOD STUDS OR STEEL CHANNEL STUDS. WOOD STUDS TO CONSIST OF NOM 2 BY 4 IN. LUMBER SPACED 16 IN. OC WITH NOM 2 BY 4 IN. LUMBER END PLATES AND CROSS BRACES. STEEL STUDS TO BE MIN 3–1/2 IN. WIDE BY 1–3/8 IN. DEEP CHANNELS SPACED MAX 24 IN. OC.
   B. GYPSUM BOARD* – NOM 5/8 IN. THICK, 4 FT. WIDE WITH SQUARE OR TAPERED EDGES. THE GYPSUM WALLBOARD TYPE, THICKNESS, NUMBER OF LAYERS, FASTENER TYPE AND SHEET ORIENTATION SHALL BE AS SPECIFIED IN THE INDIVIDUAL U300 OR U400 SERIES DESIGN IN THE UL FIRE RESISTANCE DIRECTORY. MAX DIAM OF OPENING IS 15 IN. THE HOURLY F RATING OF THE FIRESTOP SYSTEM IS EQUAL TO THE HOURLY FIRE RATING OF THE WALL ASSEMBLY IN WHICH IT IS INSTALLED.
2. THROUGH PENETRANT – ONE METALLIC PIPE, CONDUIT OR TUBING TO BE INSTALLED EITHER CONCENTRICALLY OR ECCENTRICALLY WITHIN THE FIRESTOP SYSTEM. THE SPACE BETWEEN PIPES, CONDUITS OR TUBING AND THE STEEL SLEEVE (ITEM 3A) SHALL BE MIN OF 0 IN. (POINT CONTACT) TO MAX 2–3/8 IN. PIPE, CONDUIT OR TUBING TO BE RIGIDLY SUPPORTED ON BOTH SIDES OF WALL ASSEMBLY. THE FOLLOWING TYPES AND SIZES OF METALLIC PIPES, CONDUITS OR TUBING MAY BE USED:
   A. STEEL PIPE – NOM 12 IN. DIAM (OR SMALLER) SCHEDULE 10 (OR HEAVIER) STEEL PIPE.
   B. IRON PIPE – NOM 12 IN. DIAM (OR SMALLER) SERVICE WEIGHT (OR HEAVIER) CAST IRON SOIL PIPE, NOM 12 IN. DIAM (OR SMALLER) OR CLASS 50 (OR HEAVIER) DUCTILE IRON PRESSURE PIPE.
   C. CONDUIT – NOM 6 IN. DIAM (OR SMALLER) STEEL CONDUIT OR NOM 4 IN. DIAM (OR SMALLER) STEEL ELECTRICAL METALLIC TUBING.
   D. COPPER TUBING – NOM 6 IN. DIAM (OR SMALLER) TYPE L (OR HEAVIER) COPPER TUBING.
   E. COPPER PIPE – NOM 6 IN. DIAM (OR SMALLER) REGULAR (OR HEAVIER) COPPER PIPE.
3. FIRESTOP SYSTEM – INSTALLED SYMMETRICALLY ON BOTH SIDES OF WALL ASSEMBLY. THE DETAILS OF THE FIRESTOP SYSTEM SHALL BE AS FOLLOWS.
   A. STEEL SLEEVE – CYLINDRICAL SLEEVE FABRICATED FROM MIN 0.019 IN. THICK (NO. 28 GAUGE) GALV SHEET STEEL AND HAVING A MIN 2 IN. LAP ALONG THE LONGITUDINAL SEAM. LENGTH OF STEEL SLEEVE TO BE EQUAL TO THICKNESS OF WALL PLUS 1 TO 4 IN. SUCH THAT, WHEN INSTALLED, THE ENDS OF THE SLEEVE WILL PROJECT APPROXIMATELY 1/2 TO 2 IN. BEYOND THE SURFACE OF THE WALL ON BOTH SIDES OF THE WALL ASSEMBLY. SLEEVE INSTALLED BY COILING THE SHEET STEEL TO A DIAM SMALLER THAN THE THROUGH OPENING, INSERTING THE COIL THROUGH THE OPENINGS AND RELEASING THE COIL TO LET IT UNCOIL AGAINST THE CIRCULAR CUTOUTS IN THE GYPSUM WALLBOARD LAYERS.
   B. PACKING MATERIAL – MIN 1 IN. THICKNESS OF MINERAL WOOL BATT INSULATION FIRMLY PACKED INTO STEEL SLEEVE ON BOTH SIDES OF THE WALL ASSEMBLY AS PERMANENT FORMS. PACKING MATERIAL TO BE RECESSED MIN 1/2 IN. FROM END OF STEEL SLEEVE (FLUSH WITH OR RECESSED INTO GYPSUM WALLBOARD SURFACE) ON BOTH SIDES OF WALL ASSEMBLY.
      1. PACKING MATERIAL – (NOT SHOWN) – AS AN ALTERNATE TO ITEM B, NOM 1 IN. THICK POLYETHYLENE BACKER ROD MAY BE USED. THE BACKER ROD IS TO BE RECESSED WITHIN THE STEEL SLEEVE A MIN OF 1 IN. FROM EACH SURFACE OF WALL.
   C. FILL,VOID OR CAVITY MATERIALS* – CAULK – WHEN MINERAL WOOL BATT INSULATION IS USED, APPLIED TO FILL THE STEEL SLEEVE TO A MIN DEPTH OF 1/2 IN. ON BOTH SIDES OF WALL ASSEMBLY. WHEN BACKER ROD IS USED, A MIN THICKNESS OF 1 IN. OF CP–25WB+ CAULK IS REQUIRED FLUSH WITH SURFACE OF WALL. A NOM 1/4 IN. DIAM CONTINUOUS BEAD OF CAULK SHALL BE APPLIED AROUND THE CIRCUMFERENCE OF THE STEEL SLEEVE AT ITS EGRESS FROM THE GYPSUM WALLBOARD LAYERS ON BOTH SIDES OF THE WALL ASSEMBLY.

   MINNESOTA MINING & MFG CO – CP 25WB+
   *BEARING THE UL CLASSIFICATION MARKING

UNINSULATED PIPE

PIPE THRU 2 HOUR FIRE RATED WALL DETAIL
NO SCALE
3 / M6.2

GENERAL NOTES: (APPLIES TO ALL DETAILS ON THIS PAGE)
1. FIRE RATED WALL DETAIL FOR REFERENCE ONLY.
2. EXACT WALL CONDITIONS AT PENETRATIONS SHALL BE VERIFIED PRIOR TO INSTALLATION AND THE APPROPRIATE RATING ASSEMBLY SHALL BE USED FOR THE TYPE OF PENETRATION.
3. FIRESTOPPING SHALL BE INSTALLED STRICTLY PER MANUFACTURER'S INSTALLATION INSTRUCTION'S.

tBP
architecture
planning
interiors
management
tBP/Architecture
1000 Burnett Avenue, Suite 140
Concord, CA 94520
p: 925.246.6419 f: 925.246.6495
architect

AINSWORTH ASSOCIATES
MECHANICAL ENGINEERS
SACRAMENTO, CA
consultant

DIVERSIFICATION STAMP
DIV. OF THE STATE ARCHITECT
OFFICE OF REGULATION SERVICES
APPL. # 4919025
DATE 1-13-05
name
address
city, state, zip
ph:
fx:
agency

SCIENCE BUILDING
LOS MEDANOS COLLEGE
Contra Costa Community College District
owner

tBP project number : 2024100
file name:
drawn by: checked by:
date: NOVEMBER 15, 2004

Rev:	date:	description:

drawing title:
MECHANICAL - DETAILS
LMC SCIENCE 313-023-112.01-0-00.00
drawing no.: M6.2
drawing of ?

U:\2003-0035\DWG\M6-2.dwg Tue,Nov\2,2004-03:48pm

Bulletin No.03A

Date: 1/19/2006

To: S.J. Amoroso Construction
390 Bridge Parkway
Redwood shores CA 94065

Project: **LOS MEDANOS COLLEGE SCIENCE BUILDING**
Contra Costa Community College District
DSA No. 01-106226; File # 7-C3
tBP P/N 20247.00

Description: REFERENCE: Submittal #9: P0.1, P2-2, P1-2, P1-3, and P1-4

1. Clarification to specification for Lavatories L-1, L-2, L-3, and L-4 per attached revised Plumbing schedule SKP-03.1. Revisions as follows:
   a. L-4 added to Plumbing Fixture Schedule.
   b. L-1 description changed from Tri-basin to dual-basin.
   c. Rm 135, 136: L-1 changed to L-4 single basin.
   Note that quantities of lavatories are the same as original contract. Provide credit option as the changes from two dual-bowl lavs to single bowl lavs.

2. Clarification to faucets required at Lavatories L-1, L-2, L-3 and L-4
   Provide Model "DM" Deck-mounted "J" spout.

Issued By: Architect
Requested By: Architect
Reason: Clarification to specification for Lavatories
Enclosures: SKP-03.1
Distribution:

Copies:	Name:	Organization:
1 copy	Mark Delgado	S. J. Amoroso
1 copy	Cara Perrotta	CCCCDistrict
1 copy	Bob Harke	Inspector of Record
1 copy	Tom Beckett	tBP/Architecture
1 copy	File 20247.007.4	tBP/Architecture

Action:
- ☐ For Information/Clarification only
- ☒ Provide Price/Credit Proposal. (Refer to this Bulletin.No. when responding)
- ☐ Requires DSA review and approval
- ☐ Proceed as authorized by District

tBP/Architecture, 3200 Bunnett Ave, Suite 140 , Concord, CA. 94520. ph: 925.246.6420. fax: 925.246.6495

BY

NOTES:
1. LOCATE LAVS AS FOLLOWS:
   – LAVATORY L-1 TO BE PROVIDED WITHIN ROOM 210
   – LAVATORY L-2 TO BE PROVIDED WITHIN ROOMS 110 & 212.
   – LAVATORY L-3 TO BE PROVIDED WITHIN ROOMS 109 & 211.
   – LAVATORY L-4 TO BE PROVIDED WITHIN ROOMS 135 & 136.
2. NOTE – QTY OF LAVS W/ IN ORIGINAL CONTRACT VS. BULLETIN ARE AS FOLLOWS:

LAV	QTY (ORIGINAL)	QTY (BULLETIN)
L-1	2	1
L-2	2	1
L-3	2	2
L-4	0	2
TOTAL	6	6

3. SEE ARCHITECTURAL AND PLUMBING FLOOR PLANS FOR EXACT LOCATIONS.

BULLETIN: #03A
DSA FILE: 7-C1
DSA APPL: 01-106226

PLUMBING FIXTURE SCHEDULE

L-1	LAVATORY: (WALL MOUNT/STAINLESS STEEL/DUAL–BASIN/HAND–WIRED SENSOR FAUCET/ADA): "ACCENT" MERIDIAN STAINLESS STEEL CURVED FRONT TWO–PERSON WASHBASIN, MODEL NUMBER 3702–1. PROVIDE WITH THE FOLLOWING OPTIONS: – SD SENSOR FAUCET OPERATION – HAND WIRED – ER ENCLOSED BOTTOM – MIT HOT AND COLD THERMOSTATIC MIXING VALVE – PDM PUMP TYPE SOAP DISPENSER
L-2	LAVATORY: (WALL MOUNT/STAINLESS STEEL/TRI–BASIN/HAND–WIRED SENSOR FAUCET/ADA): "ACCENT" MERIDIAN STAINLESS STEEL CURVED FRONT THREE–PERSON WASHBASIN, MODEL NUMBER 3703–1. PROVIDE WITH THE FOLLOWING OPTIONS: – SD SENSOR FAUCET OPERATION – HAND WIRED – ER ENCLOSED BOTTOM – MIT HOT AND COLD THERMOSTATIC MIXING VALVE – PDM PUMP TYPE SOAP DISPENSER
L-3	LAVATORY: (WALL MOUNT/STAINLESS STEEL/DUAL–BASIN/HAND–WIRED SENSOR FAUCET/ADA): "ACCENT" MERIDIAN STAINLESS STEEL CURVED FRONT FOUR–PERSON WASHBASIN, MODEL NUMBER 3704–1. PROVIDE WITH THE FOLLOWING OPTIONS: – SD SENSOR FAUCET OPERATION – HAND WIRED – ER ENCLOSED BOTTOM – MIT HOT AND COLD THERMOSTATIC MIXING VALVE – PDM PUMP TYPE SOAP DISPENSER
L-4	LAVATORY: (WALL MOUNT/STAINLESS STEEL/SINGLE–BASIN/HAND–WIRED SENSOR FAUCET/ADA): "ACCENT" MERIDIAN STAINLESS STEEL CURVED FRONT ONE–PERSON WASHBASIN, MODEL NUMBER 3701–1. PROVIDE WITH THE FOLLOWING OPTIONS: – SD SENSOR FAUCET OPERATION – HAND WIRED – ER ENCLOSED BOTTOM – MIT HOT AND COLD THERMOSTATIC MIXING VALVE – PDM PUMP TYPE SOAP DISPENSER

SCIENCE BUILDING
LOS MEDANOS COLLEGE
Contra Costa Community College School District

ARCHITECT: tBP/Architecture, 3200 Bunnett Ave, Suite 140, Concord, CA 94520, p: 925.246.6420 f: 925.246.6495

tBP Architecture Planning Interior Management


BULLETIN: #03A
DATE: 01/19/06
DSA NO. 01-106226
SHT. REVISED TO PAGE
SHEET: P0.1
SHEET: SKP-03.1

Bulletin No.03B

Date: January 4, 2006

To: S.J. Amoroso Construction
390 Bridge Parkway
Redwood shores CA 94065

Project: **LOS MEDANOS COLLEGE SCIENCE BUILDING**
Contra Costa Community College District
DSA No. 01-106226; File # 7-C3
tBP P/N 20247.00

Description: REFERENCE: Plumbing drawings P1.1, P2.1:

Provide surface mounted hose bibs at all restrooms Chicago Faucets Wall-mounted Inside Sill Faucet #293. Locate under lavatory counter.
Provide formal submittal upon approval of PCO.

Issued By: Architect
Requested By: Owner
Reason: Owner request hose bibs
Enclosures: Cut sheet
Distribution:

Copies:	Name:	Organization:
1 copy	Mark Delgado	S. J. Amoroso
1 copy	Cara Perrotta	CCCCDistrict
1 copy	Bob Harke	Inspector of Record
1 copy	Tom Beckett	tBP/Architecture
1 copy	File 20247.007.4	tBP/Architecture

Action:
- ☐ For Information/Clarification only
- ☒ Provide Price/Credit Potposal. (Refer to this Bulletin No. when responding)
- ☐ Requires DSA review and approval
- ☐ Proceed as authorized by District

tBP/Architecture, 3200 Bunnett Ave, Suite 140 , Concord, CA. 94520. ph: 925.246.6420. fax: 925.246.6495

CHICAGO FAUCETS
Left Mounting Arc Hose Building

TECHNICAL DATA

MATERIAL	BRASS
FINISH	CHROME PLATED
SUBMITTED BY	
SUBMITTED DATE	
RE-SUBMISSION DATE	
SUBMITTED REVISION DATE	


• 3/4" HOSE THREAD OUTLET
• ASME A112.18.1M COMPLIANT
• CSA B125 COMPLIANT

DATE:	05-24-02
BY:	SD
CHK'D:	
APP'D:	
DR:	8

293

NOTE:
INSTALLATION OF THIS FITTING SHOULD CONFORM TO LOCAL PLUMBING CODE REQUIREMENTS FOR BACKFLOW PREVENTION. (SLIP VACUUM BREAKER OR EQUIVALENT)

3-1/8" [79mm] DIA. FLANGE (REMOVABLE)
3.726 [94mm]
3/4" A.M. HOSE THREAD OUTLET
1/2" NPT FEMALE THREAD INLET
1.126 [28mm]
3.319 [84mm]

DIMENSIONS IN INCHES AND [MILLIMETERS].

© 2002 American Standard Inc.

S. J. AMOROSO
Request For Information/Clarification

DSA FILE NO. 7-C1
DSA APPL. No. 01-106226

To: tBP/Architecture, 1000 Diamond Ave, Suite 140, Concord, CA 94520, Attn: Celia Chiang, Tom Beckett, Fax: 925-246-6495

Project: LOS MEDANOS COLLEGE SCIENCE BUILDING, Contra Costa Community College District
tBP p/n: 20247.00

Subj.: American Standard Instanto Water Closet
Reference (dwg, spec.): P0.1

RFI No: 426
Subcontractor RFI: Dowdle 72

Reply Requested By: 11/17/06

INFORMATION REQUESTED: Date: 11/15/06

Please note the attached Dowdle RFI No. 72 regarding the approved Kohler 4450 for WC 1 and 2 which is no longer available. Is it acceptable to substitute American Standard "Instanto" Water Closet in place of the Kohler 4450. Please advise.

SUGGESTED SOLUTION:
Cost Impact: ☐ Schedule Impact: ☐ days: By: Mark Delgado

RESPONSE: DATE:

The American Standard "Instanto" is acceptable.

Jim Weaver / tBP Architecture
D. W. / Ainsworth Associates

11/28/06

RFI # 000
Page 1

Dave A Sons Mechanical, Inc.
PO BOX
MANTECA, 95336
(209)824-0400

RFI

To: Mark Delgado
SJ Amoroso
390 Bridge Parkway
Redwood Shores, CA 94065
Ph: 925-427-7997 Fax: 925-427-7070

RFI #: 72
Date: 11/6/2006
Job: 497: Los Medanos College
Phone: 925-427-7997

Attn:

Subject: WC 1 & 2 - Substitute American Standard in lieu of Kohler

Drawing: P0.1
Spec Section: 15400 2.24
Cost Impact: Schedule Impact:

Request:
Due to the availability of the approved Kohler 4450 for WC 1 & 2 is in question. The current lead time is approximately 4 months however Kohler is unwilling to commit to a delivery date due to casting problems. In light of the manufacturers difficulties, DSM would like to propose a substitution of the American Standard "Instanto" Water Closet, per Fixture Schedule FS-1 (Model 2612.010 - to be attached Cut Sheet). The current lead time for this product is 5 weeks. DSM would like to release our purchase order for the Instanto to our vendor, immediately - to insure the quantities necessary.

Date Required: 11/15/2006

Requested By: Brad Freeman
Dowdle & Sons Mechanical, Inc

Response:

Issued By:
Title:
Date:

Page 1 of 1

American Standard

INSTANTO™ 3.5 GPF
ELONGATED FLUSH VALVE TOILET
VITRECHINA CHINA

BARRIER FREE

INSTANTO™ ELONGATED 3.5 GPF TOILET

- Vitreous china
- Wall-mounted elongated bowl
- Rimless flush action
- Fully-glazed 2-1/2" Bullpass trapway
- 1-1/2" inlet spud
- 100% factory flush tested

2612.010
Top spud
2611.012
Back spud
2613.018
Back spud with Integral Seat

Nominal Dimensions:
660w 956 x 457mm
(26" x 14" x 18")

Recommended working pressure–between 25 psi at valve when flushing and 80 psi static

Fixture only, less seat and bolt caps

Compliance Certification s -
Meets or Exceeds the Following Specifications:
• ASME A112.19.2M and 19.6M for Vitreous China Fixtures - Includes Flush Performance, Bell Trees Diameter, Trap Seal Depth and all Dimensions

To Be Specified:
- ☐ Color: ☐ White
- ☐ Seat: Chloride 955 open front seat less cover
- ☐ Seat: Church #5050C open front seat less cover
- ☐ Seat: Prosalt seats for American Standard, open front seat with/without cover (thermoset compound material). See page TB2-X02 through TB2-X05.
- ☐ Materials Seat:
- ☐ Flush Valve: ☐ Sloan Royal #110-3 (top spud) ☐ Sloan Royal #14-4.0 (back spud)
- ☐ Aftermarket Flush Valves:
- ☐ Center Fitting (by others):

SHOP DRAWING ACTION:
Rejected ☐
Re exceptions taken: X Resubmit as specified ☐
Make corrections noted ☐ Amend and resubmit ☐
Checking is only for conformance with design concept of project. Shop drawings are subject to certification by the Architect/Engineer. Contractor is responsible for: errors, discrepancies or omissions in materials; quantities; dimensions to be confirmed and correlated at job site; information pertaining solely to fabrication processes and techniques of construction.
Contractor will make all field measurements.
AINSWORTH ASSOCIATES By: SA☐ SA ☐ WD☐
Date 11/27/06 JF☐ DS☒ L ☐

⚠ When installed on top of seat in 460 to 480mm (17" to 19") from the finished floor.


CS-9 Portland 0209

© 2002 American Standard Inc.

American Standard

INSTANTO™ 3.5 GPF
ELONGATED FLUSH VALVE TOILET
VITRECHINA CHINA

2612.010 2611.012

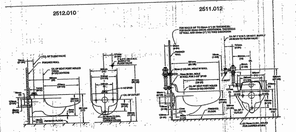

NOTES: Roughing-in information shown on reverse side of page.

Blowout water closets are exempt from the 1.6 gallon per flush requirements of the National Energy Policy Act. However, some state and local codes do not allow the use of 3.5 gallons per flush toilets. Check local codes.

SHOP DRAWING ACTION:
Rejected ☐
Re exceptions taken: X Resubmit as specified ☐
Make corrections noted ☐ Amend and resubmit ☐
Checking is only for conformance with design concept of project. Shop drawings are subject to certification by the Architect/Engineer. Contractor is responsible for: errors, discrepancies or omissions in materials; quantities; dimensions to be confirmed and correlated at job site; information pertaining solely to fabrication processes and techniques of construction.
Contractor will make all field measurements.
AINSWORTH ASSOCIATES By: SA☐ SA ☐ WD☐
Date 11/27/06 JF☐ DS☒ L ☐

⚠ When installed on top of seat in 460 to 480mm (17" to 19") from the finished floor.

CS-10

© 2002 American Standard Inc.

Los Medanos College
4CD Proj. #: L-565-B-23-SC
Science Building